
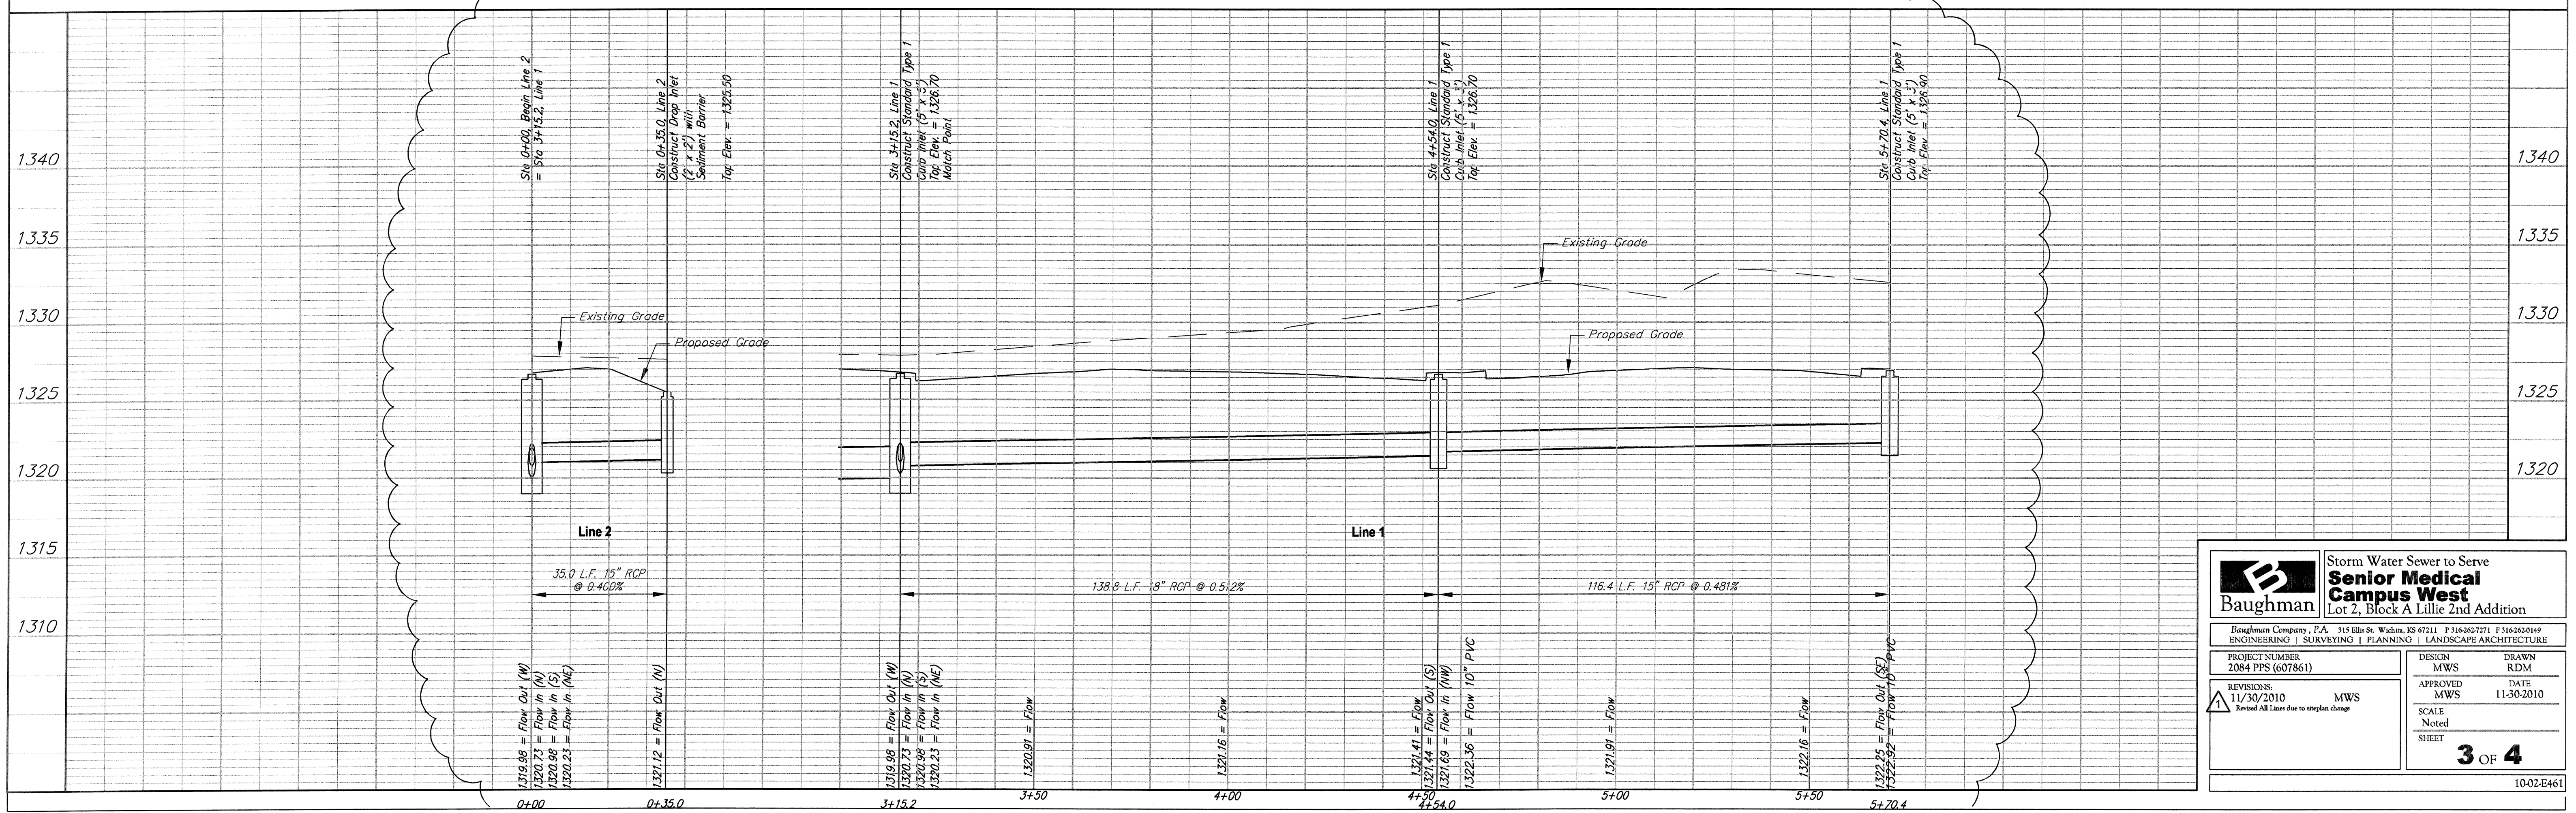
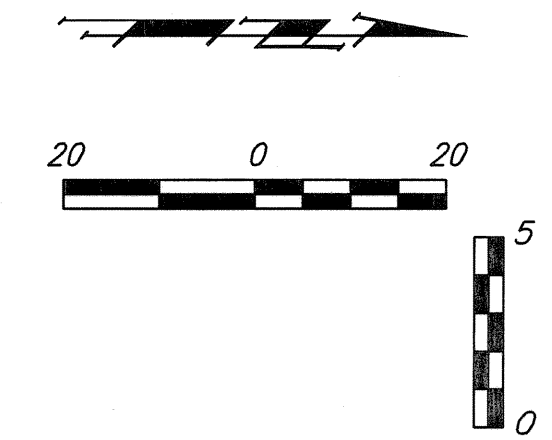


SITE BENCHMARK:

"□" Chiseled on Top of Curb,
southwest corner of Maize
Cul-de-Sac.
Elevation = 1328.65 (NAVD 88)

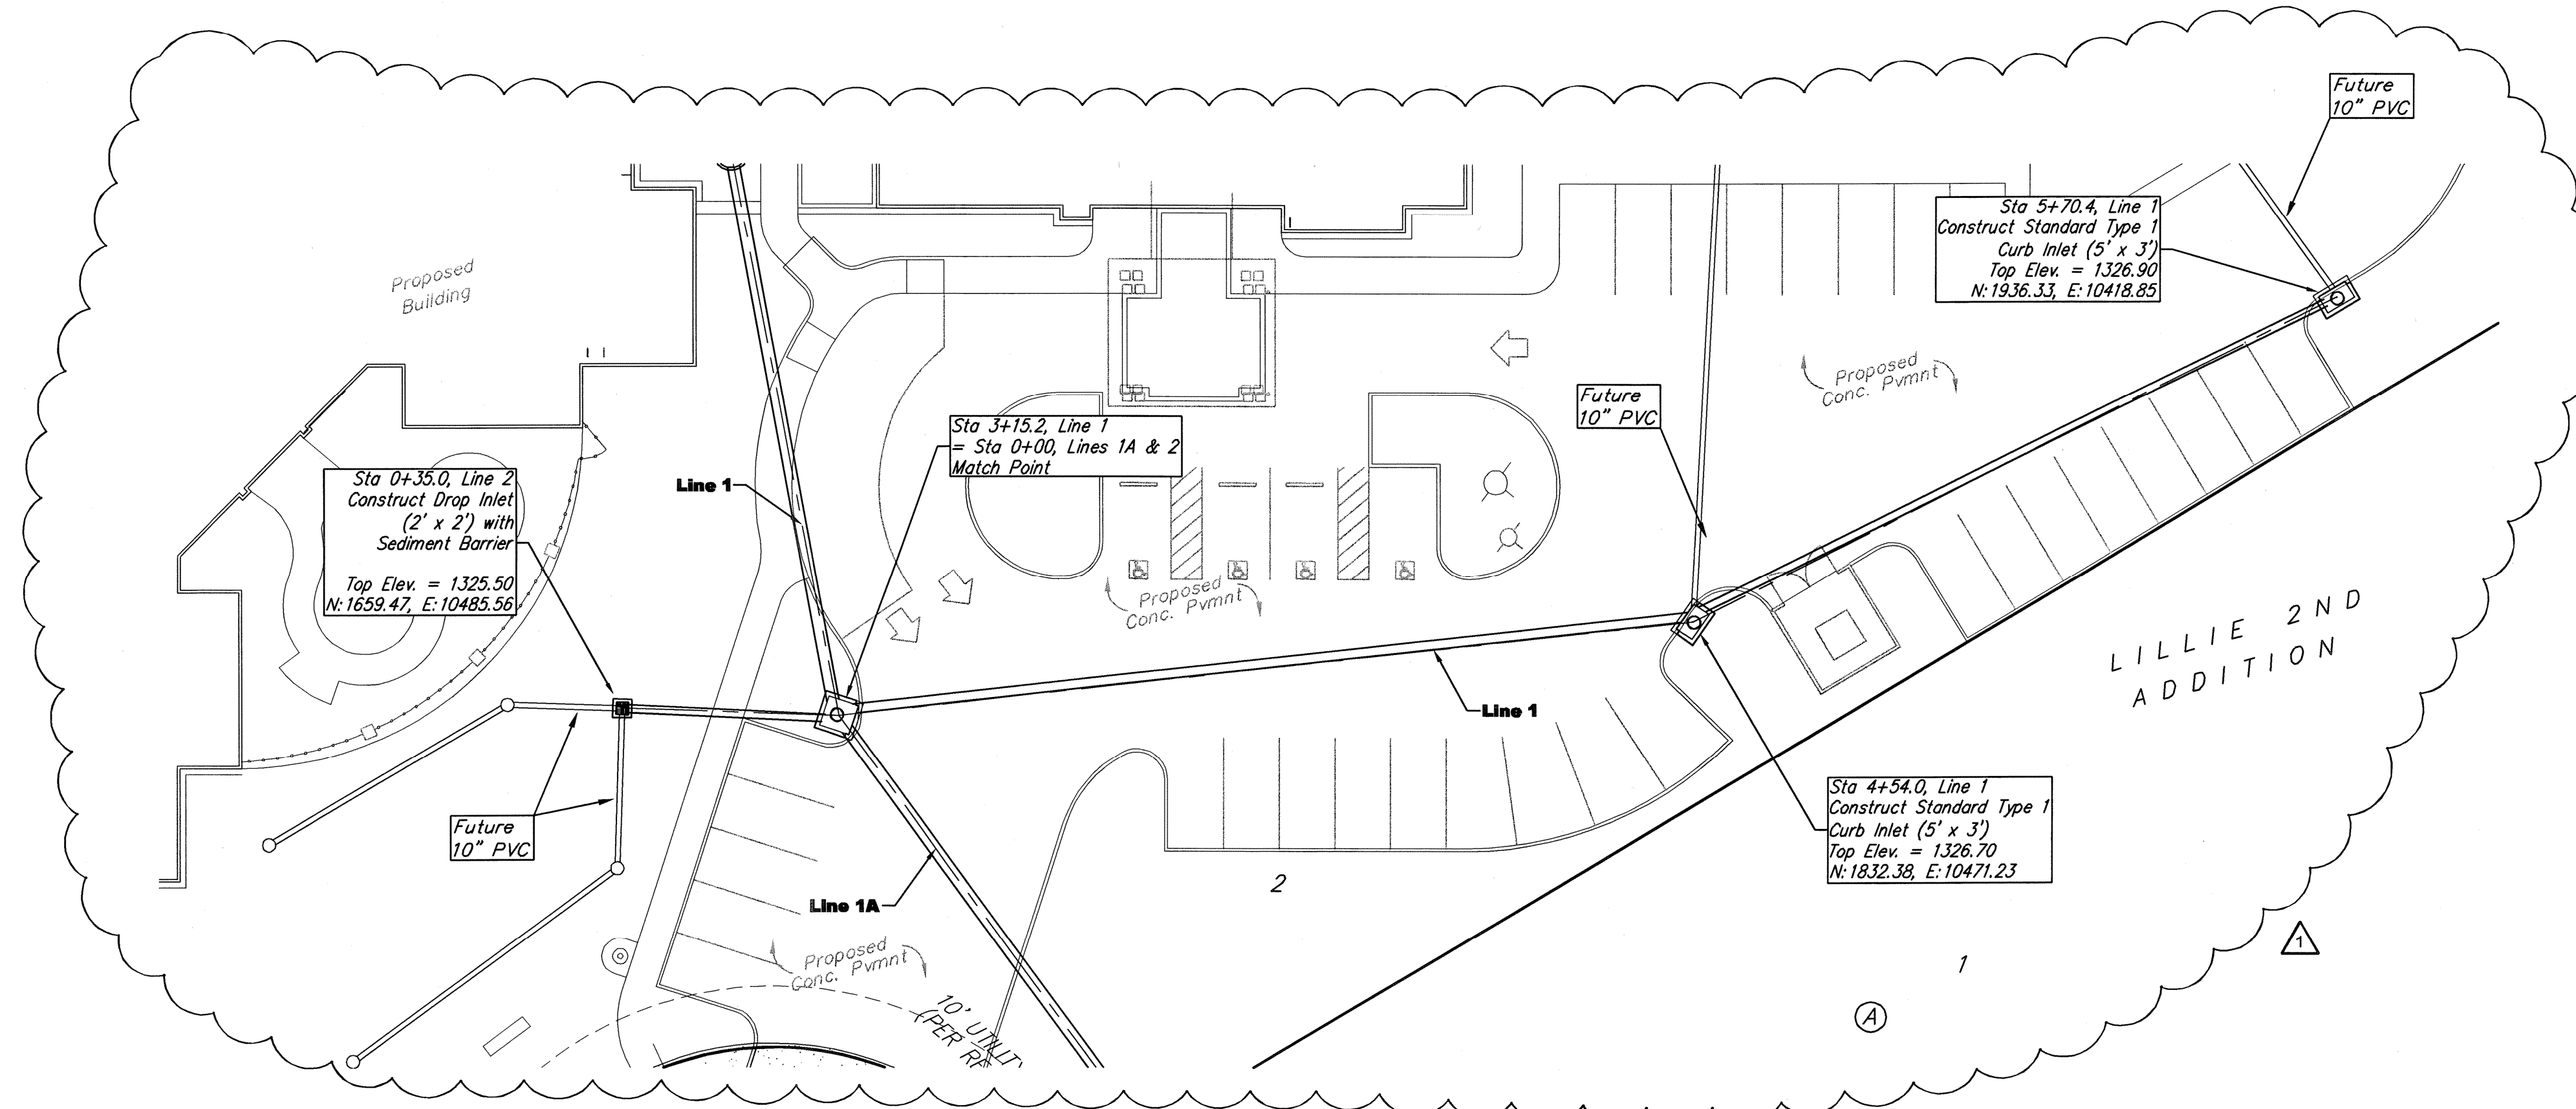

		Storm Water Sewer to Serve Senior Medical Campus West Lot 2, Block A Lillie 2nd Addition	
Baughman Company, P.A. 315 Ellis St. Wichita, KS 67211 P:3162027271 F:3162020149 ENGINEERING SURVEYING PLANNING LANDSCAPE ARCHITECTURE			
PROJECT NUMBER 2084 PPS (607861)	DESIGN MWS RDM	APPROVED MWS DATE 11-30-2010	SCALE Noted SHEET 3 OF 4
REVISIONS: 11/30/2010 MWS Revised All Lines due to stipplan change		10-02-E461	