

AS BUILTS


kemiller
engineering

516 S. Market,
Wichita, KS 67202

(316)264-0242

Benchmark:

'+' cut on back of curb on North end of median West of Davis Moore Mazda, off of access road. 61.5± feet North of Northwest property corner.
Elev. = 1360.60 (NGVD 29)

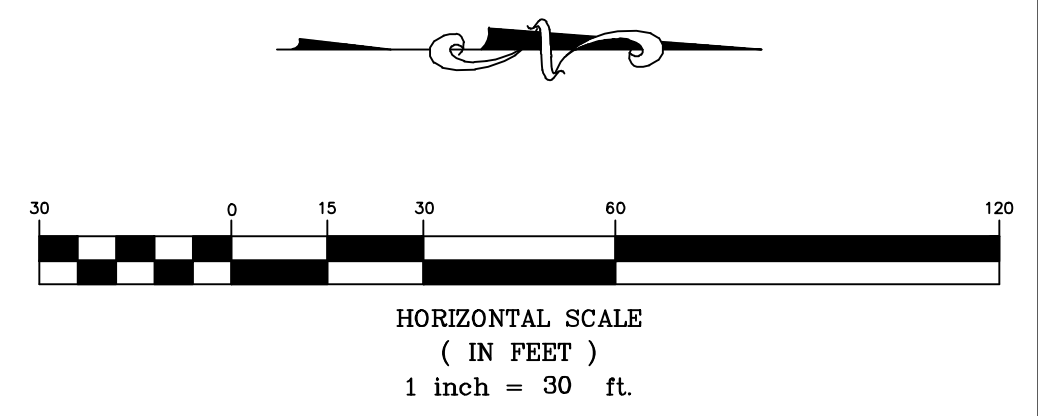

Grading Plan

kemiller engineering	PROJECT NUMBER		
	KEM NO. 10152	FILE	DATE 02/10/2011
	DESIGN KM	DRAWN NS	REVISED
	516 S. Market, Wichita, KS 67202 (316)264-0242		