



Concrete Weir Opening Detail (Resizing)

Note: Contractor shall tie the existing re-bars to the re-bars of added concrete. There should not be any exposed re-bar after cutting the concrete.

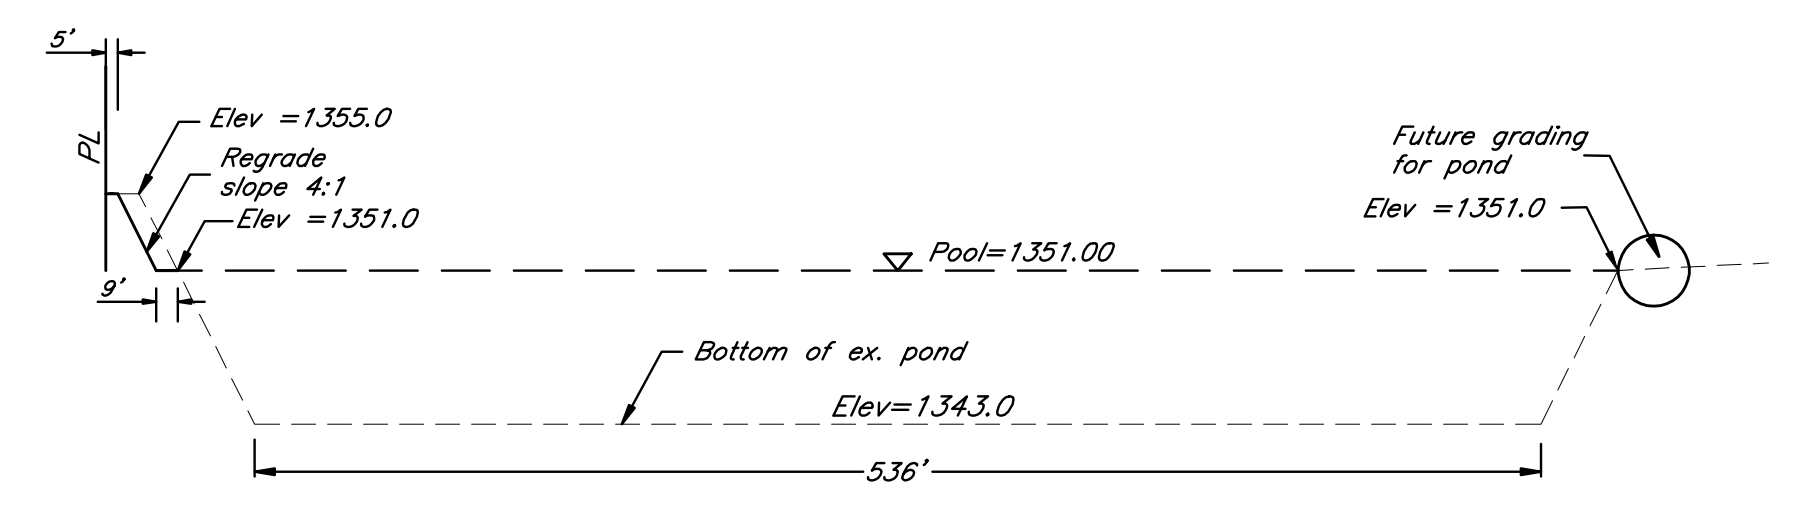

SECTION A-A
Horizontal Scale 1:80
Vertical Scale 1:10

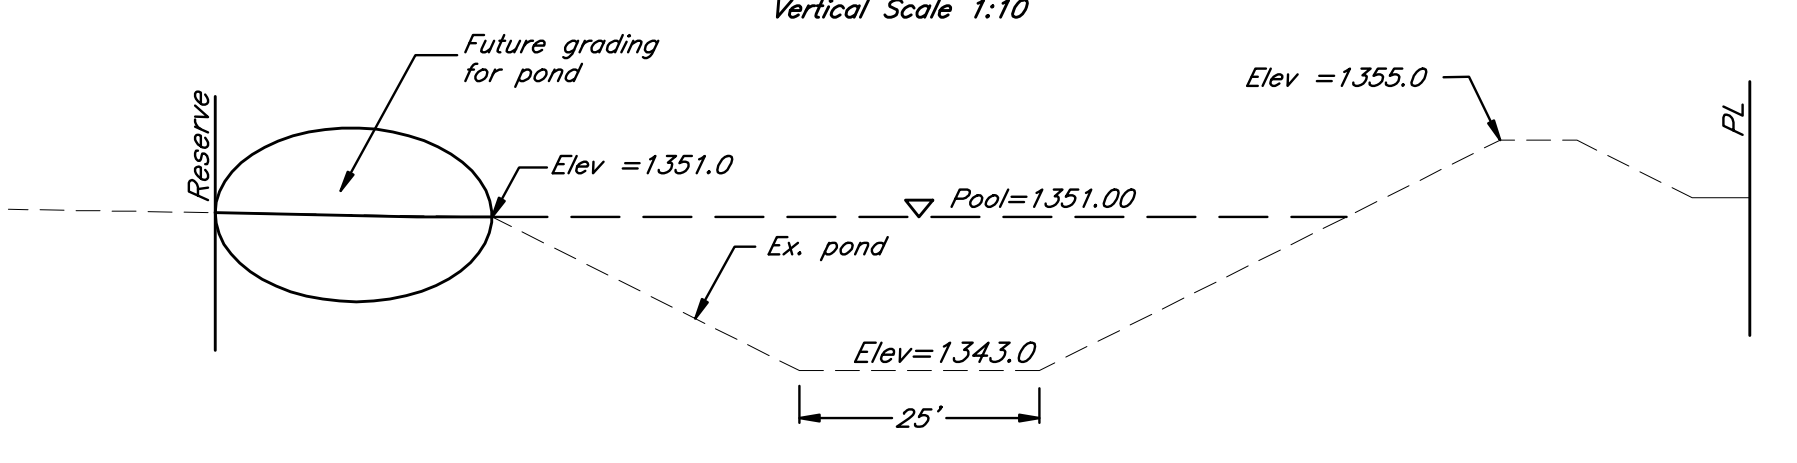


SECTION B-B
Horizontal Scale 1:20
Vertical Scale 1:10

AS BUILTS

kemiller engineering

516 S. Market,
Wichita, KS 67202 (316)284-0242

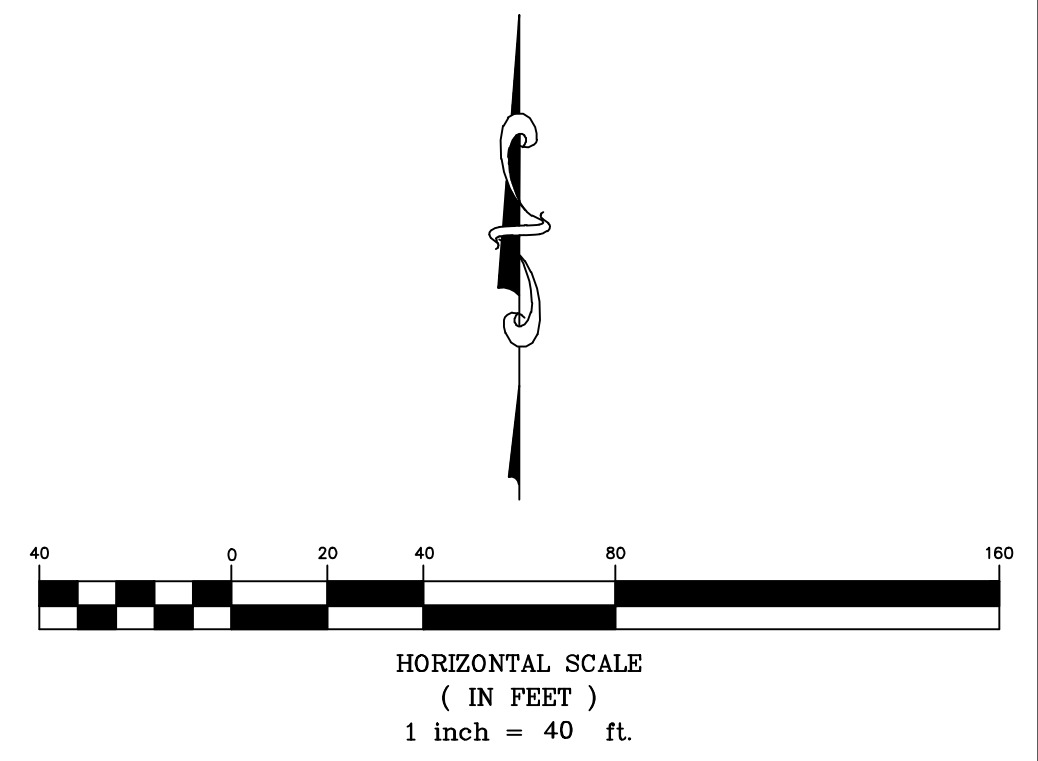

Pond Detail

kemiller engineering

516 S. Market, Wichita, KS 67202 (316)284-0242

PROJECT NUMBER		
KEM NO. 10152	FILE	DATE 2/25/2011
DESIGN KM	DRAWN NS	REVISED