

GENERAL NOTES:

1. Contractor will be required to provide notice to utility companies a minimum of twenty-four (24) hours prior to any excavation, as follows:

Kansas One-Call (316)687-2470

The Contractor must notify the following in case of an emergency:

Cox Communications (316)262-4270 or (316)263-2061

Westar Energy/ Kansas Gas & Electric Company (800)482-4950 AT&T 1-555-1212

City of Wichita Water Department (316)268-4908 City of Wichita Sewer Department (316)268-4071

Aquila Natural Gas (316)941-1608 or (800)303-0357

2. Exist. utilities and their locations, as shown on the plans, represent the best information obtainable for design. Location information has been obtained from the various utility companies and is either from company record drawings or company-provided field locations. The Contractor will be required to work around existing utilities which do not conflict with proposed constructions.

3. The Contractor to verify utility locations prior to construction of this project.

4. Utility service and installation shall be coordinated with the respective utility owner. Contacts are:

Kansas Gas Service Jim Coe (316)832-3126  
 Westar Energy Miles Capps (316)261-6251  
 Aquila Networks Calvin Briggs (316)942-8811  
 Wichita Water & Sewer Kerry Gibson (316)268-4555  
 AT&T Jim Toben (316)268-2759  
 Cox Communications Mark Anaya (316)262-4270

5. All lawn/turf areas disturbed by construction of proposed improvements shall be restored with the same grass as existing. Restoration of disturbed areas shall include, but not limited to, soil preparation, fertilizing, seeding, mulching (all seeded areas, outside the limits of erosion mat placement), and/or reseeding, and installation of erosion control mat. All seeding work shall be in accordance with the City of Wichita Standard Specifications and the City of Wichita Administrative Regulations No. AR 6.5 which governs cleanup and respiration or replacement following construction. All cost for the soil preparation, seeding and mulching (all seeded areas, outside the limits of erosion mat placement) shall be paid for through the lump sum bid item for "Seeding." All seeded areas within eight feet of the back of new curb shall be covered with an approved erosion mat, which shall be paid for by the measured quantity bed item "Back of Curb Protection (8' wide)."

6. Traffic affected by the construction of this project shall be handled in accordance with the latest edition of the Manual on Uniform Traffic Control Devices.


7. It is the contractor's responsibility to visit this site to better understand the extent of site clearing and restoration to be performed. Site Clearing and Restoration shall include all costs for removal of items which a pay item is not provided.

8. The contractor shall be responsible for preserving property irons. The contractor will be required to re-establish any property irons which are damaged or destroyed by the construction operations. Such irons shall be re-established by a licensed land surveyor in accordance with state laws.


9. Properties within the project limits may have underground sprinkler systems in public right-of-way which conflict with new construction. Contractor will be required to remove such improvements should they not be removed by their owner at the time of construction of the project. The contractor will be required to salvage all sprinkler heads and/or valves and give such material to owner. Portions of underground sprinkler systems not in conflict with new construction shall be protected from damage and shall remain in place. All work in connection with underground sprinkler systems shall be considered as subsidiary to the contract pay items for work.

10. Cuts made in paved surfaces on public property will be repaired by the City's Contractor and charged against the contractor. Unit Repair prices are available from the city at 268-4418. A surcharge may be applicable. Call 268-4418 for details. Repair costs to be paid prior to release of utility service if utilities are effected.

# DRAINAGE TO SERVE DAVIS MOORE NISSAN 0010 PPD (607861) CITY OF WICHITA, KANSAS Jim Armour, P.E., City Engineer

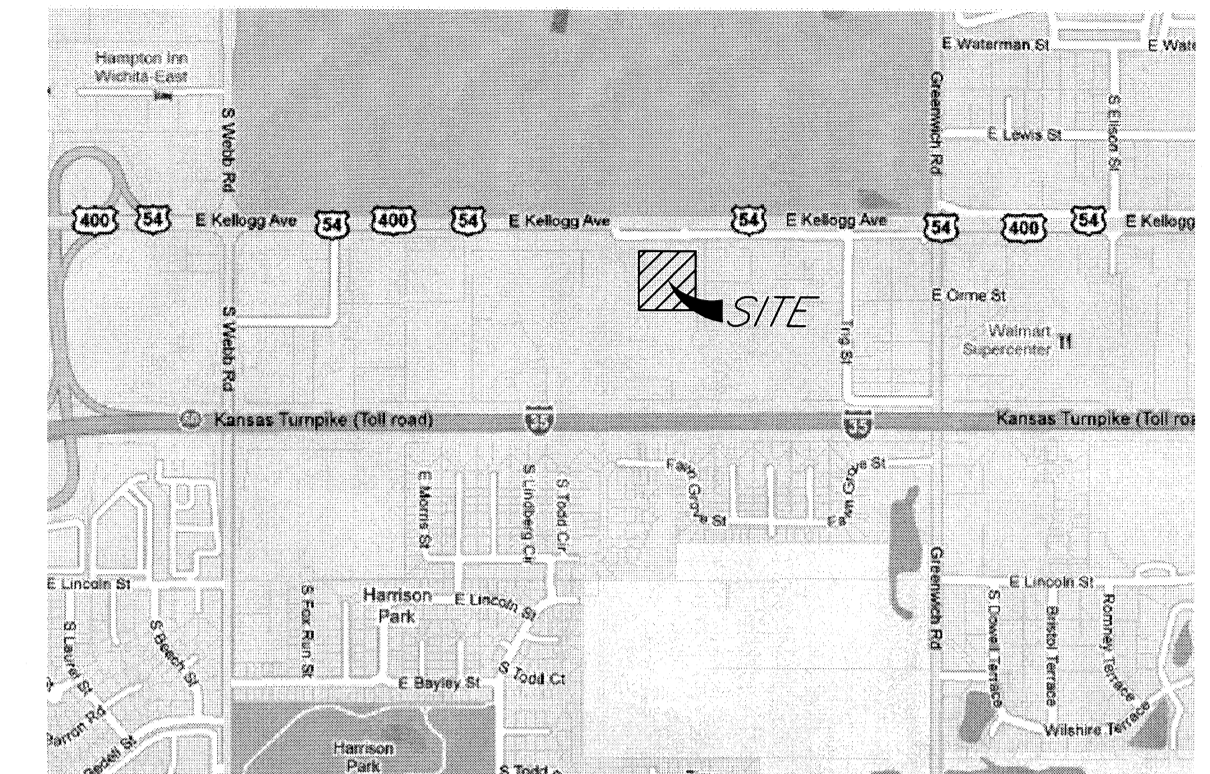

LOCATION MAP  
 (For Visual Use Only)

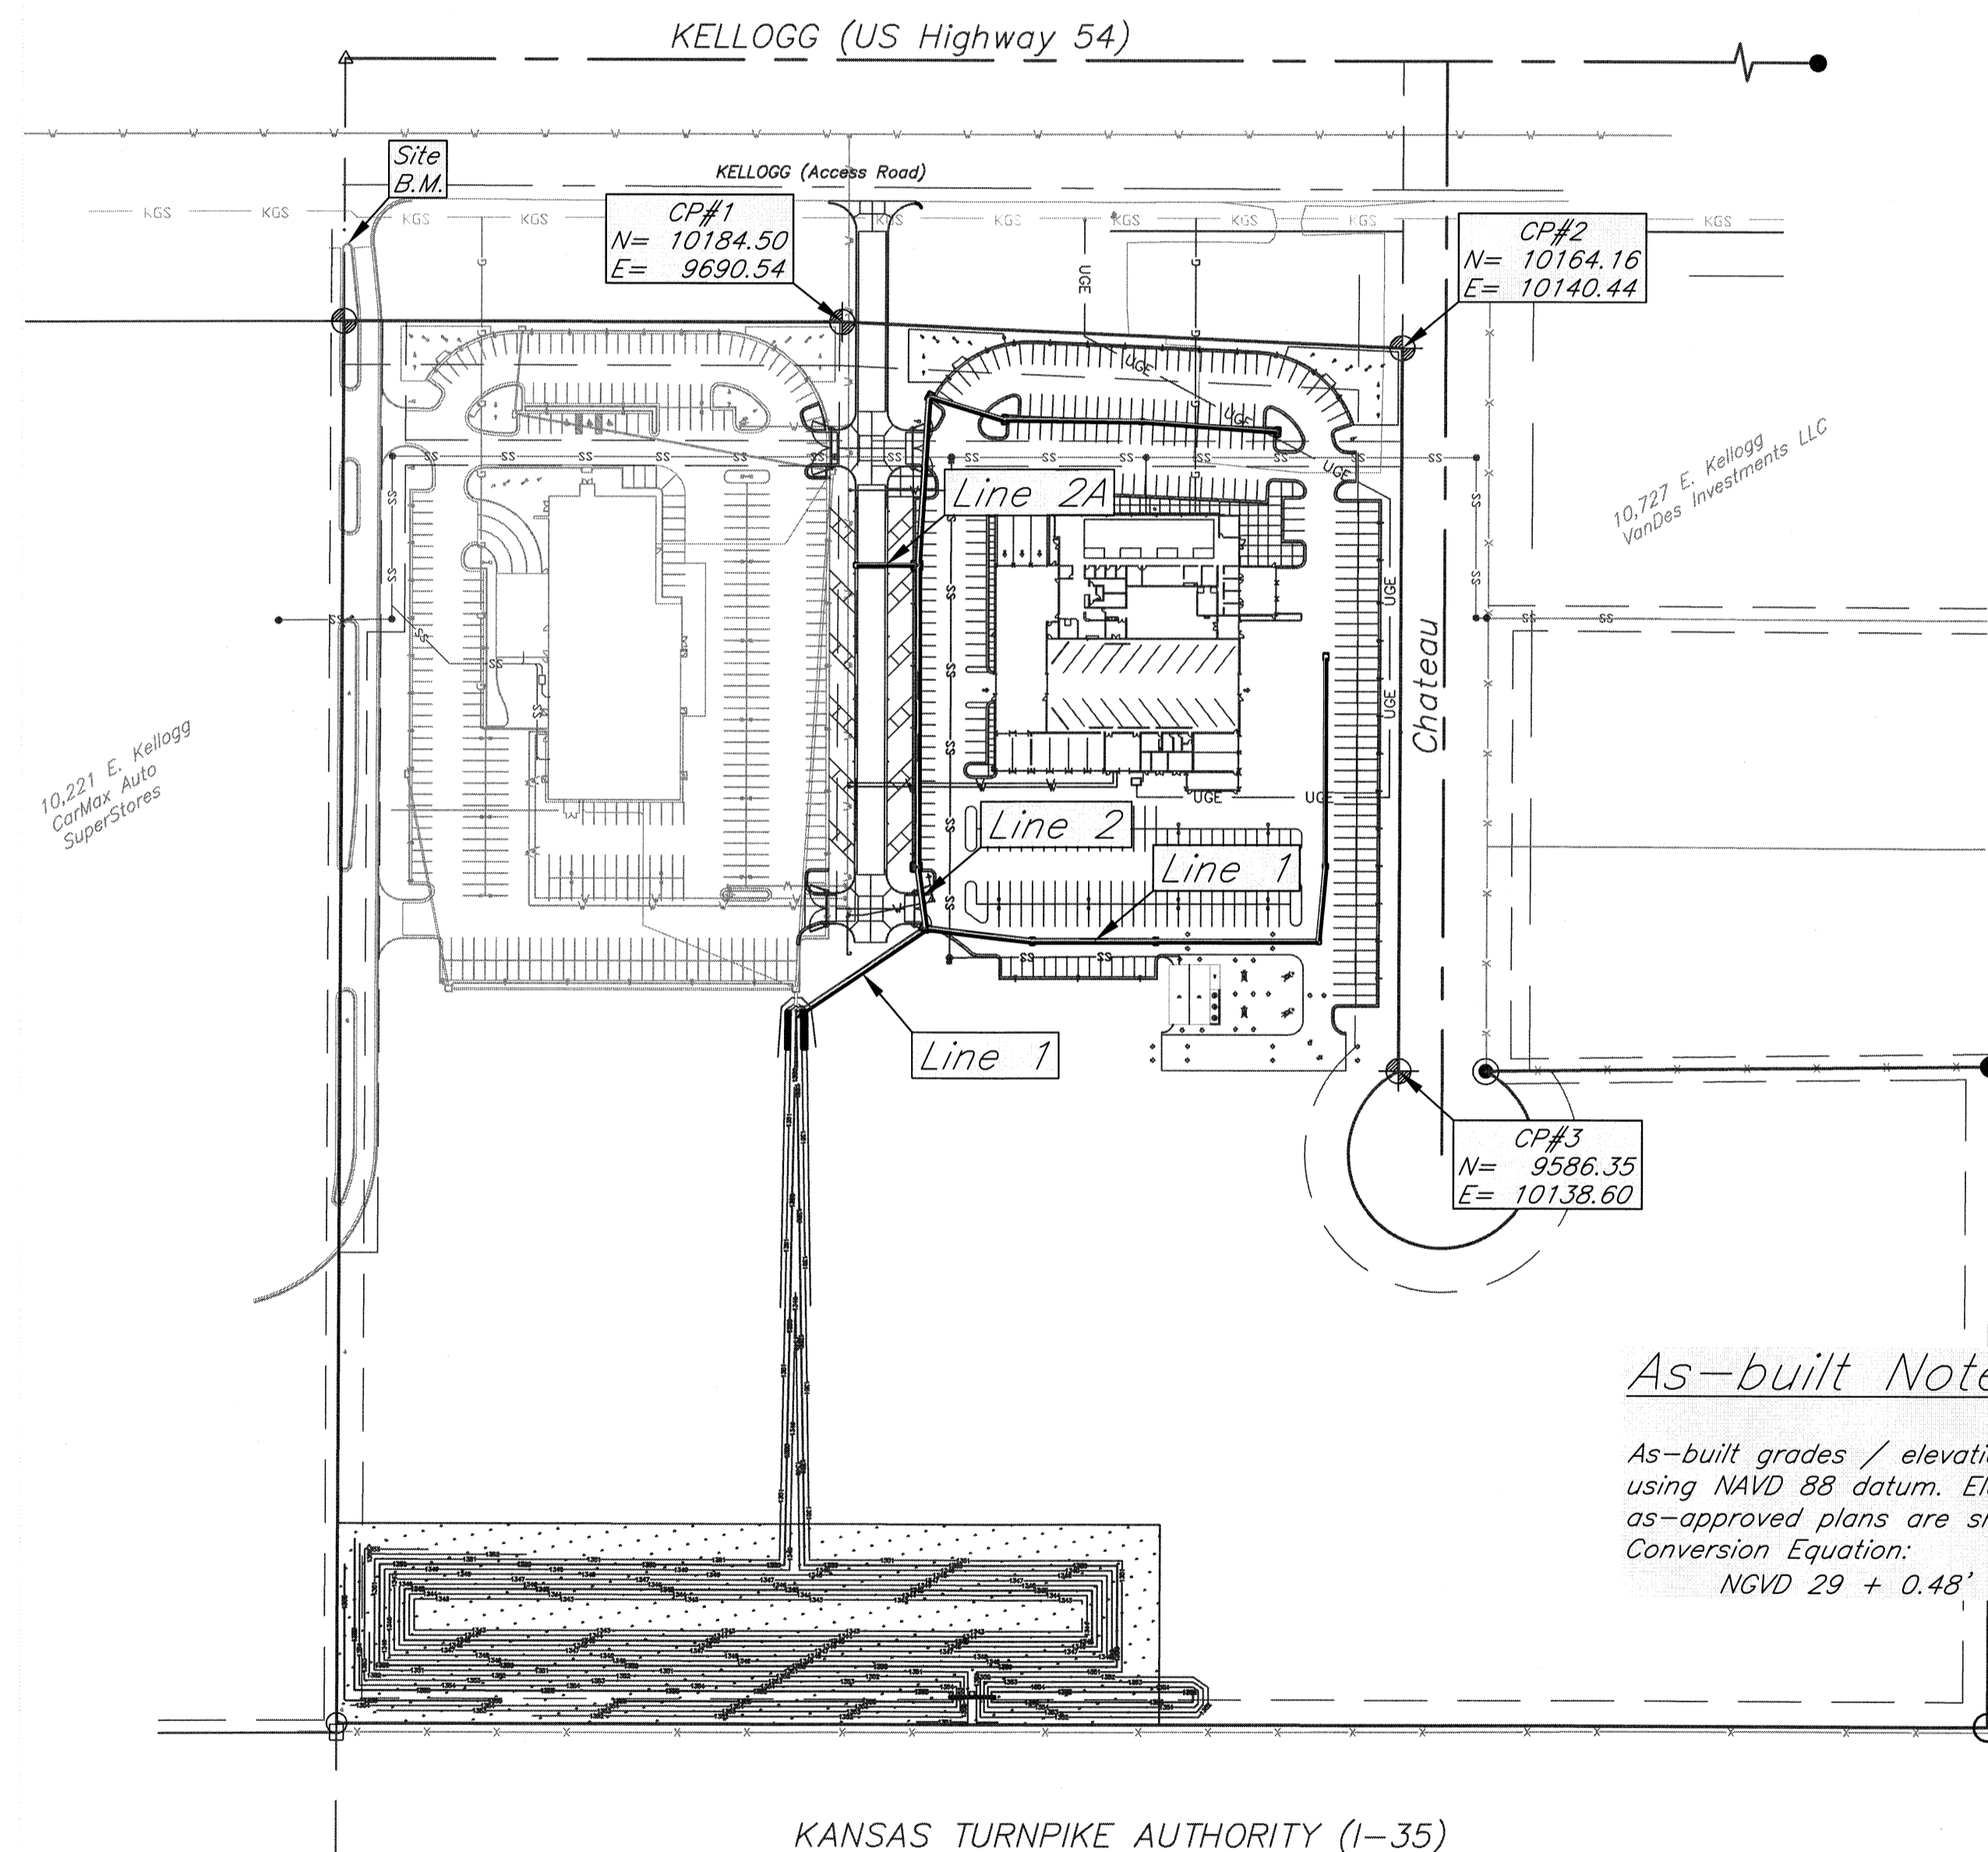

As-built Notes:

As-built grades / elevations are to be given using NAVD 88 datum. Elevations shown on as-approved plans are shown using NGVD 29. Conversion Equation:  
 NGVD 29 + 0.48' = NAVD 88

Index of Sheets:

- C5.0 Cover Sheet
- C5.1 Drainage Plan
- C5.2 ERU Plan
- C4.0 Grading Plan
- C5.3 Pond Detail
- C5.4.1 Line 1 (0+00-4+00)
- C5.4.2 Line 1 (4+00-6+68.50)
- C5.4.3 Line 2 (0+00-4+00)
- C5.4.4 Line 2 (0+00-7+07) / Line 2A
- C5.5.1 Type '1' Inlet Detail
- C5.5.2 Type '2-A' Inlet Detail
- C5.5.3 Inlet Lid & Frame Detail
- C5.5.4 Drop Inlet Detail
- C5.5.5 Rip-Rap Detail
- C6.0 Erosion Plan
- C6.1 Erosion Detail
- C6.2 Erosion Detail
- C6.3 Erosion Detail
- C7.0 Plat

Benchmark:

'4' cut on back of curb on North end of median West of Davis Moore Mazda, off of access road. 61.5± feet North of Northwest property corner.  
 Elev. = 1360.60 (NGVD 29)  
 Conv. = 1361.08 (NAVD 88)  
 \*\* see as built notes\*\*

Hatching Legend:



APPROVED AS NOTED

Storm Water Utility Office: *[Signature]* 3/11/11

City Engineer: *[Signature]* 3-11-11  
 Office: Julianne Kallman

NOTE TO CONTRACTORS

Installation, inspection and testing for this project is to be provided by a Licensed Consulting Engineering Firm under contract with the Owner/Developer. Said inspection to be in accordance with the City of Wichita standard construction engineering practices and certified by a Licensed Professional Engineer. No work shall be performed in dedicated easements or public right-of-way by the Contractor without such inspection nor shall any work be commenced without written authorization by the City Engineer. All Construction and Materials shall comply with the City of Wichita Specifications and Standards (on file and available in the City Engineer's Office).


**AS BUILTS**

Contractor: McCullough Excavation, Inc. 7/22/2011

Project Inspector: Tom Jones

**kemiller engineering**  
 516 S. Market, Wichita, KS 67202 (316)264-0242

February 2011

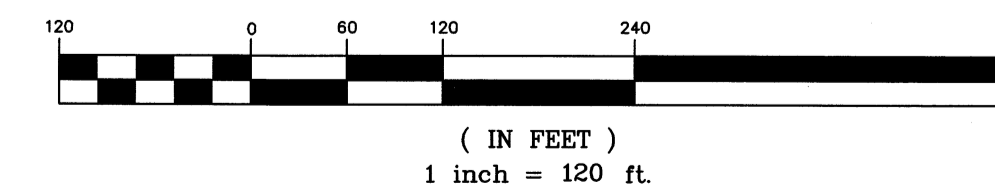

**kemiller engineering**

516 S. Market, Wichita, KS 67202 316/264-0242

0010 PPD (607861)  
 Cover Sheet

C5.0

SPANGENBERG PHILLIPS TICE ARCHITECTURE  
 121 N. Mead, Ste 201, Wichita, KS 67202  
 T 316.267.4002, F 316.267.1509  
 www.sptarchitecture.com



DAVIS MOORE NISSAN  
 E. KELLOGG, WICHITA, KS