


CAUTION - NOTICE TO CONTRACTOR
 THE CONTRACTOR IS SPECIFICALLY CAUTIONED THAT THE LOCATION AND/OR ELEVATION OF EXISTING UTILITIES AS SHOWN ON THESE PLANS IS BASED ON RECORDS OF THE VARIOUS UTILITY COMPANIES AND, WHERE POSSIBLE, MEASUREMENTS TAKEN IN THE FIELD. THE INFORMATION IS NOT TO BE RELIED ON AS BEING EXACT OR COMPLETE. THE CONTRACTOR MUST CALL THE APPROPRIATE UTILITY COMPANY AT LEAST 48 HOURS BEFORE ANY EXCAVATION TO REQUEST EXACT FIELD LOCATION OF UTILITIES. IT SHALL BE THE RESPONSIBILITY OF THE CONTRACTOR TO RELOCATE ALL EXISTING UTILITIES WHICH CONFLICT WITH THE PROPOSED IMPROVEMENTS SHOWN ON THE PLANS.

BEARING & STATIONING NOTE:
 ALL SEWER BEARINGS AND LINE DIMENSIONS ARE MEASURED TO THE CENTER OF JUNCTION BOXES AND MANHOLES UNLESS OTHERWISE INDICATED. THE CONTRACTOR SHALL MAKE ADJUSTMENTS IN PIPE CONNECTIONS AT JUNCTION BOXES AND MANHOLES AS NECESSARY TO ALLOW THE DESIGN TO BE BUILT.


NOTE: THE GENERAL CONTRACTOR IS RESPONSIBLE FOR MAKING ALL ADJUSTMENTS OF EXISTING UTILITIES TO ALLOW THE DESIGN TO BE BUILT.

TRAFFIC CONTROL NOTE:
 THE CONTRACTOR SHALL SUBMIT A TRAFFIC CONTROL PLAN TO THE CITY TRAFFIC ENGINEER AND GET APPROVAL BEFORE STARTING CONSTRUCTION OF THE STORM SEWER SYSTEM.

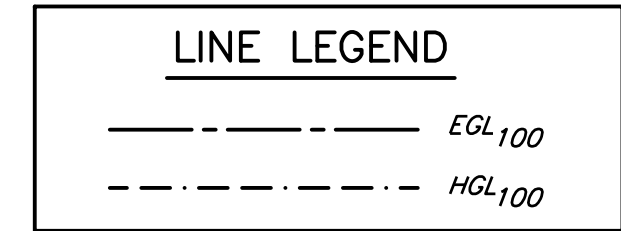

LEGEND

⊕	LIGHT POLE AND FIXTURE TYPE (REF. SITE PLAN FOR DETAILS)	---	IRR	IRRIGATION WATER LINE
+	3 WAY FIRE HYDRANT	---	UGE	POWER UNDERGROUND BY CONTRACTOR
⊥	W.L. TEE	---	UGT	TELEPHONE UNDERGROUND (PER CITY STDS)
⊥	W.L. GATE VALVE (G.V.)	---	G	GAS LINE
⊥	W.L. BENDS	---	U/E	UTILITY EASEMENT
⊕	STORM SEWER INLET	SS	SS	SANITARY SEWER
⊕	STORM SEWER CURB INLET	W.L.	W.L.	WATER LINE
⊕	STORM SEWER MANHOLE (SWMH)	DS	DS	DOWNSPOUT
		SWS	SWS	STORM SEWER

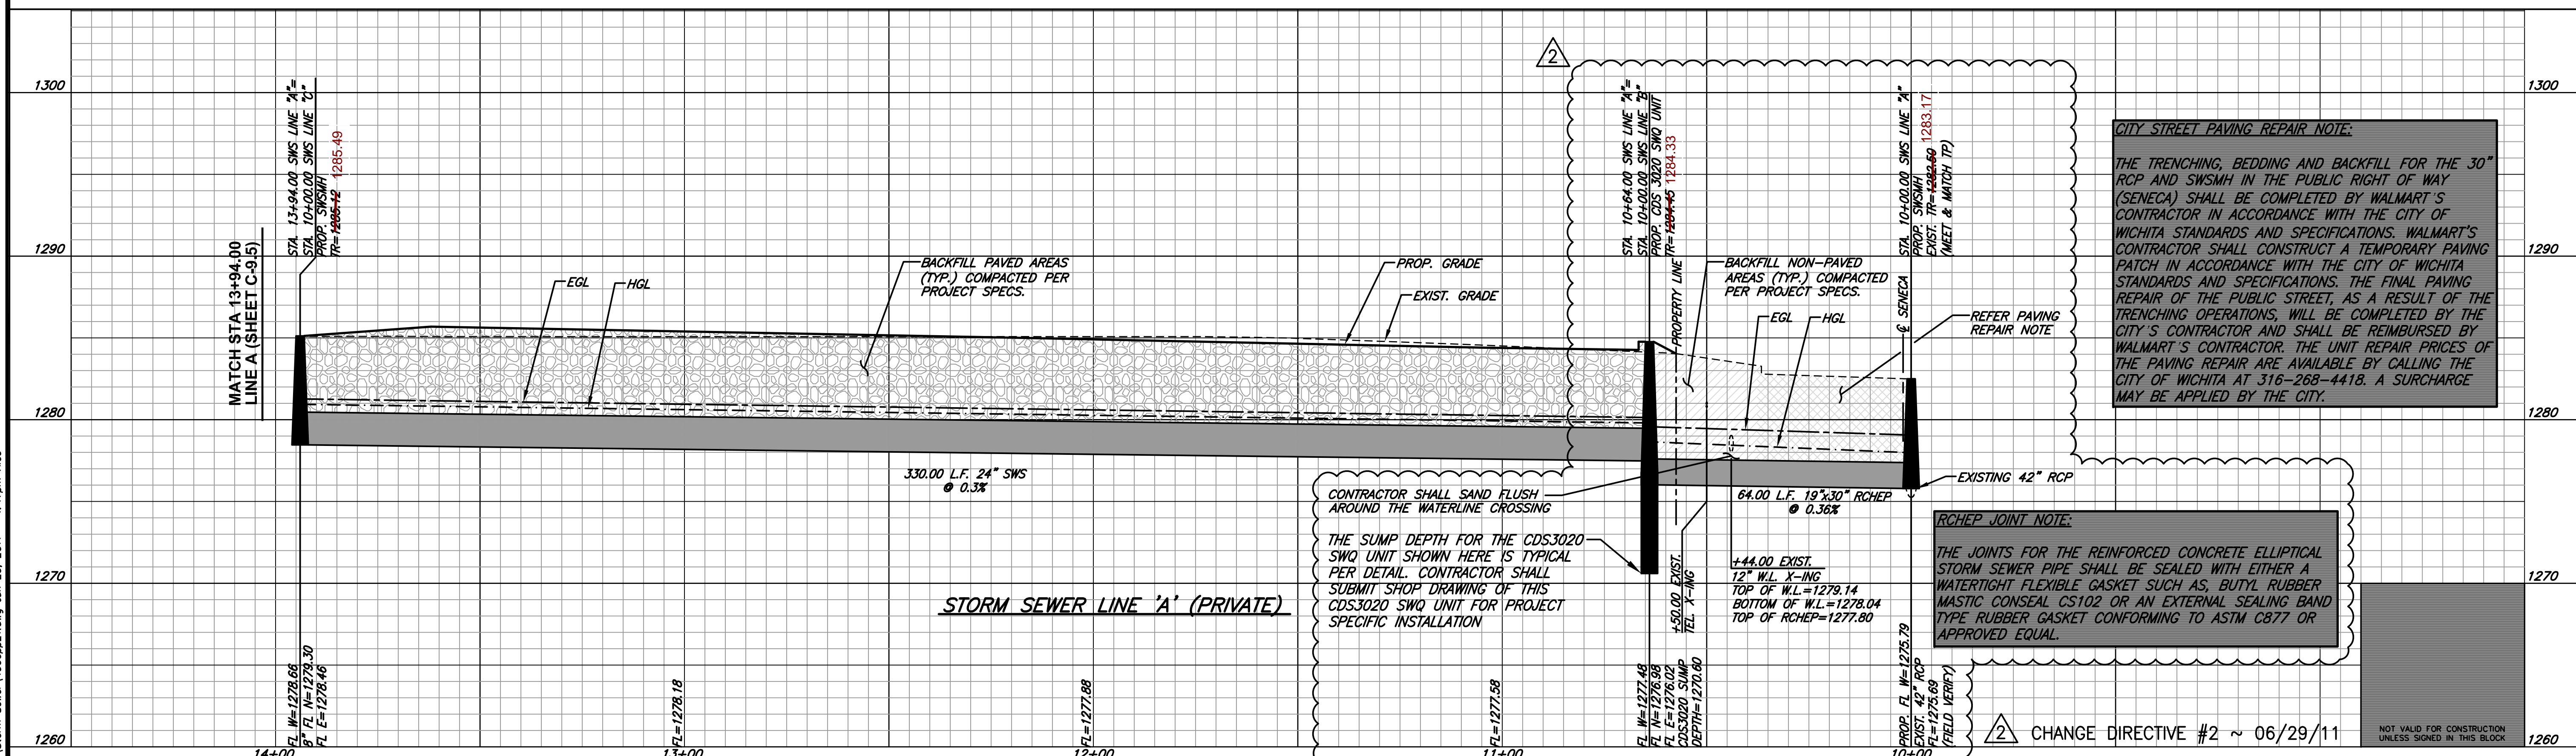

CITY STREET PAVING REPAIR NOTE:
 THE TRENCHING, BEDDING AND BACKFILL FOR THE 30" RCP AND SWSMH IN THE PUBLIC RIGHT OF WAY (SENECA) SHALL BE COMPLETED BY WALMART'S CONTRACTOR IN ACCORDANCE WITH THE CITY OF WICHITA STANDARDS AND SPECIFICATIONS. WALMART'S CONTRACTOR SHALL CONSTRUCT A TEMPORARY PAVING PATCH IN ACCORDANCE WITH THE CITY OF WICHITA STANDARDS AND SPECIFICATIONS. THE FINAL PAVING REPAIR OF THE PUBLIC STREET, AS A RESULT OF THE TRENCHING OPERATIONS, WILL BE COMPLETED BY THE CITY'S CONTRACTOR AND SHALL BE REIMBURSED BY WALMART'S CONTRACTOR. THE UNIT REPAIR PRICES OF THE PAVING REPAIR ARE AVAILABLE BY CALLING THE CITY OF WICHITA AT 316-268-4418. A SURCHARGE MAY BE APPLIED BY THE CITY.

RCHP JOINT NOTE:
 THE JOINTS FOR THE REINFORCED CONCRETE ELLIPTICAL STORM SEWER PIPE SHALL BE SEALED WITH EITHER A WATERTIGHT FLEXIBLE GASKET SUCH AS, BUTYL RUBBER MASTIC CONSEAL CS102 OR AN EXTERNAL SEALING BAND TYPE RUBBER GASKET CONFORMING TO ASTM C877 OR APPROVED EQUAL.

CONTRACTOR SHALL SAND FLUSH AROUND THE WATERLINE CROSSING
 THE SUMP DEPTH FOR THE CDS3020 SWQ UNIT SHOWN HERE IS TYPICAL PER DETAIL. CONTRACTOR SHALL SUBMIT SHOP DRAWING OF THIS CDS3020 SWQ UNIT FOR PROJECT SPECIFIC INSTALLATION

C:\46861\Storm Sewer\46861.dwg Jun 29, 2011 - 4:47pm Alic