

CAUTION - NOTICE TO CONTRACTOR
 THE CONTRACTOR IS SPECIFICALLY CAUTIONED THAT THE LOCATION AND/OR ELEVATION OF EXISTING UTILITIES AS SHOWN ON THESE PLANS IS BASED ON RECORDS OF THE VARIOUS UTILITY COMPANIES AND WHERE POSSIBLE, MEASUREMENTS TAKEN IN THE FIELD. THE INFORMATION IS NOT TO BE RELIED ON AS BEING EXACT OR COMPLETE. THE CONTRACTOR MUST CALL THE APPROPRIATE UTILITY COMPANY AT LEAST 48 HOURS BEFORE ANY EXCAVATION TO REQUEST EXACT FIELD LOCATION OF UTILITIES. IT SHALL BE THE RESPONSIBILITY OF THE CONTRACTOR TO RELOCATE ALL EXISTING UTILITIES WHICH CONFLICT WITH THE PROPOSED IMPROVEMENTS SHOWN ON THE PLANS.

BEARING & STATIONING NOTE:
 ALL SEWER BEARINGS AND LINE DIMENSIONS ARE MEASURED TO THE CENTER OF JUNCTION BOXES AND MANHOLES UNLESS OTHERWISE INDICATED. THE CONTRACTOR SHALL MAKE ADJUSTMENTS IN PIPE CONNECTIONS AT JUNCTION BOXES AND MANHOLES AS NECESSARY TO ALLOW THE DESIGN TO BE BUILT.


NOTE: THE GENERAL CONTRACTOR IS RESPONSIBLE FOR MAKING ALL ADJUSTMENTS OF EXISTING UTILITIES TO ALLOW THE DESIGN TO BE BUILT.

LINE LEGEND

---	EGL100
- - - - -	HGL100

LEGEND

KV	LIGHT POLE AND FIXTURE TYPE (REF: SITE PLAN FOR DETAILS)	IRR	IRRIGATION WATER LINE
+	3 WAY FIRE HYDRANT	UGE	POWER UNDERGROUND BY CONTRACTOR
W.L. TEE	W.L. TEE	UGT	TELEPHONE UNDERGROUND (PER CITY STDS)
W.L. GATE VALVE (G.V.)	W.L. GATE VALVE (G.V.)	G	GAS LINE
W.L. BENDS	W.L. BENDS	U/E	UTILITY EASEMENT
SS	STORM SEWER INLET	SS	SANITARY SEWER
W.L.	STORM SEWER CURB INLET	W.L.	WATER LINE
DS	STORM SEWER MANHOLE (SWMH)	DS	DOWNSPOUT
SWS		SWS	STORM SEWER

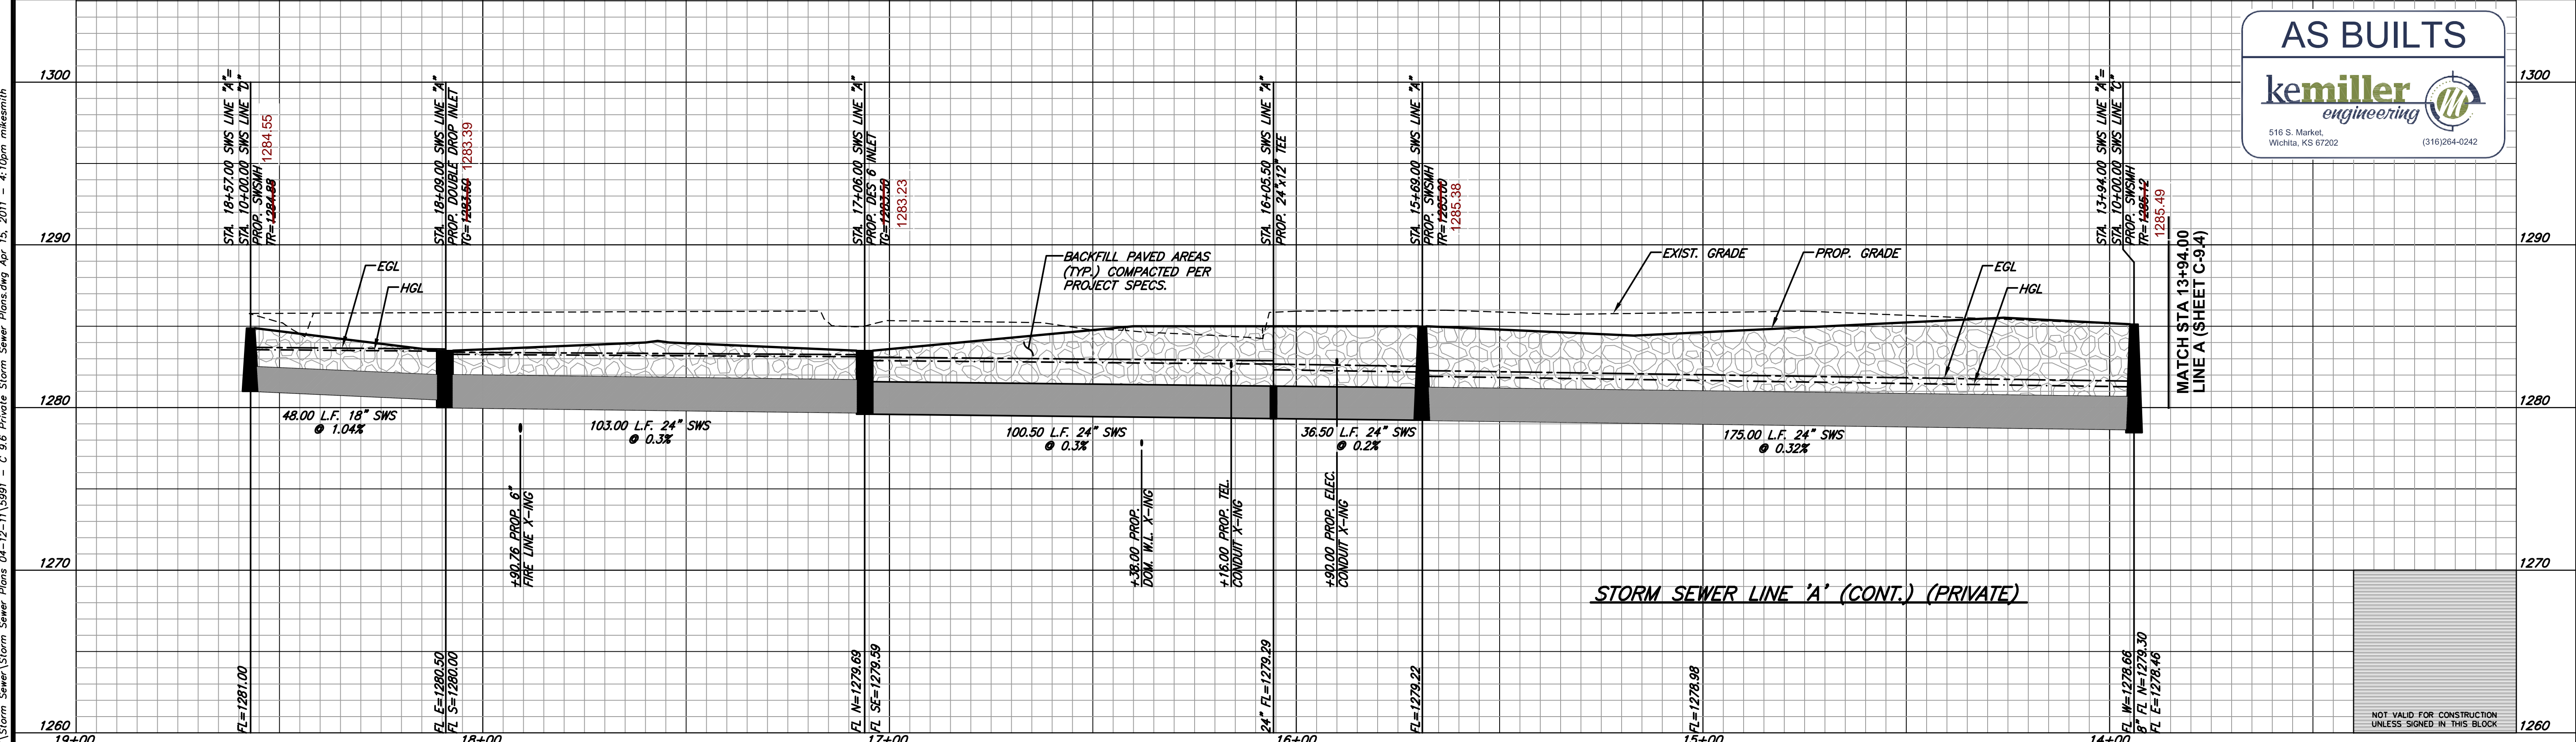

AS BUILTS
kemiller engineering
 516 S. Market, Wichita, KS 67202 (316)264-0242