


LOCATION MAP
NOT TO SCALE

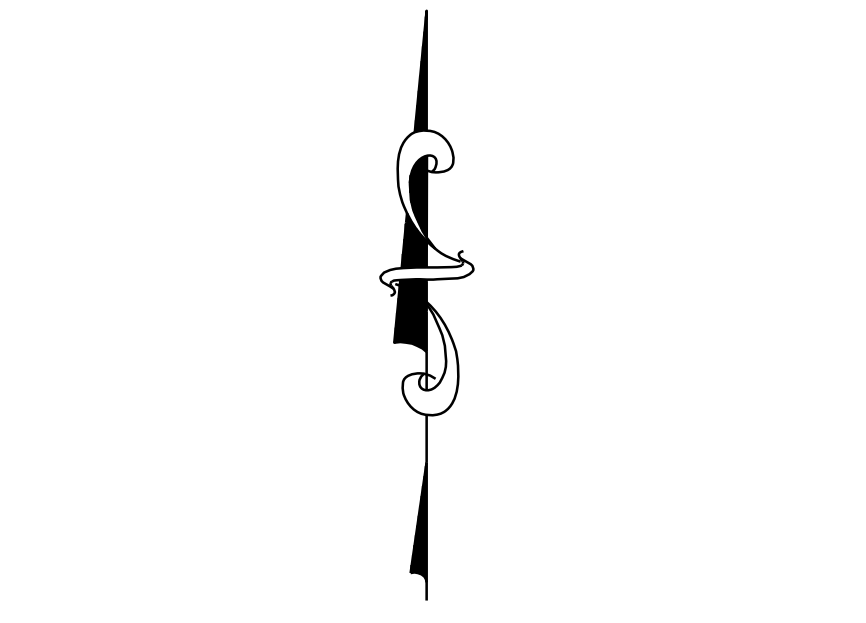

- LEGEND**
- SIGN (i.e. STOP, YIELD, etc...)
 - ⊕ LIGHT POLE AND FIXTURE TYPE
 - STORM SEWER INLET
 - ⊞ STORM SEWER CURB INLET
 - ⊙ STORM SEWER MANHOLE (SWMH)

STORM SEWER LINE LOCATION PLAN

WALMART MARKET #5991-00
31st STREET & S. SENECA STREET
WICHITA, KANSAS

SMC Consulting Engineers, P.C.
 815 West Main - Oklahoma City, OK 73106
 PH: 405-232-7715 Fax: 405-232-7859
 KANSAS CERTIFICATE OF AUTHORIZATION NO. E-335 EXP. Dec. 31, 2011

No.	Revision	By	Date
1	MM review comments	MDS	03/01/11
2	MM review comments	MDS	04/12/11

DATE: 03/01/11	SCALE:	SHEET NO.
DRAWN BY: MDS	1"=40'	C-9.1
PROJECT NO.: 4966.00	ENGINEER: TERENCE L. HAYNES, P.E. #14583	

AS BUILTS

kemiller engineering

516 S. Market
Wichita, KS 67202 (316)264-0242

UTILITY STATEMENT & CAUTION:

THE CONTRACTOR IS SPECIFICALLY CAUTIONED THAT THE LOCATION AND/OR ELEVATION OF EXISTING UTILITIES AS SHOWN ON THESE PLANS IS BASED ON A COMBINATION OF FIELD SURVEY INFORMATION, EXISTING DRAWINGS AND RECORDS OF THE VARIOUS UTILITY COMPANIES. THE ENGINEER MAKES NO GUARANTEE THAT THE UNDERGROUND UTILITIES SHOWN COMPRISE ALL SUCH UTILITIES IN THE AREA, EITHER IN SERVICE OR ABANDONED. THE ENGINEER FURTHER DOES NOT WARRANT THAT THE UNDERGROUND UTILITIES SHOWN ARE IN THE EXACT LOCATION INDICATED ALTHOUGH HE DOES CERTIFY THAT THEY ARE LOCATED AS ACCURATELY AS POSSIBLE FROM INFORMATION AVAILABLE. THE ENGINEER HAS NOT PHYSICALLY LOCATED THE UNDERGROUND UTILITIES. THE CONTRACTOR MUST CALL THE APPROPRIATE UTILITY COMPANY AT LEAST 48 HOURS BEFORE ANY EXCAVATION TO REQUEST EXACT FIELD LOCATION OF UTILITIES. IT SHALL BE THE RESPONSIBILITY OF THE CONTRACTOR TO RELOCATE ALL EXISTING UTILITIES WHICH CONFLICT WITH THE PROPOSED IMPROVEMENTS SHOWN ON THE PLANS.

NOT VALID FOR CONSTRUCTION UNLESS SIGNED IN THIS BLOCK