

CAUTION - NOTICE TO CONTRACTOR
 THE CONTRACTOR IS SPECIFICALLY CAUTIONED THAT THE LOCATION AND/OR ELEVATION OF EXISTING UTILITIES AS SHOWN ON THESE PLANS IS BASED ON RECORDS OF THE VARIOUS UTILITY COMPANIES AND, WHERE POSSIBLE, MEASUREMENTS TAKEN IN THE FIELD. THE INFORMATION IS NOT TO BE RELIED ON AS BEING EXACT OR COMPLETE. THE CONTRACTOR MUST CALL THE APPROPRIATE UTILITY COMPANY AT LEAST 48 HOURS BEFORE ANY EXCAVATION TO REQUEST EXACT FIELD LOCATION OF UTILITIES. IT SHALL BE THE RESPONSIBILITY OF THE CONTRACTOR TO RELOCATE ALL EXISTING UTILITIES WHICH CONFLICT WITH THE PROPOSED IMPROVEMENTS SHOWN ON THE PLANS.

BEARING & STATIONING NOTE:
 ALL SEWER BEARINGS AND LINE DIMENSIONS ARE MEASURED TO THE CENTER OF JUNCTION BOXES AND MANHOLES UNLESS OTHERWISE INDICATED. THE CONTRACTOR SHALL MAKE ADJUSTMENTS IN PIPE CONNECTIONS AT JUNCTION BOXES AND MANHOLES AS NECESSARY TO ALLOW THE DESIGN TO BE BUILT.

NOTE: THE GENERAL CONTRACTOR IS RESPONSIBLE FOR MAKING ALL ADJUSTMENTS OF EXISTING UTILITIES TO ALLOW THE DESIGN TO BE BUILT.


TRAFFIC CONTROL NOTE:
 THE CONTRACTOR SHALL SUBMIT A TRAFFIC CONTROL PLAN TO THE CITY TRAFFIC ENGINEER AND GET APPROVAL BEFORE STARTING CONSTRUCTION OF THE STORM SEWER SYSTEM.

LINE LEGEND

---	EGL100
- - -	HGL100

LEGEND

KV	LIGHT POLE AND FIXTURE TYPE (REF: SITE PLAN FOR DETAILS)	IRR	IRRIGATION WATER LINE
+	3 WAY FIRE HYDRANT	UGE	POWER UNDERGROUND BY CONTRACTOR
W.L. TEE	WATER LINE TEE	UGT	TELEPHONE UNDERGROUND (PER CITY STDS)
W.L. GATE VALVE (G.V.)	WATER LINE GATE VALVE	G	GAS LINE
W.L. BENDS	WATER LINE BENDS	U/E	UTILITY EASEMENT
SS	SANITARY SEWER	SS	SANITARY SEWER
W.L.	WATER LINE	W.L.	WATER LINE
DS	DOWNSPOUT	DS	DOWNSPOUT
SWS	STORM SEWER	SWS	STORM SEWER
SWI	STORM SEWER INLET		
SMH	STORM SEWER MANHOLE (SWSMH)		

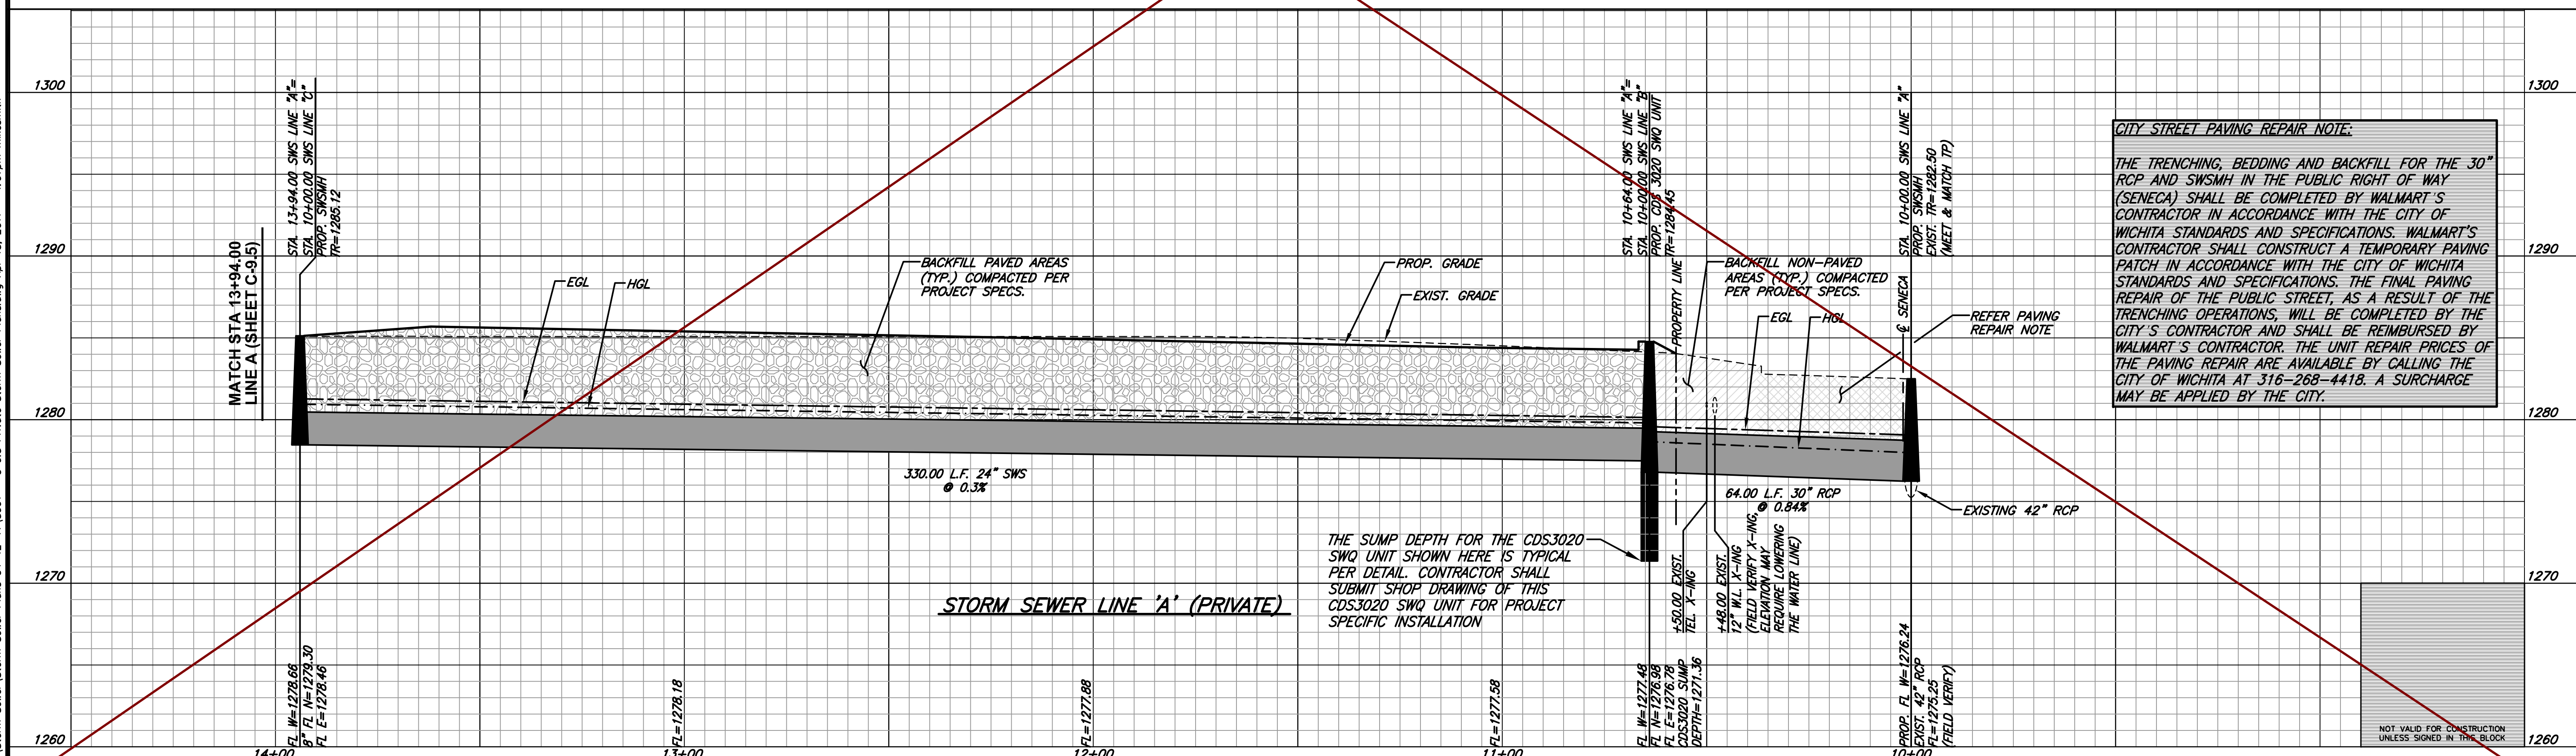

C:\40861\Storm Sewer Plans 04-12-11\40861 - C 9.5 Private Storm Sewer Plans.dwg Apr. 15, 2011 - 4:07pm mikesmith