


SEE REVISED SHEET

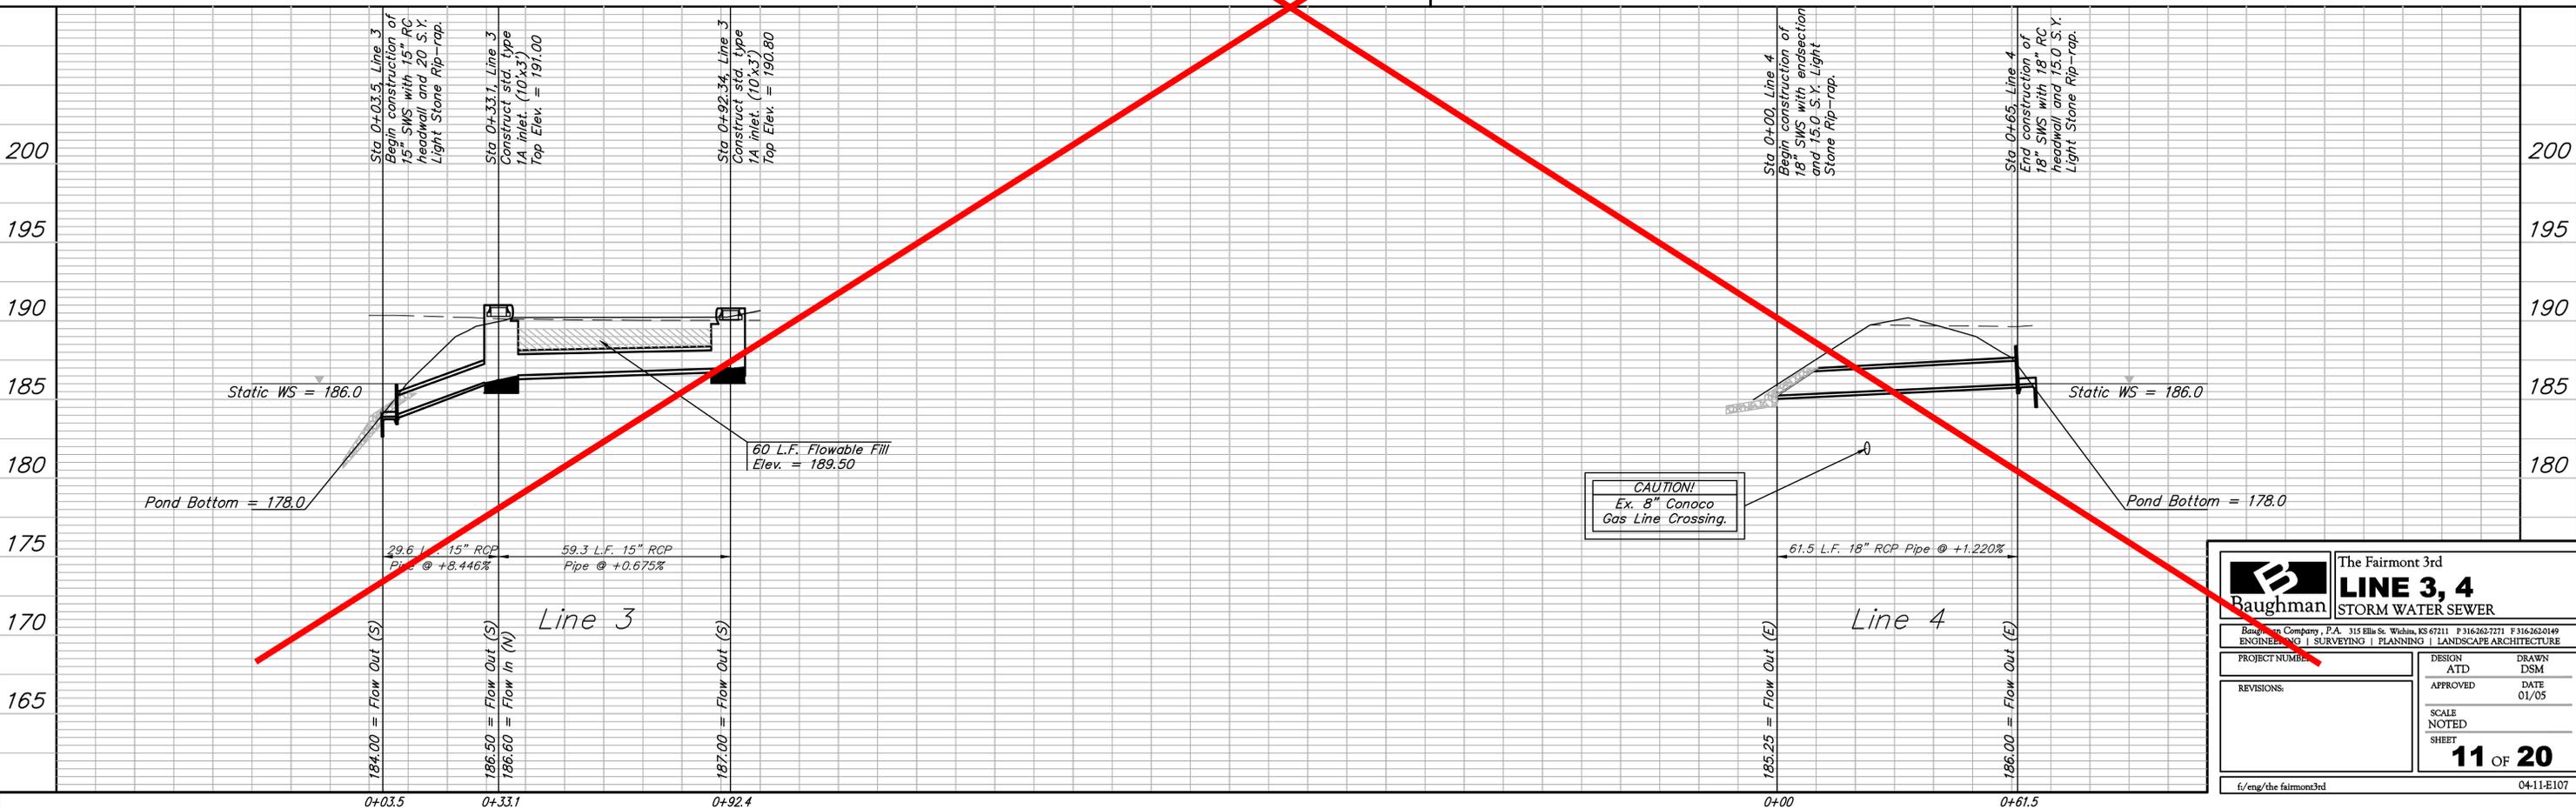

Baughman The Fairmont 3rd
LINE 3, 4
 STORM WATER SEWER

PROJECT NUMBER: _____
 DESIGN: ATT
 APPROVED: _____
 DATE: 01/05

SCALE: NOTED
 SHEET: **11 OF 20**

f:/eng/the fairmont3rd 04-11-E107