

**FIRE HYDRANT #1**  
INSTALL SWING JOINT FIRE HYDRANT  
N 1701047.9605, E 1684799.0290  
1-8"x6" TAPPING SLEEVE & VALVE TO BE  
FURNISHED & INSTALLED BY C.O.W. WATER  
DEPT. CONTRACTOR TO REMBURSE C.O.W.  
\$1,400.  
4.0 L.F. OF 6" DICL SJ PIPE


**FIRE HYDRANT #2**  
INSTALL SWING JOINT FIRE HYDRANT  
N 1701501.6755, E 1684863.2052  
1-8"x6" TAPPING SLEEVE & VALVE TO BE  
FURNISHED & INSTALLED BY C.O.W. WATER DEPT.  
CONTRACTOR TO REMBURSE C.O.W. \$1,400.  
4.0 L.F. OF 6" DICL SJ PIPE

**FIRE HYDRANT #3**  
INSTALL SWING JOINT FIRE HYDRANT  
N 1701491.2376, E 1685175.3094  
1-8"x6" TAPPING SLEEVE & VALVE TO BE  
FURNISHED & INSTALLED BY C.O.W. WATER DEPT.  
CONTRACTOR TO REMBURSE C.O.W. \$1,400.  
4.0 L.F. OF 6" DICL SJ PIPE

**PLAN FIRE HYDRANT 1, 2, & 3**

AS-BUILT PLANS - FEB. 2012

INSPECTED BY: TIM TEACHOUT, MKEC ENGINEERING  
CONSULTANTS, INC  
CONSTRUCTED BY: MIES CONSTRUCTION

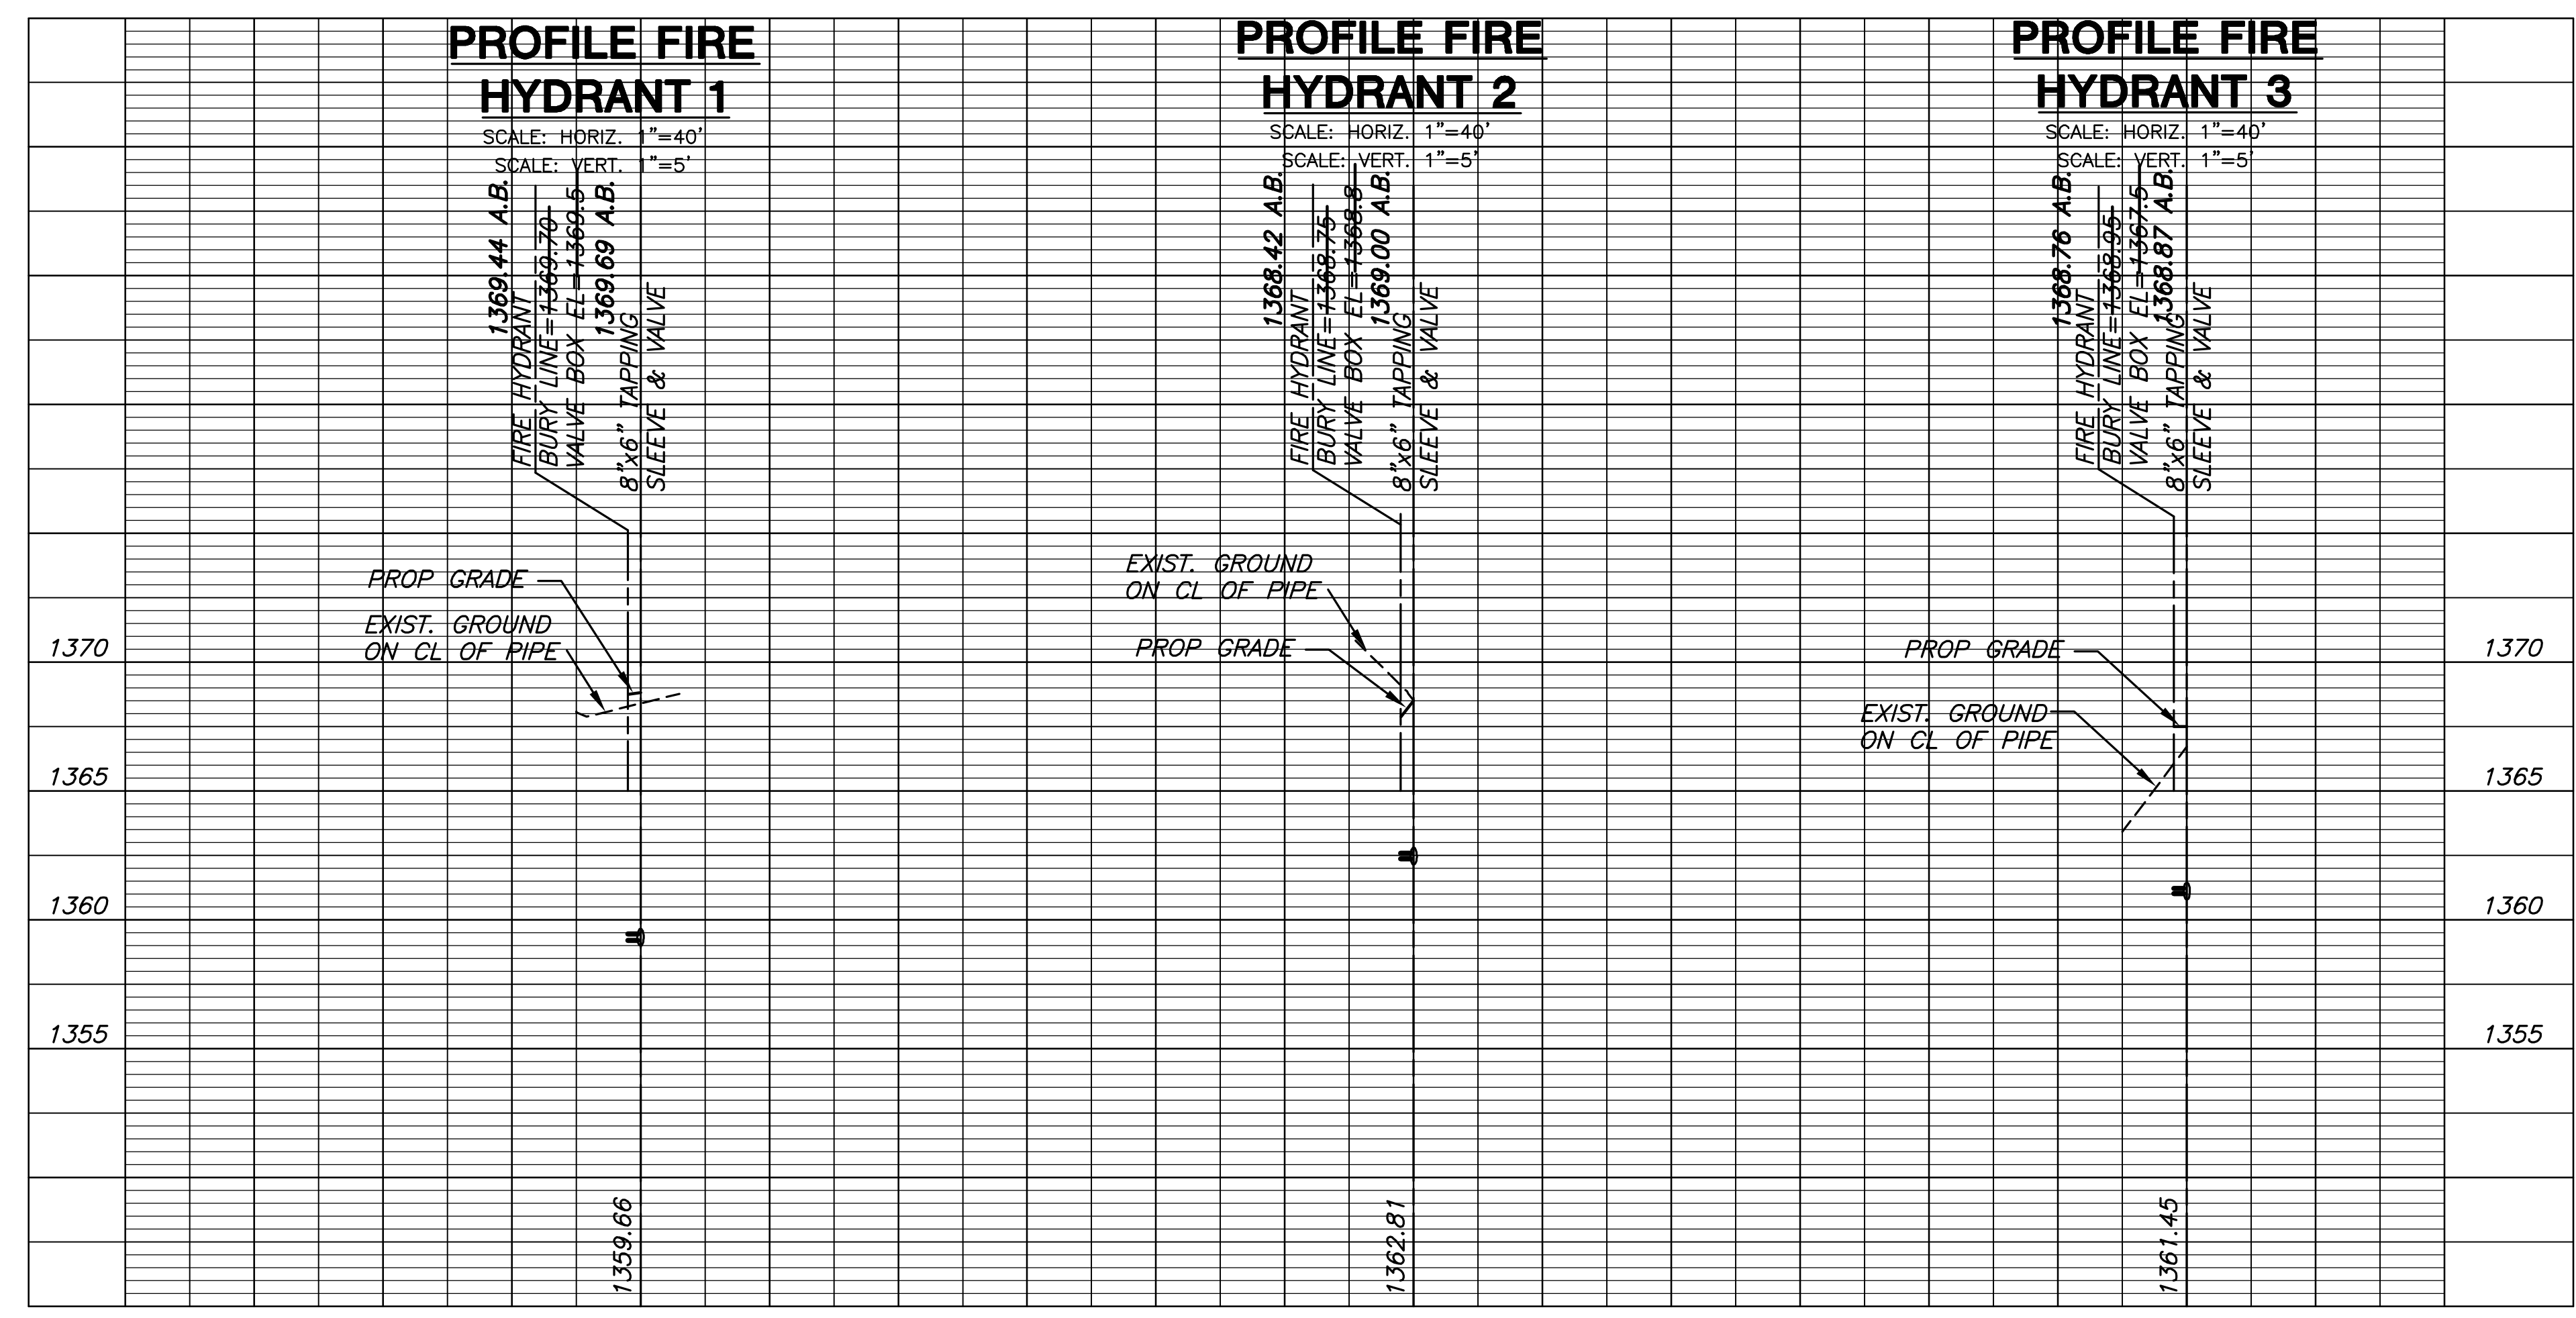

PRIVATE WATER SERVICES  
**CABELA'S, INC.**  
REGENCY LAKES COMMERCIAL 2ND ADDITION

**PRIVATE WATER**  
SHEET TITLE  
1595PPW (607853)  
PROJECT NUMBER

MAB / DM / GJA  
DESIGNED DRAWN CHECKED

ISSUED  
June 2011  
REVISED  
AS-BUILTS 02/2012

SHEET NO.  
**3 of 4**