
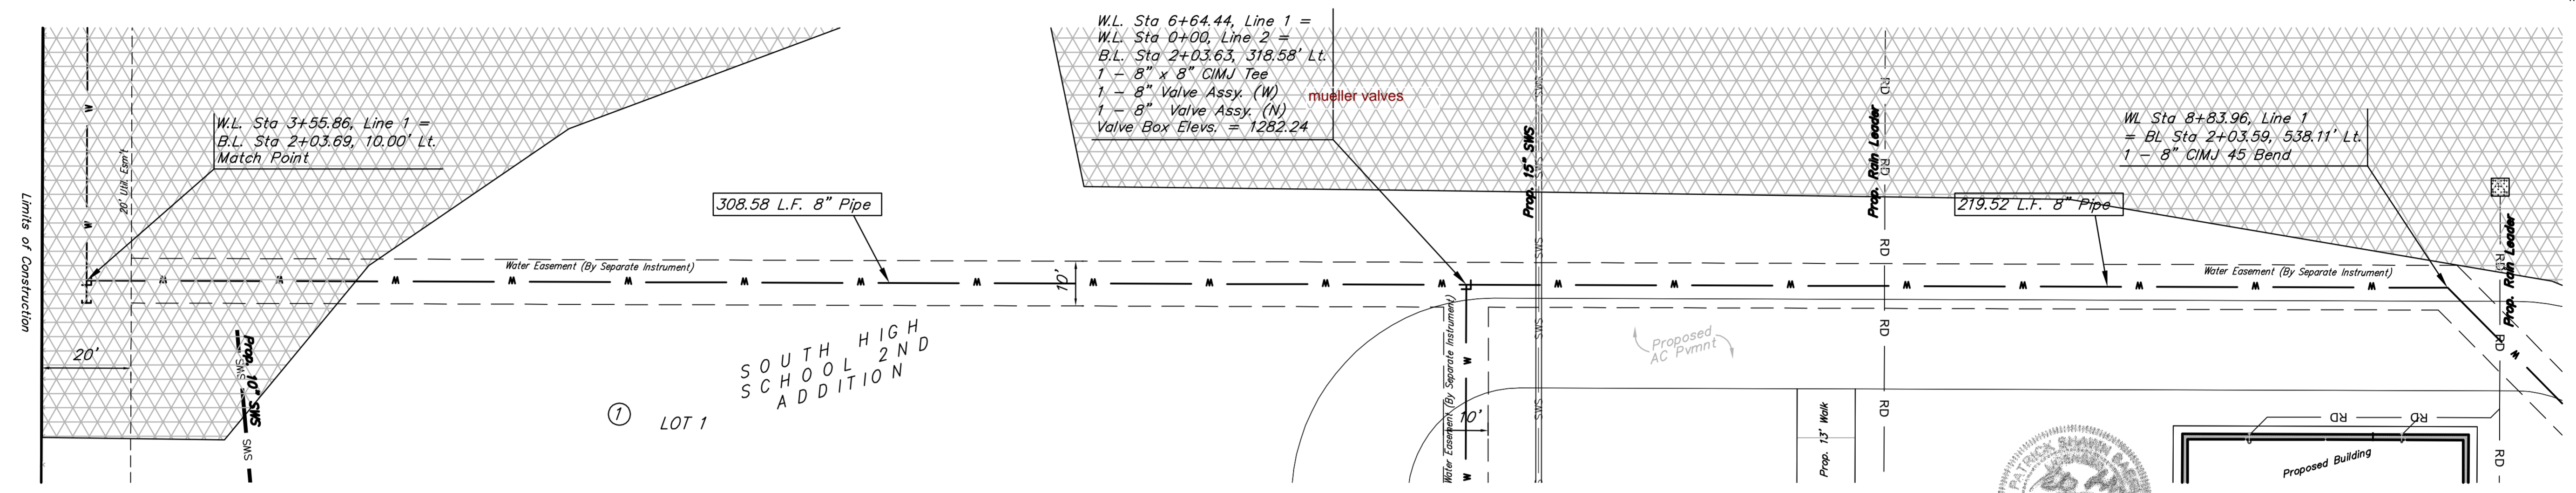



**Benchmarks**

Benchmark #1 - "□" Chiseled on Top of Concrete  
ELEV. = 1285.93 (NAVD 88)

Benchmark #2 - "□" Chiseled on Top of Concrete  
ELEV. = 1284.29 (NAVD 88)

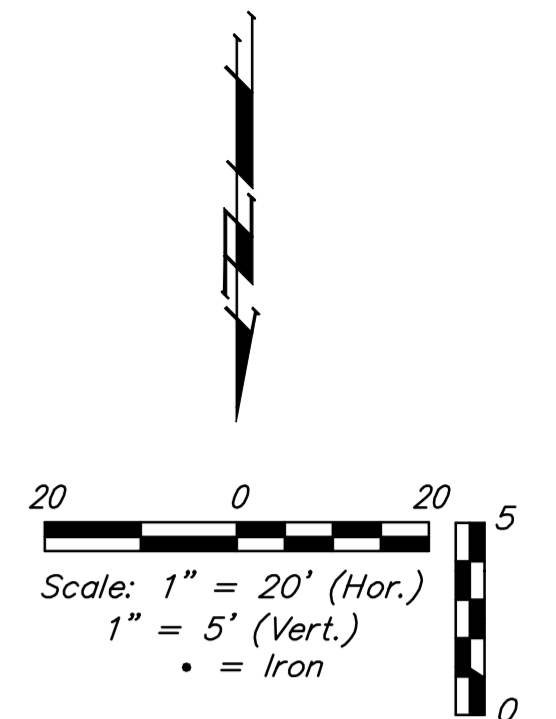

Baseline = Southeast Corner of Lot 1 Block 1 South High School 2nd Addition

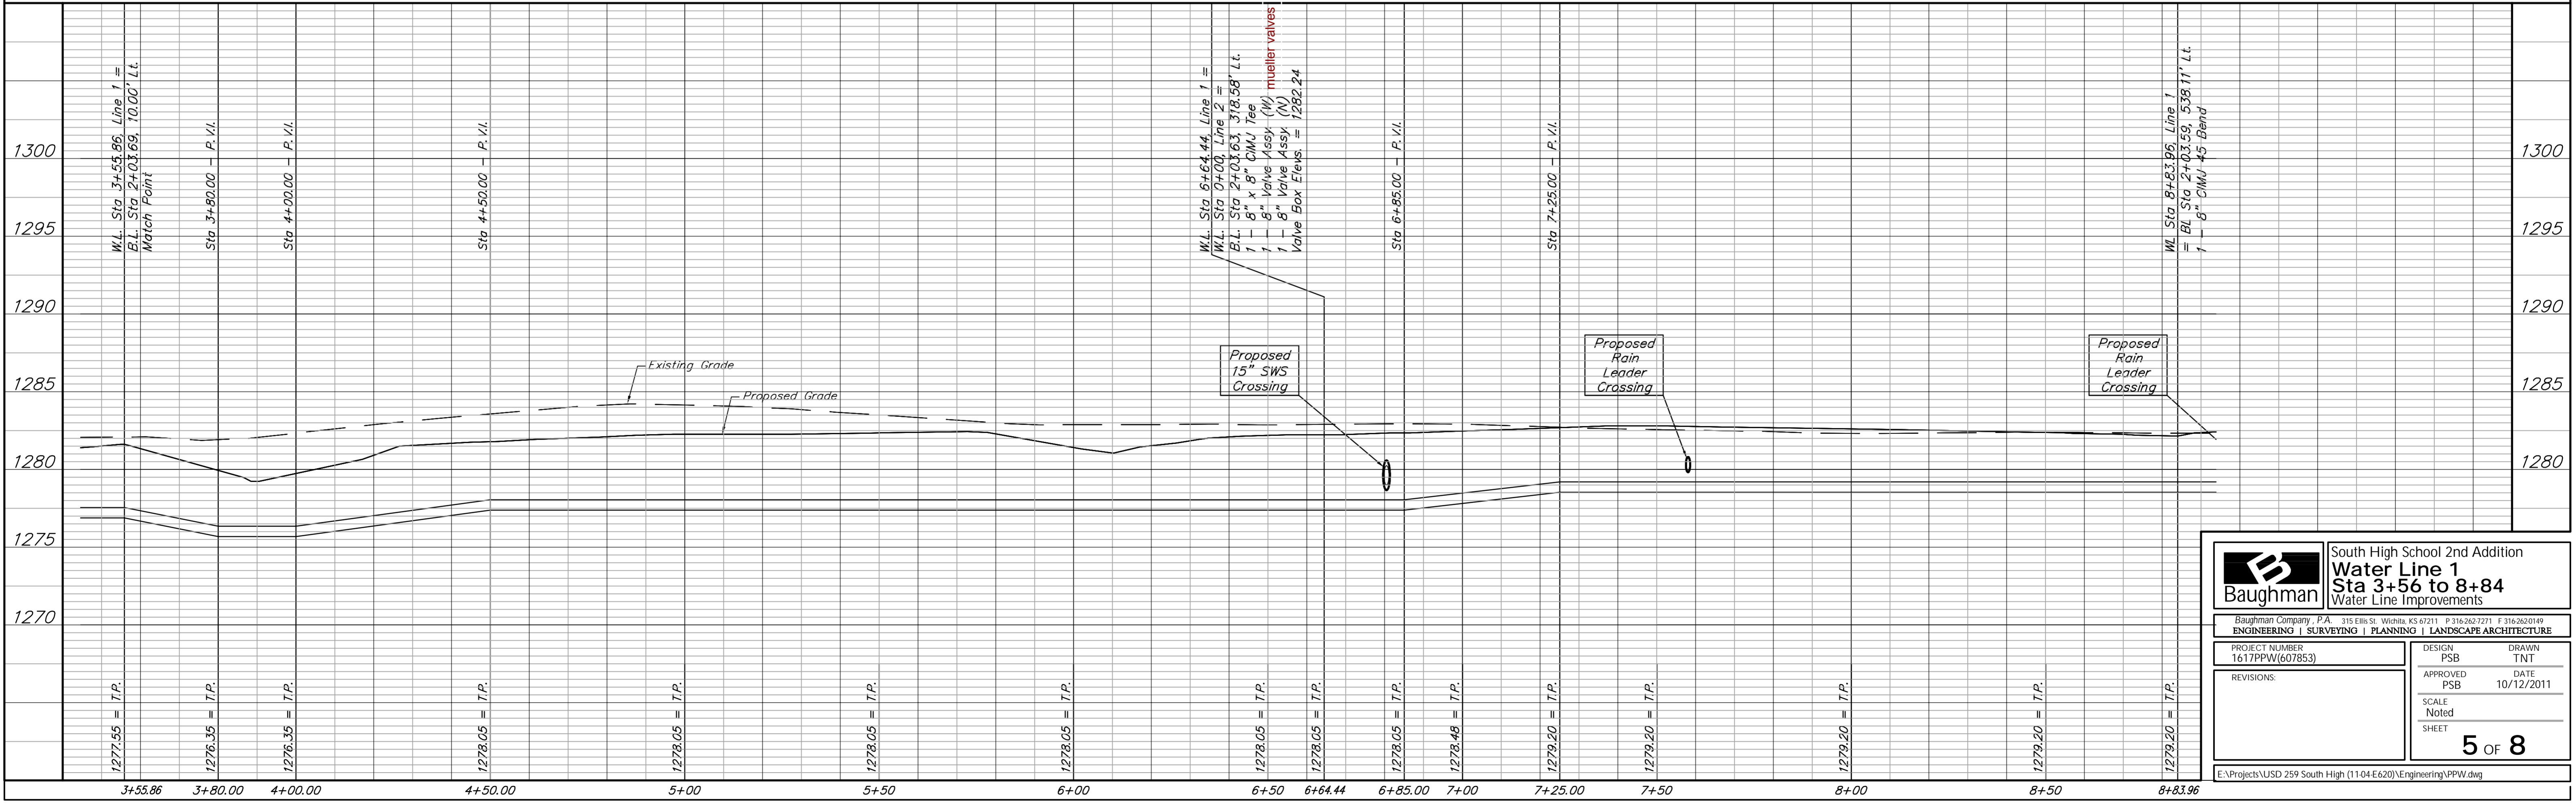

<b>Baughman</b>		South High School 2nd Addition <b>Water Line 1</b> Sta 3+56 to 8+84 Water Line Improvements	
Baughman Company, P.A. 315 Ellis St. Wichita, KS 67211 P 316.263.7271 F 316.262.0149 ENGINEERING   SURVEYING   PLANNING   LANDSCAPE ARCHITECTURE			
PROJECT NUMBER 1617PPW(607853)	DESIGN PSB	DRAWN TNT	DATE 10/12/2011
APPROVED PSB	SCALE Noted	SHEET <b>5 OF 8</b>	
E:\Projects\USD 259 South High (1104 E620)\Engineering\PPW.dwg			