

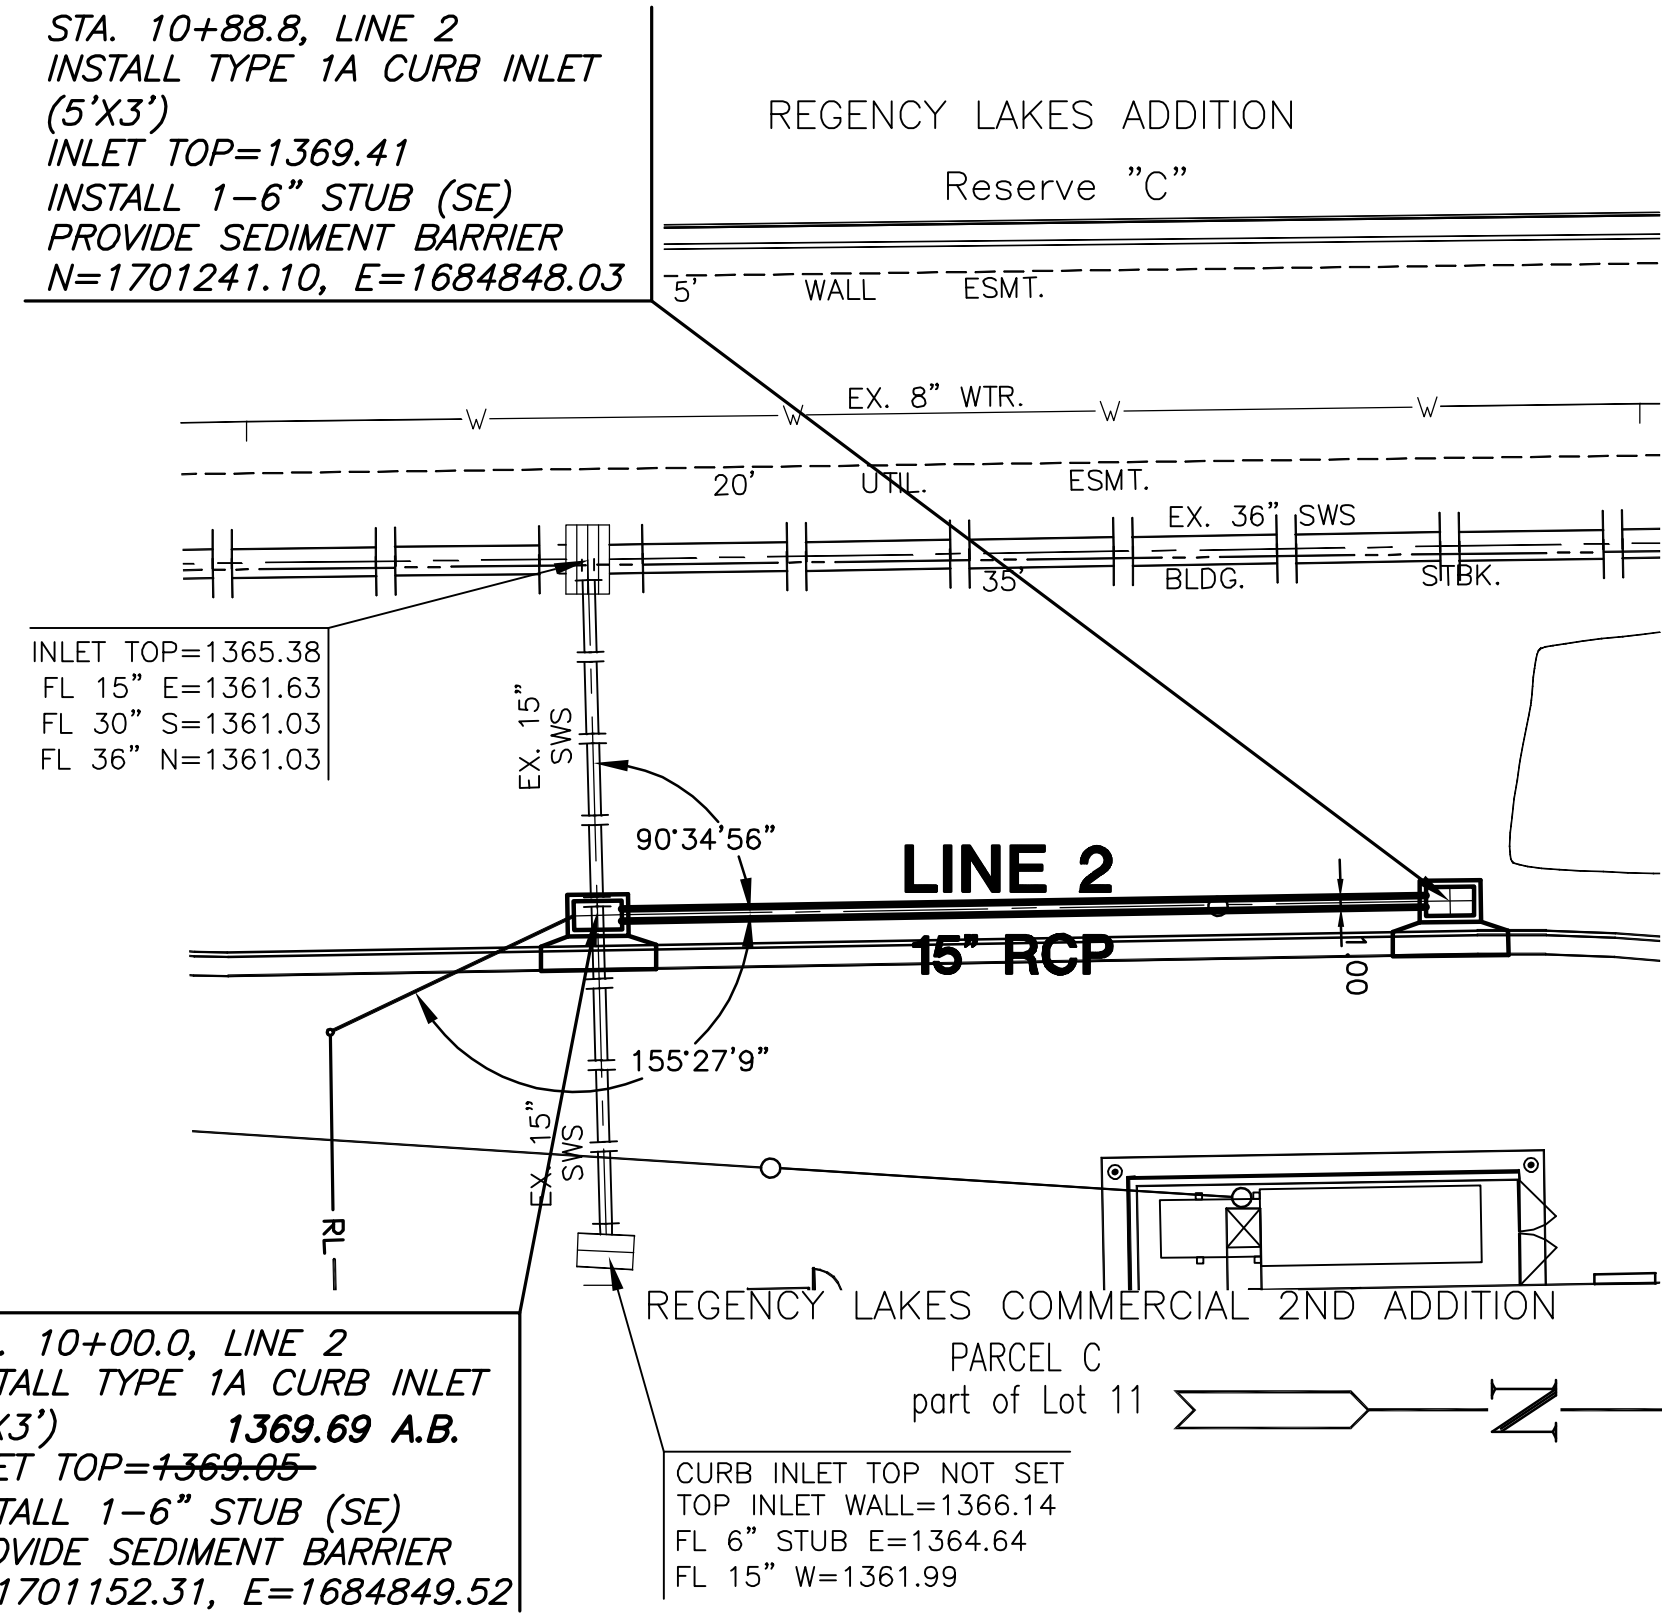


AS-BUILT PLANS - FEB. 2012



INSPECTED BY: TIM TEACHOUT, MKEC ENGINEERING
CONSULTANTS, INC.
CONSTRUCTED BY: MIES CONSTRUCTION

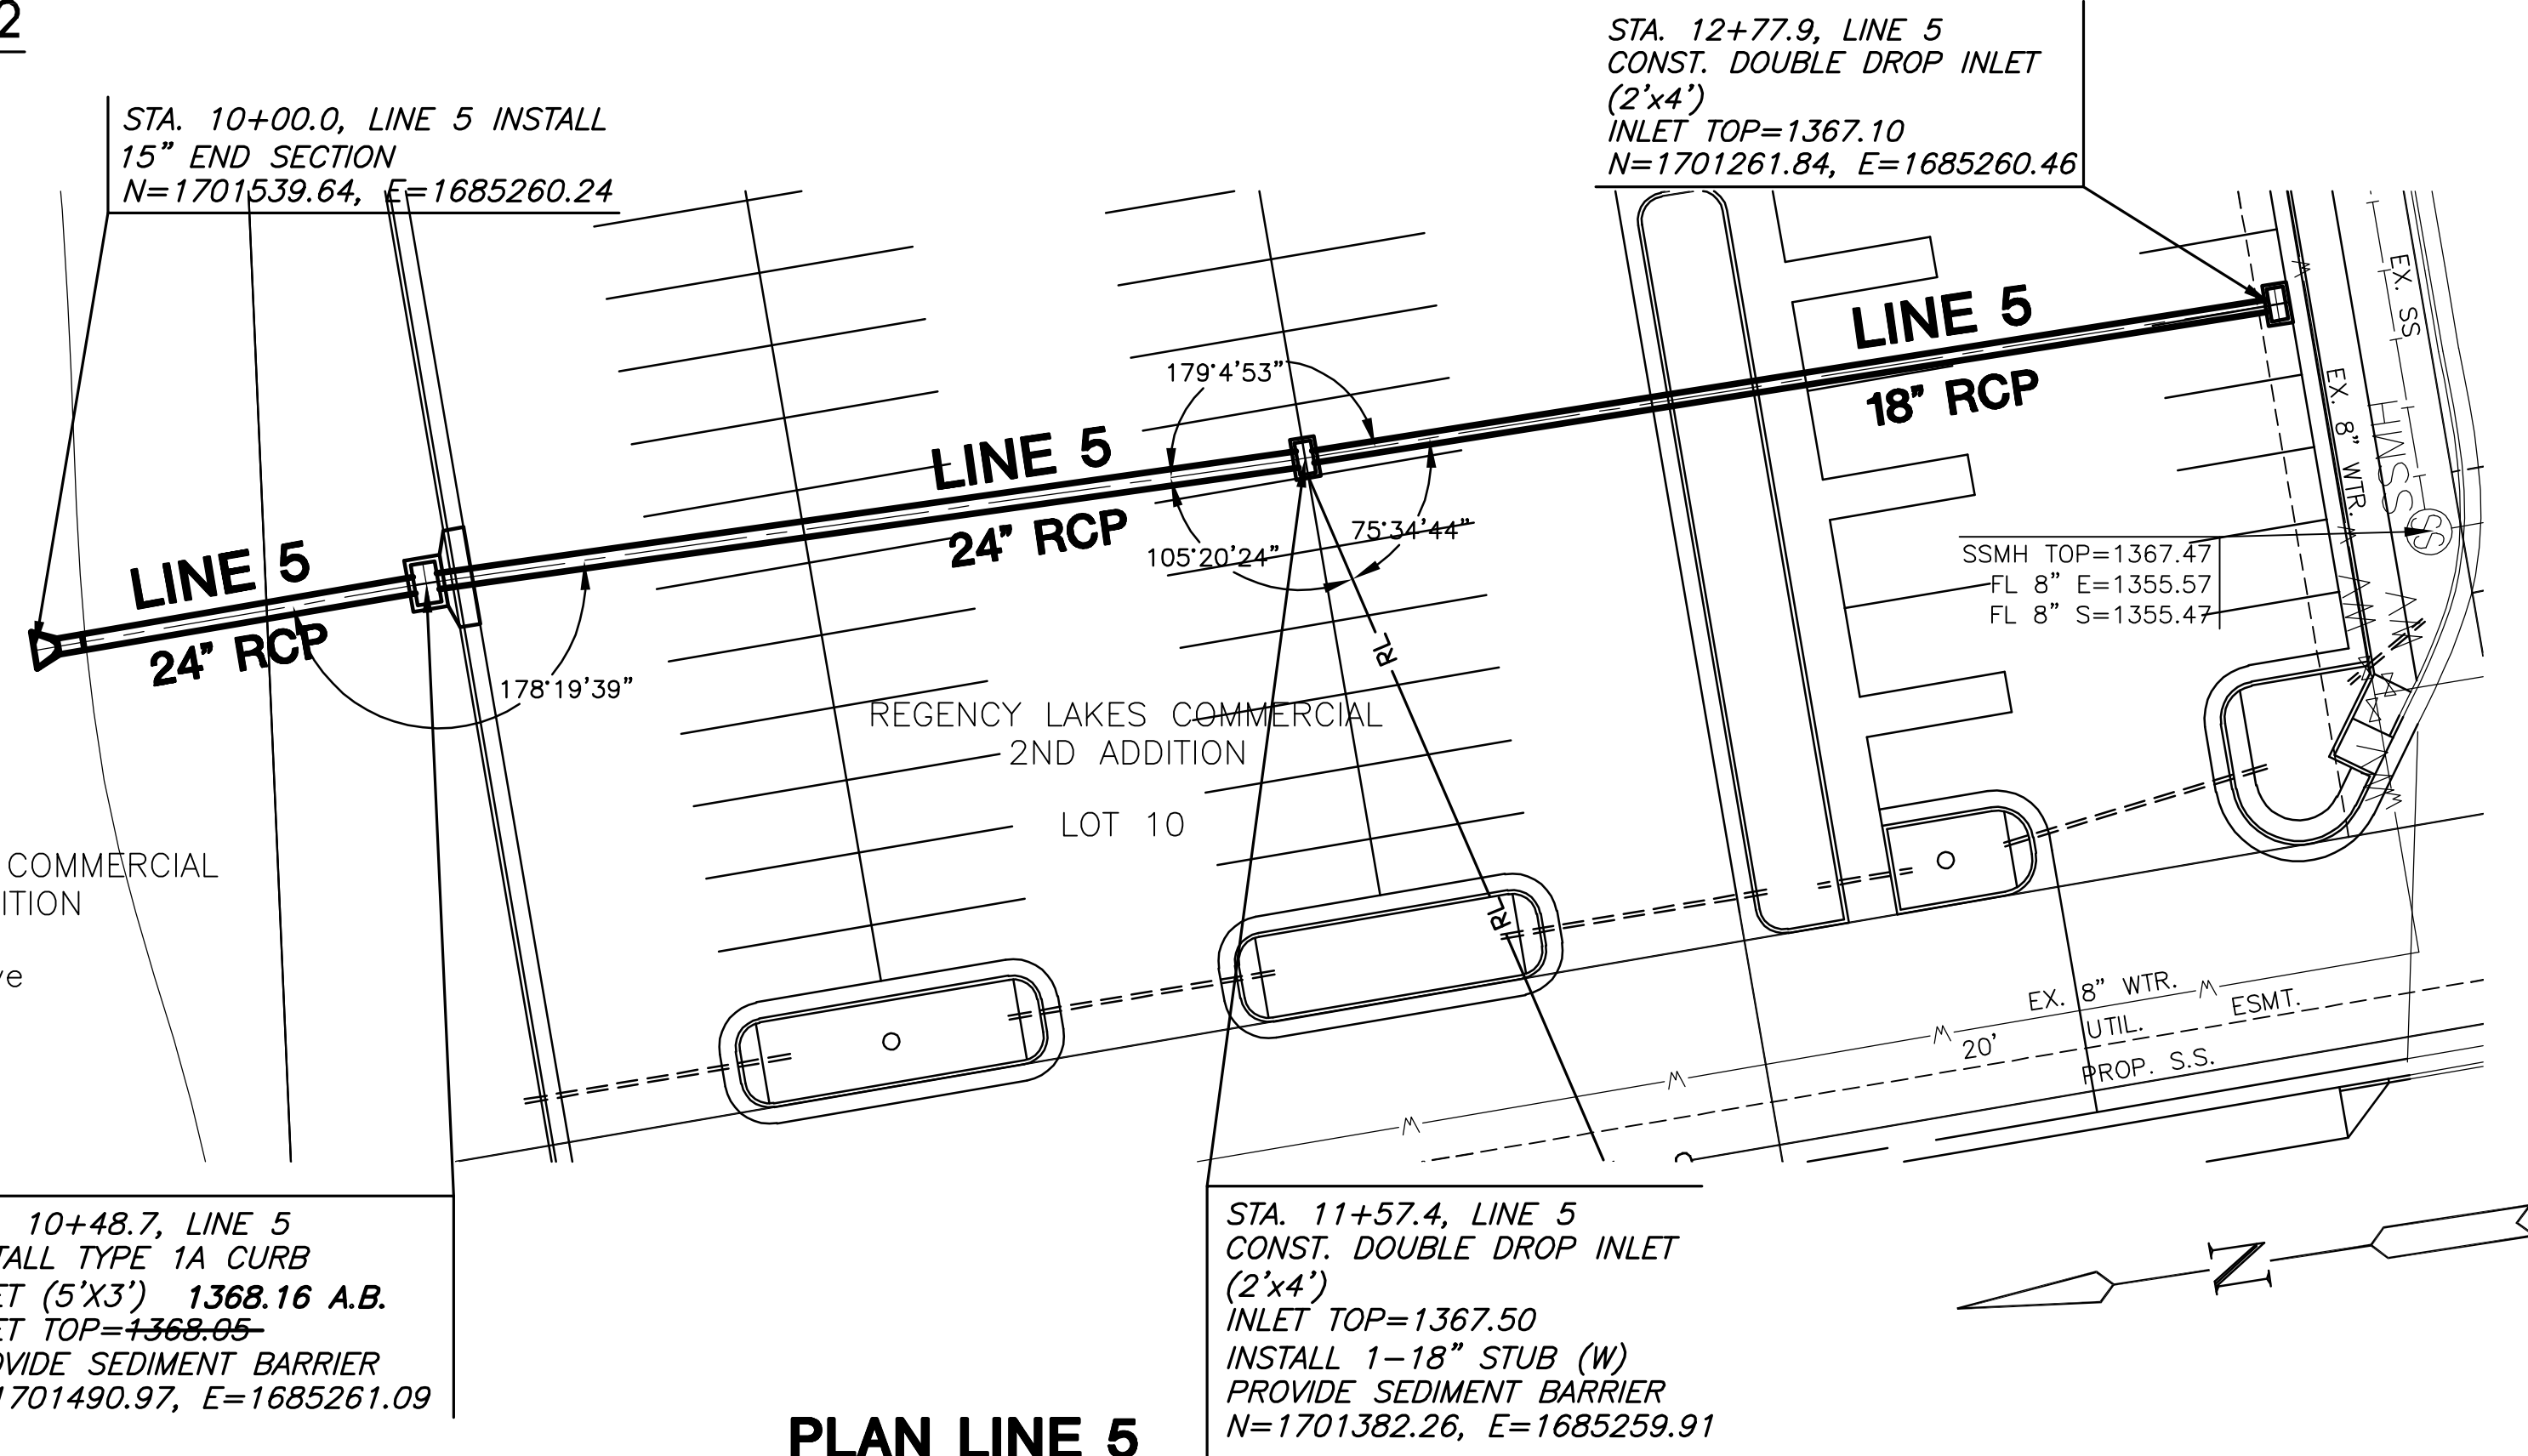

PLAN LINE 2

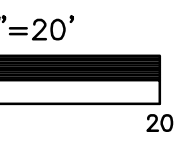

PLAN LINE 5

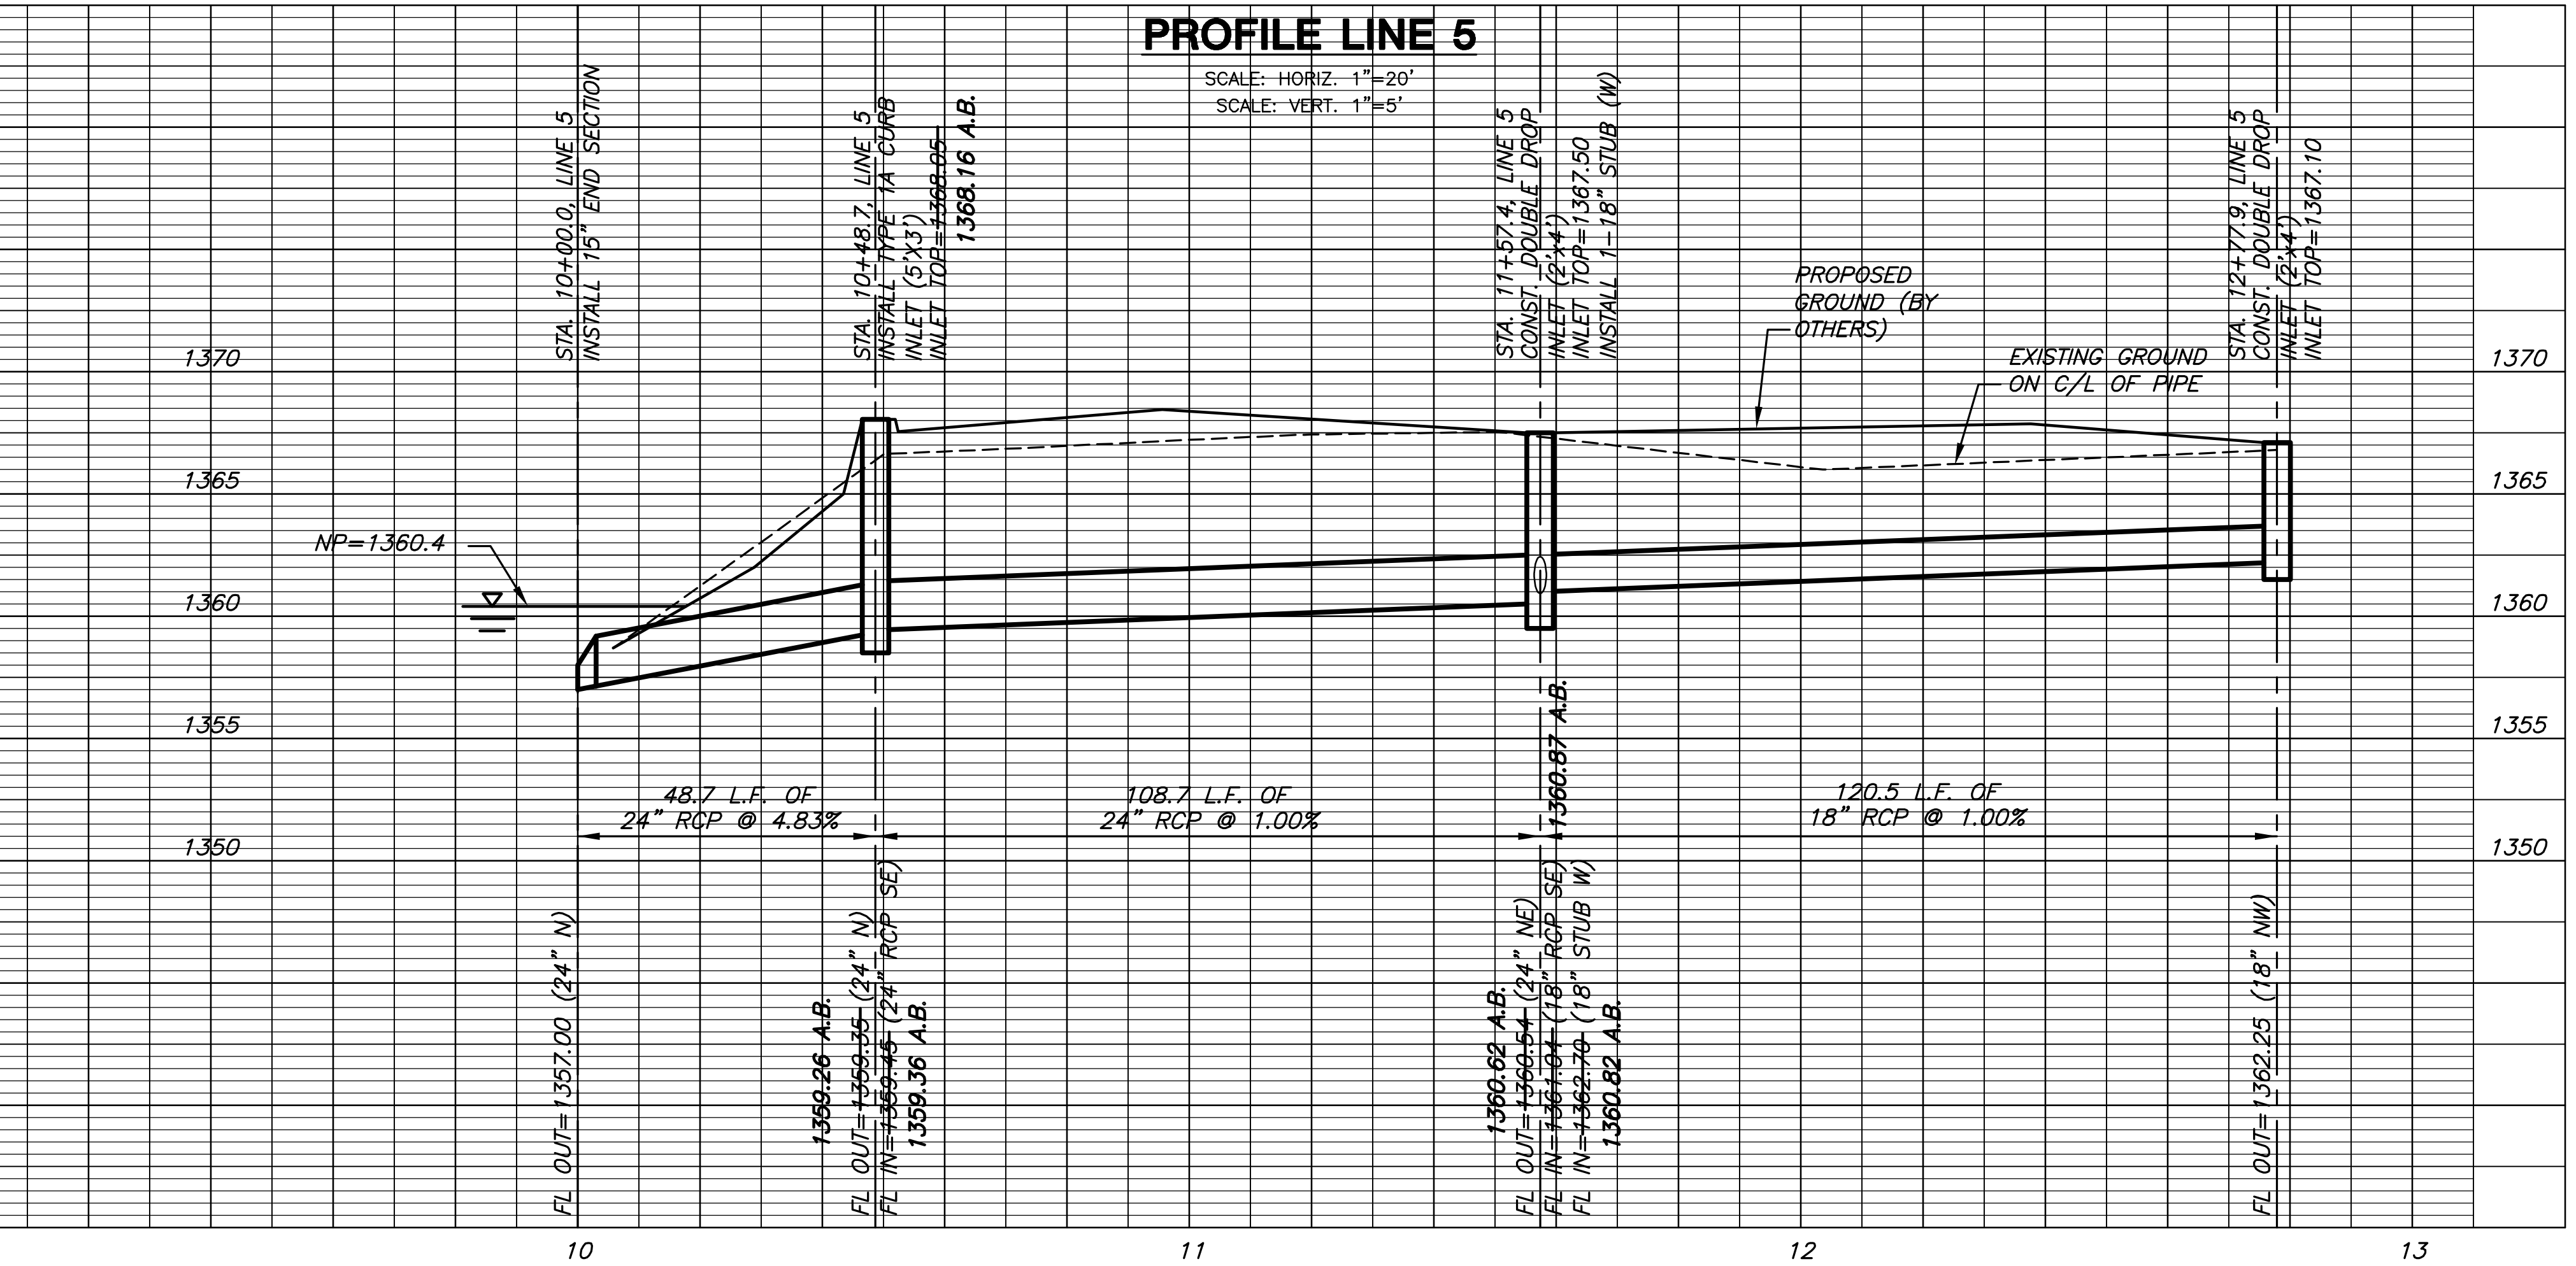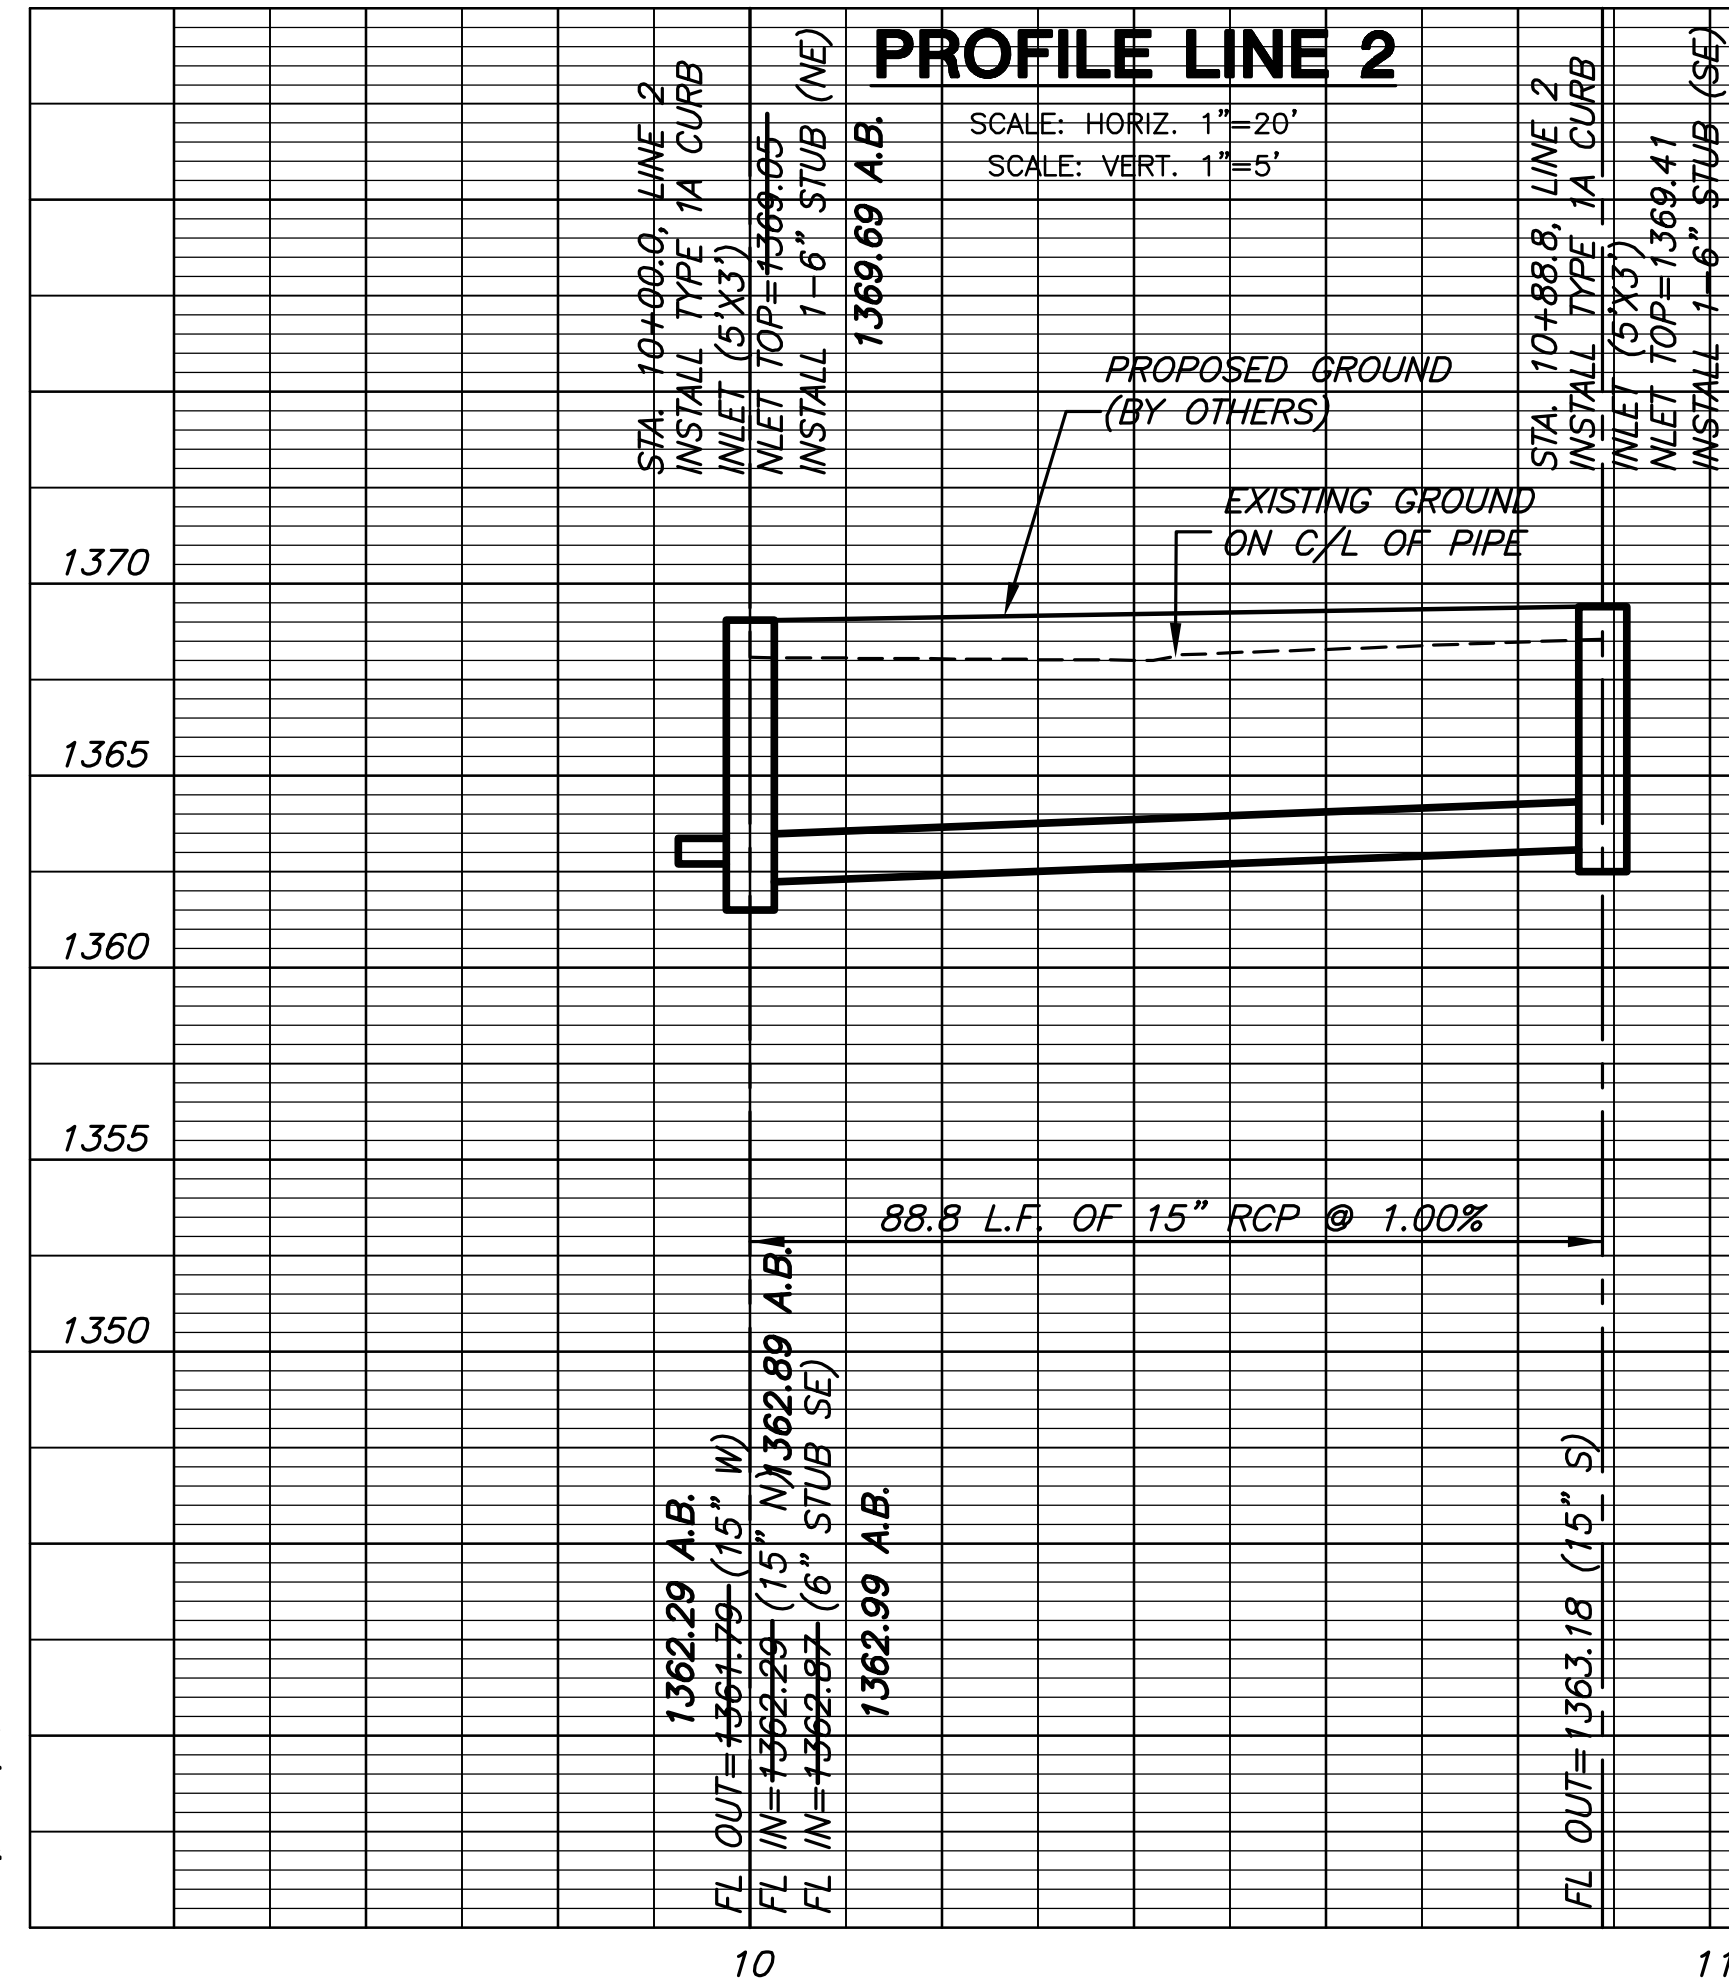

STORM WATER SEWER
CABELA'S INC.
REGENCY LAKES COMMERCIAL 2ND ADDITION

LINES 2 & 5
SHEET TITLE
0030PPD (607861)
PROJECT NUMBER

SPE / DM / MAB
DESIGNED DRAWN CHECKED

ISSUED
May 2011
REVISED
AS-BUILTS 02/2012

SHEET NO.
3 of 4

PLOT DATE: Tuesday, February 14, 2012 @ 02:13PM

J:\DWG\10617-CABELA'S\PRIVATE\PROJECT\10617_D3.DWG