

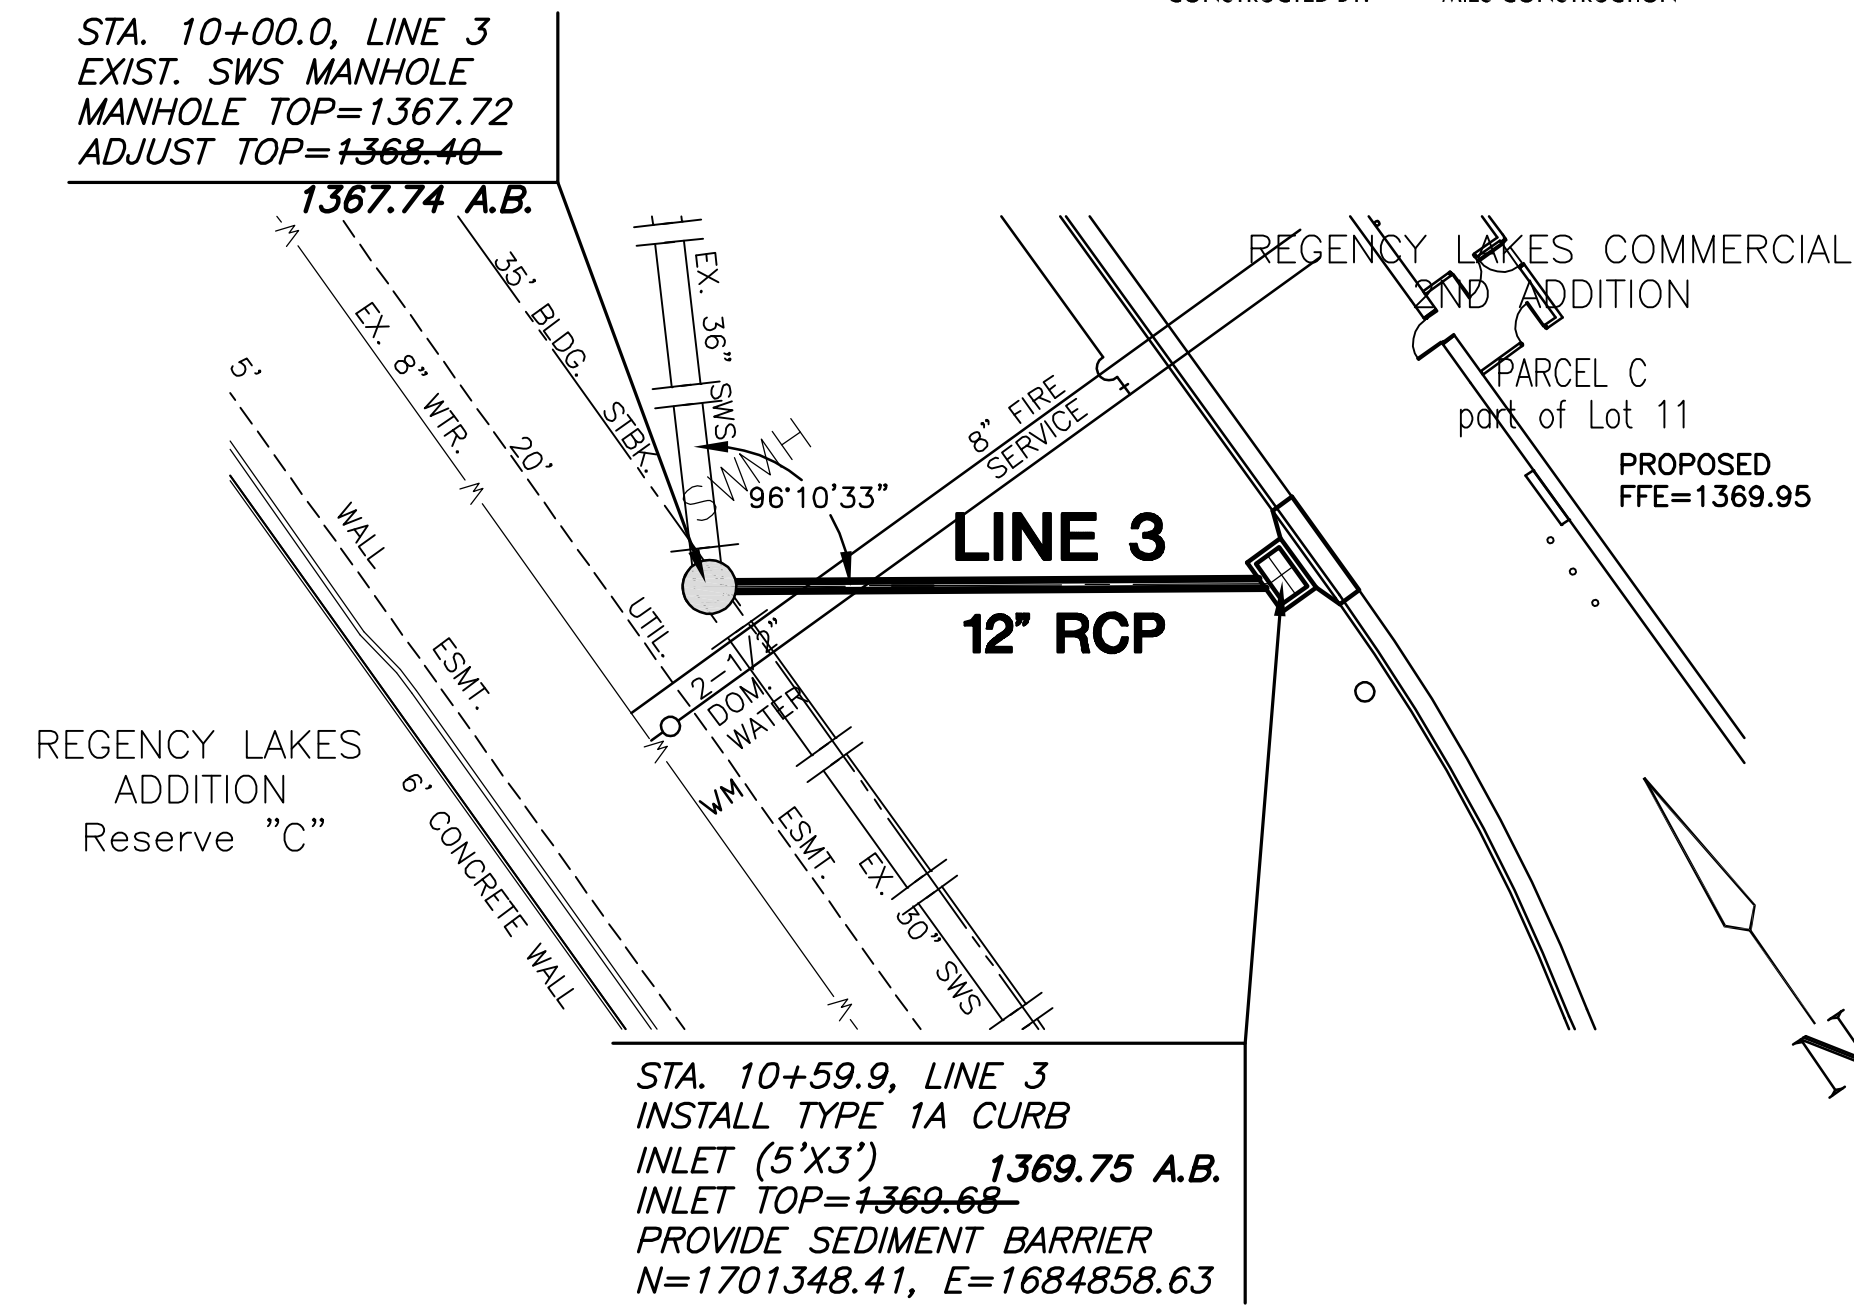


AS-BUILT PLANS - FEB. 2012

INSPECTED BY: TIM TEACHOUT, MKEC ENGINEERING CONSULTANTS, INC.
 CONSTRUCTED BY: MIES CONSTRUCTION

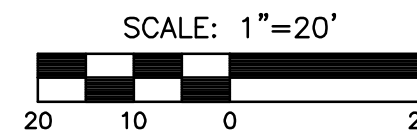


PLAN LINE 3

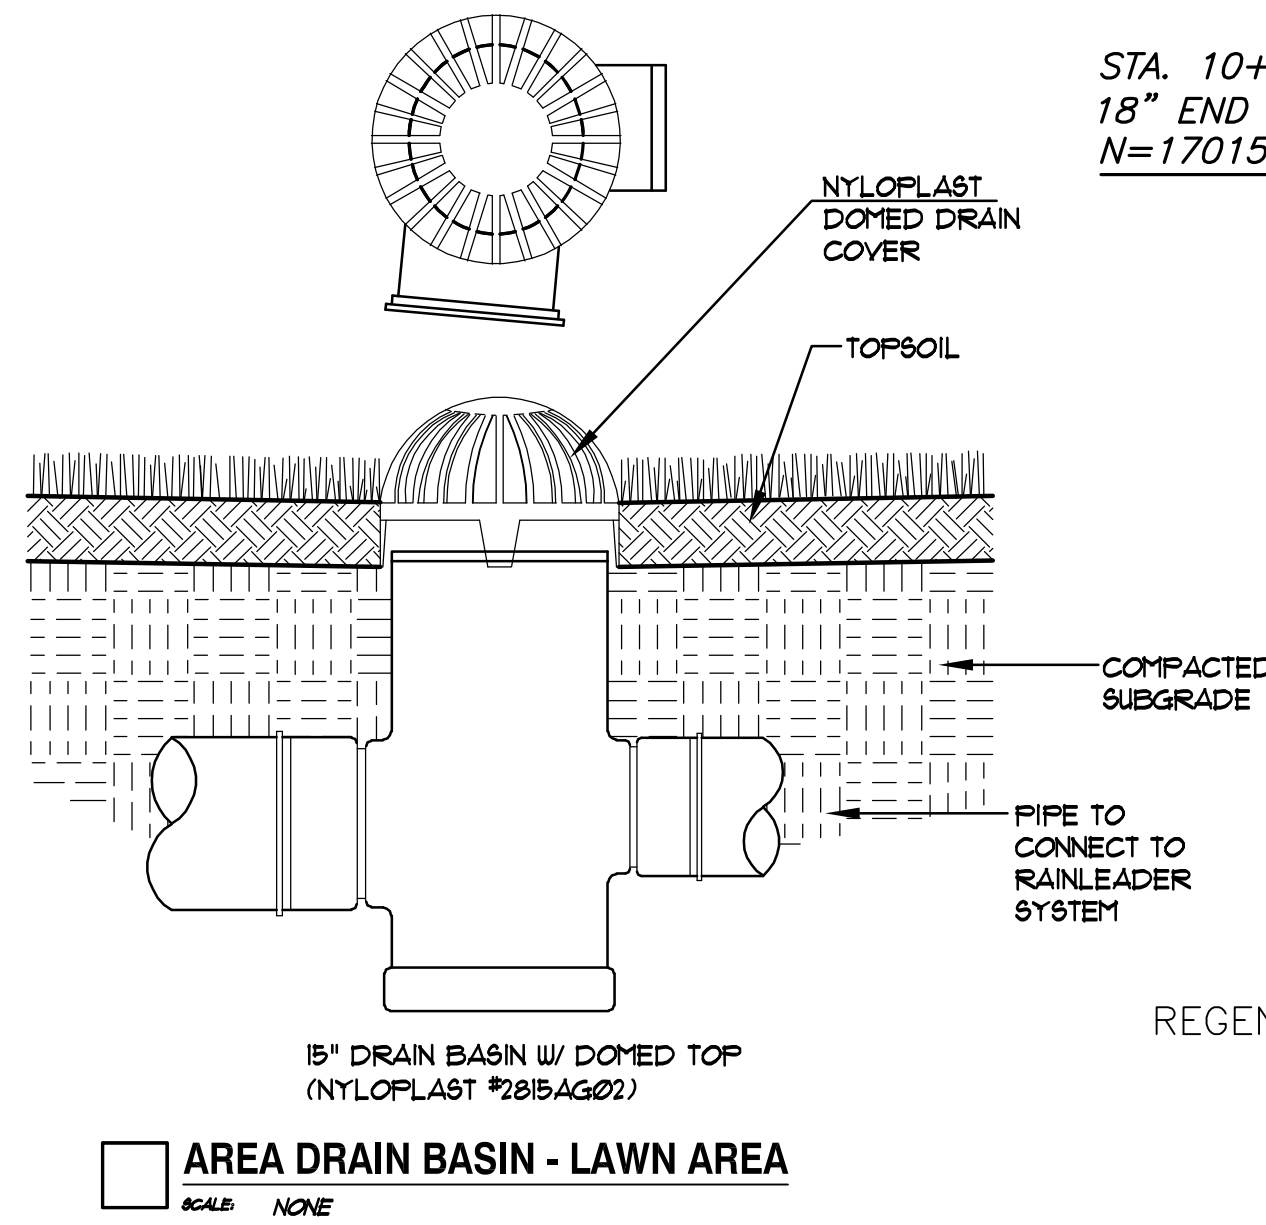


STA. 10+00.0, LINE 4 INSTALL 18" END SECTION
 N=1701565.77, E=1685078.40

STA. 11+43.0, LINE 4
 CONST. 15" NYLOPLAST CUSTOM DRAIN BASIN PART #2815AG02 W/15" DOMED GRATE PART #1599 CGD OR APPROVED EQUAL. SEE DETAIL THIS SHEET.
 INLET TOP=1369.00
 INSTALL 1-10" STUB (W)
 N=1701425.95, E=1685051.41

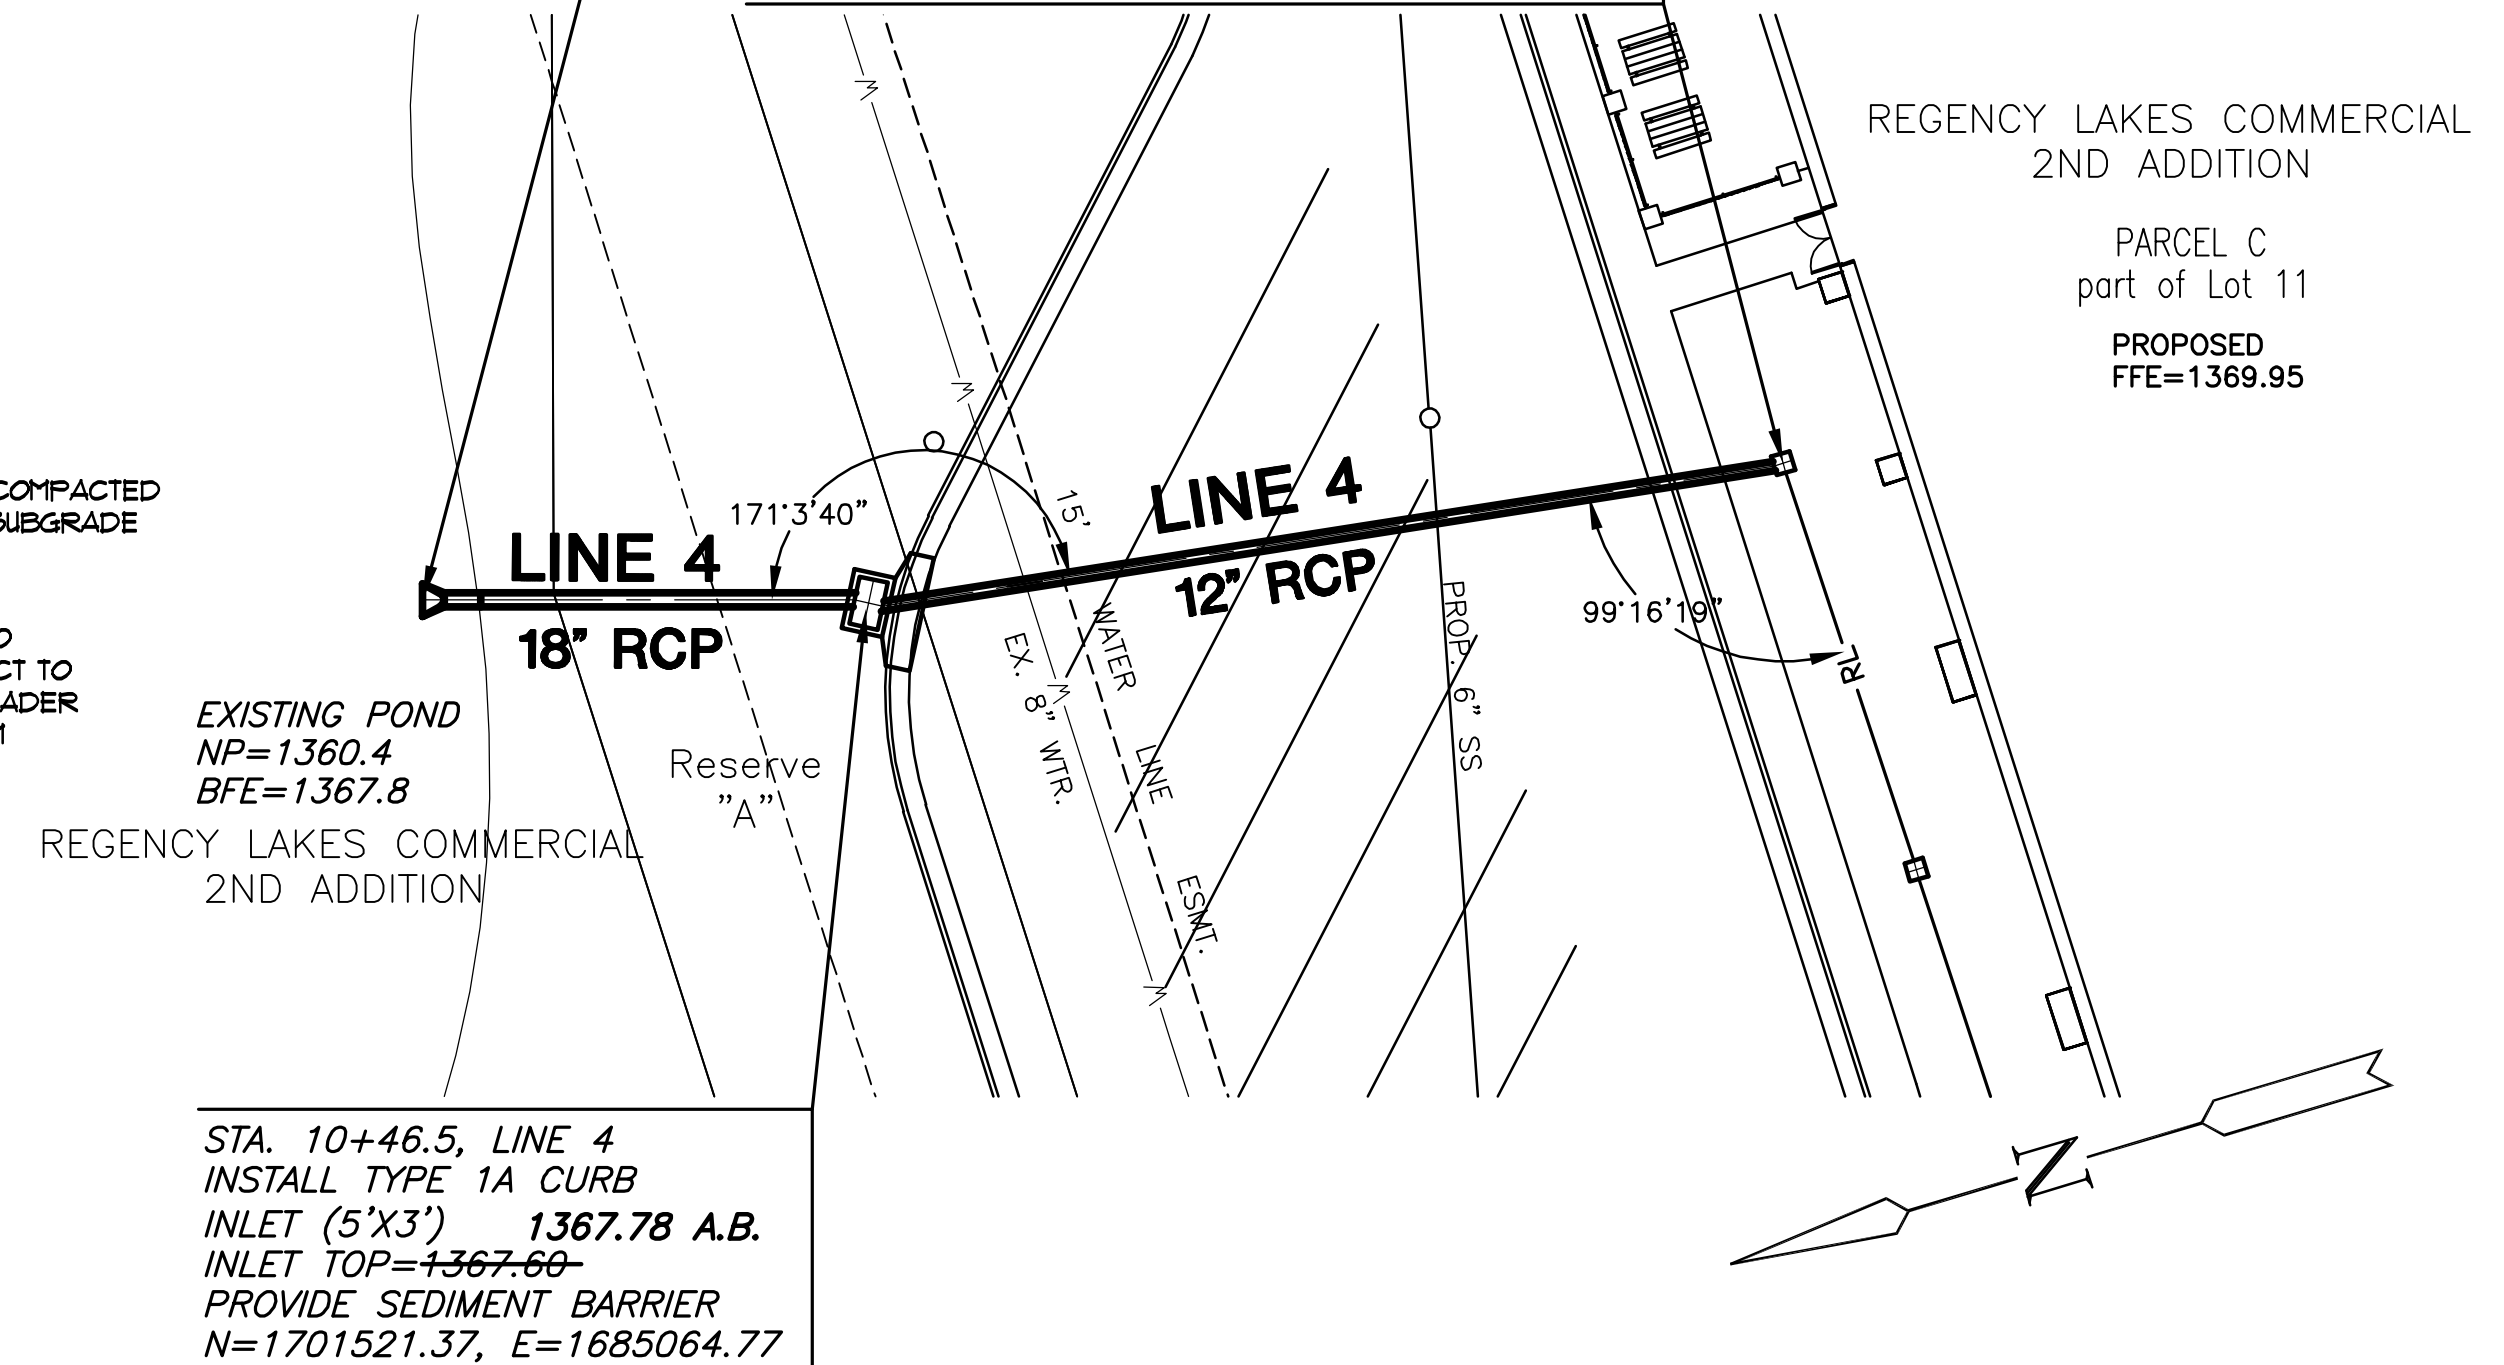


PLAN LINE 4

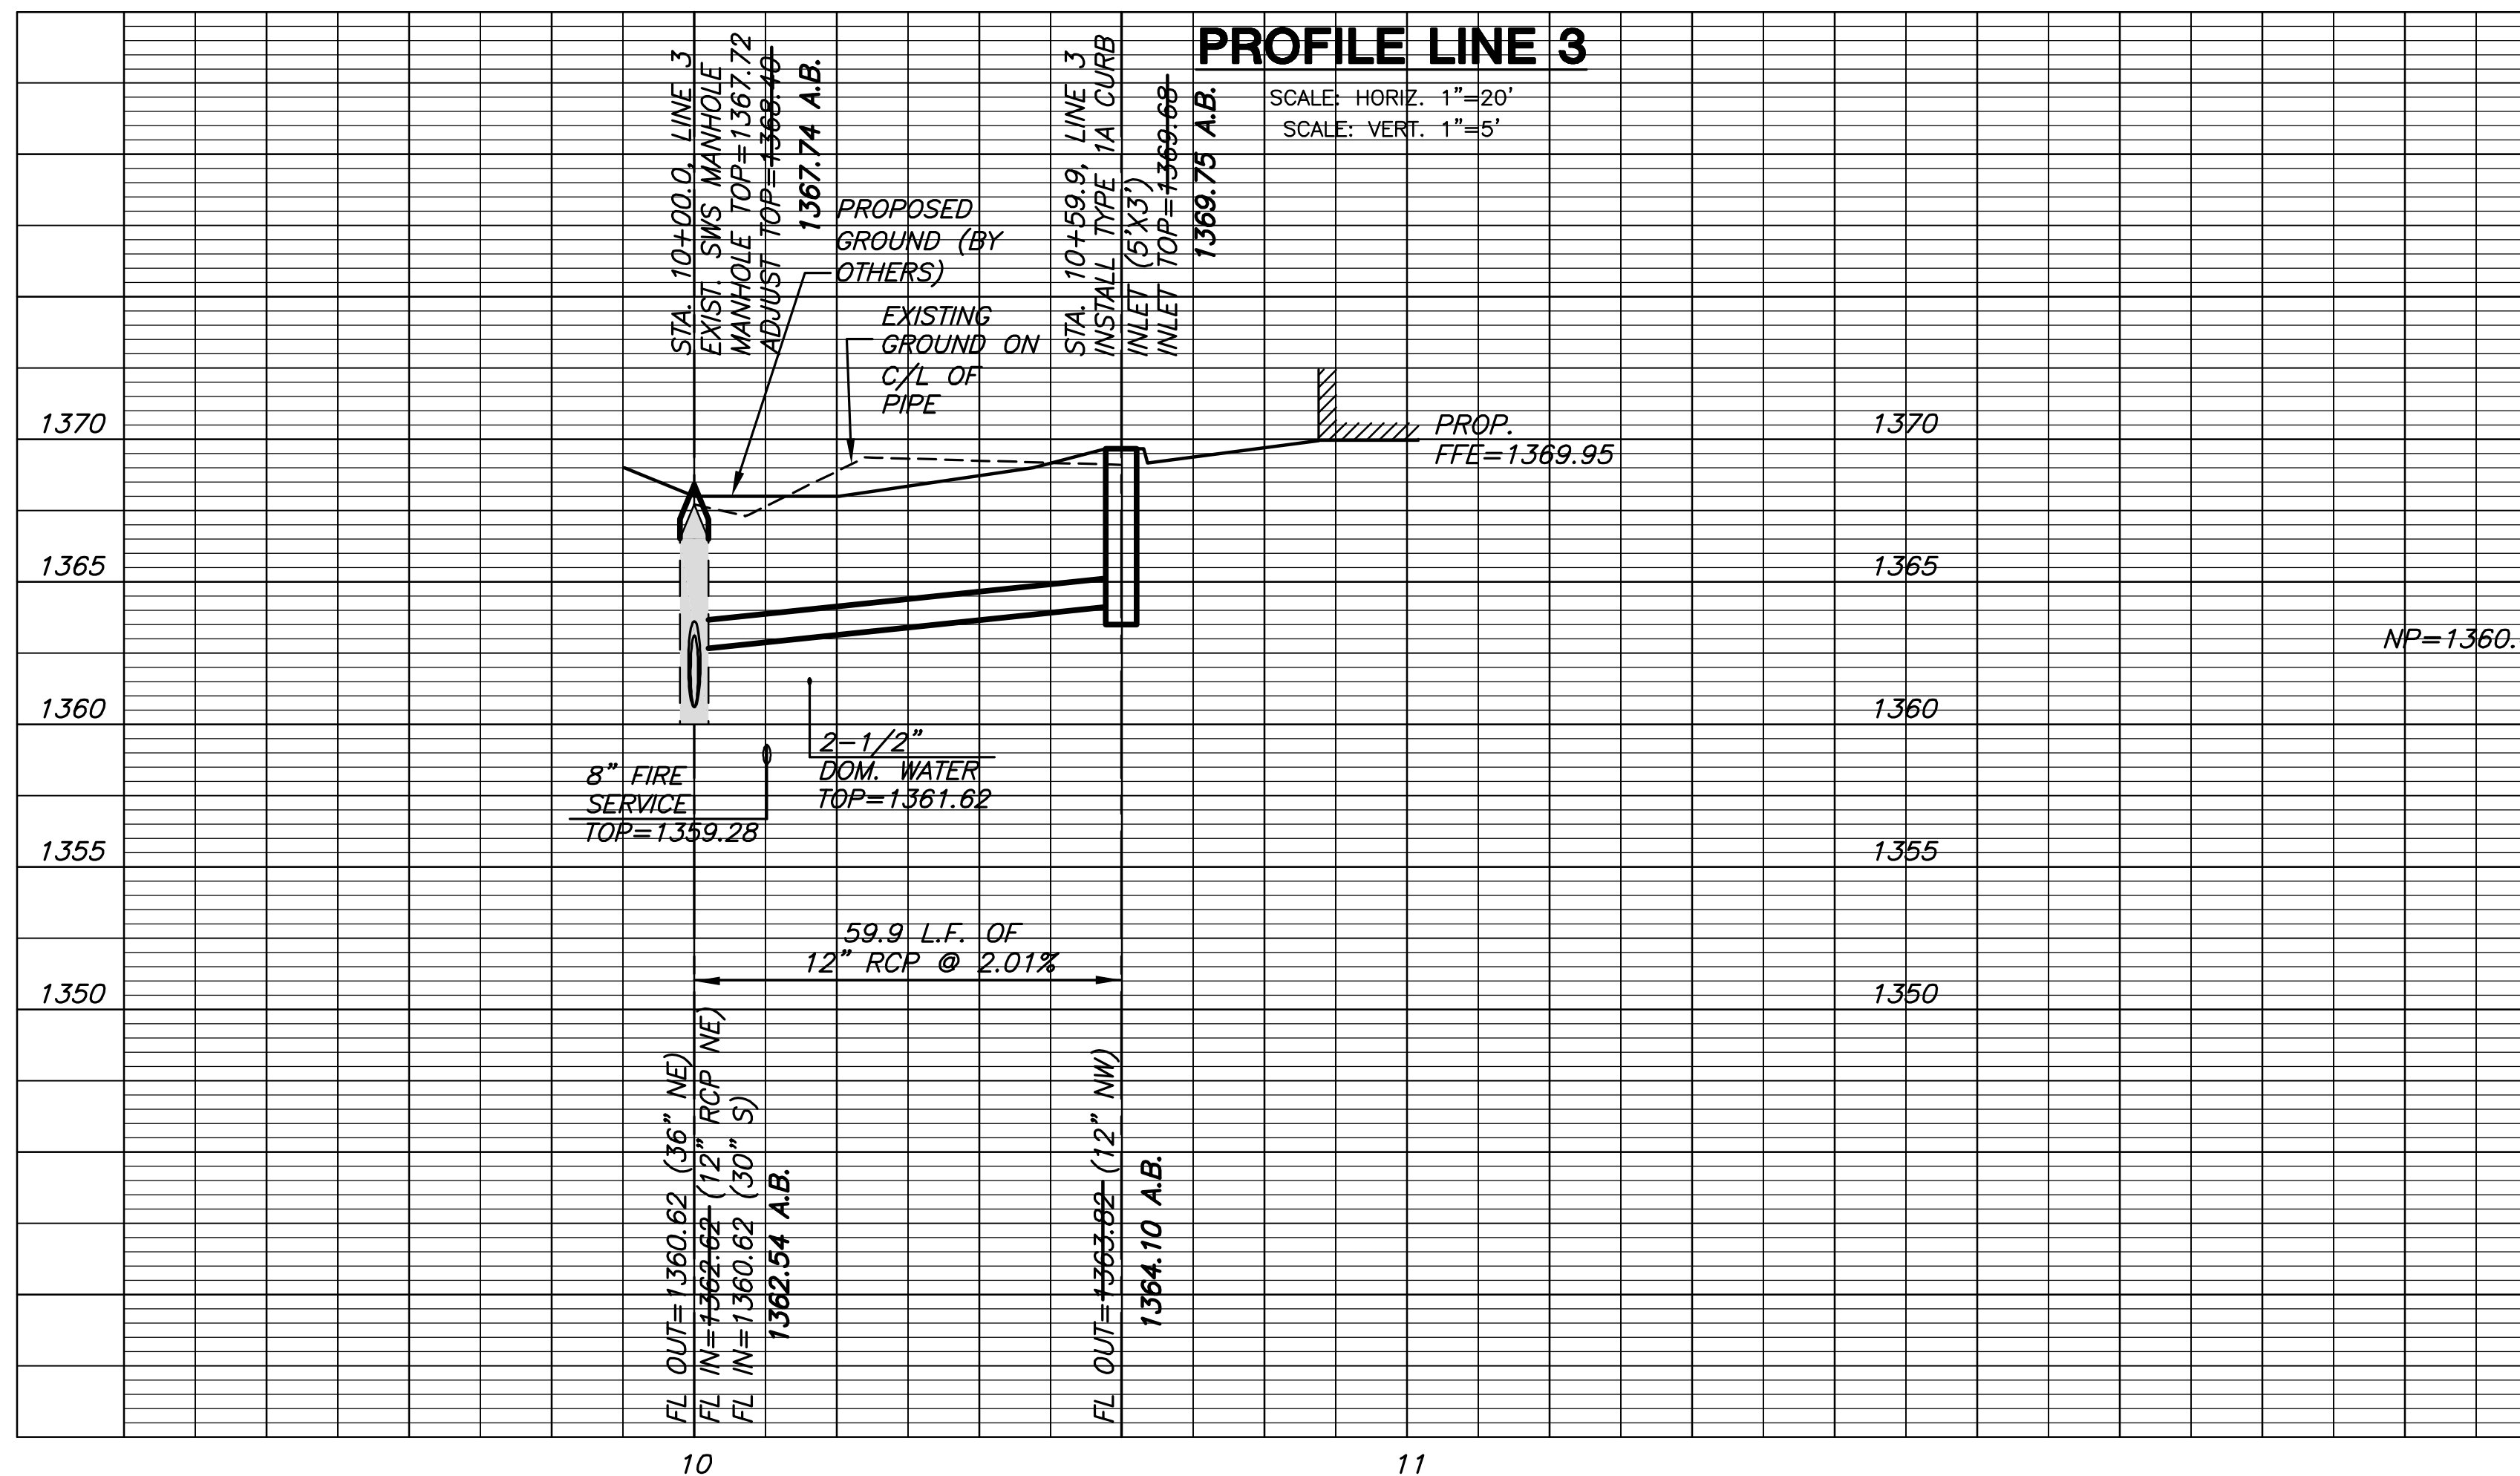

PROFILE LINE 3

SCALE: HORIZ. 1"=20'
 SCALE: VERT. 1"=5'

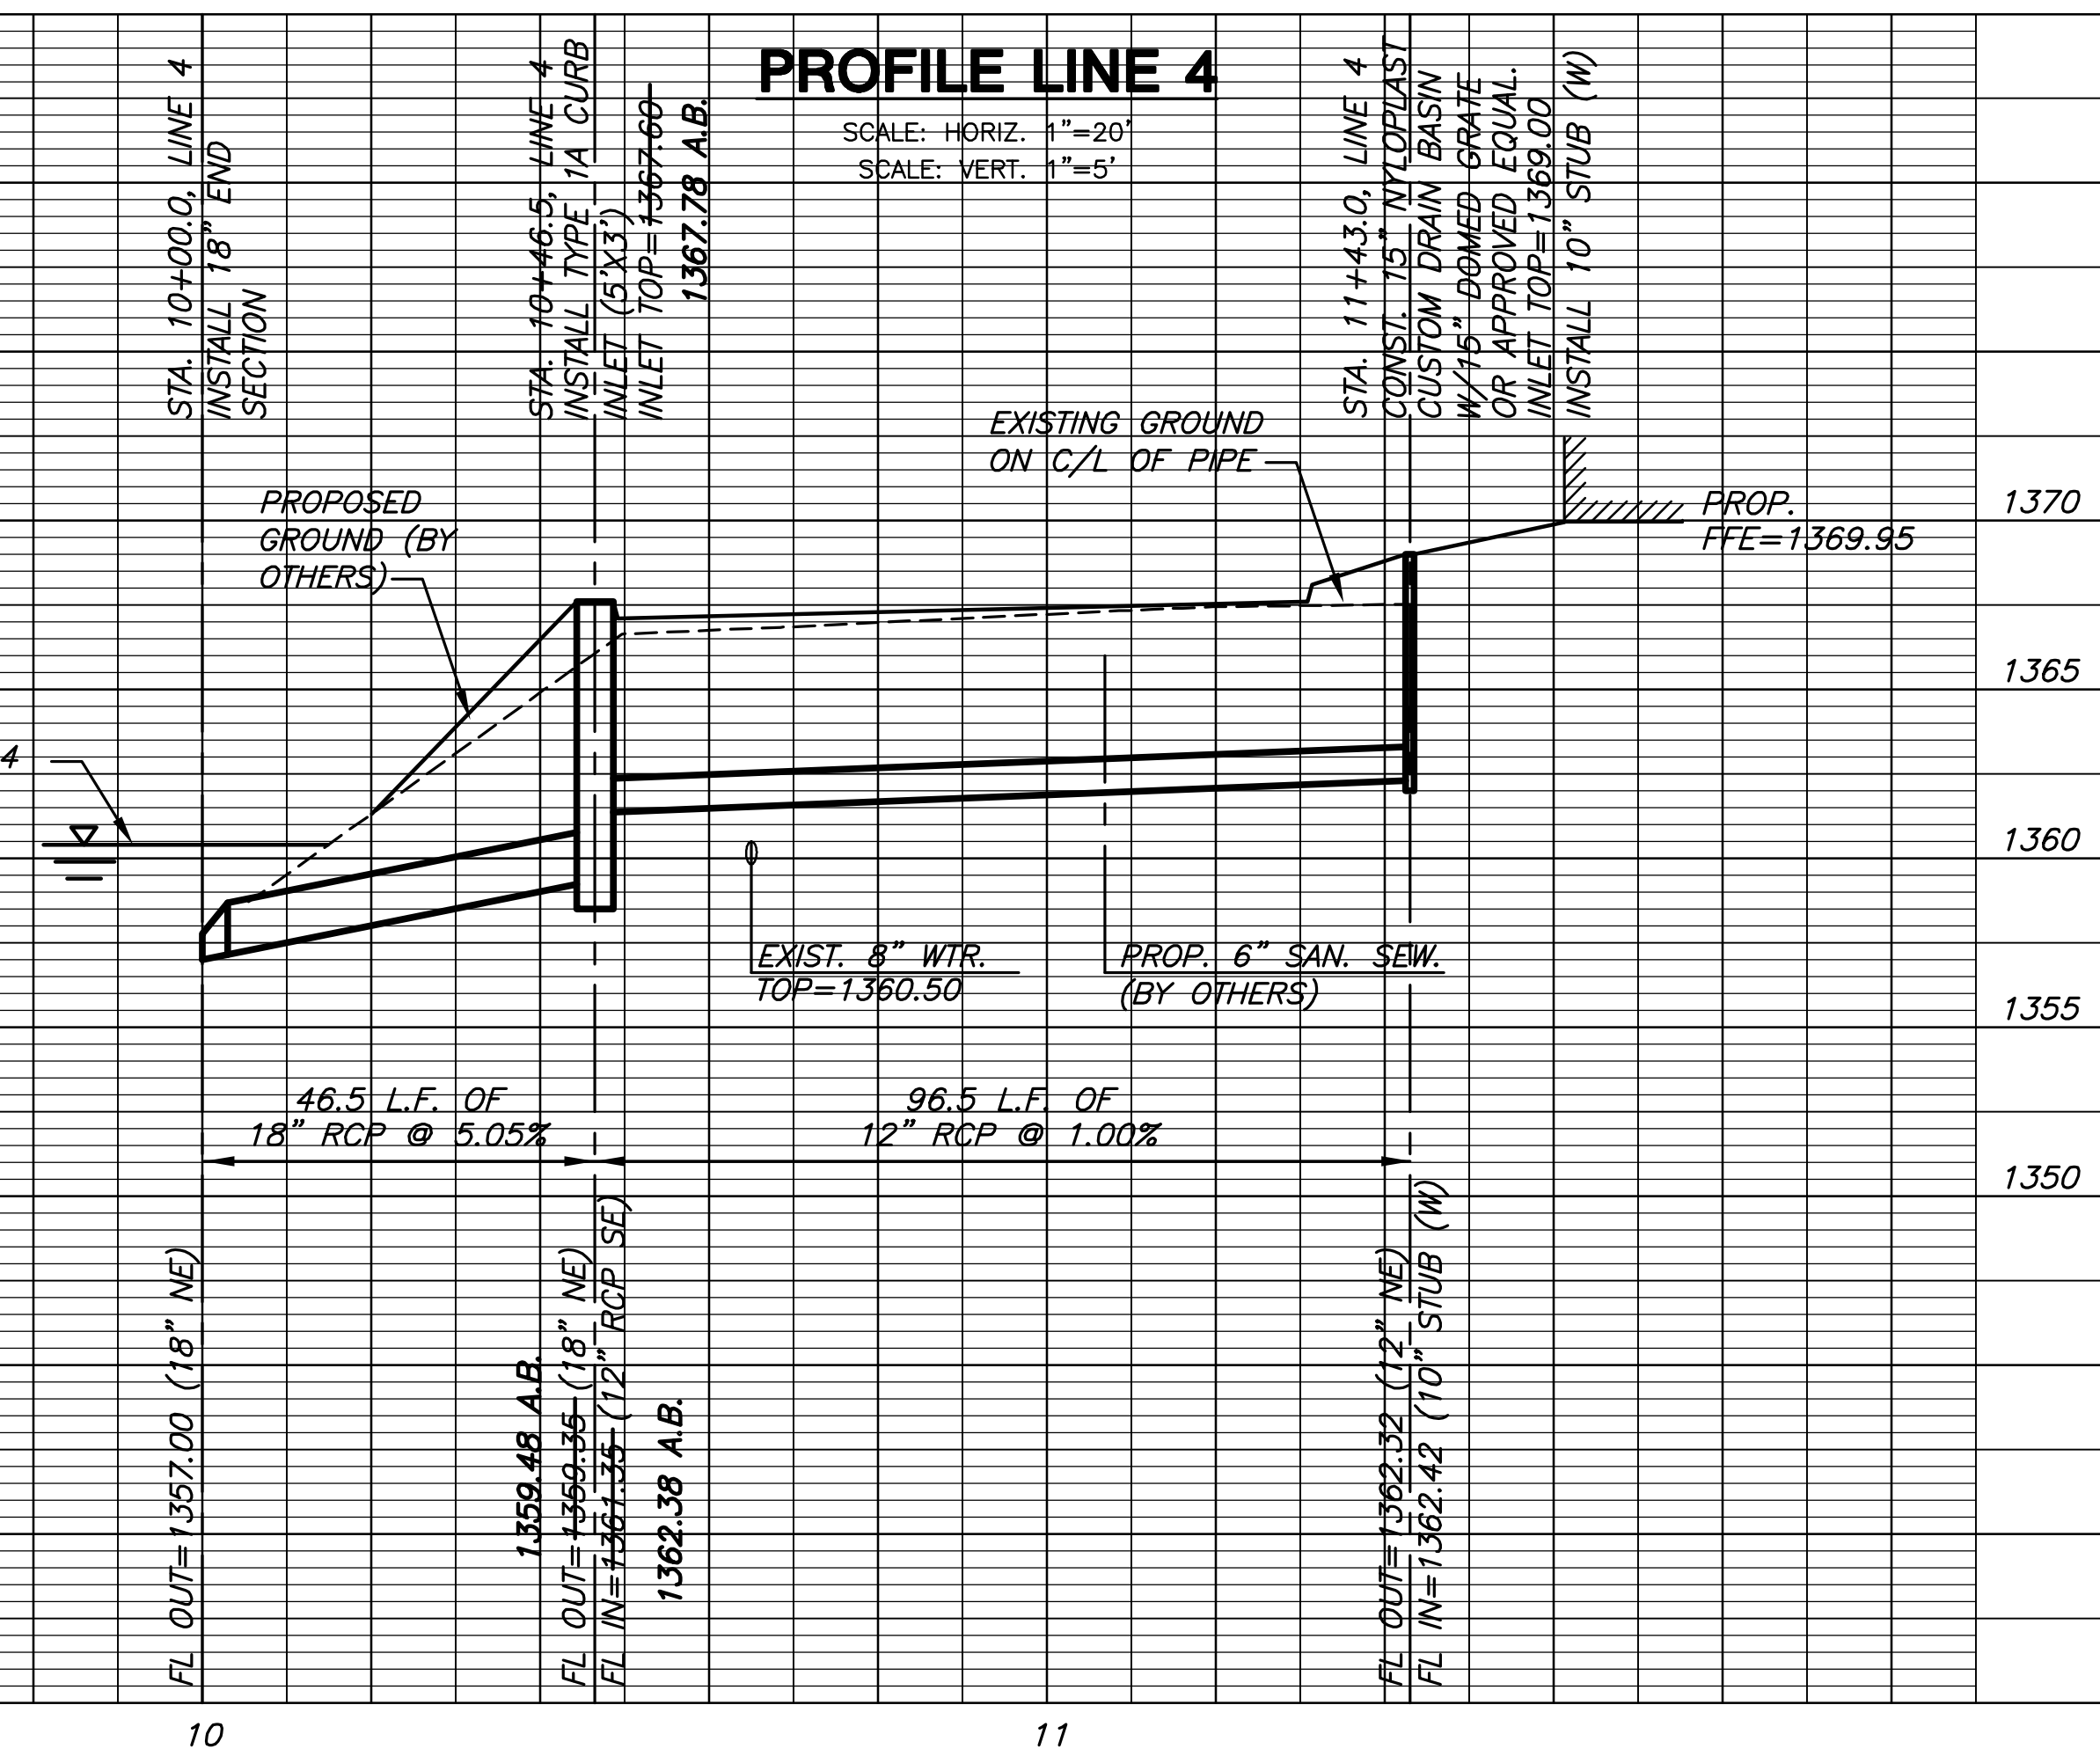

PROFILE LINE 4

SCALE: HORIZ. 1"=20'
 SCALE: VERT. 1"=5'

MKEC
 ENGINEERING
 CONSULTANTS, INC.
 411 N. WEBB ROAD
 WICHITA, K.S. 67206
 316-684-9600

STORM WATER SEWER
CABELA'S INC.
 REGENCY LAKES COMMERCIAL 2ND ADDITION

LINE 3 & 4
 SHEET TITLE
 0030PPD (607861)
 PROJECT NUMBER

SPE / DM / MAB
 DESIGNED DRAWN CHECKED

ISSUED
 May 2011
 REVISED
 AS-BUILTS 02/2012

SHEET NO.
 2 of 4