
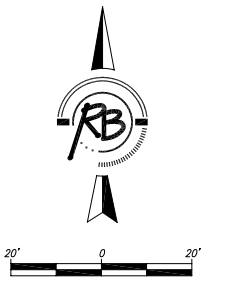


# SWS ASBUILT EXHIBIT

TRUCK FUEL STATION  
PROJECT # 55PPD (607861)

PART OF LOT 1, MALONEY 2ND ADDITION  
Wichita, Kansas

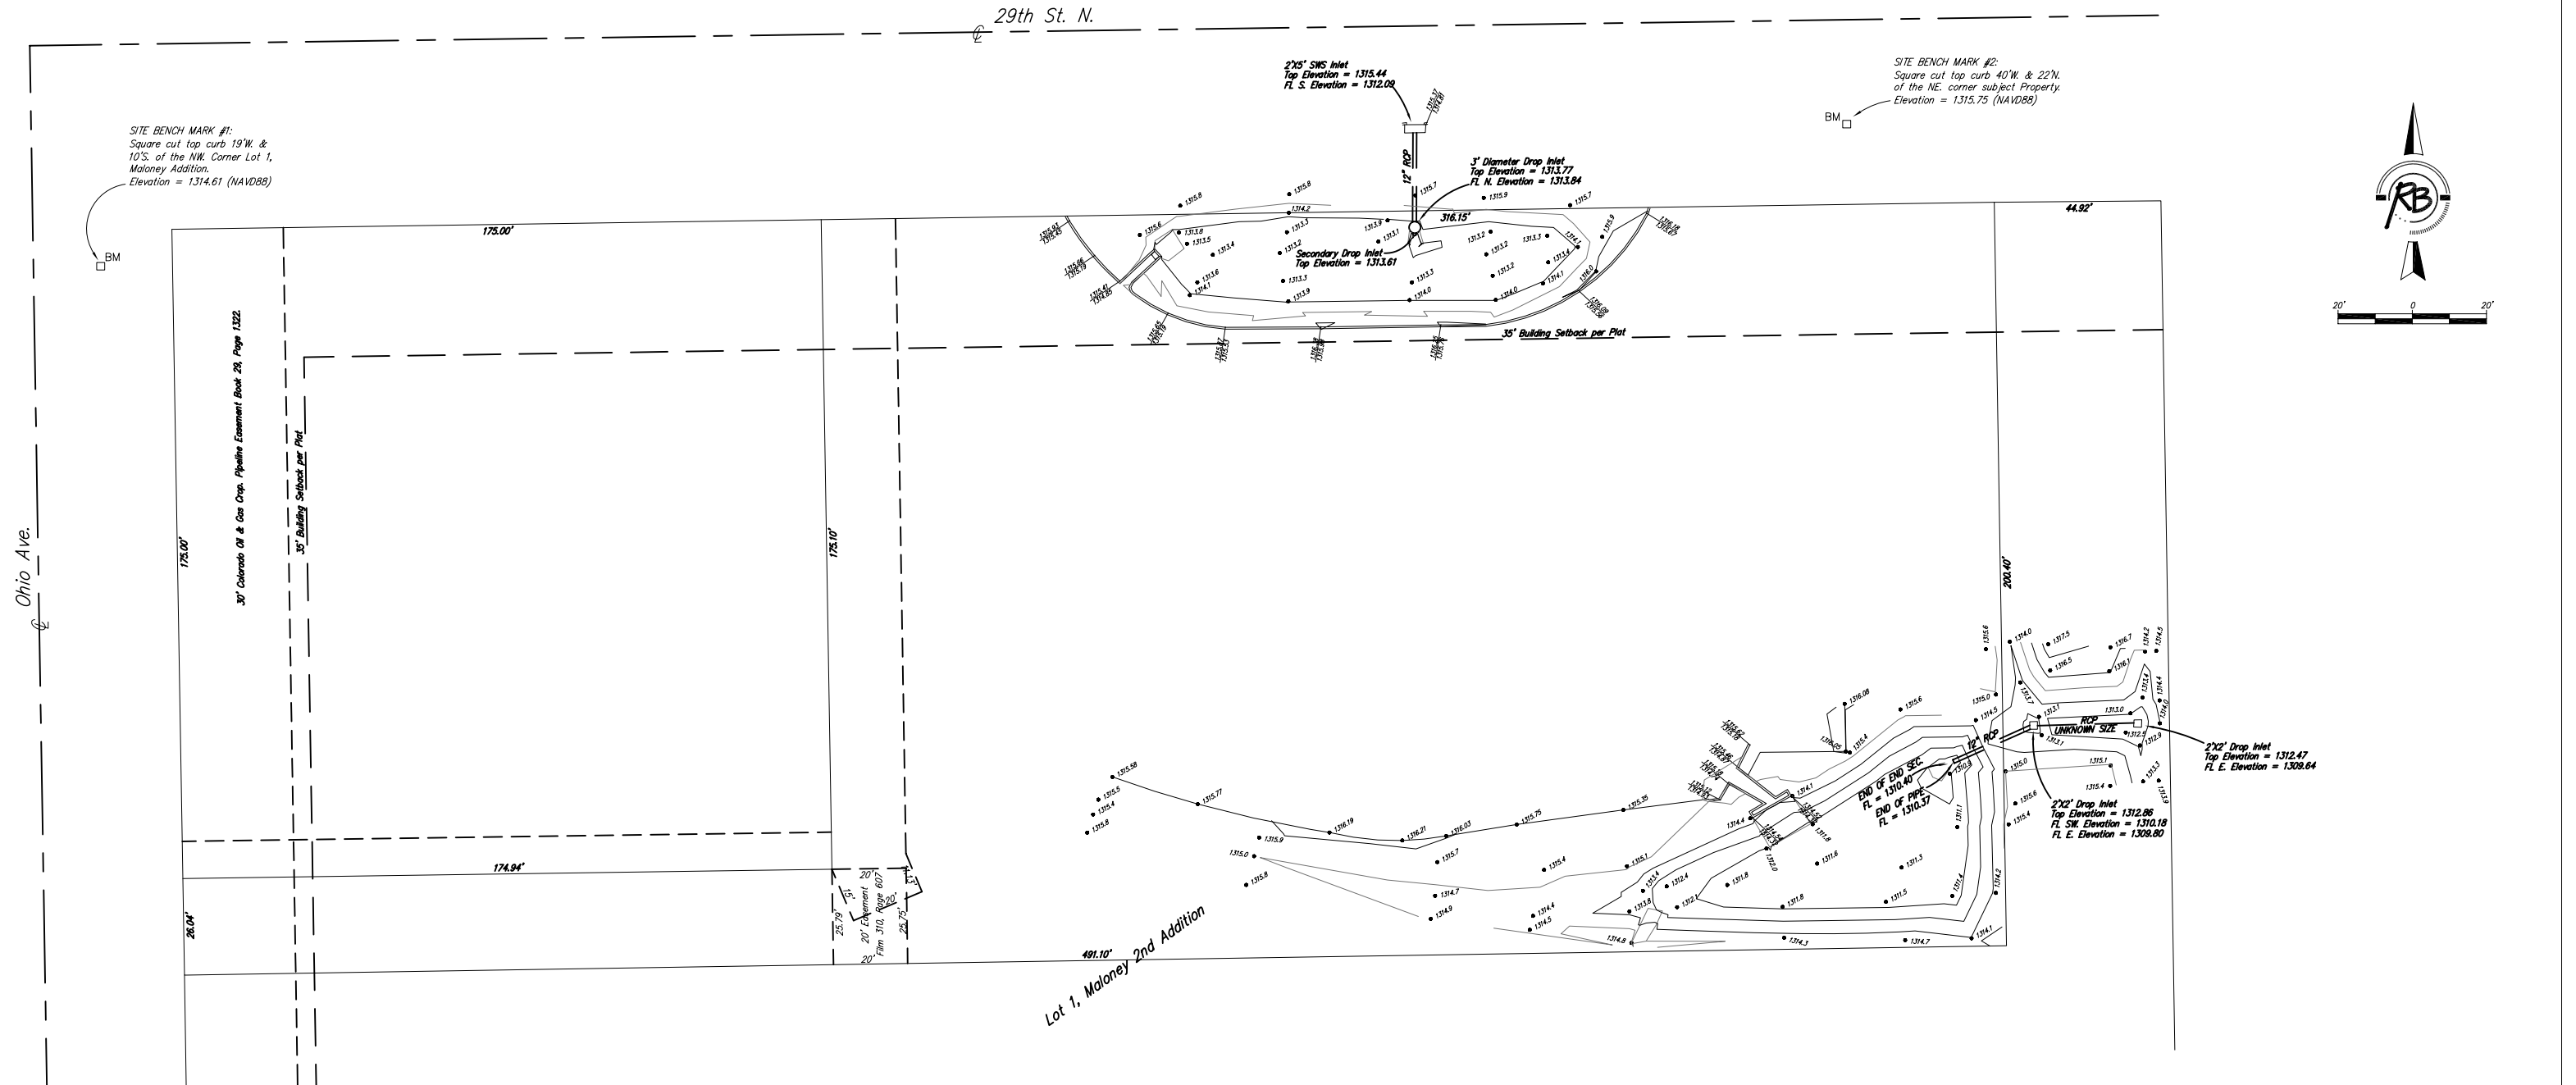

**Ruggles & Bohm, P.A.**  
Engineering, Surveying, Land Planning  
924 North Main (316) 264-8008  
Wichita, Kansas 67203 (316) 264-4621 fax  
www.rbkansas.com E-mail: info@rbkansas.com

DWG FILE: ASBUILT  
PROJECT NO. 3805E  
APRIL 25, 2012