

# STORM WATER IMPROVEMENTS


TO SERVE

## BJ'S RESTAURANT & BREWHOUSE

PRIVATE PROJECT NO. 0072 PPD (607861)

CITY OF WICHITA, KANSAS

JAMES L. ARMOUR, P.E. - CITY ENGINEER

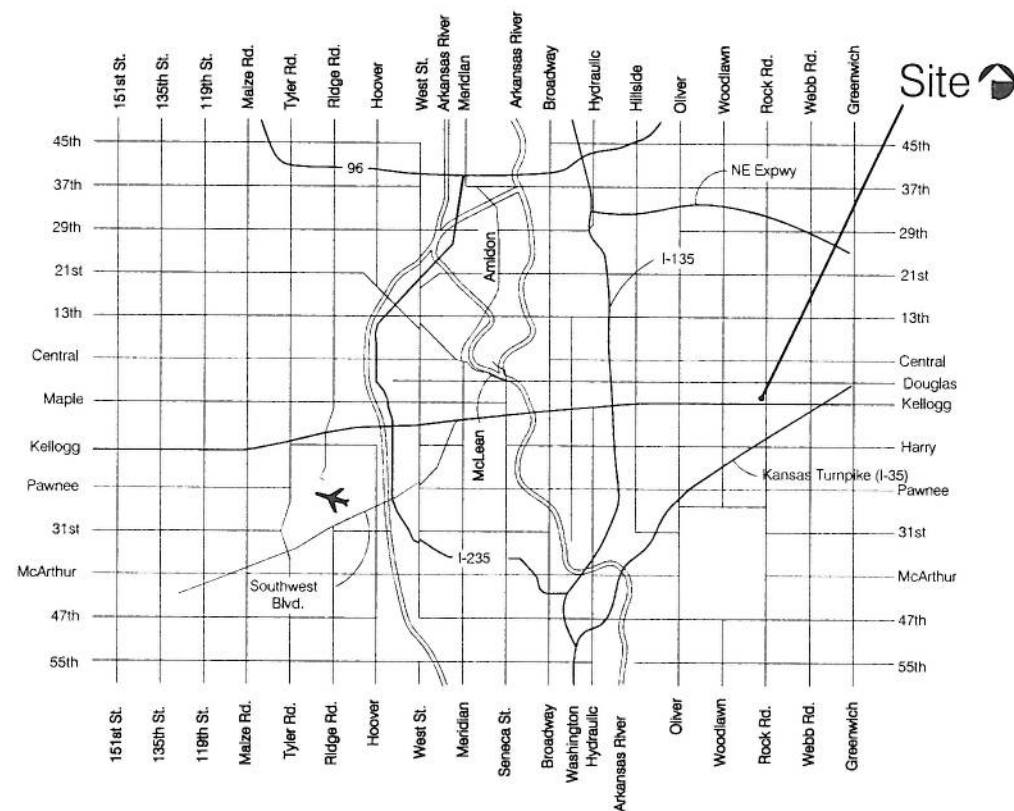

### INDEX OF SHEETS

SHEET NO. C2.0	STORMWATER TITLE SHEET
SHEET NO. C2.1	SITE GRADING PLAN
SHEET NO. C2.2	STORM SEWER PLAN
SHEET NO. C2.3	STORM SEWER PROFILES
SHEET NO. C3.0	EROSION CONTROL PLAN

APPROVED AS NOTED  
BY CITY ENGINEER OF WICHITA

Engineering: *Julianne Kellman 1-31-12*  
Stormwater: *Jim Hendry 1-31-12*

NOTE TO CONTRACTORS

*Inspection and testing for this project are to be provided by a Licensed Consulting Engineering Firm under contract with the Owner/Developer. Said inspection to be in accordance with the City of Wichita standard construction engineering practices and certified by a Licensed Professional Engineer. No work shall be performed in dedicated easements or public right-of-way by the Contractor without such inspection, nor shall any work be commenced without written authorization by the City Engineer.*

### AS BUILTS

Contractor:  
Ewertz  
Excavation

4/18/2012

Project Inspector:  
Larry Gann



516 S. Market,  
Wichita, KS 67202

(316)264-0242

JANUARY 2012  
PLANS PREPARED BY



7007 DISCOVERY BLVD  
DUBLIN, OH 43017  
614.634.7000 T

WDPARTNERS.COM



01/30/2012