


PLAN NOTES

- CONTRACTOR SHALL ENSURE THAT ALL TEMPORARY STOCKPILE AREAS UTILIZED DURING CONSTRUCTION ARE SURROUNDED WITH EROSION AND SEDIMENT CONTROL MEASURES. STOCKPILE AREAS SHALL BE SURROUNDED WITH TRIANGULAR SILT DIKE PER DETAILS ON SHEET 05.
- CONTRACTOR SHALL INSTALL A CONSTRUCTION ENTRANCE PER DETAIL ON SHEET 05 IF REQUIRED BY CITY OF DORAL PRIOR TO CONSTRUCTION. IF ASPHALT PAVEMENT WITHIN THE LIMITS OF DISTURBANCE IS TO REMAIN IN PLACE, CONSTRUCTION ENTRANCE NOT REQUIRED.

GRADING LEGEND

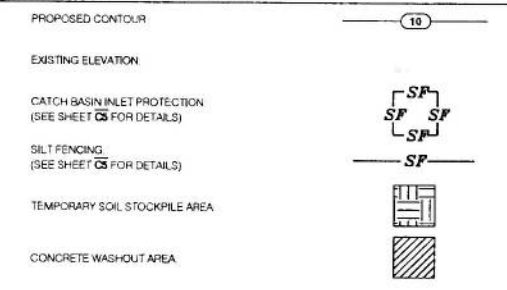

SCOPE OF EROSION CONTROL

THE CONTRACTOR SHALL CONTROL SOIL EROSION RESULTING FROM THE PROPOSED IMPROVEMENTS. THE USE OF SILT FENCING, JUTE MATTING, TEMPORARY SEEDING, SILT CHECKS, INLET PROTECTION AROUND ALL CATCH BASINS, STABILIZED CONSTRUCTION ENTRANCE(S), ETC. MAY BE REQUIRED. REFER TO PLAN. SEDIMENT CONTROL STRUCTURES/DEVICES SHALL BE INSTALLED IN ACCORDANCE WITH THE LATEST EDITION OF THE KDOT TEMPORARY EROSION-CONTROL MANUAL: A GUIDE FOR THE DESIGN, INSTALLATION, INSPECTION, AND MAINTENANCE OF TEMPORARY EROSION-CONTROL MEASURES IN KANSAS. SEDIMENT CONTROL DEVICES MUST BE INSTALLED PRIOR TO BEGINNING ANY CONSTRUCTION ACTIVITY. THE CONTRACTOR SHALL BE RESPONSIBLE FOR CONTINUED INSPECTION AND MAINTENANCE OF ALL SEDIMENT CONTROL DEVICES. THE CONTRACTOR SHALL FOLLOW THE REQUIREMENTS SET FORTH ON THE APPROVED STORMWATER POLLUTION PREVENTION PLAN IF APPLICABLE, OR AS DETAIL ON THE CONSTRUCTION PLANS, AS SPECIFIED BY CITY OF WICHITA, SEDGWICK COUNTY, KANSAS.

IT IS THE CONTRACTOR'S RESPONSIBILITY TO UPDATE BMP CONTROLS AS SITE CONDITIONS WARRANT. MORE CONTROLS MAY BE REQUIRED PER SITE CONDITIONS. THE CONTRACTOR SHALL INCLUDE THESE COSTS IN THE BASE BID. ANY AREA WHERE EROSION IS OBSERVED MUST BE ADDRESSED BY THE CONTRACTOR, WHETHER SHOWN ON THE PLANS OR NOT. IN THE CASE THAT DOWNSTREAM EROSION IS OBSERVED, THE CONTRACTOR MUST CONTACT THE ENGINEER OF RECORD FOR RECOMMENDATIONS.

PERMANENT EROSION CONTROL, TURF ESTABLISHMENT, AND SOIL STABILIZATION IS THE RESPONSIBILITY OF THE CONTRACTOR. THE INTENT OF THIS PLAN IS TO PROVIDE GUIDANCE FOR PLACEMENT OF BEST MANAGEMENT PRACTICES.

CONTRACTOR SHALL BE RESPONSIBLE FOR PROPER CLEANING AND DISPOSAL OF ANY DEBRIS TAKEN OFF SITE. CONTRACTOR IS RESPONSIBLE FOR ALL FINES AND FEES FOR IMPROPER PLACEMENT OR MAINTENANCE OF CONTROLS.

ROCK ROAD

KELLOGG (U.S. HIGHWAY 54)

CURB INLET
INV. S. - 1348.85

SITE BENCH-MARK 2
1" OF CURB
ELEVATION = 1344.11
(PLAVID 86)

CURB INLET
INV. N. - 1346.50
INV. S. - 1346.40

CURB INLET
INV. - 1345.53

AS BUILTS




516 S. Market,
Wichita, KS 67202
(316)264-0242

ON-SITE REVISIONS

DATE	REVISION DESCRIPTION	INITIALS

CALL BEFORE YOU DIG!
KANSAS LAW REQUIRES NOTIFICATION OF THE UNDERGROUND FACILITY OWNER AT LEAST TWO (2) WORKING DAYS BUT NO MORE THAN FIFTEEN (15) CALENDAR DAYS PRIOR TO EXCAVATION OR DEMOLITION.

Kansas One-Call
www.kansasonecall.com
1-800-DIG-SAFE

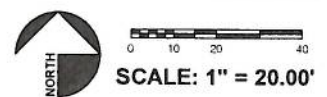

brand : operations : build

7007 DISCOVERY BLVD
DUBLIN, OH 43017
614.834.7000 T

WDPARTNERS.COM

40 PROTOTYPE

BJ'S RESTAURANT & BREWHOUSE
7960 EAST KELLOGG
WICHITA, KANSAS 67207



01/30/2012

REVISIONS



WO PROJECT: B-SB0167
PERMIT ISSUE DATE: 11/17/11
HEALTH SUBMITTAL
BIO ISSUE DATE: 12/18/11
CONSTRUCTION SET:

C3

EROSION CONTROL PLAN