
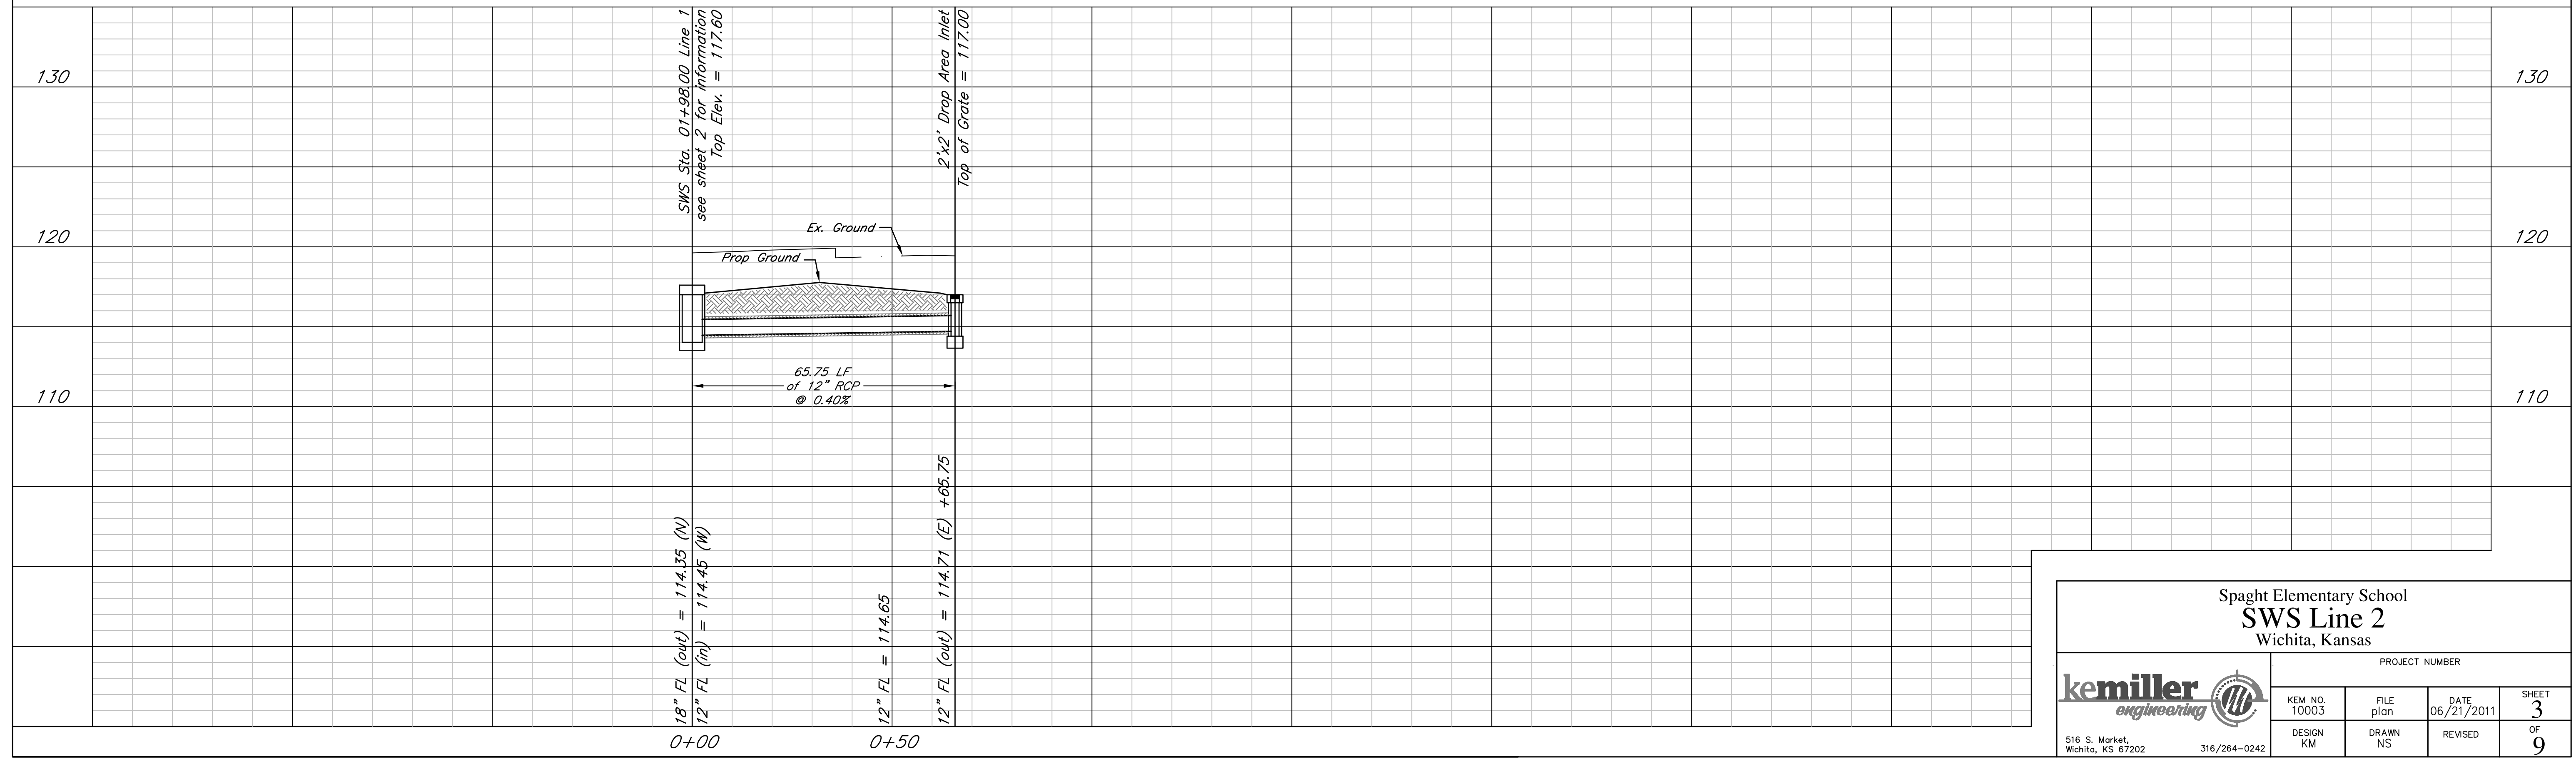


Notes:  
1. Use sand backfill where pipe is under pavement if applicable.

AS BUILTS	
Contractor: McCullough Excavation, Inc.	Project Inspector: Larry Gann
516 S. Market, Wichita, KS 67202 (316)264-0242	

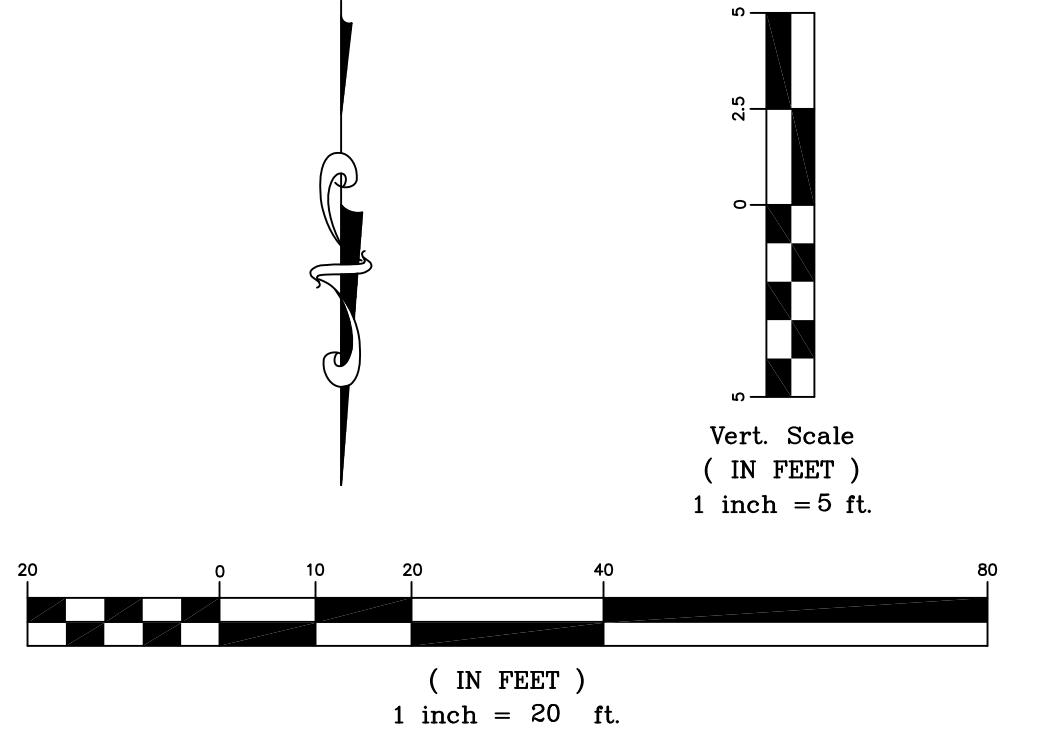

Spaght Elementary School SWS Line 2 Wichita, Kansas				
		PROJECT NUMBER		
KEM NO. 10003	FILE plan	DATE 06/21/2011	SHEET <b>3</b>	
DESIGN KM	DRAWN NS	REVISED	OF <b>9</b>	
516 S. Market, Wichita, KS 67202		316/264-0242		