
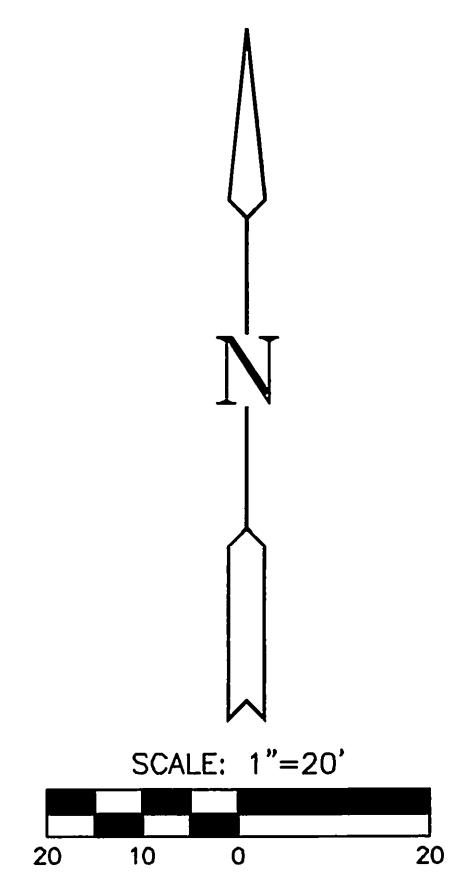


FOR CONSTRUCTION

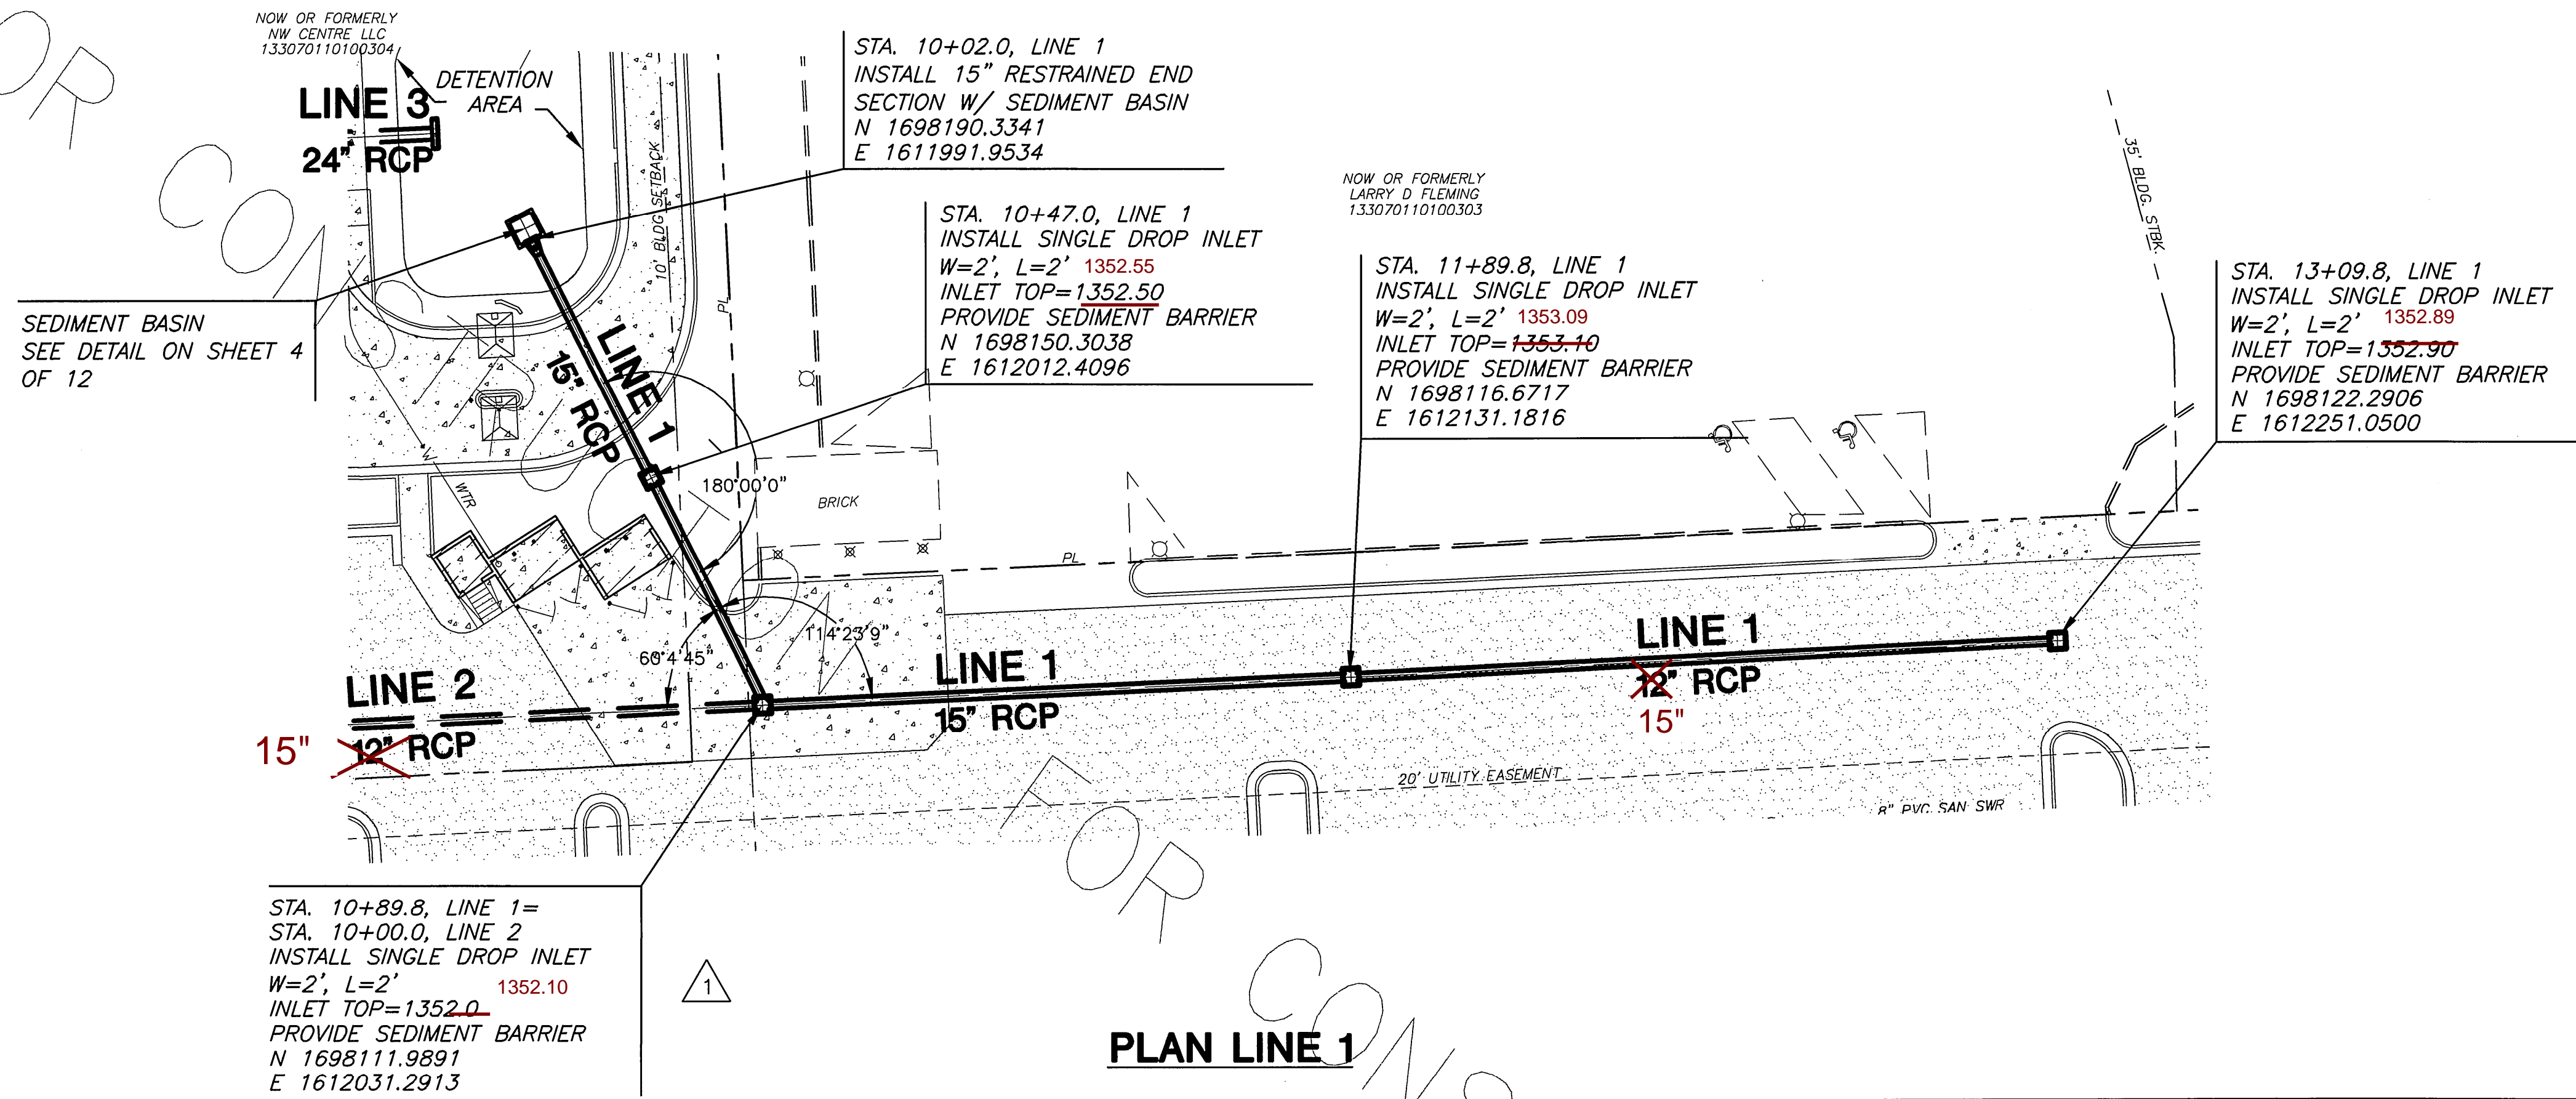


AS BUILTS

kemiller
engineering

516 S. Market
Wichita, KS 67202
(316)264-0242

PLAN LINE 1

PROFILE LINE 1

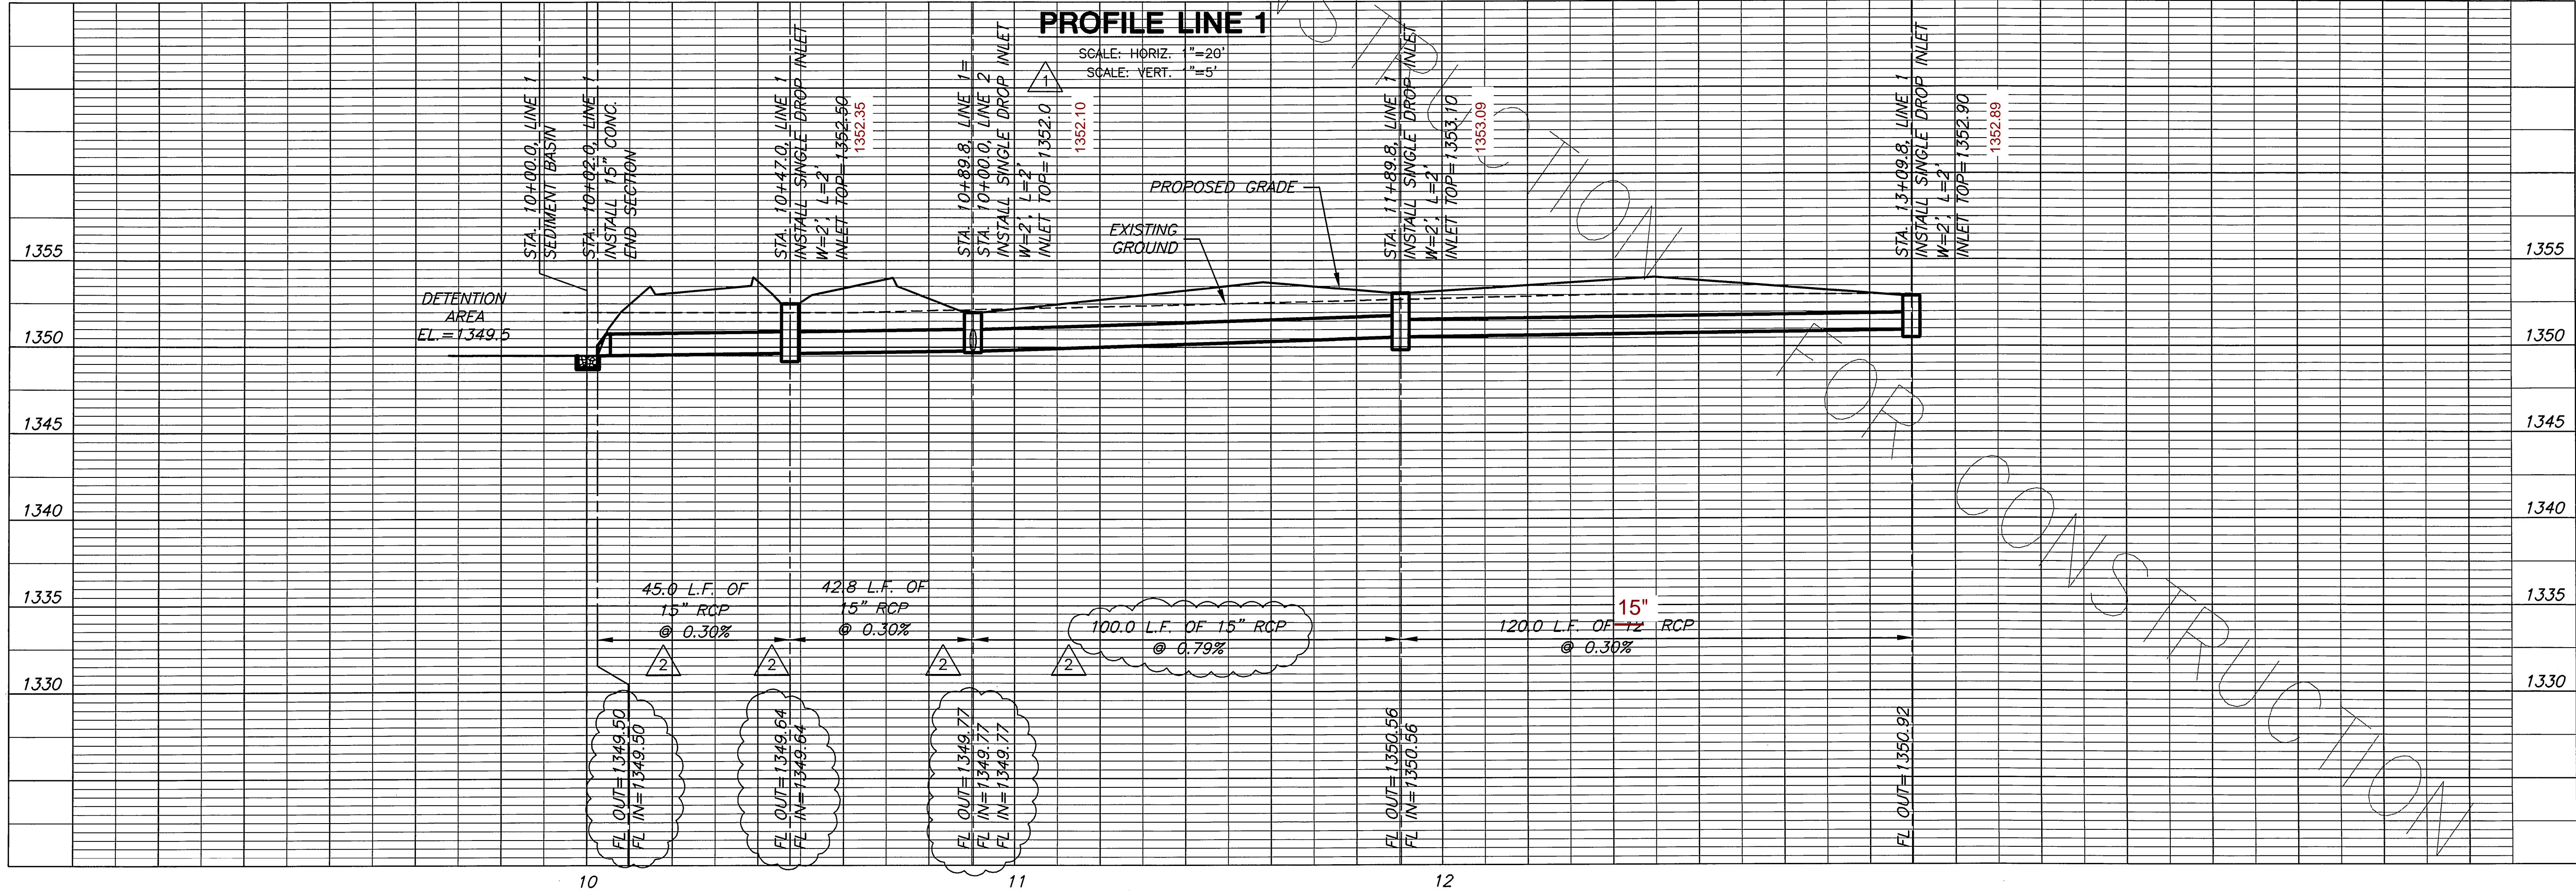

MKEC
ENGINEERING
CONSULTANTS, INC.

411 N. WEBB ROAD
WICHITA, KS. 67206
316-684-9600

JOSEPH J. JOHNSON
Professional Engineer
20916
2-26-12
KANSAS

STORM WATER SEWER PLANS FOR
CHICK-FIL-A
WICHITA, KANSAS

LINE 1
SHEET TITLE
1201010135
PROJECT NUMBER

A/JK / DM / GJA
DESIGNED / DRAWN / CHECKED

ISSUED
March 2012

REVISED
4-17-2012
4-26-2012

SHEET NO.
6 of 14

PLOTTED: Thursday, April 26, 2012 @ 03:45PM

J:\PROJECTS\2012\1201010135_CHICK-FIL-A\5-CIVIL\CADD\SWS\1201010135-D1.DWG