



AS BUILTS
kemiller engineering
 516 S. Market, Wichita, KS 67202 (316)264-0242

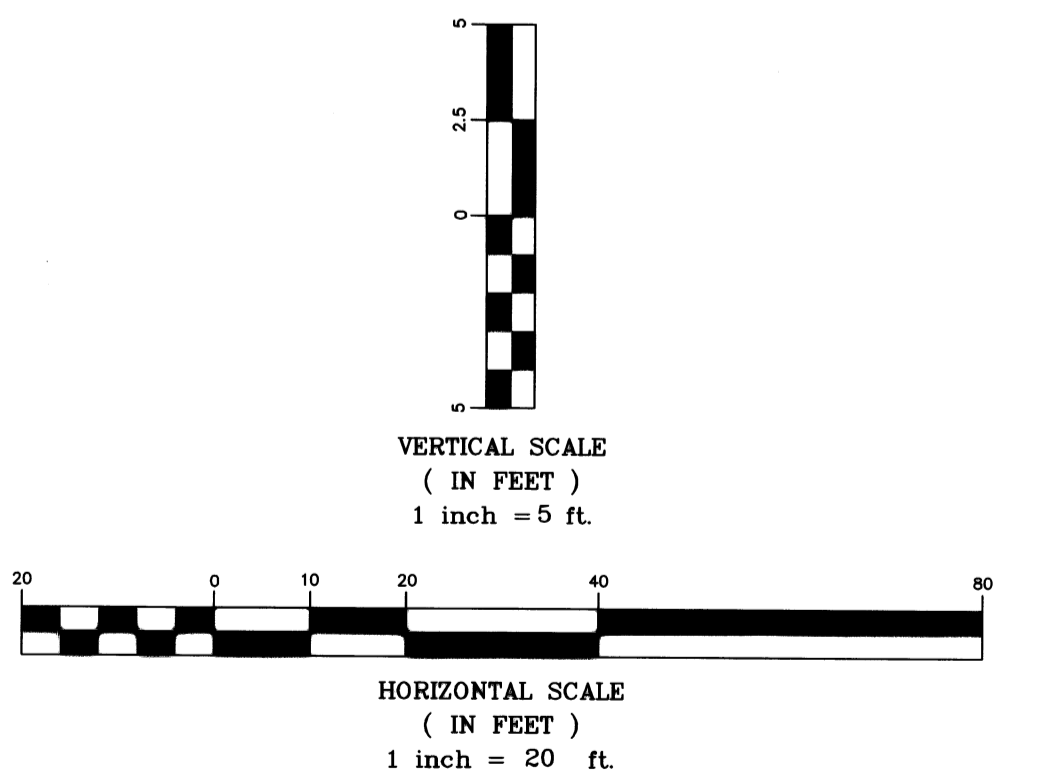

Oakleaf Diversified, LLC
Water Line 1
 Wichita, Kansas

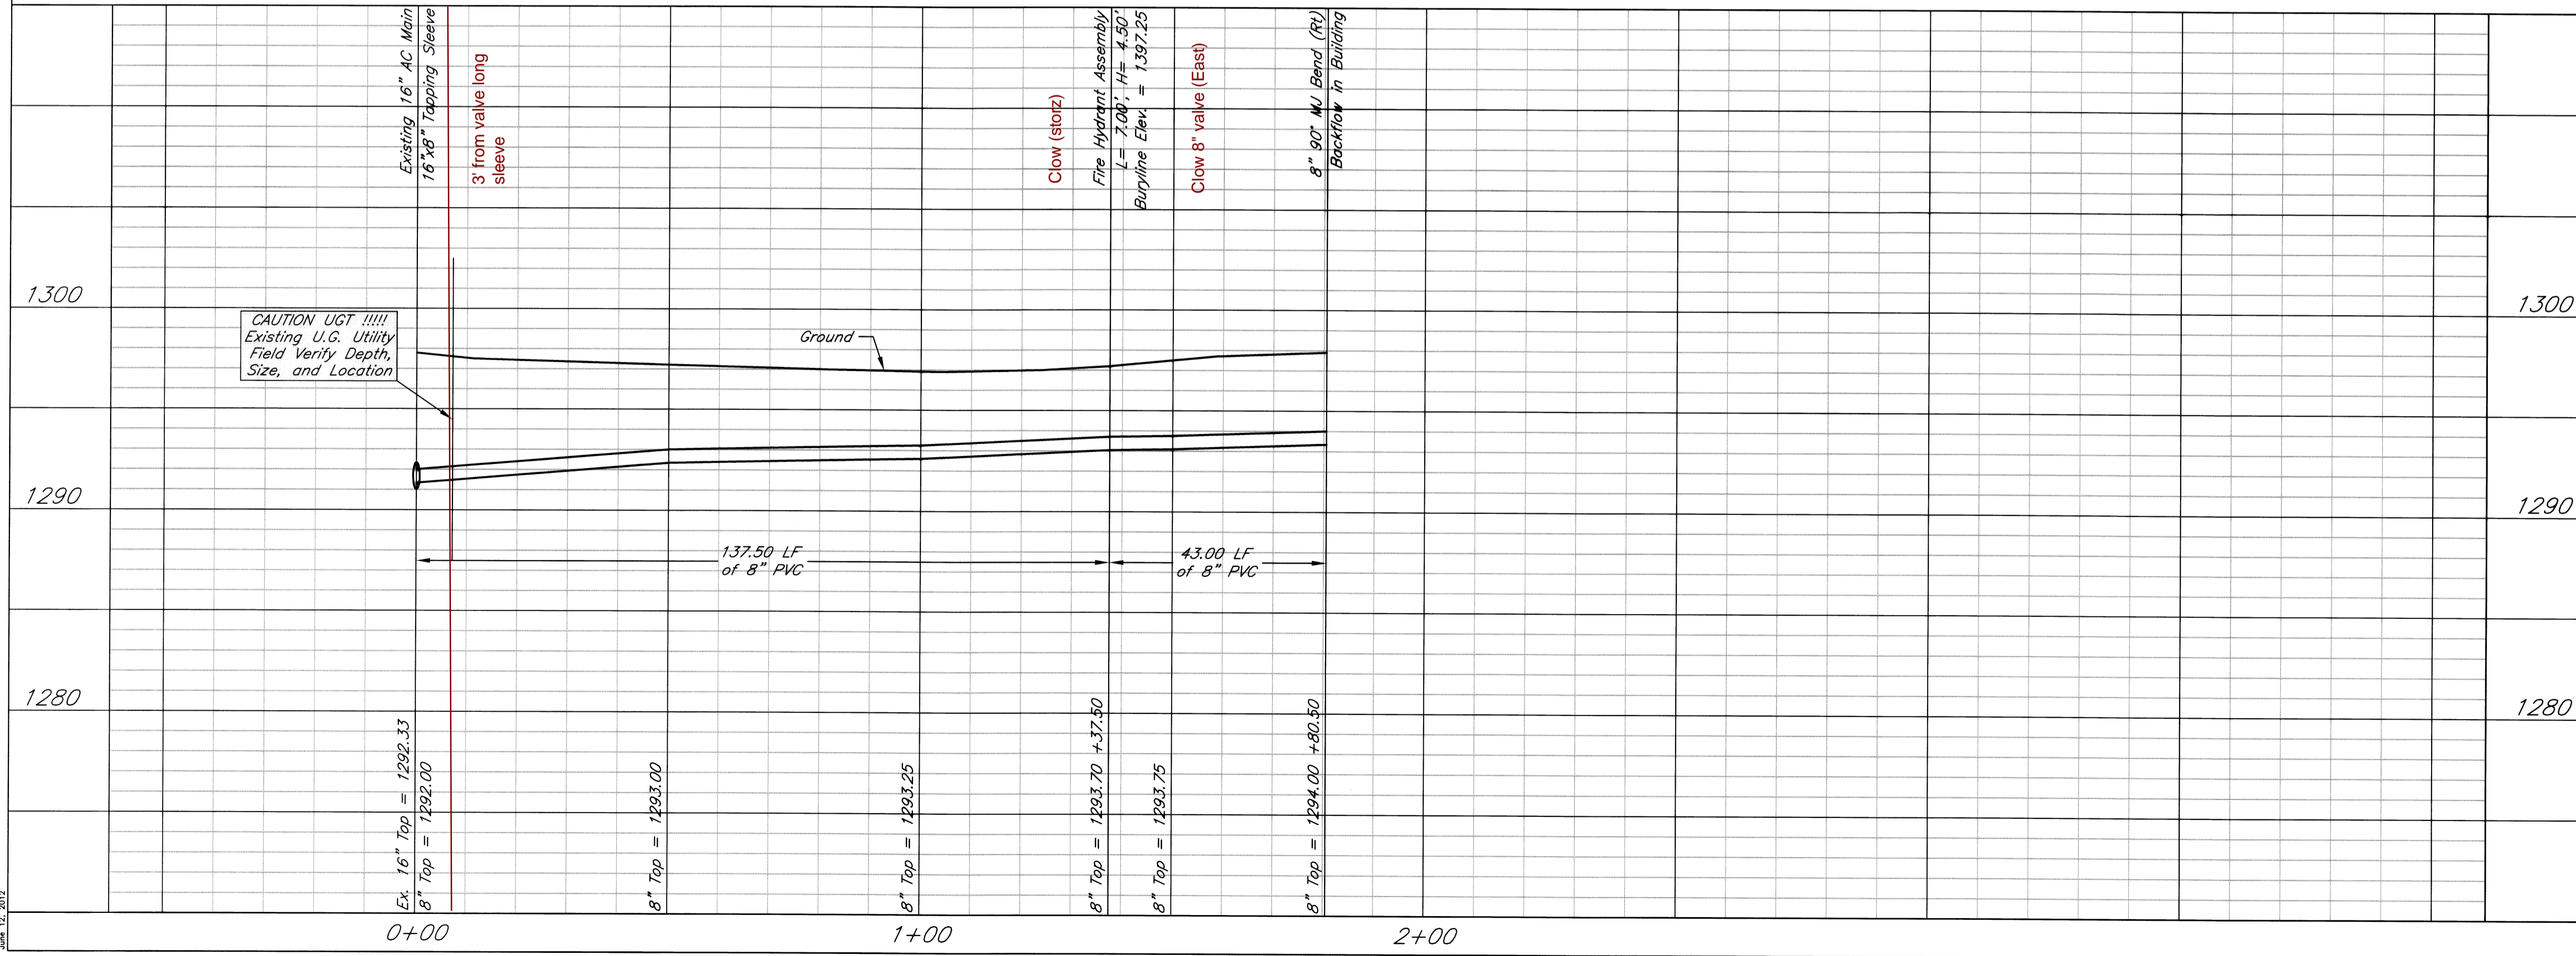

PROJECT NUMBER			
KEM NO. 12068	FILE	DATE 05/31/12	SHEET 2.0
DESIGN KM	DRAWN NS	REVISED	

June 12, 2012