


**SANITARY SEWER LATERAL 8, MAIN 14
KRUG SOUTH ADDITION
PHASE 2**

LINE 1
SHEET TITLE
468-84322
PROJECT NUMBER


DFL / KKL / GJA
DESIGNED / DRAWN / CHECKED

ISSUED
May 2012
REVISED

SHEET NO.
5 of 16

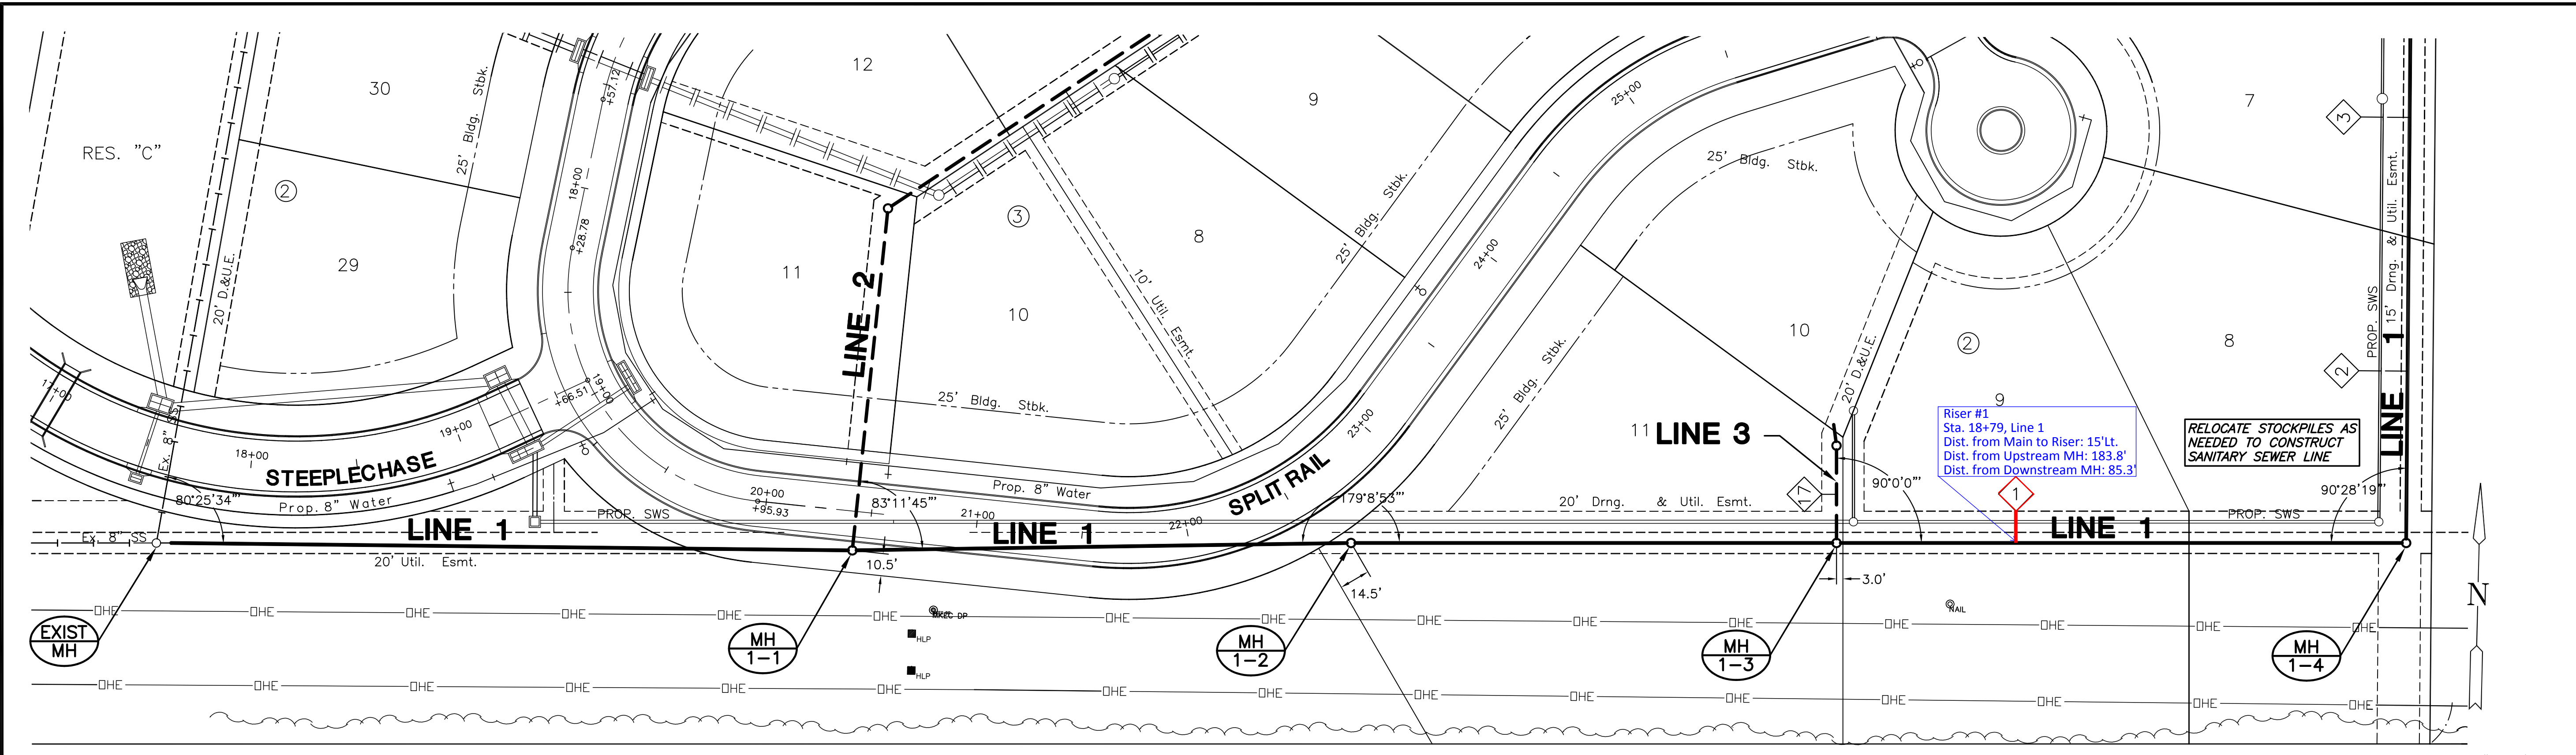

PLAN LINE 1

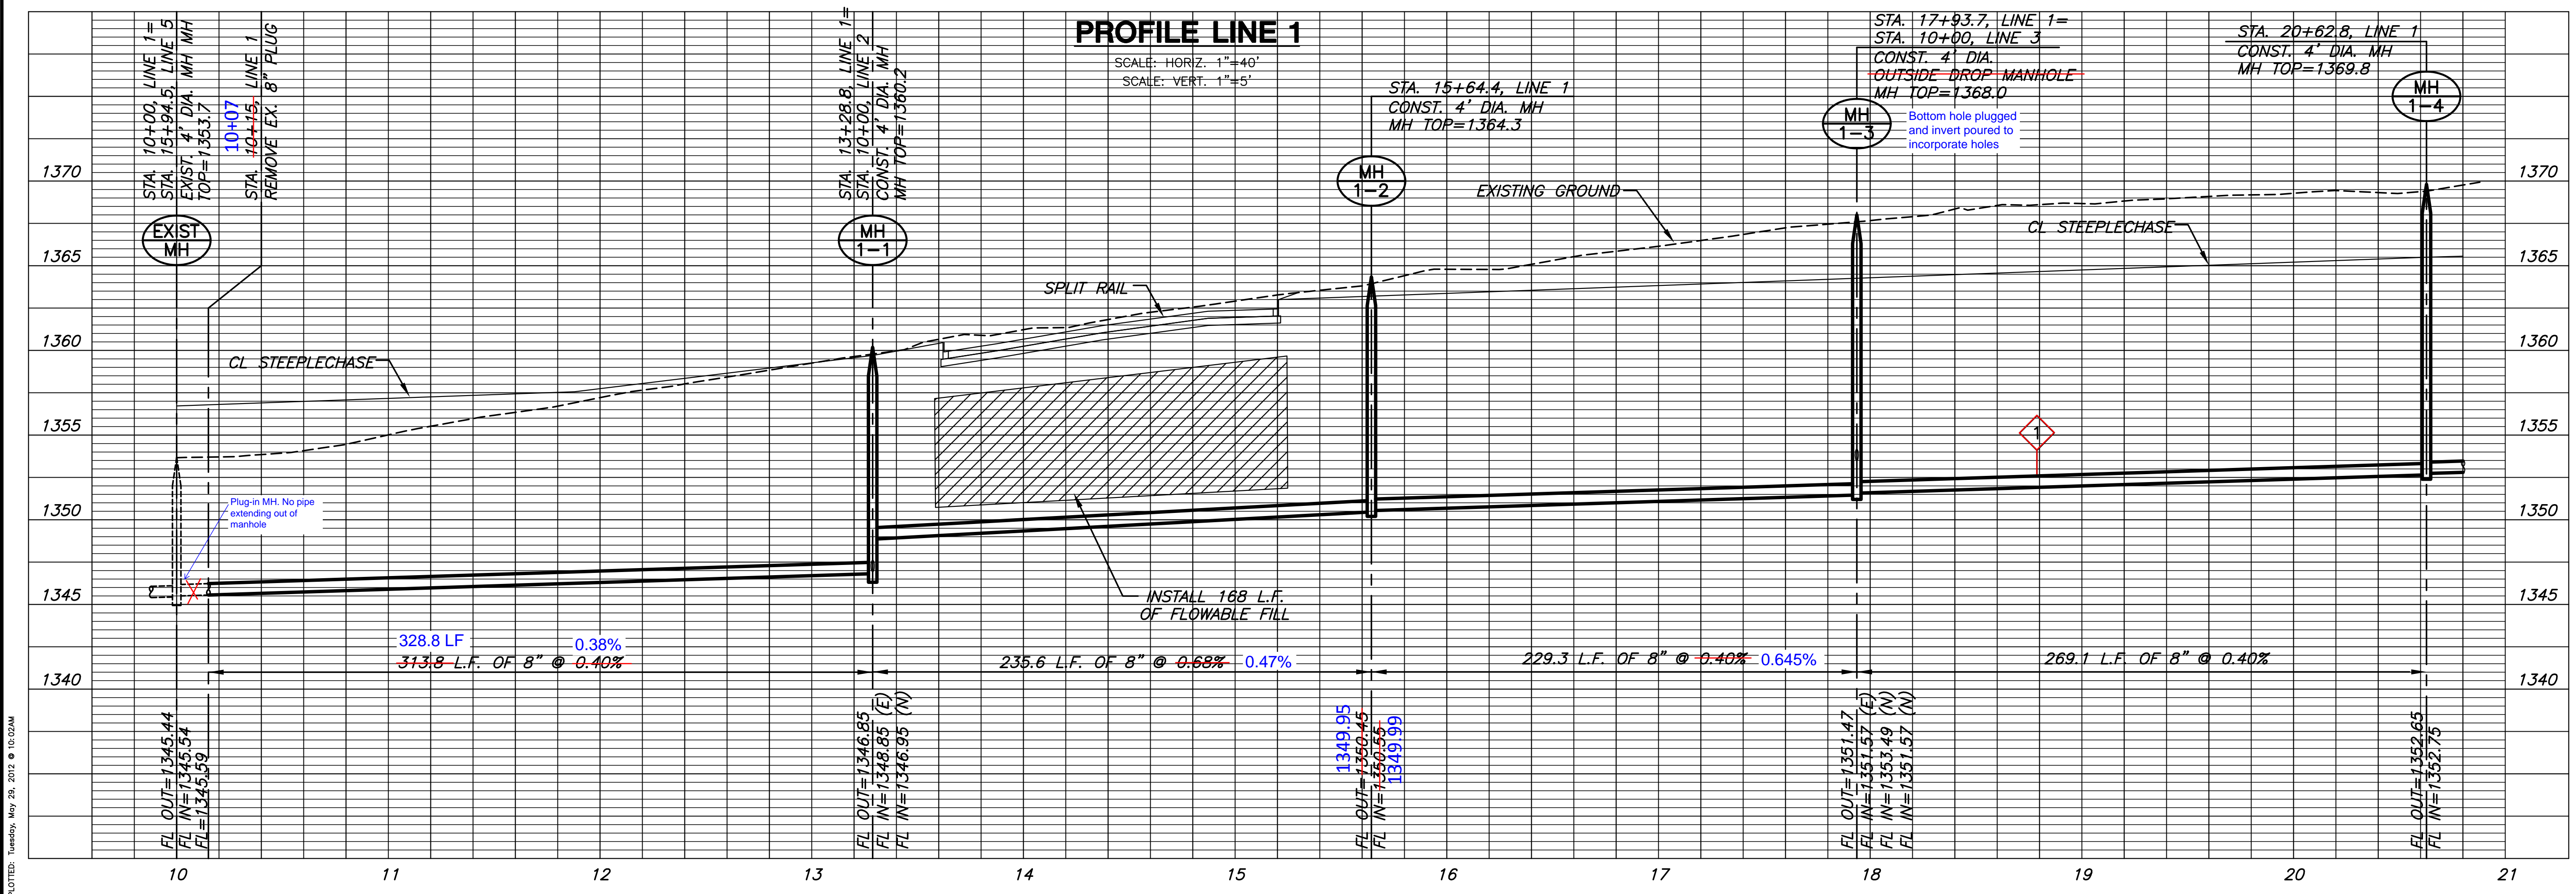

PROFILE LINE 1

PLOTTED: Tuesday, May 29, 2012 @ 10:02AM

J:\CIVIL\05291\WORK\SAN\PH2\05291_B1.DWG