

# GENERAL NOTES

- Existing utilities, both above and below ground, and their locations as shown on the plans, represent the best information available for design. The locations of utilities as shown on the plans are not guaranteed and the Contractor shall verify all utilities and their locations before beginning construction. Additional utilities, including relocated utilities, which are not shown on the plans may be encountered. In this event, the Contractor shall adjust his schedule and cooperate with the utility companies to ensure that their facilities be adjusted as required to clear construction. The Contractor shall exercise extreme caution while working near utilities.
- The Contractor shall not start work on the project until the Project Inspector assigned to the project is present. Any work done without inspection will be required to be uncovered for inspection.
- All Existing Pavement Removal to be Replaced with 6" Temporary Asphalt Pavement.
- Sewage Flow Shall be Uninterrupted Around Work Zones.

# SANITARY SEWER REPLACEMENT FOR HYDRAULIC AVE.

## From South of Harry Street to Kellogg Drive

Pavers, Inc./Whitewing - Contractors  
 J. Wagner - City of Wichita, Field Project Engineer  
 M. Foster - City of Wichita, Inspector  
 AS-built  
 Release Date: 09/16/2011  
 pdf: APRosas 02/12/2013




Project Number  
468-84637

O.C.A. Number  
620546


CITY OF WICHITA, KANSAS  
 James L. Armour, P.E. City Engineer  
 AUGUST 2009

### Index

SH - 1	Title Sheet
SH - 2	Line 1 & Line 2
SH - 3	Line 3

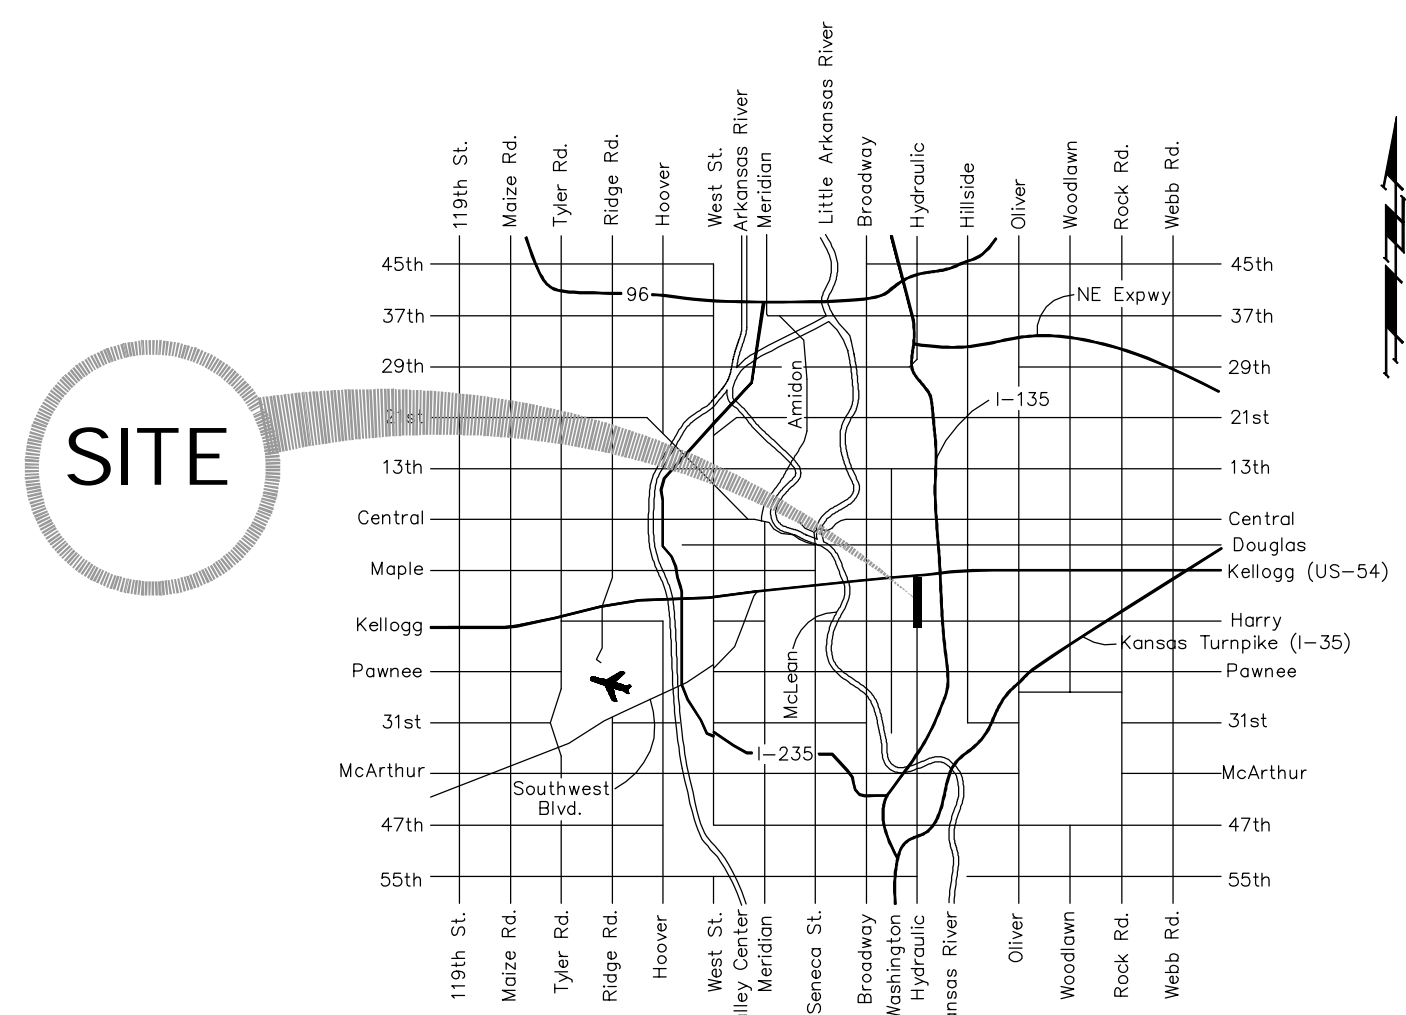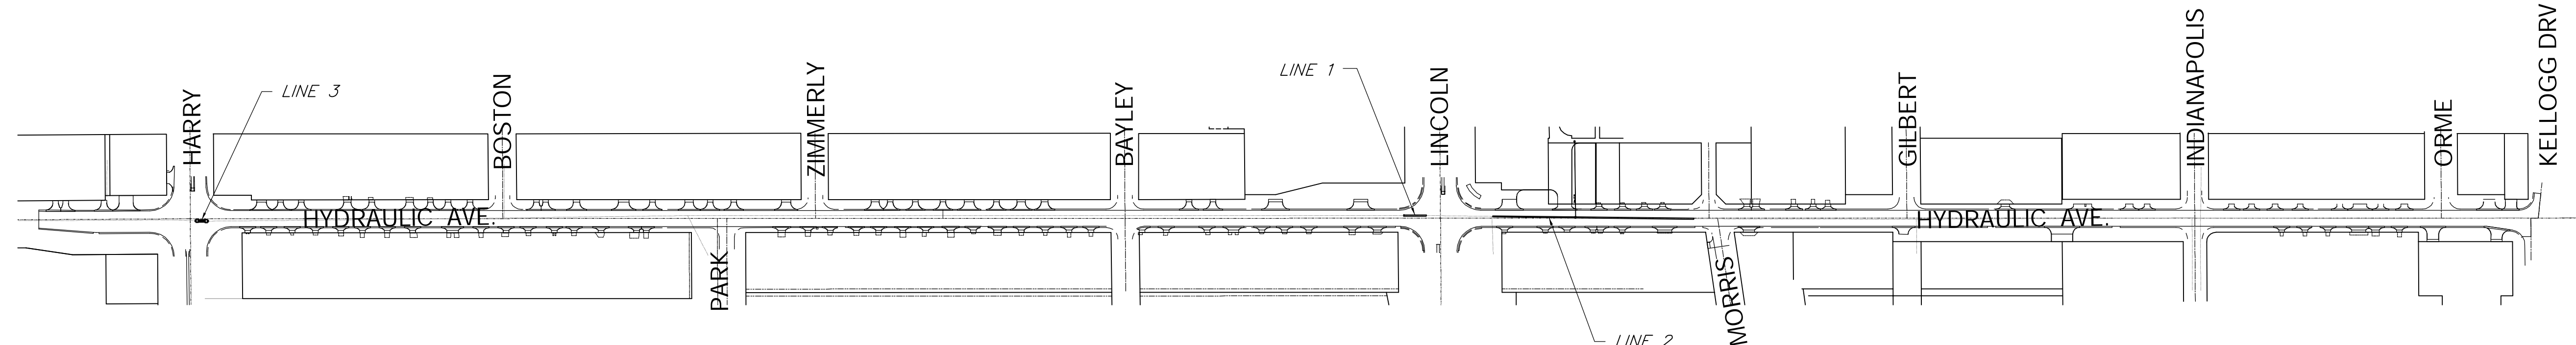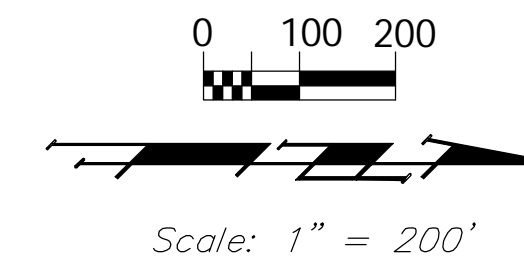

## PROJECT AREA

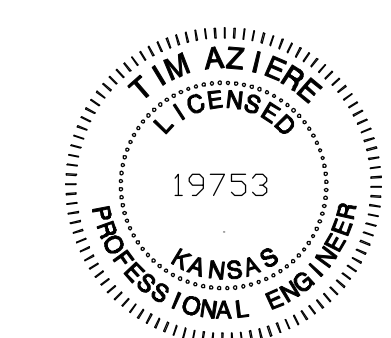

Vicinity Map