


Nowak Construction - Contractor
 S. Degenhardt - City of Wichita, Field Project Engineer
 J. Koleczek - City of Wichita, Inspector
 As-built
 Release Date: 11/22/2013
 pdf: APROsas 03/26/2014

INDEX

- 1 Title Sheet
- 2 Key Sheet
- 3 General Notes
- 4 Forcemain Details
- 5 Air Release Details
- 6 MH & Inlet Frame & Cover Details
- 7-18 S.S. Line 1 Plan & Profile
- 19-23 Erosion Control BMP's
- 24 Detour Routes

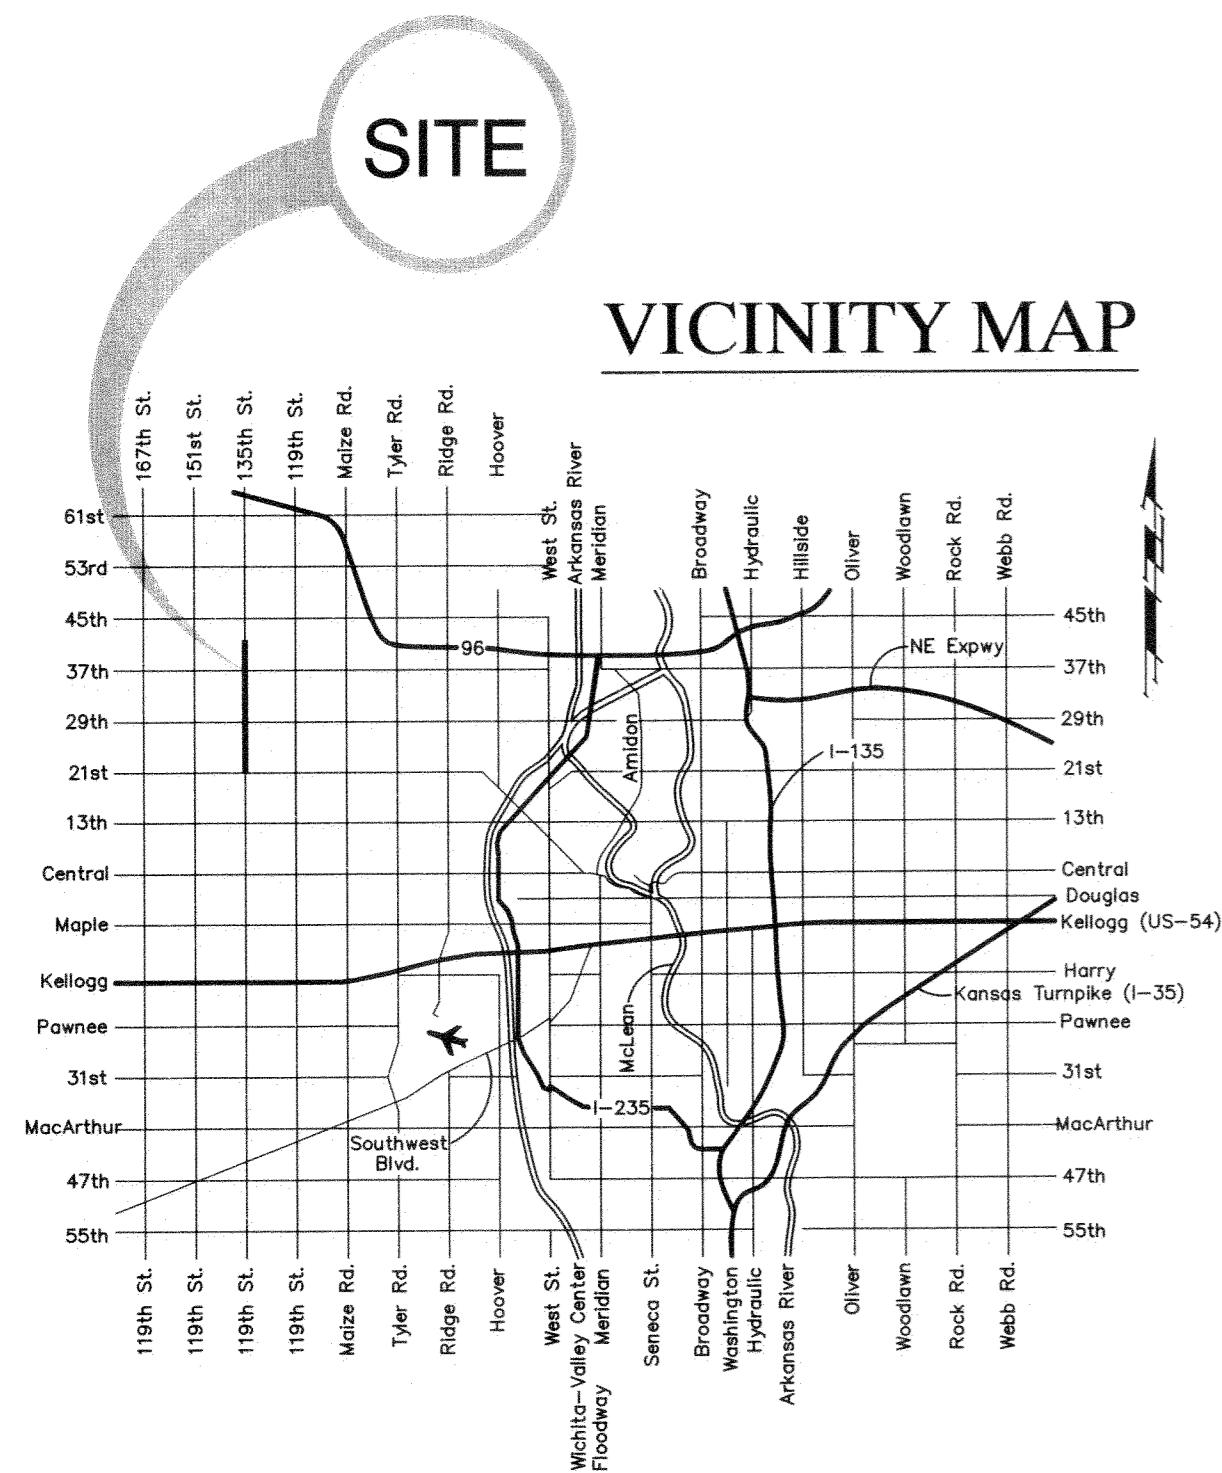

135th St. W.

20" Force Main Phase - II

750' NORTH OF 21ST STREET to WATER RECLAMATION FACILITY

CITY OF WICHITA

Project No. 468-84699-b OCA No. 624-094

Gary Janzen P.E., City Engineer

Jan, 2013

FINAL PLANS

