
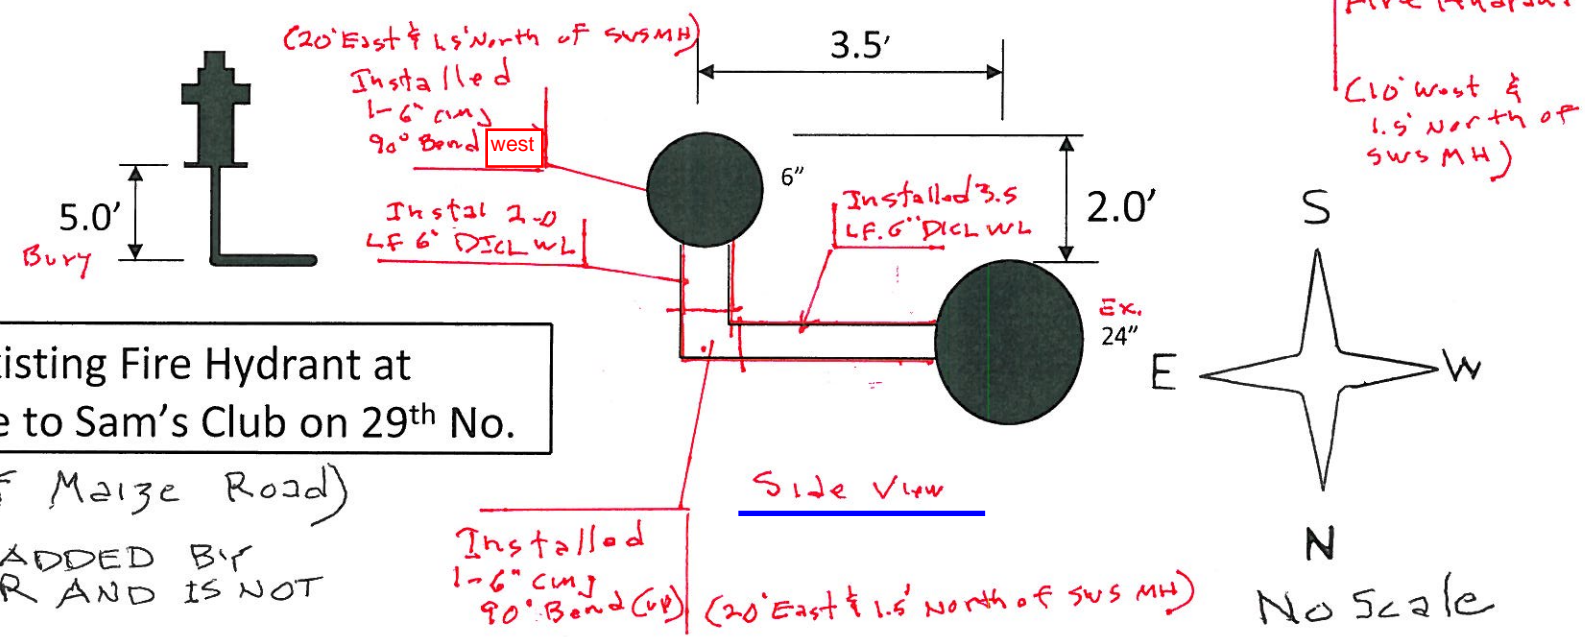


AS BUILT PLAN

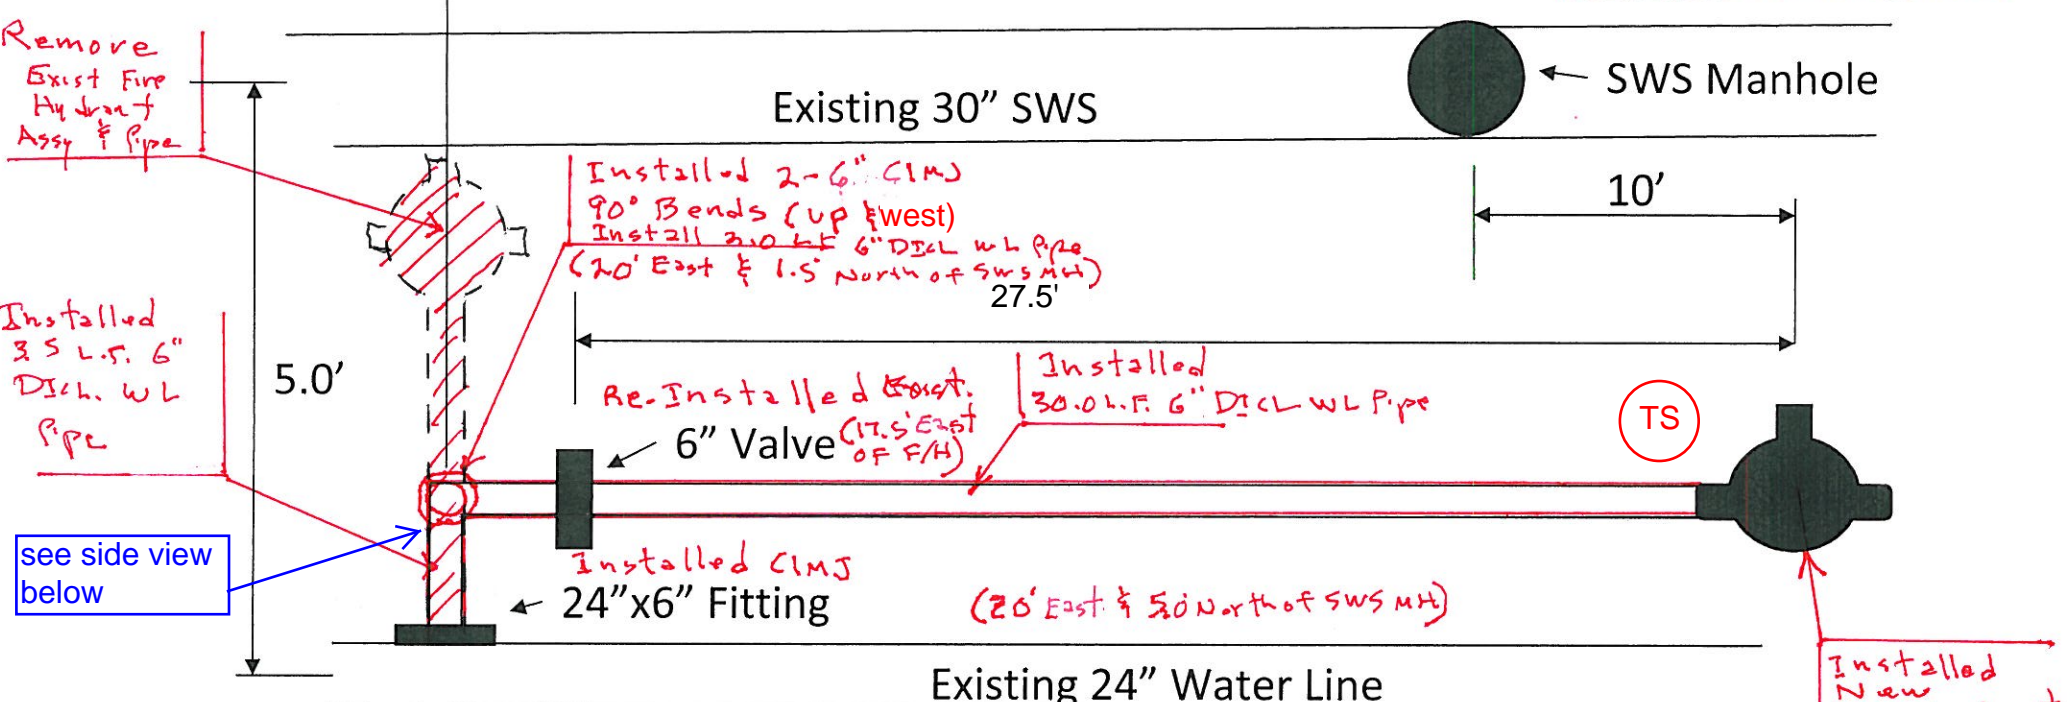

3-5-2014
Relocation of Existing Fire Hydrant at Middle Entrance to Sam's Club on 29th No.

(Just East of Maize Road)

THIS WORK WAS ADDED BY CHANGE ORDER AND IS NOT IN PLANS