


N 1700850.94 E 1641304.72
 STA. 0+00.00 SWS LINE 3=
 STA. 0+00.00 SWS LINE 3A
 BL STA. 37+74.45, 21.97' LT
 CONSTRUCT STD. TYPE P MH (6' DIA.)
 OVER EXISTING 42" RCP
 Moved 4'SW due to WL conflict.

N 1700786.57 E 1641305.83
 STA. 0+64.37 SWS LINE 3=
 STA. 0+00.00 SWS LINE 3B
 STA. 0+00.00 LINE 3C
 BL STA. 37+10.08, 22.00' LT
 CONSTRUCT TYPE P MANHOLE (5' DIA.)

N 1700494.14 E 1641310.99
 STA. 3+56.85 SWS LINE 3=
 STA. 0+00.00 SWS LINE 3D
 STA. 0+00.00 LINE 3E
 BL STA. 34+17.60, 22.00' LT
 CONSTRUCT TYPE P MANHOLE (5' DIA.)

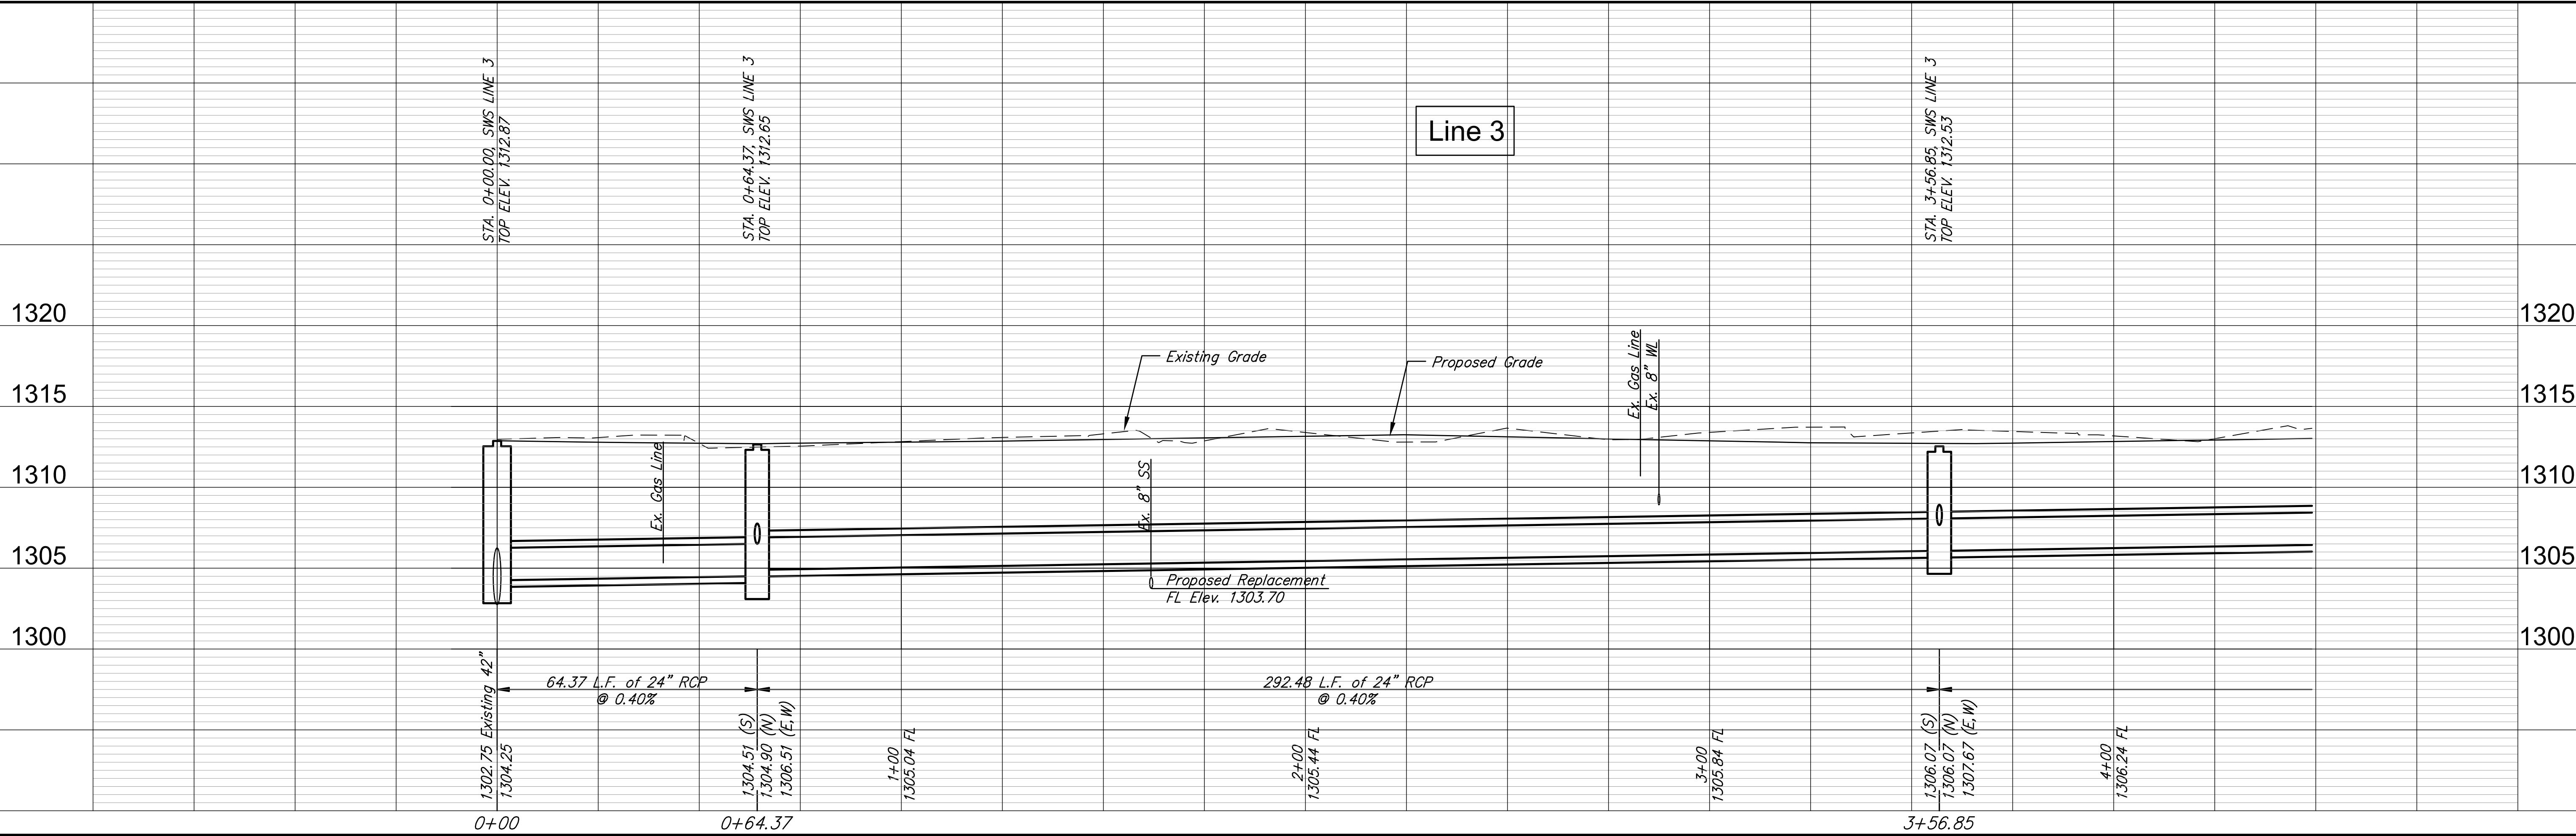

REVIEW

DESIGN KWL

PROJECT NUMBER 472-84914

DRAWING FILE

ENGINEERING BASE (SWS 2)

AMIDON IMPROVEMENTS
 SWS LINE 3
 WICHITA, KANSAS

DATE Oct. 23, 2014

RB JOB 3647T

SHEET 27 OF 133