


△XX LF - REMOVE "X" LF STORM SEWER PIPE.

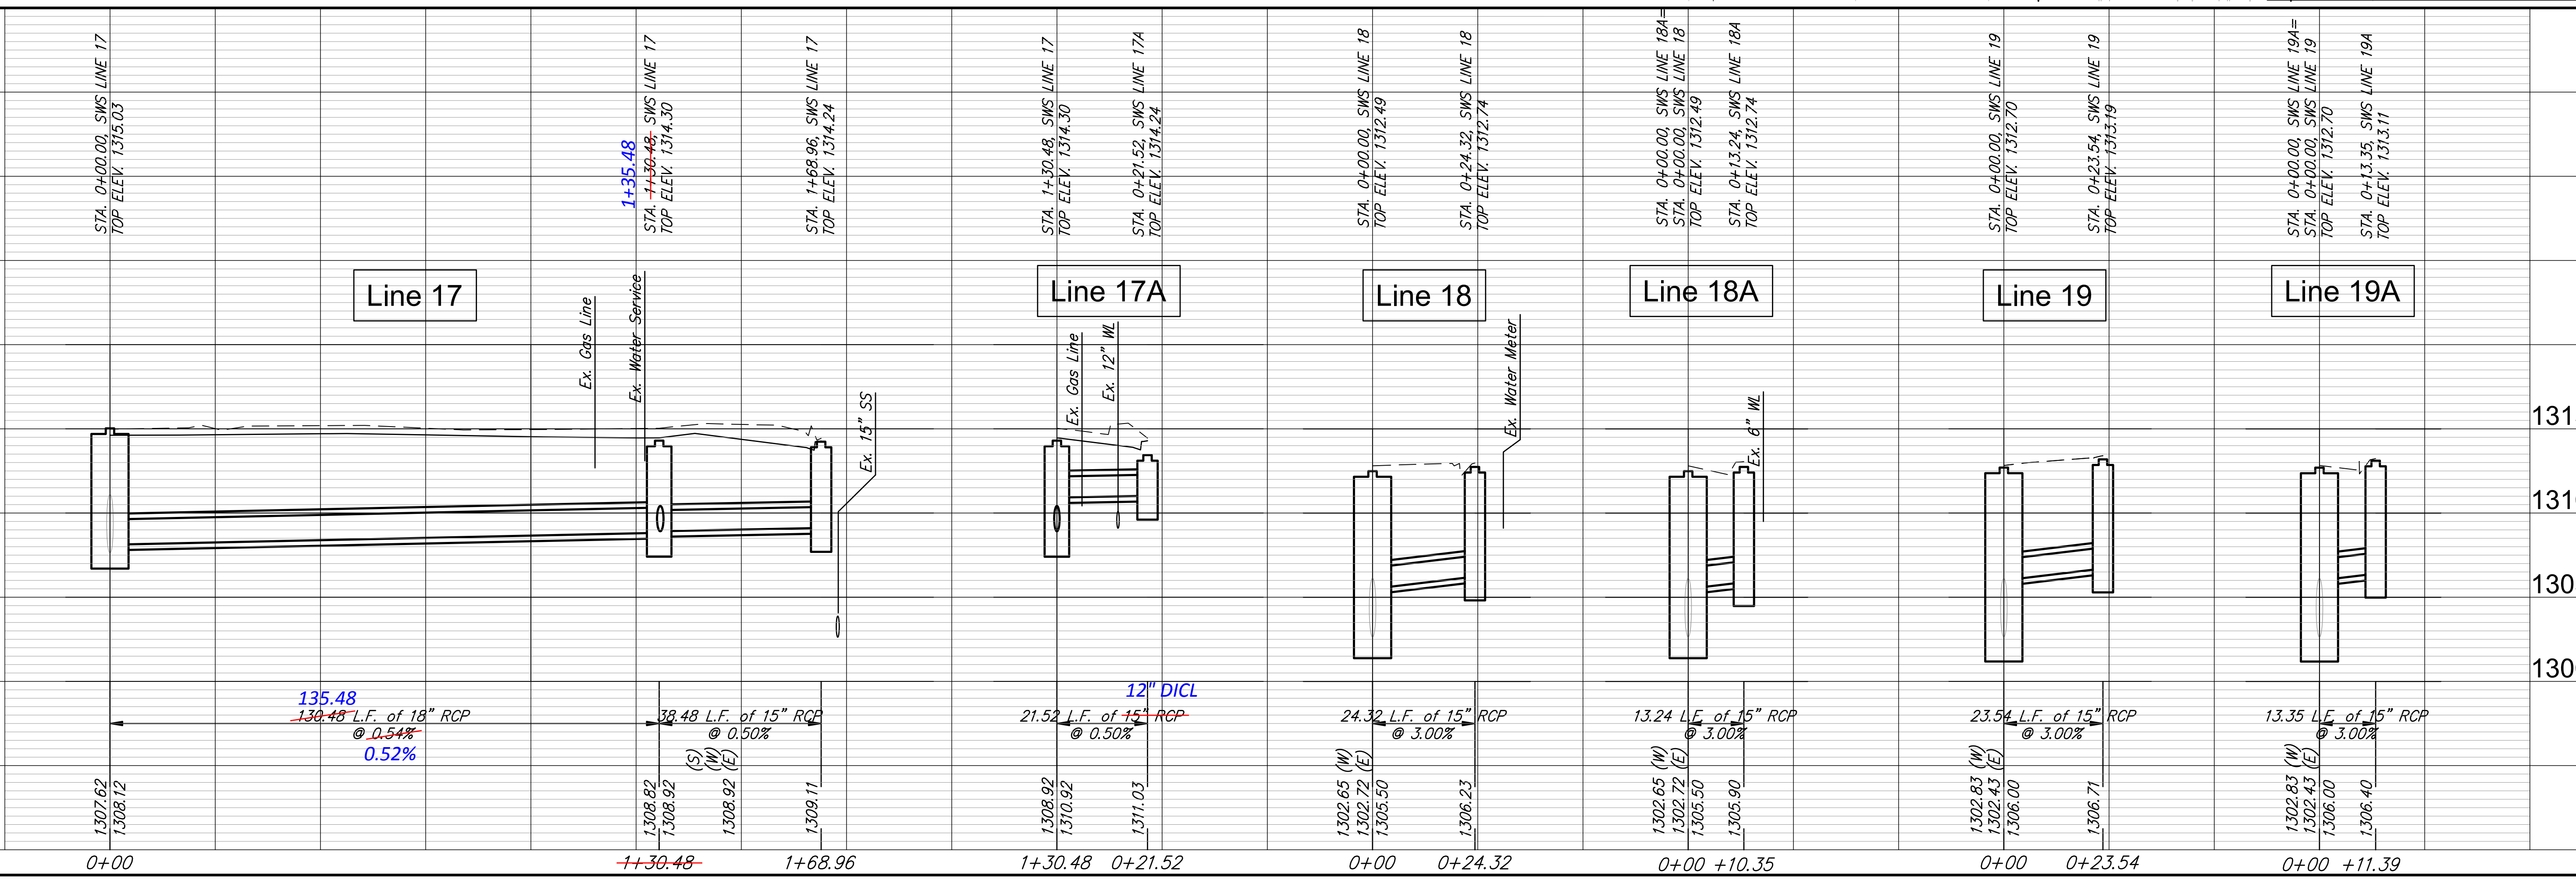

REVIEW: KWL
DESIGN: KWL
PROJECT NUMBER: 472-84914
DRAWING FILE: SWS LINE 17, 18, 19, 19A
ENGINEERING BASE: [SWS 12]
DATE: Oct. 23, 2014
DRAWN: RA

AMIDON IMPROVEMENTS
SWS LINE 17, 18, 19, 19A
WICHITA, KANSAS
37 OF 133