


GENERAL NOTES:

- The Contractor shall comply with all applicable safety regulations. All construction shall be completed following current City Standard Specifications and Special Provisions.
- Contractor will be required to provide notice to utility companies a minimum of seventy-two (72) hours prior to any excavation, as follows:
 Kansas One-Call 1-316-687-2470
 The Contractor must notify the following in case of an emergency:
 AT&T 1-800-246-8464
 Black Hills Energy 1-800-694-8989
 City of Wichita Water 1-316-268-4555
 City of Wichita Sewer 1-316-268-4073
 City of Wichita Stormwater 1-316-268-4090
 City of Wichita Traffic 1-316-268-4034
 Cox Communications 1-888-249-3530
 Kansas Gas Service 1-888-482-4950
 Westar Energy 1-800-544-4857
- Utility service lines, poles, etc. are to be adjusted as necessary by others prior to construction unless the plans specifically call for their adjustment by the Contractor or unless the plans specifically identify a utility to be adjusted by its owner during construction. Existing utilities and their location, as shown on the plans, represent the best information obtainable for design. The Contractor will be required to work around existing utilities within the right-of-way which do not conflict with proposed construction.
- Rubble from the removal of miscellaneous structures and excess excavation which is to be wasted shall be disposed of on sites to be provided by the Contractor. These sites shall be approved by the Engineer as to suitability, appearance and site location. Locations, in the opinion of the Engineer, that will leave an unsightly appearance will not be approved. All disposal sites must be approved by the Kansas Department of Health and Environment. Material either stockpiled or disposed of in a flood plain would require a Kansas State Board of Agriculture permit. Any material buried or stockpiled beyond approved construction limits would require additional archeological investigations unless buried in a previously approved borrow location.
- Trees and shrubs in public right-of-way which are in direct conflict with proposed new construction shall be removed by the Contractor with the Engineer's approval. Trees and shrubs which are not in direct conflict with proposed new construction shall be saved and protected from damage.
- The Contractor shall give all property owners and/or tenants of developed property abutting the construction of this project a minimum of ten (10) days notice prior to start of construction.
- The Contractor shall be responsible for preserving property irons. The Contractor will be required to re-establish any property irons which are damaged or destroyed by his construction operations. Such irons shall be re-established by a licensed land surveyor in accordance with state laws.
- The Water Distribution Division shall field locate water valves one time during construction when requested by the Contractor. It shall be the Contractor's responsibility to preserve such field locations during the construction process. Water valves, valve boxes or fire hydrants damaged during construction shall be repaired by Contractor at his own expense. Valves boxes and water meters within the project limits shall be adjusted to match field grades.
- The Contractor shall notify the consultant engineer and Tom Mason with the City at 316-268-4574 with the anticipated construction start date and notify them of project completion. Staking and inspection for this project will be the responsibility of the Contractor.
- If traffic is impacted by construction, a traffic control plan must be submitted and approved by the City Traffic Engineer, Brian Coon at traffic@wichita.gov before construction can begin. The Contractor shall be responsible for all traffic control measures to facilitate construction. All construction zone markings and signage shall conform to the latest version of the Manual on Uniform Traffic Control Devices (MUTCD) as published by the US Dept. of Transportation, Federal Highway Administration. All costs associated with construction markings and signage shall be the Contractors responsibility.
- All elevations shown are U.S.G.S. Datum (NGVD 88).
- All areas disturbed during construction that will not be under proposed pavement shall be restored to match existing conditions.

- A portion of excess excavated material shall be mounded around manholes which extend more than one (1) foot above the existing ground. Such mound shall be constructed with new development a six (6) foot diameter flat top with 4 to 1 side slopes down to the original ground. The elevation of the flat top of the mound shall be 0.4 foot below the top of the manhole.
- Geotechnical report available upon request.
- Contractor shall limit the extent of trench openings overnight and weekends to less than 50 feet.
- Contractor shall provide positive drainage away from all manhole covers.
- City maintenance of storm sewer ends at right-of-way or easement line.
- Any sidewalk, drive approach, or street pavement removed to construct project must have a pavement cut permit and be replaced by the City contractor. Permits can be obtained by calling 316-268-4501 or 316-268-4480.
- The inspection firm shall submit to the City Stormwater Maintenance Division a digital copy of the CCTV inspection of the conduits and structures following construction. The digital file formation shall be compatible with the City input template. A copy of the template is available upon request at 316-268-4090.

STORM SEWER IMPROVEMENTS
 to serve
Lot 12, Comotara Industrial Fifth Addition
CITY OF WICHITA, KANSAS
 Gary Janzen, P.E., City Engineer
 0300 PPD (607861)



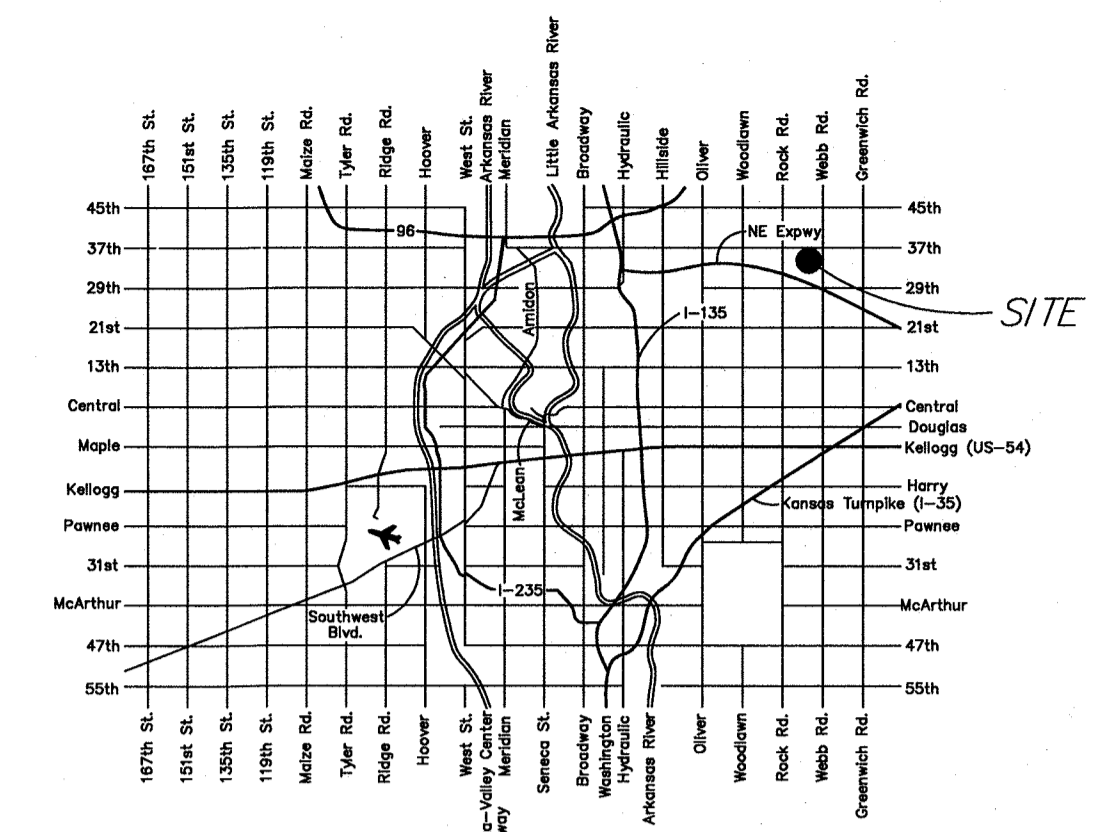


Vicinity Map
Index of Sheets:

- 1.0 Cover Sheet
- 2.0 Grading Plan
- 3.0 ERU Plan
- 4.0 Line 1
- 4.1 Line 2
- 5.0 Drainage Plan
- 5.1 36FTB Snout Detail
- 5.2 24F Snout Detail
- 6.0 Drop Inlet Detail
- 6.1 Type 1 Curb Inlet Detail
- 7.0 Erosion Plan
- 7.1-7.5 Erosion Control BMP Details (attached or available on City's website) Plat
- 8.0

AS BUILTS

Contractor: Ewertz Excavation 4/24/2015	Project Inspector: Tom Jones KEMILLER ENGINEERING PA 117 E. Lewis, Wichita, KS 67202 (316)264-0242
--	---

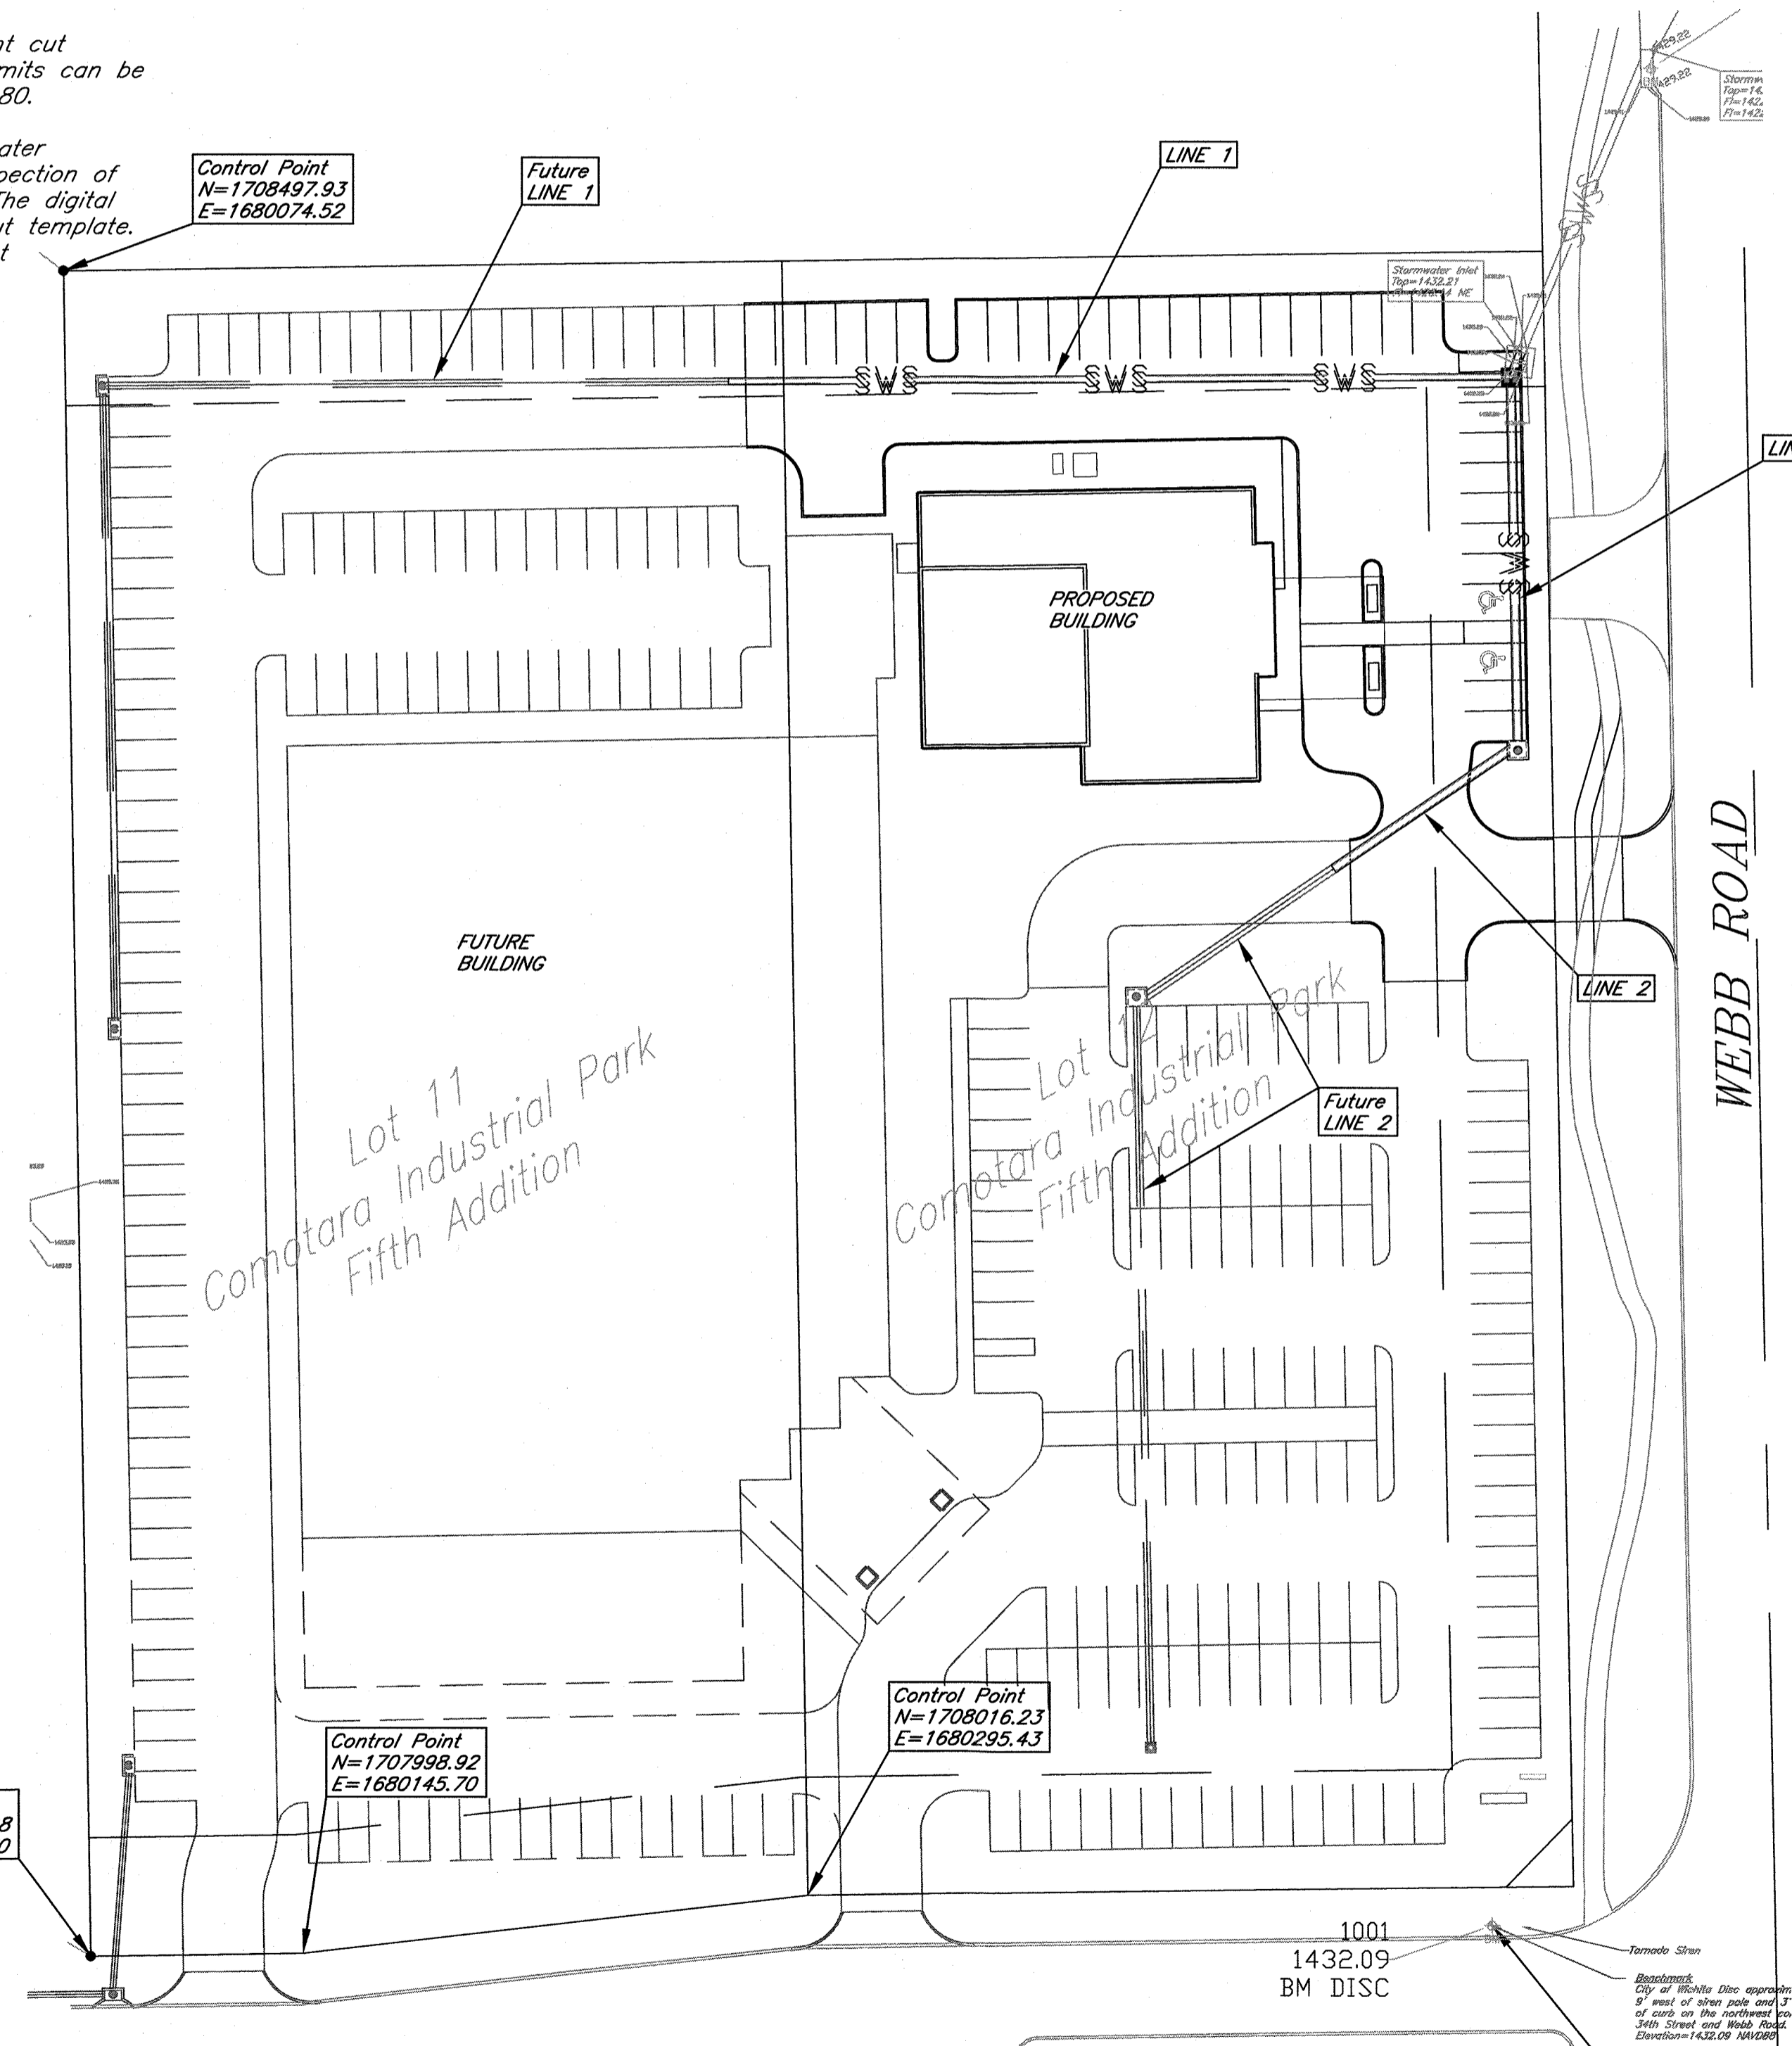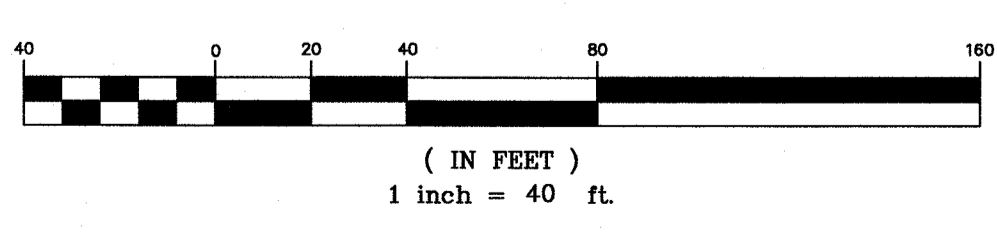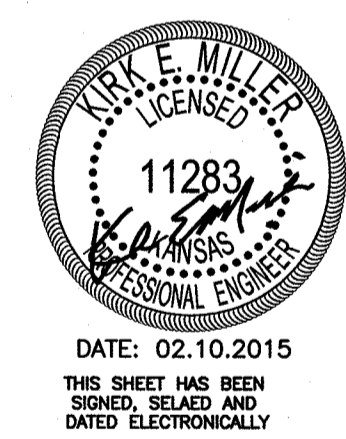

Stormwater Certification:
 New Development or Redevelopment

These construction plans were prepared in accordance with the current Stormwater Management Regulations as set forth in the City of Wichita's Stormwater Management Ordinance 16.32 and the policies/guidelines presented in the Wichita/Sedgwick County Stormwater Manual.

Disturbed Area: 37789 sq. ft.
 Water Quality Treatment: BMP Snout
 Downstream Channel Protection: N/A
 Detention:
 The BMP used for this development is Snout.

Benchmark:

City of Wichita Disc approximately 9' west of siren pole and 3' north of curb on the northwest corner of 34th Street and Webb Road.
 Elev. = 1432.09 NAVD88

APPROVED AS NOTED
 BY WICHITA PUBLIC WORKS ENGINEERING AND STORMWATER DIVISION

Engineering *Rebecca Sivil* 2/12/2015
 Stormwater *[Signature]* 02/13/15


NOTE TO CONTRACTORS

Installation, inspection and testing for this project is to be provided by a Licensed Consulting Engineering Firm under contract with the Owner/Developer. Said inspection to be in accordance with the City of Wichita standard construction engineering practices and certified by a Licensed Professional Engineer in the state of Kansas. No work shall be performed in dedicated easements or public right-of-way by the Contractor without such inspection nor shall any work be commenced without written authorization by the City Engineer. All Construction and Materials shall comply with the City of Wichita Specifications and Standards (on file and available in the City Engineer's Office).

An approved copy of these plans signed by City staff are required on-site.

34th STREET NORTH **January 2015**

KEMILLER
 ENGINEERING PA
 117 E. Lewis, Wichita, KS 67202 (316)264-0242

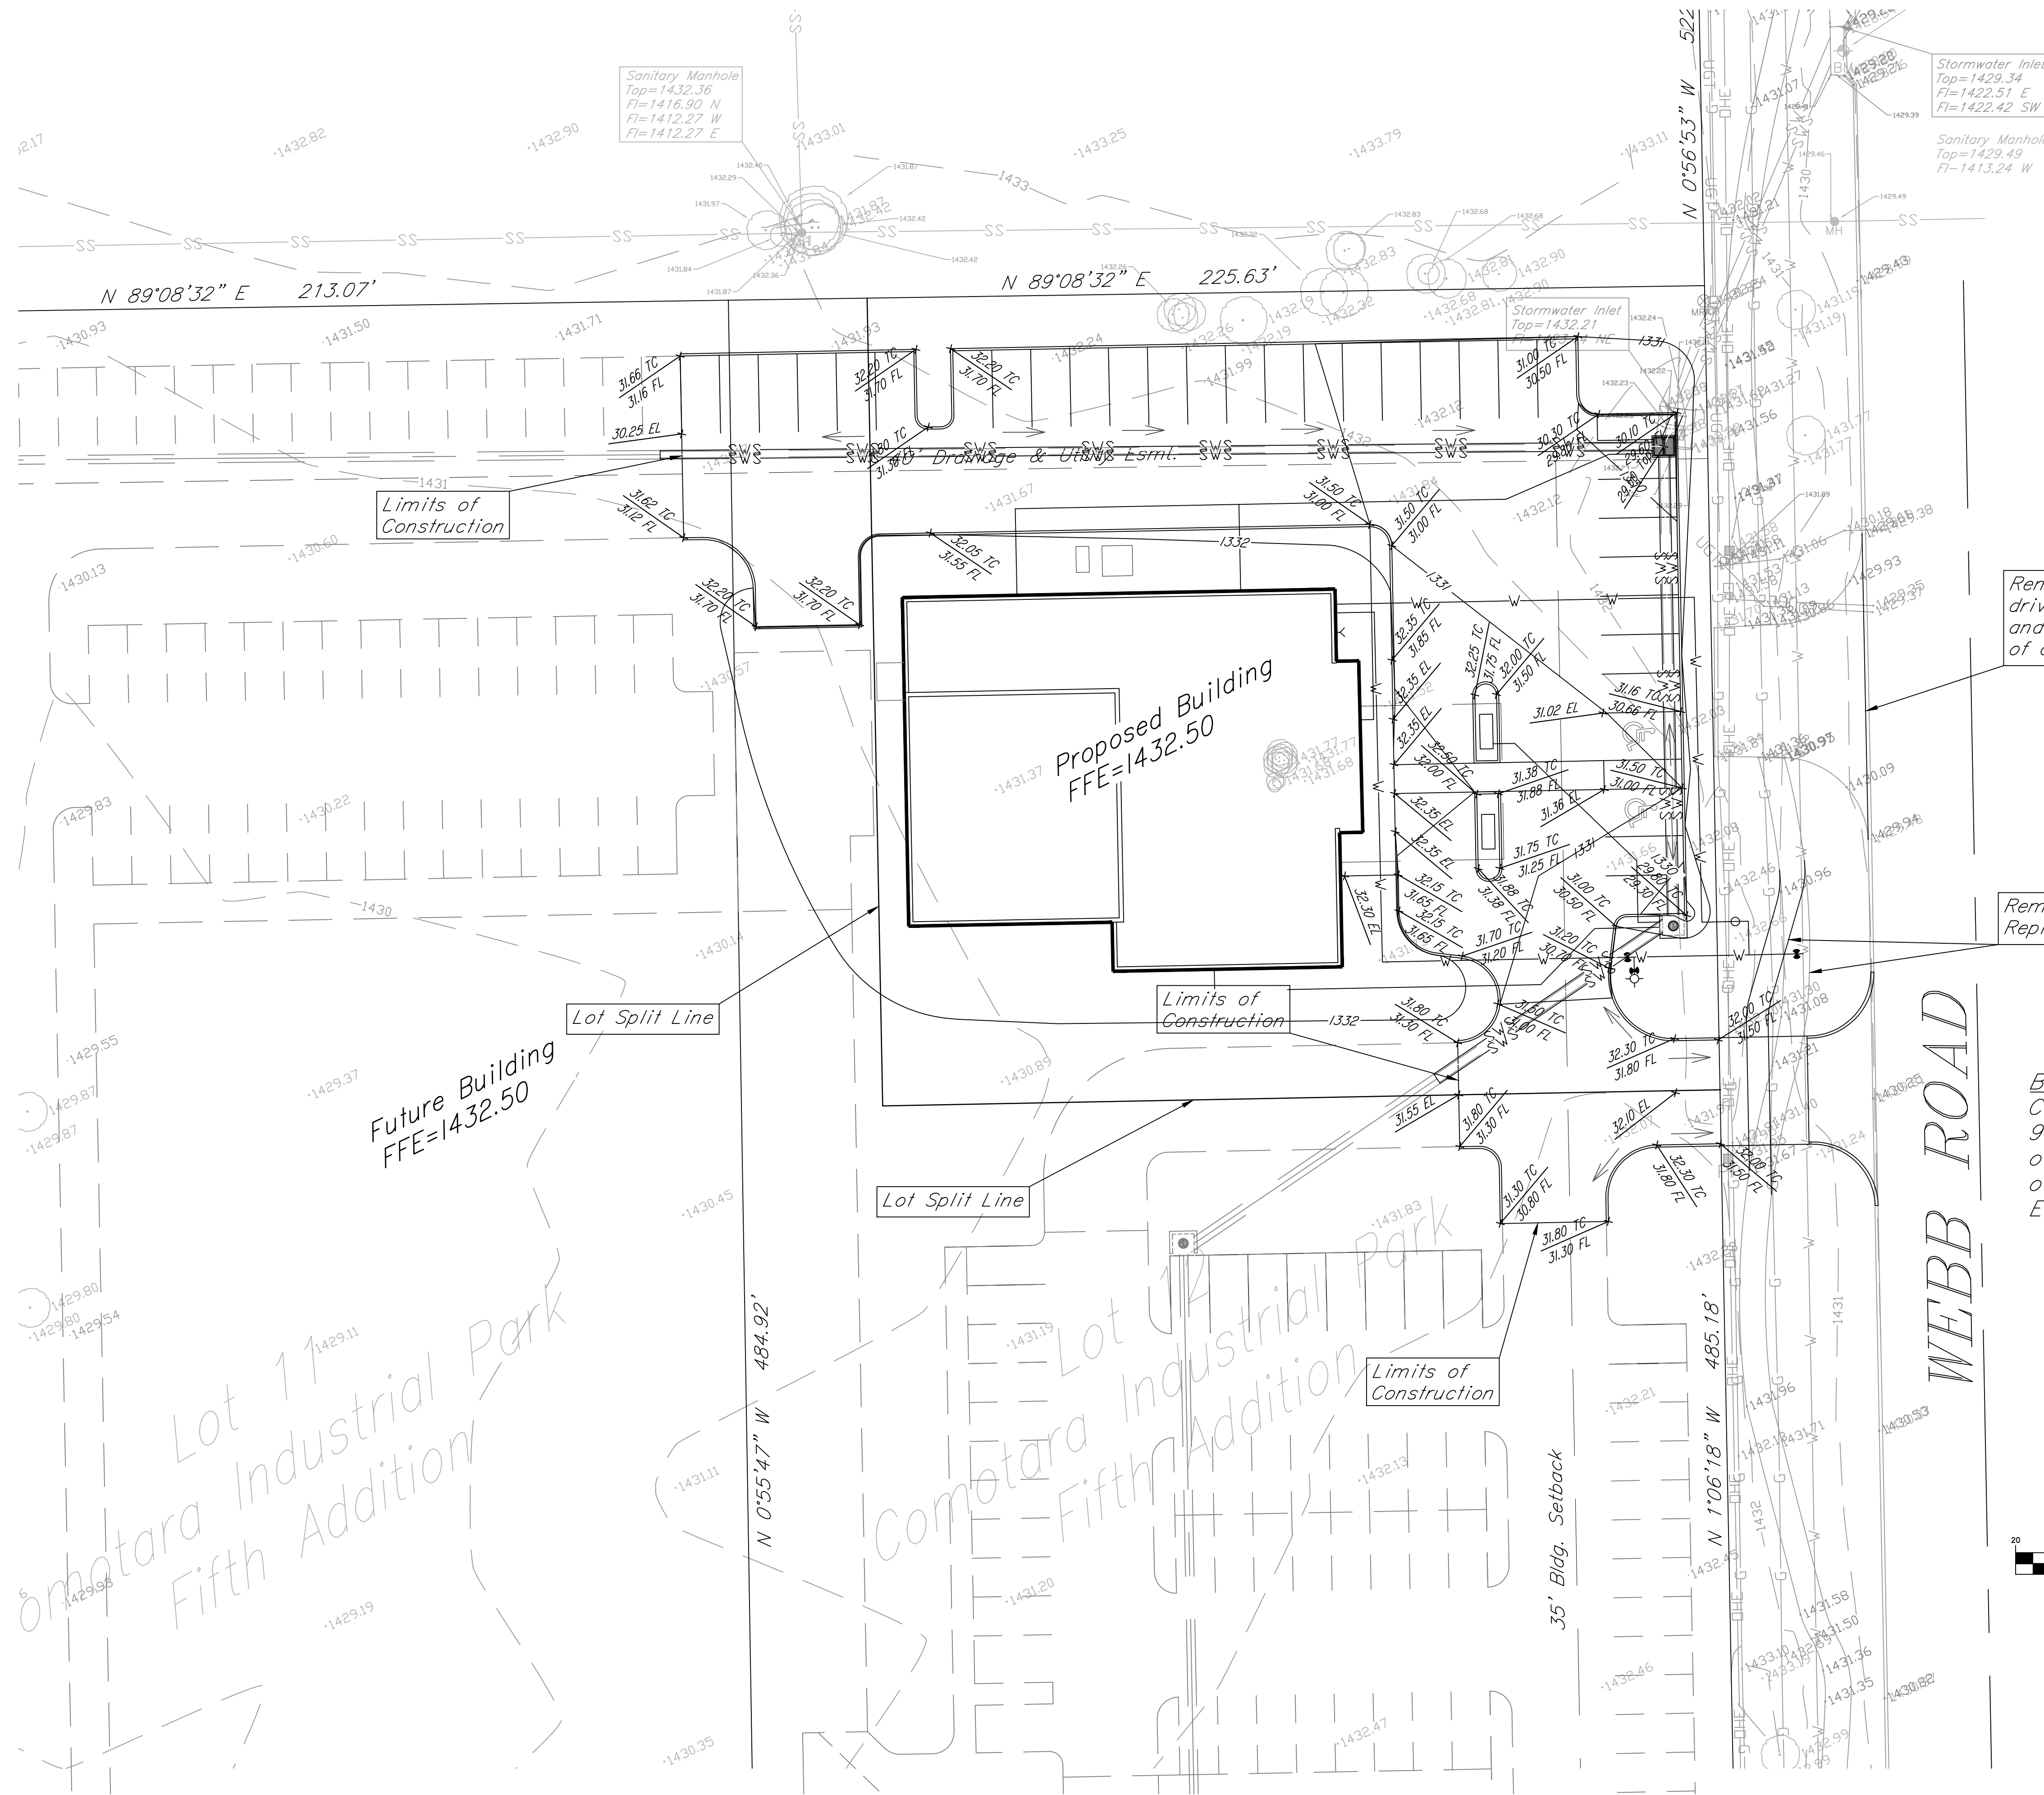


Grading Legend:

- EP = Edge of Pavement
- EL = Elevation
- FL = Flow Line
- TC = Top of Curb
- SW = Top of Sidewalk
- TP = Top of Pavement
- TW = Top of Wall
- FFE = Finish Floor Elevation
- Flow Arrows



Remove existing drive approach and install 71 LF of curb and gutter.

Remove and Replace Sidewalk

Benchmark
 City of Wichita Disc approximately 9' west of siren pole and 3' north of curb on the northwest corner of 34th Street and Webb Road.
 Elevation=1432.09 NAVD88

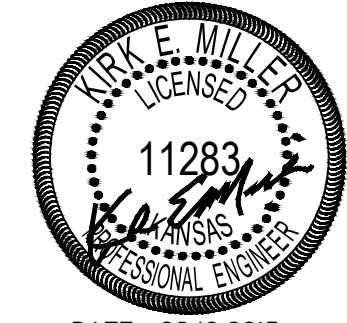

DATE: 02.10.2015
 THIS SHEET HAS BEEN SIGNED, SEALED AND DATED ELECTRONICALLY

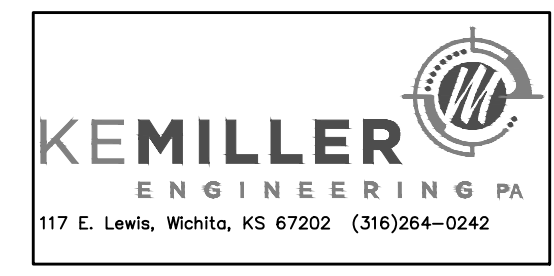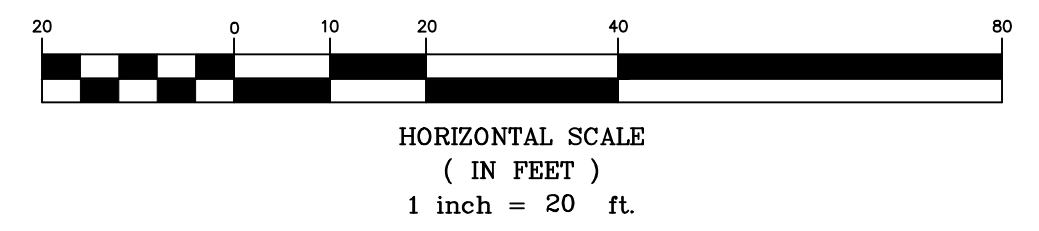

WDM Architects P.A.
 105 North Washington
 Wichita, KS 67202-2815
 T 316.262.4700
 F 316.262.0002
 wdmarchitects.com

We do more

**Outpatient Cath Lab Shell Building
 Heartland Cardiology**


Wichita, Kansas

PRINTS ISSUED
 11-05-14 Shell Bldg for Tenant Finish
 01-12-15 For Bidding

WDM No. 14089
 drawn: rlf
 checked: rfm

Grading Plan



2.0

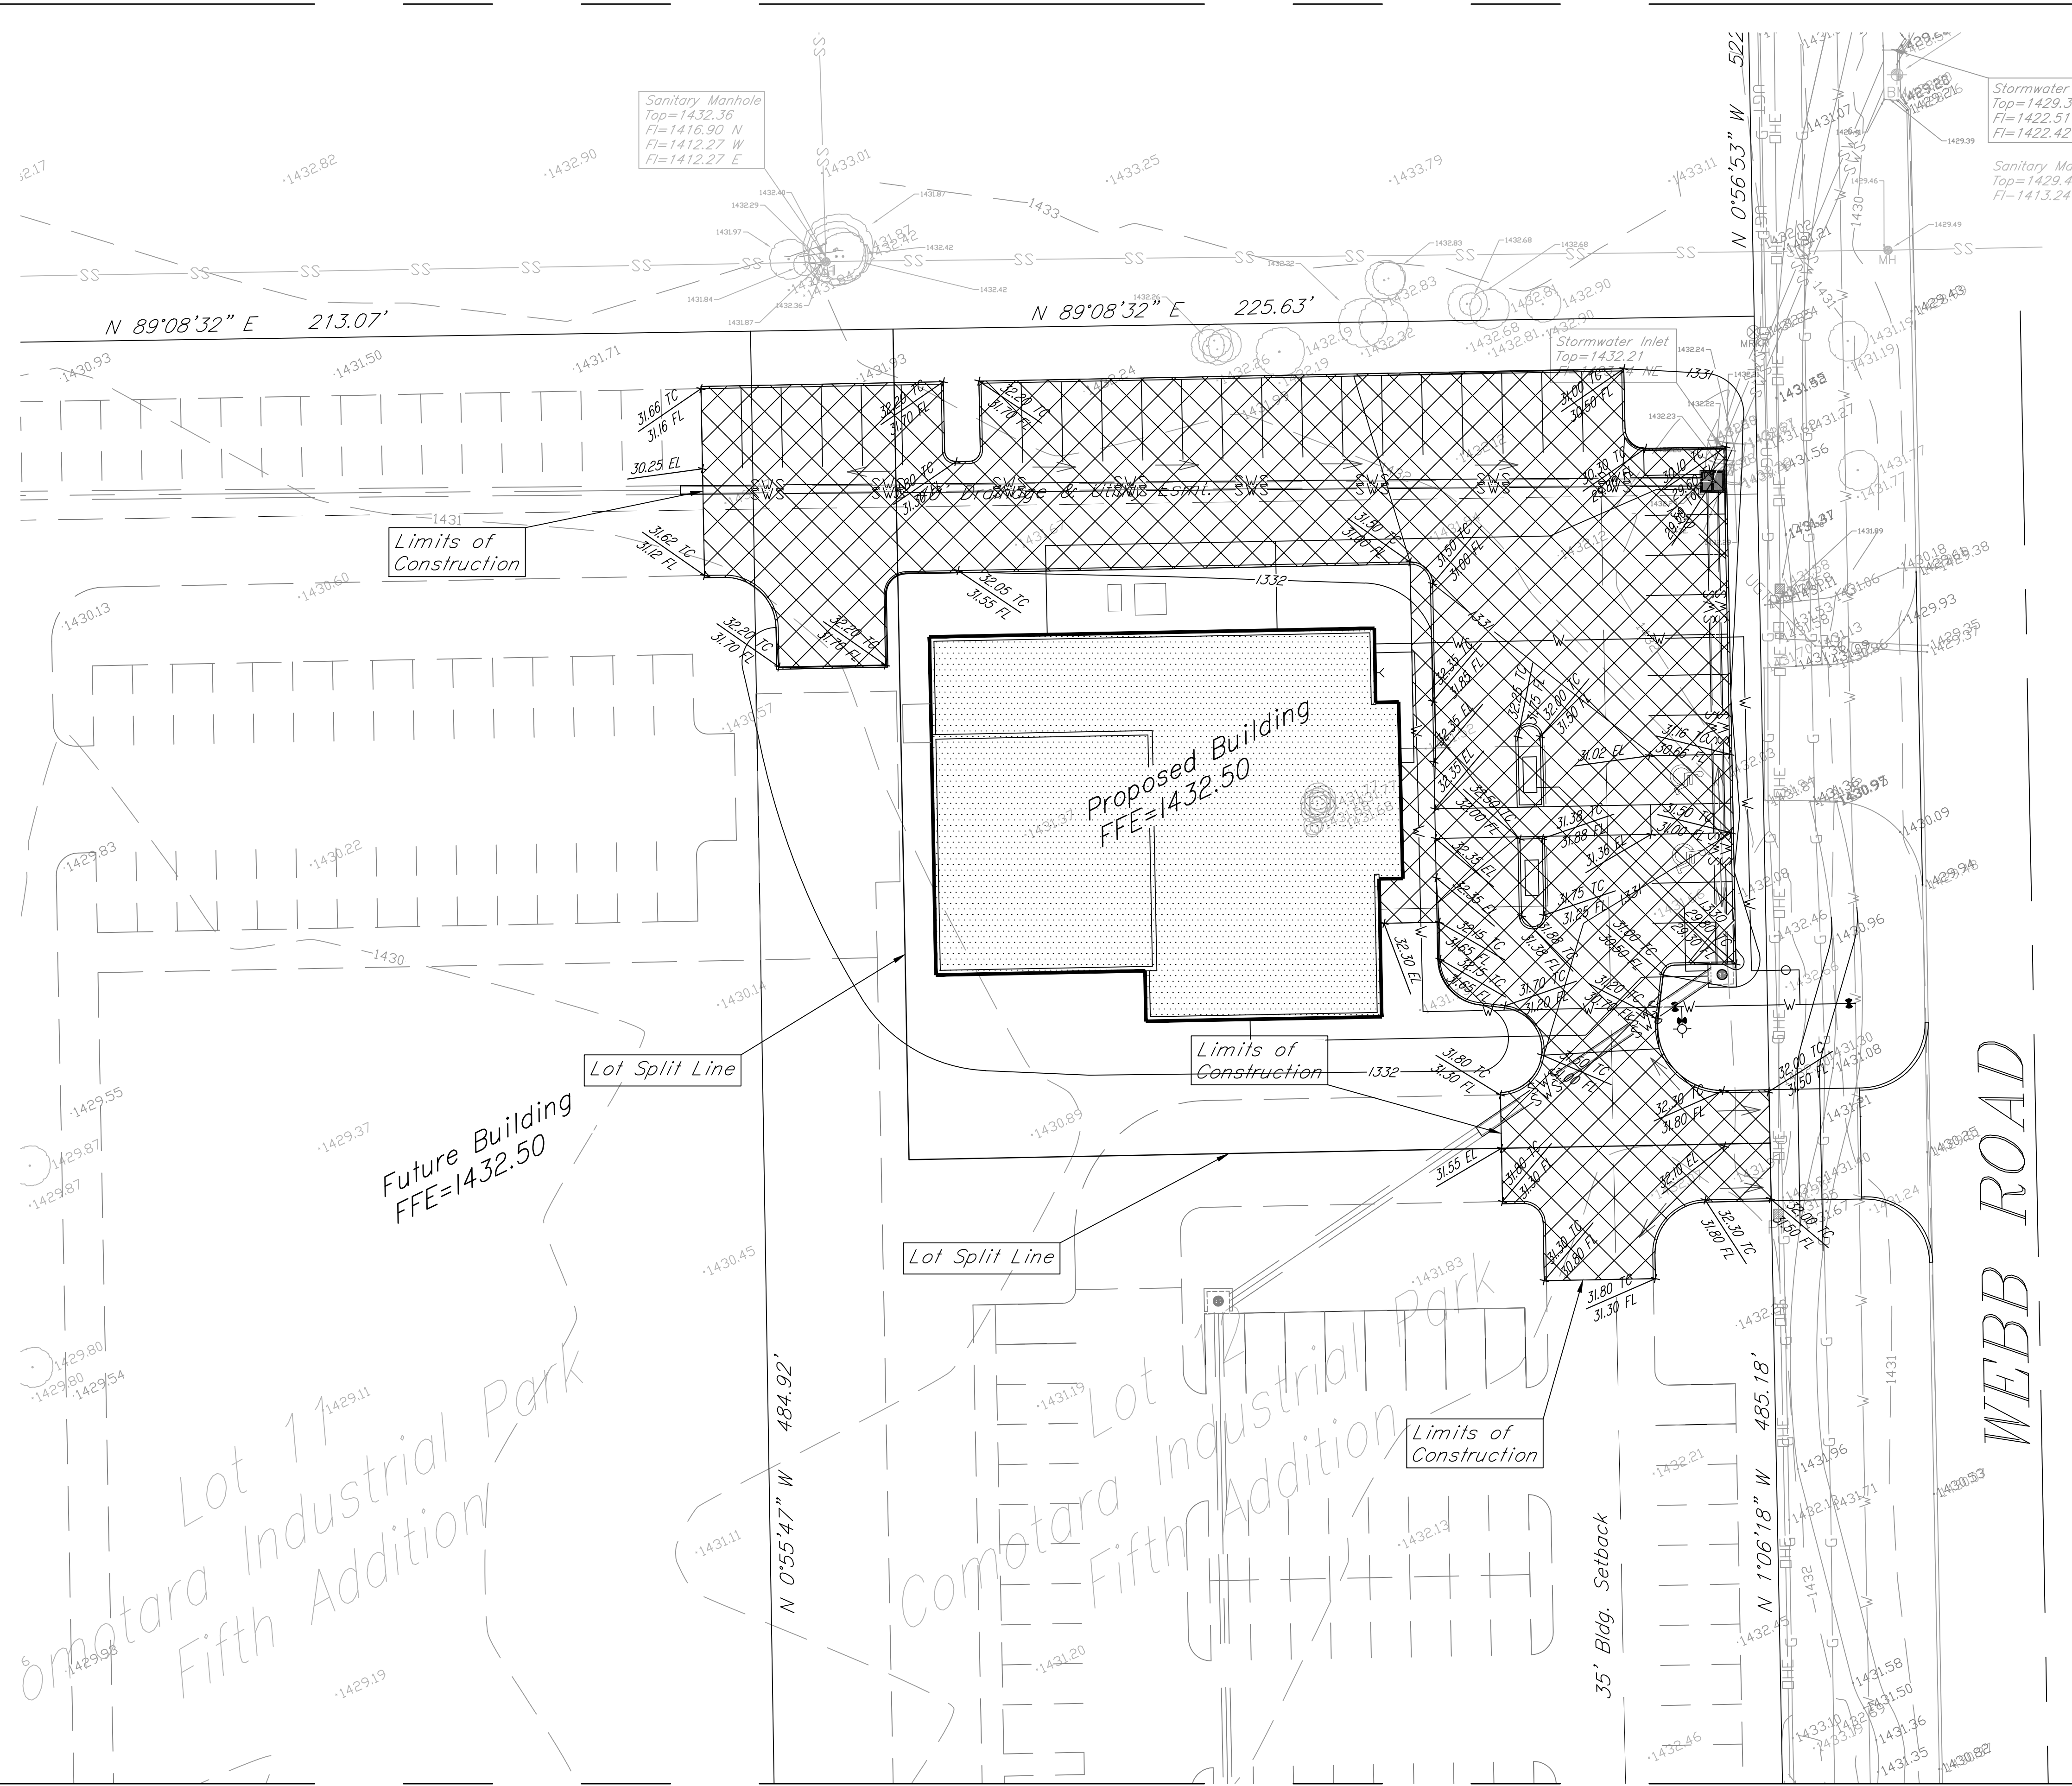

ERU Calculations:

Ex. Impervious Area =	0.0 sq. ft.
Total Lot Area =	215191.42 sq. ft.
Proposed Building Area =	8408.92 sq. ft.
Proposed Parking, Sidewalks, and Other Impervious Areas =	19520.61 sq. ft.
Total Impervious Area =	27929.53 sq. ft.
(Post Construction)	
Net Increase in Impervious Area =	27929.53 sq. ft.


Hatching Legend:

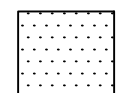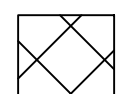-  Building Area
-  Parking, Sidewalks, and Other Impervious Area




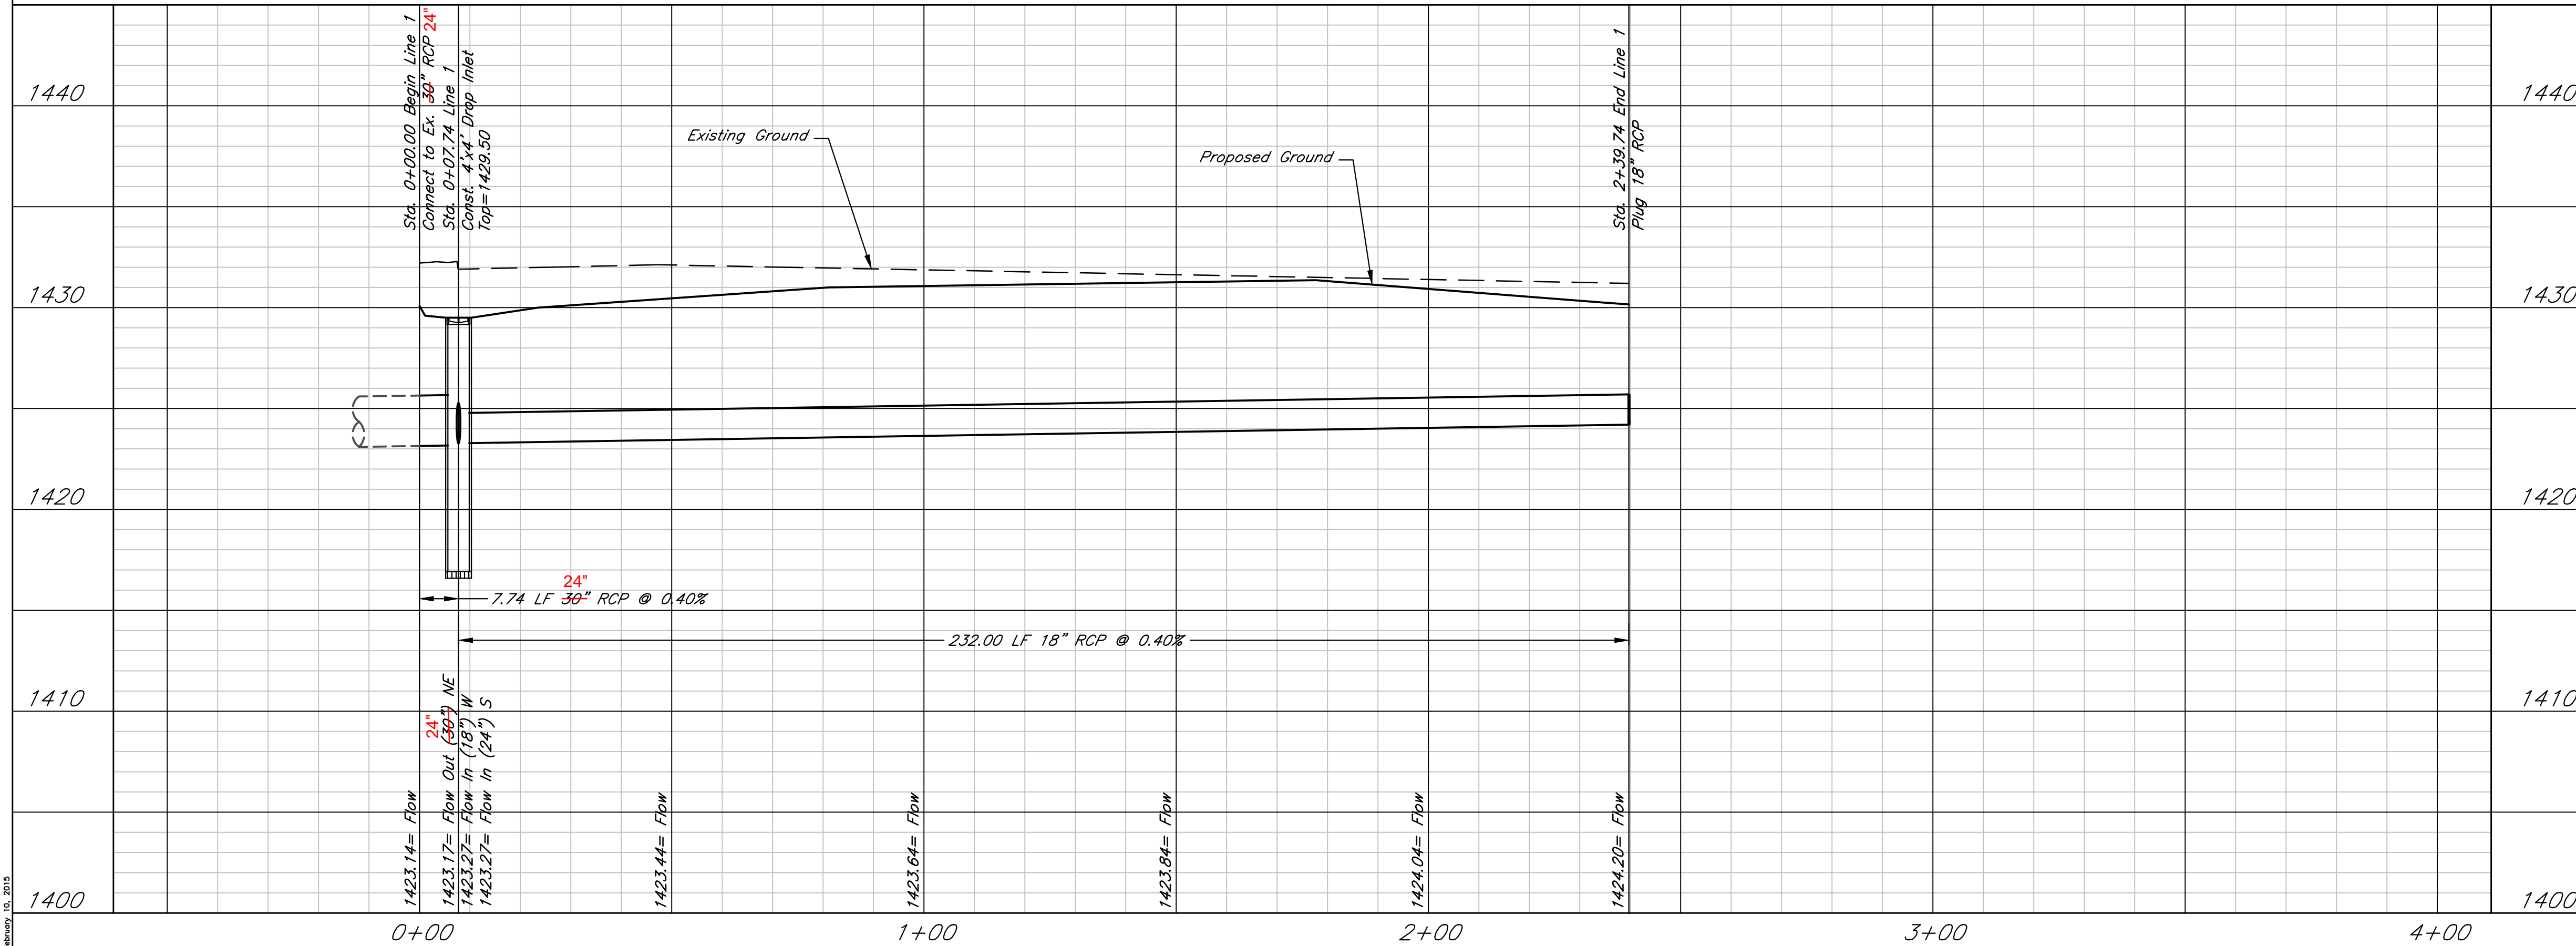
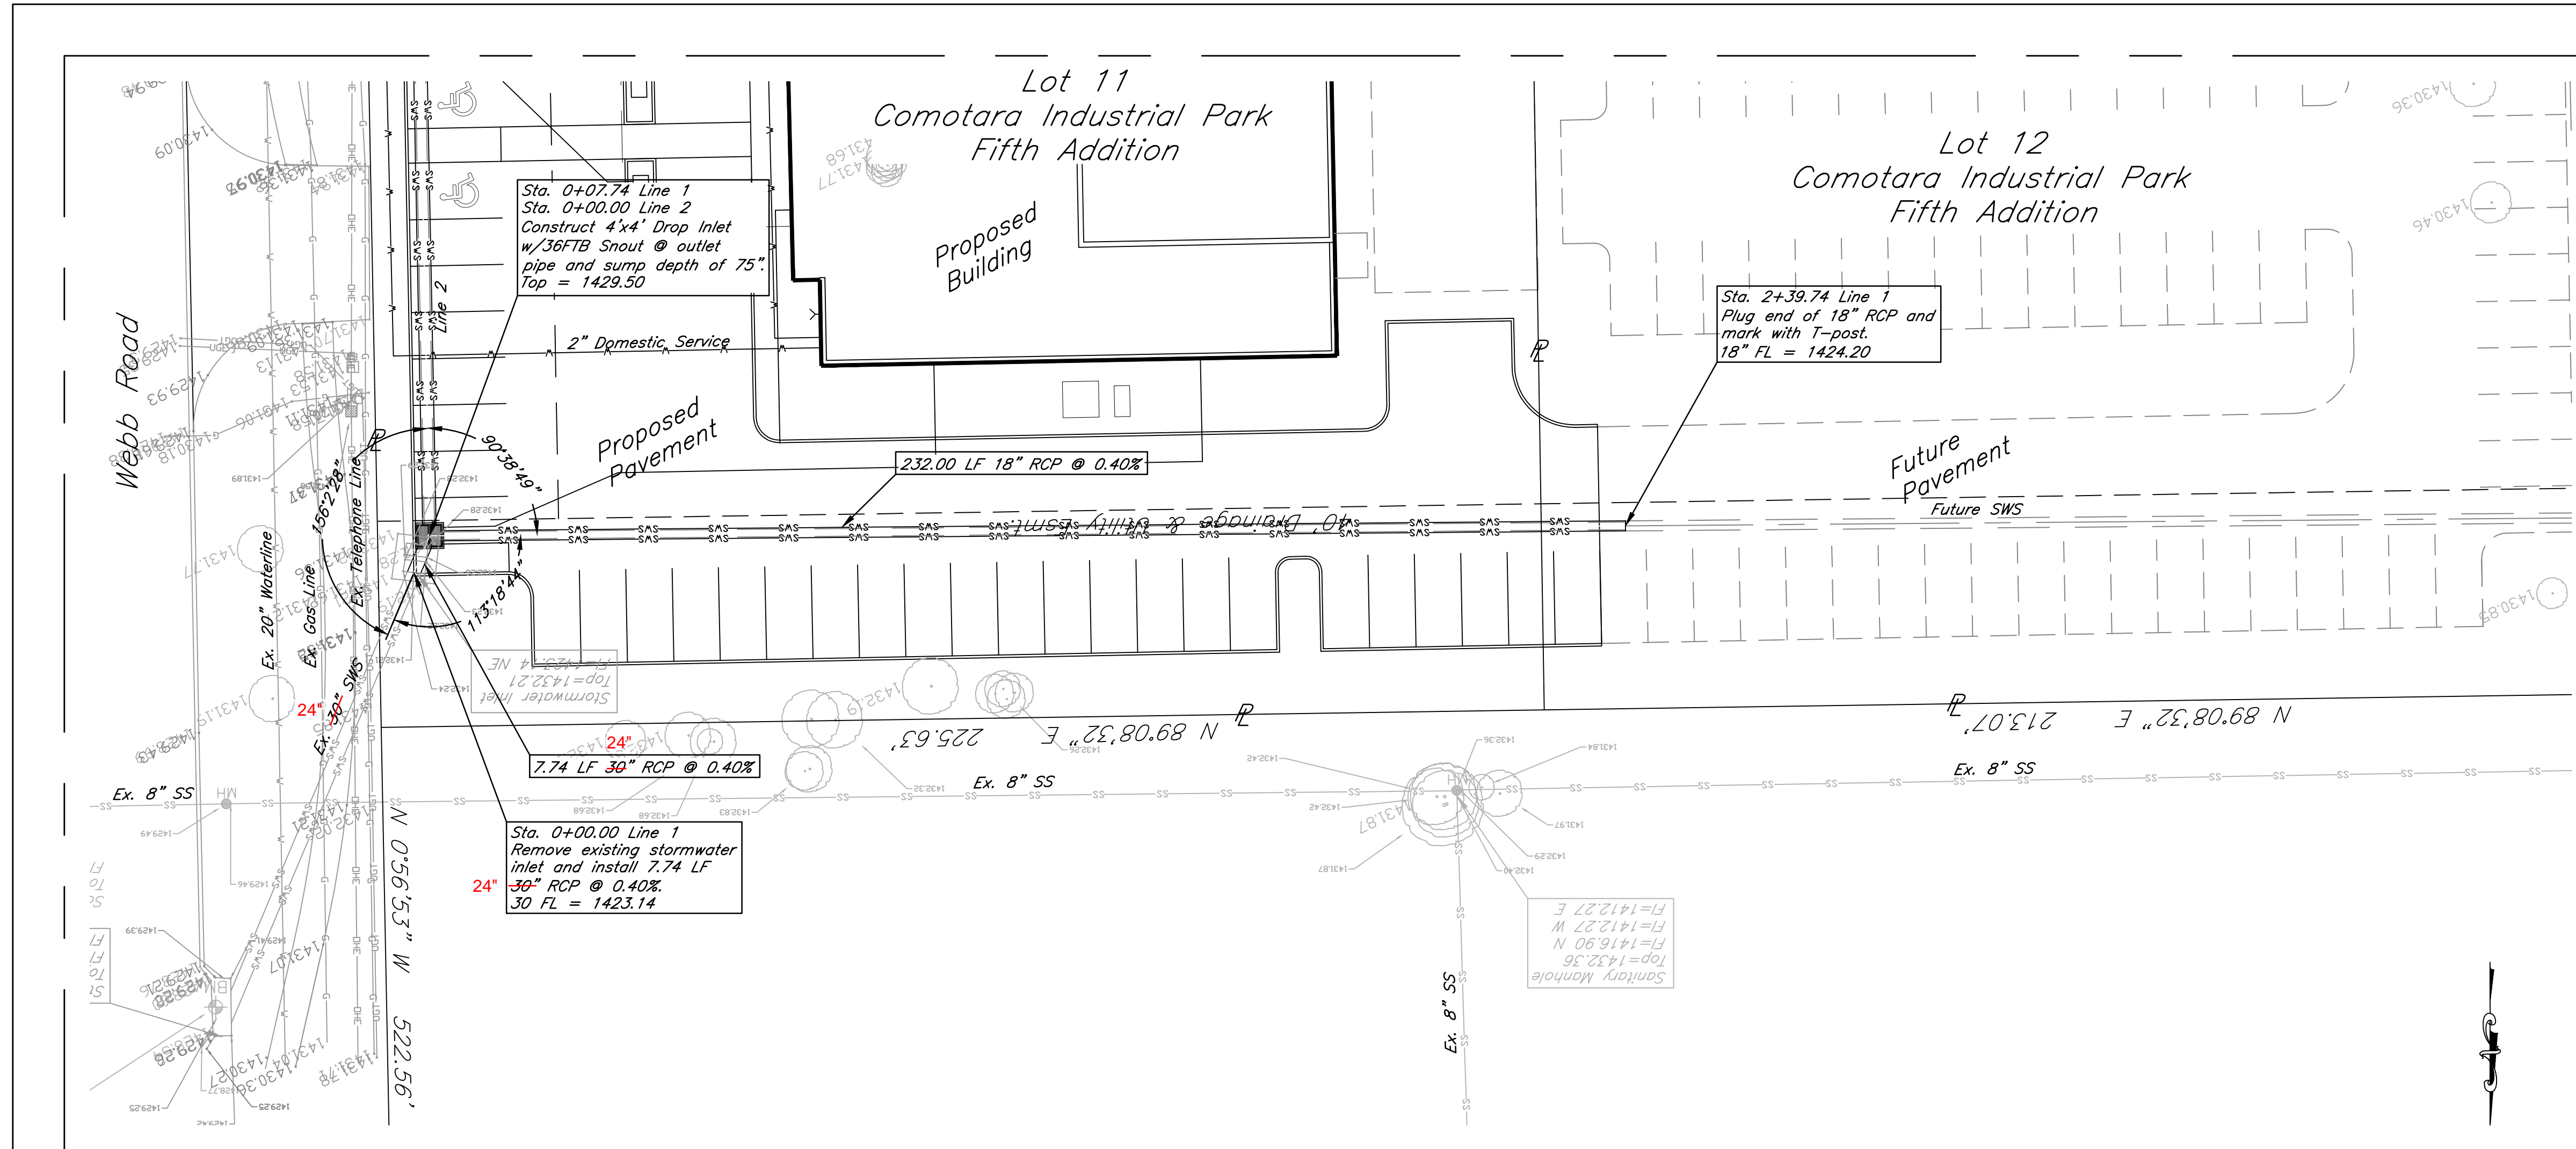
DATE: 02.10.2015
THIS SHEET HAS BEEN
SIGNED, SEALED AND
DATED ELECTRONICALLY

Benchmark
City of Wichita Disc approximately
9' west of siren pole and 3' north
of curb on the northwest corner
of 34th Street and Webb Road.
Elevation=1432.09 NAVD88

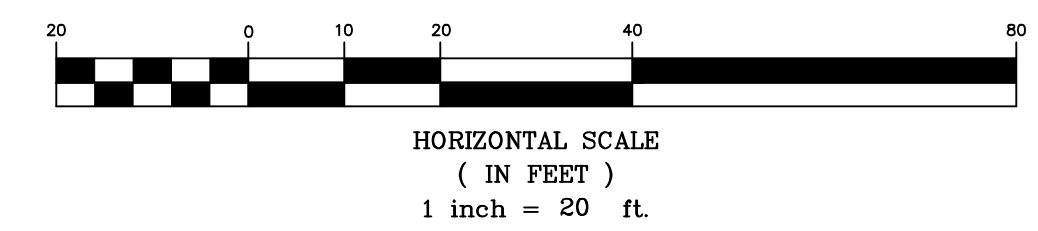

**Heartland Cardiology
ERU Plan
Wichita, Kansas**

 117 E. Lewis, Wichita, KS 67202 (316)264-0242	PROJECT NUMBER 0300 PPD (607861)		SHEET 3.0
	KEM NO. 14186	FILE	
DESIGN KM	DRAWN MP	REVISED	




AS BUILTS

117 E. Lewis,
Wichita, KS 67202 (316)264-0242





DATE: 02.10.2015
THIS SHEET HAS BEEN
SIGNED, SEALED AND
DATED ELECTRONICALLY

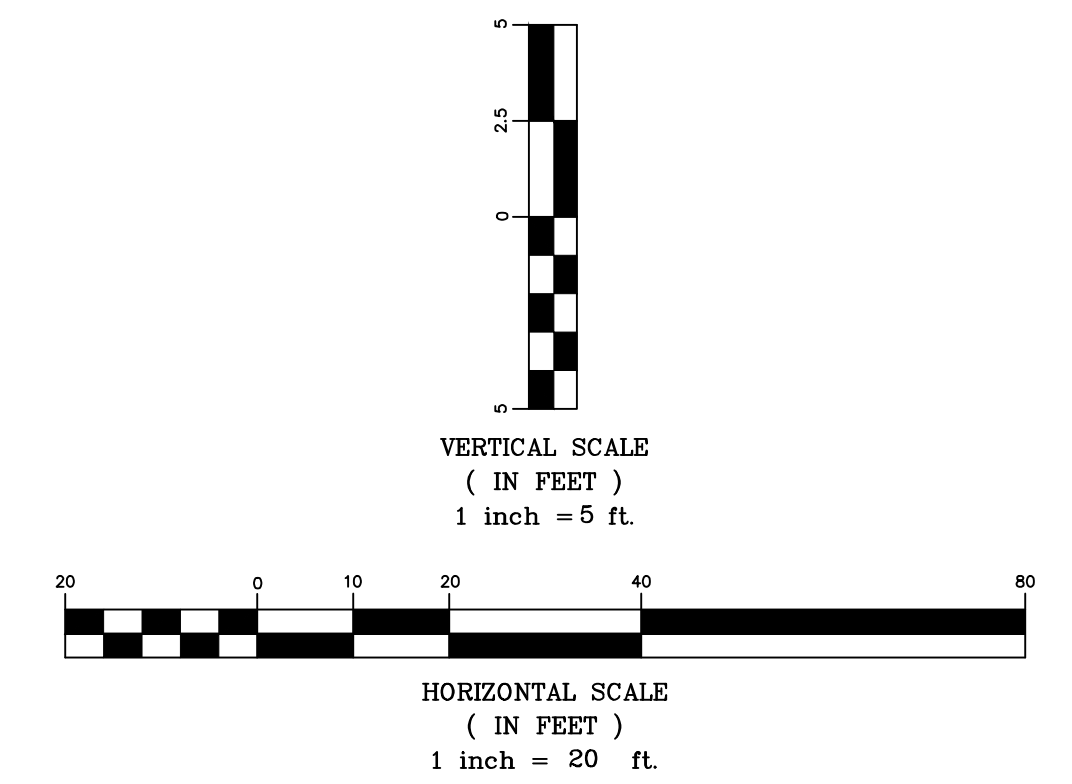

Heartland Cardiology
Plan and Profile
Wichita, Kansas

	PROJECT NUMBER 0300 PPD (607861)			SHEET 4.0
	KEM NO. 14176 DESIGN KM	FILE DRAWN MP	DATE 01/2015 REVISED	


February 10, 2015

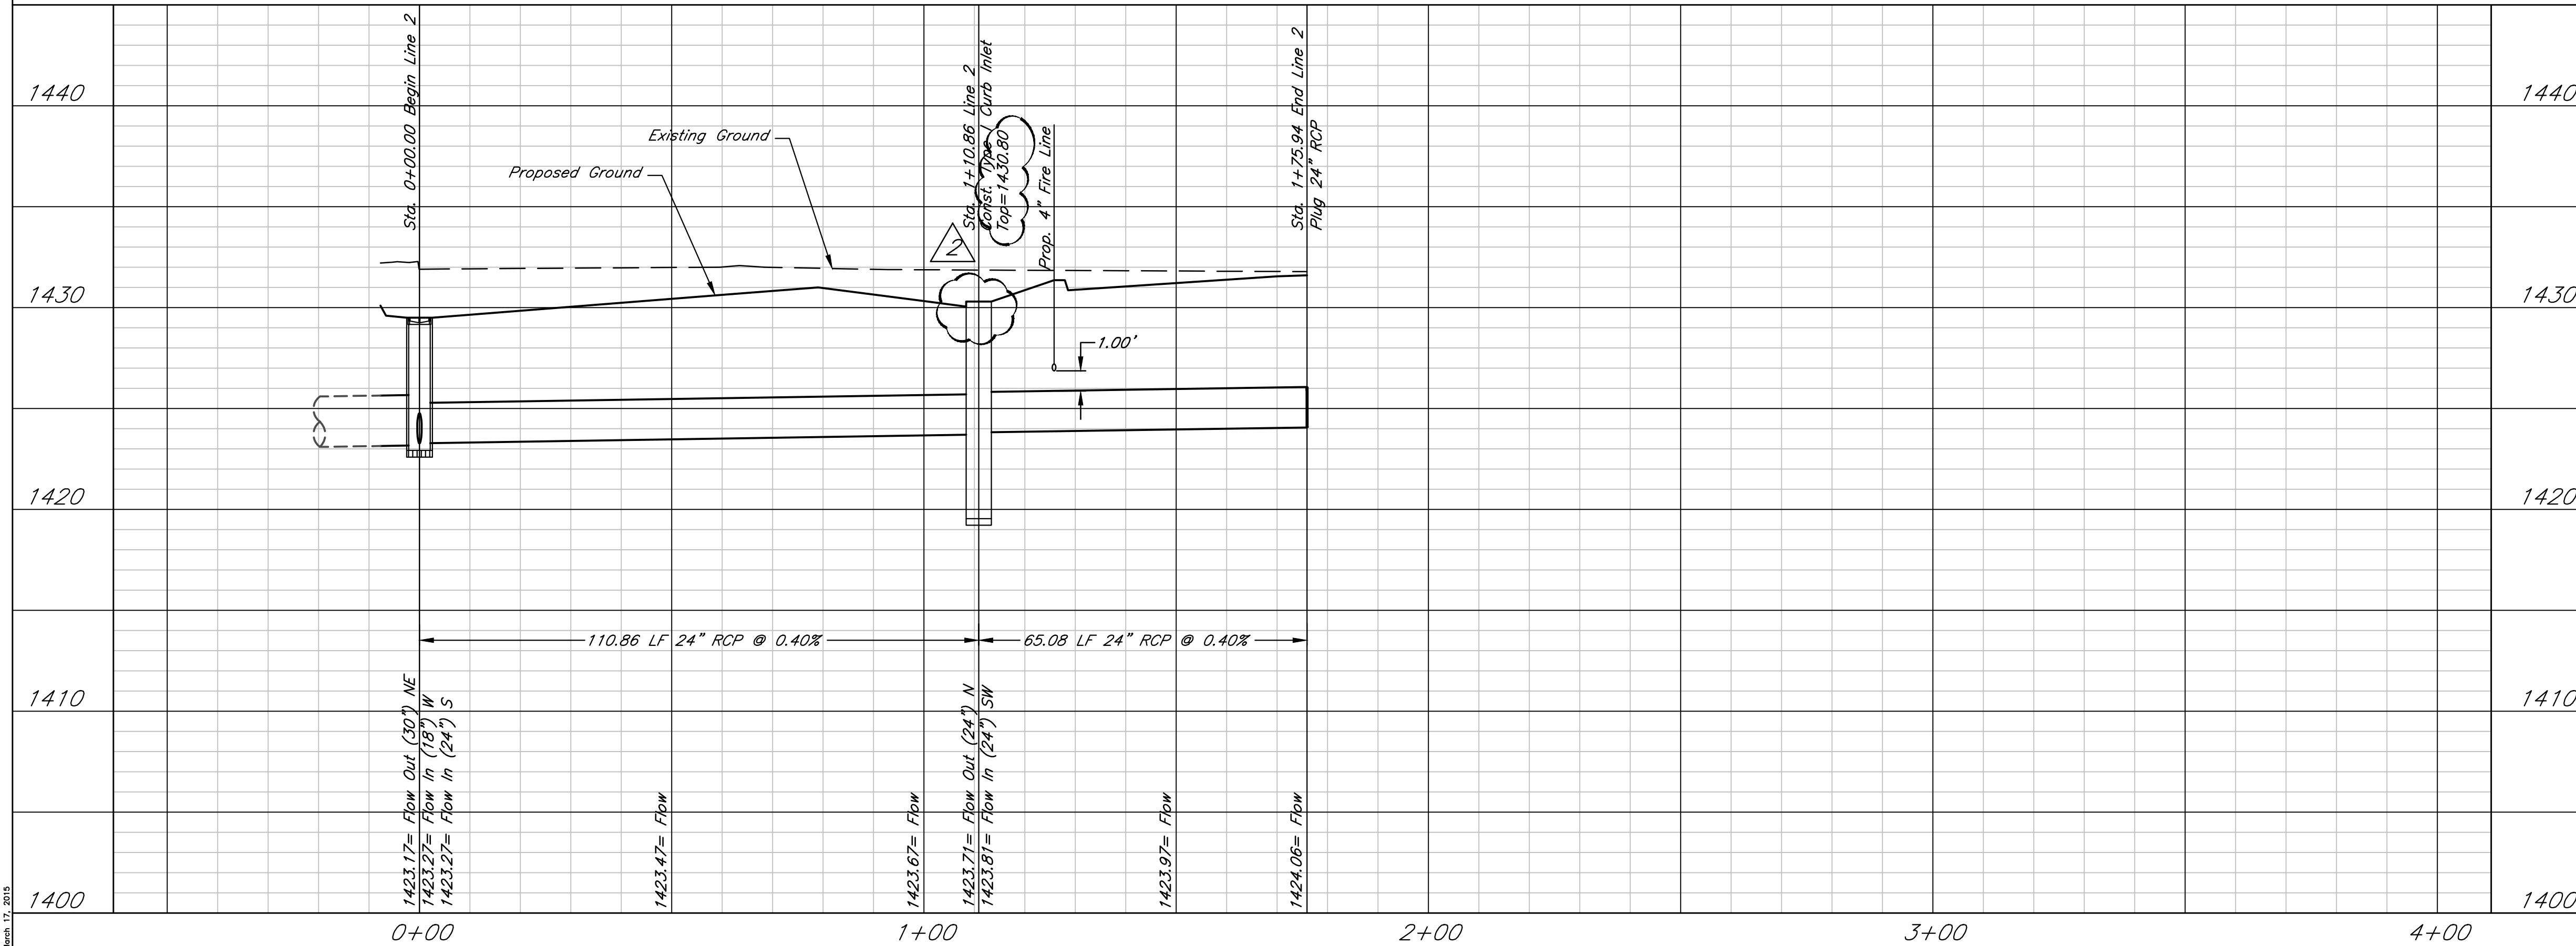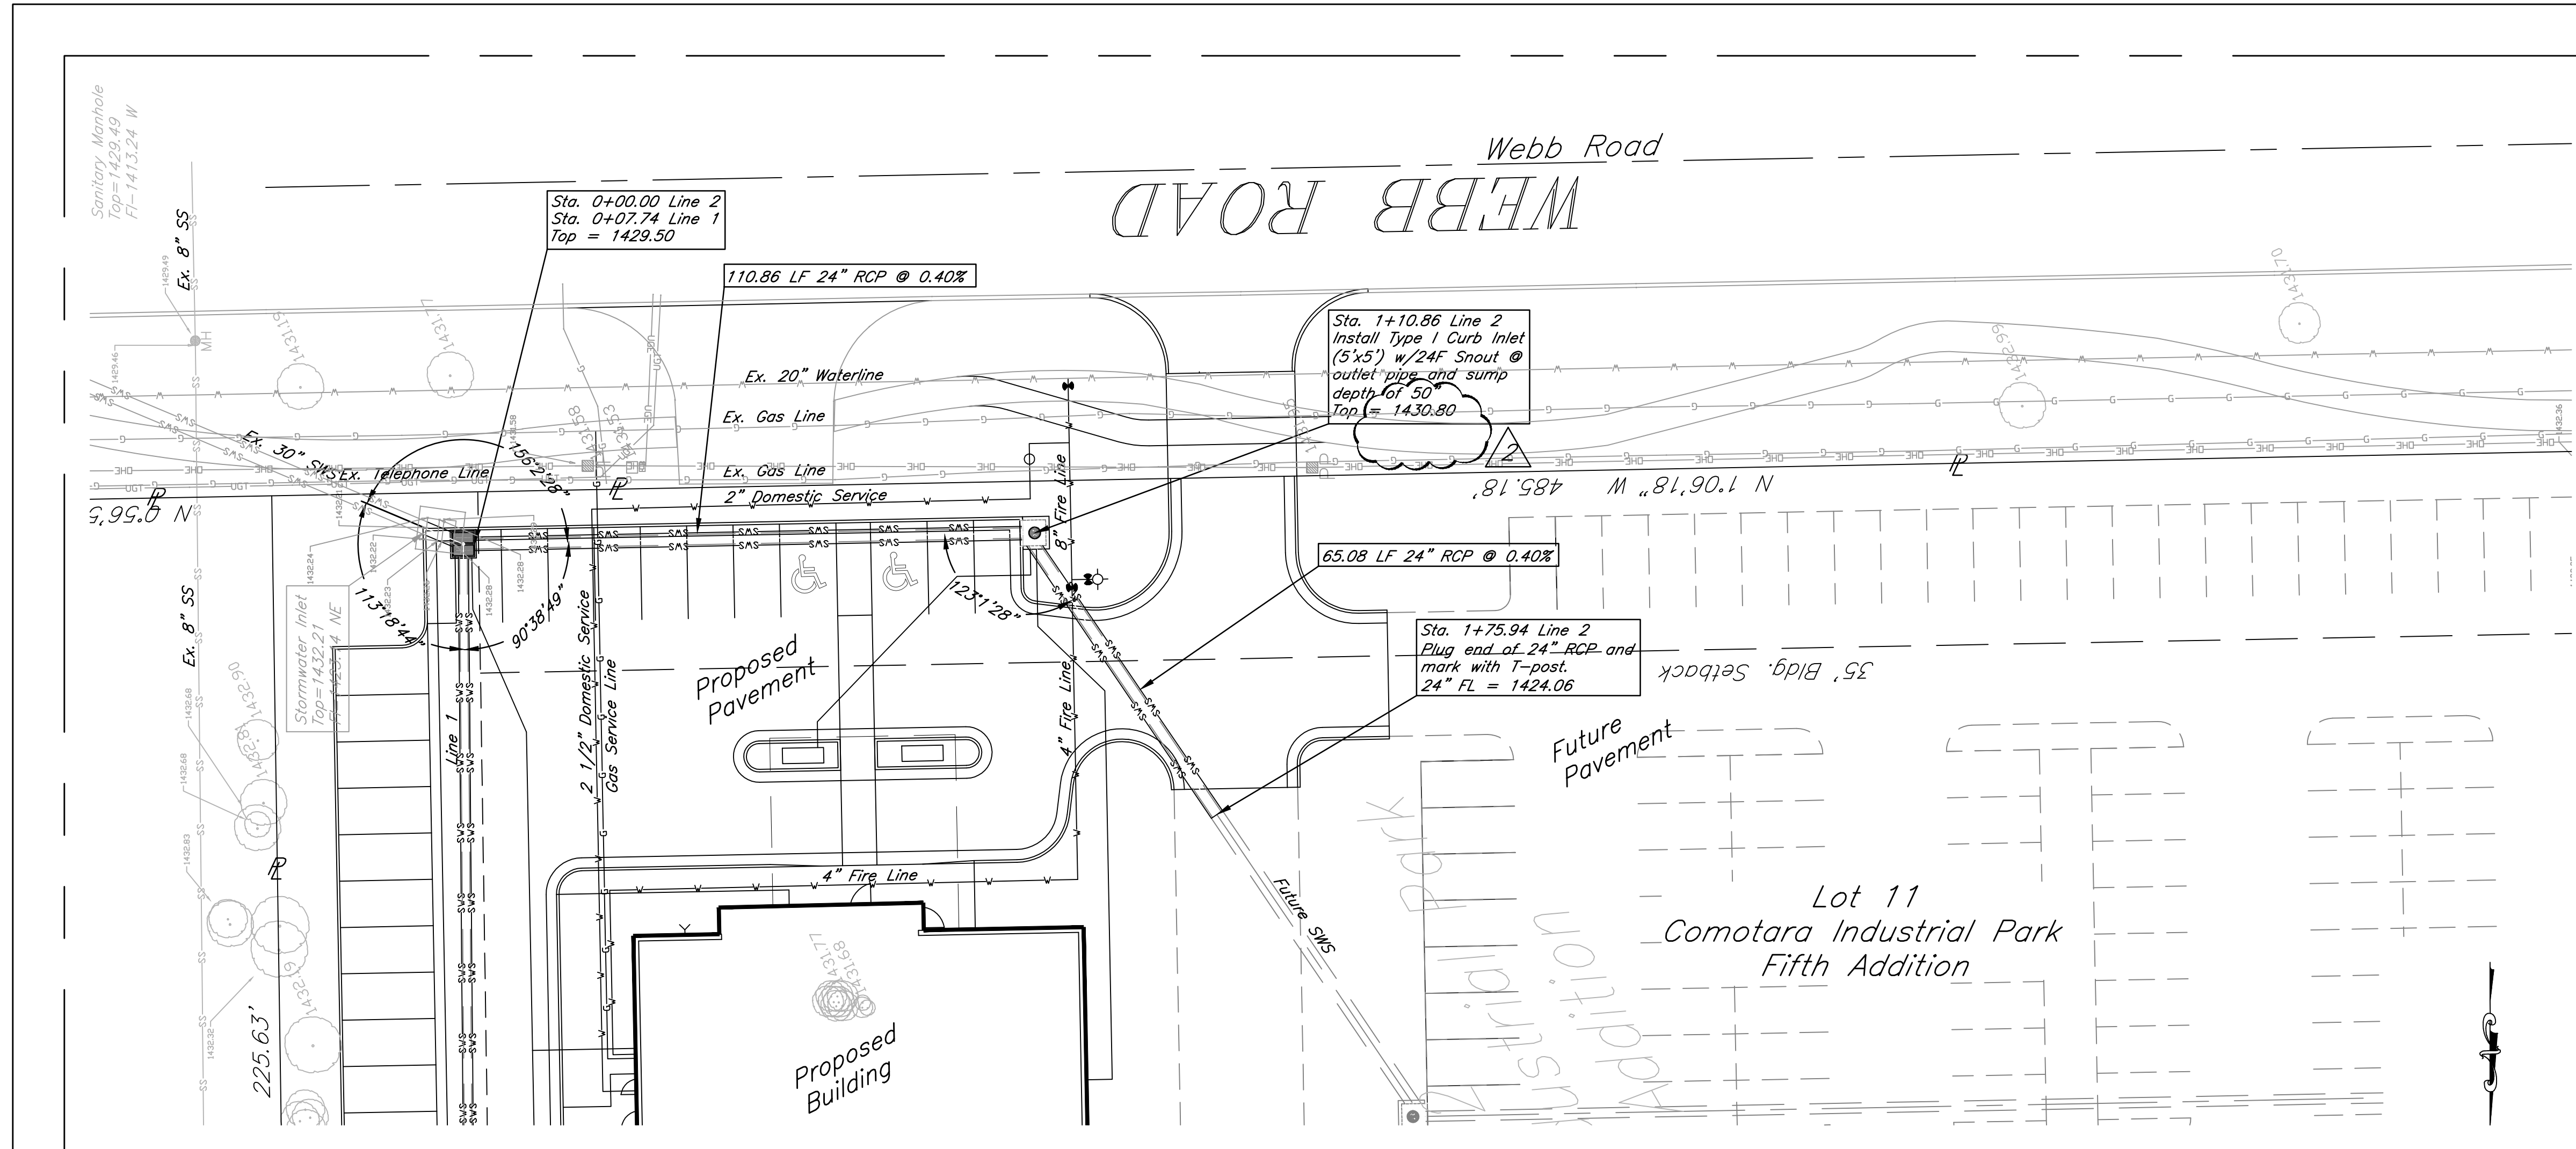

AS BUILTS

117 E. Lewis
Wichita, KS 67202 (316)264-0242


DATE: 03.16.2015
THIS SHEET HAS BEEN
SIGNED, SEALED AND
DATED ELECTRONICALLY

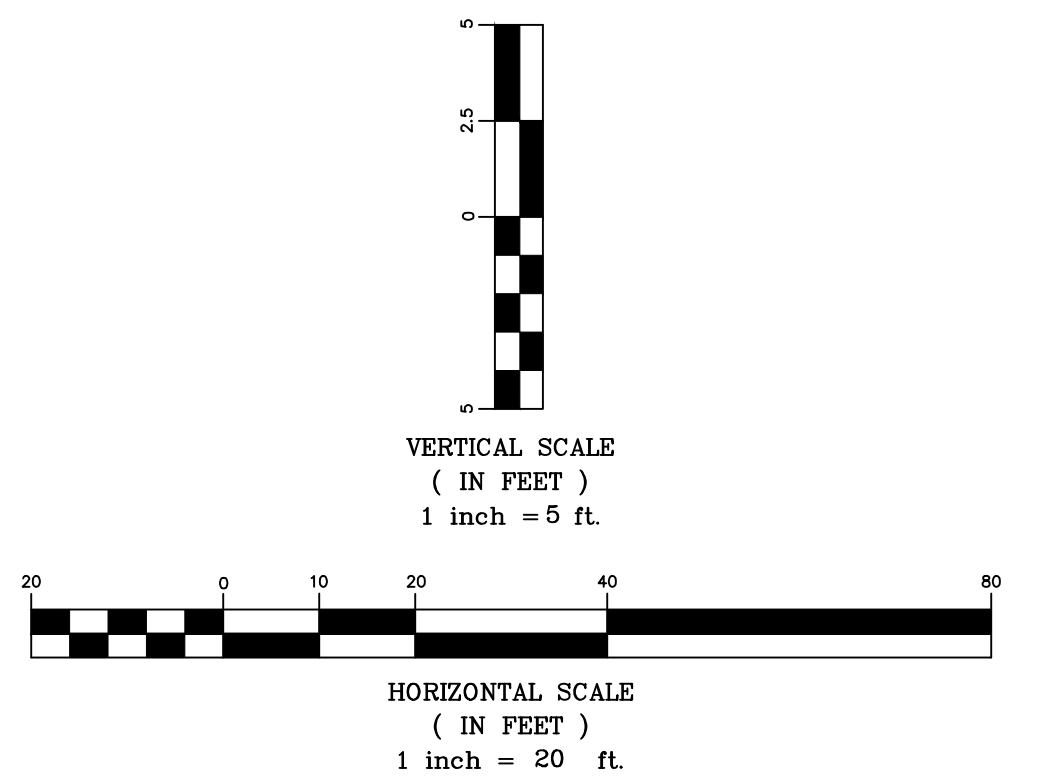

Heartland Cardiology
Plan and Profile
Wichita, Kansas

KEMILLER ENGINEERING PA 117 E. Lewis, Wichita, KS 67202 (316)264-0242	PROJECT NUMBER 0300 PPD (607861)			4.1
	KEM NO. 14176 DESIGN KM	FILE DRAWN MP	DATE 07/2015 REVISED 3/16/15	

March 17, 2015

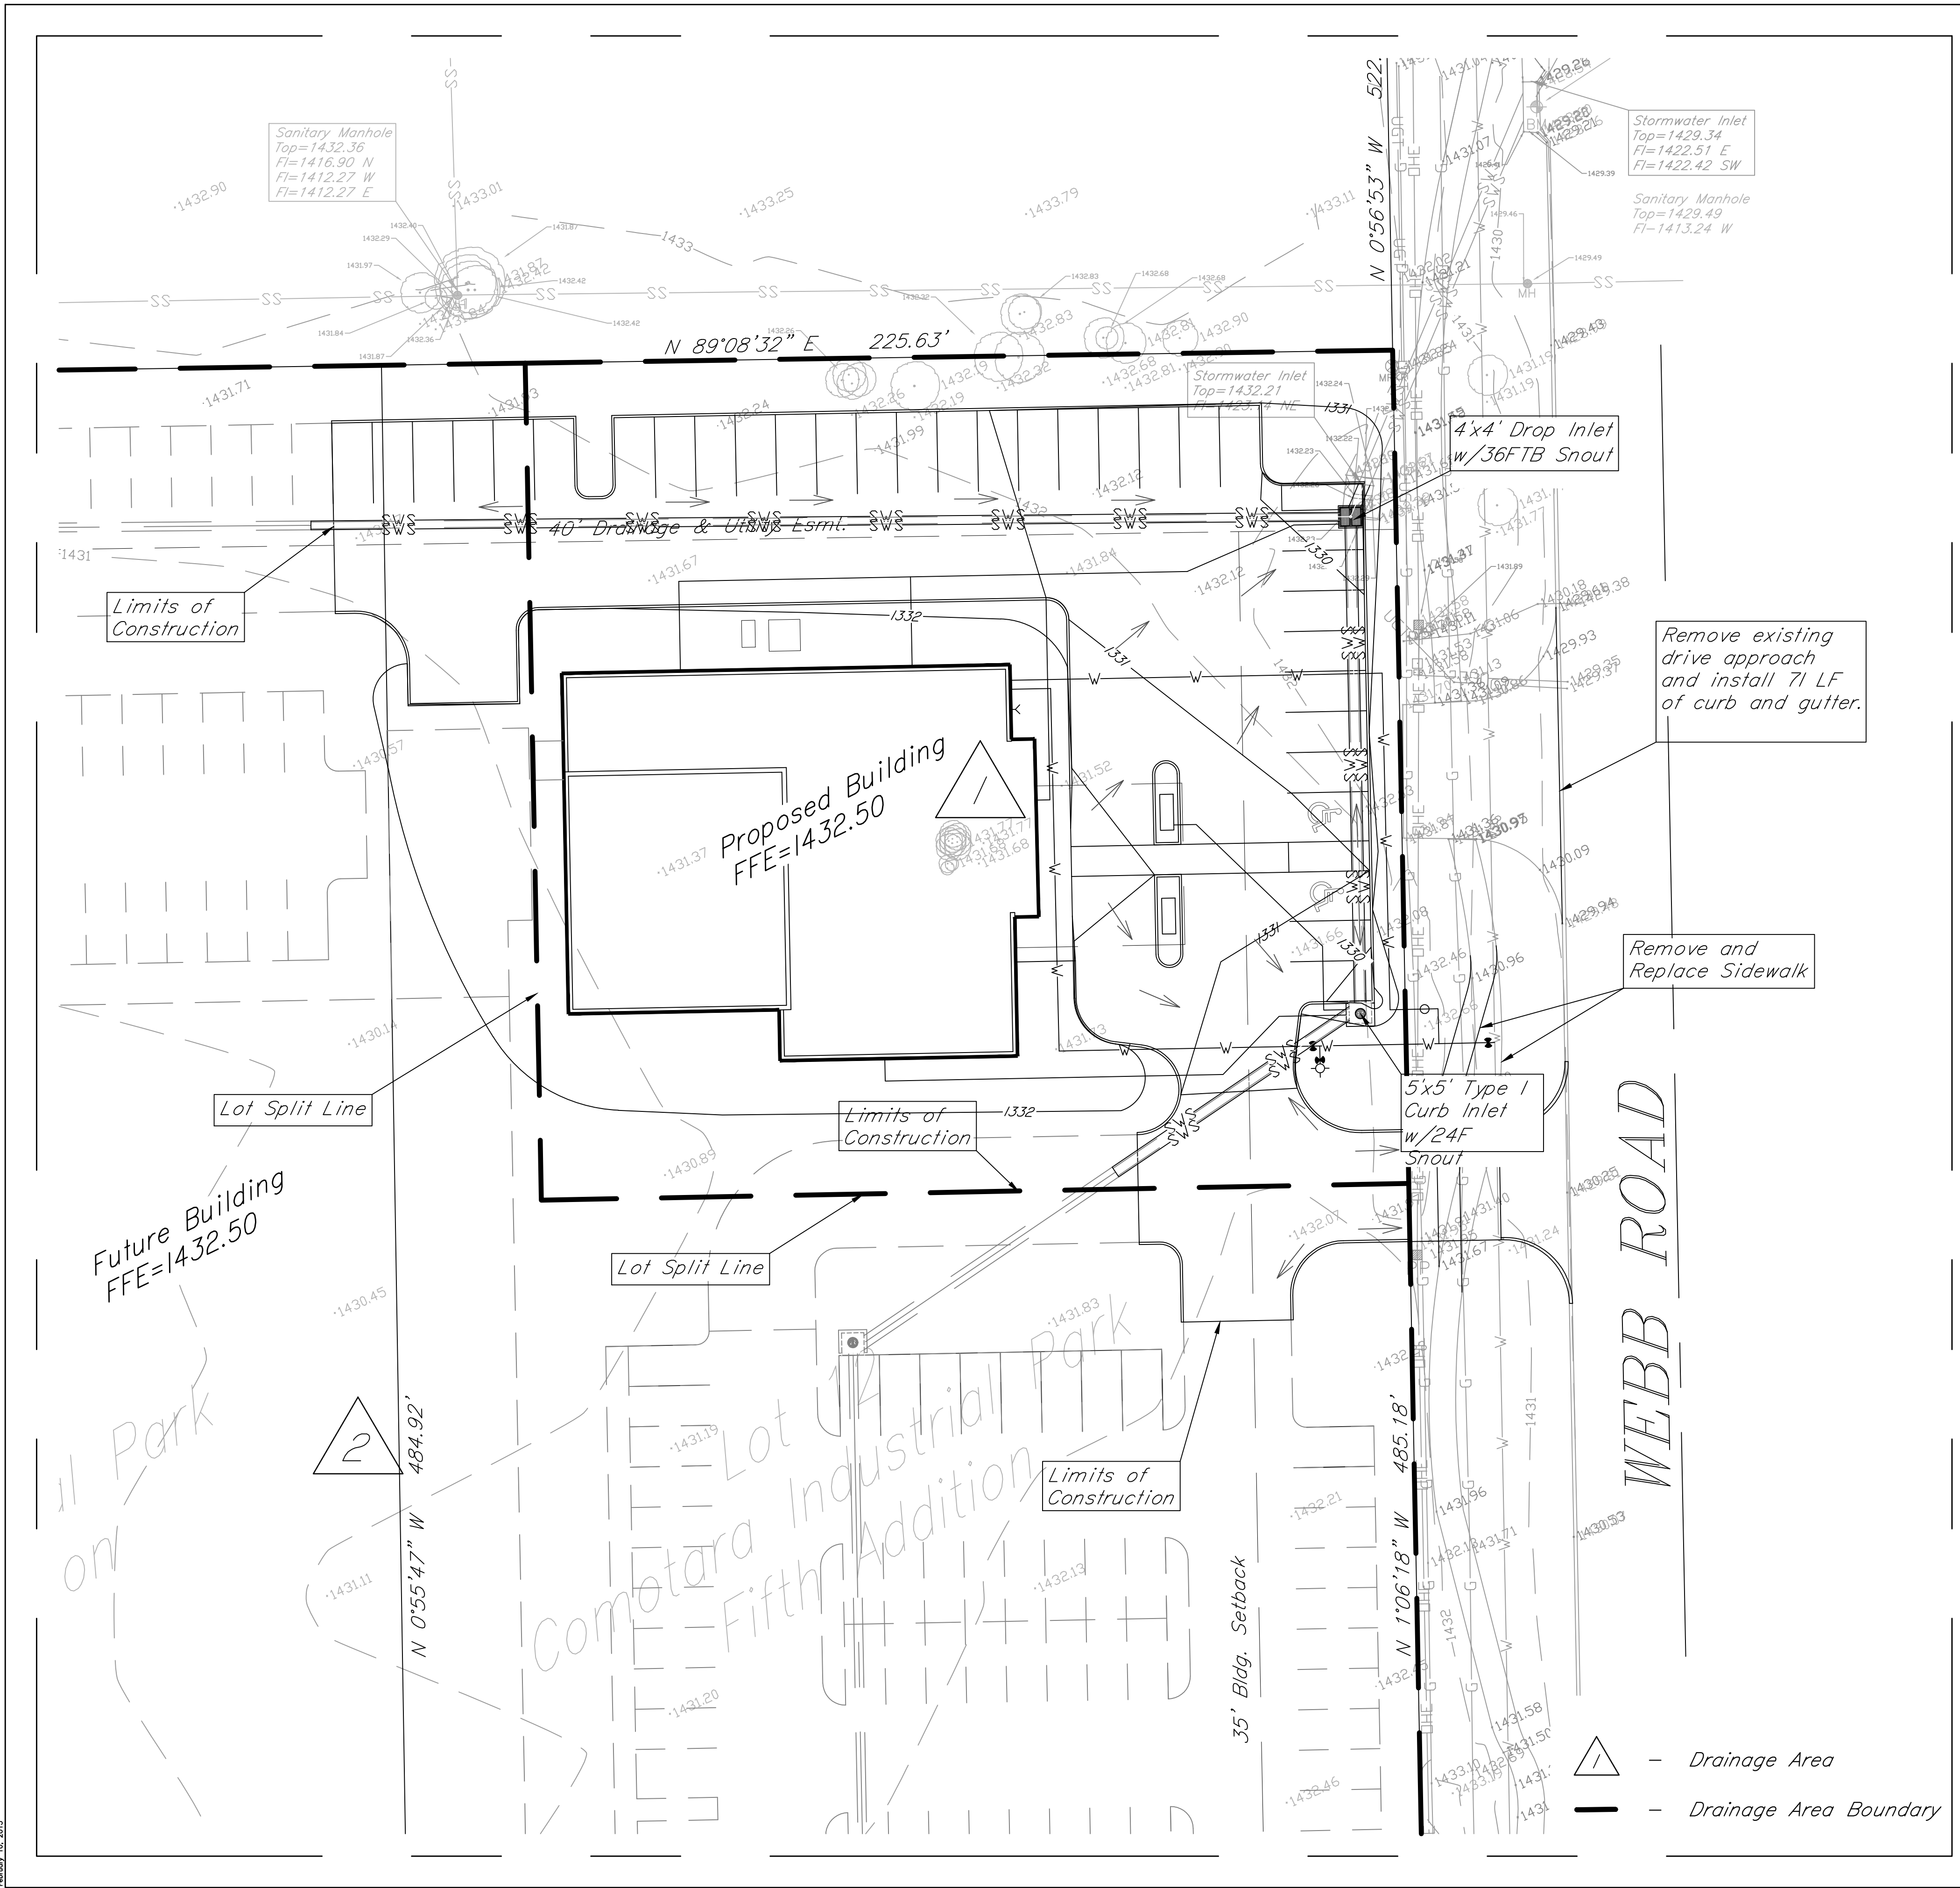

Project Narrative:
 The site is located at the Northwest corner of the intersection of 34th Street N and N Webb Road. The total site is 1.17 acres. The proposed development includes the construction of a new building and parking lot. The existing drainage pattern indicates that the site drains to the southwest, but following future expansion will be routed to the northeast corner of the property to an existing SWS System.

Water Quality and TSS Removal Calculation

The Water Quality and TSS Removal Calculation is not required for this site as the disturbed area is less than 1.0 acre, and runoff from the site enters a series of ponds within the existing development.

Water Quality Volume (WQv) Calculation				
Calculation for water quality volume (WQv=P*Rv*A/12)			Soil Group 'C'	
85th percentile storm event (1.2 inches), P =	1.20	inches	Calculation of Rv	
Total area, A =	0.83	acres	Coeff.	Area
Rainfall Coeff, Rv, =	0.830	cf	Coeff for undisturbed area, Rv _U =	0.03 0.00
Required Vol. for Water Quality =	0.069	ac-ft	Coeff for turf cover, disturbed, Rv _T =	0.20 0.16
Corresponding Water Quality Peak Flow =	0.67	cfs	Coeff for impervious area, Rv _I =	0.95 0.84
			Weighted, Rv =	0.830

Channel Protection Volume (CPv)

The Channel protection volume detention (1-yr storm for 24 hrs) is not required for this site as the total disturbance of proposed development is less than 5.0 acres.

Runoff Calculations (2-, 5-, 10-, 25-, and 100-yr)



EXISTING CONDITION:
 On-site Area to be Disturbed = 0.83 acres
 Soil Group = C (as per COW HSG map)
 CN=83

EXISTING SITE									
DRAINAGE AREA	ACRES	Tc min	CN	Q2	Q5	Q10	Q25	Q100	REMARKS
On-site (1)	0.83	15.6	83	1.94	2.84	3.48	4.31	5.88	Draining to Existing SWS
Off-site (2)	3.33	27	83	2.69	3.86	4.69	5.75	7.76	Draining to Existing SWS

DEVELOPED CONDITION:
 Total Area of Present and Future project = 4.16 acres
 Soil Group = C (as per COW HSG map)
 CN=95.5

DEVELOPED SITE									
DRAINAGE AREA	ACRES	Tc	CN	Q2	Q5	Q10	Q25	Q100	REMARKS
On-site (1)	0.83	15	96	2.99	3.09	4.54	5.35	6.89	Draining to Existing SWS
Future Dev. (2)	3.33	15	95	12	15.66	18.21	21.48	27.62	Draining to Existing SWS

- Notes:**
- Existing and developed flows are calculated using the SCS hydrograph method. "CN" & "Runoff Depth" values are established from "City of Wichita Stormwater Design Manual." Time of concentration (Tc) are calculated using TR-55 method.
 - The developed peak flows are calculated for the Type II rainfall distribution for 24 hours. The peak flows are routed to the Drainage Easement along the south line of the property.
 - The site is not in designated 100-yr floodplain (FIRM 2017C0355E, dated February 2, 2007).
 - Lidar indicates the site drains to the southwest, but will be picked up and carried northeast during future development.

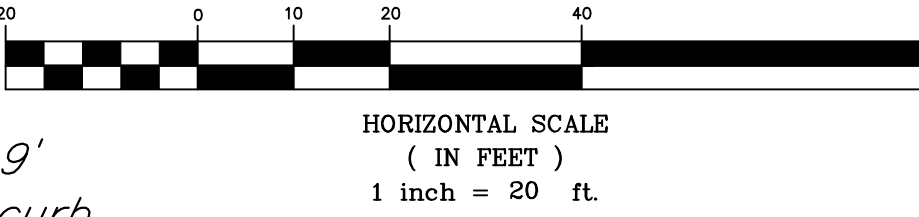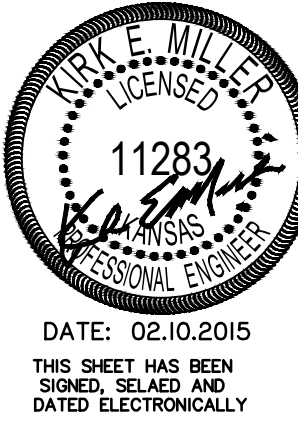


Benchmark
 City of Wichita Disc approximately 9' west of siren pole and 3' north of curb on the northwest corner of 34th Street and Webb Road.
 Elevation=1432.09 NAVD88

- Drainage Area
- Drainage Area Boundary

Heartland Cath Lab
DRAINAGE PLAN
 Wichita, Kansas


	PROJECT NUMBER 0300 PPD (607861)			SHEET 5.0
	KEM NO. 14176	FILE	DATE 01/2015	
117 E. Lewis, Wichita, KS 67202 (316)264-0242	DESIGN KM	DRAWN MP	REVISED	

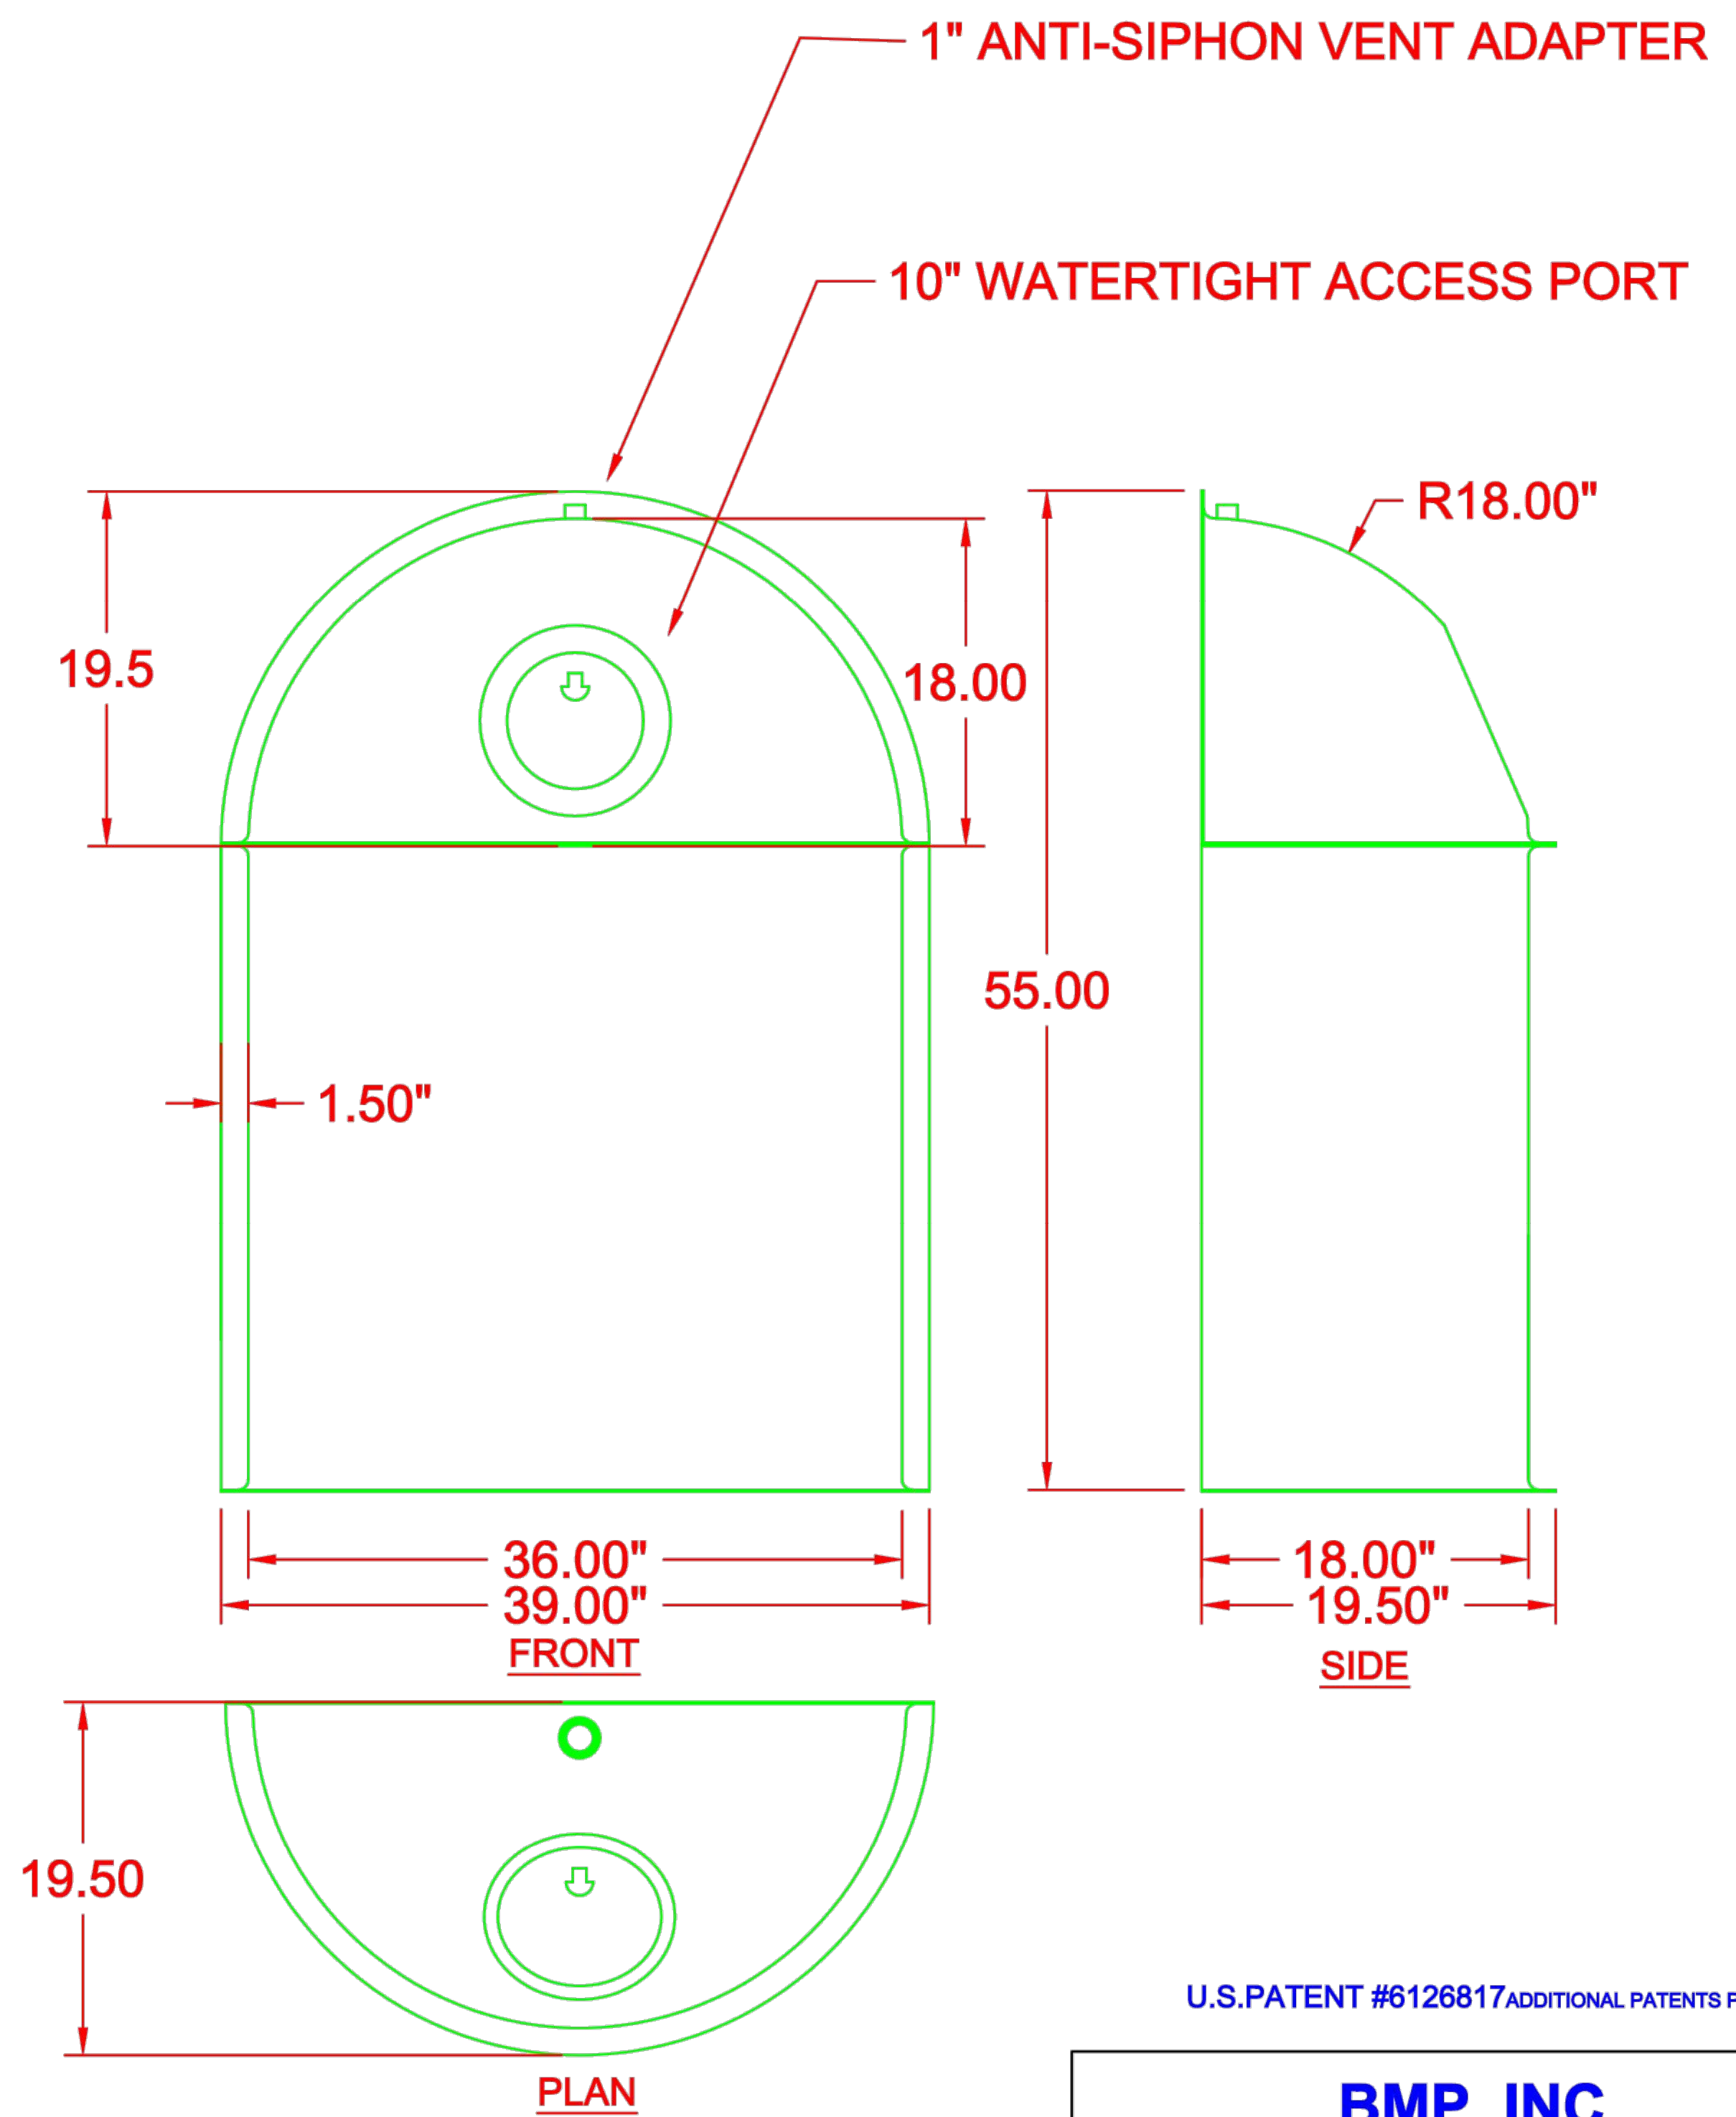

U.S.PATENT #6126817 ADDITIONAL PATENTS PENDING

BMP, INC.
 53 MT. ARCHER ROAD, LYME, CT. 06371
 (800) 504-8008 FAX: (860)434-3195


DESCRIPTION	DATE	SCALE
36FTB SNOUT OIL & DEBRIS STOP	03/28/05	NONE
DRAWING NUMBER		
36FTB		

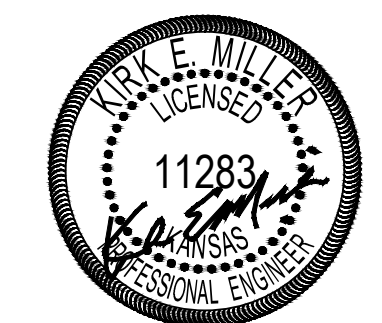

DATE: 02.10.2015
 THIS SHEET HAS BEEN
 SIGNED, SEALED AND
 DATED ELECTRONICALLY

Heartland Cath Lab
 Snout Detail
 Wichita, Kansas


 117 E. Lewis, Wichita, KS 67202 (316)284-0242	PROJECT NUMBER 0300 PPD (607861)			SHEET 5.1
	KEM NO. 14176 DESIGN KM	FILE DRAWN MP	DATE 01/2015 REVISED	

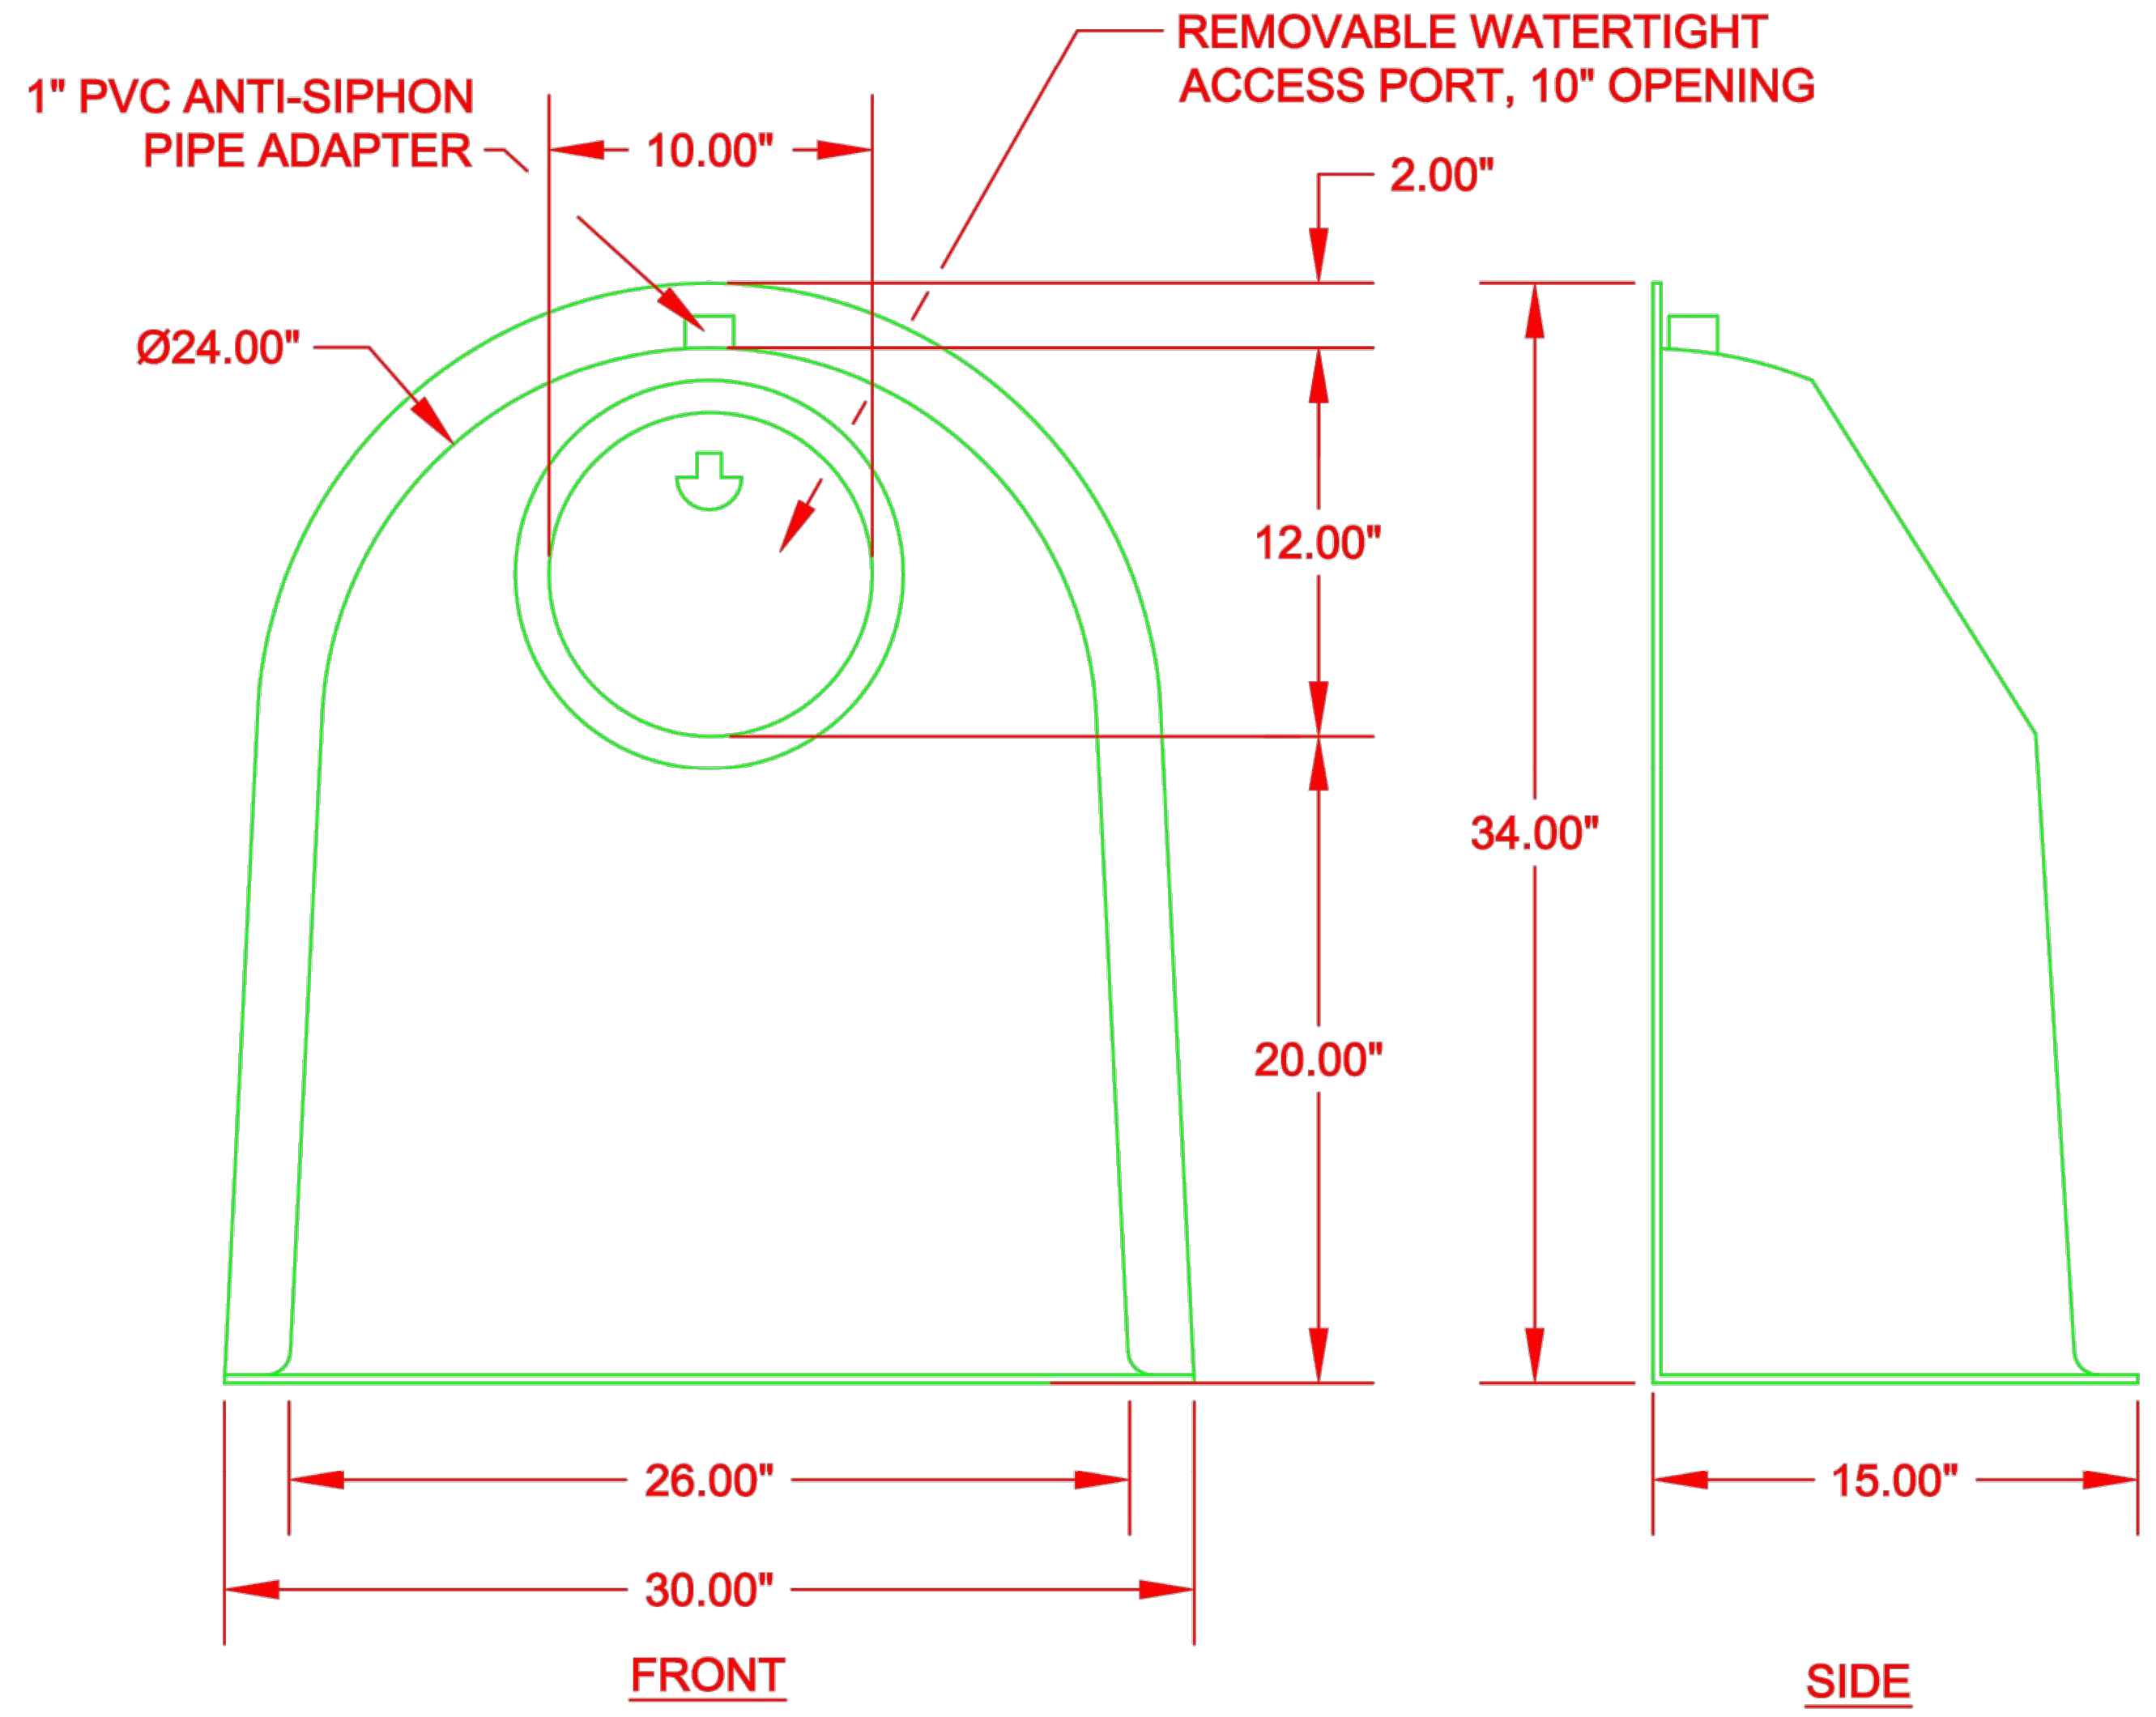

U.S. PATENT #6126817 ADDITIONAL PATENTS PENDING


BMP, INC.
 53 MT. ARCHER ROAD, LYME, CT. 06371
 (800) 504-8008 FAX: (860)434-3195

DESCRIPTION	DATE	SCALE
24F SNOUT OIL & DEBRIS STOP	09/20/99	NONE
DRAWING NUMBER		
24F		

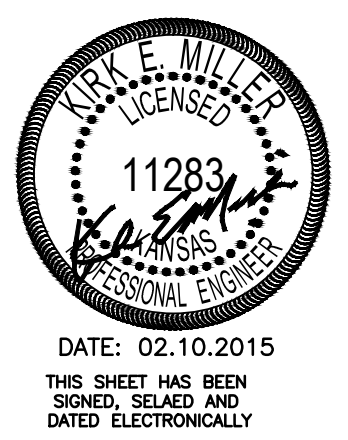


Heartland Cath Lab
 Snout Detail
 Wichita, Kansas


 117 E. Lewis, Wichita, KS 67202 (316)284-0242	PROJECT NUMBER 0300 PPD (607861)			SHEET 5.2
	KEM NO. 14176 DESIGN KM	FILE DRAWN MP	DATE 01/2015 REVISED	

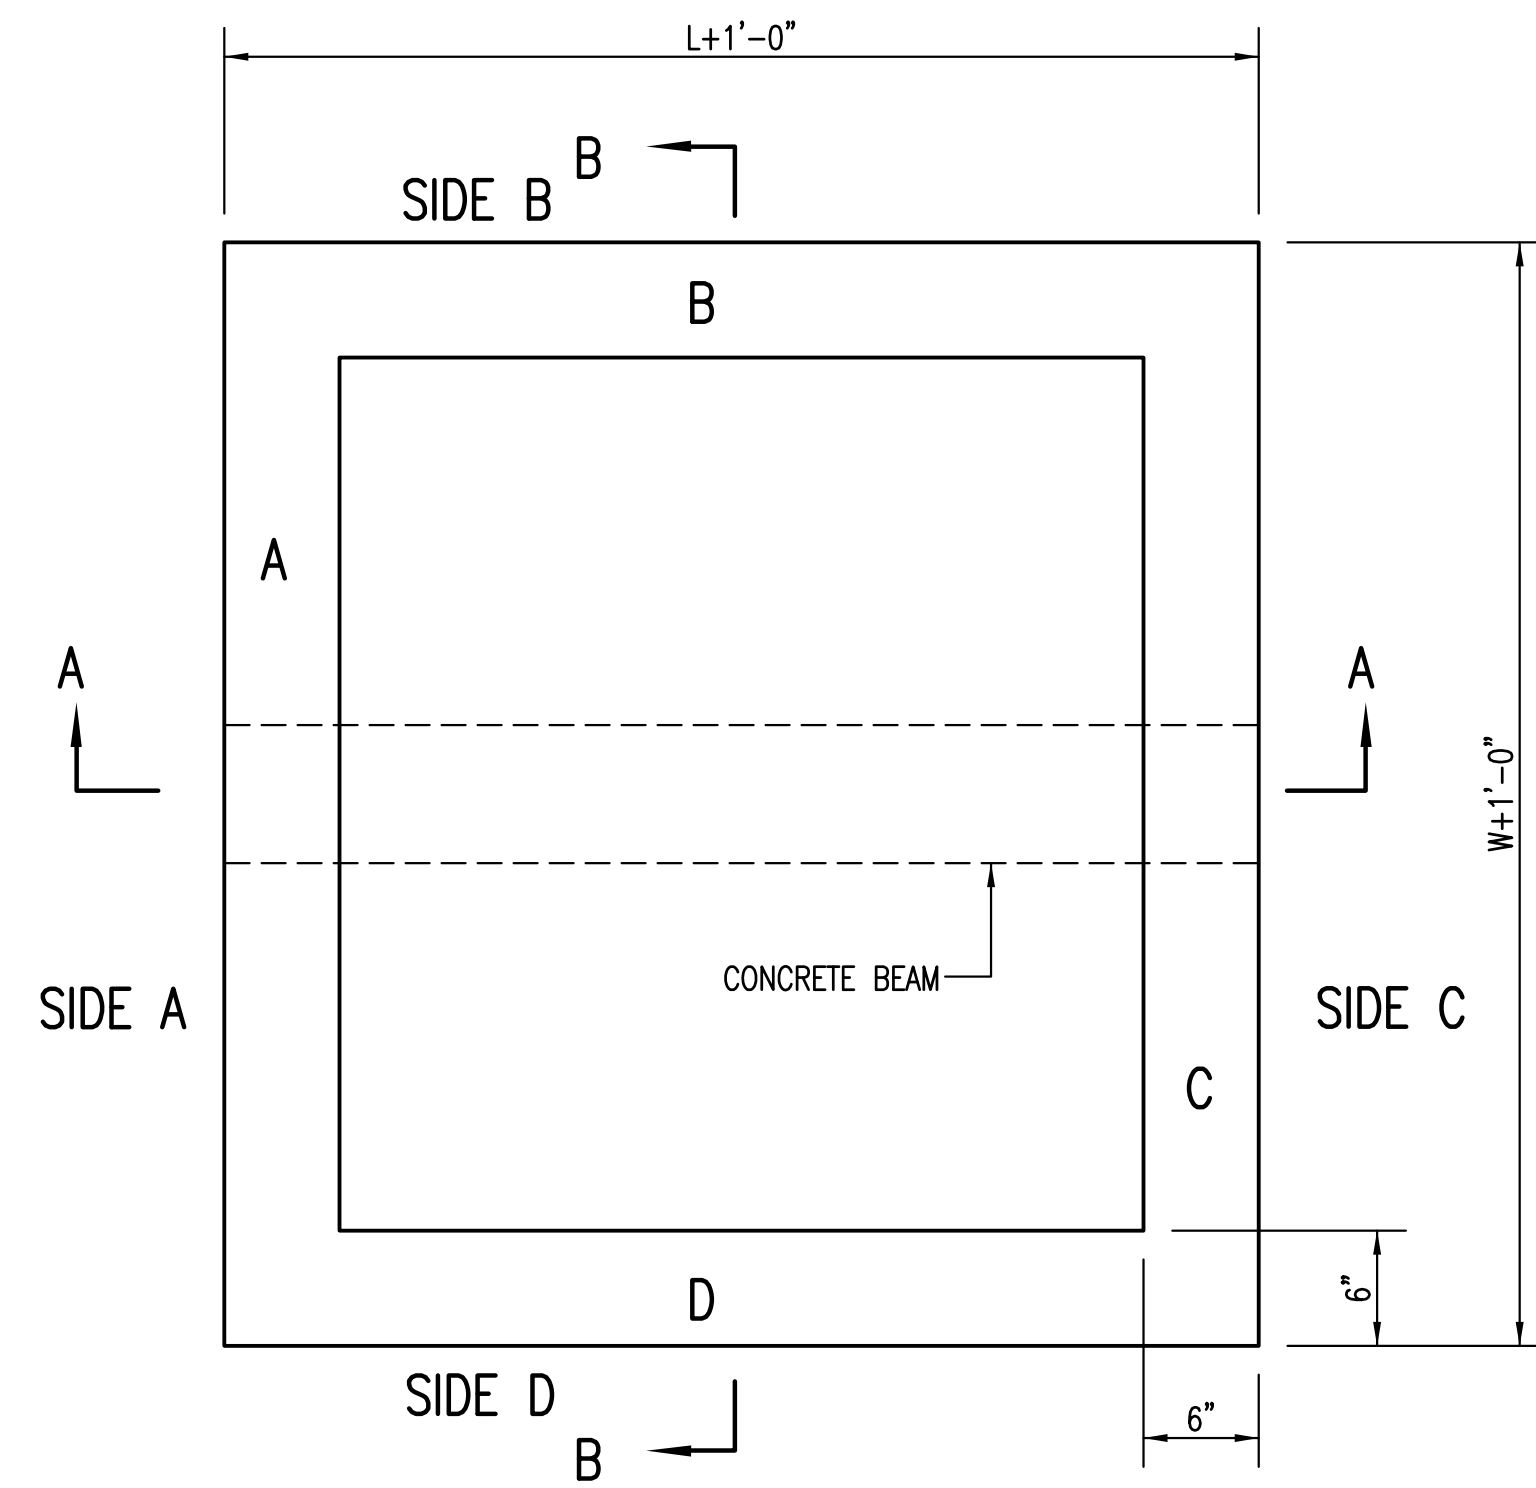

TOP VIEW

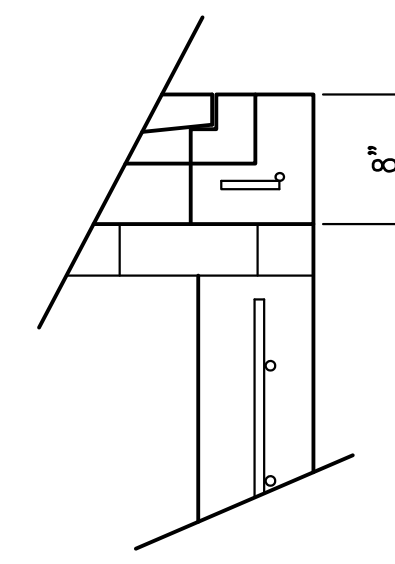


FLUSH STYLE TOP
NO APRON

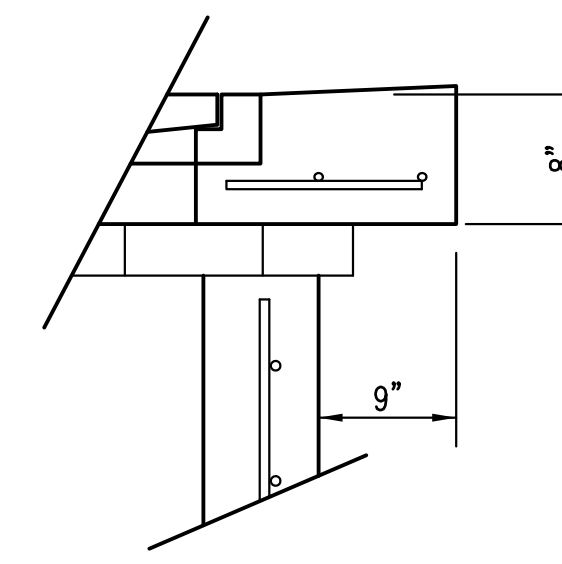


9" APRON

* APRON TO EXTEND ON ALL 4 SIDES OF INLET.
DESIGNER TO DESIGNATE APRON SIZE.

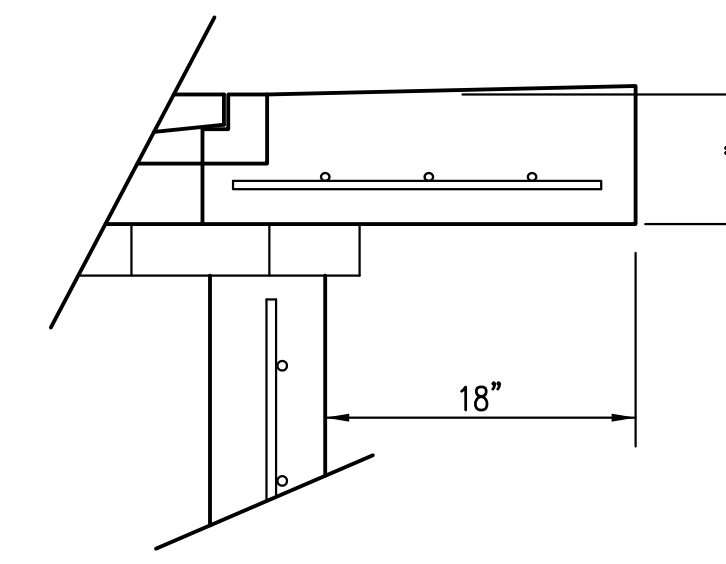

18" APRON

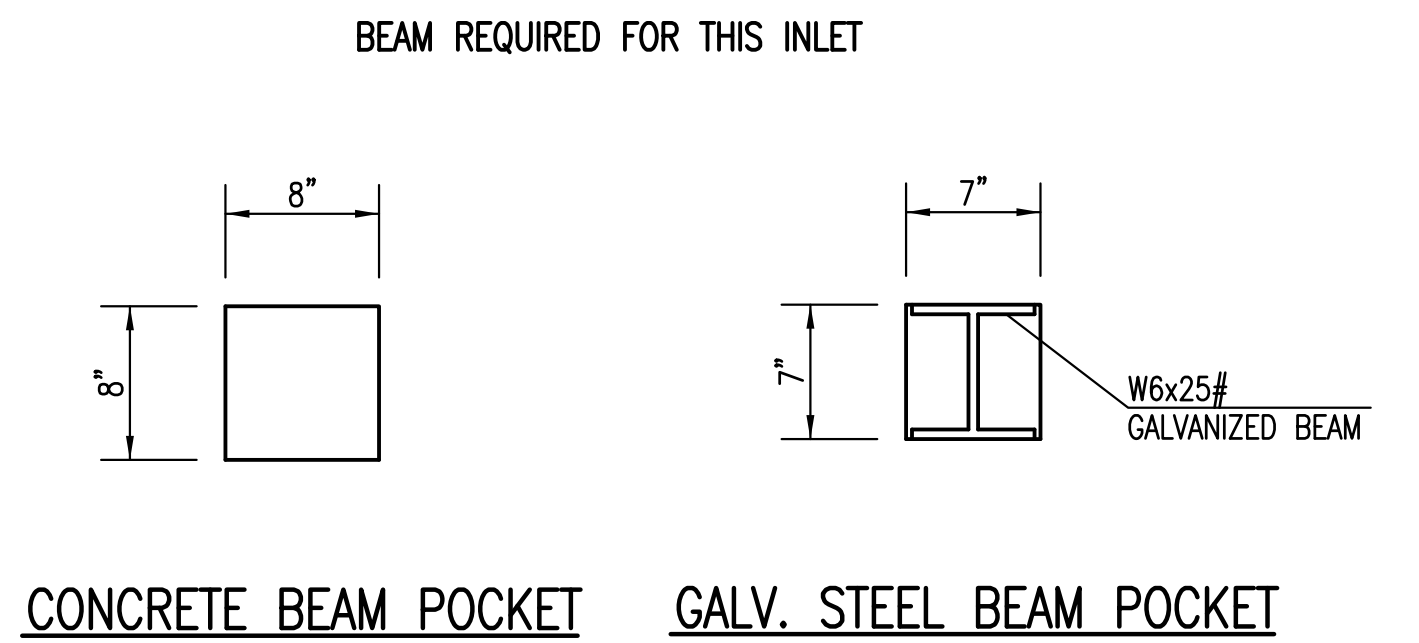

CONCRETE BEAM POCKET


GALV. STEEL BEAM POCKET

W=4'-4" and L=4' for DOUBLE DROP INLET


The structure(s) on this detail sheet are designed for HS-20 loading at these specific dimensions only. If larger dimensions are required, the ENGINEER shall provide a project specific structure design for approval by the City Engineer's office.

GENERAL NOTES


1. GRATE FRAME TO BE INSTALLED ON THIN MORTAR CUSHION TO INSURE FULL SUPPORT ALONG BRICK. CONCRETE USED FOR INLET CONSTRUCTION SHALL CONFORM TO CITY OF WICHITA SPECIFICATIONS FOR CONCRETE PAVEMENT MIX.
2. INLET INVERT SHALL BE SHAPED WITH 8 SACK SAND MIX CONCRETE TO CREATE FLOW CHANNELS AND TO INCREASE HYDRAULIC EFFICIENCY SUCH THAT THE INLET WILL BE SELF CLEANING BETWEEN ALL INLET AND/OR OUTLET PIPES.
3. THE ENDS OF ALL PIPES INSTALLED IN INLETS SHALL BE CUT OFF FLUSH WITH THE INSIDE FACE OF THE INLET WALL.
4. INLET FRAME AND GRATE TO BE DEETER #2433, EJIW #5391-Z1 OR APPROVED EQUAL FOR 2'x2' SINGLE DROP INLET AND DEETER #2434, EJIW #5391 Z3 OR APPROVED EQUAL FOR 2'x4' DOUBLE DROP INLET.
5. CONTRACTOR SHALL REMOVE LIFTING HOOKS AFTER INSTALLATION. RECESSES IN INLET WALL SHALL BE GROUTED FLUSH TO THE INLET WALL WITH HYDRAULIC CEMENT AFTER THE INLET IS IN PLACE. LIFTING HOLES THRU THE INLET WALL WILL NOT BE ACCEPTED.

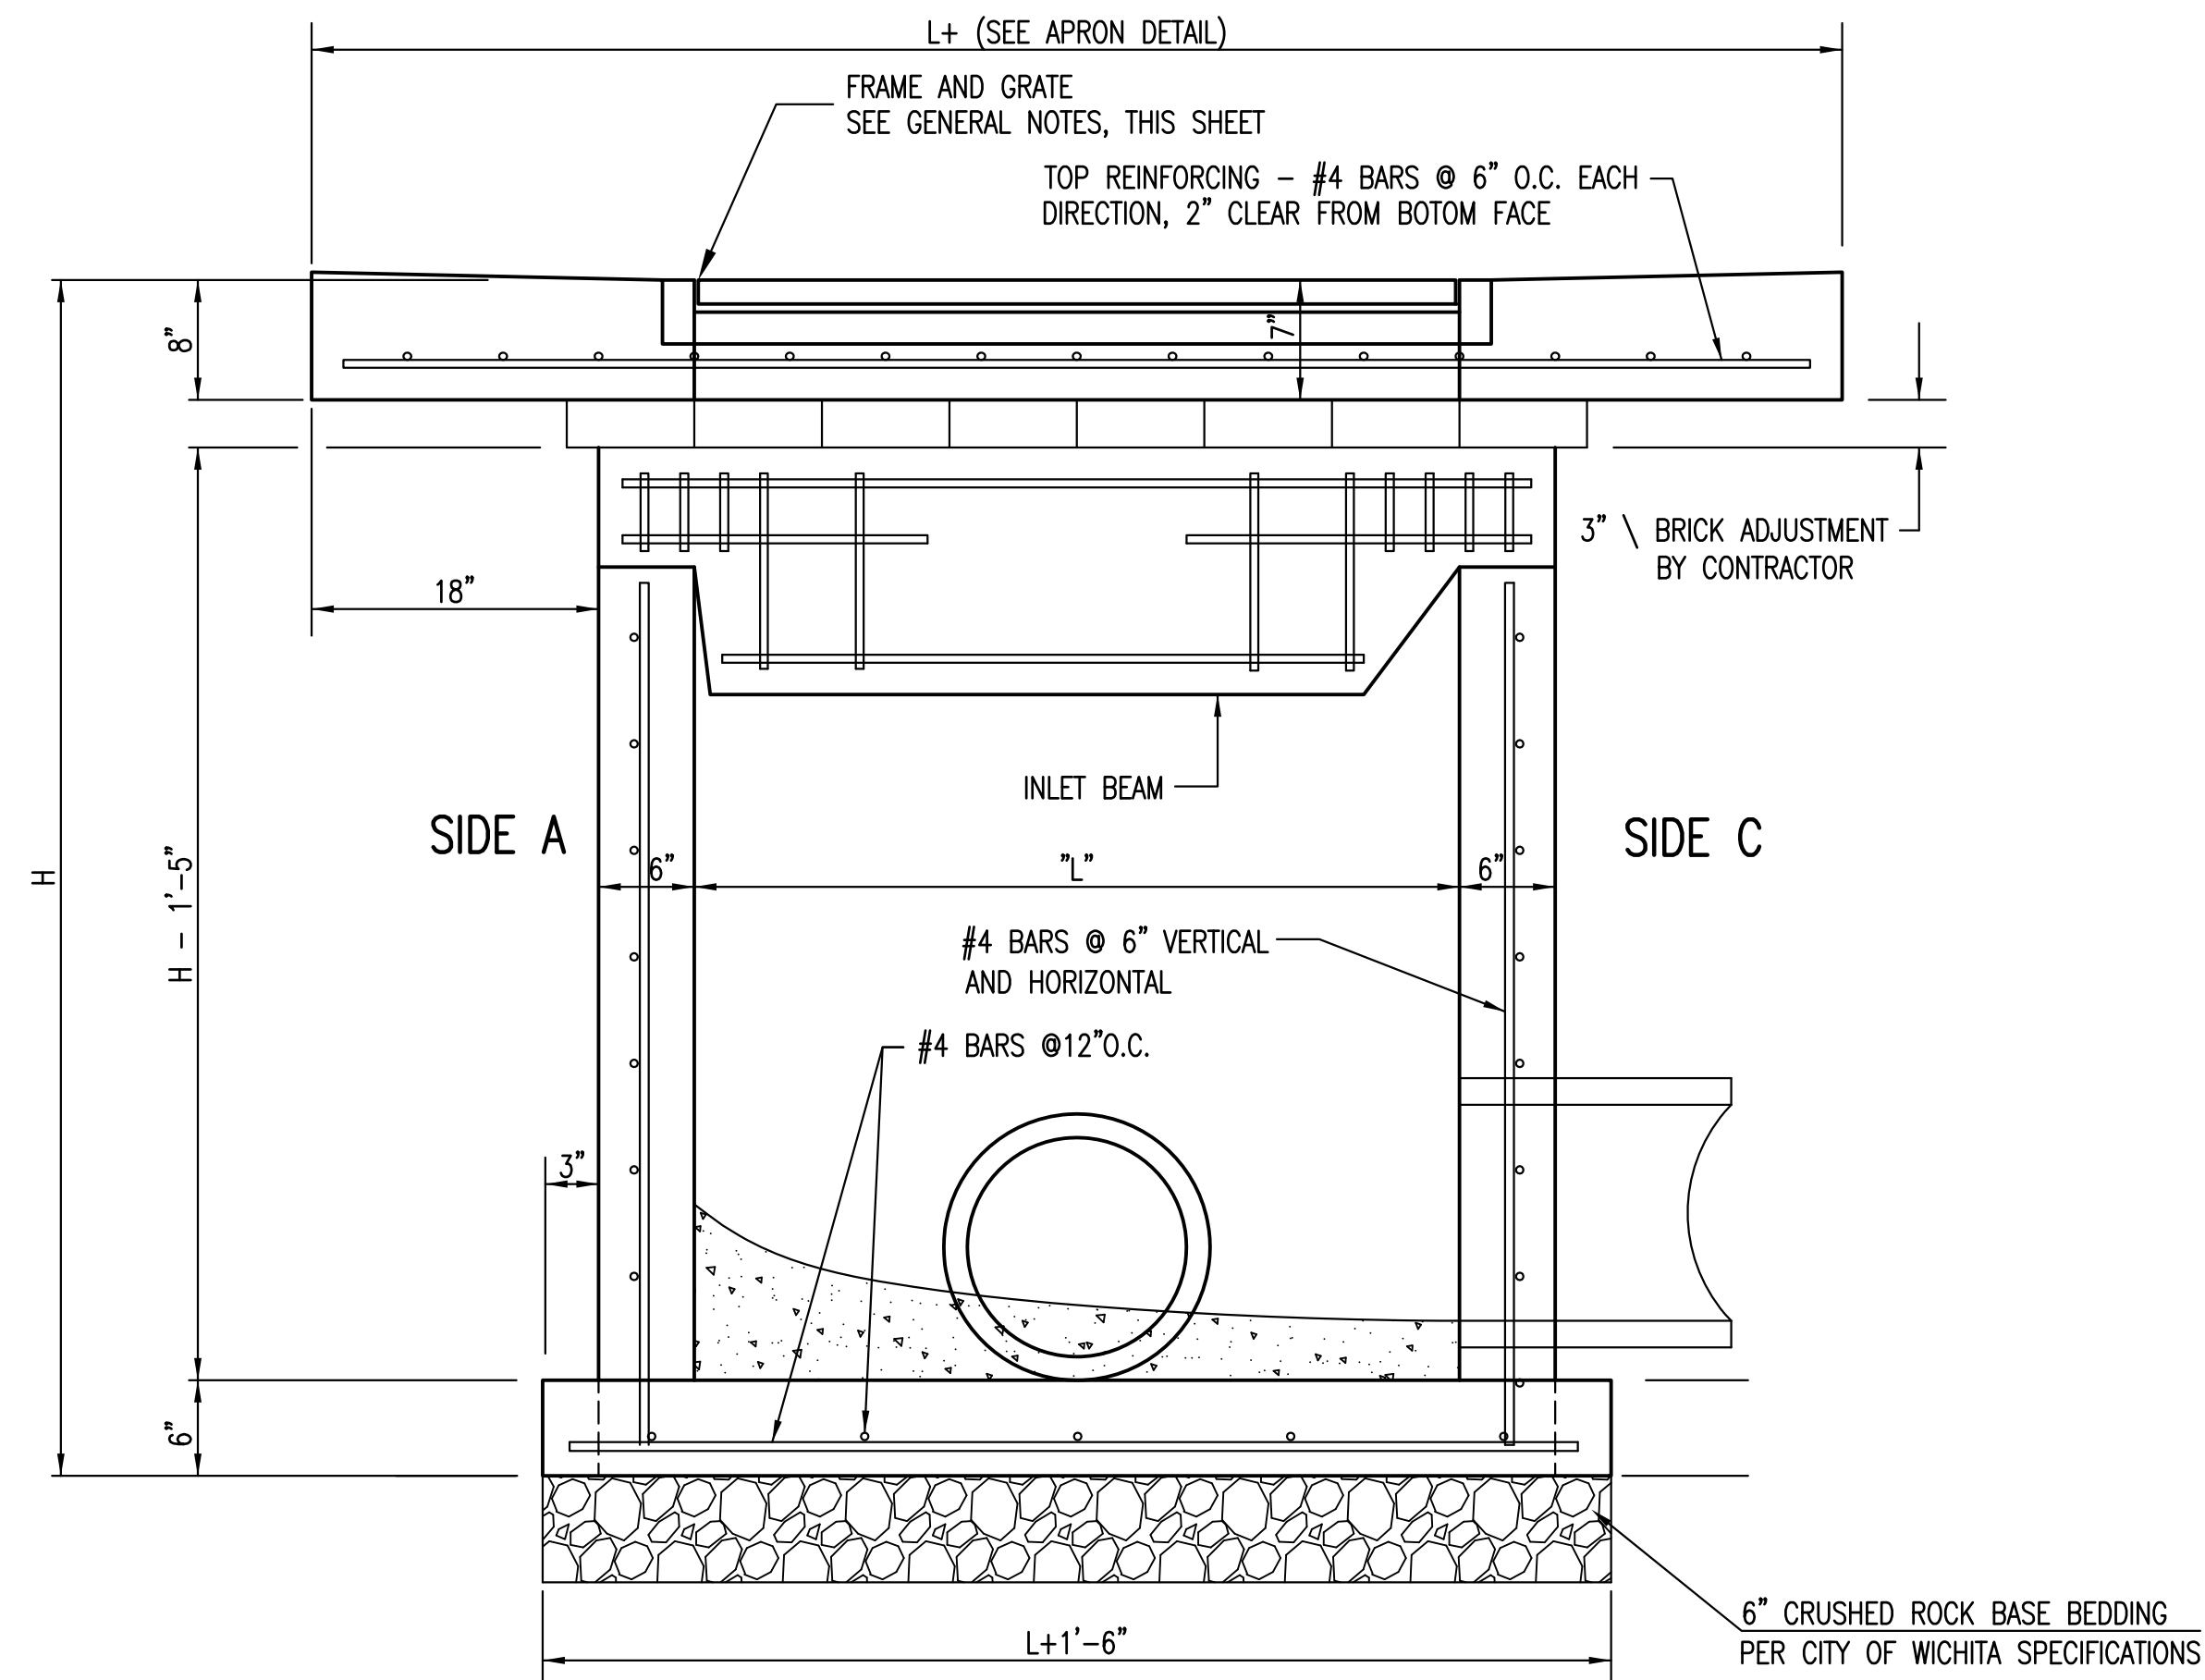


SECTION "A-A"

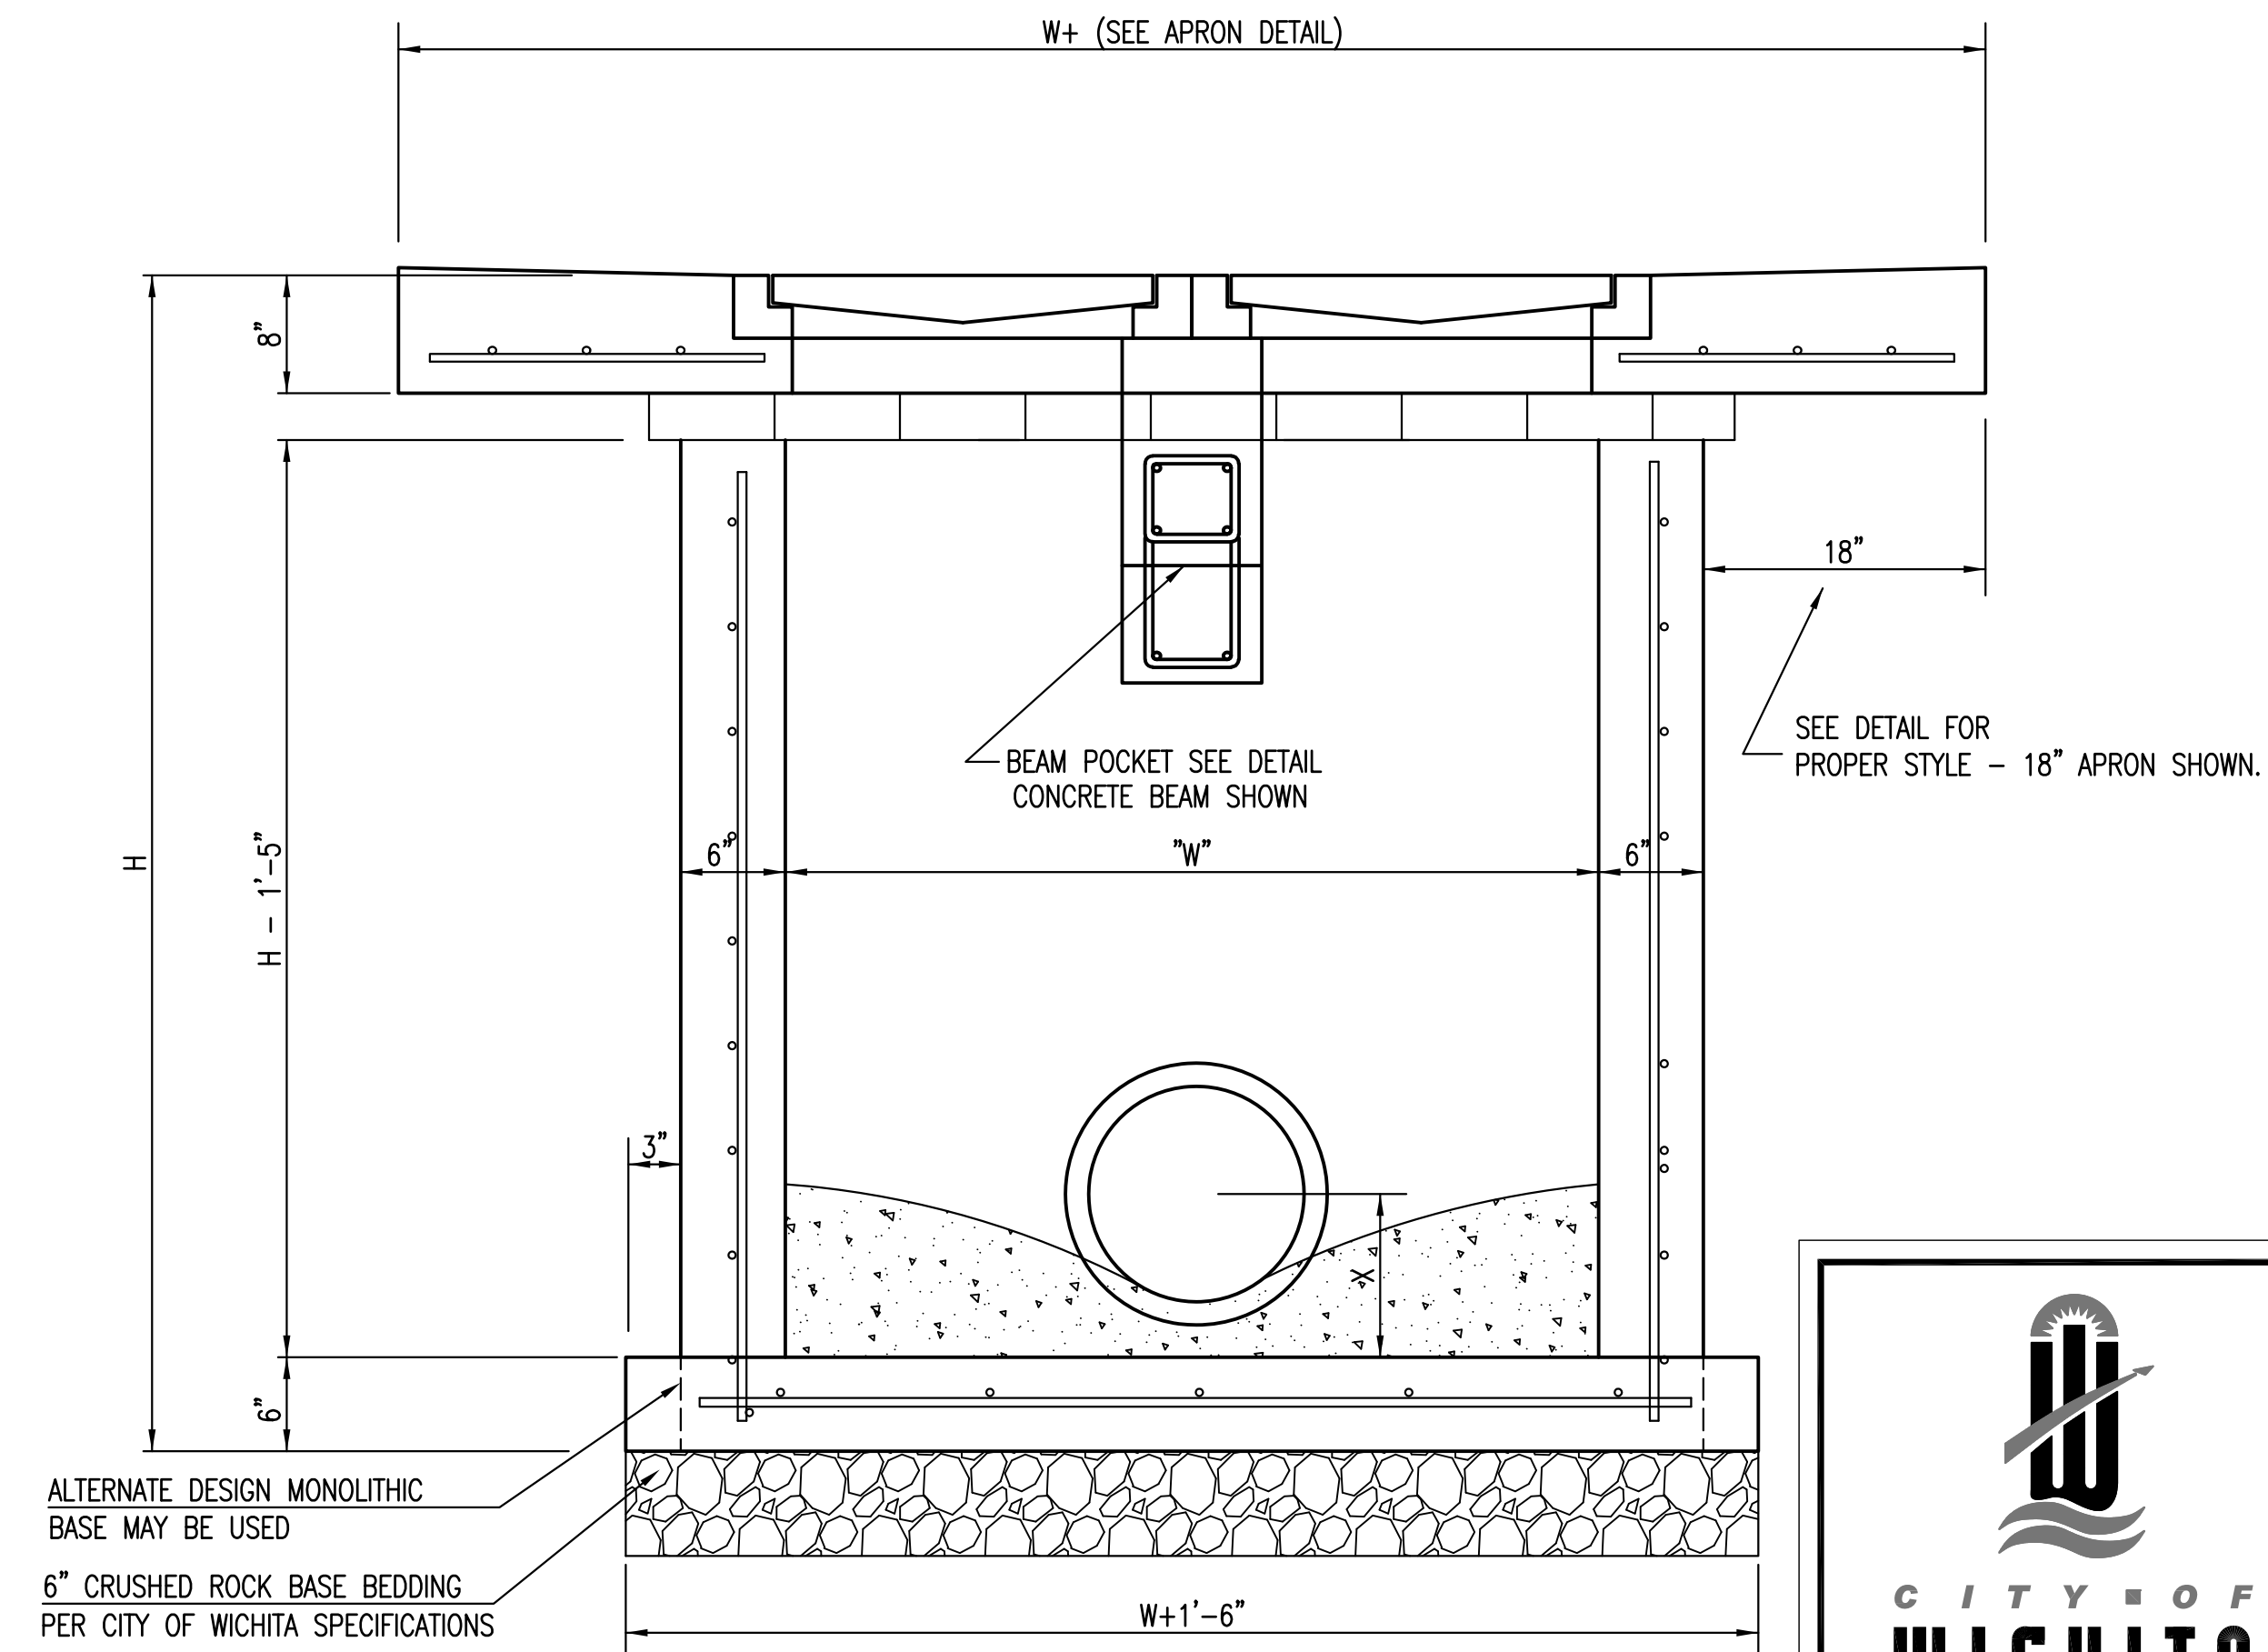

SECTION "B-B"

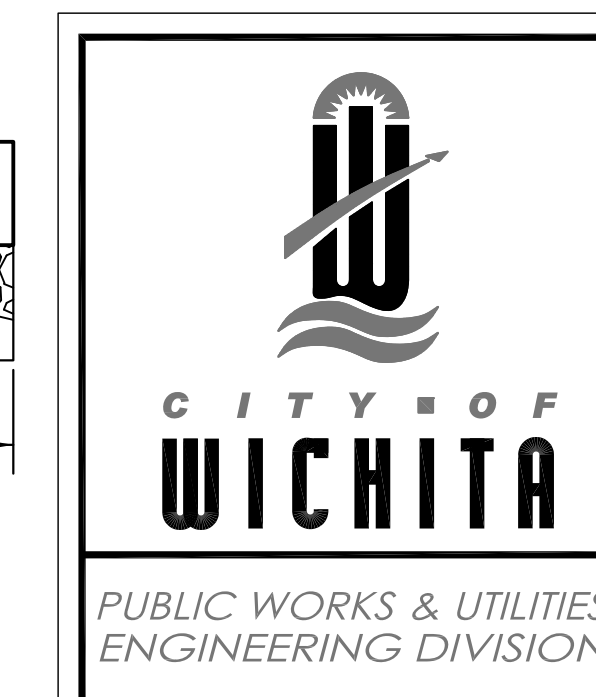

DOUBLE DOUBLE DROP INLET WITH BEAM		
CITY ENGINEER GARY JANZEN, P.E..		
PROJECT NUMBER	OCA NUMBER	DATE 05/2011
CITY ENGINEER'S OFFICE CITY HALL - SEVENTH FLOOR 455 NORTH MAIN STREET WICHITA, KANSAS 67202-1620 (316) 268-4501		SHEET 6.0

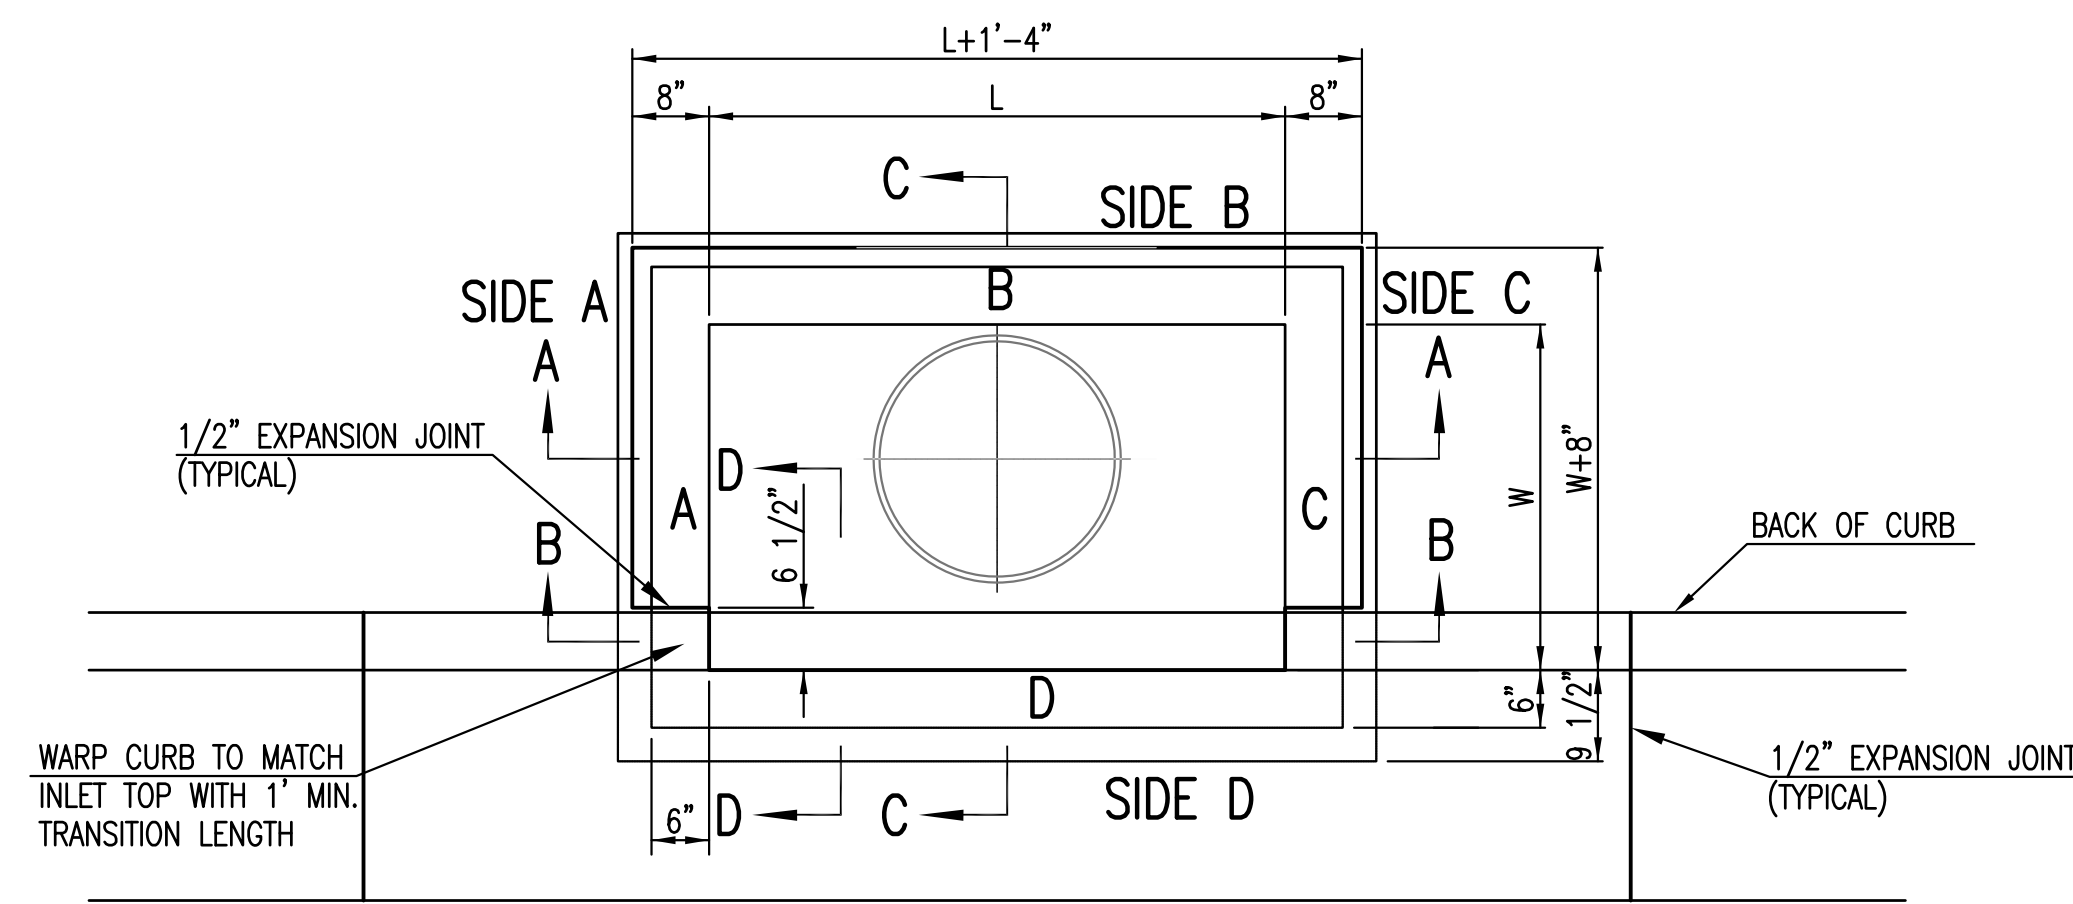

TOP VIEW


BAR SCHEDULE		
INLET OPENING	B1 BARS	SPACING
5'-0"	#4	4"
10'-0"	#6	3.5"

PRECAST CURB INLET WIDTHS				
W	PRE-CAST TOP SIZE			PIPE DIA.**
	WIDTH	LENGTH	TOP	
3'-0"	W+8"	L+1'-4"	7 1/2"	21" & SMALLER
4'-0"	W+8"	L+1'-4"	7 1/2"	24" & 30"
5'-0"	W+8"	L+1'-4"	7 1/2"	36" & 42"
6'-0"	W+8"	L+1'-4"	7 1/2"	48" & 54"
7'-0"	W+8"	L+1'-4"	7 1/2"	60" & 66"


** FOR PIPES PERPENDICULAR TO INLET WALL

GENERAL NOTES

1. CONCRETE TOPS TO BE INSTALLED ON THIN MORTAR CUSHION TO INSURE FULL SUPPORT ALONG BRICK. CONCRETE TOPS MAY BE CAST IN PLACE OR PRECAST. CONCRETE USED FOR INLET CONSTRUCTION SHALL CONFORM TO CITY OF WICHITA SPECIFICATIONS FOR CONCRETE PAVEMENT MIX.
2. CONTRACTOR SHALL HAVE THE OPTION OF CONSTRUCTING 8" BRICK MASONRY WALLS BETWEEN THE CONCRETE INLET BASE AND TOP OF THIS INLET WHEN W=5'-0" AND H=7'-0" OR LESS.
3. INLET INVERT SHALL BE SHAPED WITH 8 SACK SAND MIX CONCRETE TO CREATE FLOW CHANNELS AND TO INCREASE HYDRAULIC EFFICIENCY SUCH THAT THE INLET WILL BE SELF CLEANING BETWEEN ALL INLET AND/OR OUTLET PIPES.
4. THE ENDS OF ALL PIPES INSTALLED IN INLETS SHALL BE CUT OFF FLUSH WITH THE INSIDE FACE OF THE INLET WALL.
5. INLET FRAME AND COVER TO BE DEETER #2014, EJIW #1936 Z4, OR APPROVED EQUAL, SEE SW-303.
6. CONTRACTOR SHALL REMOVE LIFTING HOOKS AFTER INSTALLATION. RECESSES IN INLET WALL SHALL BE GROUDED FLUSH TO THE INLET WALL WITH HYDRAULIC CEMENT AFTER THE INLET IS IN PLACE. LIFTING HOLES THRU THE INLET WALL WILL NOT BE ACCEPTED.


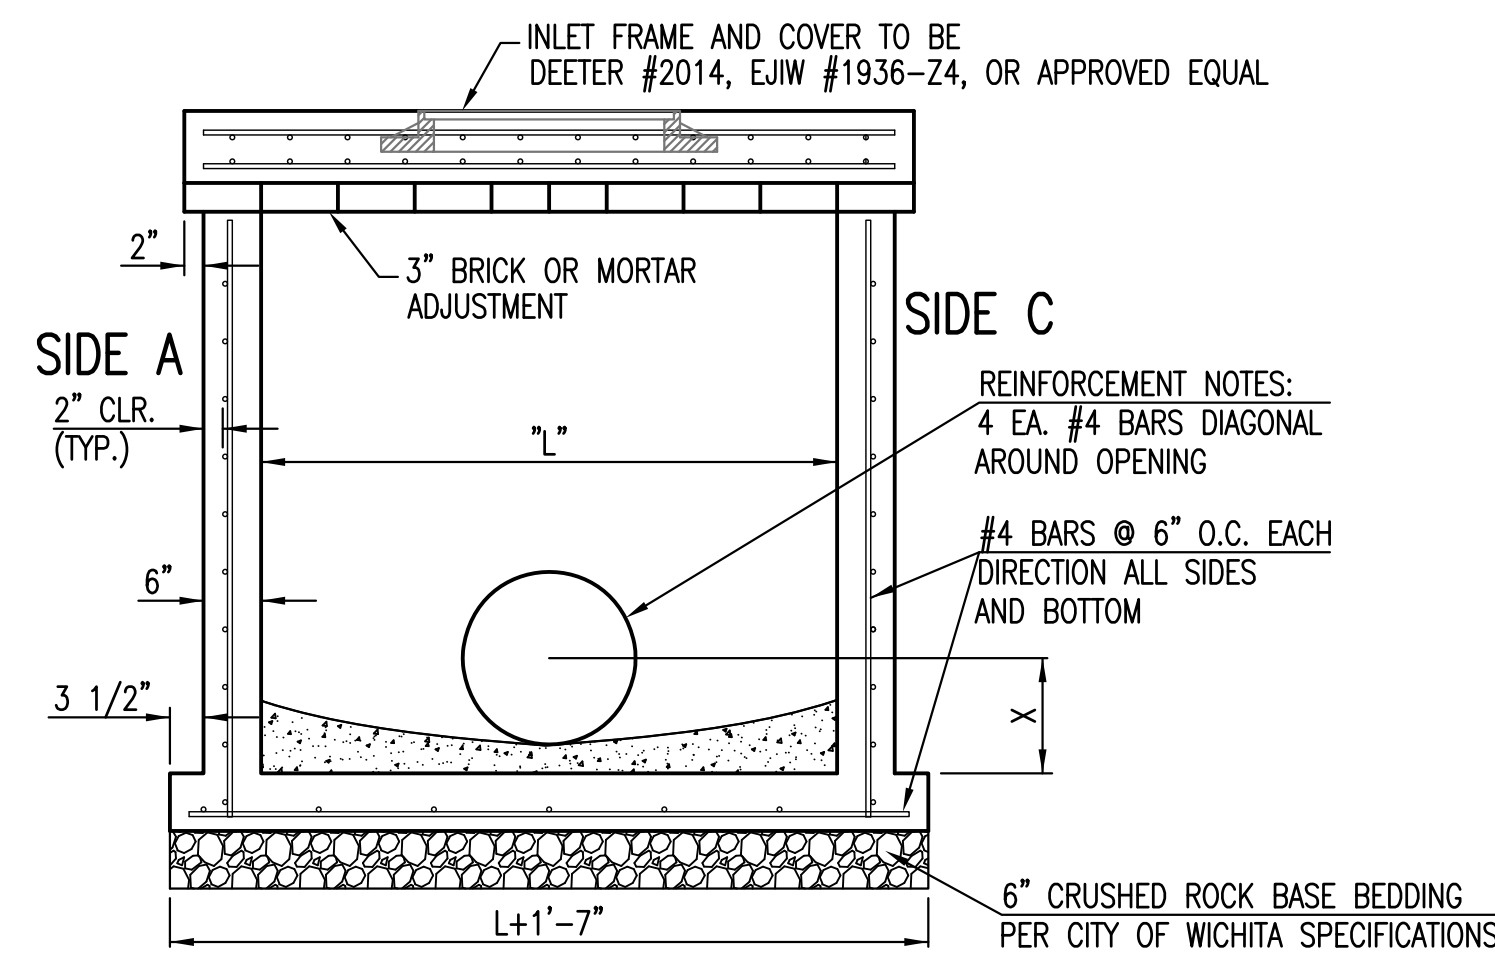


SECTION "A-A"

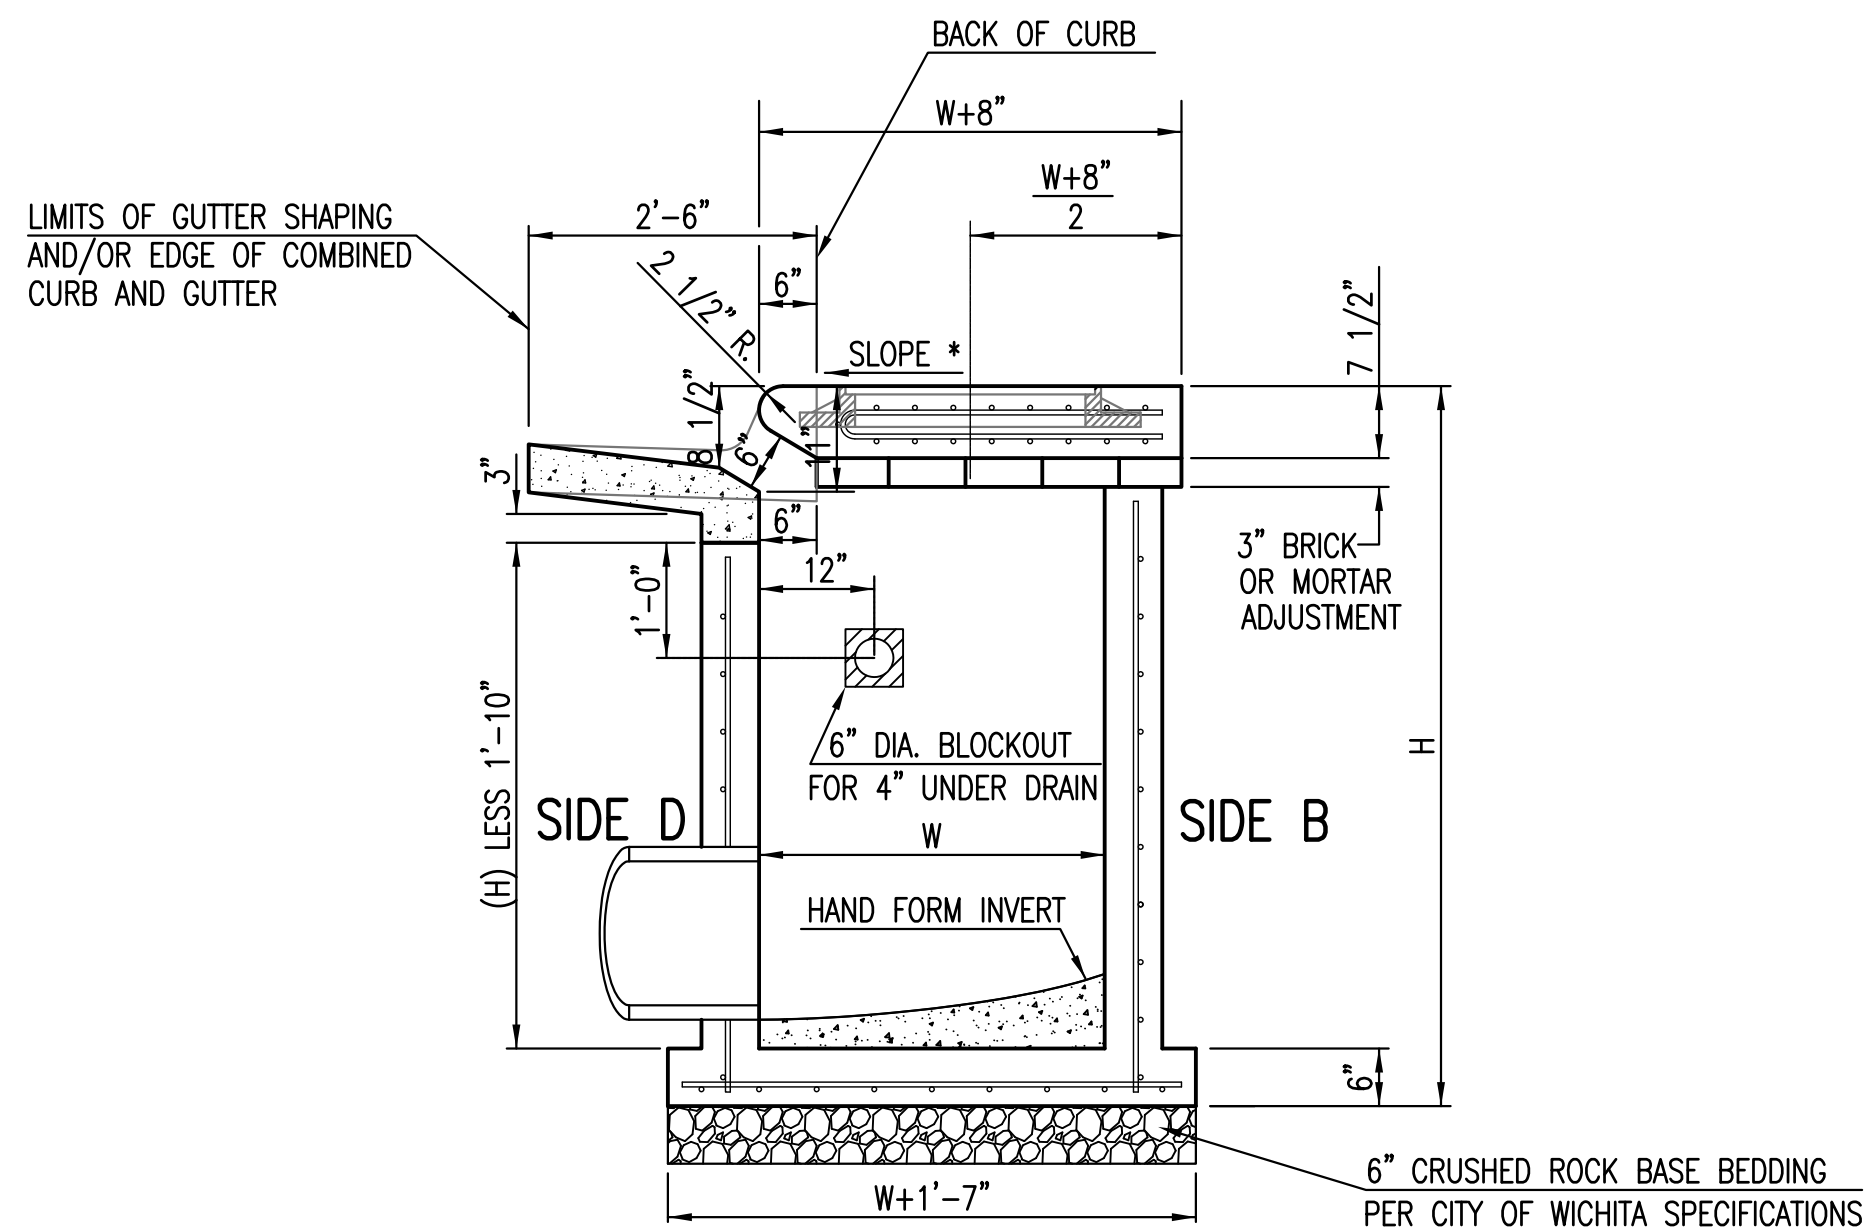


SECTION "C-C"

NOTES:
* SLOPE OF INLET TOP TO MATCH SIDEWALK OR PARKING SLOPES WITHIN LIMITS INDICATED.

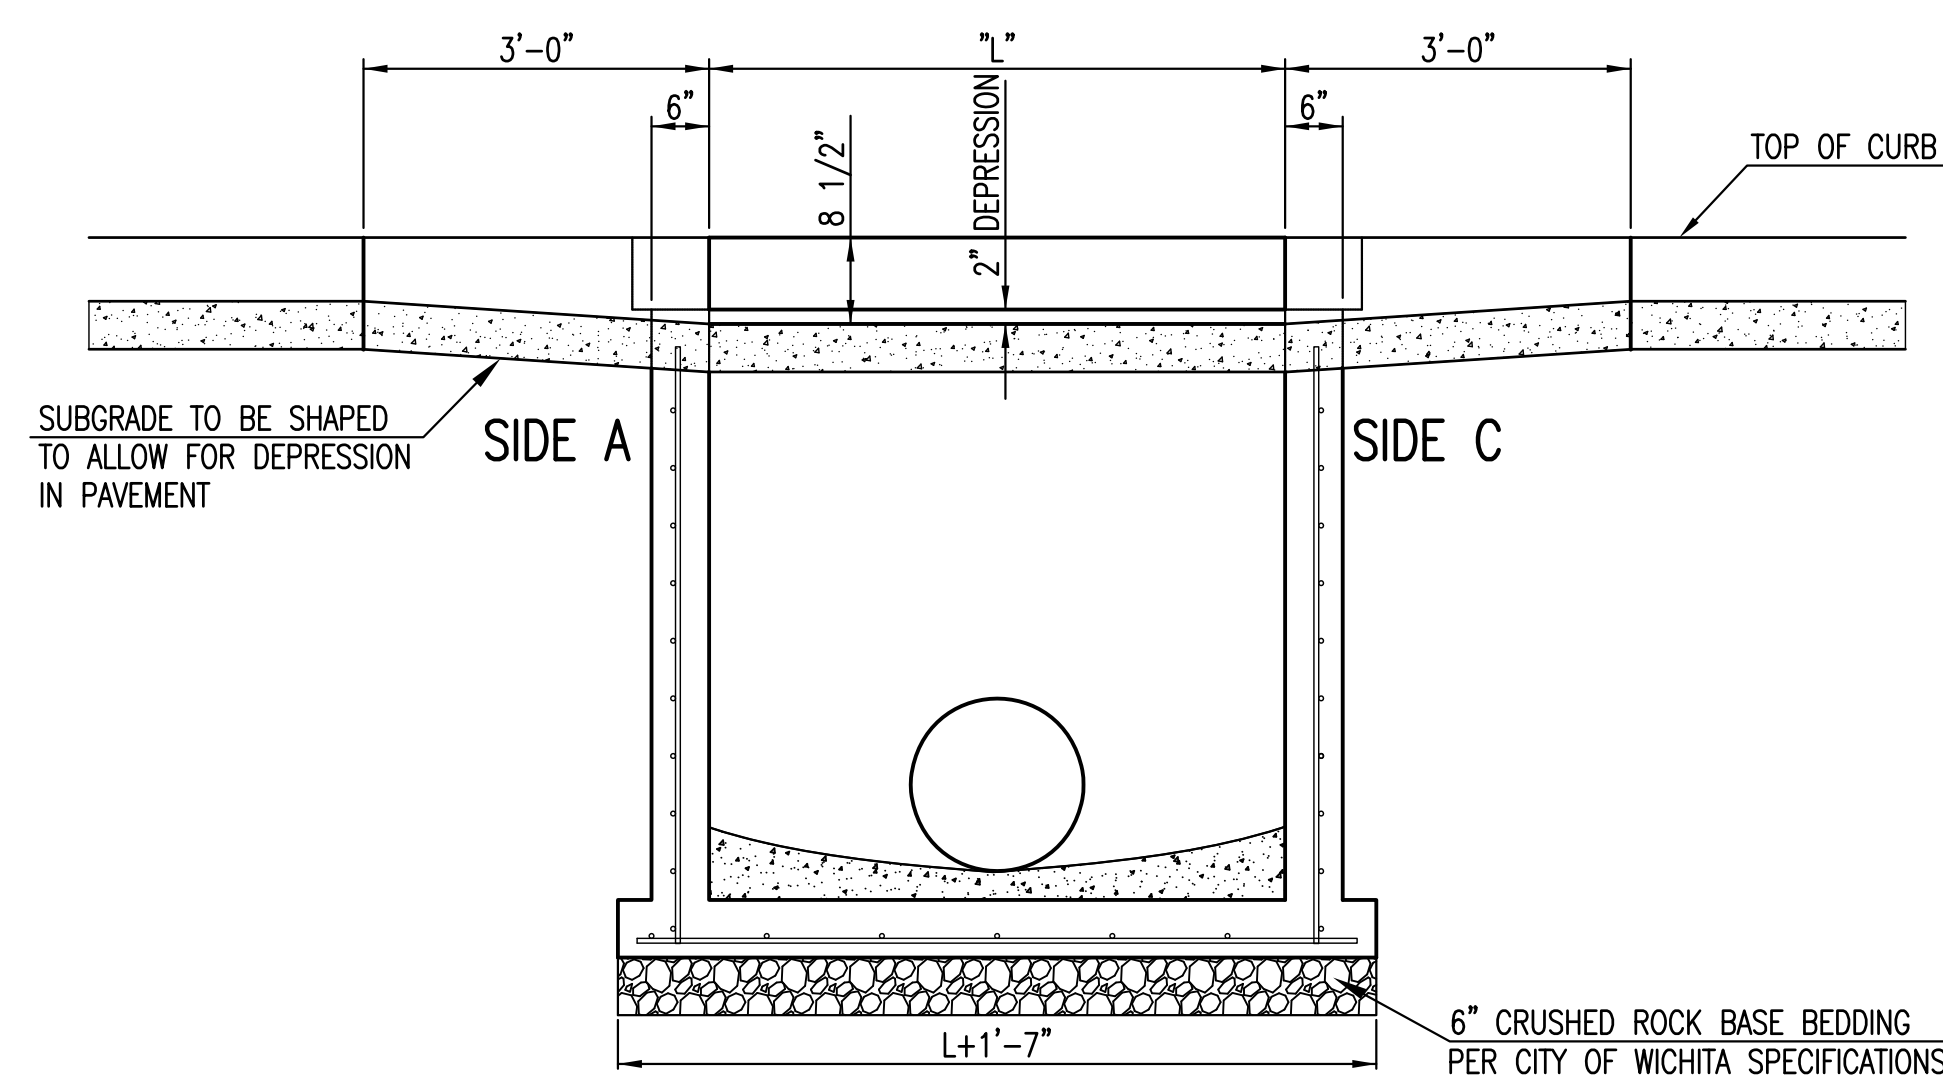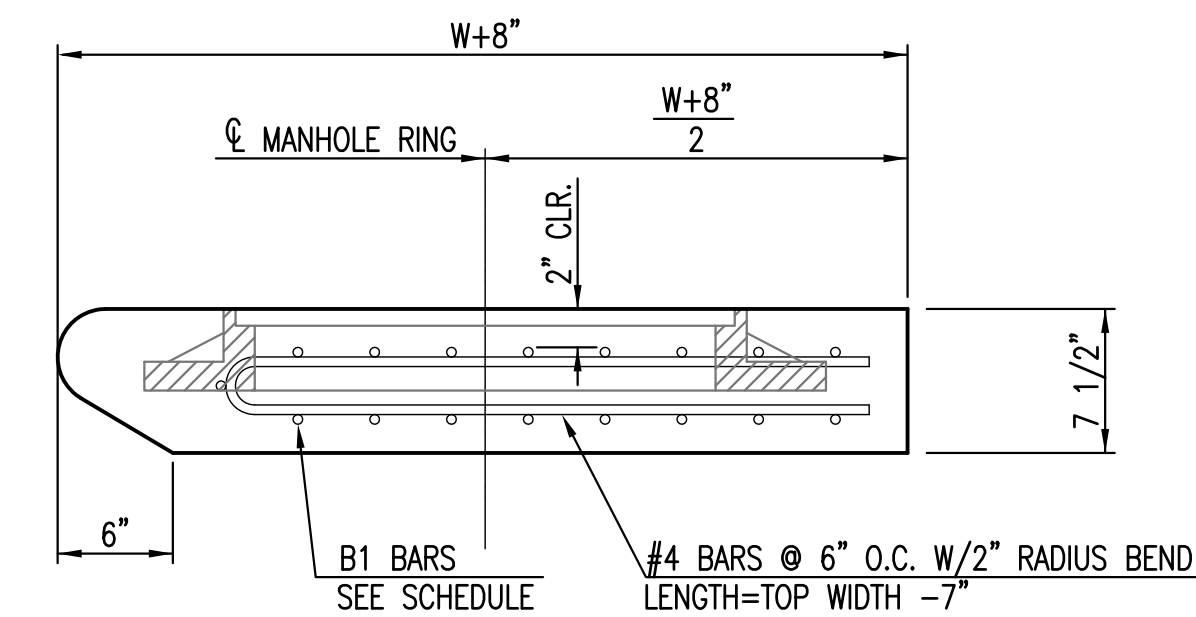


SECTION "B-B"

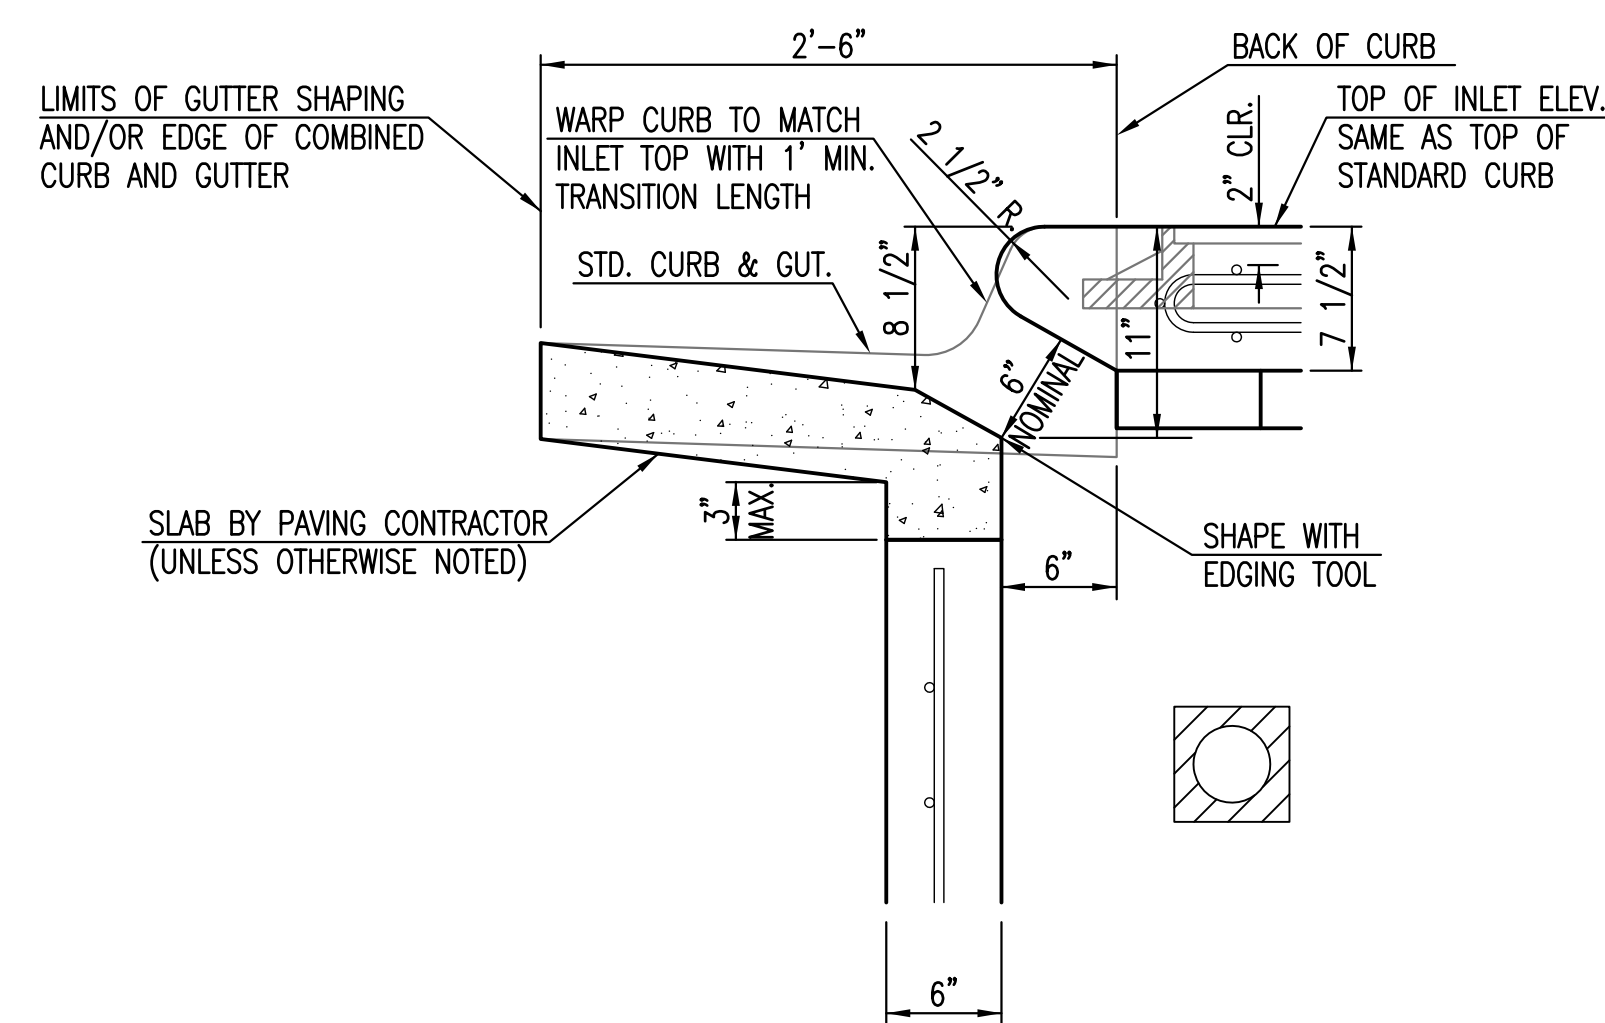

SECTION "D-D"



STANDARD TYPE 1 CURB INLET 5'-0" OR 10'-0" OPENING		
CITY ENGINEER GARY JANZEN, P.E.		
PROJECT NUMBER	OCA NUMBER	DATE 11/2010
CITY ENGINEER'S OFFICE CITY HALL - SEVENTH FLOOR 455 NORTH MAIN STREET WICHITA, KANSAS 67202-1620 (316) 268-4501		SHEET 6.1

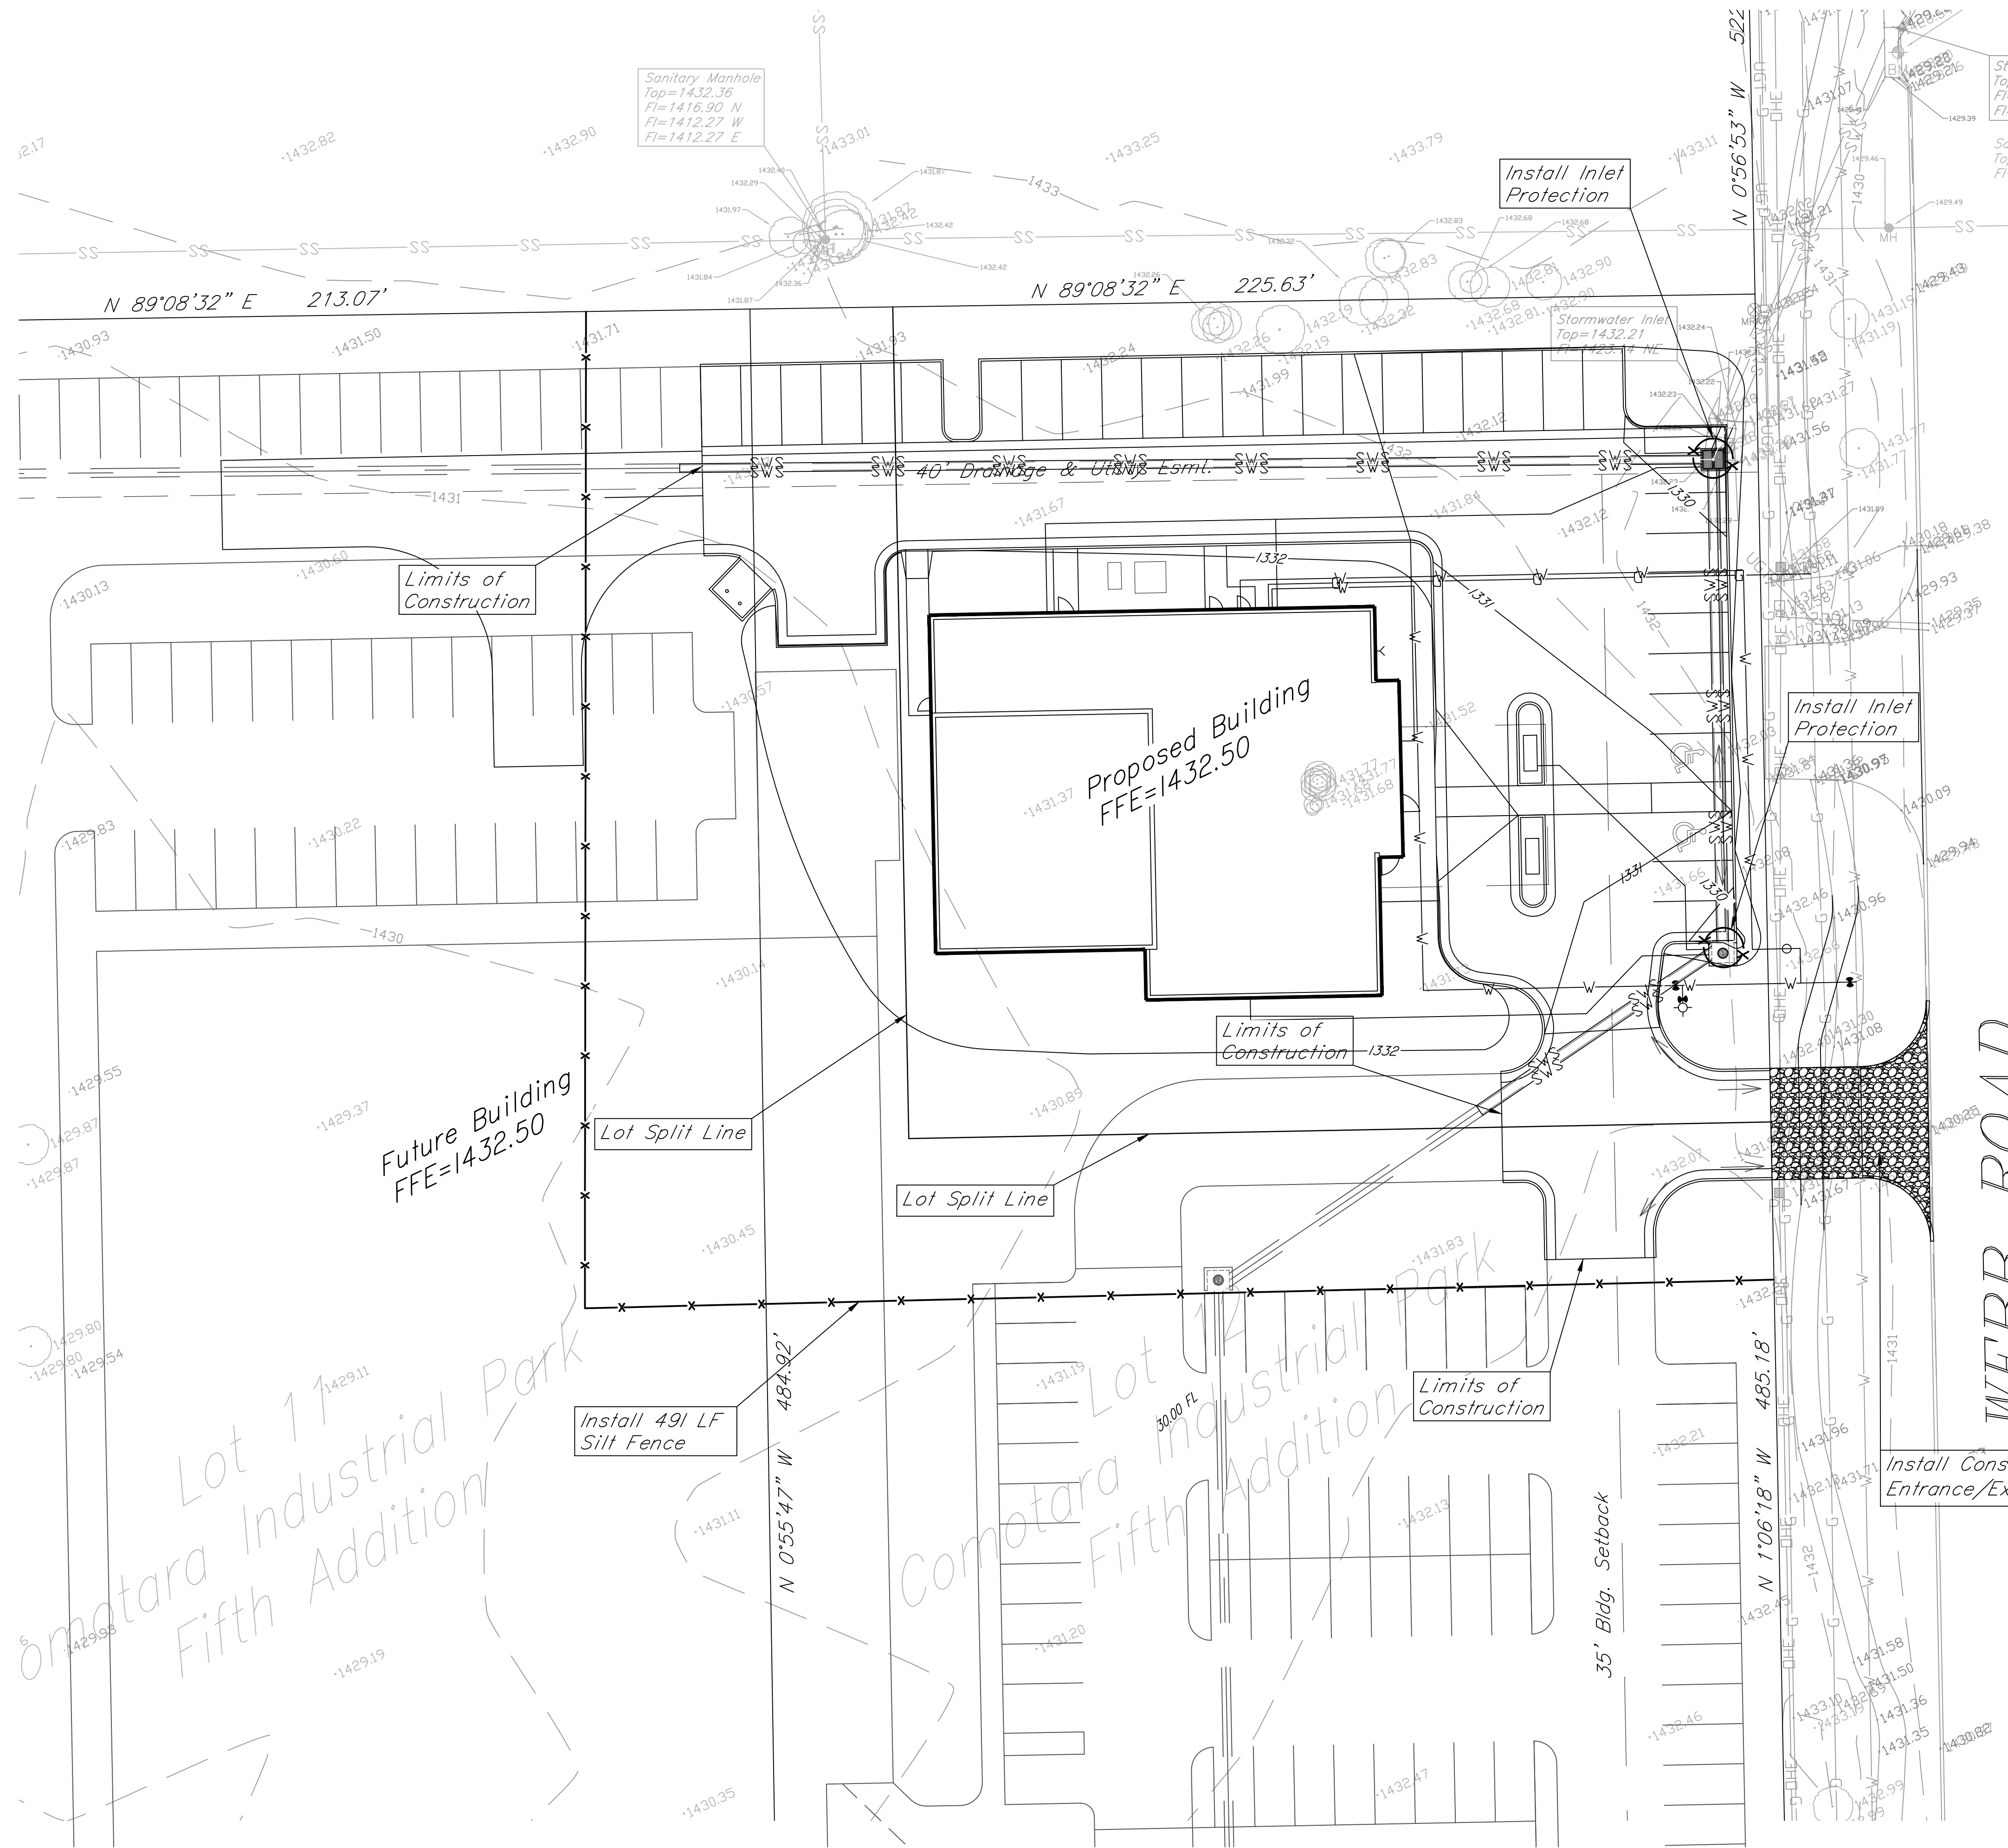


General Notes:

1. The BMP's shown on this sheet are considered minimum standards. Whenever sediment enters the streets, storm sewers, ditches, or ponds, contractor will install additional BMP's, as needed, to correct the problem.
2. The soil erosion BMP's shown hereon must be in place at all times during construction until such time as the site is re-established with paving or grass.
3. Back of curb protection can include hay bale, silt fence, Curlex barrier, or approved alternate as shown on BMP standard details. This BMP must remain in place until the area between the curb and right-of-way line has been permanently stabilized.
4. The General Contractor is responsible for the installation and maintenance per the prevention maintenance plan.
5. Concrete trucks will be permitted to wash out at approved locations, then maintain and clean up as conditions require, by contractor. No hazardous materials are expected to be encountered. Any spills (diesel, fuel, oil, etc.) will be cleaned up and removed immediately. Portable toilets will be supplied and maintained at various sites along the project. Disposal of sewage will be handled by a contracting firm specializing in this activity.
6. The above mentioned storm water prevention methods will be monitored daily and maintained as required. A weekly erosion control log will be posted in the job trailer onsite, and updated weekly. Site inspections are required within 24 hours after a precipitation event of 0.5" or greater.


LEGEND:

- Flow Direction
- ⊗ Inlet Protection - to be provided at all inlets subject to silt laden runoff.
- Ditch Check
- Temporary Seeding and Mating.
- Silt Fence or Hay Bale Barrier - to be installed along property lines where runoff from construction site can run onto other properties.
- Stabilized Construction Entrance - to be used at all locations where vehicles or equipment enter or exit property.
- Back of Curb Protection - to be installed whenever curb is backfilled to less than 3 inches from top and disturbed earth exists adjacent thereto. (See City Standard Details.)

Benchmark
 City of Wichita Disc approximately 9' west of siren pole and 3' north of curb on the northwest corner of 34th Street and Webb Road.
 Elevation=1432.09 NAVD88

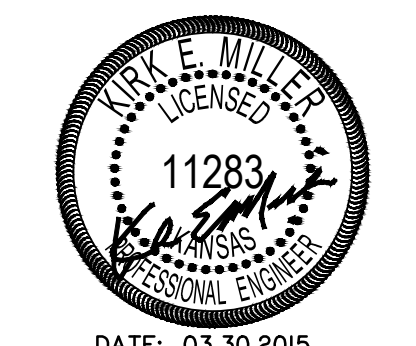

DATE: 03.30.2015
 THIS SHEET HAS BEEN SIGNED, SEALED AND DATED ELECTRONICALLY

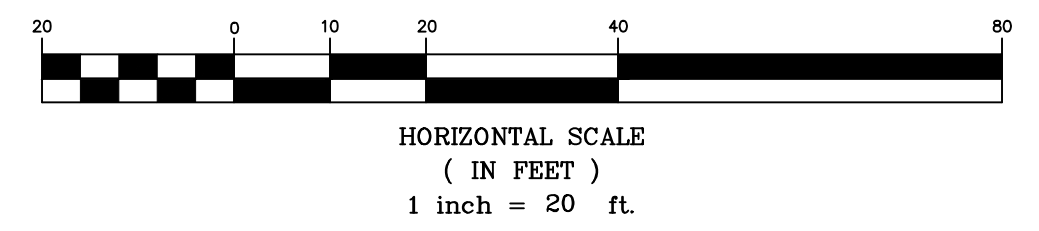

**Outpatient Cath Lab Shell Building
 Heartland Cardiology**

Wichita, Kansas

PRINTS ISSUED
 11-05-14 Shell Bldg for Tenant Finish
 01-12-15 For Bidding
 03-02-15 Conditional Permit
 3-30-15 For Construction

WDM No. 14089
 drawn: rlf
 checked: rfm
 Erosion Control Plan

C7.0

