

# LATERAL 545

## SOUTHWEST INTERCEPTOR SEWER

FOR  
55th STREET SOUTH, EAST OF SENECA

THE CITY OF WICHITA,  
SEDGWICK COUNTY, KANSAS

Gary Janzen, P.E., City Engineer


City Project No. - 468-85020  
O.C.A. No. - 744395

September 2015


Danco Construction - Contractor  
G. Baalman - City of Wichita, Field Project Engineer  
J. Koleczek - City of Wichita, Inspector  
As-built  
Stub  
Release Date: 03/14/2016  
pdf: apr 04/22/2016

### Index

- 1 Title Sheet
- 2 Notepage
- 3 Sanitary Sewer Plan & Profile
- 4 Sanitary Sewer Manhole Details
- 5 Detour Plan
- 6-8 Traffic Control Details
- 9-13 Erosion Control Details

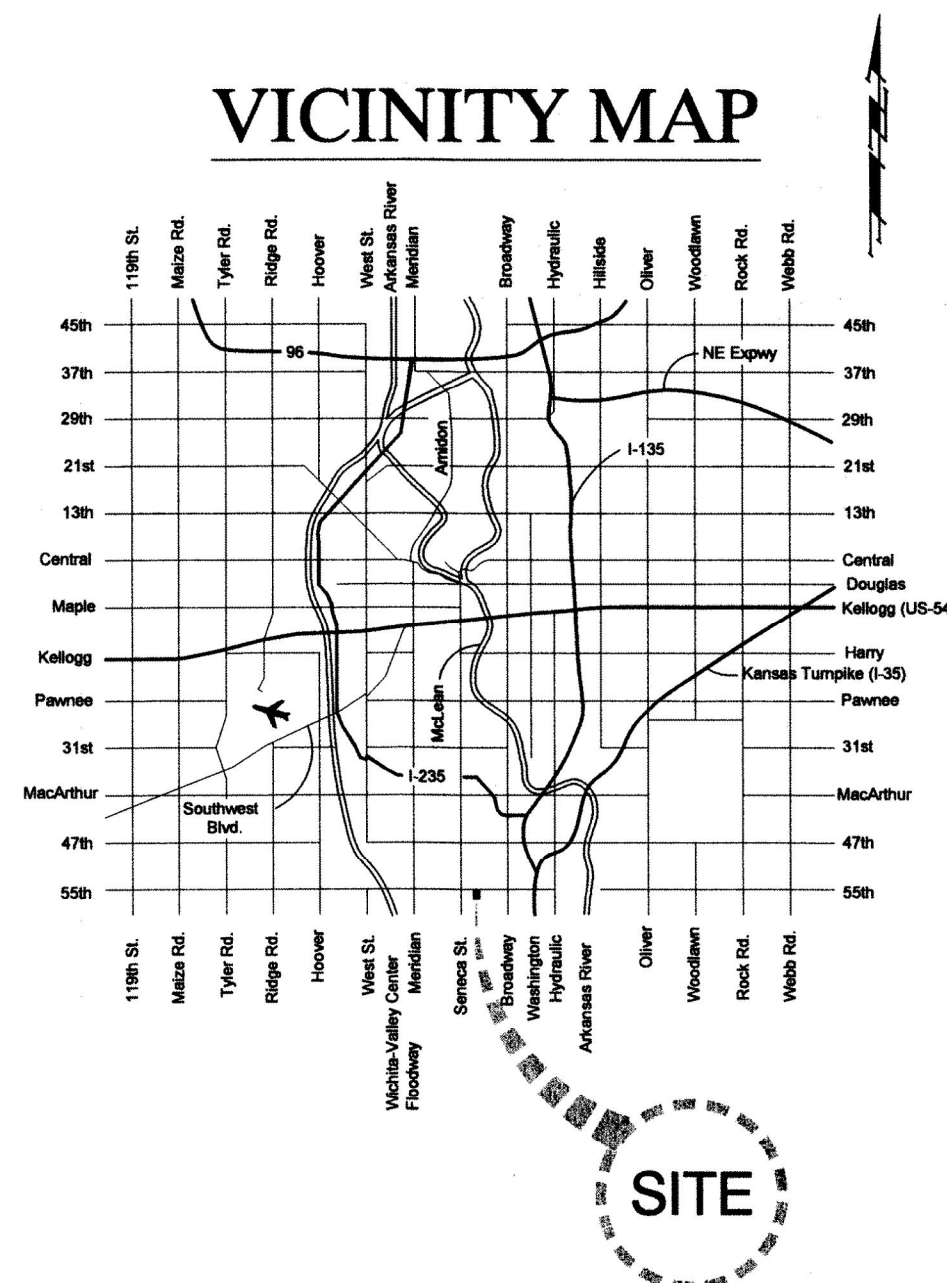

SCALE: 1" = 200'

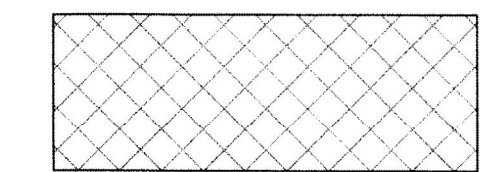

**BENEFIT DISTRICT**

Lateral 545, Southwest Interceptor Sewer

