


FHWA REG NO.	STATE	PROJECT NO.	YEAR	SHEET NO.	TOTAL SHEETS
7	KANSAS	87N-0116-01	1999	91	110

DATE	BY	REFERENCES NOTED	REFERENCES CHECKED

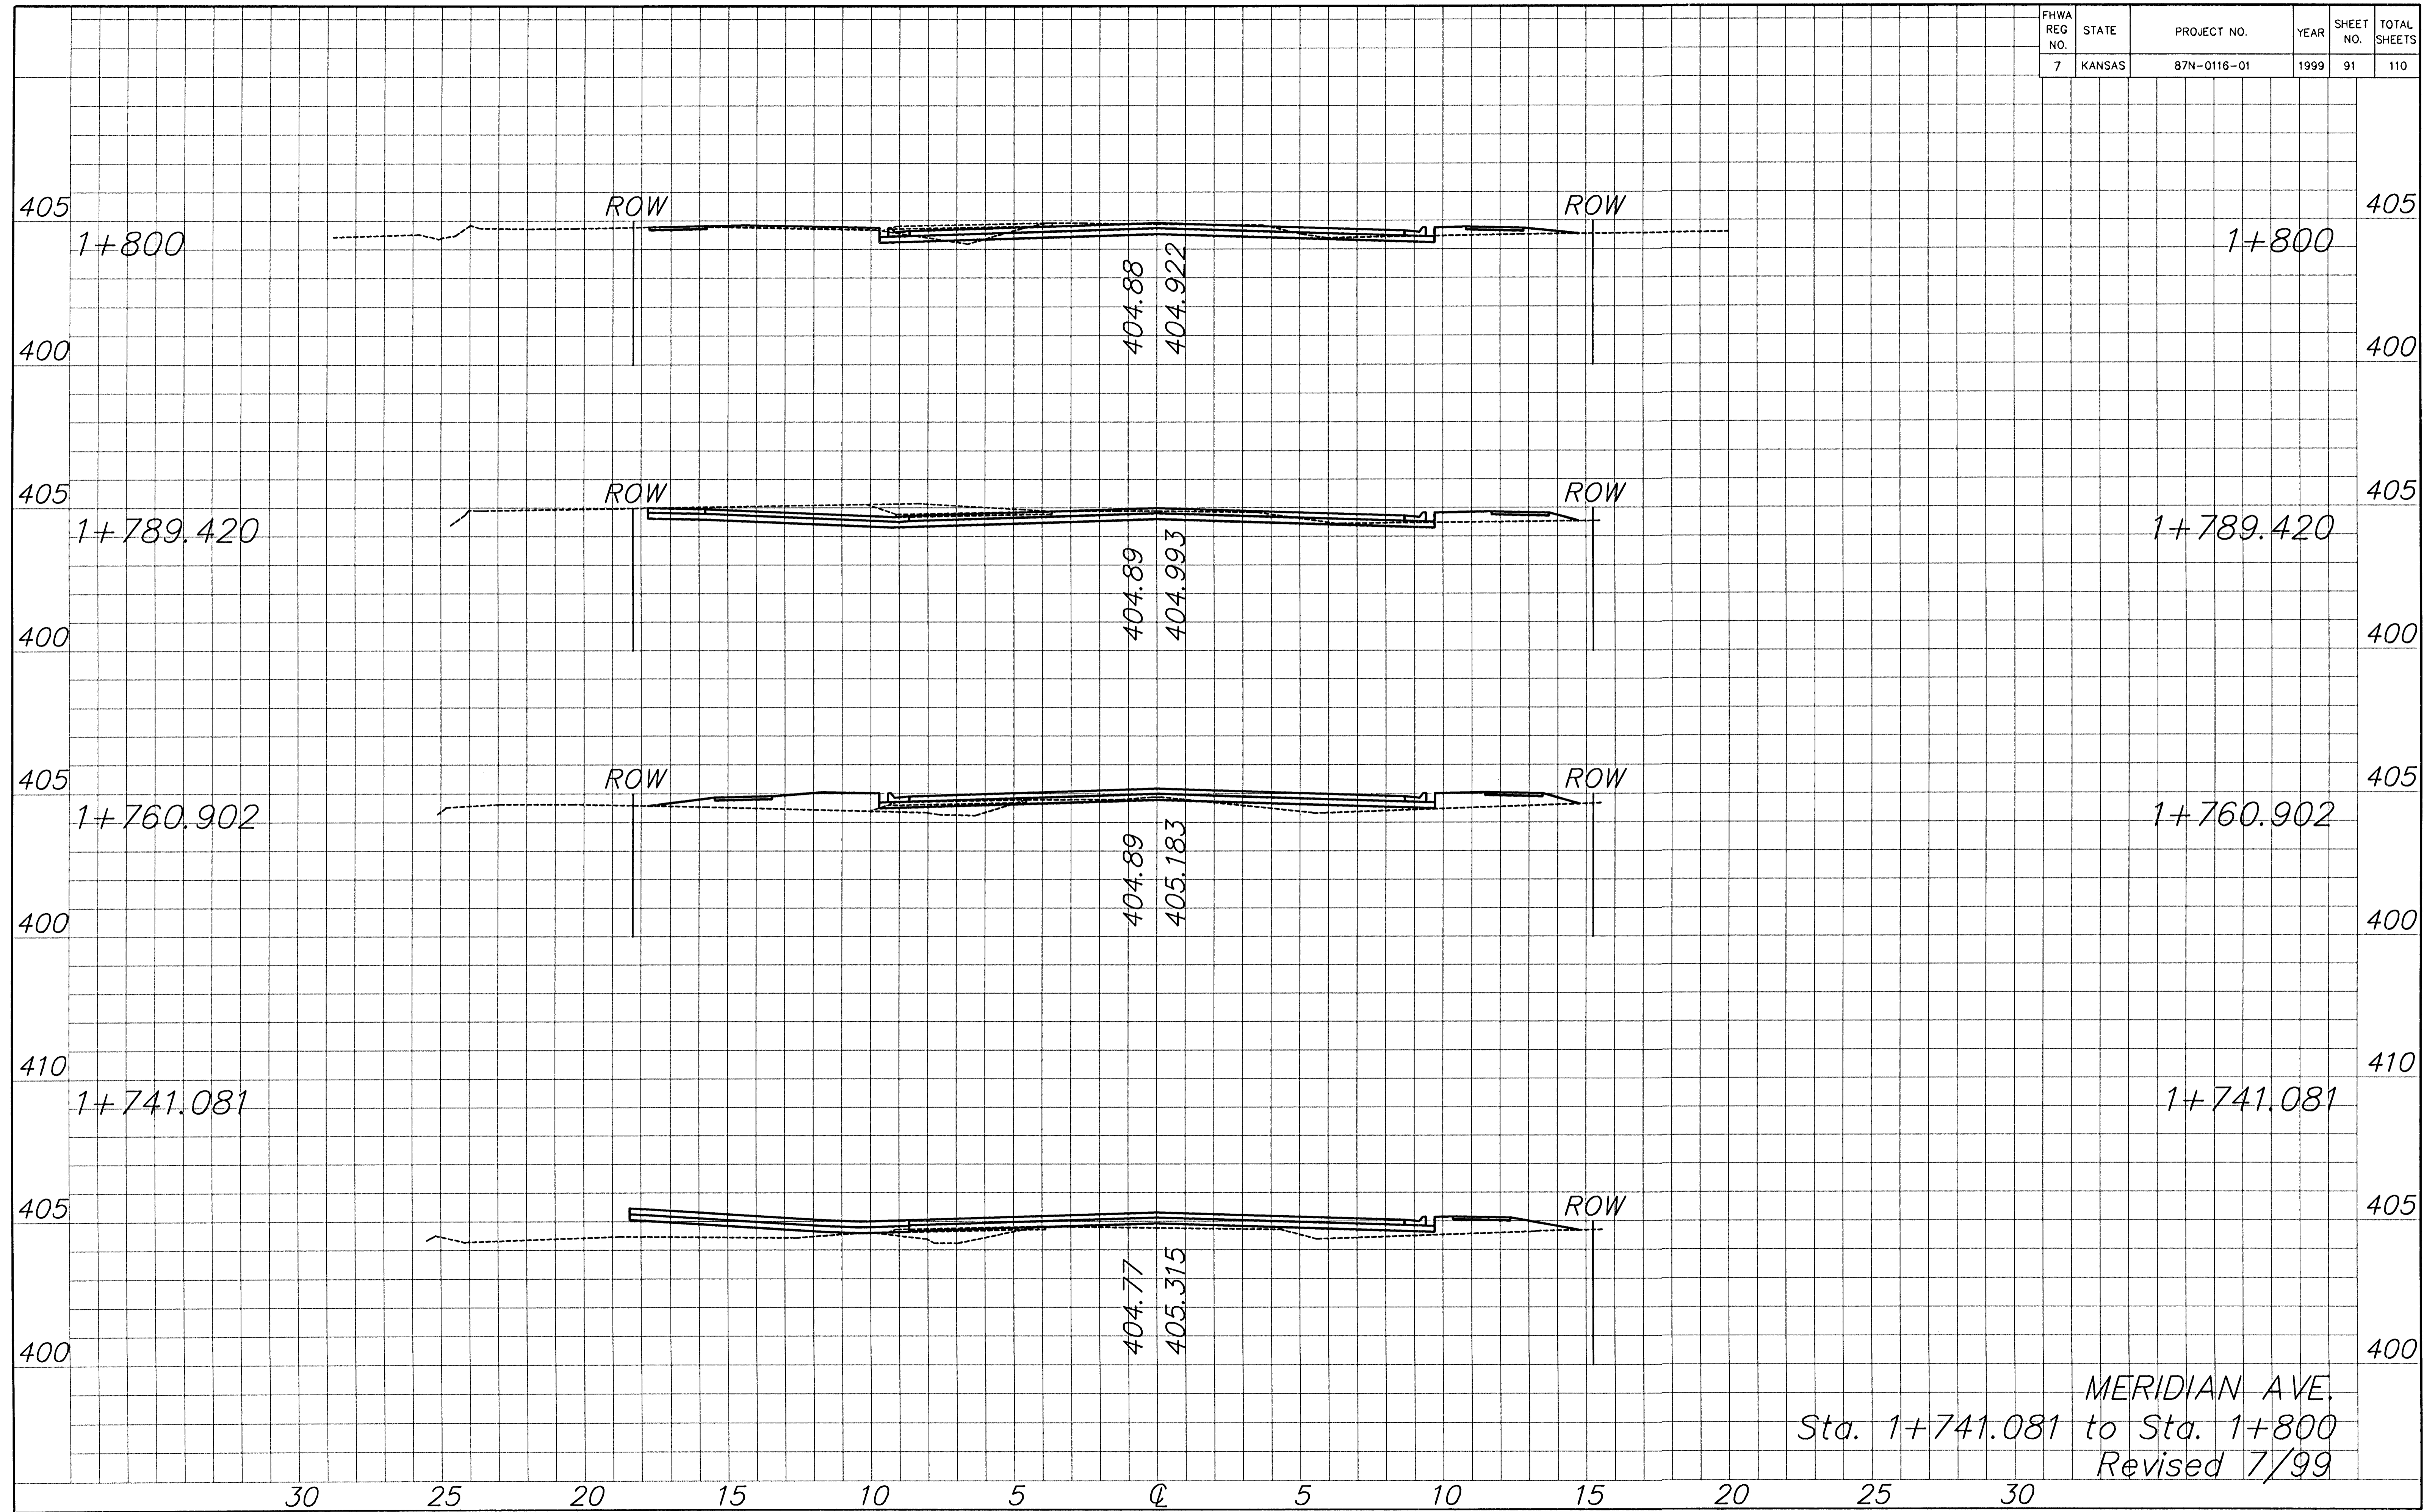

MERIDIAN AVE.
 Sta. 1+741.081 to Sta. 1+800
 Revised 7/99

K:\CIVIL\97043\REVISION\SECTION\RAF207.DWG F71 Aug 06 13:49:41 1999