


AS BUILT PLANS

Contractor: Ewertz Excavation
 Inspector: Fred Smith, Baughman Co.
 pdf's by: KEK, 3/11/16

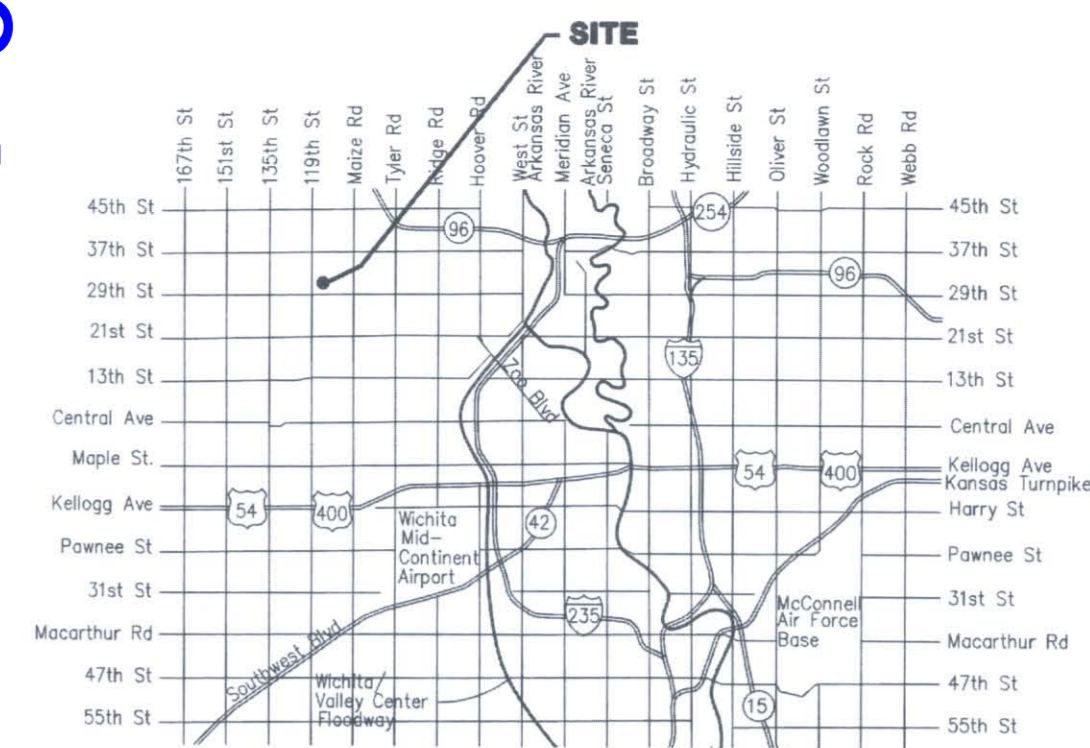

Vicinity Map

STORM SEWER IMPROVEMENTS to serve OXFORD VILLAS AT NEWMARKET SQUARE


3130 N. PARKDALE CIRCLE, WICHITA, KANSAS

CITY OF WICHITA, KANSAS

Gary Janzen, P.E. City Engineer
 Project Number
 0334 PPD (607861)

GENERAL NOTES

- THE CONTRACTOR SHALL COMPLY WITH ALL APPLICABLE SAFETY REGULATIONS. ALL CONSTRUCTION SHALL BE COMPLETED FOLLOWING CURRENT CITY STANDARD SPECIFICATIONS AND SPECIAL PROVISIONS.
- CONTRACTOR WILL BE REQUIRED TO PROVIDE NOTICE TO UTILITY COMPANIES A MINIMUM OF SEVENTY-TWO (72) HOURS PRIOR TO ANY EXCAVATION, AS FOLLOWS:
 KANSAS ONE-CALL 687-2470
 THE CONTRACTOR MUST NOTIFY THE FOLLOWING IN CASE OF AN EMERGENCY:
 AT&T 1-800-246-8464
 BLACK HILLS ENERGY 1-800-694-8989
 CITY OF WICHITA WATER 1-316-268-4555
 CITY OF WICHITA SEWER 1-316-268-4073
 CITY OF WICHITA STORMWATER 1-316-268-4090
 CITY OF WICHITA TRAFFIC 1-316-268-4034
 COX COMMUNICATIONS 1-888-249-3530
 KANSAS GAS SERVICE 1-888-482-4950
 WESTAR ENERGY 1-800-544-4857
- UTILITY SERVICE LINES, POLES, ETC. ARE TO BE ADJUSTED AS NECESSARY BY OTHERS PRIOR TO CONSTRUCTION UNLESS THE PLANS SPECIFICALLY CALL FOR THEIR ADJUSTMENT BY THE CONTRACTOR OR UNLESS THE PLANS SPECIFICALLY IDENTIFY A UTILITY TO BE ADJUSTED BY ITS OWNER DURING CONSTRUCTION. EXISTING UTILITIES AND THEIR LOCATION, AS SHOWN ON THE PLANS, REPRESENT THE BEST INFORMATION OBTAINABLE FOR DESIGN. THE CONTRACTOR WILL BE REQUIRED TO WORK AROUND EXISTING UTILITIES WITHIN THE RIGHT-OF-WAY WHICH DO NOT CONFLICT WITH PROPOSED CONSTRUCTION.
- RUBBLE FROM THE REMOVAL OF MISCELLANEOUS STRUCTURES AND EXCESS EXCAVATION WHICH IS TO BE WASTED SHALL BE DISPOSED OF ON SITES TO BE PROVIDED BY THE CONTRACTOR. THESE SITES SHALL BE APPROVED BY THE ENGINEER AS TO SUITABILITY, APPEARANCE AND SITE LOCATION. LOCATIONS, IN THE OPINION OF THE ENGINEER, THAT WILL LEAVE AN UNSIGHTLY APPEARANCE WILL NOT BE APPROVED. ALL DISPOSAL SITES MUST BE APPROVED BY THE KANSAS DEPARTMENT OF HEALTH AND ENVIRONMENT. MATERIAL EITHER STOCKPILED OR DISPOSED OF IN A FLOOD PLAIN WILL REQUIRE A KANSAS STATE BOARD OF AGRICULTURE PERMIT. ANY MATERIAL DUMPED IN WATERS OF THE UNITED STATES OR WETLANDS IS SUBJECT TO U.S. CORPS OF ENGINEERS PERMITTING REGULATIONS. ANY MATERIAL BURIED OR STOCKPILED BEYOND APPROVED CONSTRUCTION LIMITS WILL REQUIRE ADDITIONAL ARCHAEOLOGICAL INVESTIGATIONS UNLESS BURIED IN A PREVIOUSLY APPROVED BORROW LOCATION.
- TREES AND SHRUBS IN PUBLIC RIGHT-OF-WAY WHICH ARE IN DIRECT CONFLICT WITH PROPOSED NEW CONSTRUCTION SHALL BE REMOVED BY THE CONTRACTOR WITH THE ENGINEER'S APPROVAL. TREES AND SHRUBS WHICH ARE NOT IN DIRECT CONFLICT WITH PROPOSED NEW CONSTRUCTION SHALL BE SAVED AND PROTECTED FROM DAMAGE.
- THE CONTRACTOR SHALL GIVE ALL PROPERTY OWNERS AND/OR TENANTS OF DEVELOPED PROPERTY ADJUTING THE CONSTRUCTION OF THIS PROJECT A MINIMUM OF TEN (10) DAYS NOTICE PRIOR TO START OF CONSTRUCTION.
- THE CONTRACTOR SHALL BE RESPONSIBLE FOR PRESERVING PROPERTY IRONS. THE CONTRACTOR WILL BE REQUIRED TO RE-ESTABLISH ANY PROPERTY IRONS WHICH ARE DAMAGED OR DESTROYED BY HIS CONSTRUCTION OPERATIONS. SUCH IRONS SHALL BE RE-ESTABLISHED BY A LICENSED LAND SURVEYOR IN ACCORDANCE WITH STATE LAWS.
- THE WATER DISTRIBUTION DIVISION SHALL FIELD LOCATE WATER VALVES ONE TIME DURING CONSTRUCTION WHEN REQUESTED BY THE CONTRACTOR. IT SHALL BE THE CONTRACTOR'S RESPONSIBILITY TO PRESERVE SUCH FIELD LOCATIONS DURING THE CONSTRUCTION PROCESS. WATER VALVES, VALVE BOXES OR FIRE HYDRANTS DAMAGED DURING CONSTRUCTION SHALL BE REPAIRED BY CONTRACTOR AT HIS OWN EXPENSE. VALVE BOXES AND WATER METERS WITHIN THE PROJECT LIMITS SHALL BE ADJUSTED TO MATCH FIELD GRADES.
- THE CONTRACTOR SHALL NOTIFY THE CONSULTANT ENGINEER AND TOM MASON WITH THE CITY AT 316-268-4574 WITH THE ANTICIPATED CONSTRUCTION START DATE AND NOTIFY THEM OF PROJECT COMPLETION. STAKING AND INSPECTION FOR THIS PROJECT WILL BE THE RESPONSIBILITY OF THE CONTRACTOR.
- IF TRAFFIC WILL BE IMPACTED BY CONSTRUCTION, A TRAFFIC CONTROL PLAN MUST BE SUBMITTED AND APPROVED BY THE CITY TRAFFIC ENGINEER, BRIAN COON AT TRAFFIC@WICHITA.GOV BEFORE CONSTRUCTION CAN BEGIN. THE CONTRACTOR SHALL BE RESPONSIBLE FOR ALL TRAFFIC CONTROL MEASURES TO FACILITATE CONSTRUCTION. ALL CONSTRUCTION ZONE MARKINGS AND SIGNAGE SHALL CONFORM TO THE LATEST VERSION OF THE MANUAL ON UNIFORM TRAFFIC CONTROL DEVICES (MUTCD) AS PUBLISHED BY THE US DEPT. OF TRANSPORTATION, FEDERAL HIGHWAY ADMINISTRATION. ALL COSTS ASSOCIATED WITH CONSTRUCTION MARKINGS AND SIGNAGE SHALL BE THE CONTRACTORS RESPONSIBILITY.
- ALL ELEVATIONS SHOWN ARE NAVD 88.
- ALL AREAS DISTURBED DURING CONSTRUCTION THAT WILL NOT BE UNDER PROPOSED PAVEMENT SHALL BE RESTORED IN ACCORDANCE WITH THE LANDSCAPE PLANS.
- A PORTION OF EXCESS EXCAVATED MATERIAL SHALL BE MOUNDED AROUND MANHOLES WHICH EXTEND MORE THAN ONE (1) FOOT ABOVE THE EXISTING GROUND. SUCH MOUNDINGS SHALL BE CONSTRUCTED WITH NEW DEVELOPMENT AS A SIX (6) FOOT DIAMETER FLAT TOP WITH 4 TO 1 SIDE SLOPES DOWN TO THE ORIGINAL GROUND. THE ELEVATION OF THE FLAT TOP OF THE MOUND SHALL BE 0.4 FOOT BELOW THE TOP OF THE MANHOLE.
- GEOTECHNICAL REPORT AVAILABLE UPON REQUEST.
- CONTRACTOR SHALL LIMIT THE EXTENT OF TRENCH OPEN OVERNIGHT AND WEEKENDS TO LESS THAN 50 FEET.
- CONTRACTOR SHALL PROVIDE POSITIVE DRAINAGE AWAY FROM ALL MANHOLE COVERS.
- CITY MAINTENANCE OF STORM SEWER ENDS AT RIGHT-OF-WAY OR EASEMENT LINE.
- ANY SIDEWALK, DRIVE APPROACH, OR STREET PAVEMENT REMOVED TO CONSTRUCT PROJECT MUST HAVE A PAVEMENT CUT PERMIT AND BE REPLACED BY THE CITY CONTRACTOR. PERMITS CAN BE OBTAINED BY CALLING 316-268-4501 OR 316-268-4480.
- THE INSPECTING FIRM SHALL SUBMIT TO THE CITY STORMWATER MAINTENANCE DIVISION A DIGITAL COPY OF THE CCTV INSPECTION OF THE CONDUITS AND STRUCTURES FOLLOWING CONSTRUCTION. THE DIGITAL FILE FORMATION SHALL BE COMPATIBLE WITH THE CITY INPUT TEMPLATE. A COPY OF THE TEMPLATE IS AVAILABLE UPON REQUEST AT 316-268-4090.
- ALL APPROVED EXCESS EXCAVATION WHICH IS TO BE WASTED SHALL BE STOCKPILED AS DIRECTED BY THE ENGINEER AT NO ADDITIONAL COST TO THE OWNER. STOCKPILE LOCATIONS SHALL BE AS DIRECTED BY THE OWNER AND IN ACCORDANCE WITH GENERAL NOTE NO. 4 ABOVE.
- ALL LAWN/TURF AREAS DISTURBED BY CONSTRUCTION OF THE PROPOSED IMPROVEMENTS SHALL BE RESTORED IN ACCORDANCE WITH THE LANDSCAPE PLANS.
- THE CONTRACTOR SHALL SEED ALL AREAS DISTURBED BY CONSTRUCTION ACTIVITIES WITH TEMPORARY RYE GRASS. RYE GRASS SEED SHALL BE PLANTED AT A MINIMUM RATE OF SIX (6) POUNDS PER ONE THOUSAND (1,000) SQUARE FEET. THIS TEMPORARY SEEDING MAY BE OMITTED IF OTHER SEEDING IS REQUIRED IN ACCORDANCE WITH GENERAL NOTE NO. 21 ABOVE. TEMPORARY SEEDING OR PERMANENT SEEDING/SODDING SHALL BE APPLIED WITHIN 14 DAYS AFTER THE AREA HAS BEEN DISTURBED.
- THE CONTRACTOR SHALL PREVENT ANY CONSTRUCTION DEBRIS FROM ENTERING THE EXISTING STORM WATER SEWER AND DETENTION POND DURING CONSTRUCTION.
- THE CONTRACTOR SHALL INSTALL AND/OR MAINTAIN EROSION CONTROL METHODS AS SPECIFIED. THE GENERAL LOCATION OF THE REQUIRED EROSION CONTROL IS ILLUSTRATED ON THE EROSION CONTROL PLAN. THE CONTRACTOR SHALL BE RESPONSIBLE FOR MAINTAINING THE EROSION CONTROL SHOWN THROUGH THE COMPLETION OF THIS PROJECT. INSTALLATION OF THESE BMP'S DOES NOT RELIEVE THE CONTRACTOR OF THE RESPONSIBILITY OF ABATING SOIL EROSION.
- REFERENCE CITY OF WICHITA PLANS (PROJECT NO. 472-84991 & NO. 472-85225) FOR OFFSITE PAVING AND DRAINAGE. COORDINATE WITH OTHER CONTRACTORS AS NECESSARY.

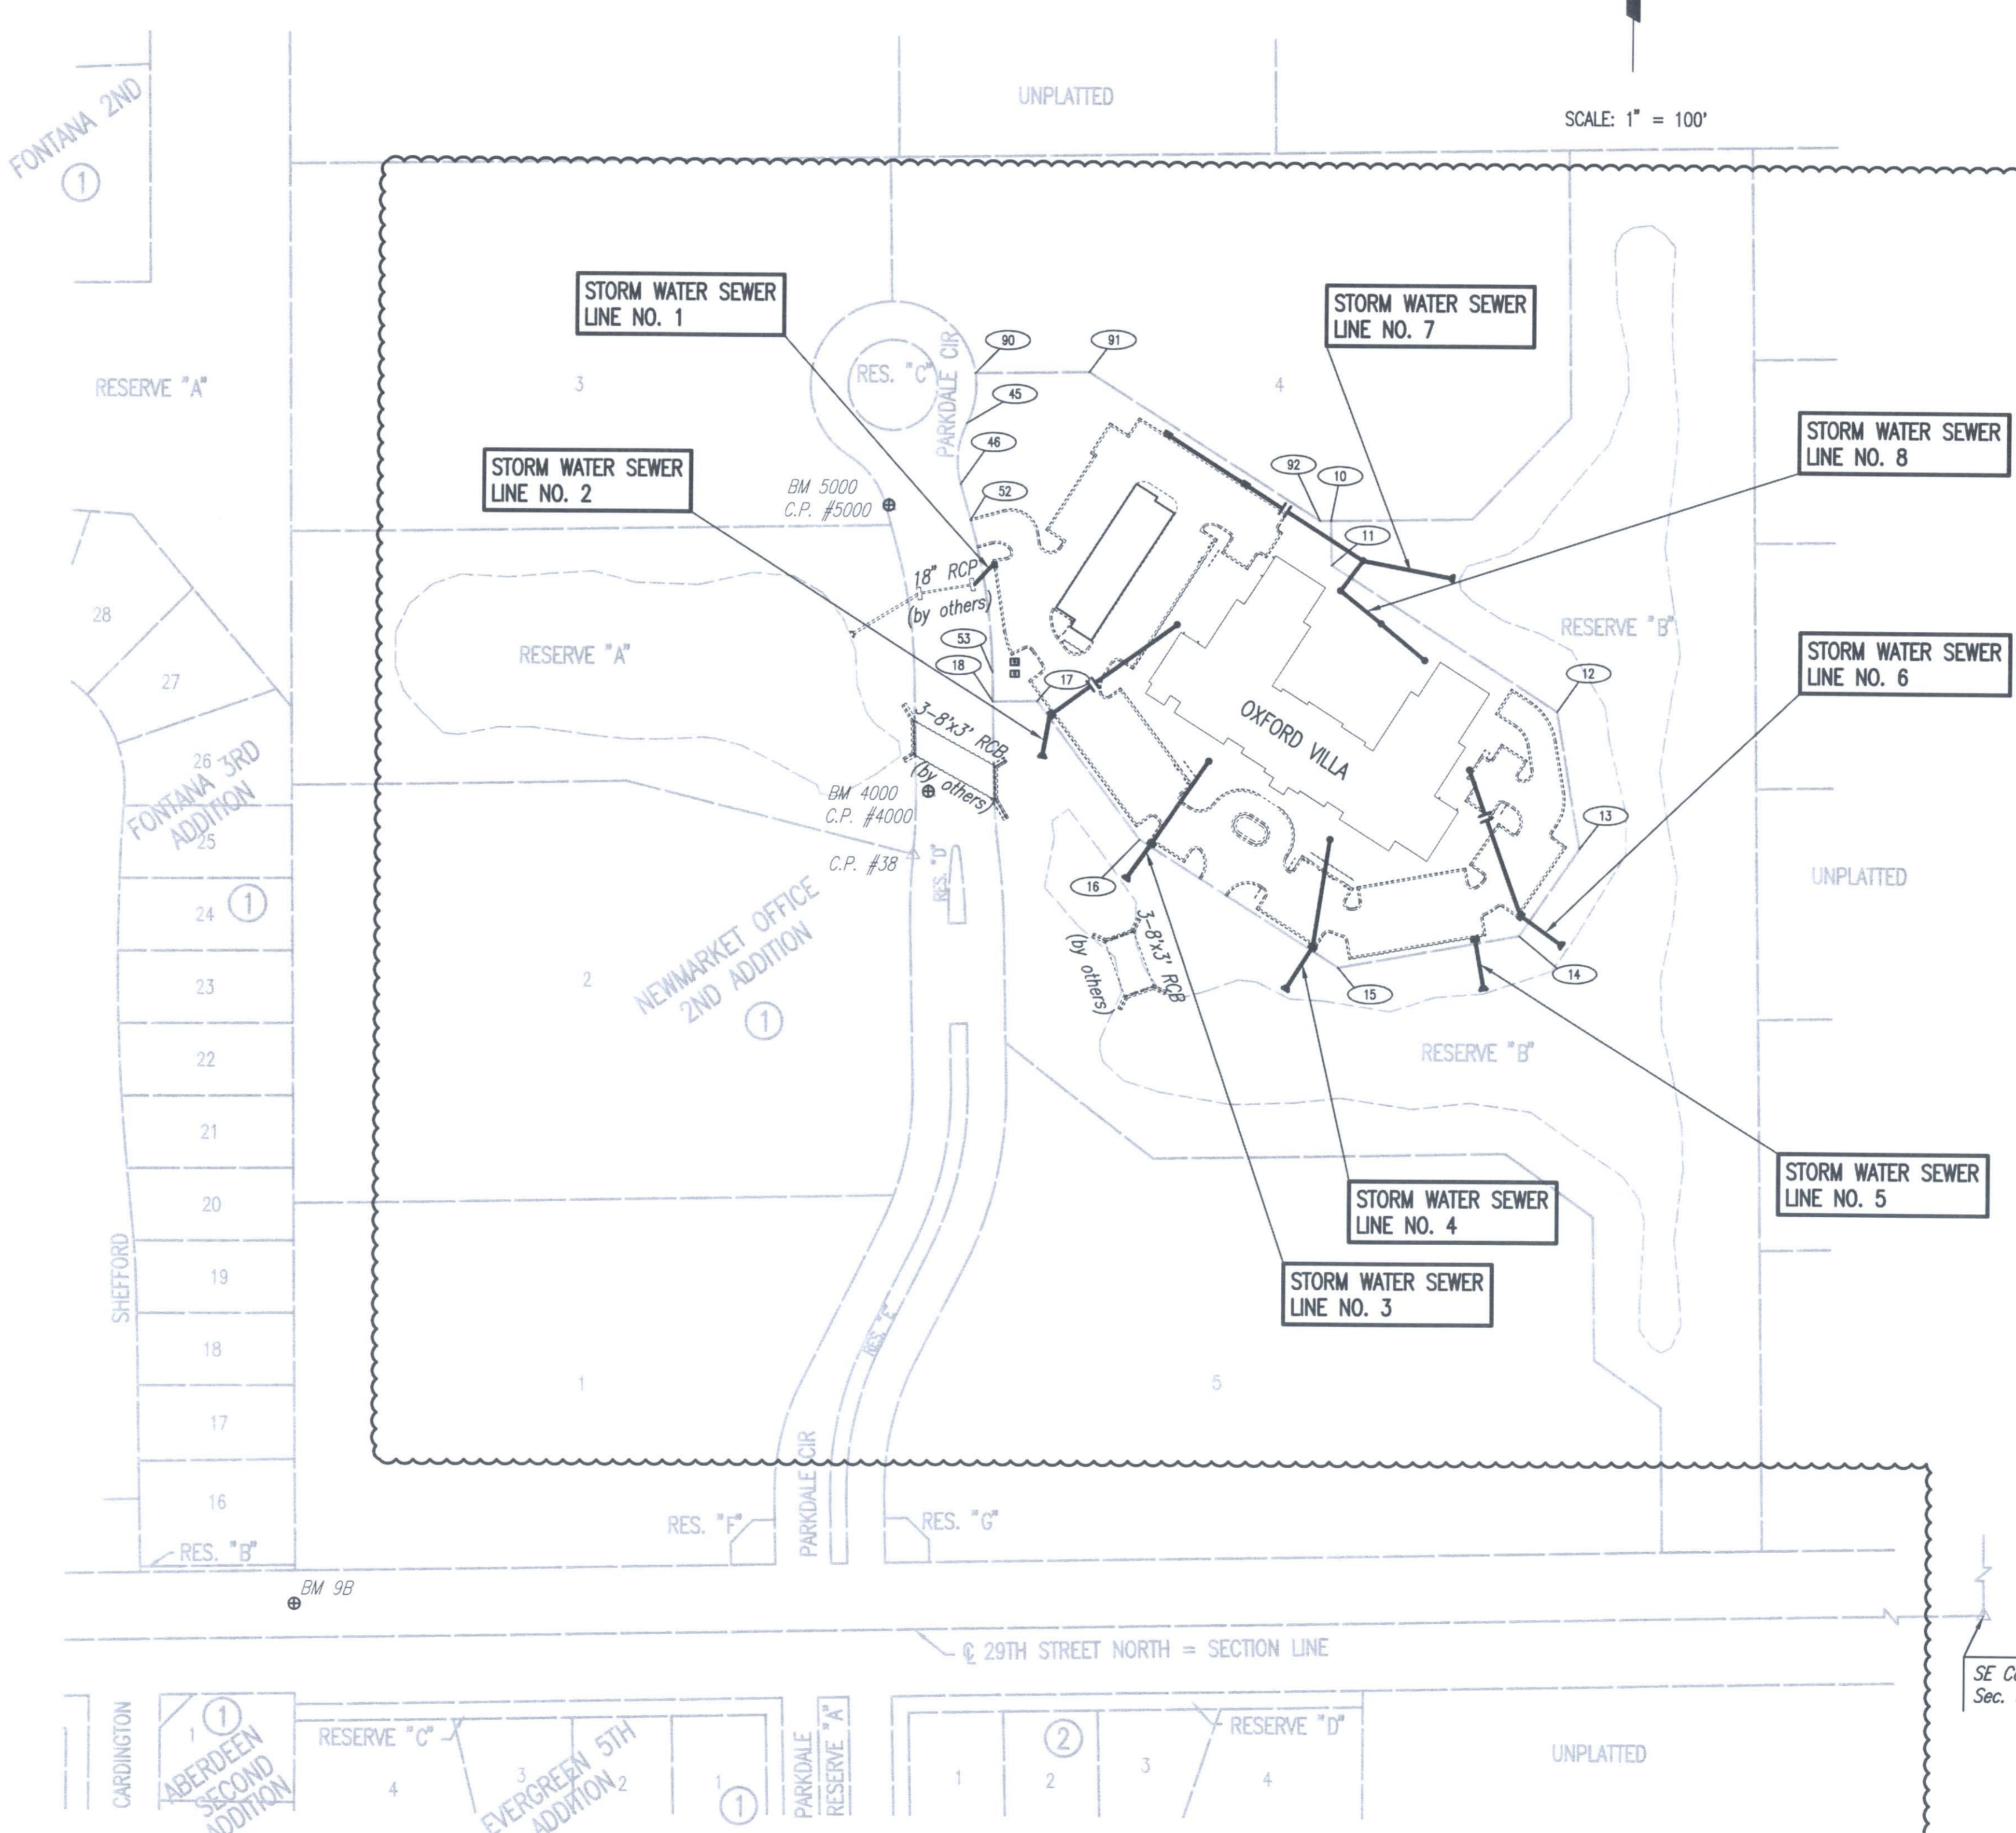

STORM WATER SEWER SHALL BE PRIVATELY MAINTAINED.

SCALE: 1" = 100'

SHEET INDEX

SHEET NO.	DESCRIPTION
SHEET NO. C4.1	PPD TITLE SHEET AND GENERAL NOTES
SHEET NO. C4.2	SWS LINE NO. 1 AND NO. 2
SHEET NO. C4.3	SWS LINE NO. 3
SHEET NO. C4.4	SWS LINE NO. 4 AND NO. 5
SHEET NO. C4.5	SWS LINE NO. 6
SHEET NO. C4.6	SWS LINE NO. 7
SHEET NO. C4.7	SWS LINE NO. 8
SHEET NO. C4.8	STANDARD TYPE 1 CURB INLET
SHEET NO. C4.9	PRECAST CONCRETE MANHOLE (STORM SEWER)
SHEET NO. C4.10	MANHOLE/INLET FRAME AND COVER (STORM SEWER)
SHEET NO. C4.11	SINGLE/DOUBLE DROP INLET
SHEET NO. C4.12	HEADWALL DETAILS
SHEET NO. C4.13	MISCELLANEOUS DETAILS (STORM SEWER)
SHEET NO. C2.3	COPY OF PLAT
SHEET NO. C1.4	GRADING PLAN
SHEET NO. C6.1	EROSION CONTROL PLAN
SHEET NO. C6.2 thru C6.6	EROSION CONTROL DETAILS

Stormwater Certification:
 New Development

These construction plans were prepared in accordance with the current Stormwater Management Regulations as set forth in the City of Wichita's Stormwater Management Ordinance 16.32 and the policies/guidelines presented in the Wichita/Sedgewick County Stormwater Manual.

Disturbed Area = 165,127 SQ.FT. (4.30 ACRES)
 Water Quality Treatment: Storm Water Detention Pond (Wet)
 Downstream Channel Protection: N/A
 Detention: Storm Water Detention Pond (Wet)
 The BMP used for this development is the Storm Water Detention Pond (Wet)

APPROVED AS NOTED
 BY WICHITA PUBLIC WORKS ENGINEERING AND STORMWATER DIVISION

Engineering: *Rebecca Dill* 10/20/2015
 Stormwater: *Joe Hinkle P.E.* 10/20/15

NOTE TO CONTRACTORS

Inspection and testing for this project is to be provided by a Licensed Consulting Engineering Firm under contract with the Owner/Developer. Said inspection to be in accordance with the City of Wichita standard construction engineering practices and certified by a Licensed Professional Engineer in the state of Kansas. No work shall be performed by the Contractor without such inspection nor shall any work be commenced without written authorization by City Engineering. All Construction and Materials shall comply with the current City of Wichita Specifications and Standards and Special Provisions. (on file and available at Wichita.gov).

An approved copy of these plans signed by City staff are required on-site.

SE Cor. SE 1/4
 Sec. 31, T26S, R1W

BENCHMARKS

- BM #98 - CHISELED "I" AT THE TOP OF THE CURB ON THE NORTH CURB OF 29TH STREET NORTH, ADJACENT TO THE S 1/4 COR. 31-126S-R1W. ELEV. 1365.00 (NAVD 88)
- BM #4000 - 1/2" REBAR 11.3' EAST OF THE WEST LINE OF PARKDALE CIRCLE, 30' SOUTH OF CHANNEL BETWEEN PONDS. ELEV. 1353.50 (NAVD 88)
- BM #5000 - 1/2" REBAR 3' EAST OF THE PC AT WEST LINE OF PARKDALE CIRCLE AT THE CUR-DE-SAC. ELEV. 1355.99 (NAVD 88)

HORIZONTAL CONTROL

- Pt. No. 38
 N-25,921.192, E-17,913.828
 1/2" REBAR W/ALPHA CAP
 1. NORTHEAST CORNER OF LOT 2, BLOCK 1
- Pt. No. 4000
 N-25,977.616, E-17,927.384
 1/2" REBAR
 1. 54.20' SW TO NE CORNER OF TRANSFORMER PAD.
 2. 29' NORTH TO FLOWLINE OF CHANNEL BETWEEN PONDS.
 3. 11.3' WEST TO 1/2" REBAR W/PEC CAP.
- Pt. No. 5000
 N-26,234.407, E-17,889.770
 1/2" REBAR
 1. 3' WEST TO 1/2" REBAR W/PEC CAP.
 2. 108.5' NORTH TO CENTER OF CUL-DE-SAC.
 3. 33' SOUTH TO PC AT WEST LINE OF PARKDALE CIRCLE.

PROPERTY CORNERS

POINT	COORDINATE LIST	
	NORTH	EAST
10	26,223.1930	18,286.0572
11	26,183.1991	18,286.7517
12	26,052.8978	18,491.5366
13	25,929.9894	18,512.5758
14	25,851.6961	18,457.5836
15	25,822.6124	18,294.6204
16	25,935.8503	18,116.9670
17	26,059.4055	18,024.4603

POINT	COORDINATE LIST	
	NORTH	EAST
18	26,058.6013	17,984.4684
53	26,084.6478	17,983.9446
52	26,221.3123	17,963.3409
46	26,253.4794	17,954.1202
45	26,308.2822	17,959.2856
90	26,353.0819	17,966.5053
91	26,354.8610	18,068.9495
92	26,223.0210	18,276.1525

⑩ = COORDINATE POINT NO.

OCTOBER 2015

PRINTS ISSUED

DATE	PURPOSE	NO.
05.11.2015	75% OWNER REVIEW	
05.20.2015	PERMIT SET/BID SET	
05.12.2015	ADDENDUM 1	1
08.10.2015	ADDENDUM 2	2
08.17.2015	ADDENDUM 3	3
09.15.2015	CCD 1	4
09.30.2015	CCD 2	5
10.19.2015	CCD 3	6

ADDED SHEET
 ENTIRE SHEET

OXFORD VILLA
 WICHITA, KS

LKArchitecture


Architecture • Engineering • Planning • Interior Design • Landscape Architecture



LKArchitecture, Inc.®
 345 Riverview Wichita, KS 67203
 T 316.268.0230 F 316.268.0205
 CONTACT: Isaac Krumme
 DRAWN: Roy Thomas
 CHECKED: Ben Mabry
 PROJECT NUMBER:
14619
 SHEET TITLE:
 PPD TITLE SHEET AND
 GENERAL NOTES
 SHEET NUMBER:
C4.1





Sheet: 10-19-2015, 1:51:05 PM, by: CSJ
 Plot: Scale: 1:1, 10-19-2015, 1:53:25 PM, by: CSJ
 U:\Wichita-City\2015\15120\005\Main\Drawings\15120-005-C4.1-PPD TITLE SHEET AND GENERAL NOTES

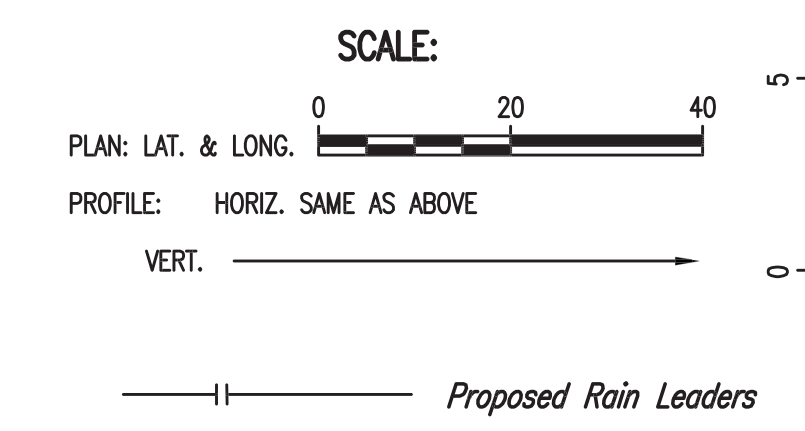

DATE	PURPOSE	NO.
05.11.2015	75% OWNER REVIEW	
05.29.2015	PERMIT SET/BID SET	
06.12.2015	ADDENDUM 1	1
08.19.2015	ADDENDUM 2	2
08.17.2015	ADDENDUM 3	3
09.15.2015	CD 1	4
09.30.2015	CD 2	5
10.19.2015	CD 3	6

- ▲ ADDED SHEET
- ▲ REVISED ENTIRE SHEET
- ▲ REVISED ENTIRE SHEET

OXFORD VILLA WICHITA, KS

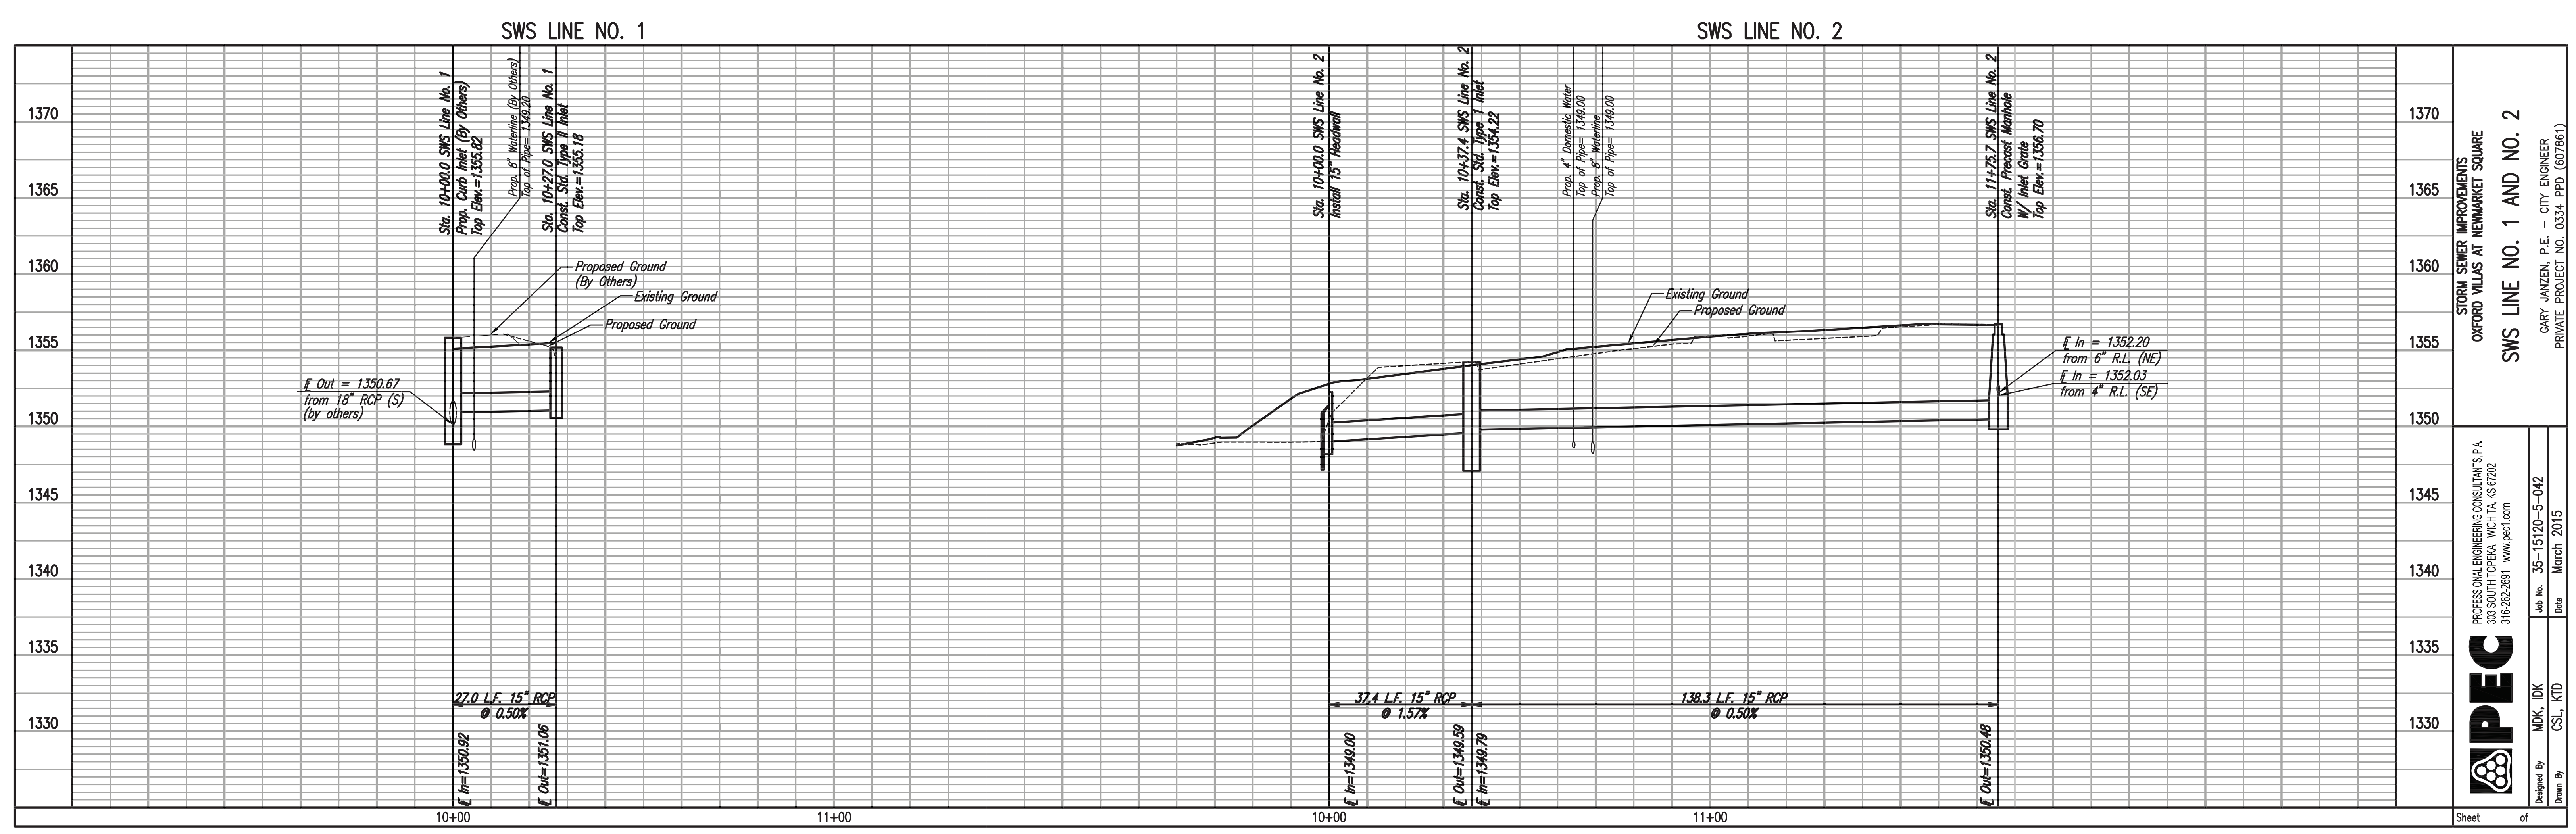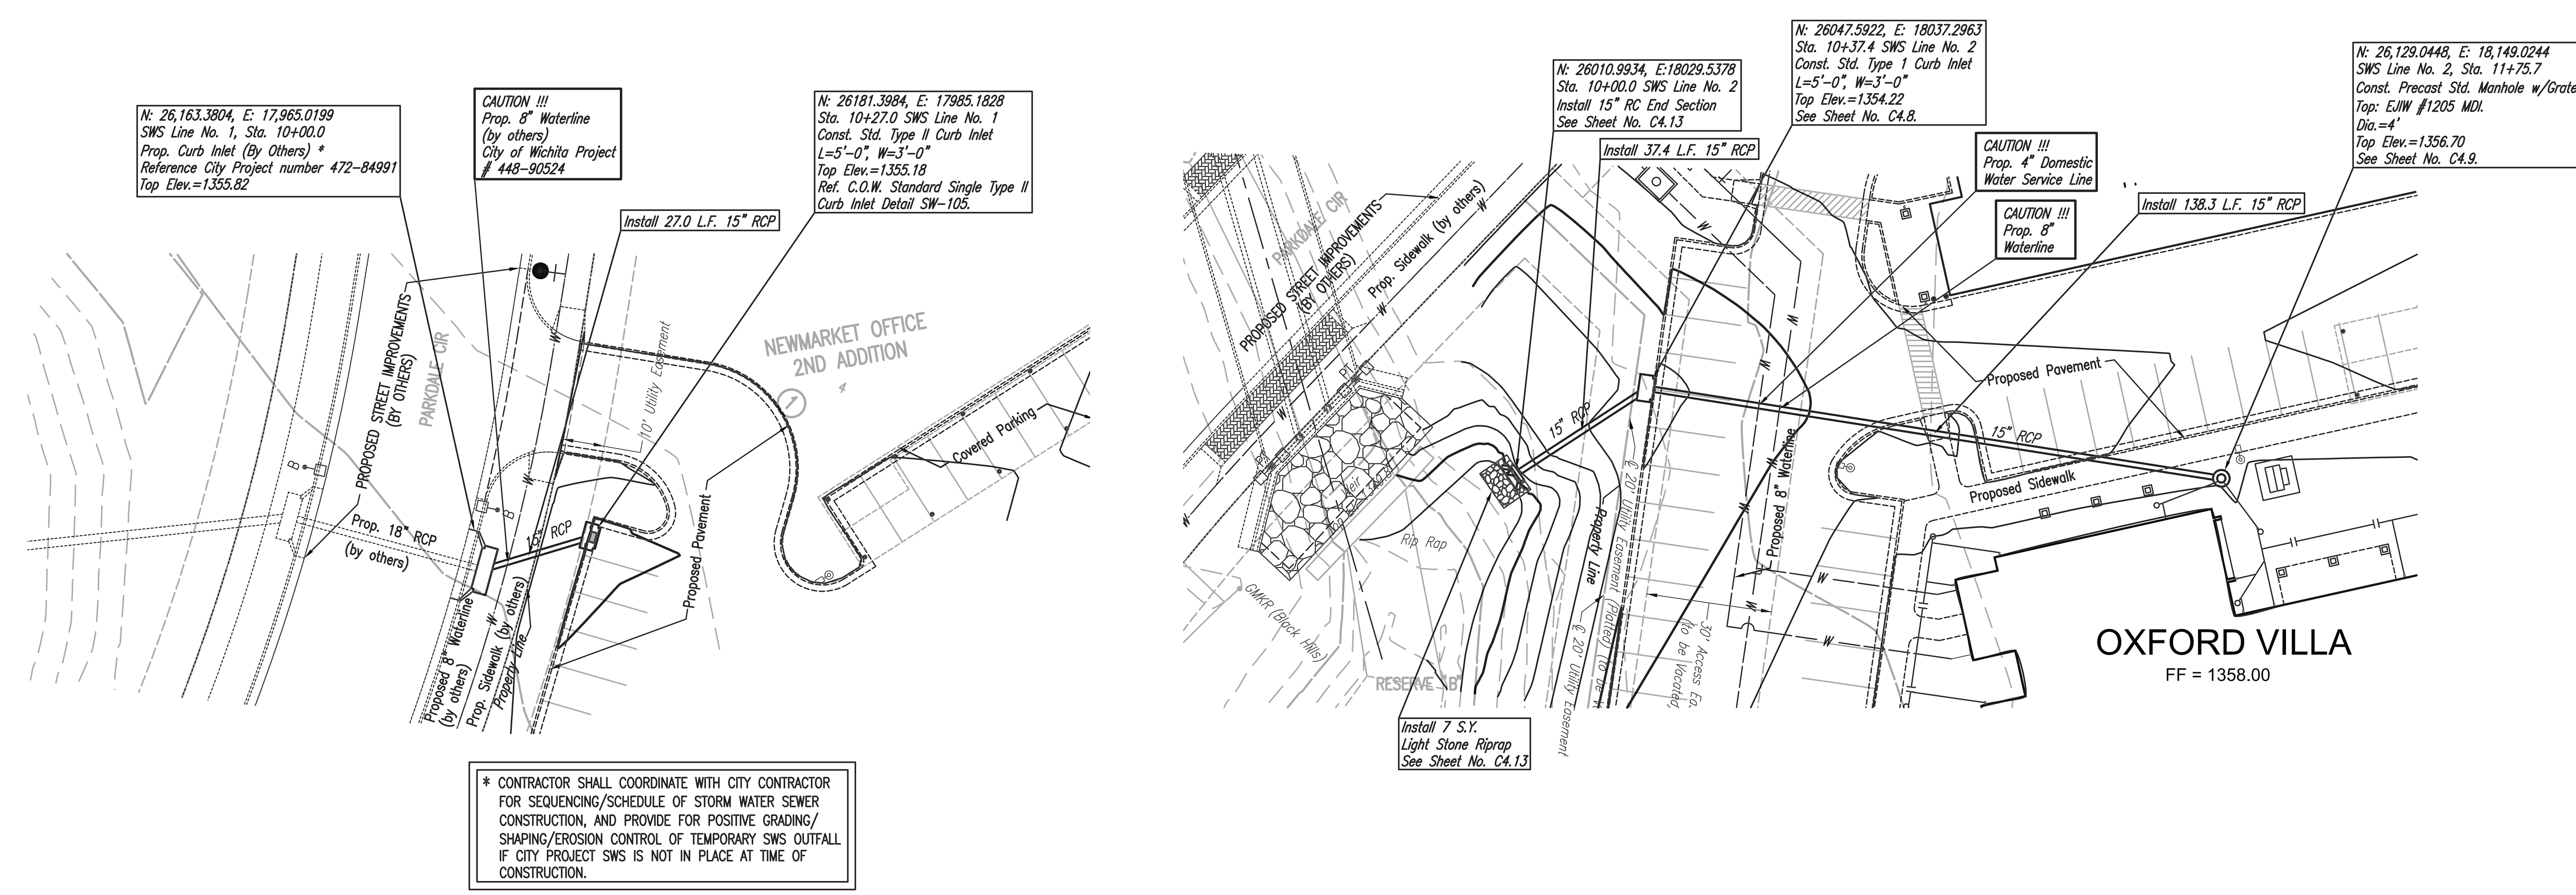

STORM SEWER IMPROVEMENTS
OXFORD VILLAS AT NEWMARKET SQUARE
SWS LINE NO. 1 AND NO. 2

GARY JANZEN, P.E. - CITY ENGINEER
PRIVATE PROJECT NO. 0334 PFD (607861)

PEPC PROFESSIONAL ENGINEERING CONSULTANTS, P.A.
303 SOUTH TOPEKA WICHITA, KS 67202
316-262-2891 www.pec1.com

Job No. 35-15120-5-042
Date March 2015

Designed By MDK, IDK
Drawn By CSL, KTD

LKArchitecture

Architecture • Engineering • Planning • Interior Design • Landscape Architecture

Professional Engineer Seal: 20923, 10/19/2015, KANSAS PROFESSIONAL ENGINEER

LK Architecture, Inc.®
345 Riverside Wichita, KS 67203
T 316.268.0230 F 316.268.0205


CONTACT: Isaac Krumme
DRAWN: Roy Thomas
CHECKED: Ben Mabry

PROJECT NUMBER:
14619

SHEET TITLE:
SWS LINE NO. 1 AND NO. 2

SHEET NUMBER:
C4.2


Save: 10-19-2015 1:30:15 PM by: CSL
U:\Projects-2015\15120\15120-05-042-SWS LINE NO. 1 AND NO. 2

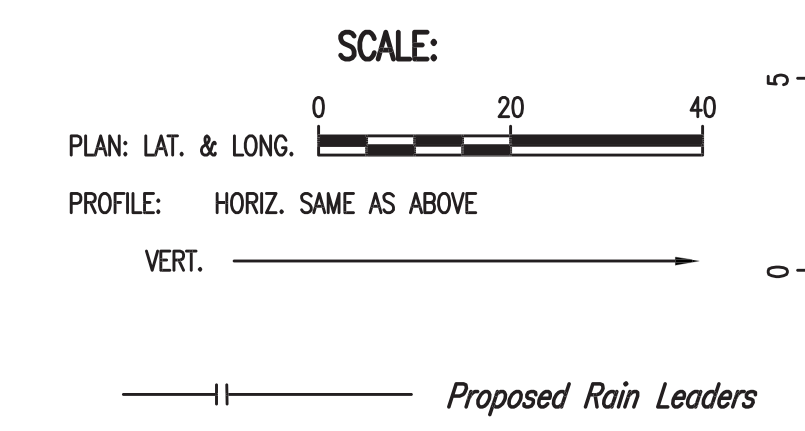


DATE	PURPOSE	NO.
05.11.2015	75% OWNER REVIEW	
05.29.2015	PERMIT SET/BID SET	
06.12.2015	ADDENDUM 1	1
08.10.2015	ADDENDUM 2	2
08.17.2015	ADDENDUM 3	3
09.15.2015	CCD 1	4
09.30.2015	CCD 2	5
10.19.2015	CCD 3	6

- ▲ ADDED SHEET
- ▲ REVISED ENTIRE SHEET
- ▲ REVISED ENTIRE SHEET


OXFORD VILLA WICHITA, KS

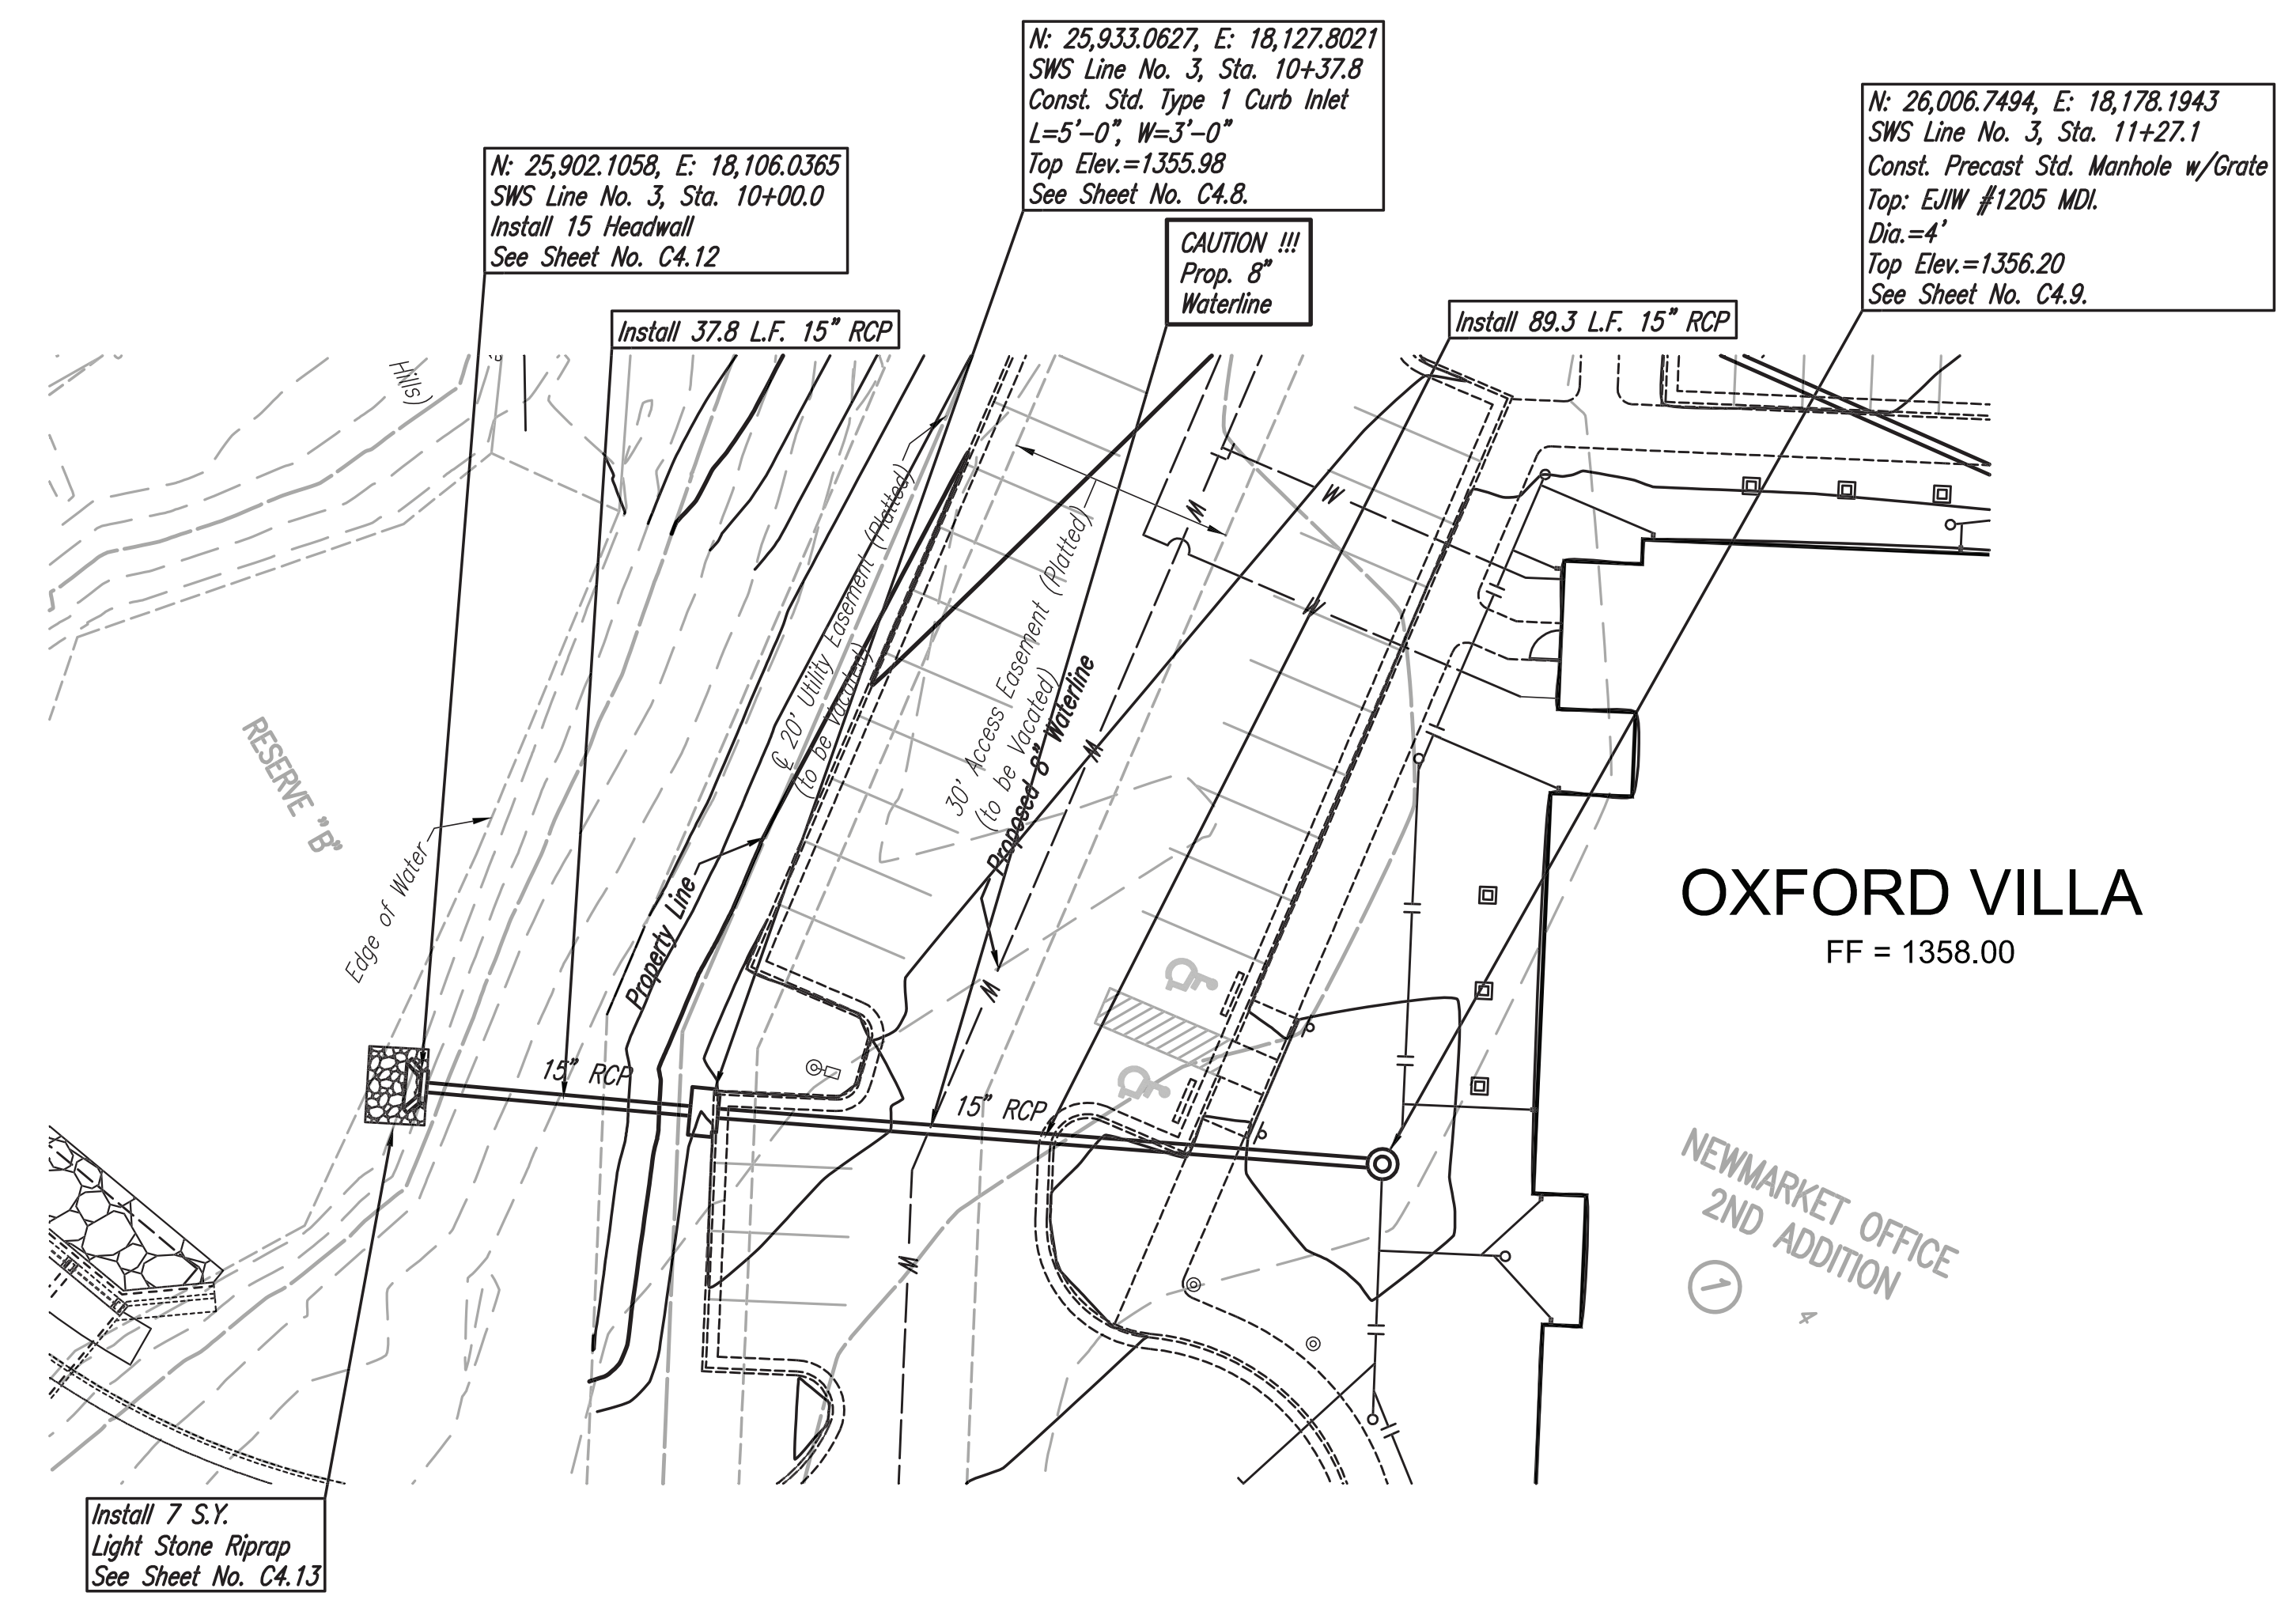

SWS LINE NO. 3

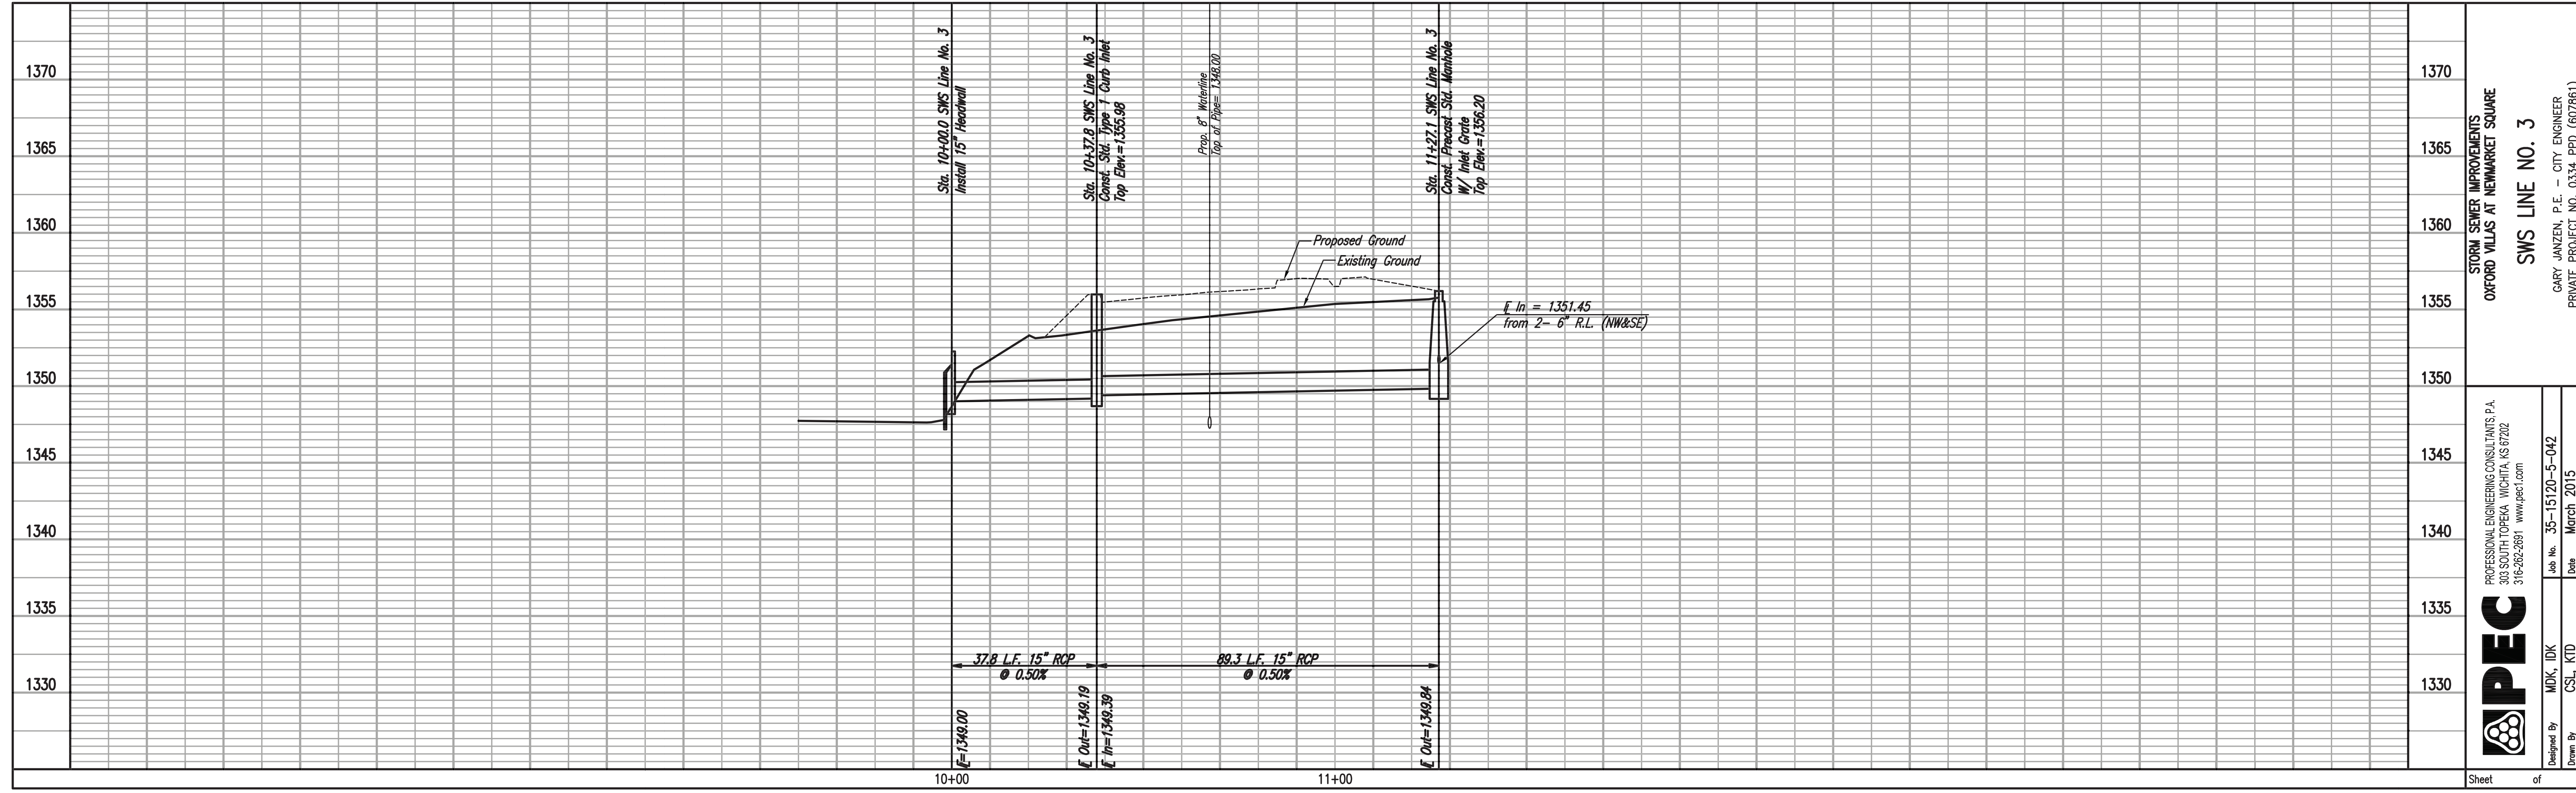


PEPC PROFESSIONAL ENGINEERING CONSULTANTS P.A. 303 SOUTH TOPEKA, WICHITA, KS 67202 316-262-2891 www.pec1.com		JOB NO. 35-15120-5-042 DATE March 2015
DESIGNED BY MDK, IDK DRAWN BY CSL, KTD	PROJECT NO. 0334.PPD. (607861) GARY JANZEN, P.E. - CITY ENGINEER PRIVATE PROJECT NO. 0334.PPD. (607861)	

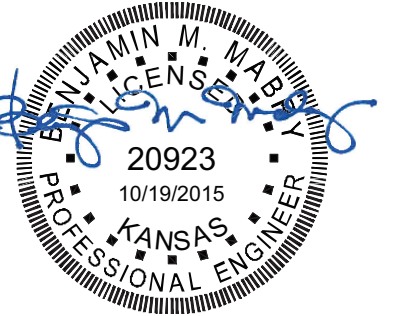

LKArchitecture, Inc.®
 345 Riverview Wichita, KS 67203
 T 316.268.0230 F 316.268.0205
 CONTACT: Isaac Krumme
 DRAWN: Roy Thomas
 CHECKED: Ben Mabry
PROJECT NUMBER: 14619
 SHEET TITLE: SWS LINE NO. 3
 SHEET NUMBER: **C4.3**




Save: 10-19-2015 1:49:47 PM by: CSL
 U:\Projects - Civil\2015\15120\0334\15120-05-C4.3-SWS LINE NO. 3
 U:\Projects - Civil\2015\15120\0334\15120-05-C4.3-SWS LINE NO. 3

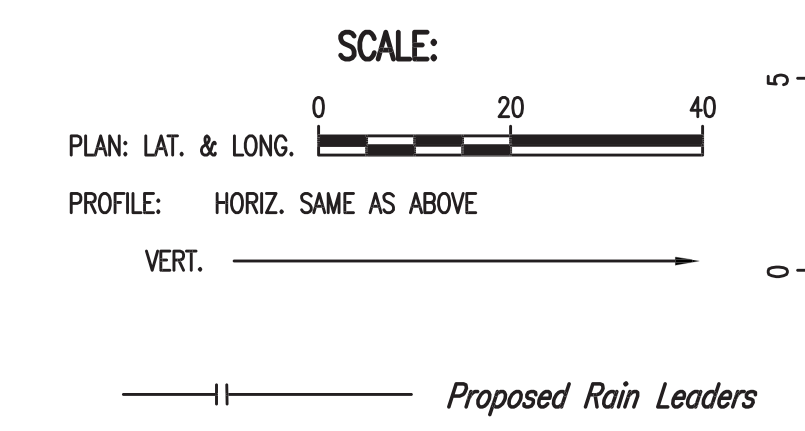

DATE	PURPOSE	NO.
05.11.2015	75% OWNER REVIEW	
05.29.2015	PERMIT SET/BID SET	
06.12.2015	ADDENDUM 1	1
08.10.2015	ADDENDUM 2	2
08.17.2015	ADDENDUM 3	3
09.15.2015	CCD 1	4
09.30.2015	CCD 2	5
10.19.2015	CCD 3	6

- ▲ ADDED SHEET
- ▲ REVISED ENTIRE SHEET
- ▲ REVISED ENTIRE SHEET

OXFORD VILLA WICHITA, KS

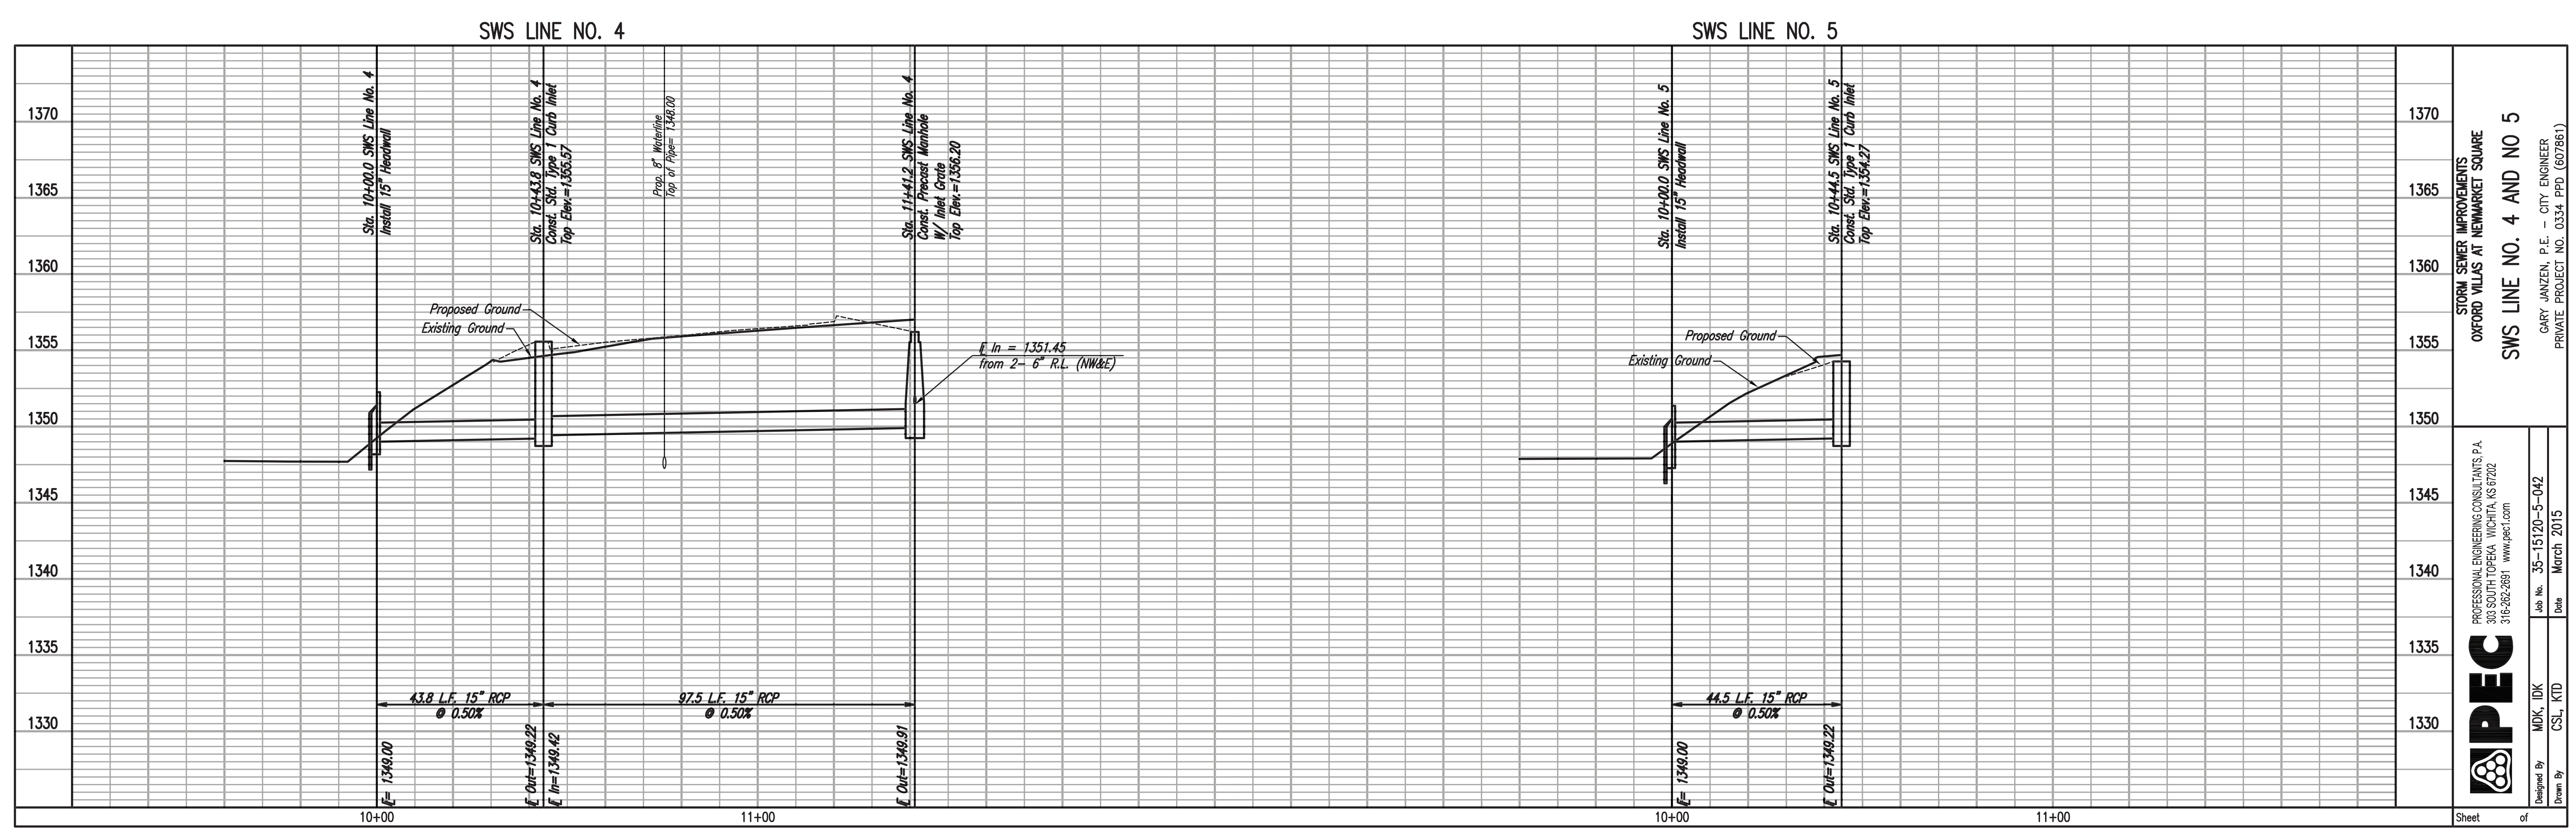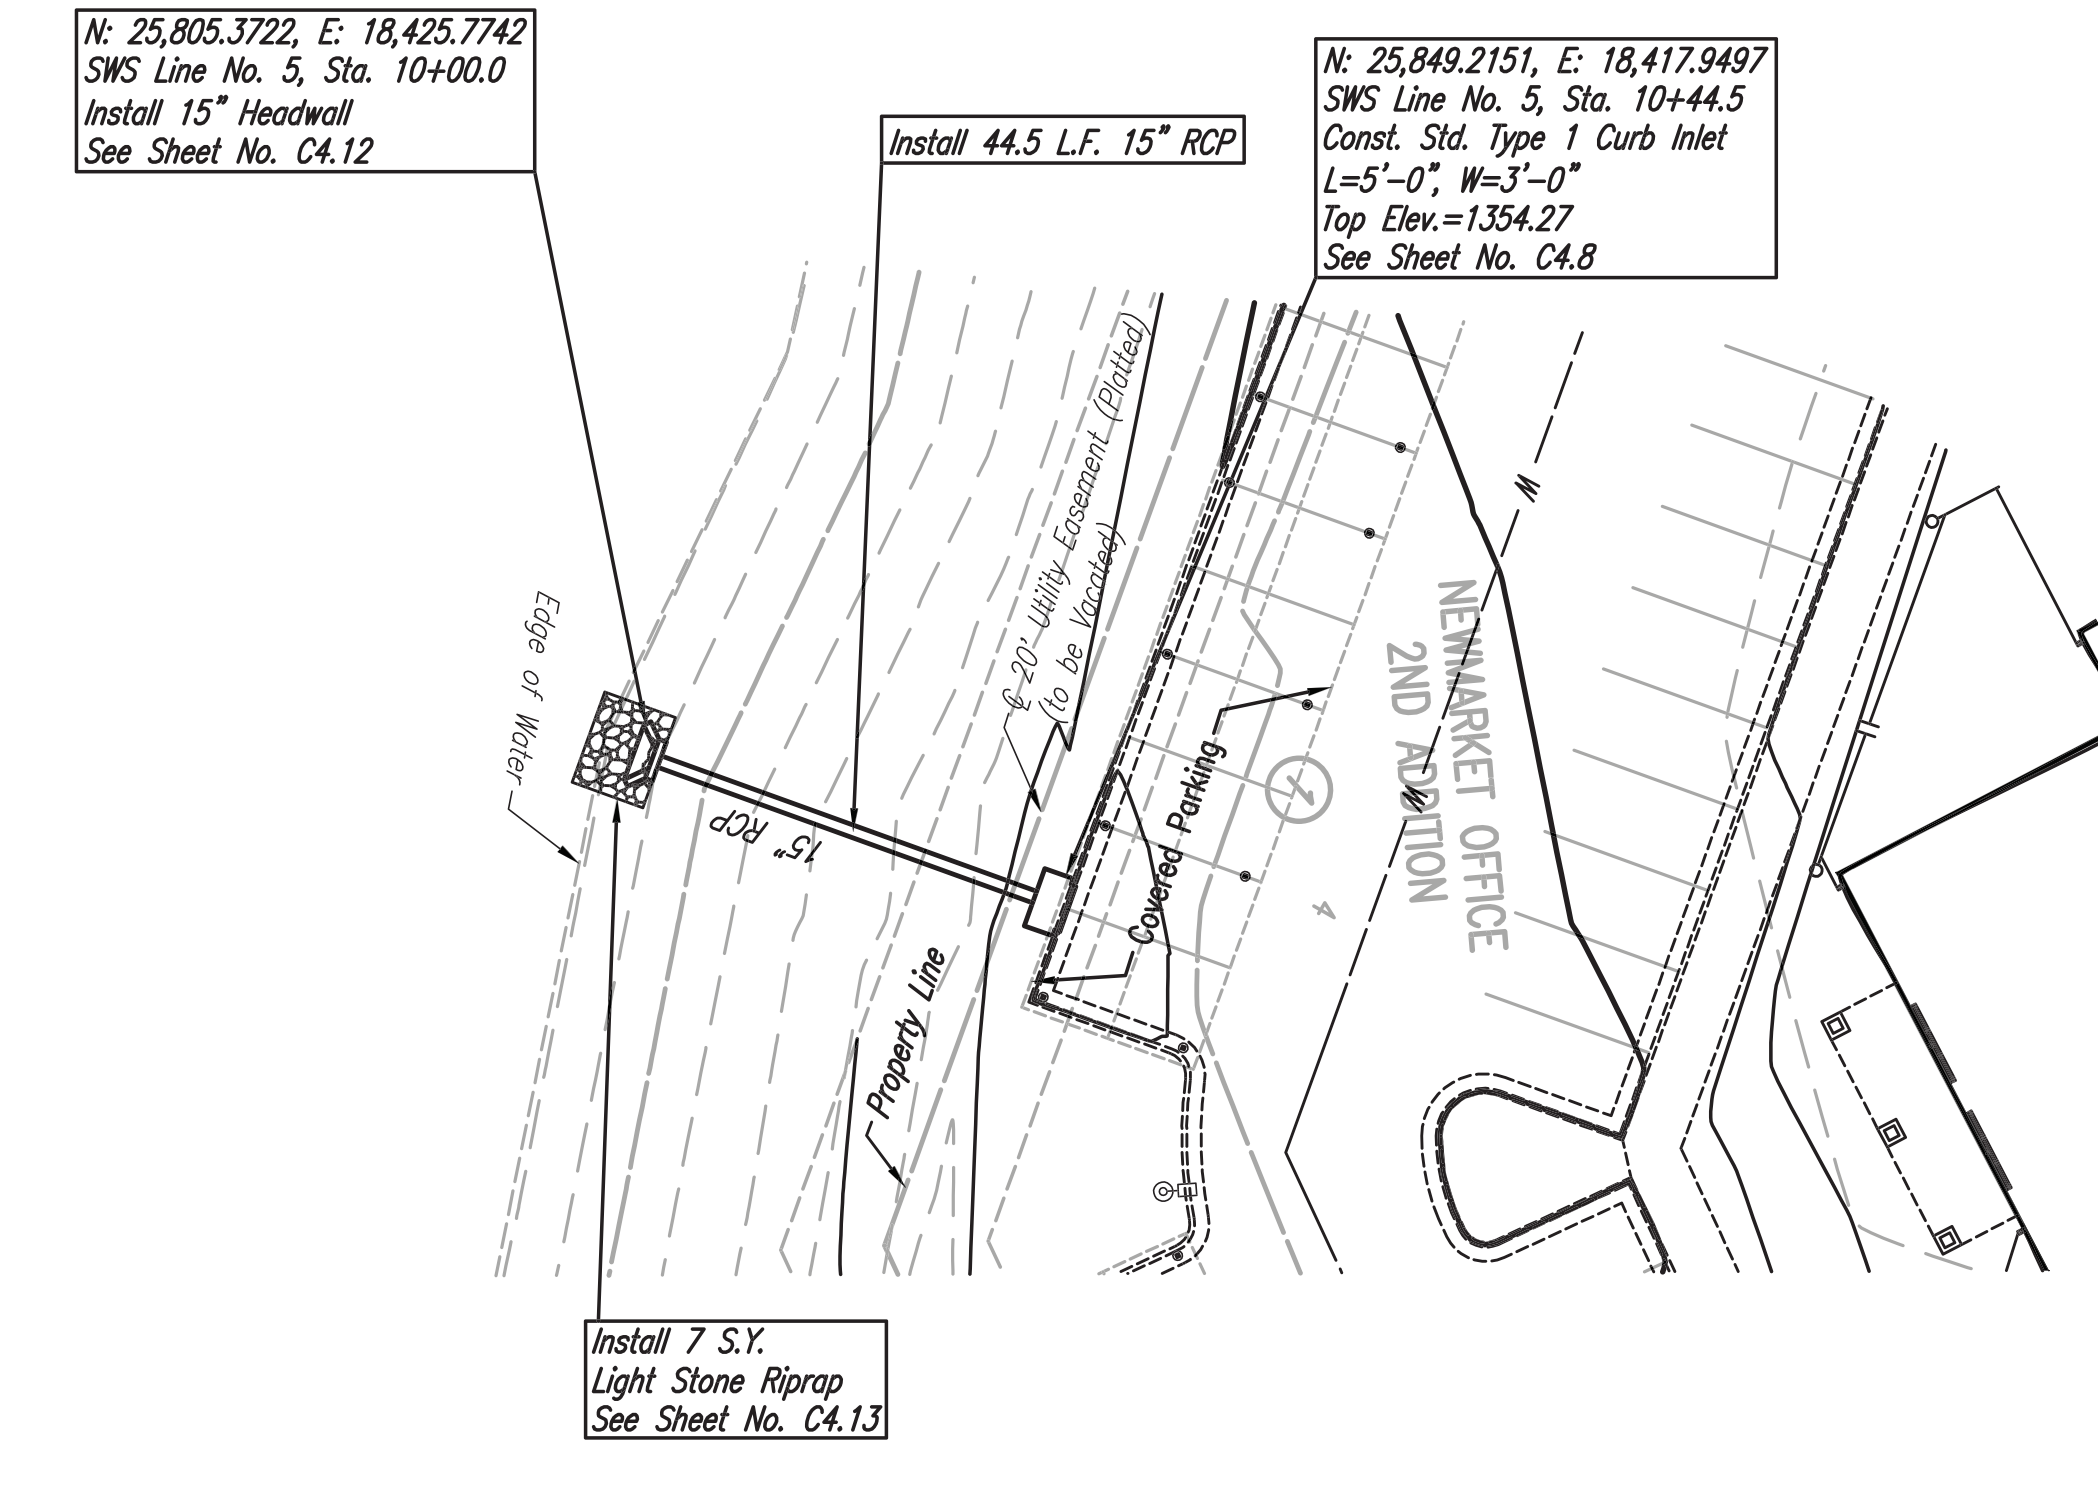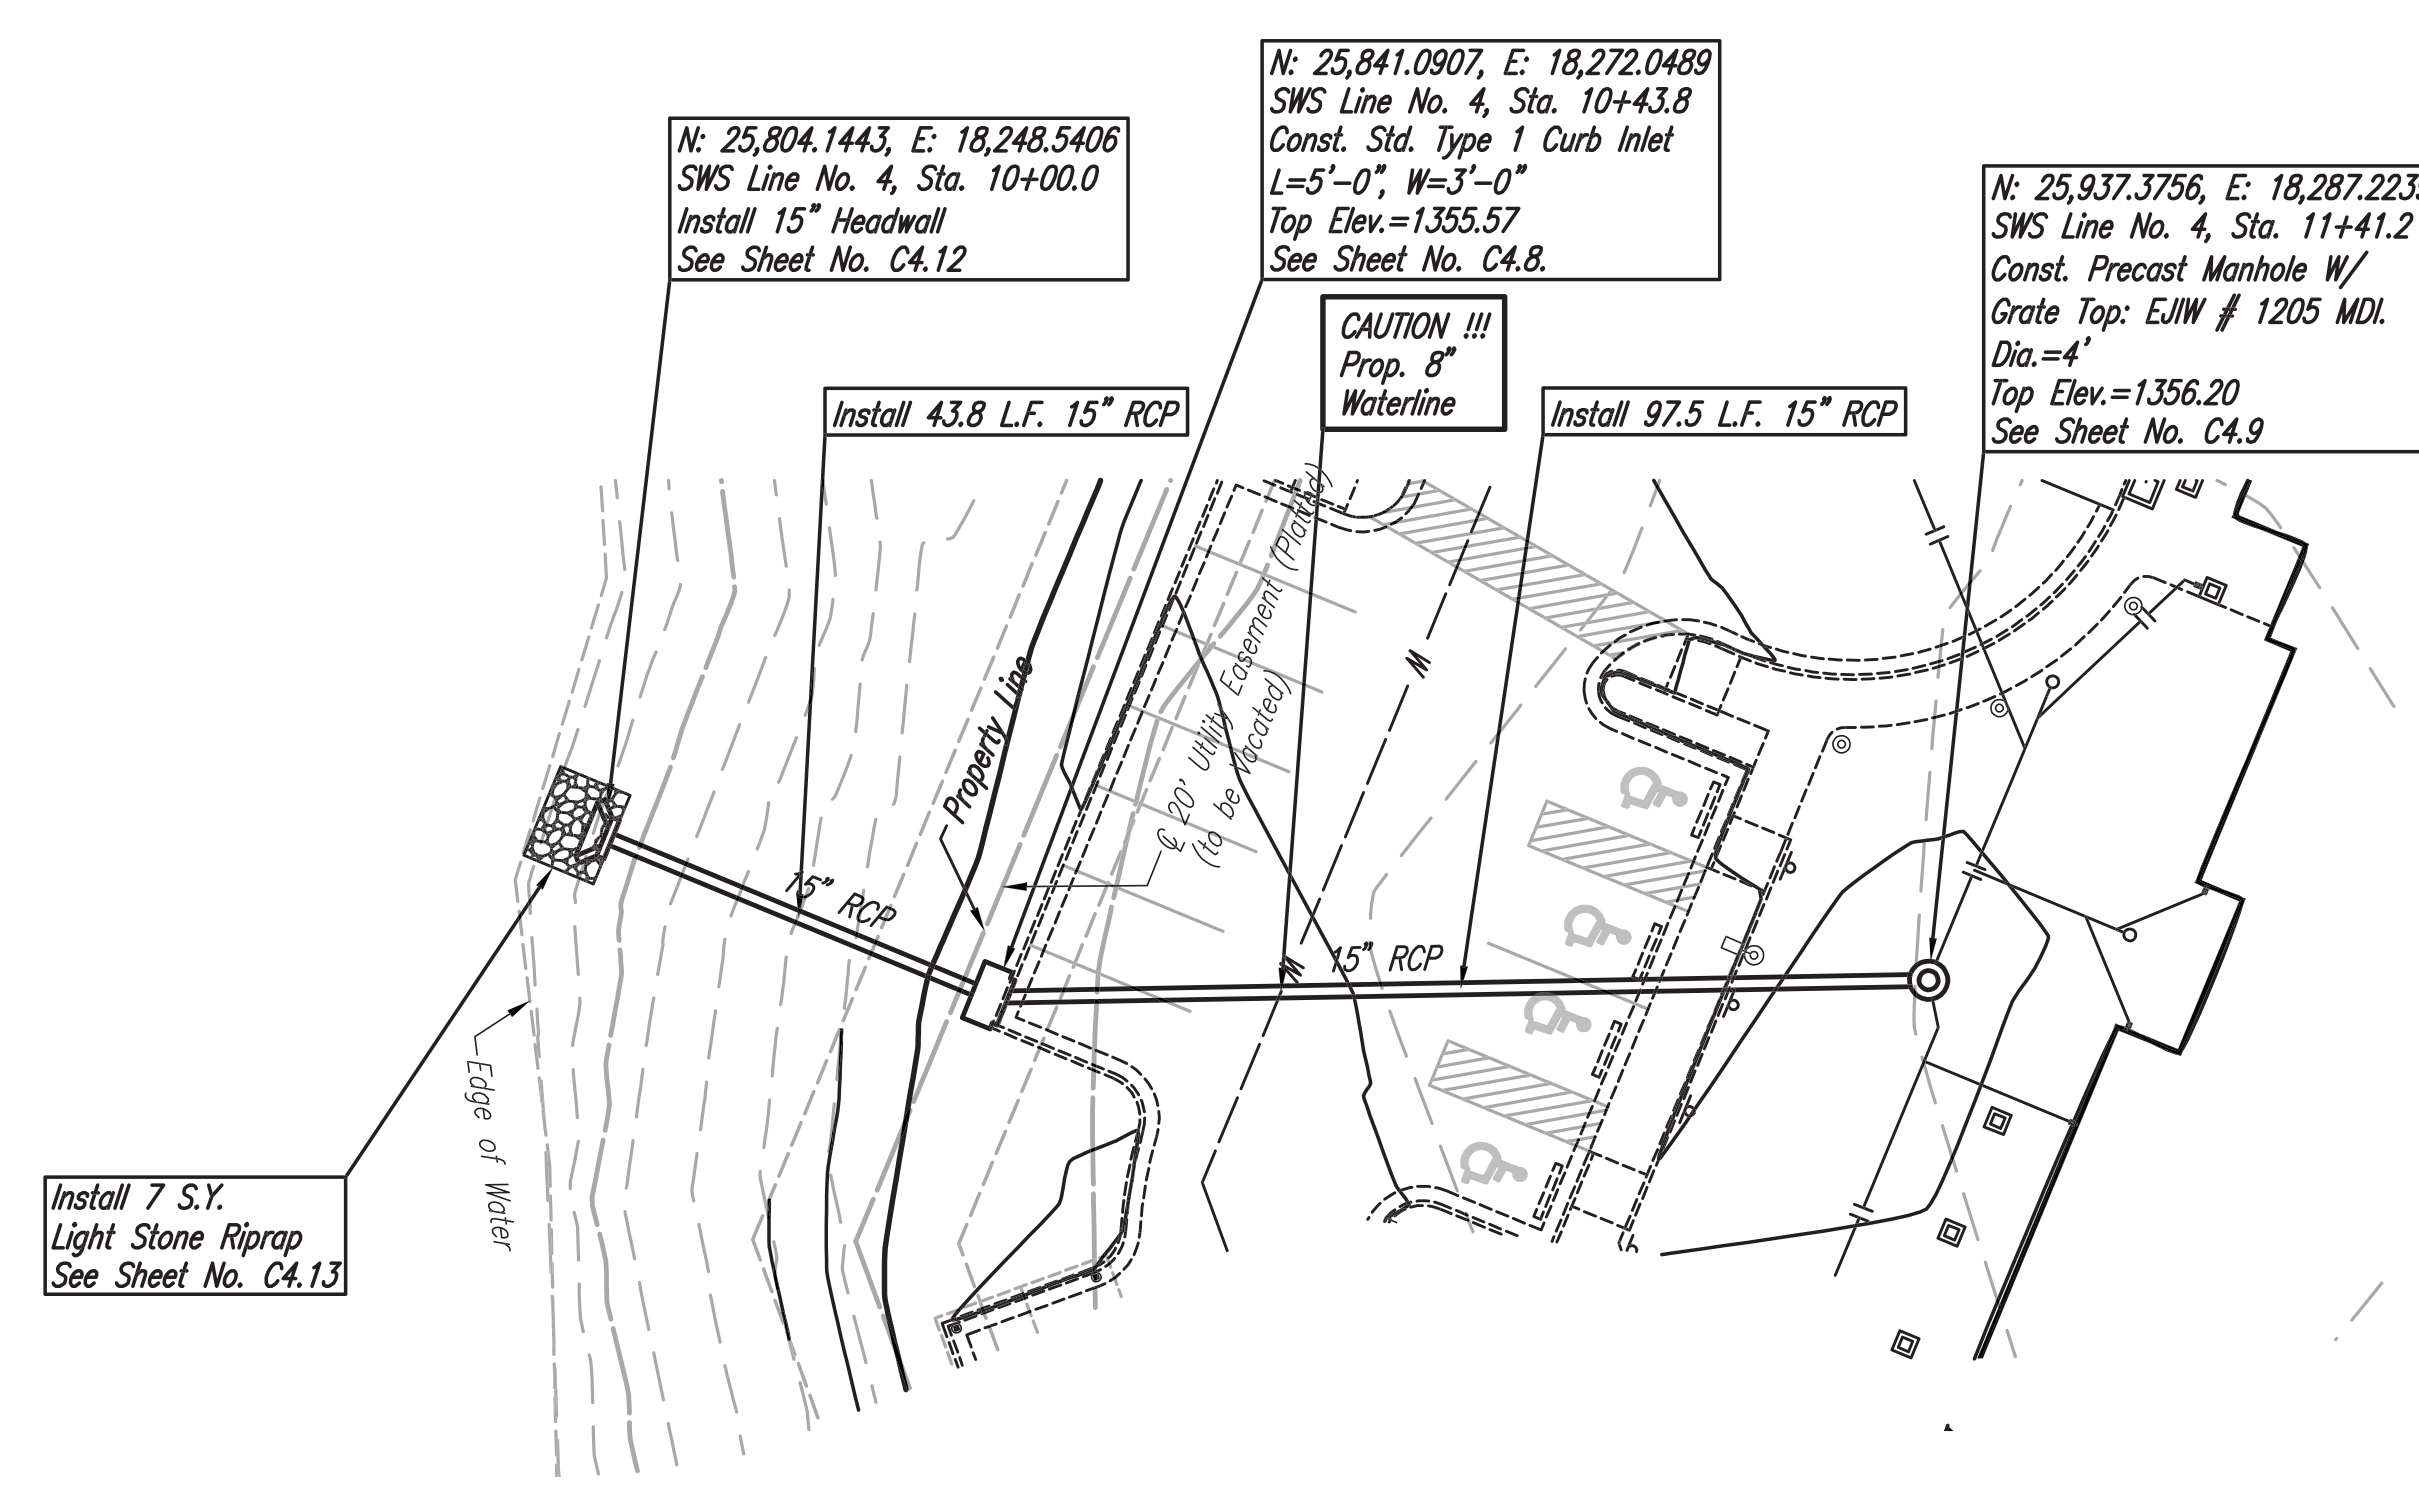

PEPC PROFESSIONAL ENGINEERING CONSULTANTS, P.A.
303 SOUTH TOPEKA WICHITA, KS 67202
316-262-2891 www.pec1.com


Job No. 35-15120-5-042 Date March 2015

Designed By MDK, IDK
Drawn By CSL, KTD


STORM SEWER IMPROVEMENTS
OXFORD VILLAS AT NENMARKET SQUARE
SWS LINE NO. 4 AND NO 5
GARY JANZEN, P.E. - CITY ENGINEER
PRIVATE PROJECT NO. 0334 PFD (607861)

Sheet of

Saved: 10-19-2015 1:49:23 PM by CSL
 U:\Projects-2015\15120\15120-05-04-4-SWS LINE NO. 4 AND NO 5

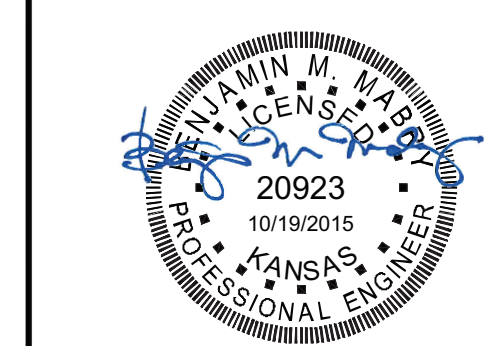


Saved: 10-19-2015 1:46:59 PM by: CSL
 U:\Projects - 2015\15120\15120-005-045-SWS LINE NO. 6

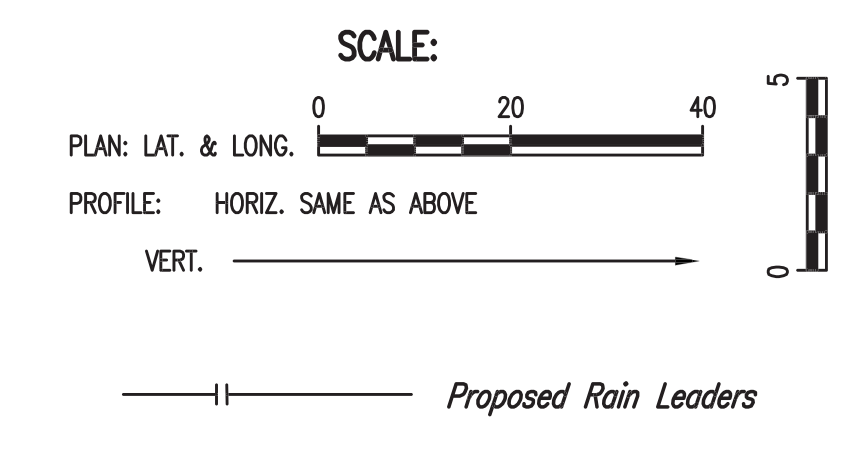


DATE	PURPOSE	NO.
05.11.2015	75% OWNER REVIEW	
05.29.2015	PERMIT SET/BID SET	
06.12.2015	ADDENDUM 1	1
08.10.2015	ADDENDUM 2	2
08.17.2015	ADDENDUM 3	3
09.15.2015	CCD 1	4
09.30.2015	CCD 2	5
10.19.2015	CCD 3	6

- △ ADDED SHEET
- △ REVISED ENTIRE SHEET
- △ REVISED ENTIRE SHEET

OXFORD VILLA WICHITA, KS

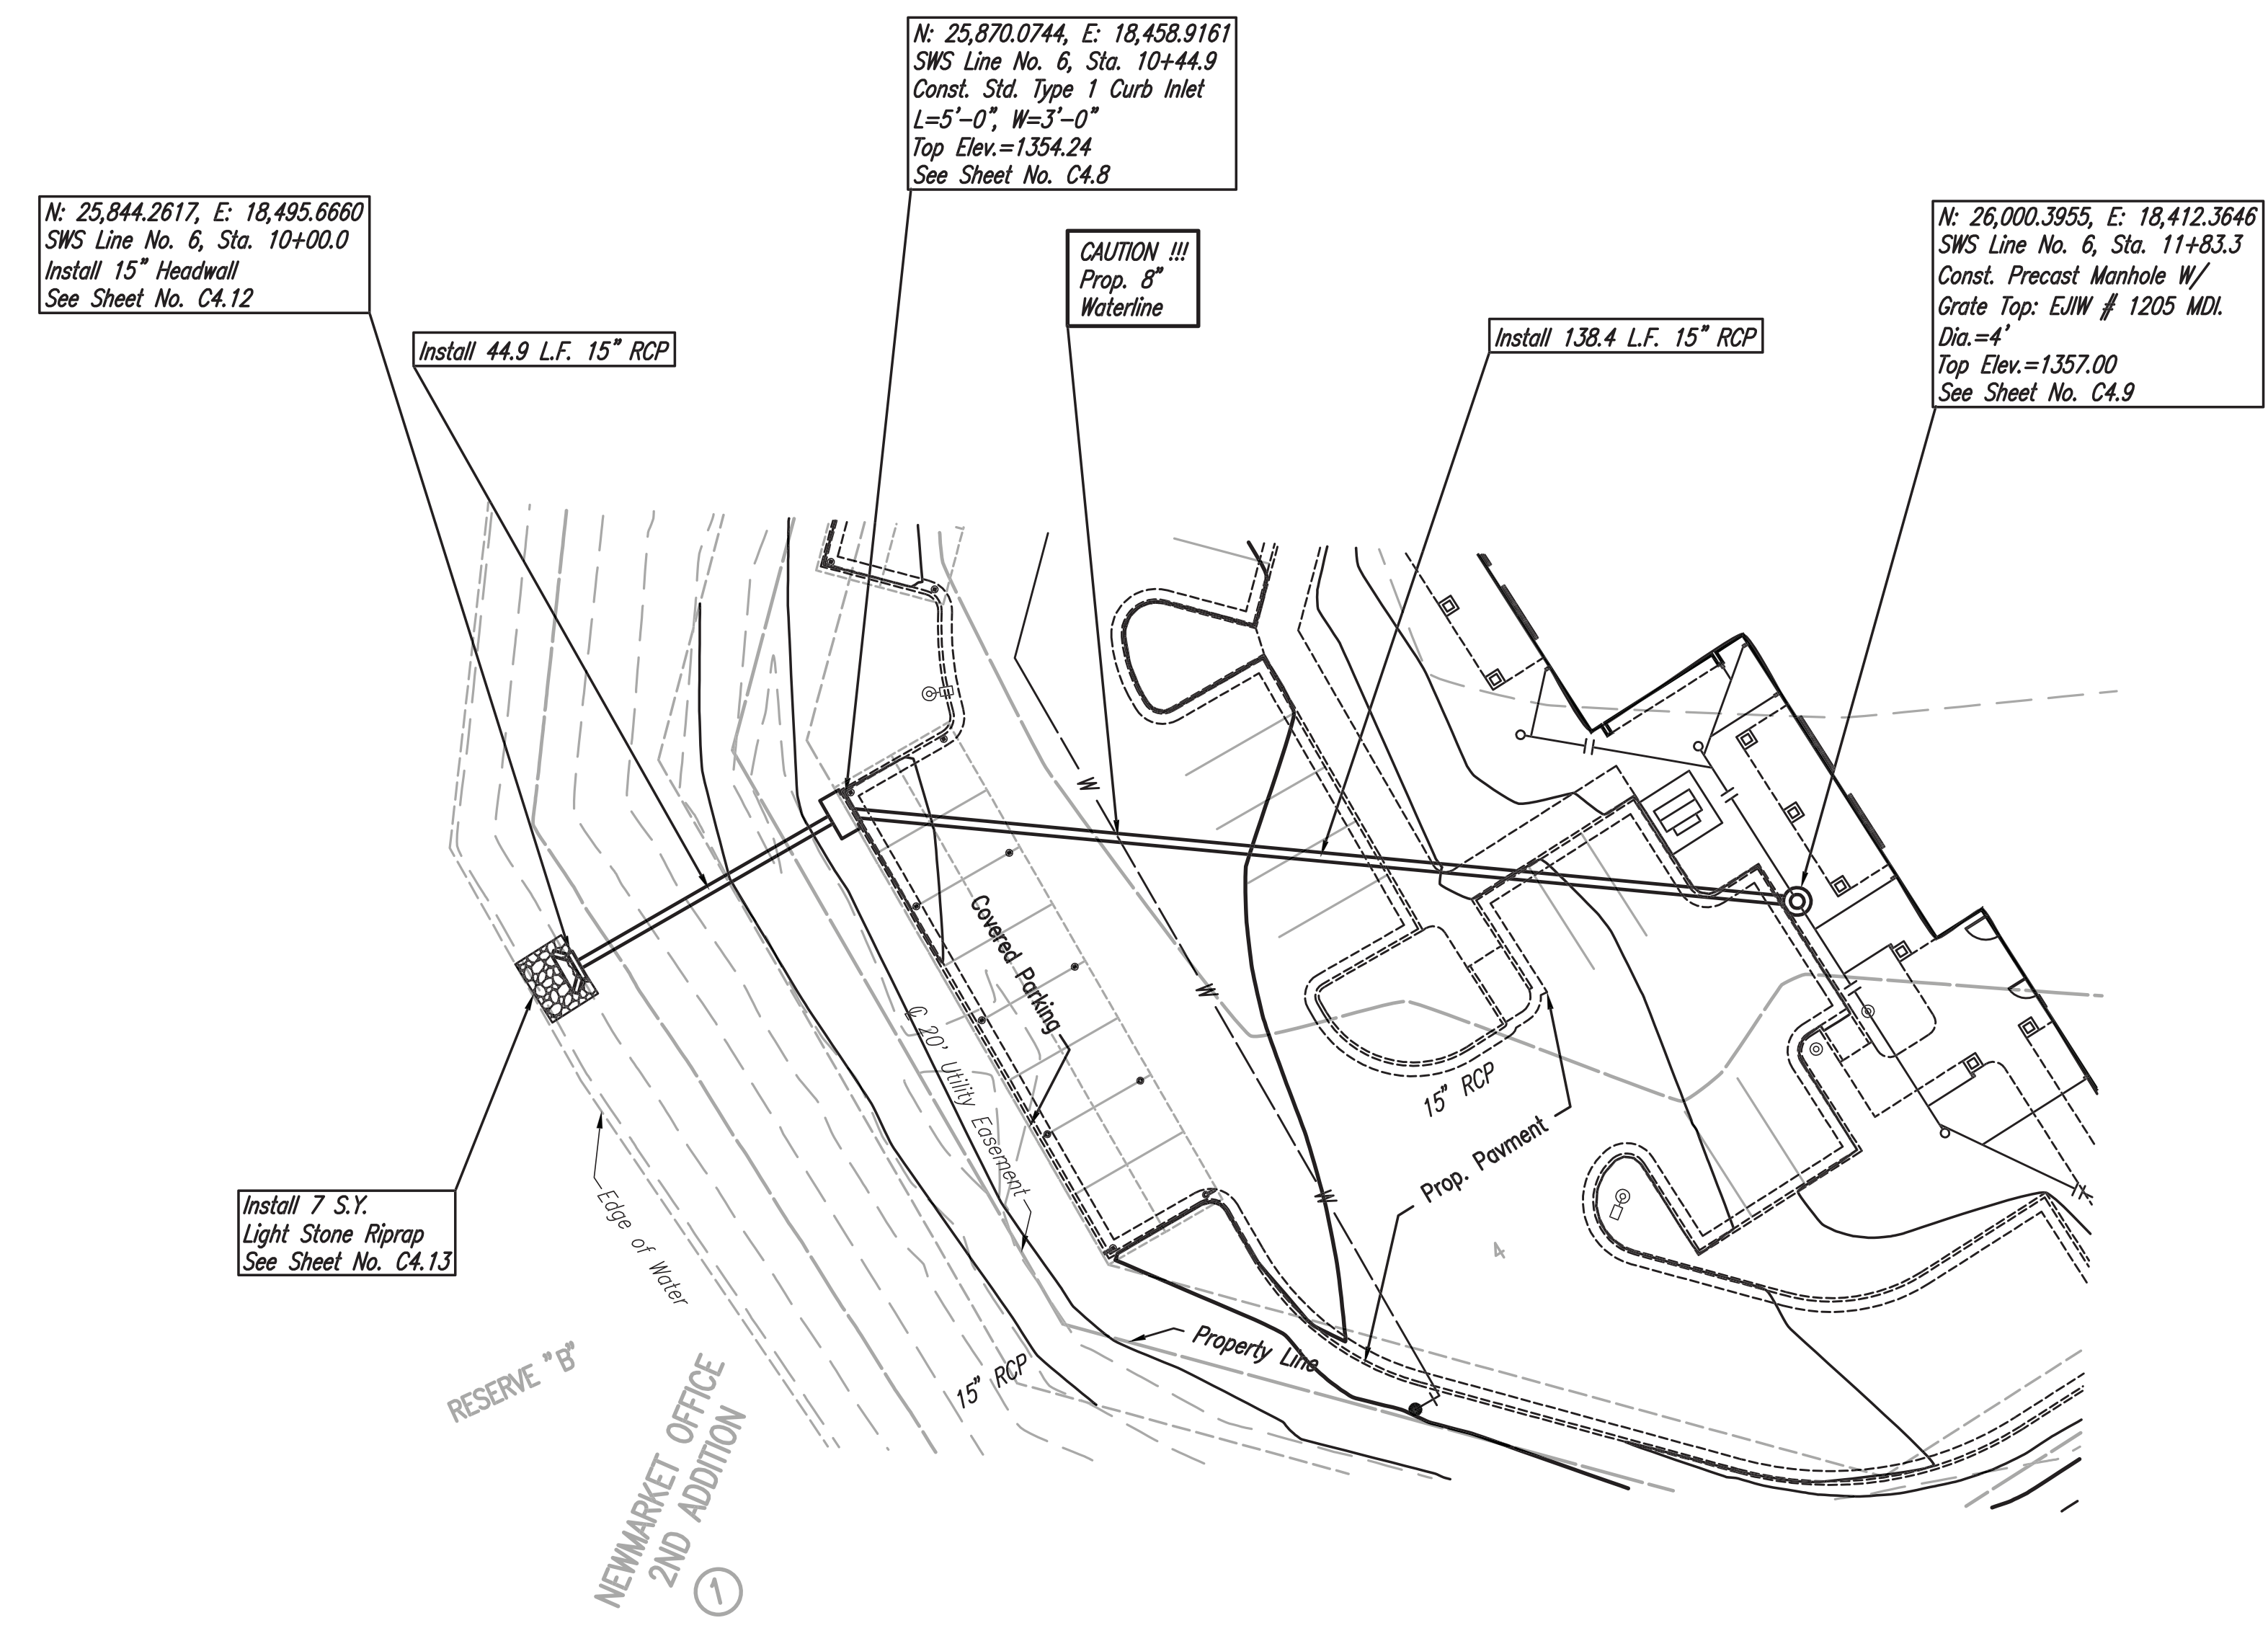


SWS LINE NO. 6

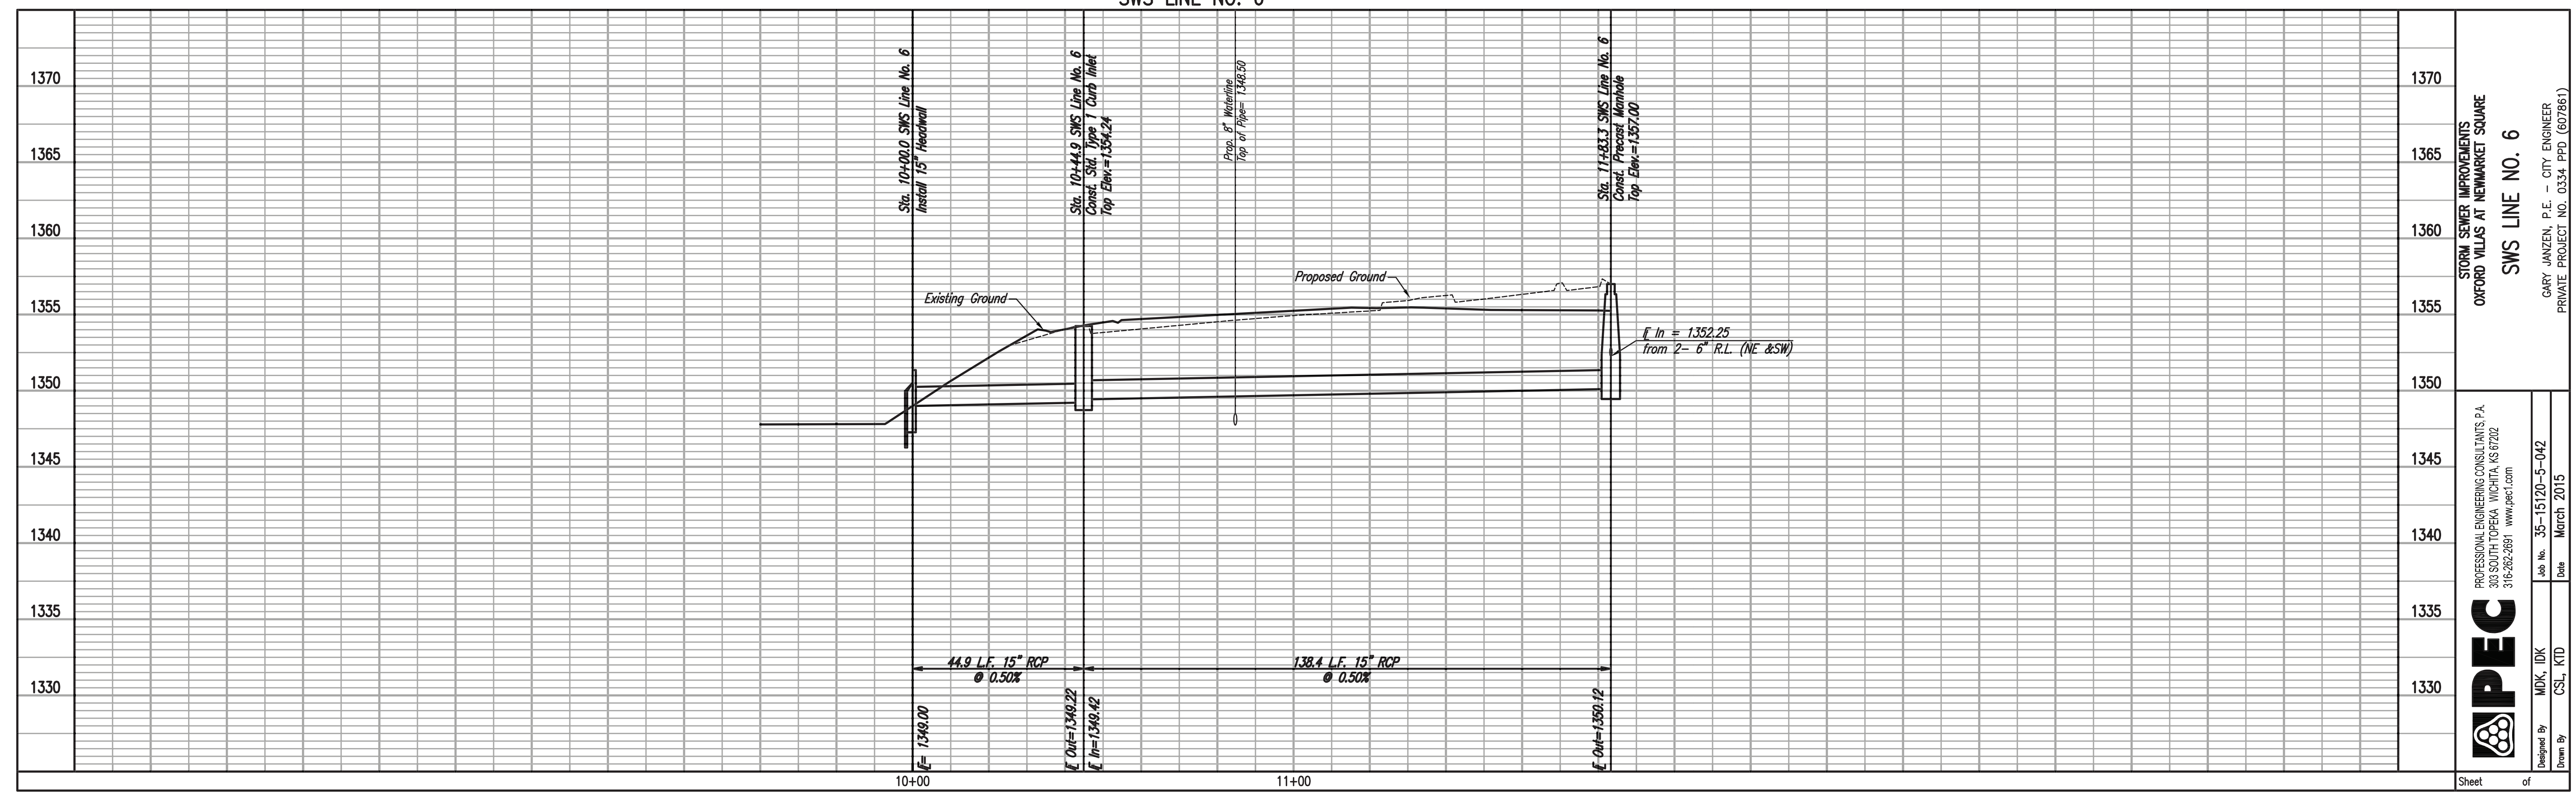

PEEC PROFESSIONAL ENGINEERING CONSULTANTS, P.A. 303 SOUTH TOPEKA WICHITA, KS 67202 316-282-2891 www.pec1.com		Job No. 35-15120-5-042 Date March 2015
Designed By	MDK, IDK	
Drawn By	CSL, KTD	

Sheet of


LKArchitecture
 Architecture • Engineering • Planning • Interior Design • Landscape Architecture

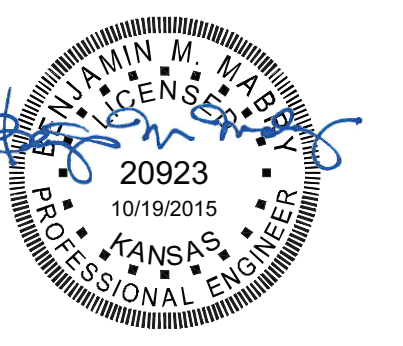

LKArchitecture, Inc.
 345 Riverview Wichita, KS 67203
 T 316.268.0230 F 316.268.0205
 CONTACT: Isaac Krumme
 DRAWN: Roy Thomas
 CHECKED: Ben Mabry
PROJECT NUMBER:
14619


SHEET TITLE:
 SWS LINE NO. 6

SHEET NUMBER:
C4.5

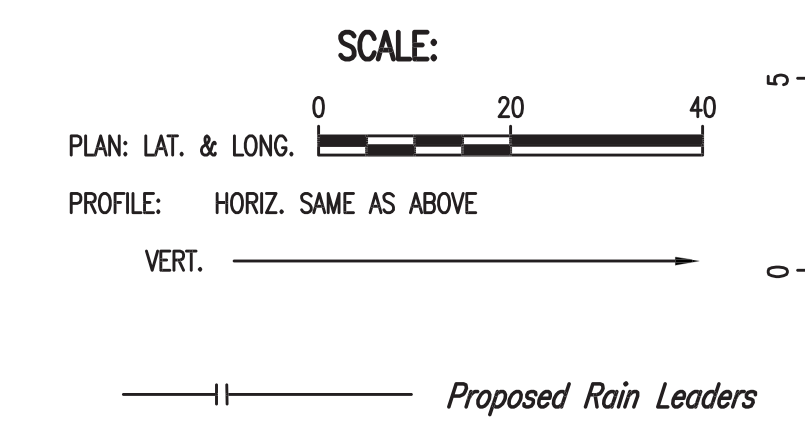


DATE	PURPOSE	NO.
05.11.2015	75% OWNER REVIEW	
05.29.2015	PERMIT SET/BID SET	
06.12.2015	ADDENDUM 1	1
08.10.2015	ADDENDUM 2	2
08.17.2015	ADDENDUM 3	3
09.15.2015	CCD 1	4
09.30.2015	CCD 2	5
10.19.2015	CCD 3	6

- ▲ ADDED SHEET
- ▲ REVISED ENTIRE SHEET
- ▲ REVISED ENTIRE SHEET

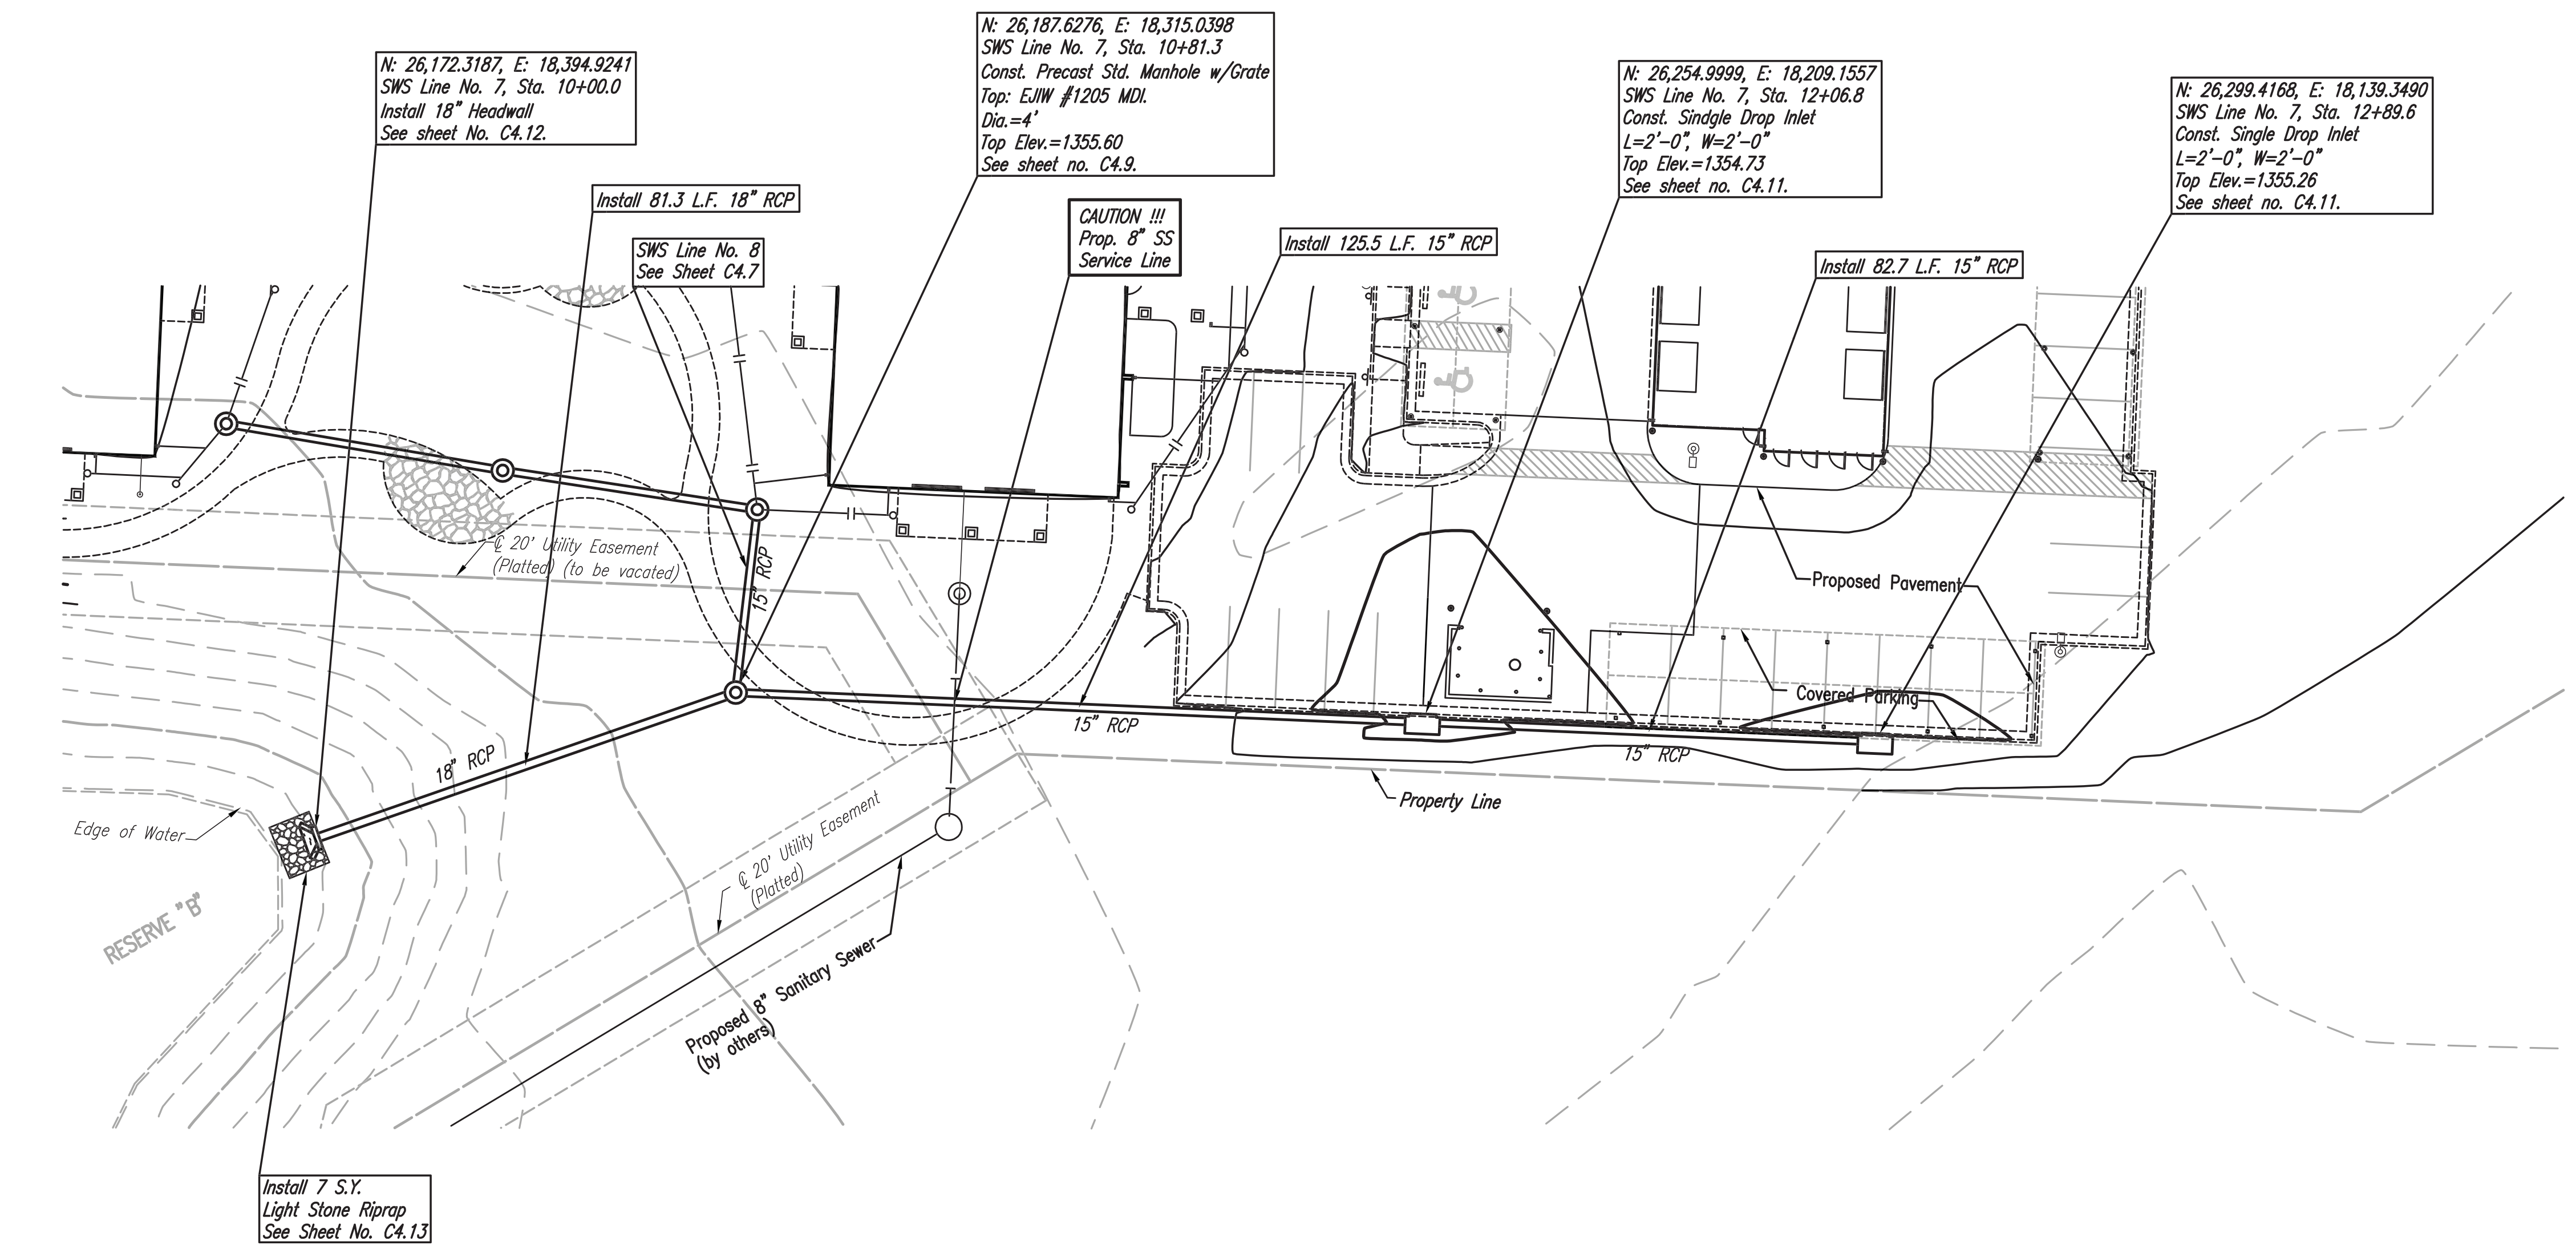

SWS LINE NO. 7

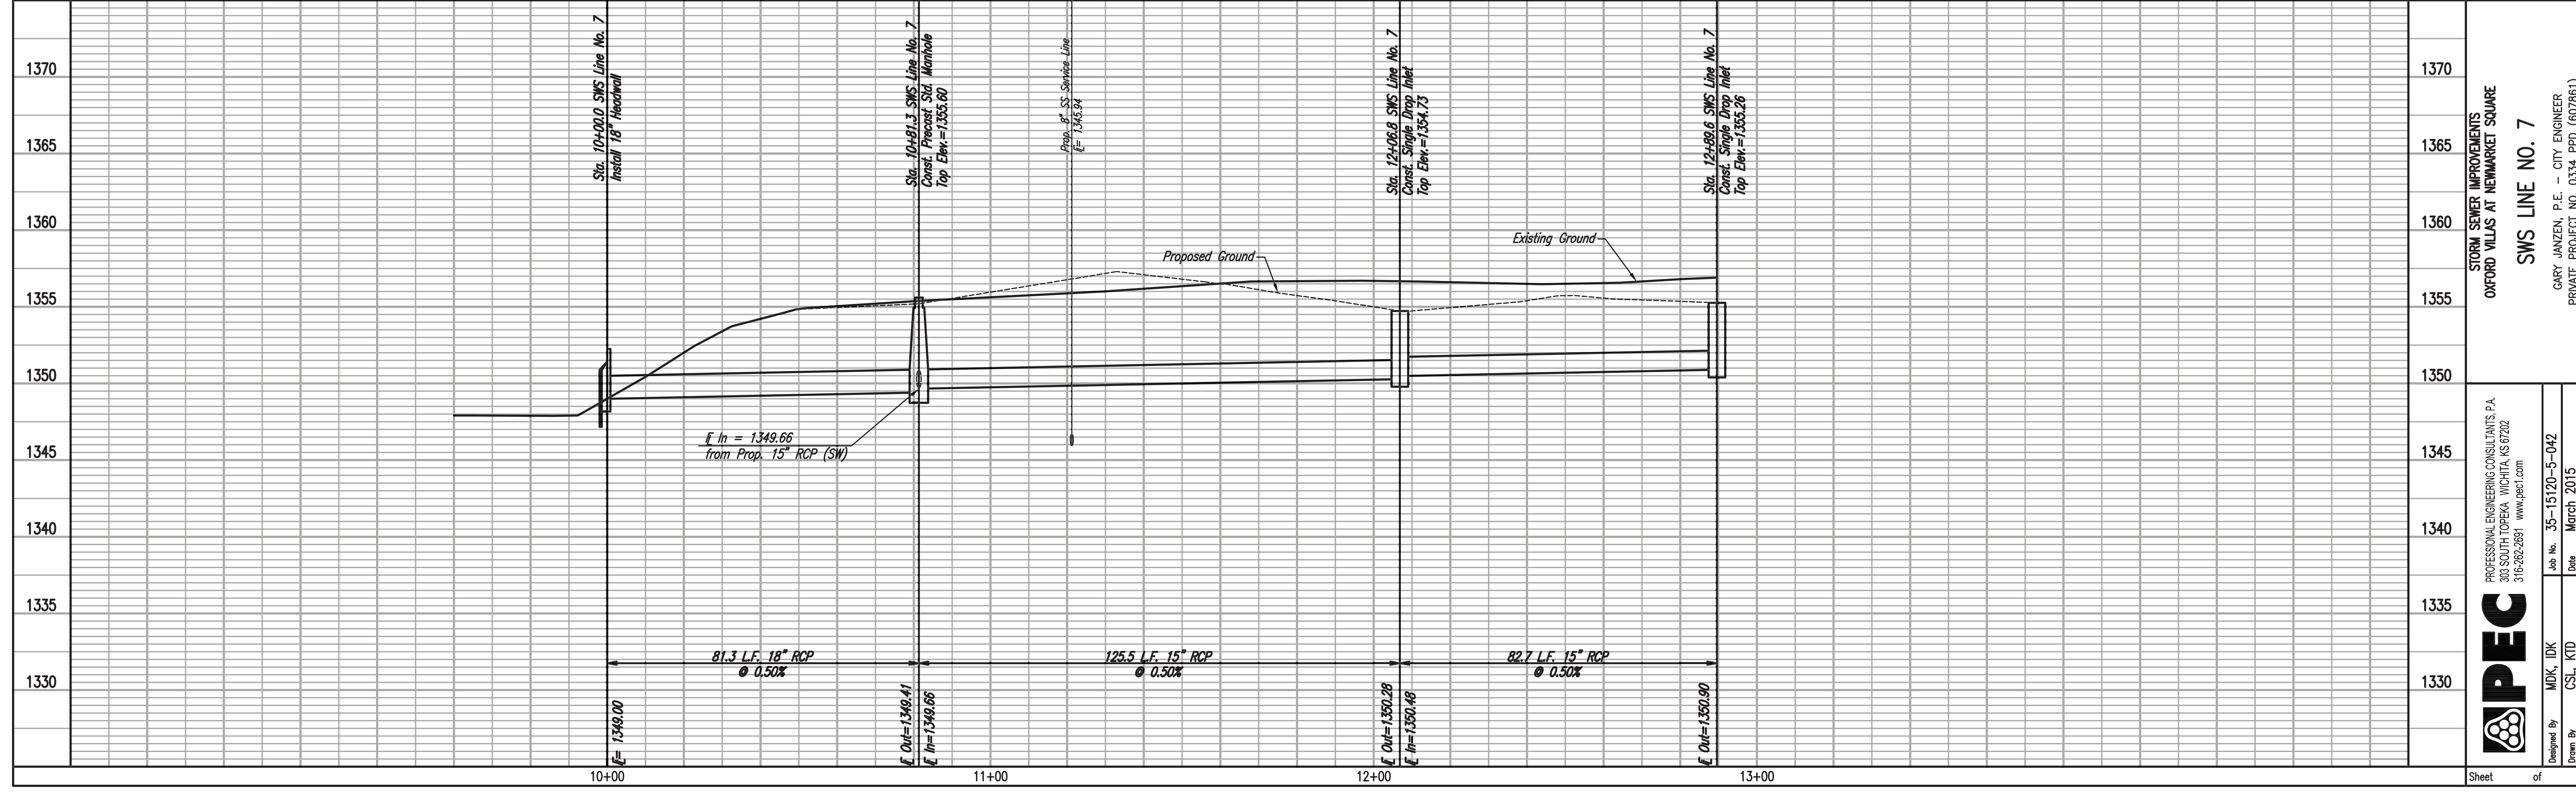

PEPC PROFESSIONAL ENGINEERING CONSULTANTS P.A.
303 SOUTH TOPEKA WICHITA, KS 67202
316-262-2891 www.pec1.com

STORM SEWER IMPROVEMENTS
OXFORD VILLAS AT NEWMARKET SQUARE

SWS LINE NO. 7

GARY JANZEN, P.E. - CITY ENGINEER
PRIVATE PROJECT NO. 0334 PPD (607861)

Designed By: MDK, IDK
Drawn By: CSL, KTD

Job No.: 35-15120-5-042
Date: March 2015


Sheet of

Saved: 10-19-2015 1:48:39 PM by: CSL
U:\Projects - 2015\15120\15120-5-042\Drawings\15120-05-042-SWS LINE NO. 7

**OXFORD VILLA
WICHITA, KS**



Architecture • Engineering • Planning • Interior Design • Landscape Architecture

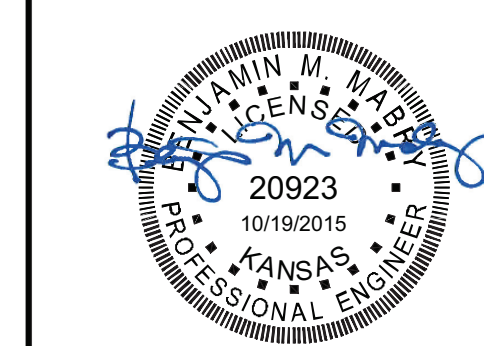

LK Architecture, Inc. ©
345 Riverview Wichita, KS 67203
T 316.268.0230 F 316.268.0205


CONTACT: Isaac Krumme
DRAWN: Roy Thomas
CHECKED: Ben Mabry

PROJECT NUMBER:
14619

SHEET TITLE:
SWS LINE NO. 7

SHEET NUMBER:
C4.6


Save: 10-19-2015 1:48:16 PM by: CSL
 U:\Projects - Civil\2015\15120-03\15120-03-047-SWS LINE NO. 8

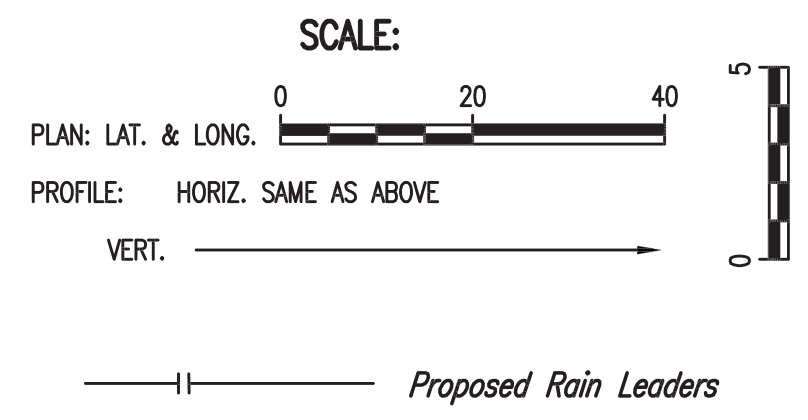


DATE	PURPOSE	NO.
05.11.2015	75% OWNER REVIEW	
05.29.2015	PERMIT SET/BID SET	
06.12.2015	ADDENDUM 1	1
08.10.2015	ADDENDUM 2	2
08.17.2015	ADDENDUM 3	3
09.15.2015	CCD 1	4
09.30.2015	CCD 2	5
10.19.2015	CCD 3	6

- ADD SHEET
- REVISED ENTIRE SHEET
- REVISED ENTIRE SHEET

OXFORD VILLA WICHITA, KS

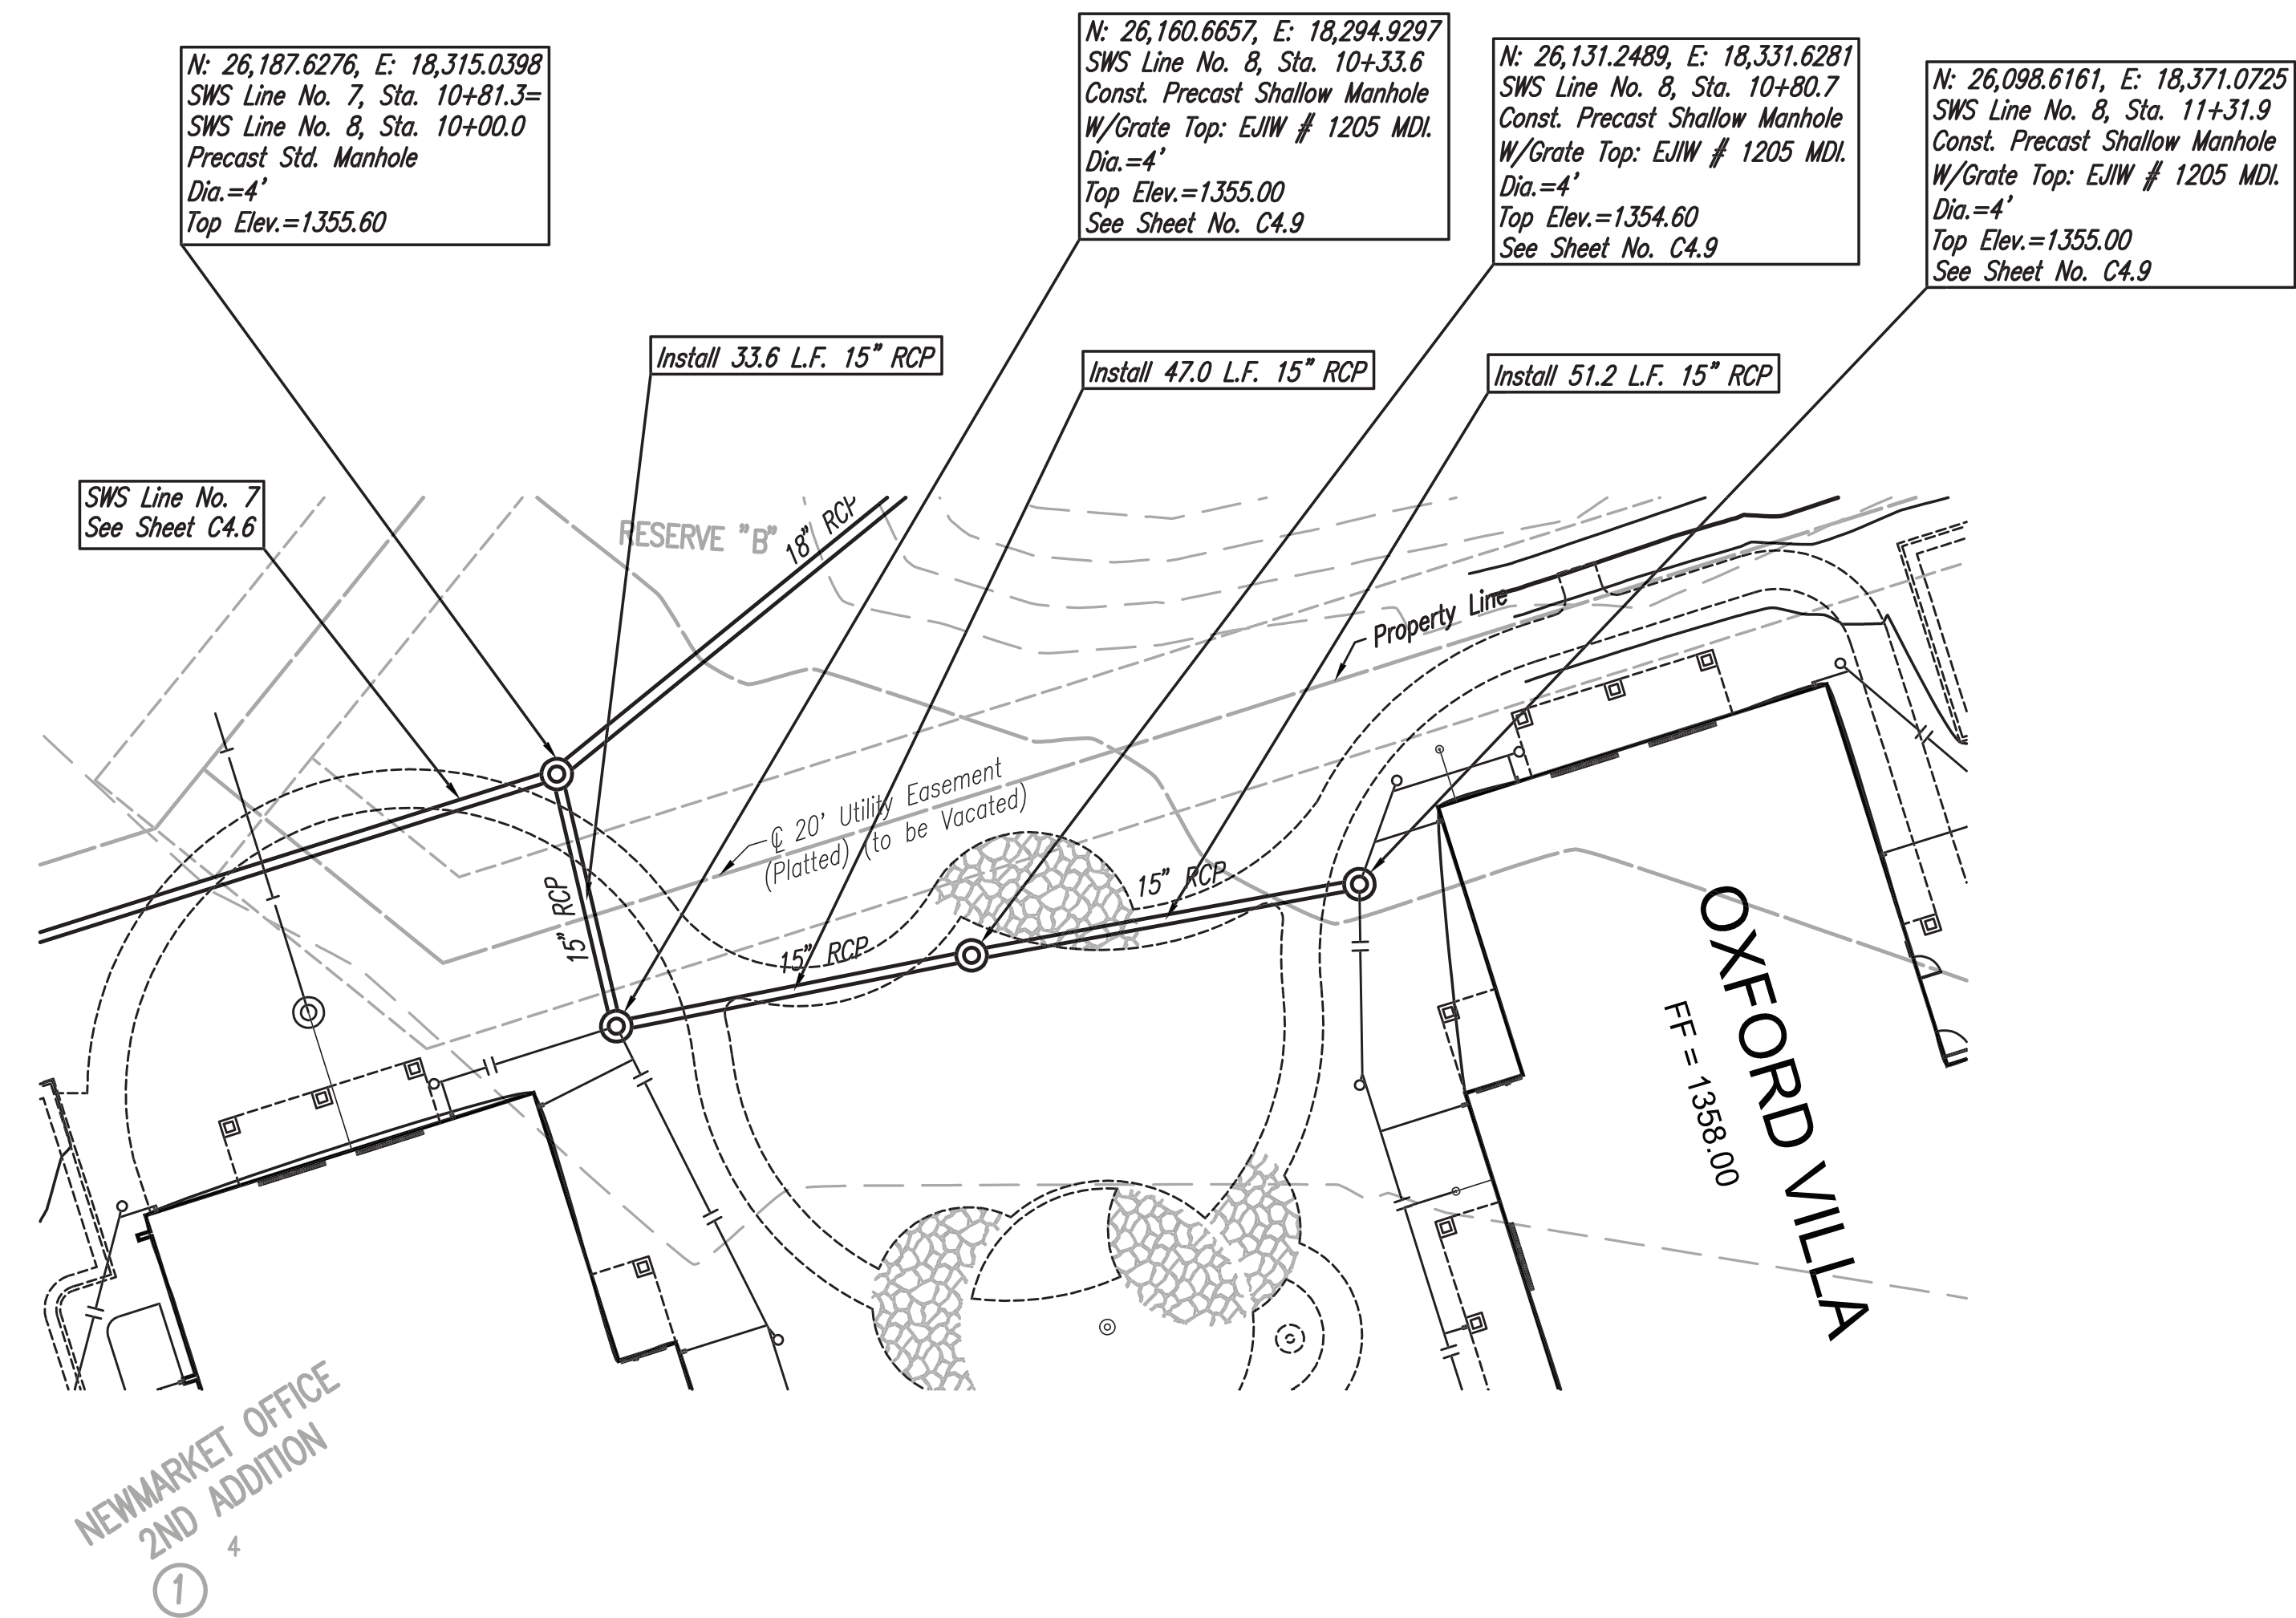


SWS LINE NO. 8

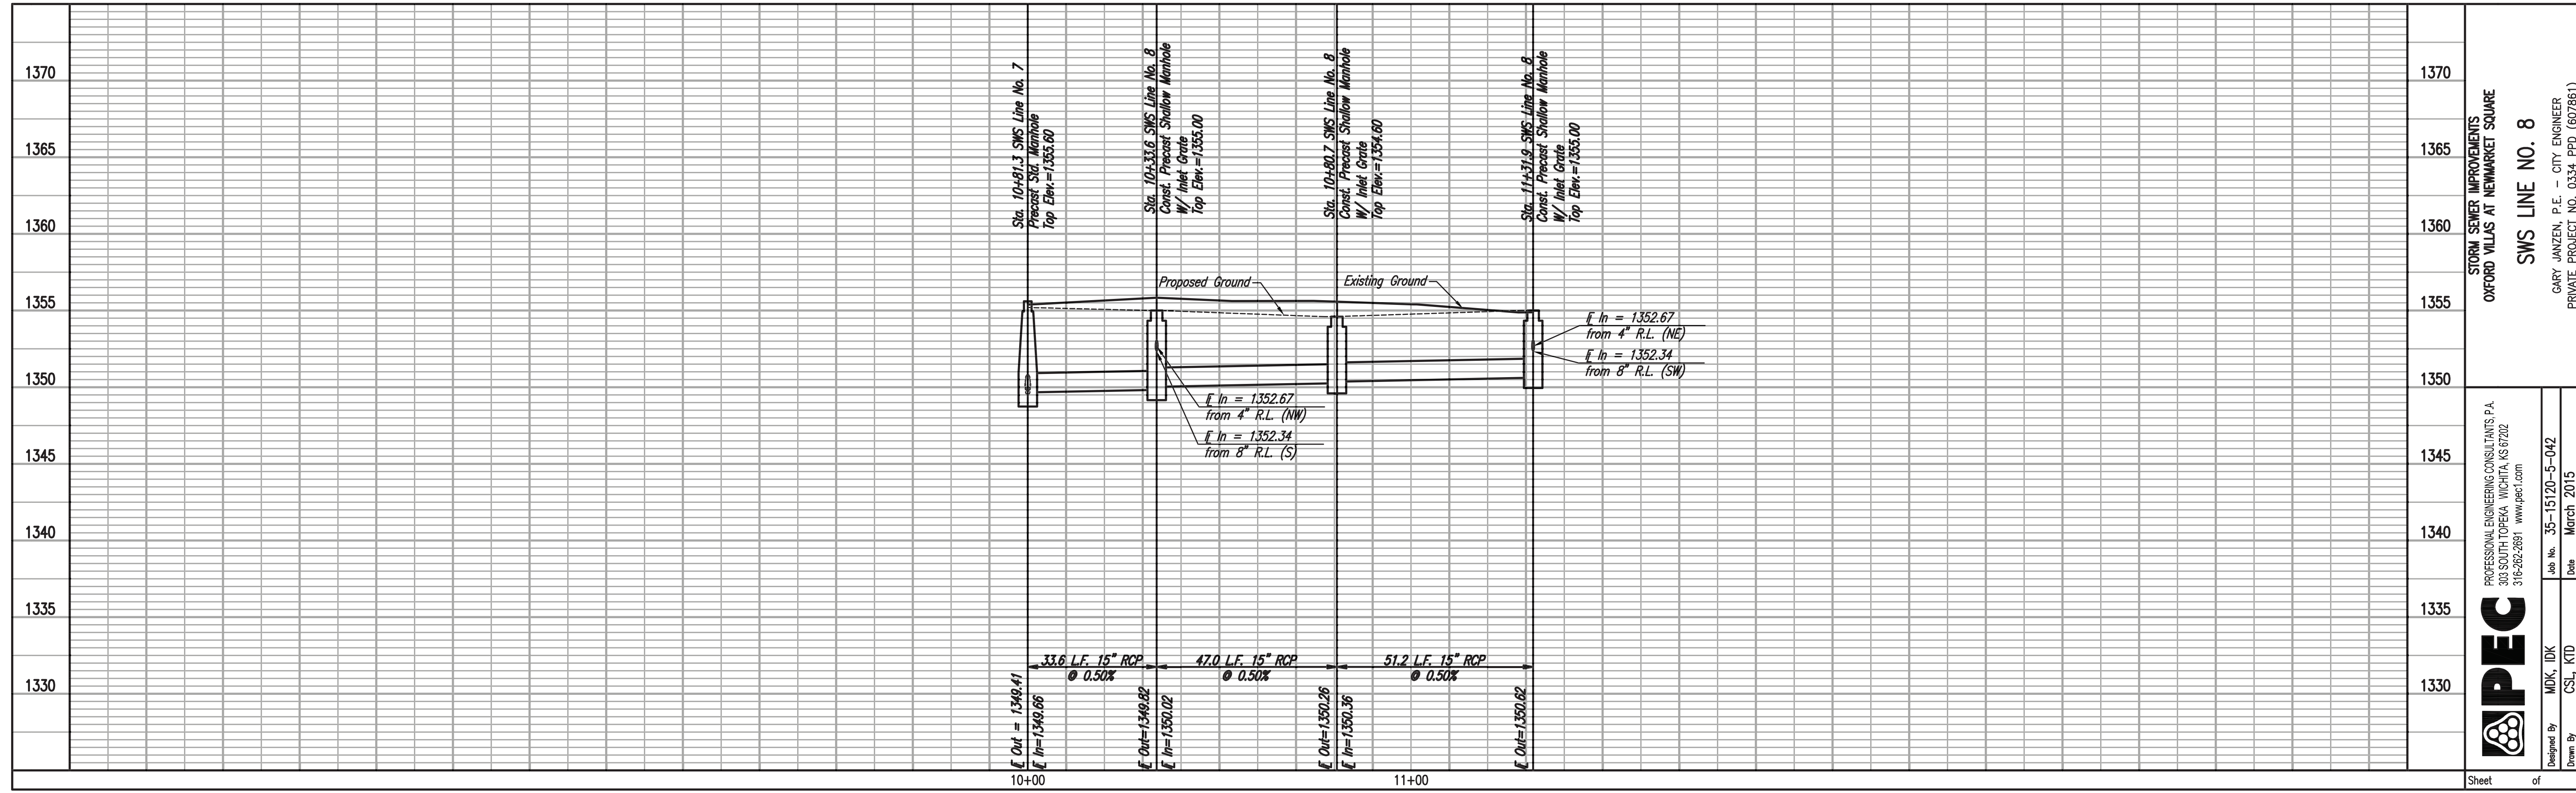

STORM SEWER IMPROVEMENTS
 OXFORD VILLAS AT NEWMARKET SQUARE
 SWS LINE NO. 8
 GARY JANZEN, P.E. - CITY ENGINEER
 PRIVATE PROJECT NO. 0334-PPD (607861)

PROFESSIONAL ENGINEERING CONSULTANTS, P.A.
 303 SOUTH TOPEKA, WICHITA, KS 67202
 316-262-2891 www.pec1.com
 Job No. 35-15120-5-442
 Date: March 2015
 Designed By: MDK, BDK
 Drawn By: CSL, KTD


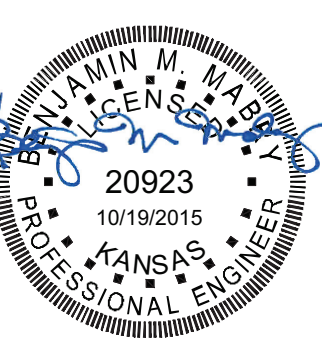


DATE	PURPOSE	NO.
05.11.2015	75% OWNER REVIEW	
05.29.2015	PERMIT SET/BID SET	
06.12.2015	ADDENDUM 1	1
08.10.2015	ADDENDUM 2	2
08.17.2015	ADDENDUM 3	3
09.15.2015	CCD 1	4
09.30.2015	CCD 2	5
10.19.2015	CCD 3	6


ENTIRE SHEET

**OXFORD VILLA
WICHITA, KS**

LKArchitecture
Architecture • Engineering • Planning • Interior Design • Landscape Architecture

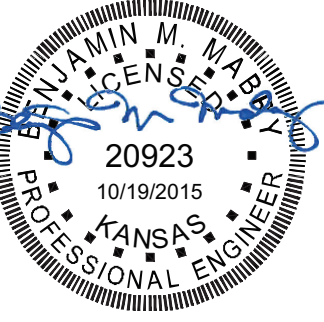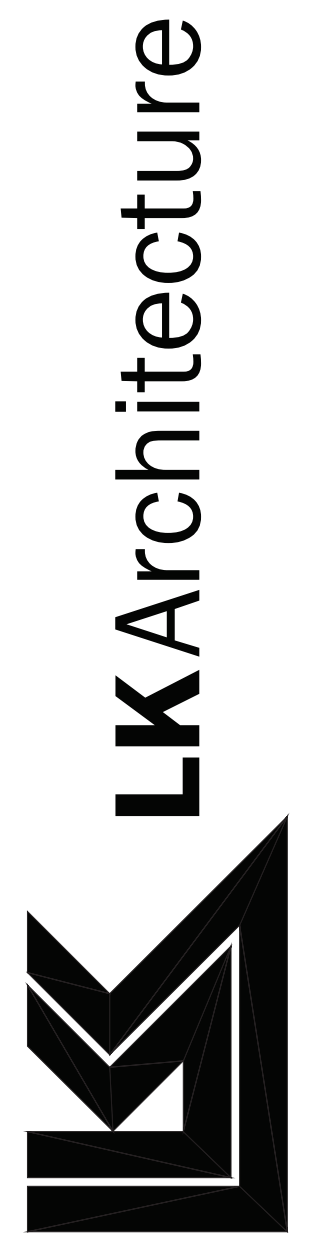

LKArchitecture, Inc.®
345 Riverview Wichita, KS 67203
T 316.268.0230 F 316.268.0205
CONTACT: Isaac Krumme
DRAWN: Roy Thomas
CHECKED: Ben Mabry
PROJECT NUMBER:
14619
SHEET TITLE:
STANDARD TYPE 1
CURB INLET
SHEET NUMBER:
C4.8

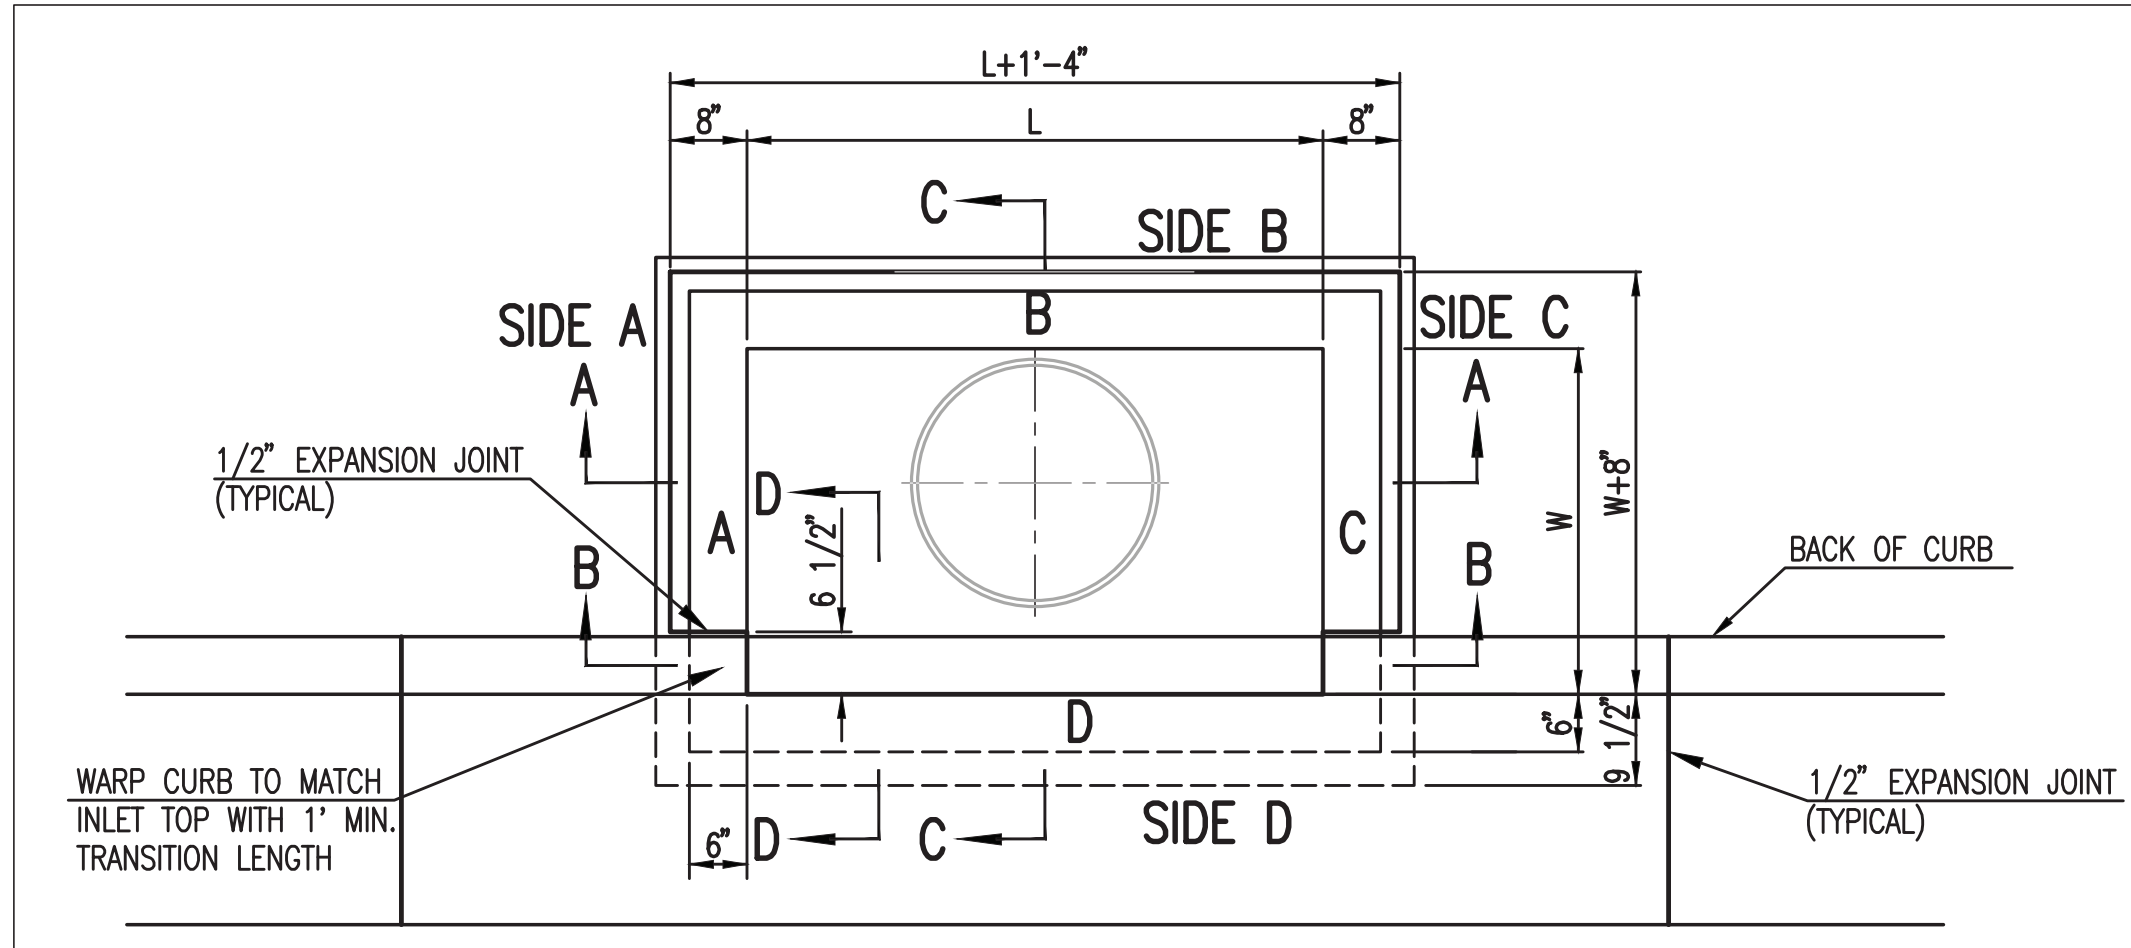

TOP VIEW


BAR SCHEDULE		
INLET OPENING	B1 BARS	SPACING
5'-0"	#4	4"
10'-0"	#6	3.5"

PRECAST CURB INLET WIDTHS				
W	PRE-CAST TOP SIZE			PIPE DIA.**
	WIDTH	LENGTH	TOP	
3'-0"	W+8"	L+1'-4"	7 1/2"	21" & SMALLER
4'-0"	W+8"	L+1'-4"	7 1/2"	24" & 30"
5'-0"	W+8"	L+1'-4"	7 1/2"	36" & 42"
6'-0"	W+8"	L+1'-4"	7 1/2"	48" & 54"
7'-0"	W+8"	L+1'-4"	7 1/2"	60" & 66"


** FOR PIPES PERPENDICULAR TO INLET WALL

GENERAL NOTES

- CONCRETE TOPS TO BE INSTALLED ON THIN MORTAR CUSHION TO INSURE FULL SUPPORT ALONG BRICK. CONCRETE TOPS MAY BE CAST IN PLACE OR PRECAST. CONCRETE USED FOR INLET CONSTRUCTION SHALL CONFORM TO CITY OF WICHITA SPECIFICATIONS FOR CONCRETE PAVEMENT MIX.
- CONTRACTOR SHALL HAVE THE OPTION OF CONSTRUCTING 8" BRICK MASONRY WALLS BETWEEN THE CONCRETE INLET BASE AND TOP OF THIS INLET WHEN W=5'-0" AND H=7'-0" OR LESS.
- INLET INVERT SHALL BE SHAPED WITH 8 SACK SAND MIX CONCRETE TO CREATE FLOW CHANNELS AND TO INCREASE HYDRAULIC EFFICIENCY SUCH THAT THE INLET WILL BE SELF CLEANING BETWEEN ALL INLET AND/OR OUTLET PIPES.
- THE ENDS OF ALL PIPES INSTALLED IN INLETS SHALL BE CUT OFF FLUSH WITH THE INSIDE FACE OF THE INLET WALL.
- INLET FRAME AND COVER TO BE DEETER #2014, EJIW #1936 Z4, OR APPROVED EQUAL, SEE SW-303.
- CONTRACTOR SHALL REMOVE LIFTING HOOKS AFTER INSTALLATION. RECESSES IN INLET WALL SHALL BE GROUTED FLUSH TO THE INLET WALL WITH HYDRAULIC CEMENT AFTER THE INLET IS IN PLACE. LIFTING HOLES THRU THE INLET WALL WILL NOT BE ACCEPTED.

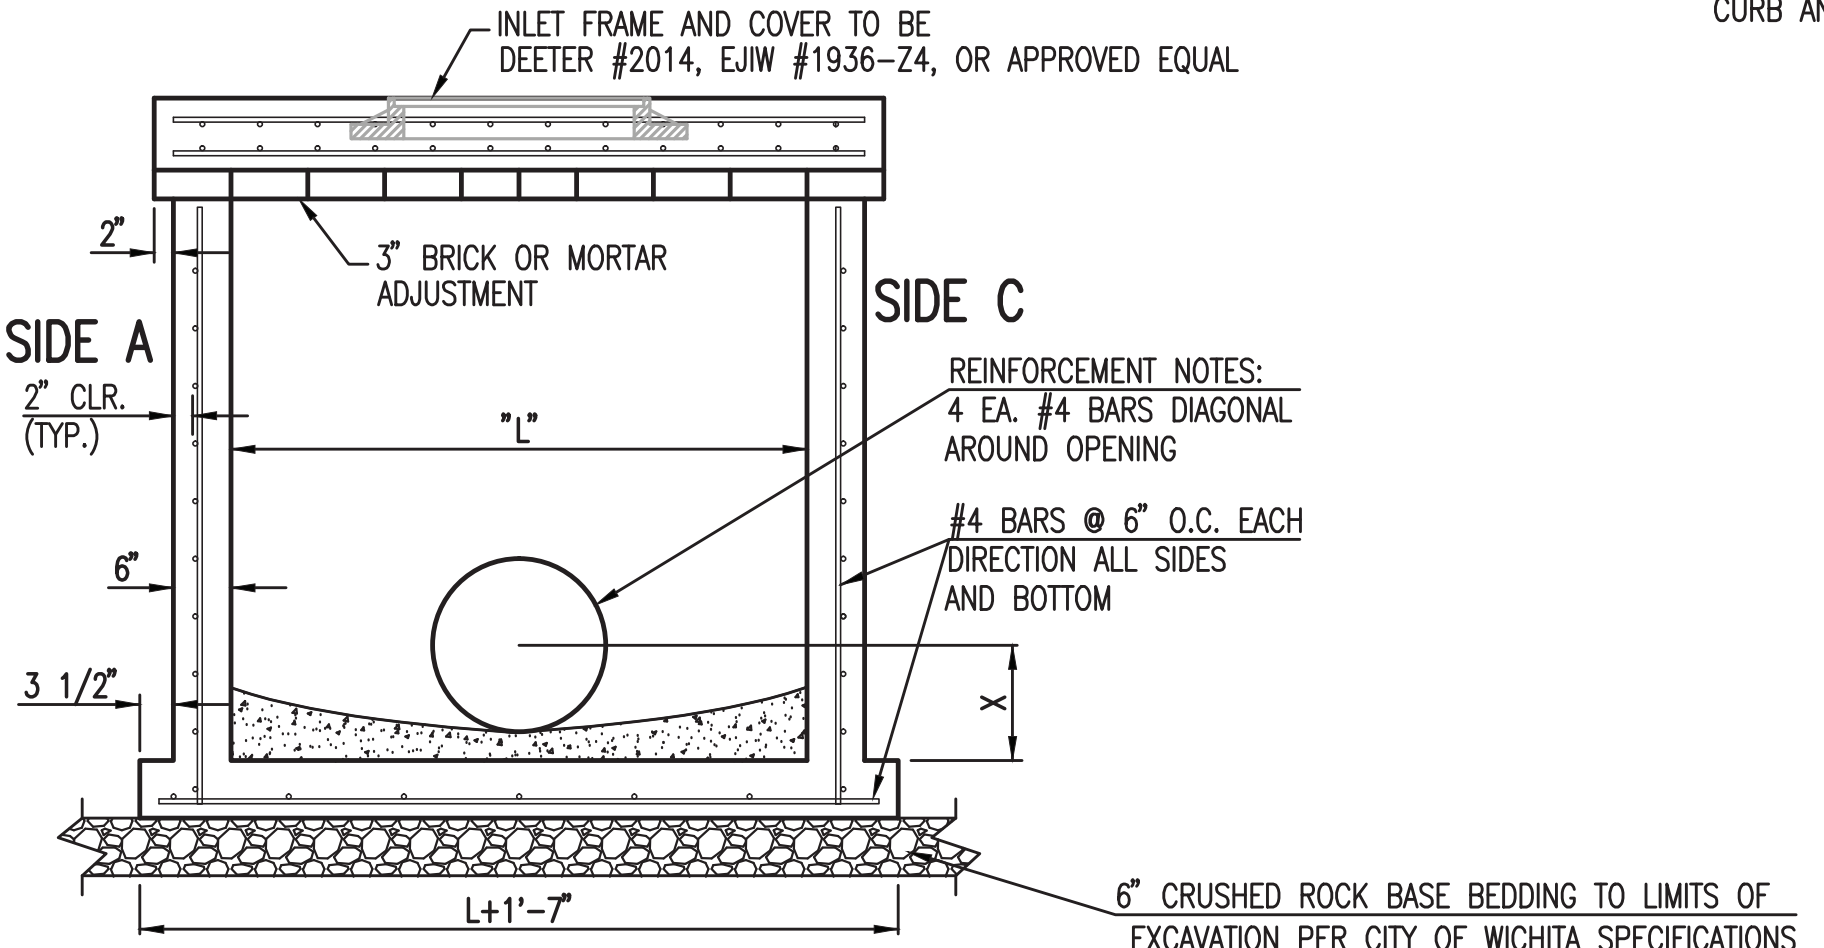


SECTION "A-A"

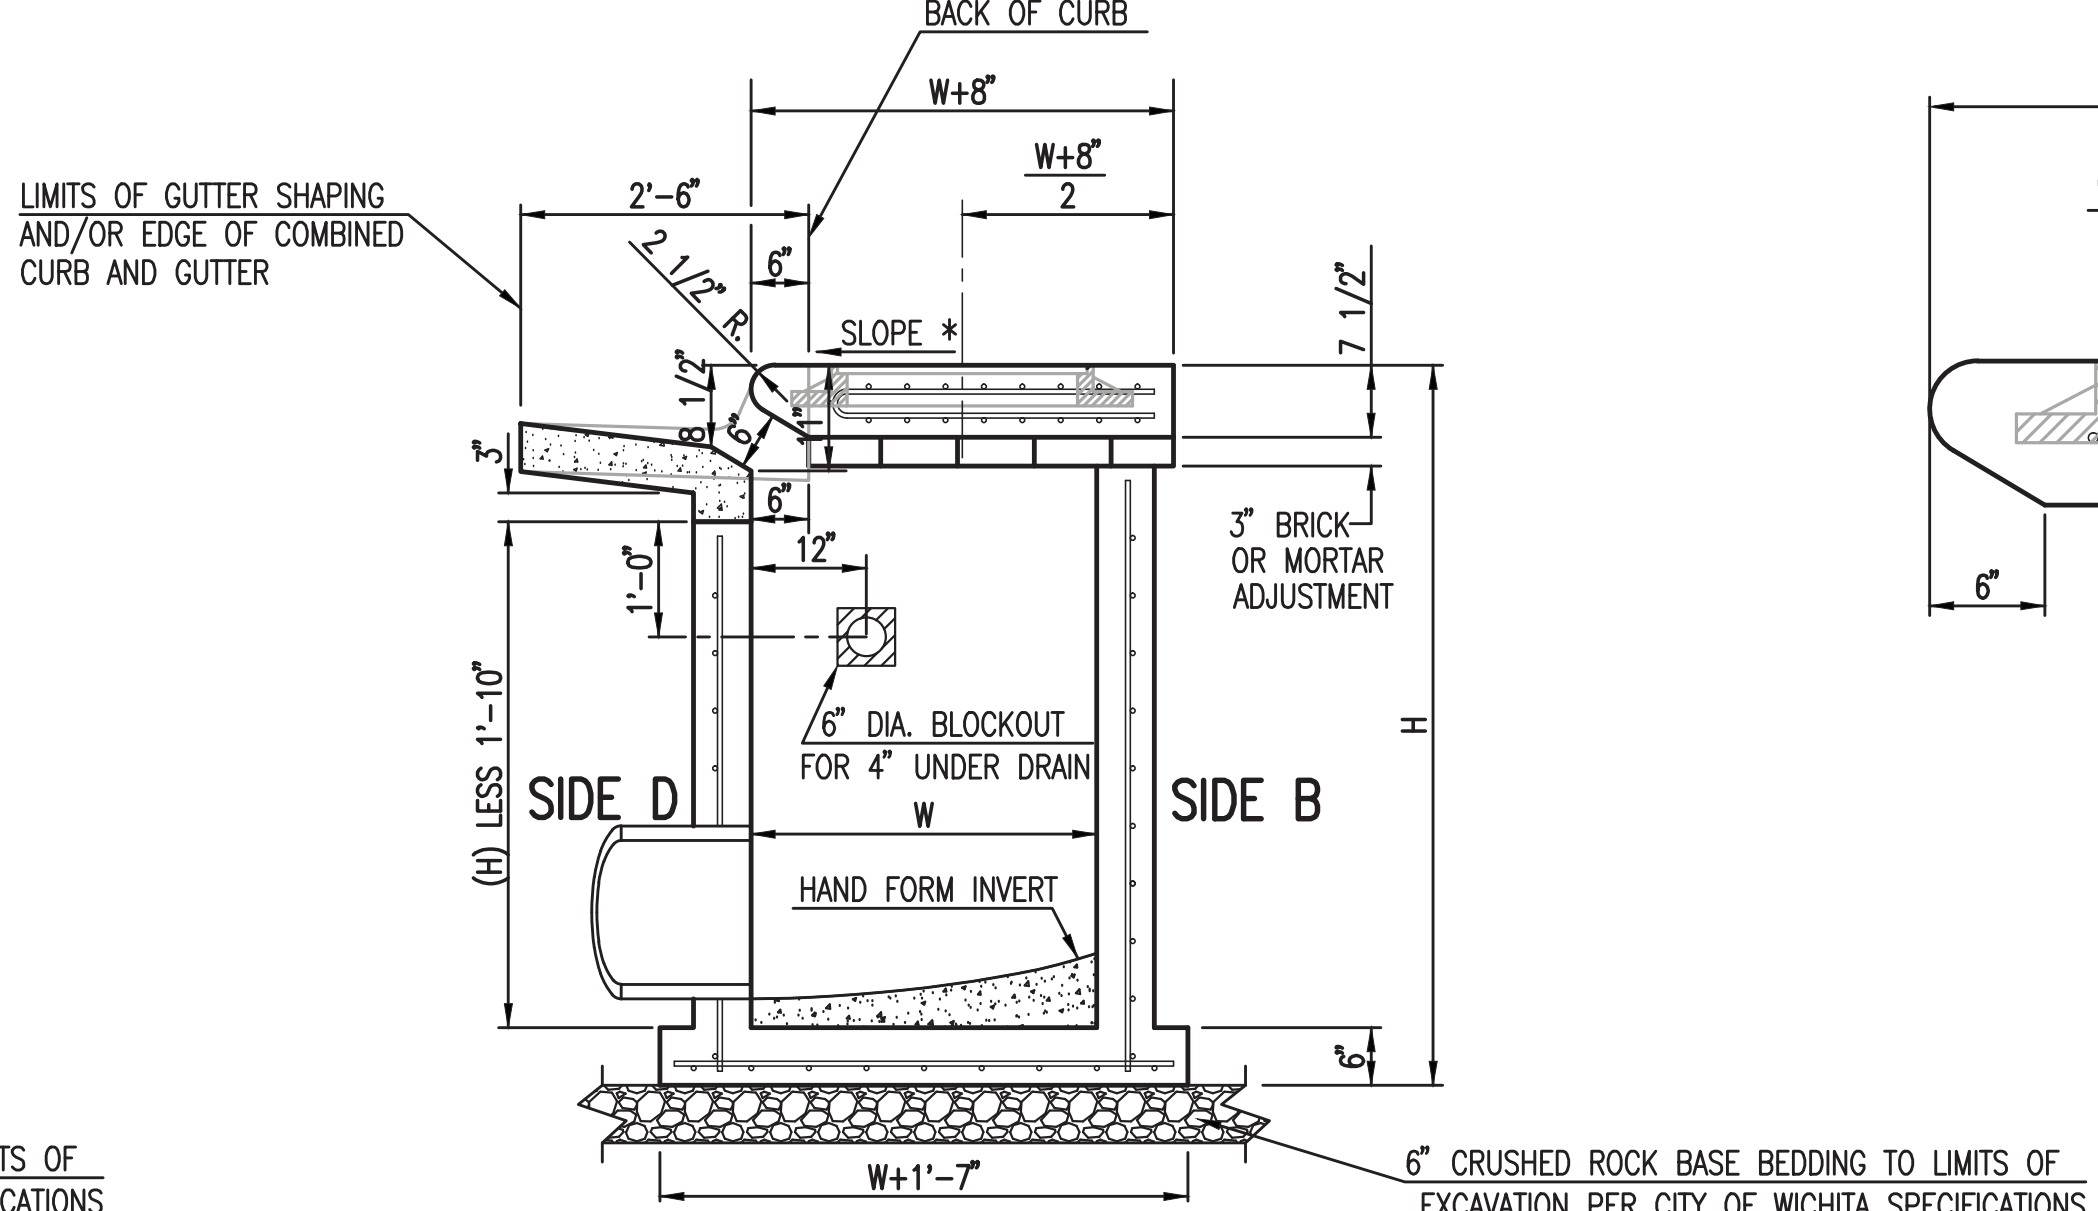


SECTION "C-C"

NOTES:
* SLOPE OF INLET TOP TO MATCH SIDEWALK OR PARKING SLOPES WITHIN LIMITS INDICATED.

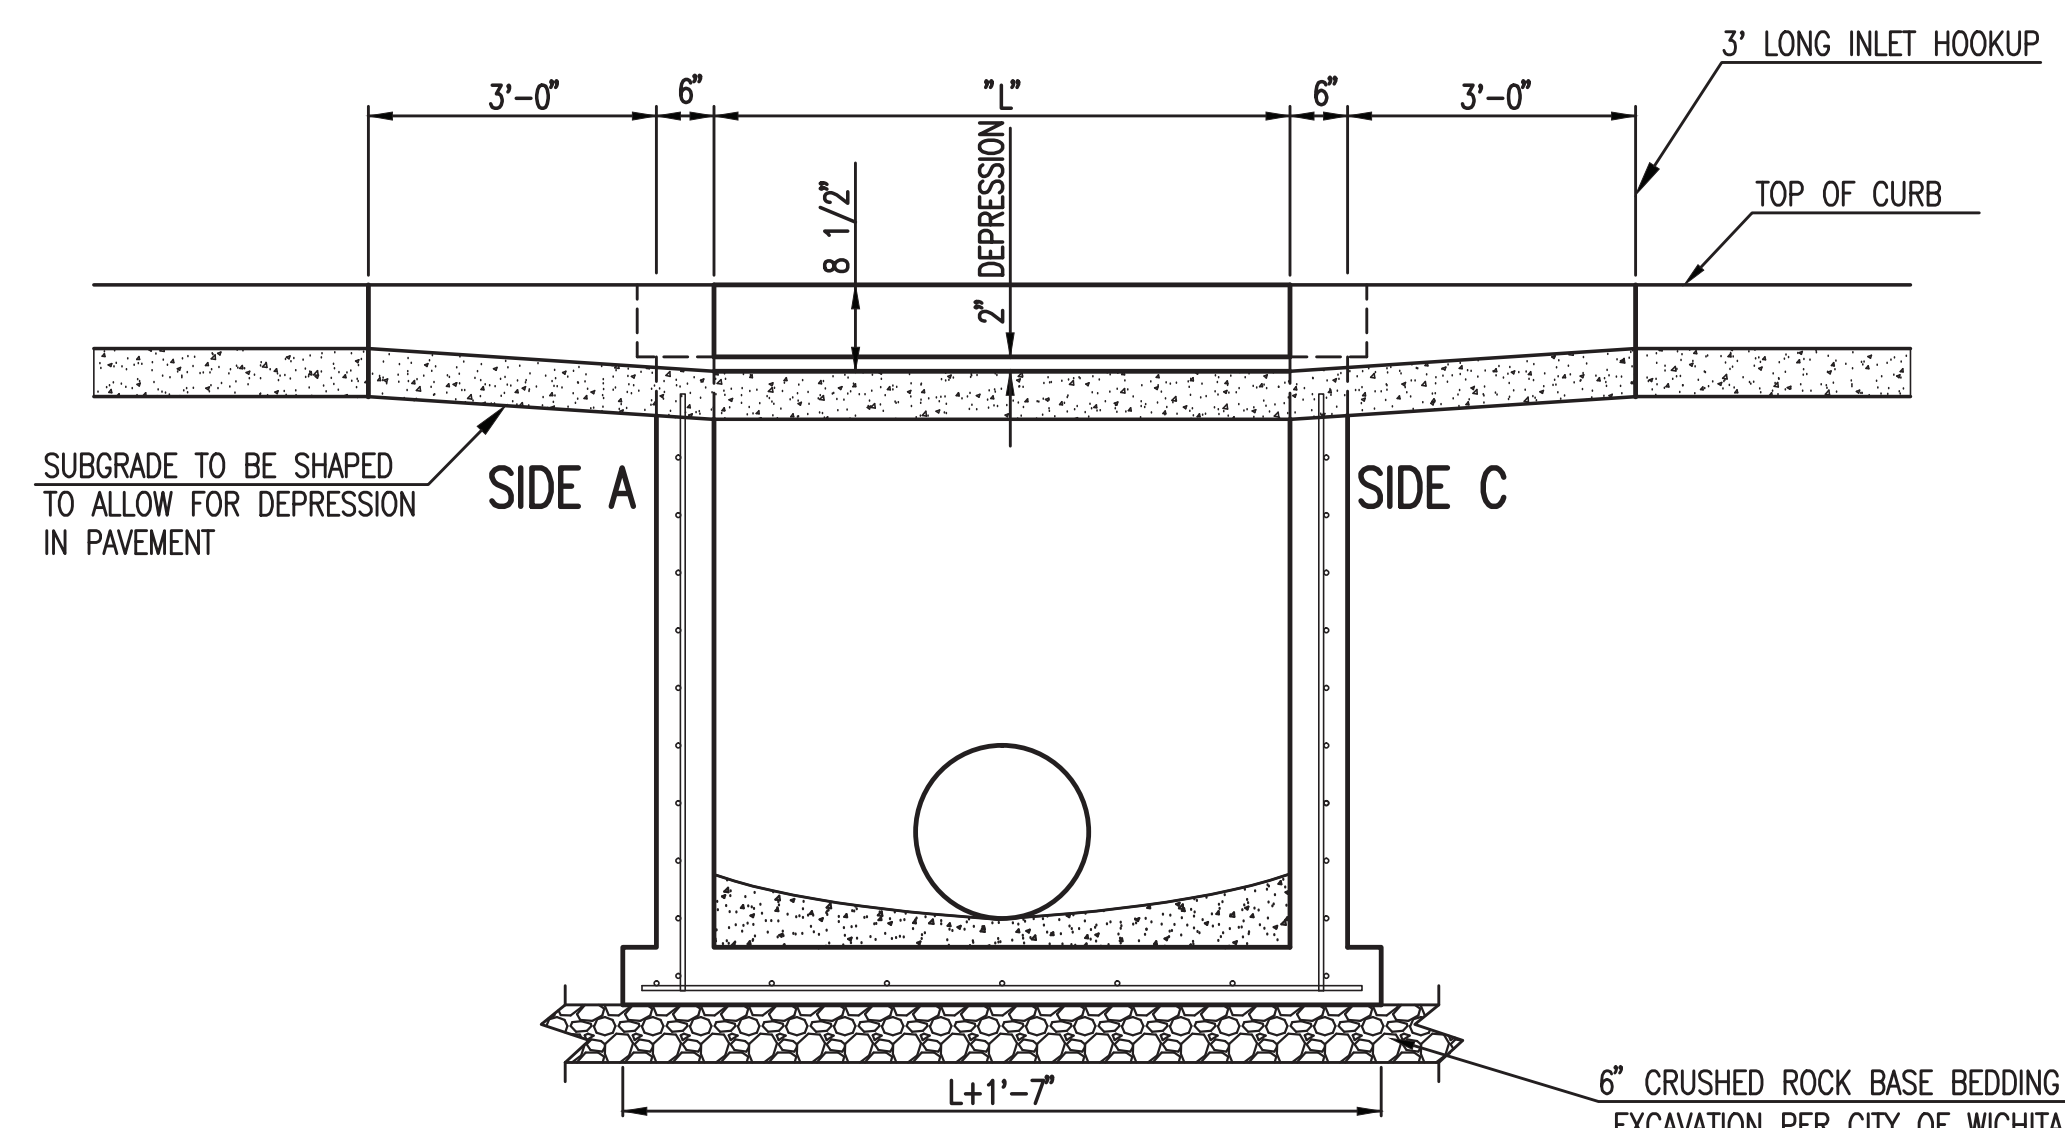

SECTION "B-B"

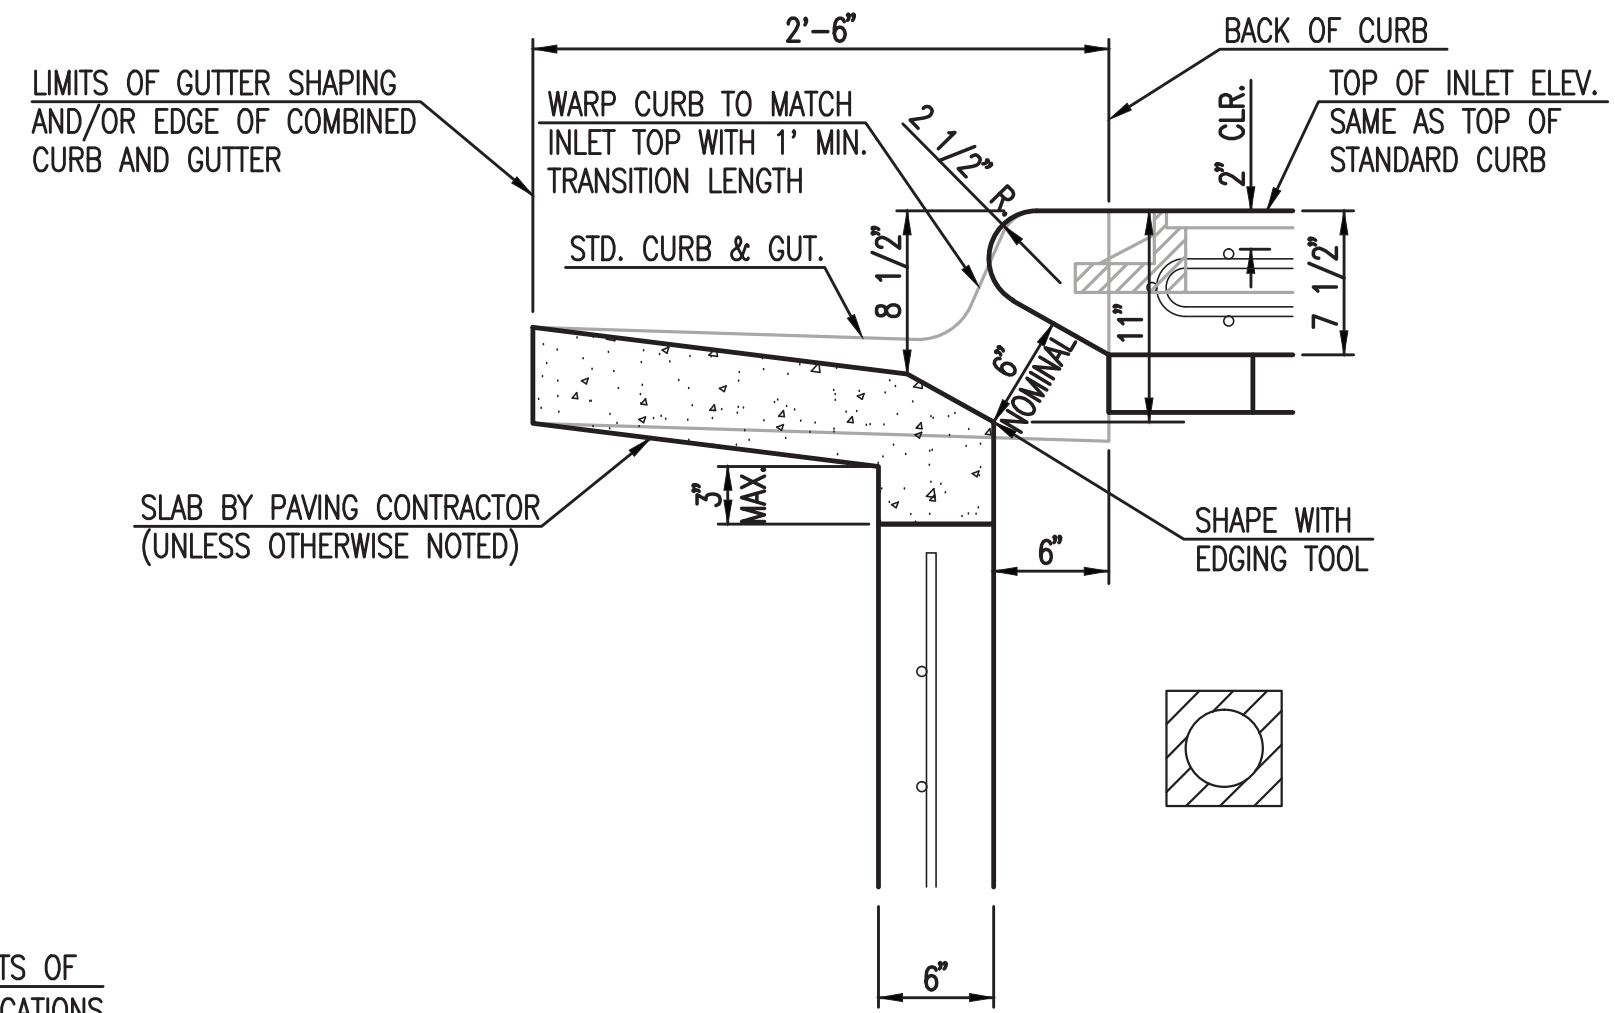

SECTION "D-D"



REVISED: MARCH 2015

**STANDARD TYPE 1
CURB INLET
5'-0" OR 10'-0" OPENING**

CITY ENGINEER
GARY JANZEN, P.E.

PROJECT NUMBER 0334-PPD	OCA NUMBER (607861)	DATE
----------------------------	------------------------	------

CITY ENGINEER'S OFFICE
CITY HALL - SEVENTH FLOOR
435 NORTH MAIN STREET
WICHITA, KANSAS 67202-1620
(316) 268-4501

SHEET
_ of _

SW-101

DATE	PURPOSE	NO.
05.11.2015	75% OWNER REVIEW	
05.29.2015	PERMIT SET/BID SET	
06.12.2015	ADDENDUM 1	1
08.10.2015	ADDENDUM 2	2
08.17.2015	ADDENDUM 3	3
09.15.2015	CCD 1	4
09.30.2015	CCD 2	5
10.19.2015	CCD 3	6


ENTIRE SHEET

**OXFORD VILLA
WICHITA, KS**


LKArchitecture




Architecture • Engineering • Planning • Interior Design • Landscape Architecture

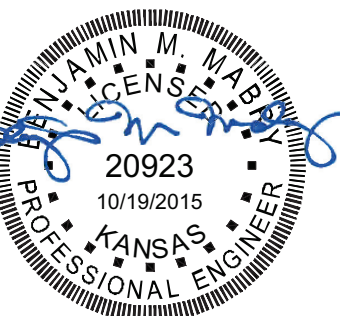


LKArchitecture, Inc.
345 Riverview Wichita, KS 67203
T 316.268.0230 F 316.268.0205
CONTACT: Isaac Krumme
DRAWN: Roy Thomas
CHECKED: Ben Mabry
**PROJECT NUMBER:
14619**
SHEET TITLE:
PRECAST CONCRETE
MANHOLE (STORM SEWER)
SHEET NUMBER:
C4.9

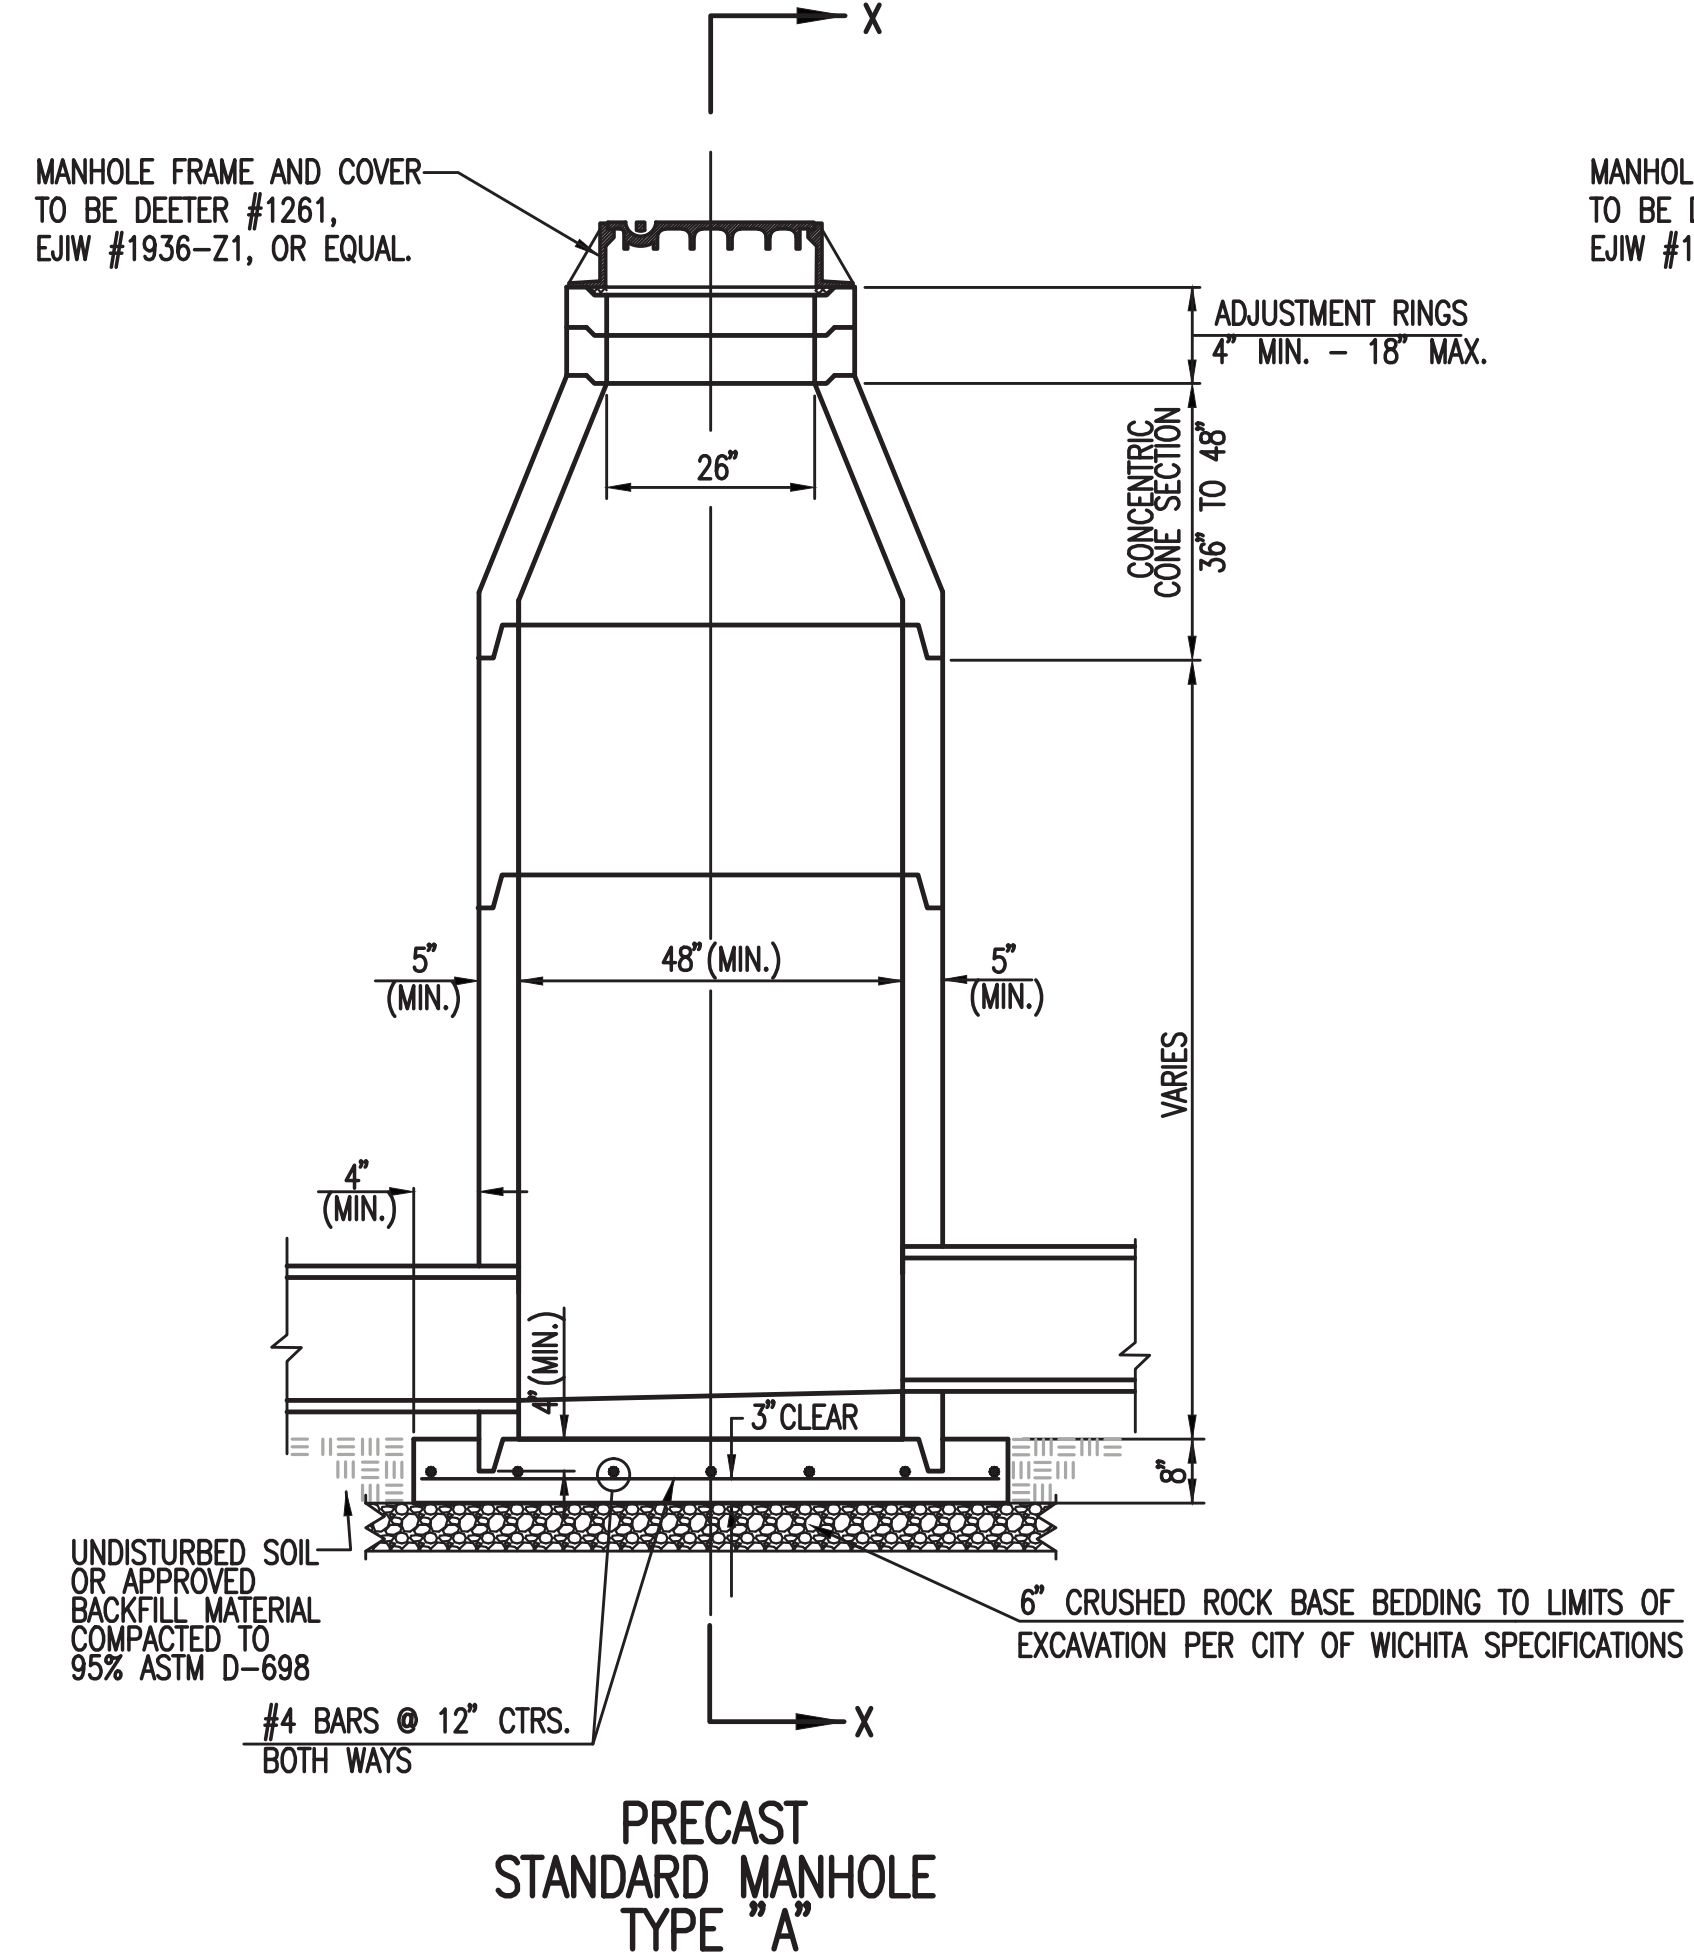


**PRECAST
STANDARD MANHOLE
TYPE "A"**

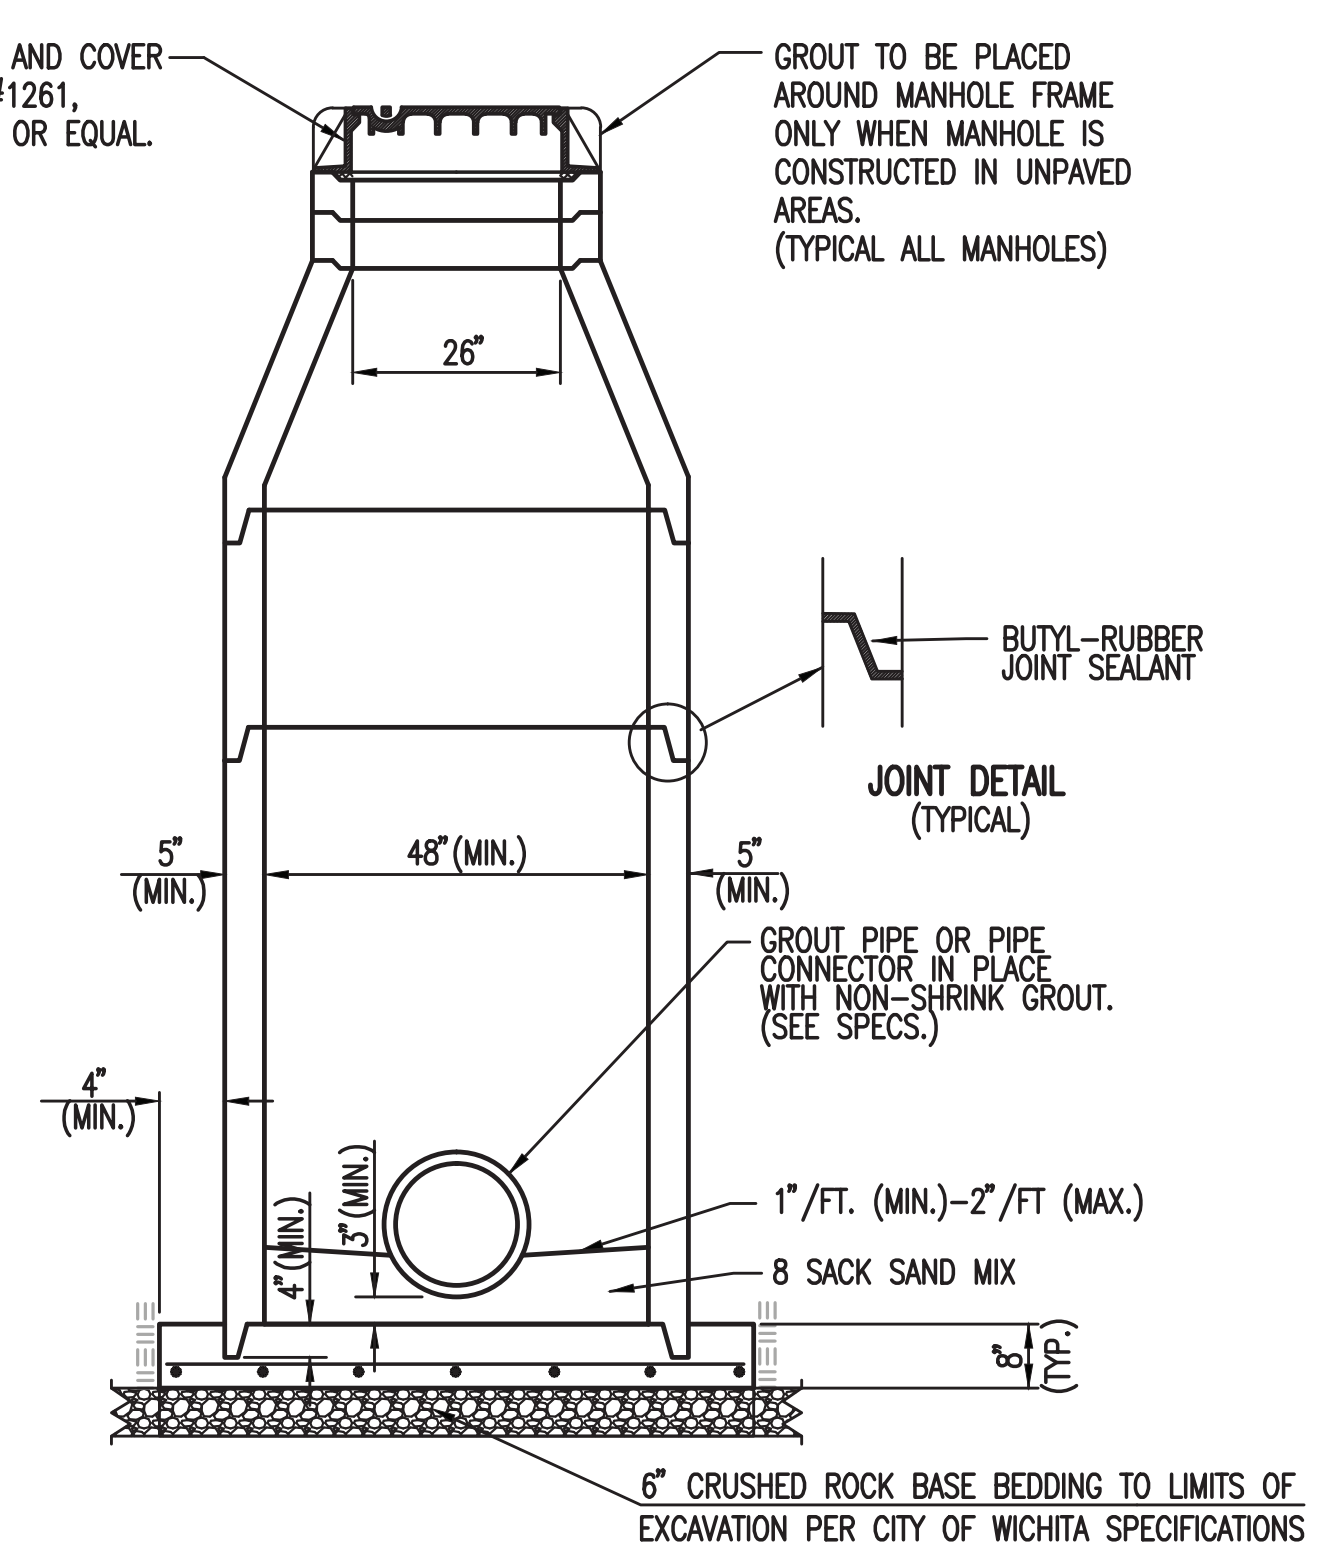

**SECTION X-X
(TYPICAL)**

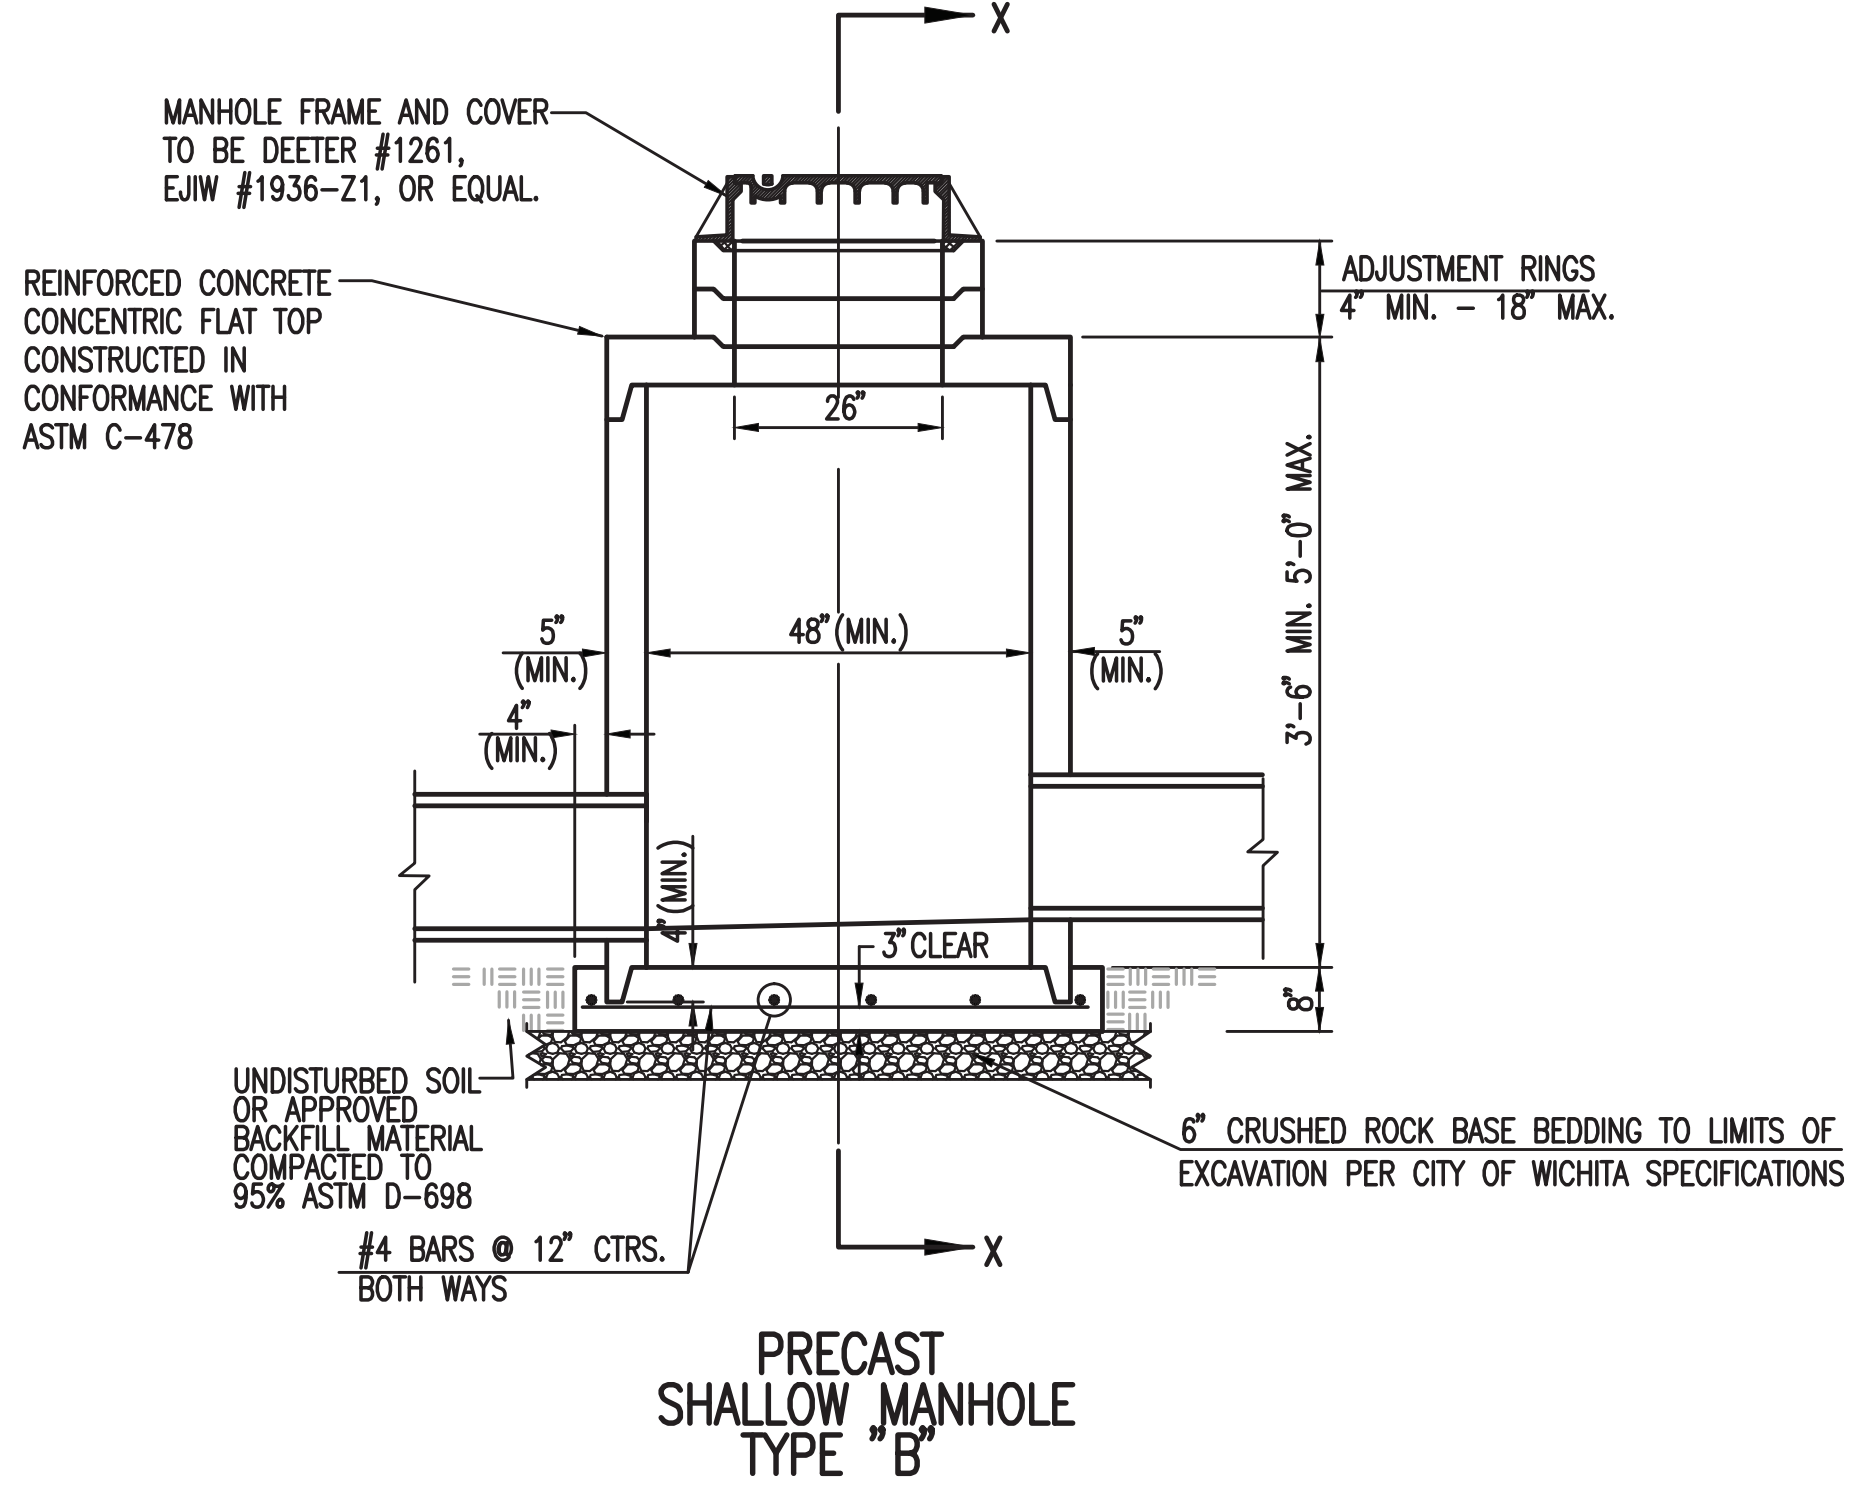

**PRECAST
SHALLOW MANHOLE
TYPE "B"**

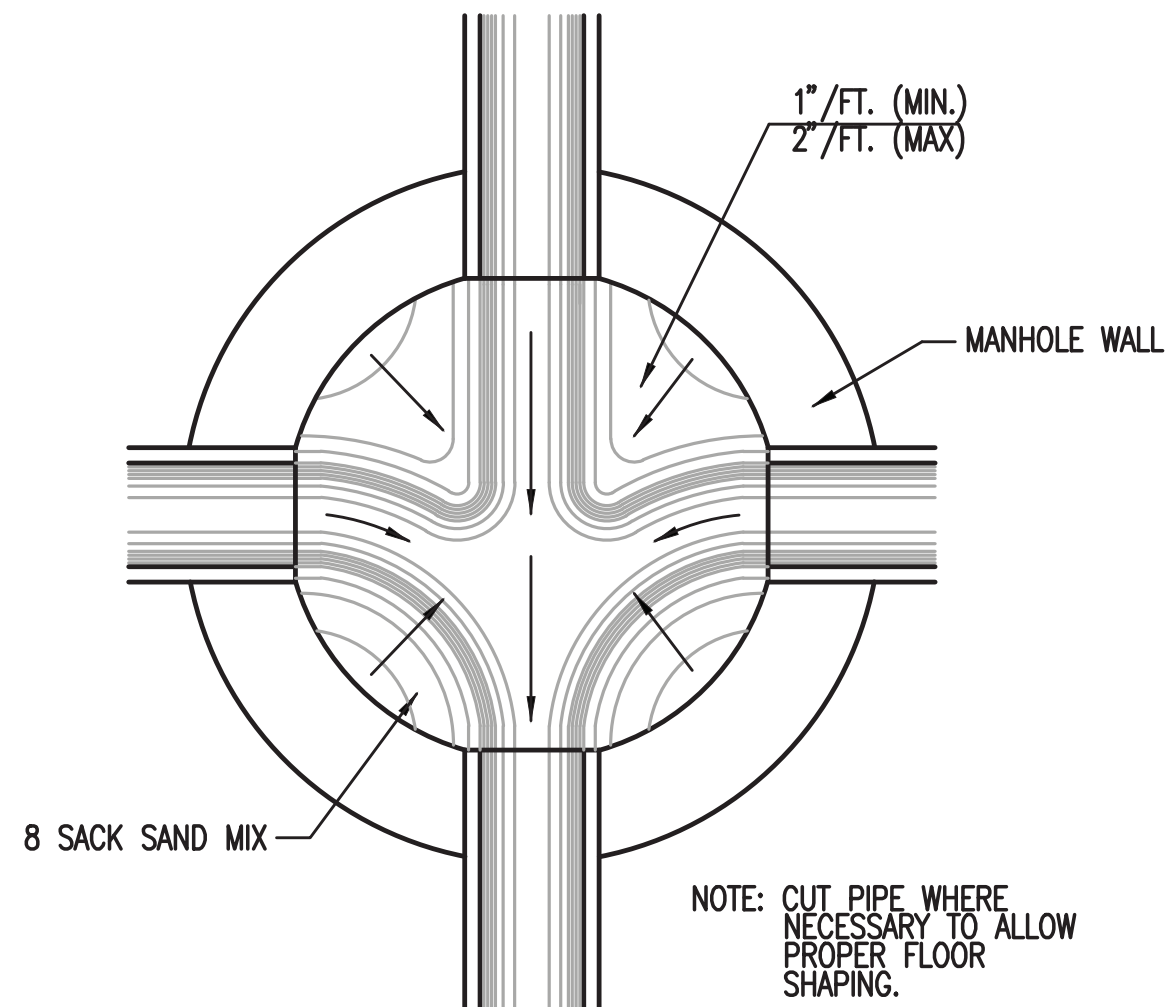

**TYPICAL MANHOLE
FLOOR SHAPING**

GENERAL NOTES

- IF, IN THE OPINION OF THE ENGINEER, THE MANHOLE SUBGRADE APPEARS UNSTABLE, THE CONTRACTOR WILL HAVE THE OPTION TO COMPACT SUBGRADE AS SHOWN OR INCREASE THE THICKNESS OF THE MANHOLE BASE AS DIRECTED BY THE ENGINEER.
- STEEL REINFORCING WILL BE REQUIRED IN ALL MANHOLE BASES.
- ALL MANHOLE CONSTRUCTION SHALL BE WATER TIGHT.
- TOP OF MANHOLE FLOOR SLAB SHALL BE AT LEAST 3 INCHES BELOW THE FLOW LINE OF THE OUTLET PIPE TO INSURE SUFFICIENT MINIMUM THICKNESS OF SHAPED INVERT.
- ALL PRECAST CONCRETE MANHOLE SECTIONS SHALL CONFORM TO THE LATEST REVISION OF ASTM C-478 AS MODIFIED BY THE SPECIFICATIONS.
- CONCRETE USED FOR MANHOLE CONSTRUCTION SHALL CONFORM TO CITY OF WICHITA SPECIFICATIONS FOR CONCRETE PAVEMENT MIX.
- PRECAST MANHOLES SHALL BE SET AT LEAST 4 INCHES INTO MANHOLE BASE.
- MANHOLES WITH PIPE SIZES 24" AND LARGER SHALL HAVE 5 FOOT INSIDE DIAMETER (MIN.)
- MANHOLES WITH PRECAST BASES MAY BE USED AT THE CONTRACTORS OPTION. THESE MANHOLES SHALL HAVE AN 8" MINIMUM BASE THICKNESS AND SHALL BE PLACED ON AN 8" MIN. CRUSHED ROCK BASE. PIPES SHALL BE ENCASED WITH CRUSHED ROCK TO AT LEAST 3 FEET FROM THE MANHOLE WALL.
- CONTRACTOR SHALL REMOVE LIFTING HOOKS AFTER INSTALLATION. RECESSES IN MANHOLE WALL SHALL BE GROUTED FLUSH TO THE MANHOLE WALL WITH HYDRAULIC CEMENT AFTER THE MANHOLE IS IN PLACE. LIFTING HOLES THRU THE MANHOLE WALL WILL NOT BE ACCEPTED.
- THE ENDS OF ALL PIPES IN MANHOLES SHALL BE CUT OFF FLUSH WITH THE INSIDE FACE OF THE MANHOLE WALL.
- MANHOLE INVERT SHALL BE SHAPED WITH 8 SACK SAND MIX CONCRETE TO CREATE FLOW CHANNELS AND TO INCREASE HYDRAULIC EFFICIENCY SUCH THAT THE MANHOLE WILL BE SELF CLEANING BETWEEN ALL INLET AND/OR OUTLET PIPES.
- MANHOLE FRAME AND COVER TO BE DEETER #1261, EJIW #1936-Z1, OR APPROVED EQUAL, SEE SW-303.
- FOR FLAT GRATED INLET APPLICATION, GRATE TO BE DEETER #1933, EJIW #1205 MDI, OR APPROVED EQUAL.
- FOR BEEHIVE GRATE APPLICATION, GRATE TO BE DEETER #4495, EJIW #120545, OR APPROVED EQUAL.



REVISED: MARCH 2015		
PRECAST CONCRETE MANHOLE (STORM SEWER)		
CITY ENGINEER GARY JANZEN, P.E.		
PROJECT NUMBER 0334-PPD	OCA NUMBER (607861)	DATE
CITY ENGINEER'S OFFICE CITY HALL - SEVENTH FLOOR 455 NORTH MAIN STREET WICHITA, KANSAS 67202-1620 (316) 268-4501		SHEET

SW-301

Save: 08-10-2015 10:40:06 AM by: RBT
U:\Projects - Civil\2015\15120\2015\15120\DWG\15120-005-C4.9-PRECAST CONCRETE MANHOLE




DATE	PURPOSE	NO.
05.11.2015	75% OWNER REVIEW	
05.29.2015	PERMIT SET/BID SET	
06.12.2015	ADDENDUM 1	1
08.10.2015	ADDENDUM 2	2
08.17.2015	ADDENDUM 3	3
09.15.2015	CCD 1	4
09.30.2015	CCD 2	5
10.19.2015	CCD 3	6


ENTIRE SHEET

**OXFORD VILLA
WICHITA, KS**

LKArchitecture
Architecture • Engineering • Planning • Interior Design • Landscape Architecture

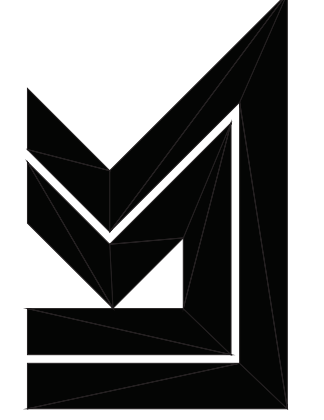

LKArchitecture, Inc.
345 Riverview Wichita, KS 67203
T 316.268.0230 F 316.268.0205
CONTACT: Isaac Krumme
DRAWN: Roy Thomas
CHECKED: Ben Mabry
PROJECT NUMBER:
14619
SHEET TITLE:
MANHOLE-INLET
FRAME AND COVER
(STORM SEWER)
SHEET NUMBER:
C4.10

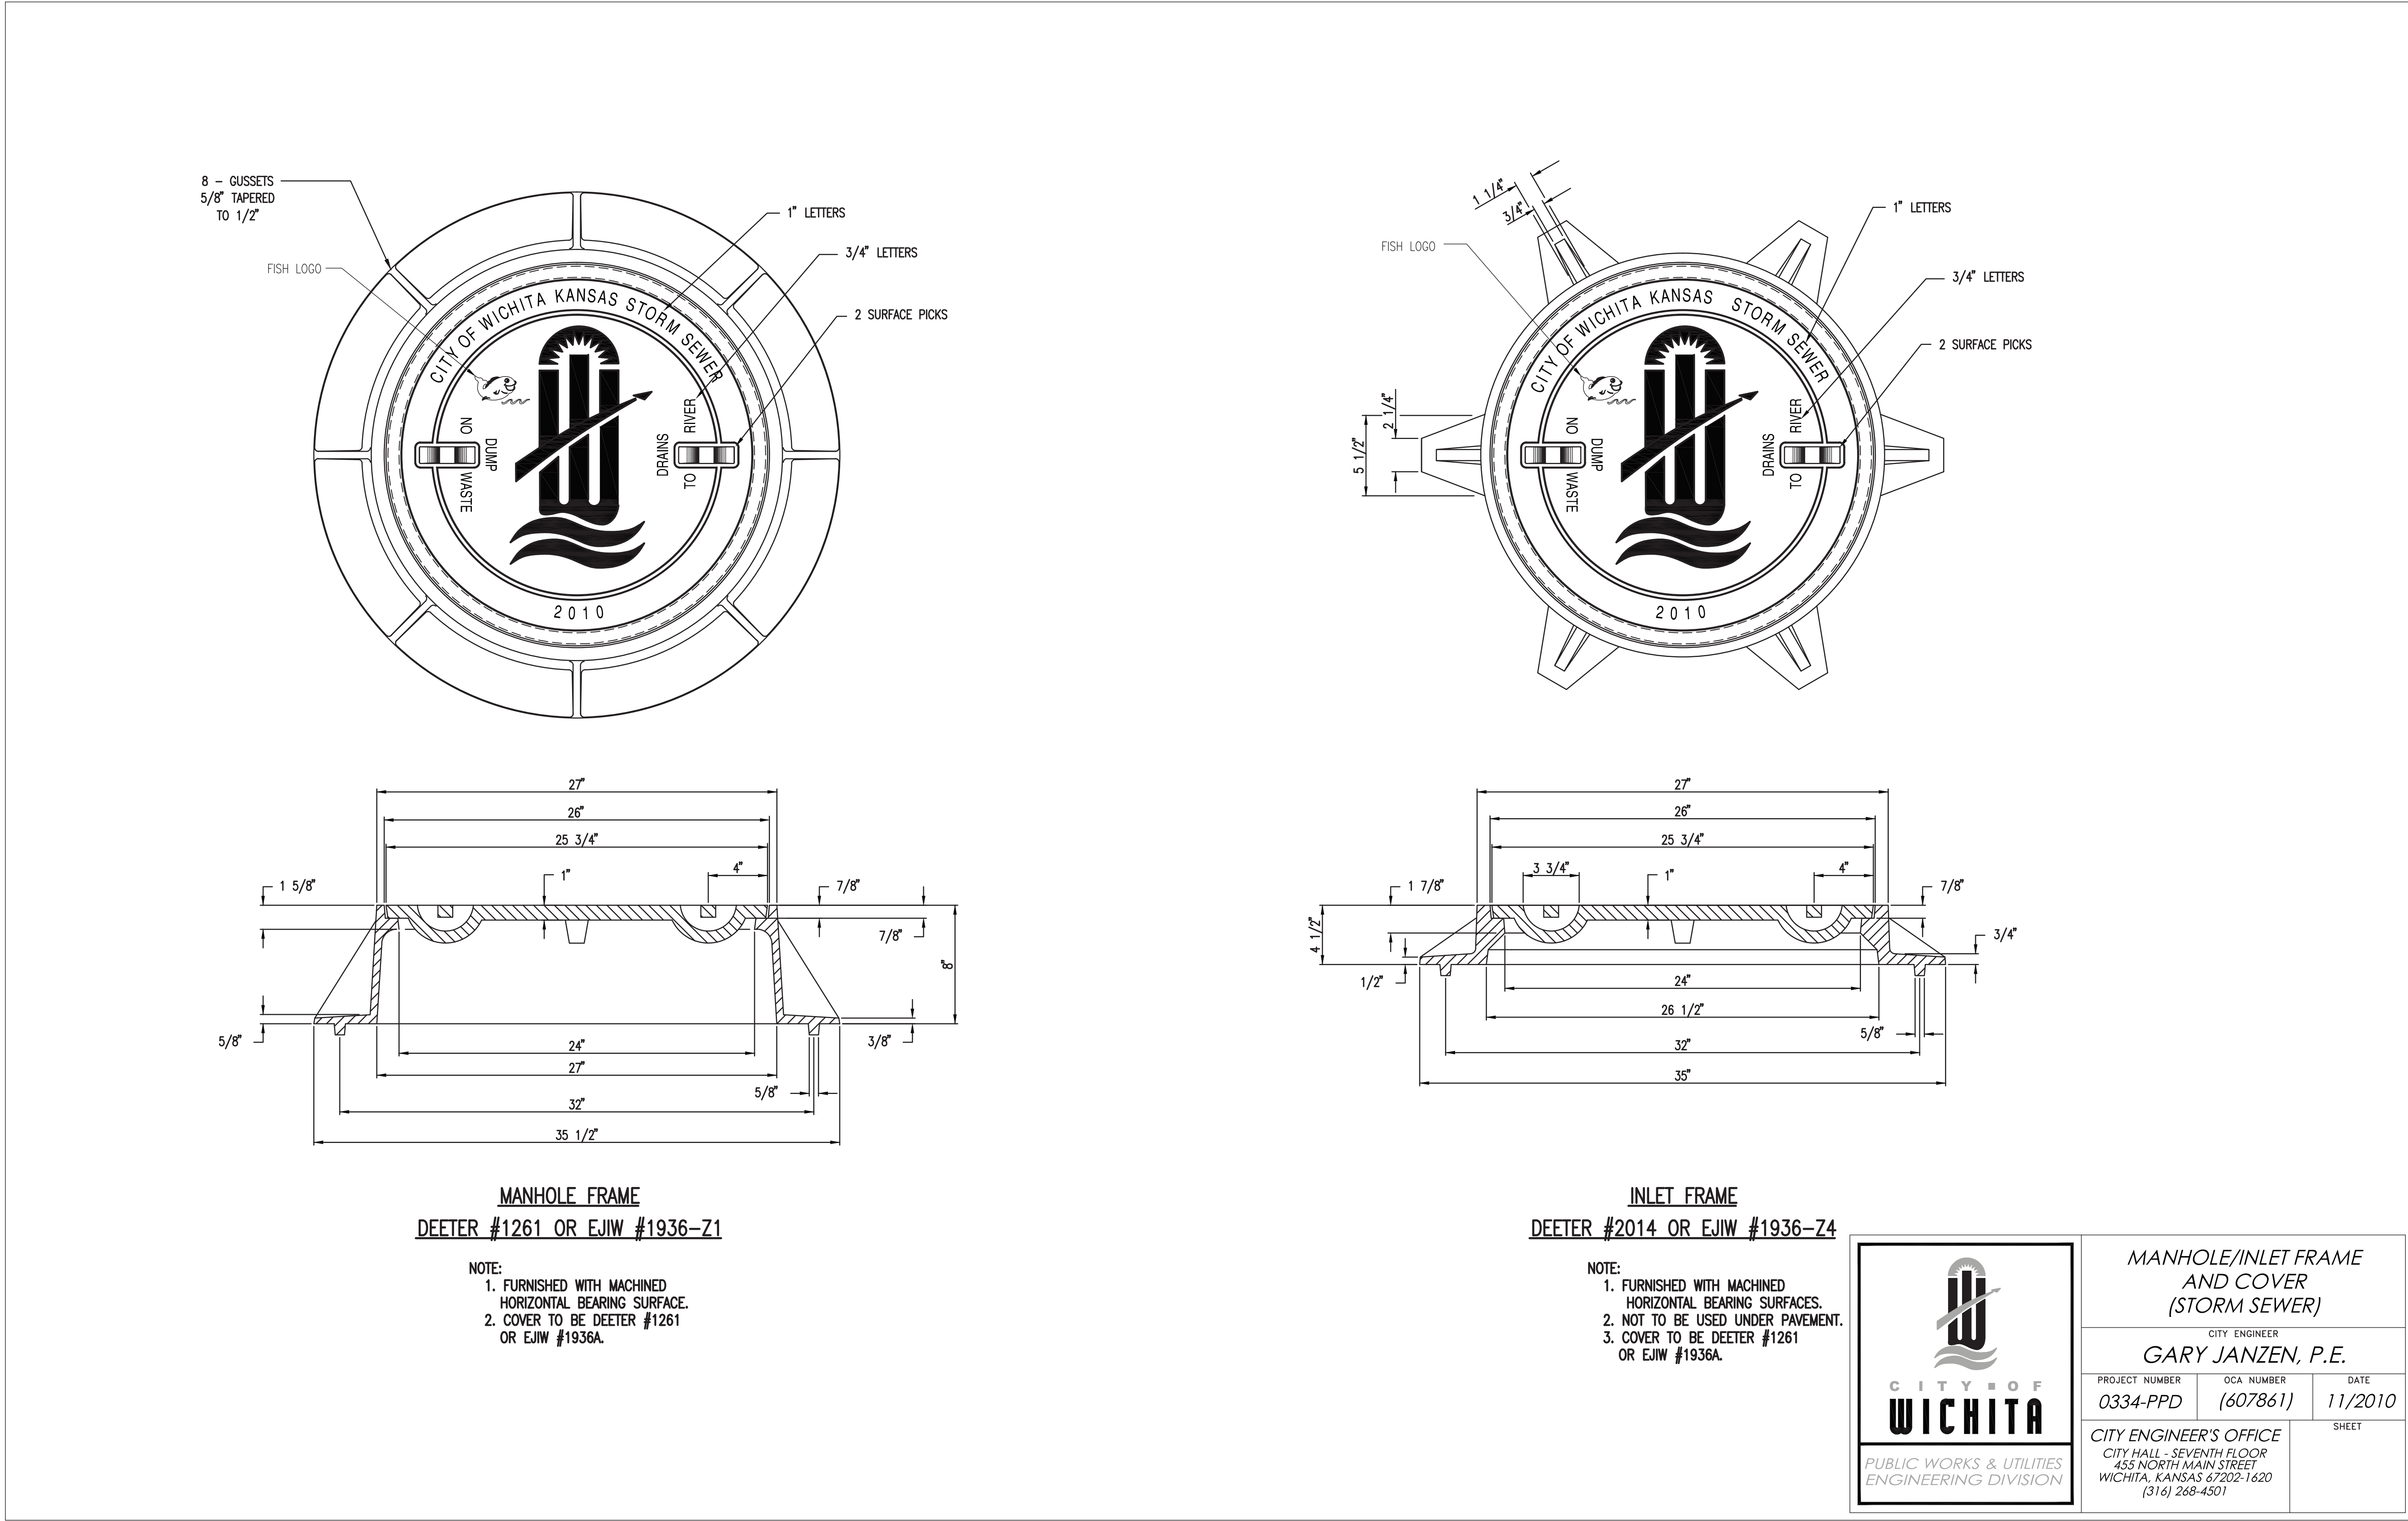

MANHOLE FRAME
DEETER #1261 OR EJIW #1936-Z1

- NOTE:
1. FURNISHED WITH MACHINED HORIZONTAL BEARING SURFACE.
 2. COVER TO BE DEETER #1261 OR EJIW #1936A.

INLET FRAME
DEETER #2014 OR EJIW #1936-Z4

- NOTE:
1. FURNISHED WITH MACHINED HORIZONTAL BEARING SURFACES.
 2. NOT TO BE USED UNDER PAVEMENT.
 3. COVER TO BE DEETER #1261 OR EJIW #1936A.



MANHOLE/INLET FRAME AND COVER (STORM SEWER)		
CITY ENGINEER GARY JANZEN, P.E.		
PROJECT NUMBER 0334-PPD	OCA NUMBER (607861)	DATE 11/2010
CITY ENGINEER'S OFFICE CITY HALL - SEVENTH FLOOR 435 NORTH MAIN STREET WICHITA, KANSAS 67202-1620 (316) 268-4501		SHEET

SW-303


Save: 10-01-2015 8:56:52 AM by: C.S.L.
U:\Projects-2015\15101\03\Drawings\15101-005-C4.10-MANHOLE INLET FRAME AND COVER

DATE	PURPOSE	NO.
05.11.2015	75% OWNER REVIEW	1
05.29.2015	PERMIT SET/BID SET	1
06.12.2015	ADDENDUM 1	2
08.10.2015	ADDENDUM 2	3
08.17.2015	ADDENDUM 3	4
09.15.2015	CCD 1	5
09.30.2015	CCD 2	6
10.19.2015	CCD 3	6



ENTIRE SHEET

**OXFORD VILLA
WICHITA, KS**

LKArchitecture
Architecture • Engineering • Planning • Interior Design • Landscape Architecture

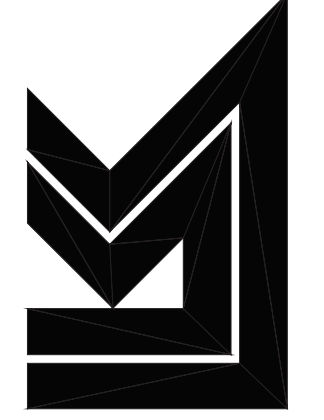

LKArchitecture, Inc.
345 Riverview Wichita, KS 67203
T 316.268.0230 F 316.268.0205
CONTACT: Isaac Krumme
DRAWN: Roy Thomas
CHECKED: Ben Mabry
PROJECT NUMBER:
14619
SHEET TITLE:
SINGLE-DOUBLE
DROP INLET
SHEET NUMBER:
C4.11

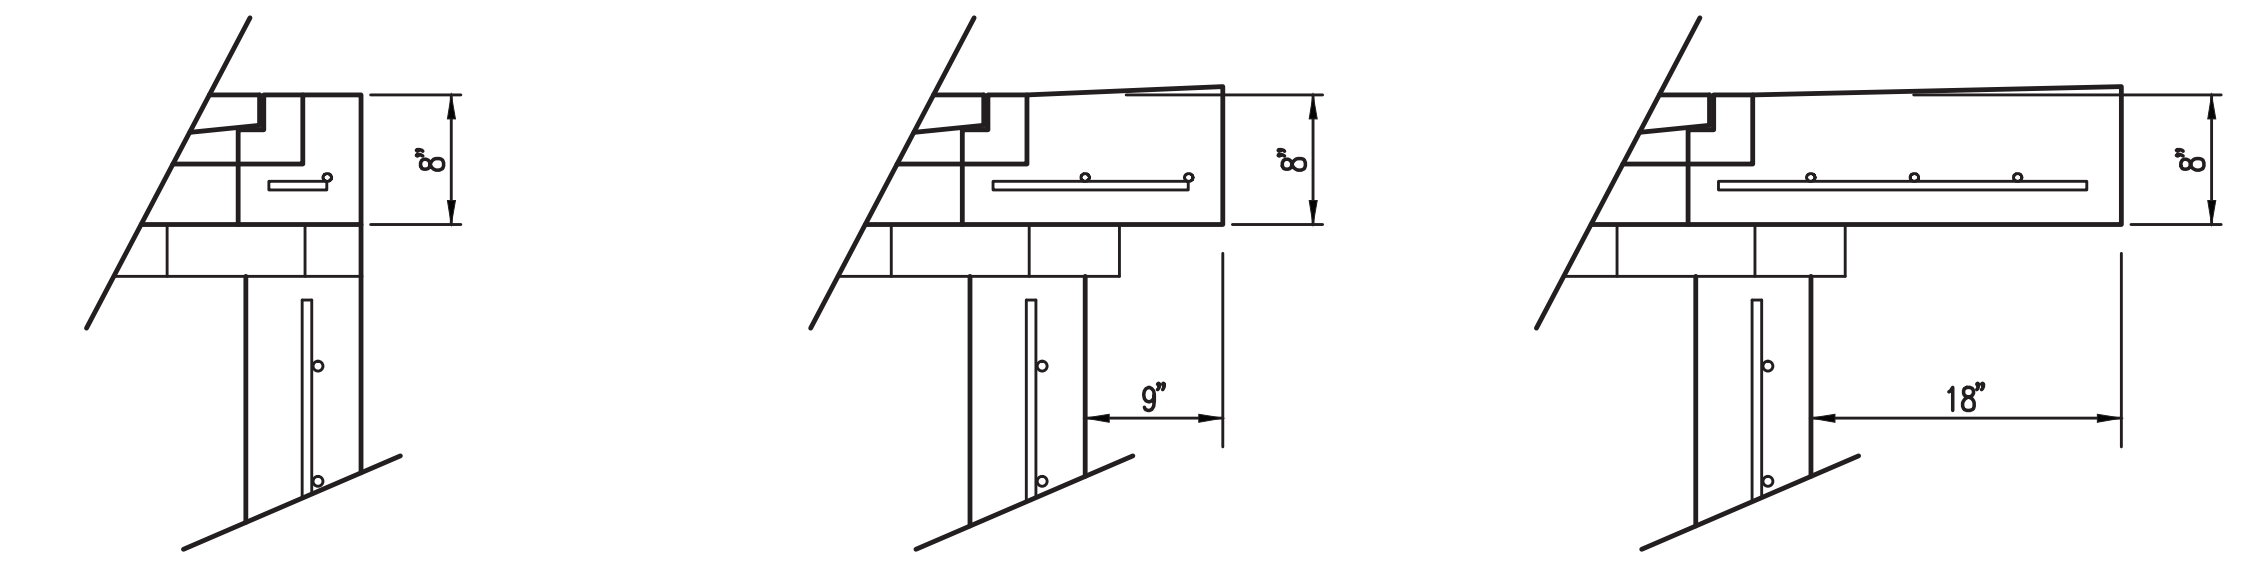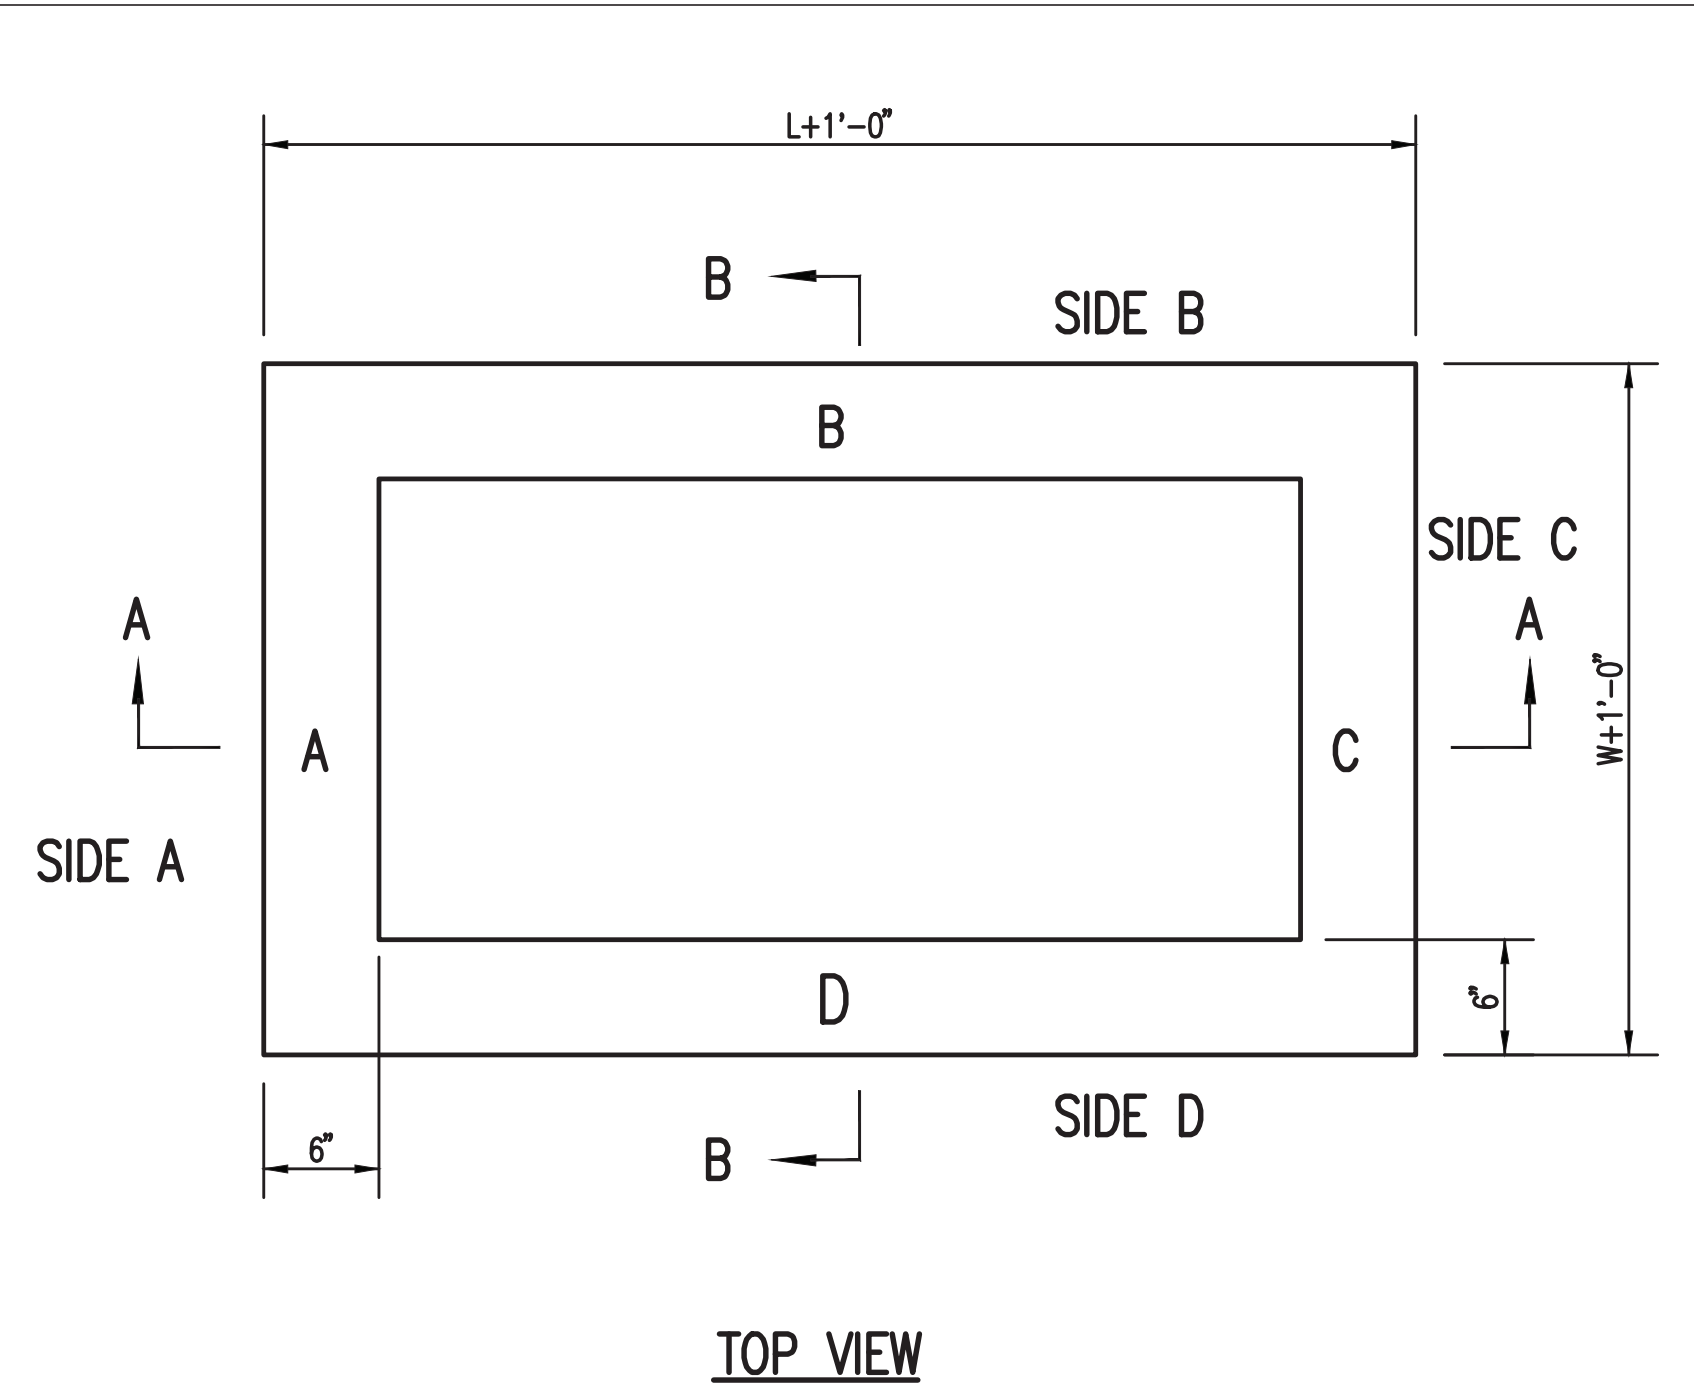


**FLUSH STYLE TOP
NO APRON**
9" APRON
18" APRON

* APRON TO EXTEND ON ALL 4 SIDES OF INLET.
DESIGNER TO DESIGNATE APRON SIZE.


W=2' and L=2' for SINGLE DROP INLET
W=2' and L=4' for DOUBLE DROP INLET

The structure(s) on this detail sheet are designed for HS-20 loading at these specific dimensions only. If larger dimensions are required, the ENGINEER shall provide a project specific structure design for approval by the City Engineer's office.


- GENERAL NOTES**
- GRATE FRAME TO BE INSTALLED ON THIN MORTAR CUSHION TO INSURE FULL SUPPORT ALONG BRICK. CONCRETE USED FOR INLET CONSTRUCTION SHALL CONFORM TO CITY OF WICHITA SPECIFICATIONS FOR CONCRETE PAVEMENT MIX.
 - INLET INVERT SHALL BE SHAPED WITH 8 SACK SAND MIX CONCRETE TO CREATE FLOW CHANNELS AND TO INCREASE HYDRAULIC EFFICIENCY SUCH THAT THE INLET WILL BE SELF CLEANING BETWEEN ALL INLET AND/OR OUTLET PIPES.
 - THE ENDS OF ALL PIPES INSTALLED IN INLETS SHALL BE CUT OFF FLUSH WITH THE INSIDE FACE OF THE INLET WALL.
 - INLET FRAME AND GRATE TO BE DEETER #2433, EIJW #5391-Z1 OR APPROVED EQUAL FOR 2'x2' SINGLE DROP INLET AND DEETER #2434, EIJW #5391 Z3 OR APPROVED EQUAL FOR 2'x4' DOUBLE DROP INLET.
 - CONTRACTOR SHALL REMOVE LIFTING HOOKS AFTER INSTALLATION. RECESSES IN INLET WALL SHALL BE GROUTED FLUSH TO THE INLET WALL WITH HYDRAULIC CEMENT AFTER THE INLET IS IN PLACE. LIFTING HOLES THRU THE INLET WALL WILL NOT BE ACCEPTED.

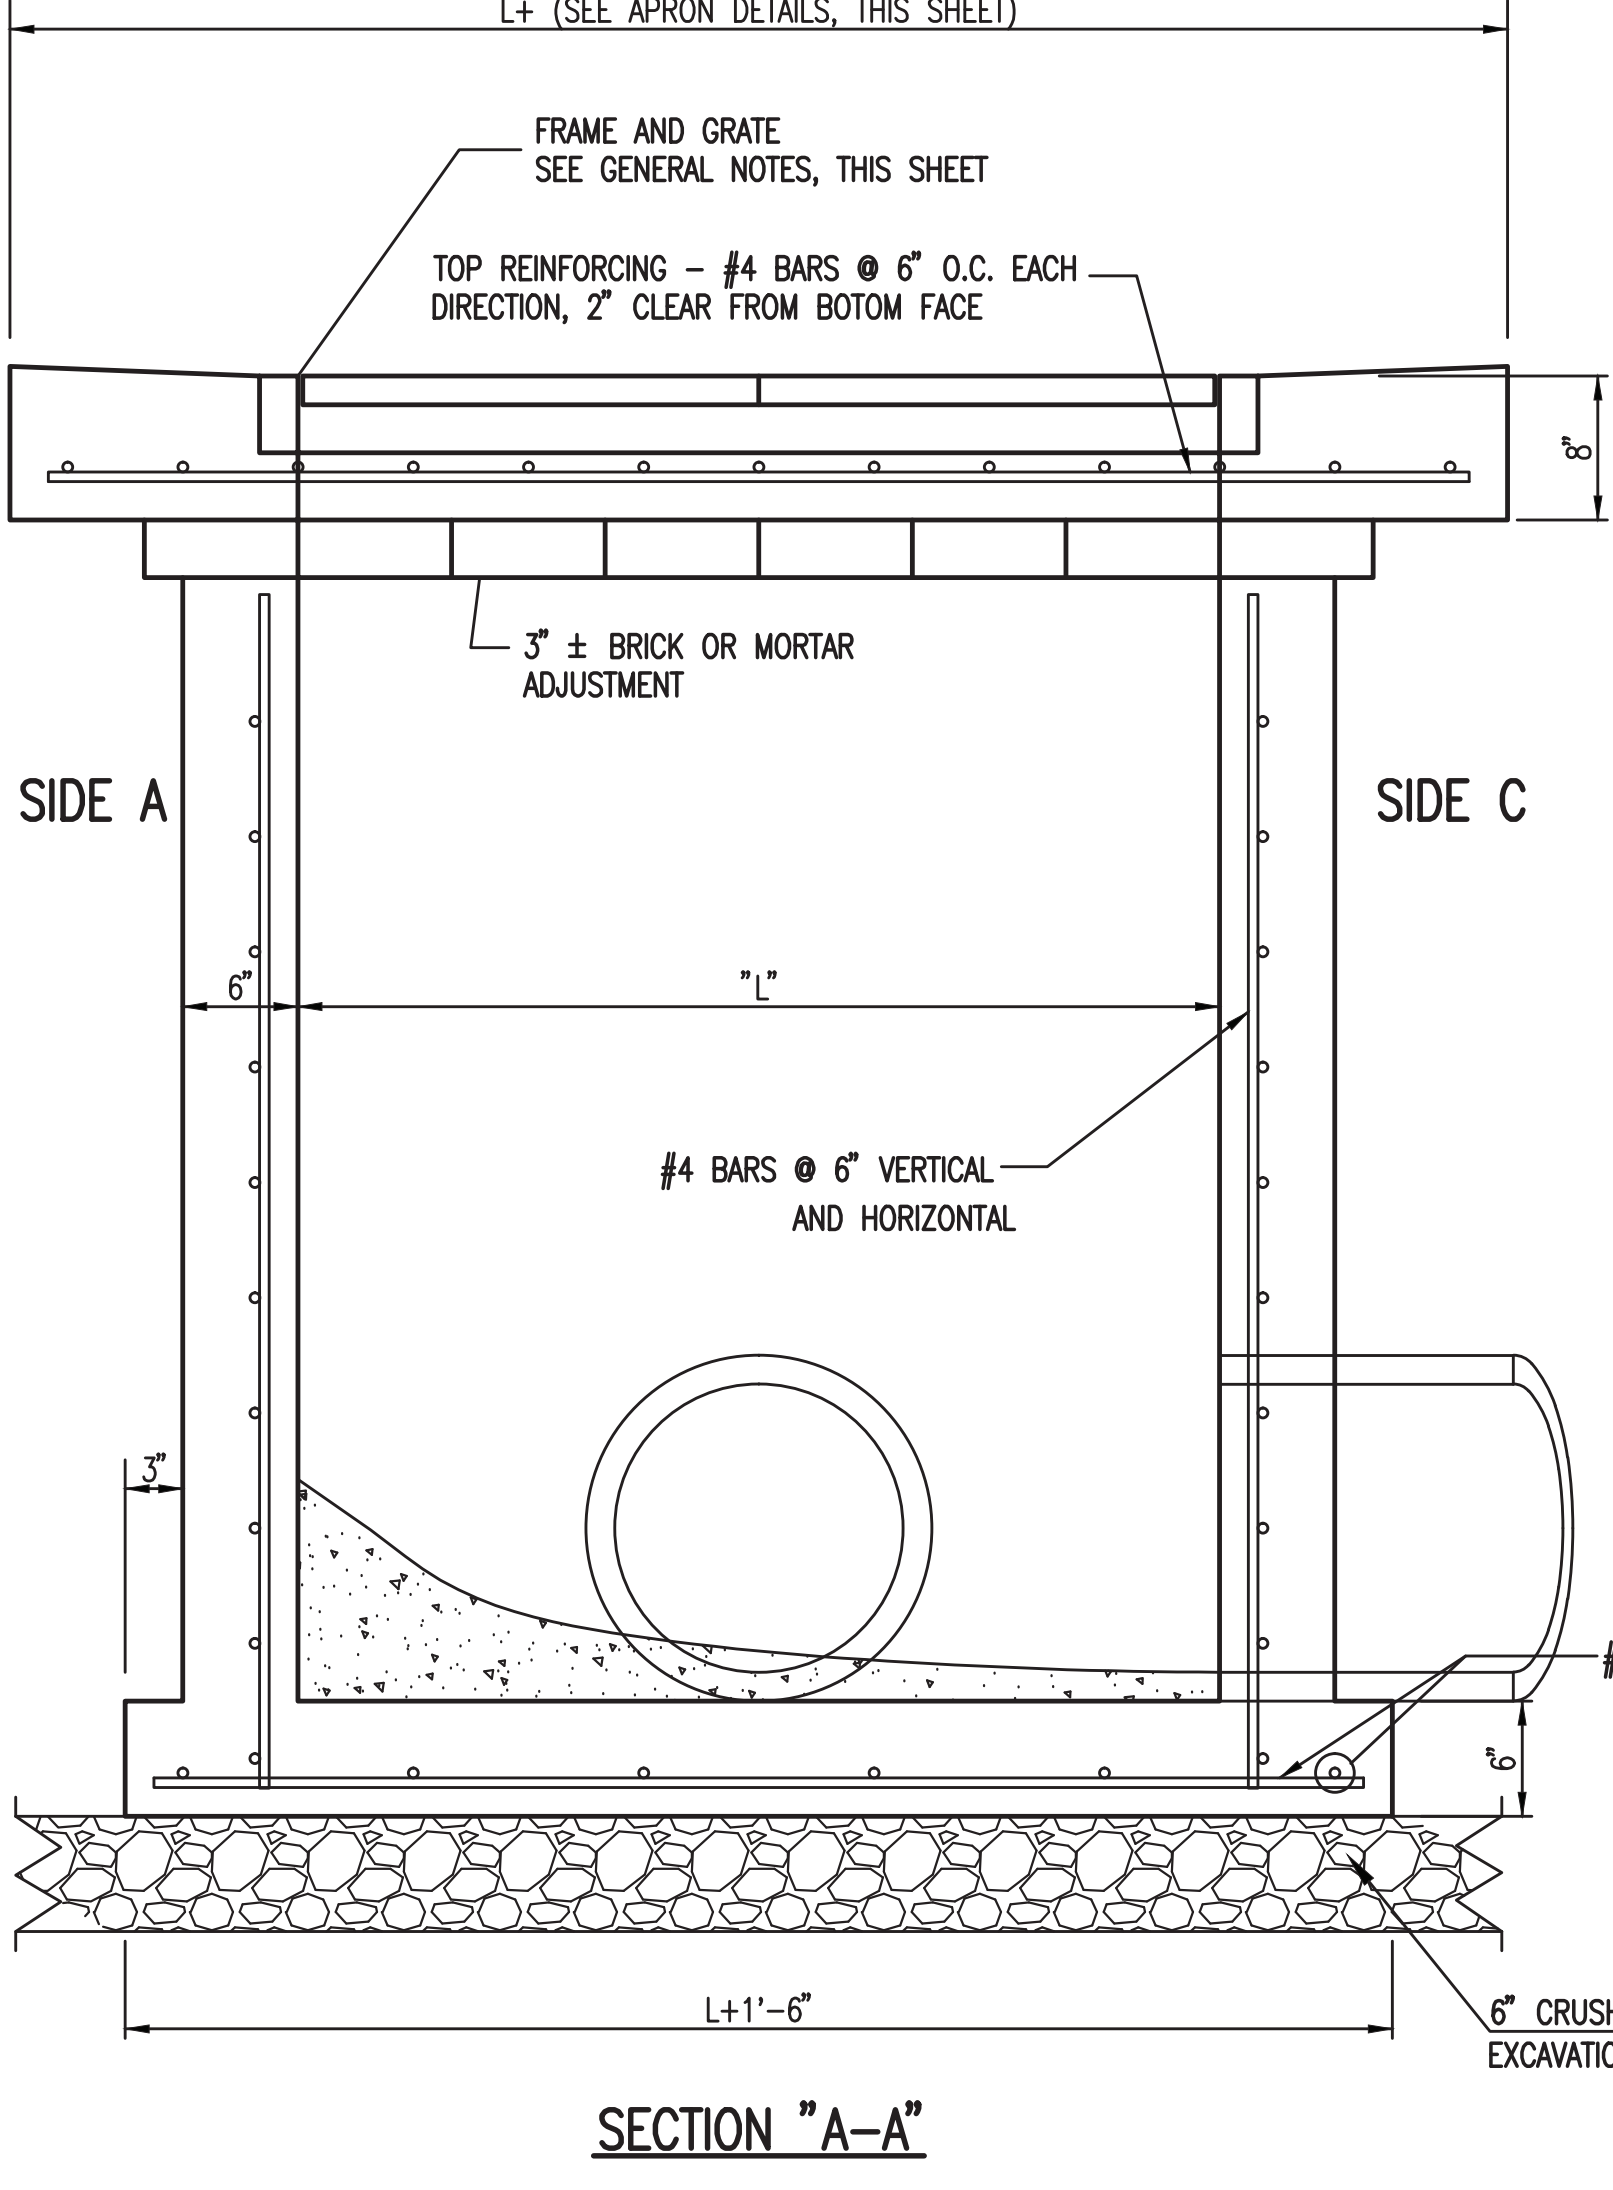

SECTION "A-A"

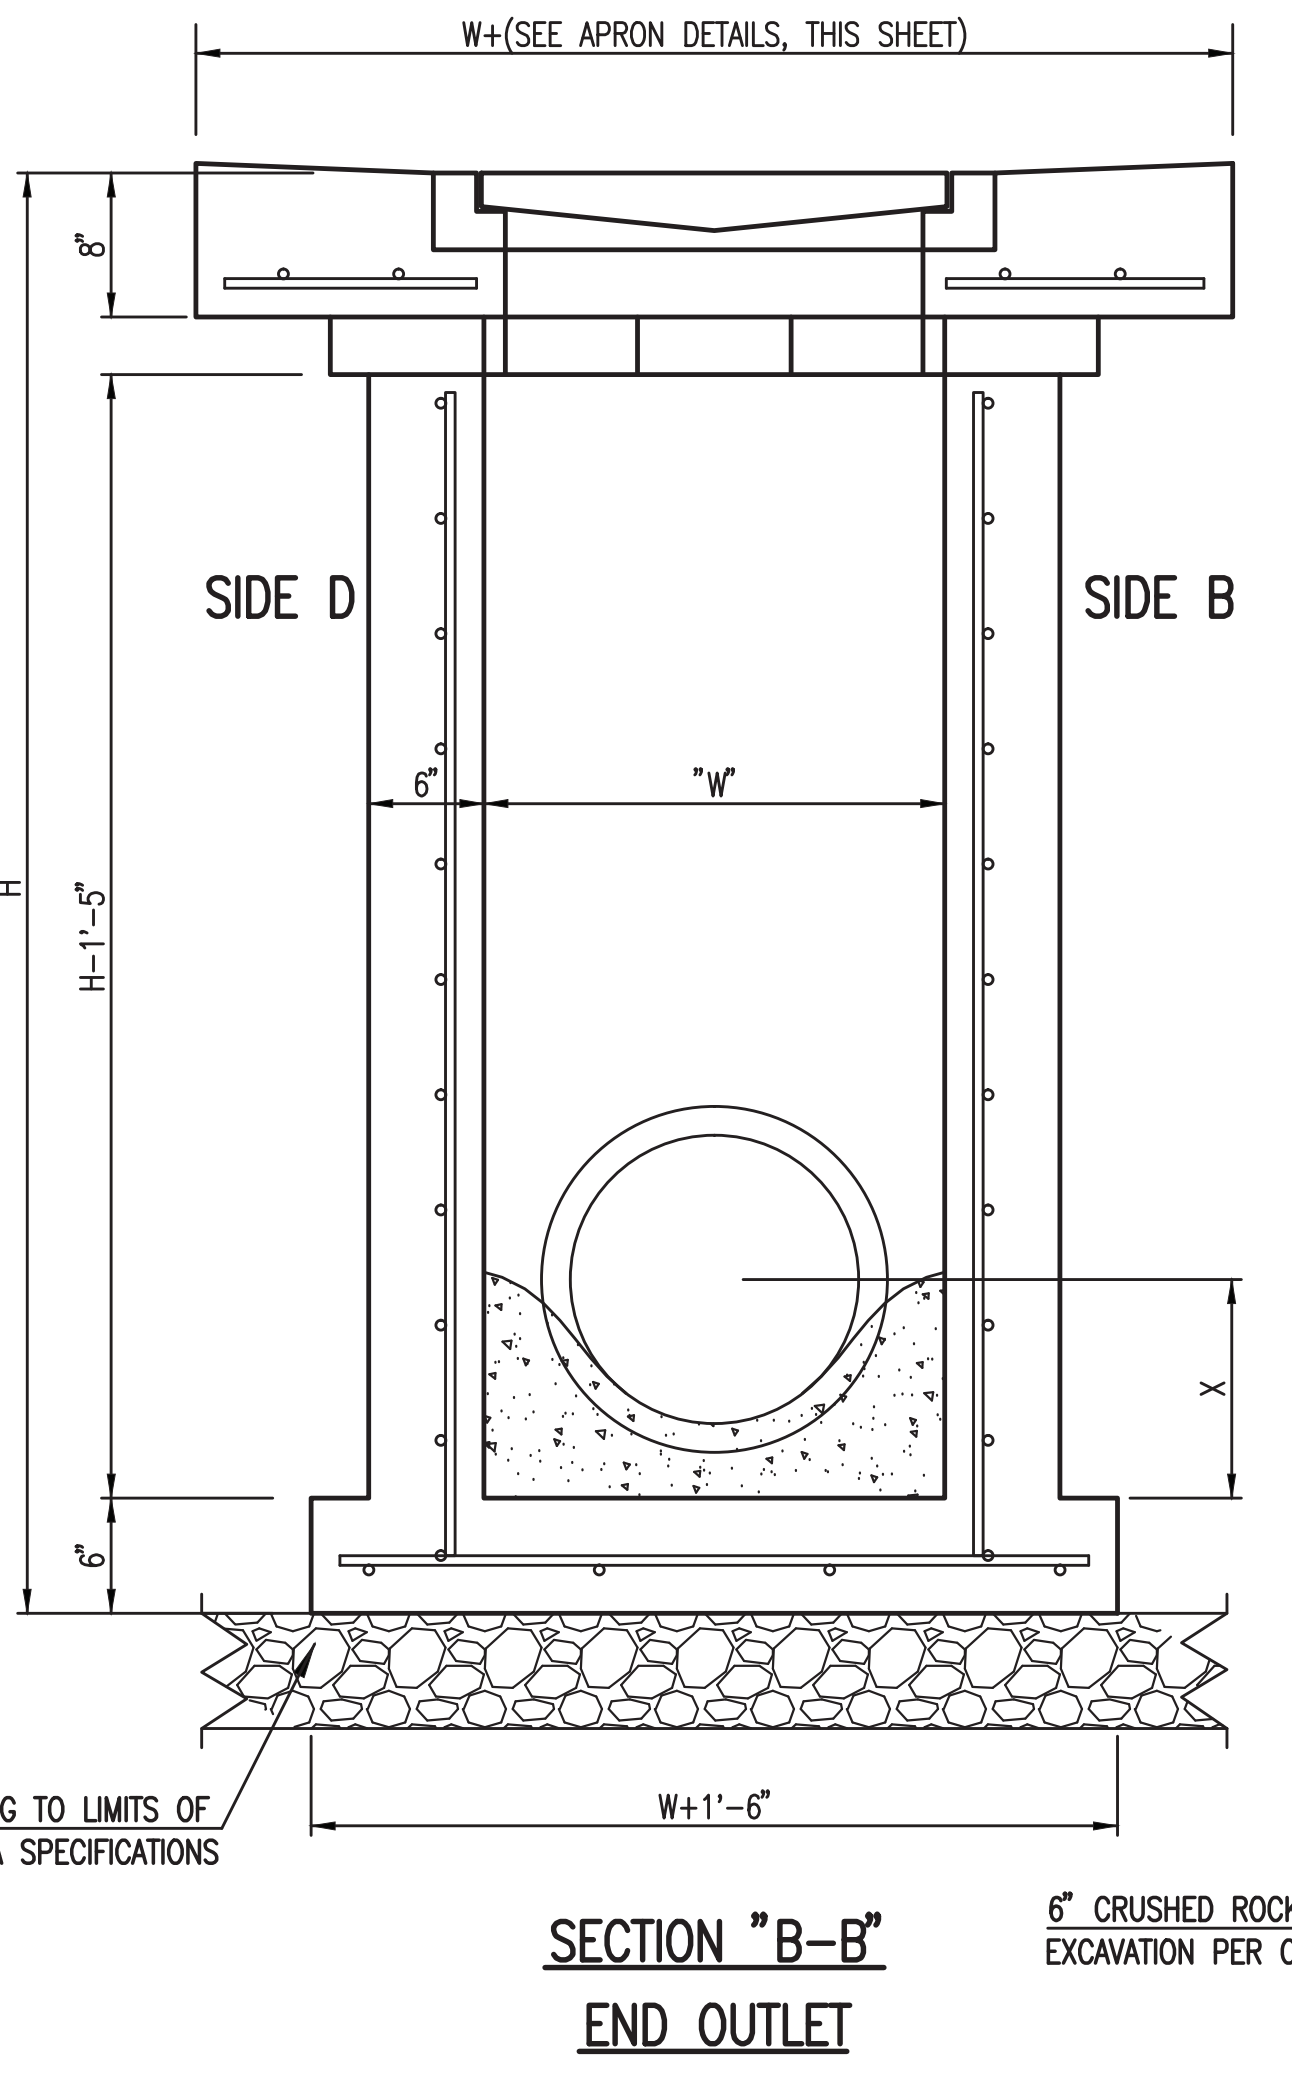

**SECTION "B-B"
END OUTLET**

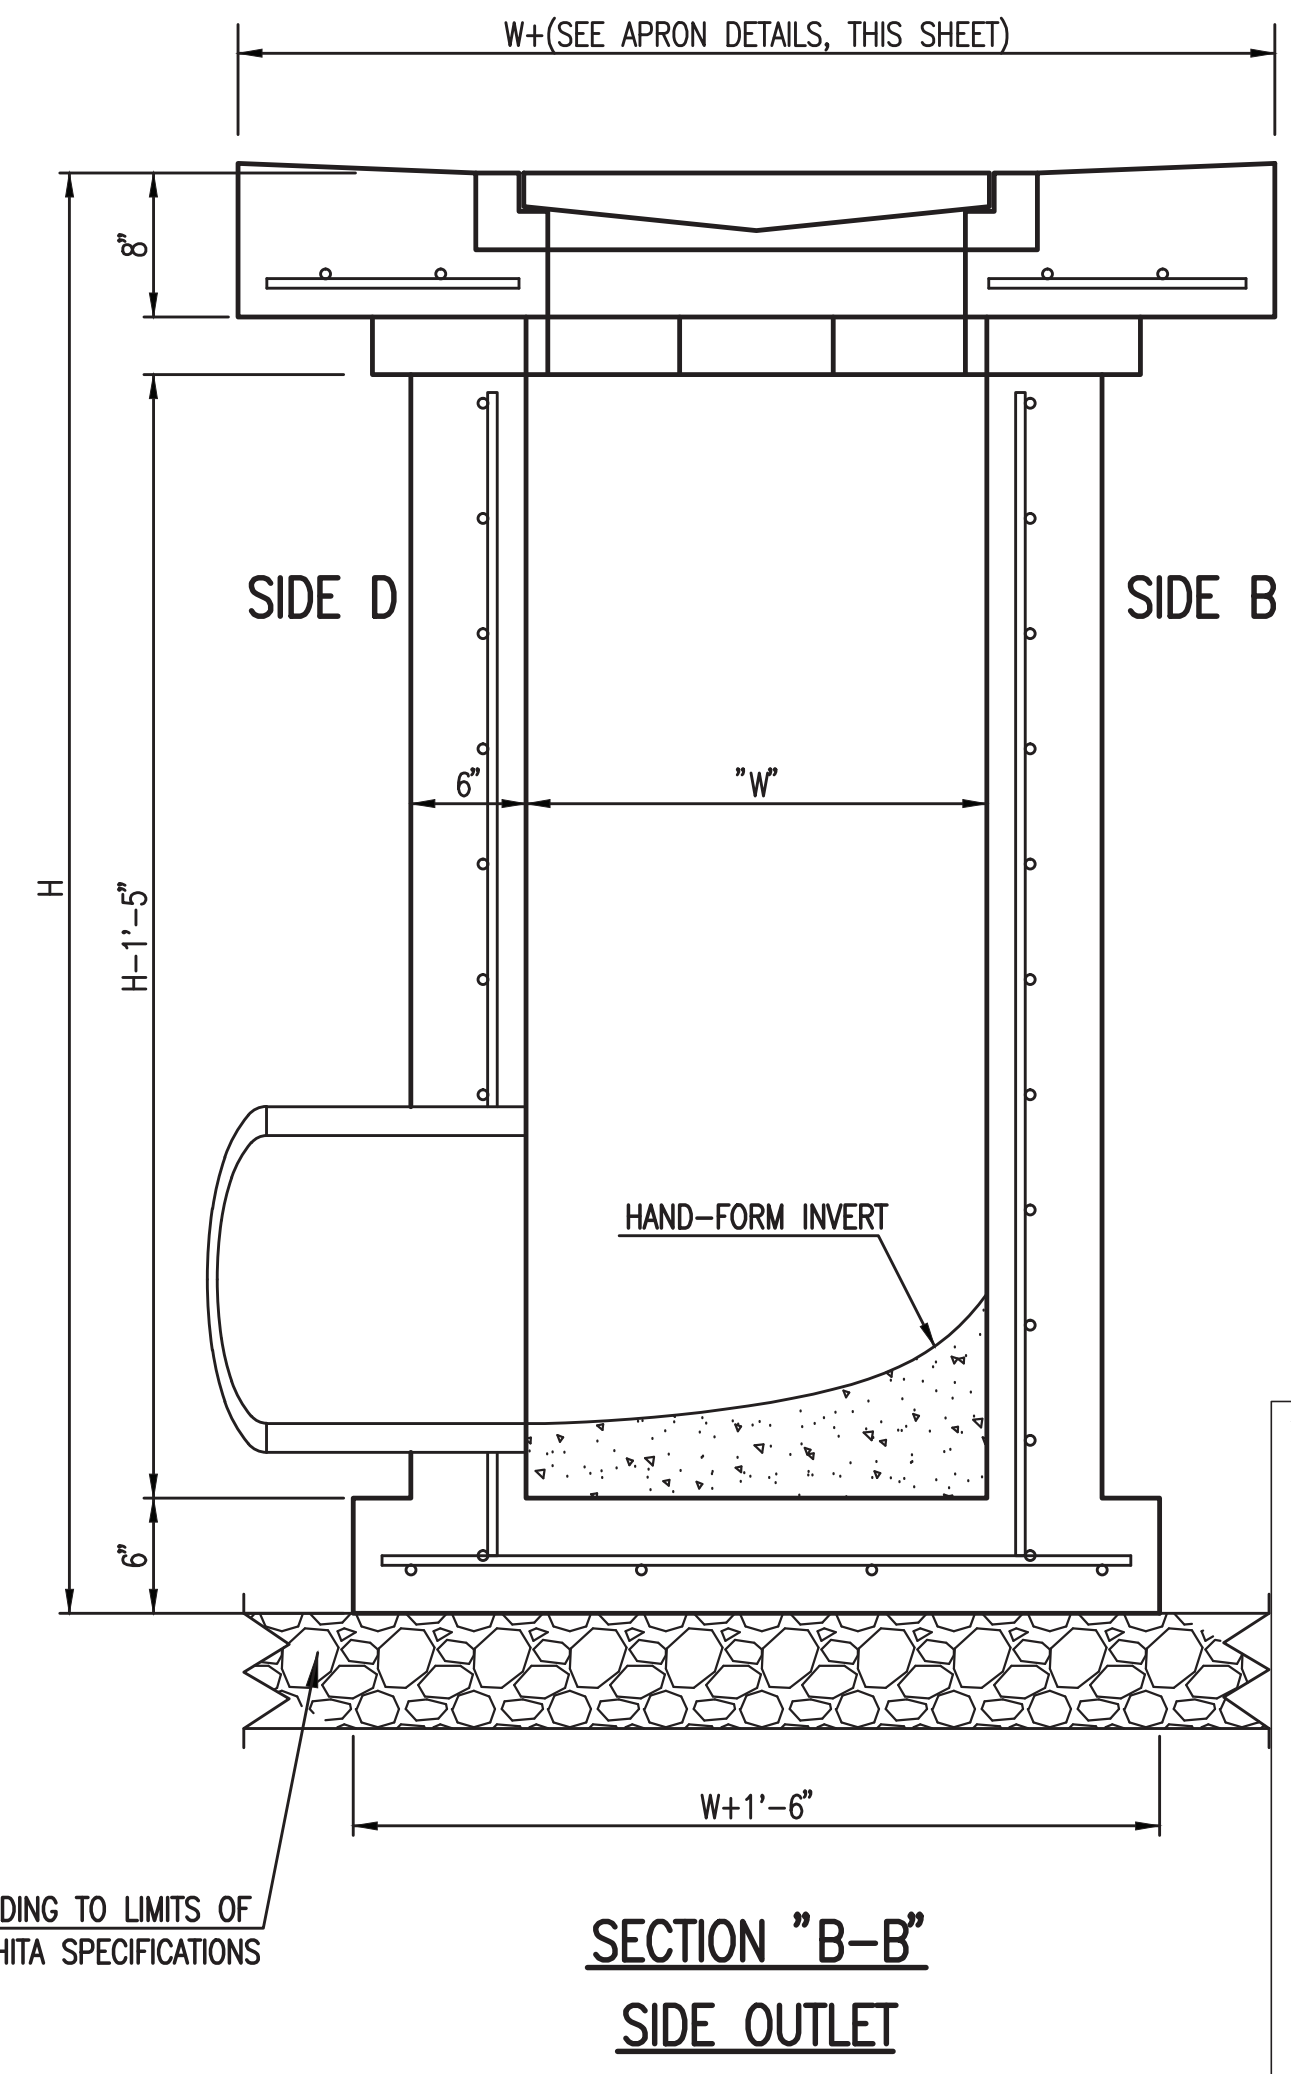

**SECTION "B-B"
SIDE OUTLET**



SINGLE/DOUBLE DROP INLET		
CITY ENGINEER GARY JANZEN, P.E.		
PROJECT NUMBER 0334-PPD	OCA NUMBER (607861)	DATE
CITY ENGINEER'S OFFICE CITY HALL - SEVENTH FLOOR 435 NORTH MAIN STREET WICHITA, KANSAS 67202-1620 (316) 268-4501		SHEET

REVISED: MARCH 2015

SW-201

Saved: 08-10-2015 10:41:26 AM by RBT
 U:\Projects-2015\15120\15120-005-0411-SINGLE-DOUBLE DROP INLET
 U:\Projects-2015\15120\15120-005-0411-SINGLE-DOUBLE DROP INLET



PROFESSIONAL ENGINEERING CONSULTANTS, P.A.
303 SOUTH TOPEKA WICHITA, KS 67202
316-262-2891 www.pecc1.com

DATE	PURPOSE	NO.
05.11.2015	75% OWNER REVIEW	1
05.29.2015	PERMIT SET/BID SET	2
06.12.2015	ADDENDUM 1	1
08.10.2015	ADDENDUM 2	2
08.17.2015	ADDENDUM 3	3
09.15.2015	CCD 1	4
09.30.2015	CCD 2	5
10.19.2015	CCD 3	6

ENTIRE SHEET


**OXFORD VILLA
WICHITA, KS**




Architecture • Engineering • Planning • Interior Design • Landscape Architecture



LKArchitecture, Inc.
 345 Riverview Wichita, KS 67203
 T 316.268.0230 F 316.268.0205
 CONTACT: Isaac Krumme
 DRAWN: Roy Thomas
 CHECKED: Ben Mabry
**PROJECT NUMBER:
14619**
 SHEET TITLE:
 HEADWALL DETAILS
 FOR 15 INCH, 18 INCH
 AND 24 INCH PIPE
**SHEET NUMBER:
C4.12**

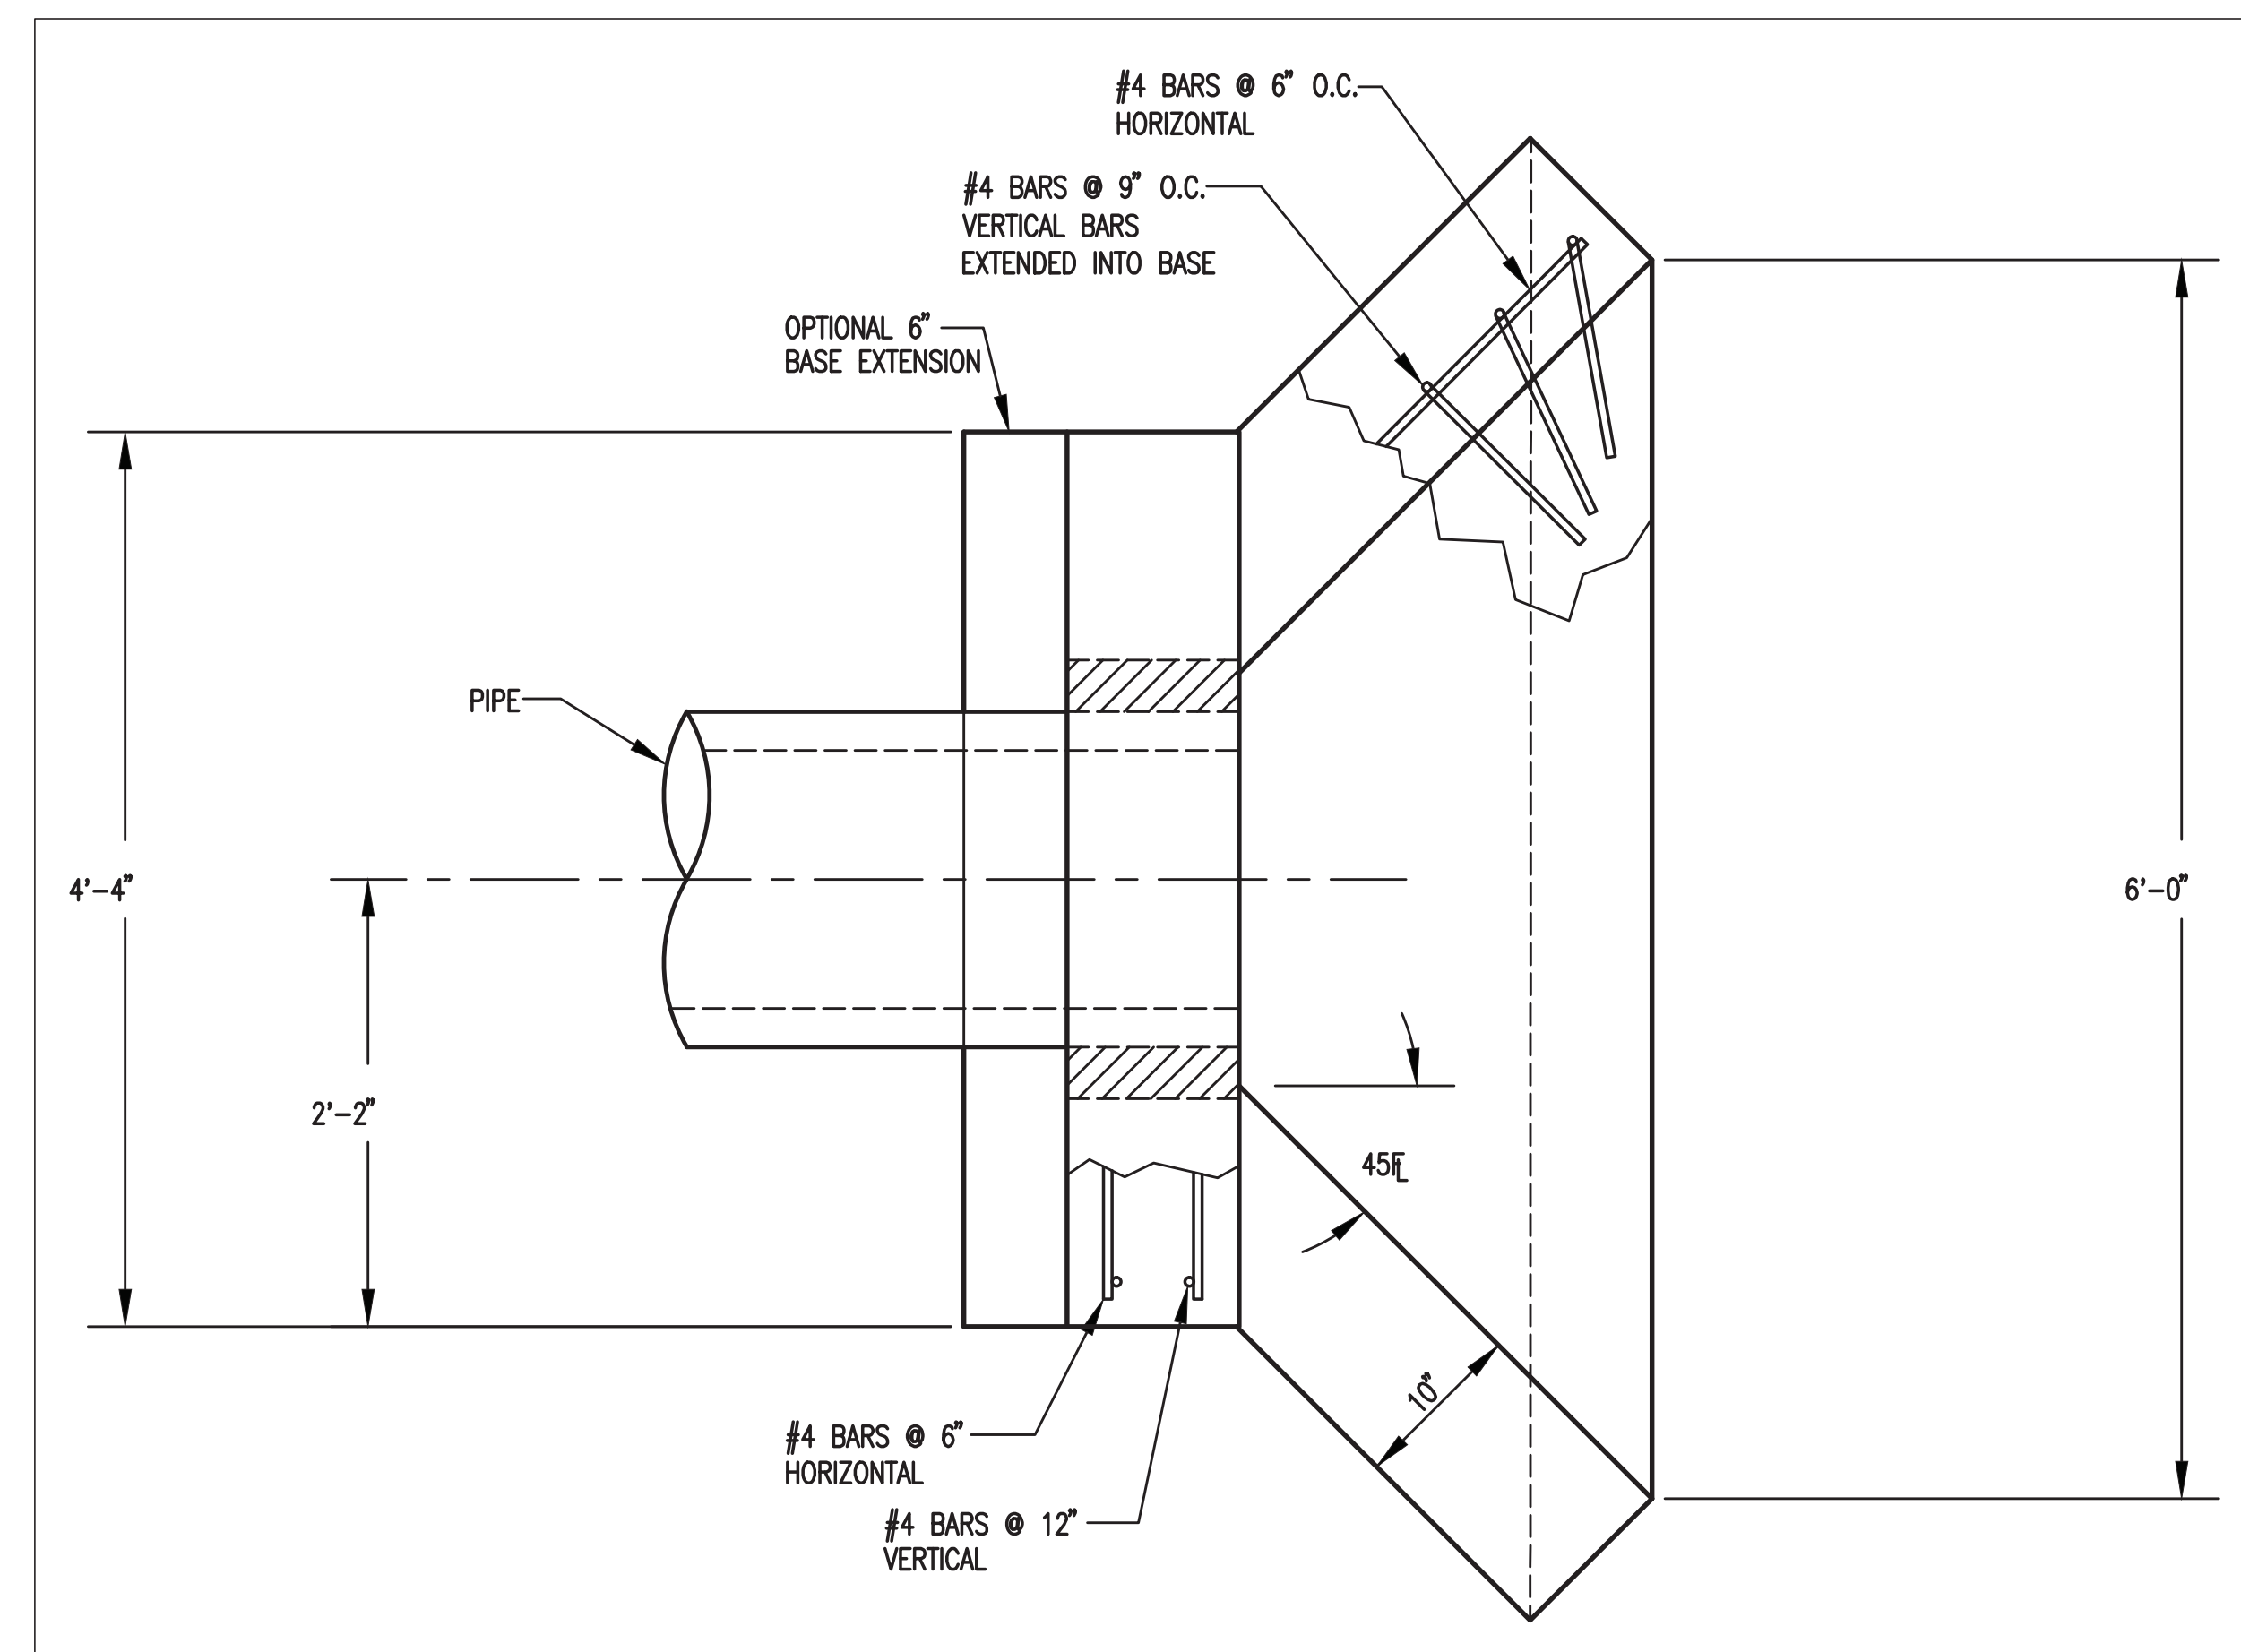


PLAN VIEW

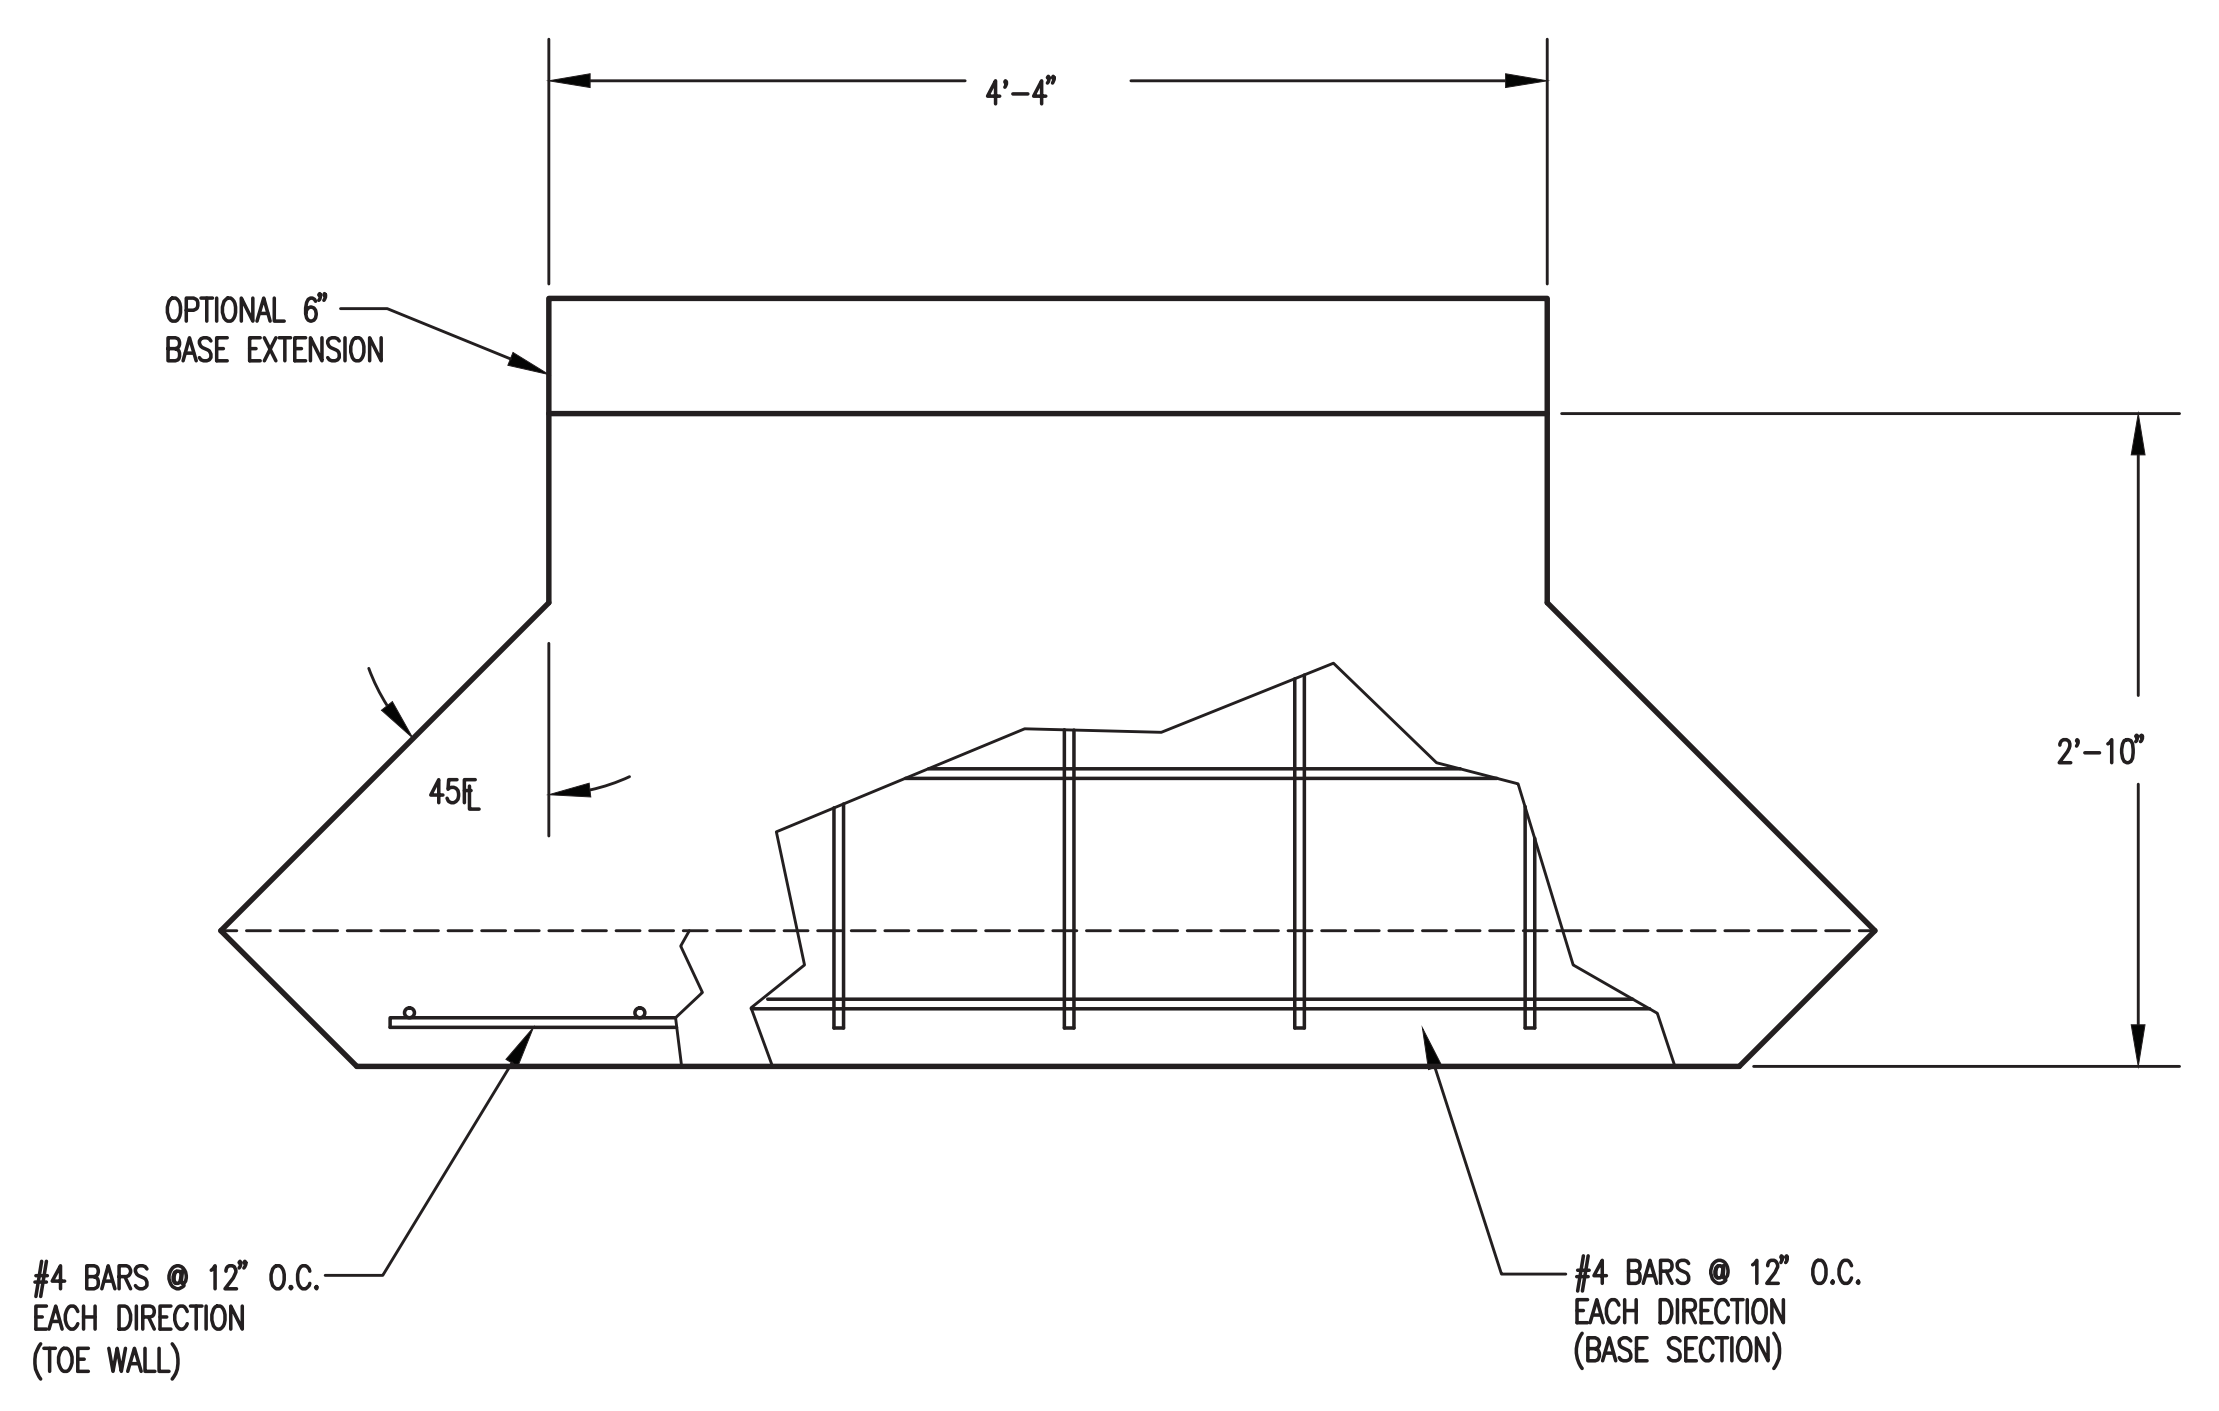


PLAN VIEW
BASE

PIPE ϕ	A	B	BLOCKOUT ϕ
15"	1'-5 1/2"	7 1/2"	2'-1 1/2"
18"	1'-7"	9"	2'-5"
24"	1'-10"	1'-0"	3'-0"

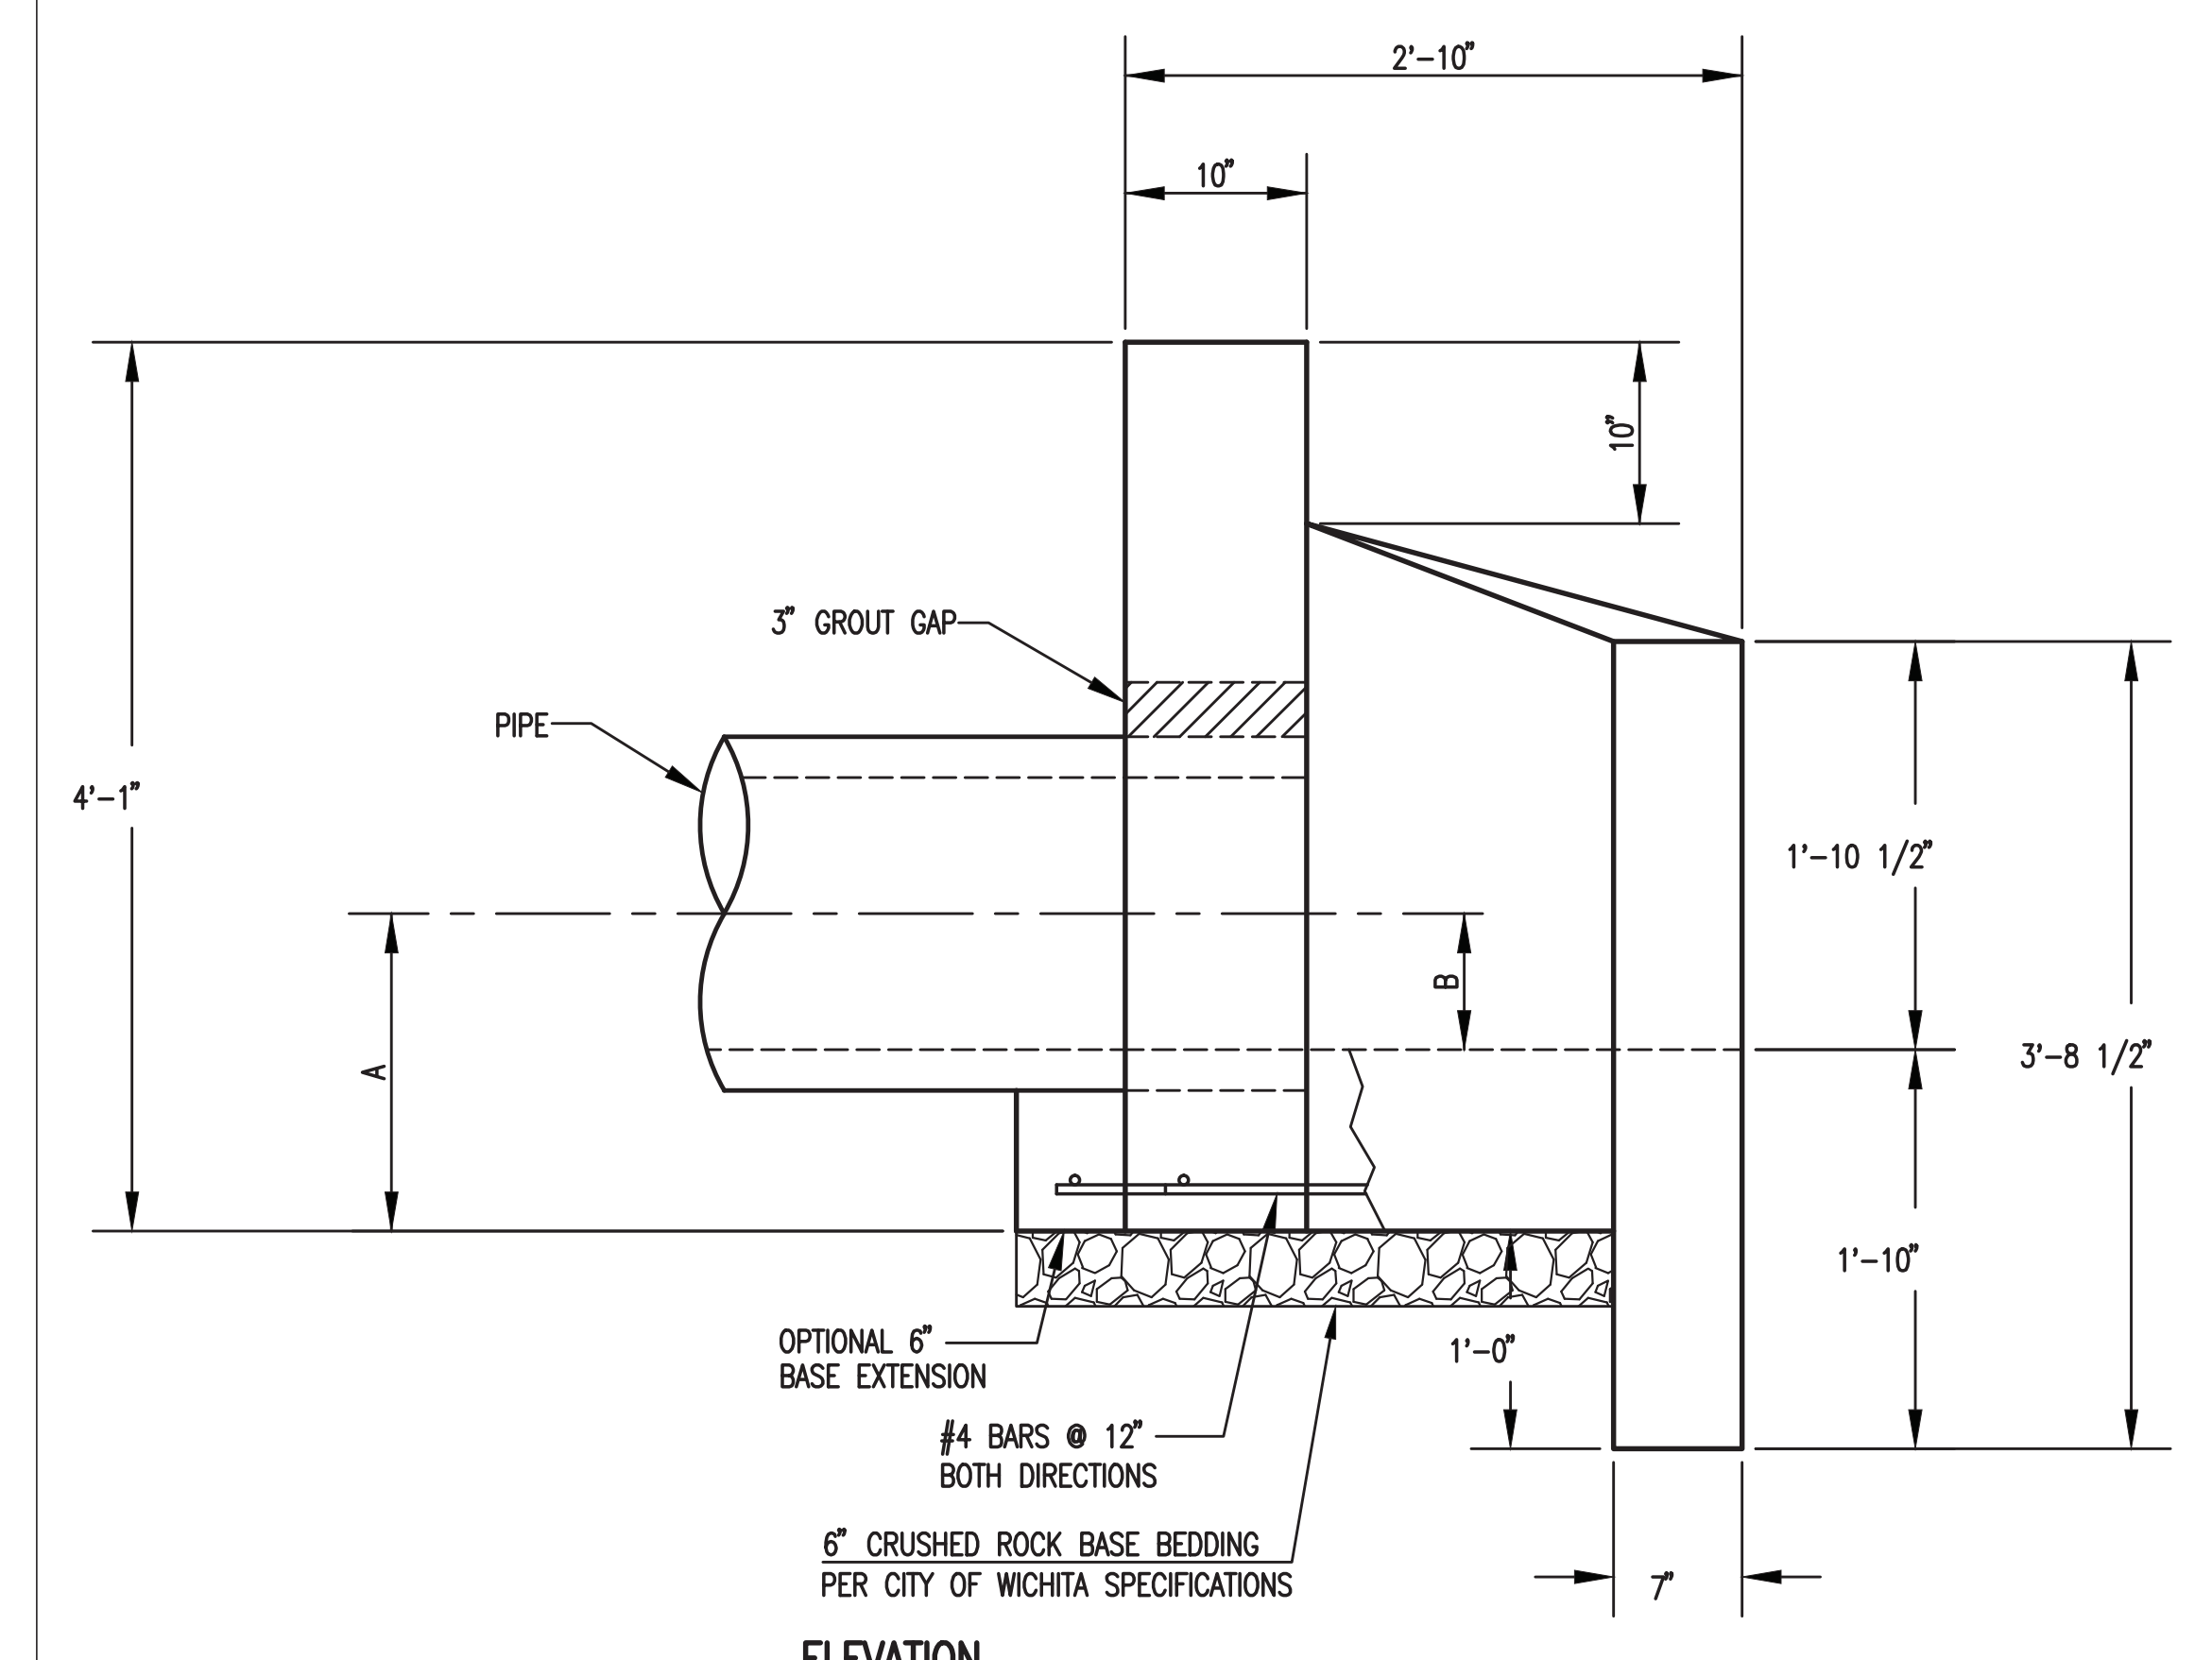

ELEVATION

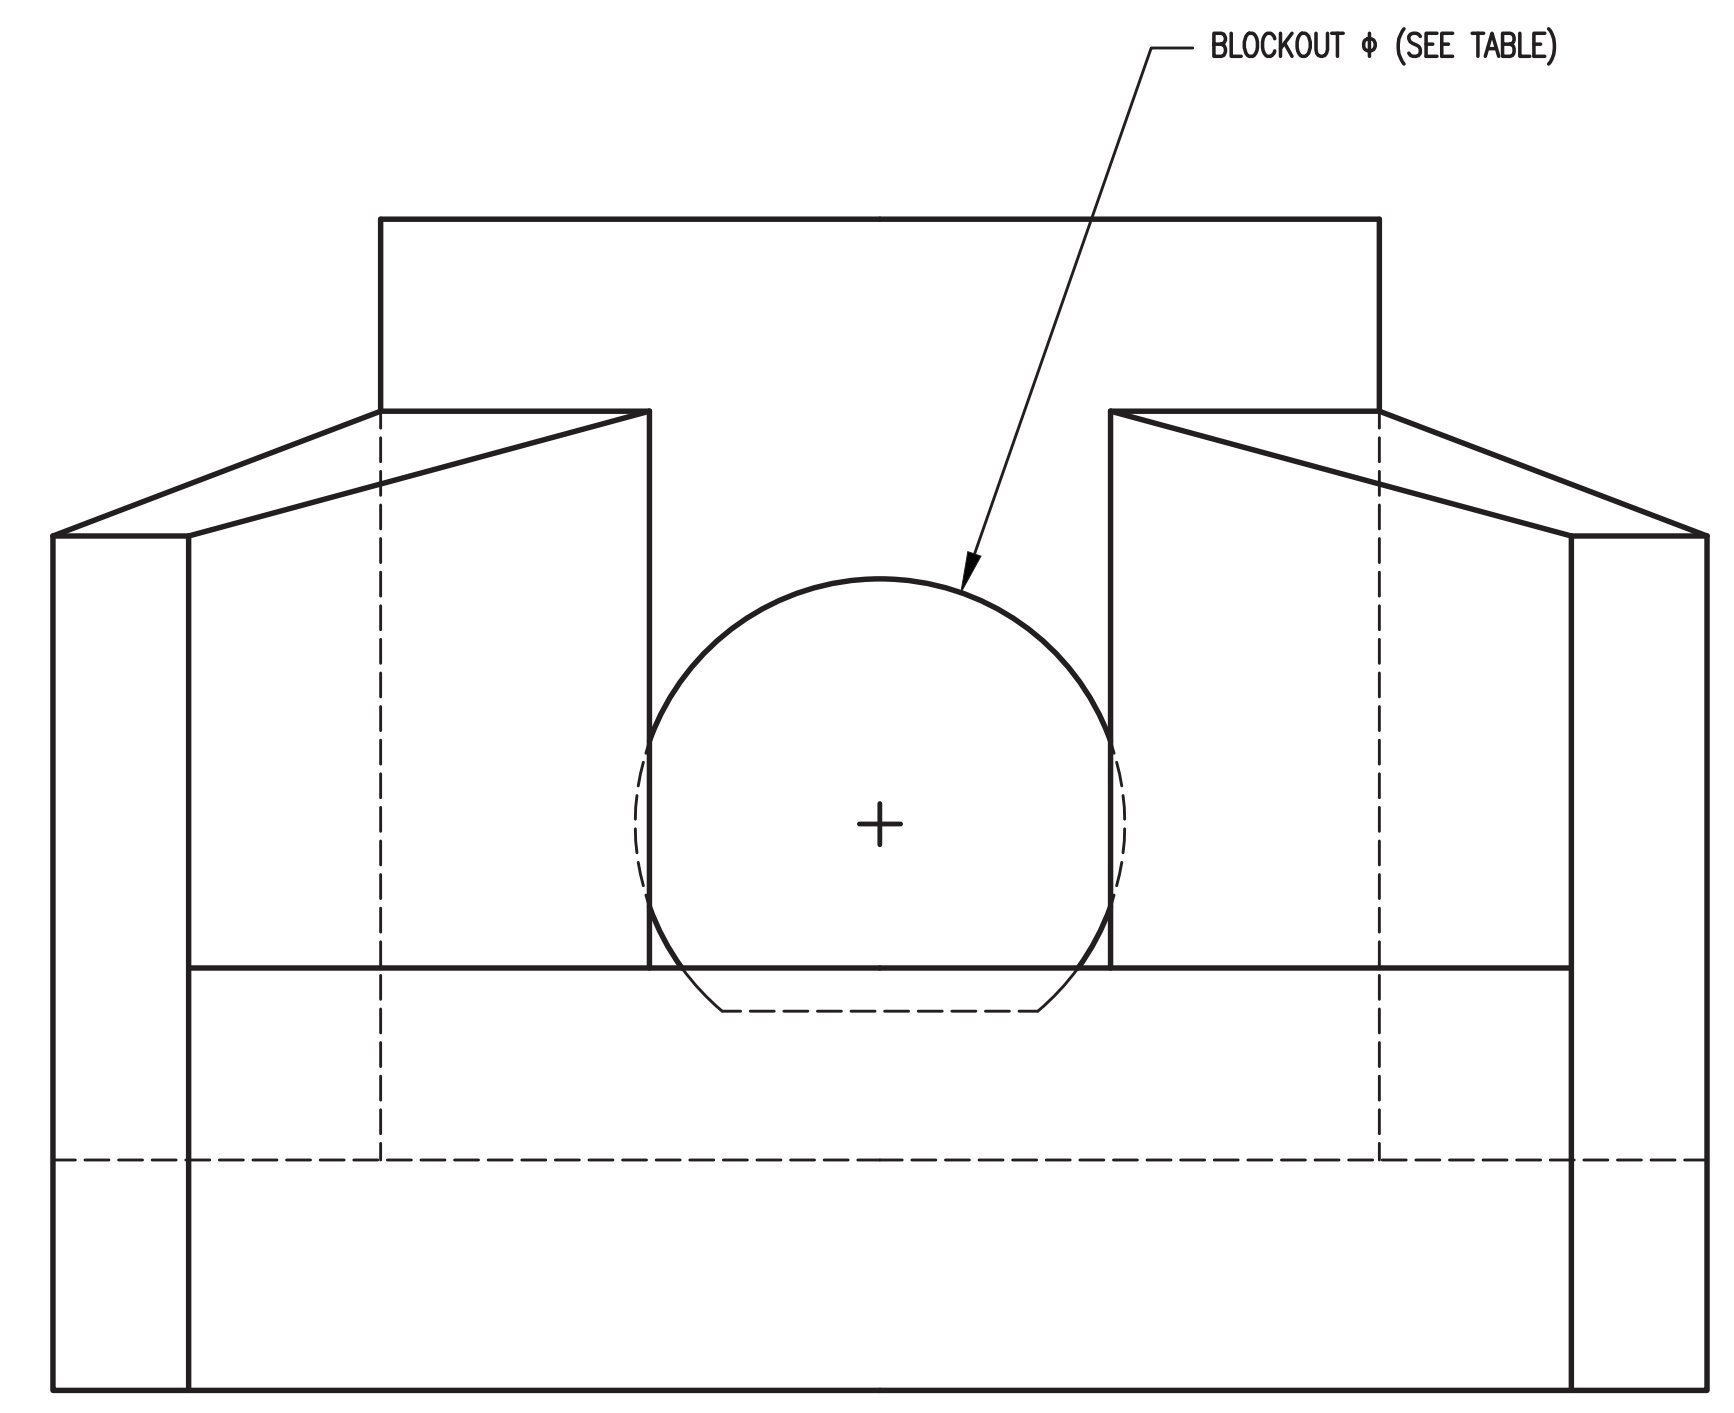

FRONT VIEW

HEADWALLS, AS SHOWN, WILL NOT SUPPORT FLAP GATE.

 CITY OF WICHITA PUBLIC WORKS & UTILITIES ENGINEERING DIVISION	HEADWALL DETAILS FOR 15", 18", AND 24" PIPE		
	CITY ENGINEER GARY JANZEN, P.E.		
	PROJECT NUMBER 0334-PPD	OCA NUMBER (607861)	DATE 11/2010
CITY ENGINEER'S OFFICE CITY HALL - SEVENTH FLOOR 435 NORTH MAIN STREET WICHITA, KANSAS 67202-1620 (316) 268-4501			SHEET

SW-402


Saved: 08-10-2015 10:42:08 AM by REE
 File Name: C:\Users\jgibson\OneDrive\Documents\15120-005-C4.12-HEADWALL DETAIL

DATE	PURPOSE	NO.
05.11.2015	75% OWNER REVIEW	
05.29.2015	PERMIT SET/BID SET	
06.12.2015	ADDENDUM 1	1
08.10.2015	ADDENDUM 2	2
08.17.2015	ADDENDUM 3	3
09.15.2015	CCD 1	4
09.30.2015	CCD 2	5
10.19.2015	CCD 3	6


ENTIRE SHEET

**OXFORD VILLA
WICHITA, KS**

LKArchitecture
Architecture • Engineering • Planning • Interior Design • Landscape Architecture

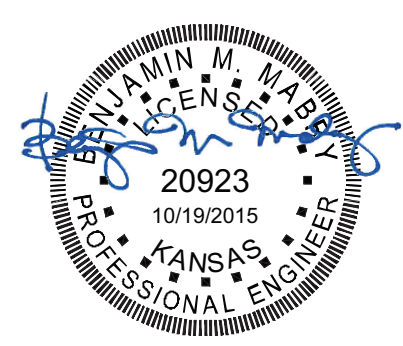


LKArchitecture, Inc.
345 Riverview Wichita, KS 67203
F 316.268.0230
CONTACT: Isaac Krumme
DRAWN: Roy Thomas
CHECKED: Ben Mabry
**PROJECT NUMBER:
14619**
SHEET TITLE:
MISCELLANEOUS
DETAILS
SHEET NUMBER:
C4.13

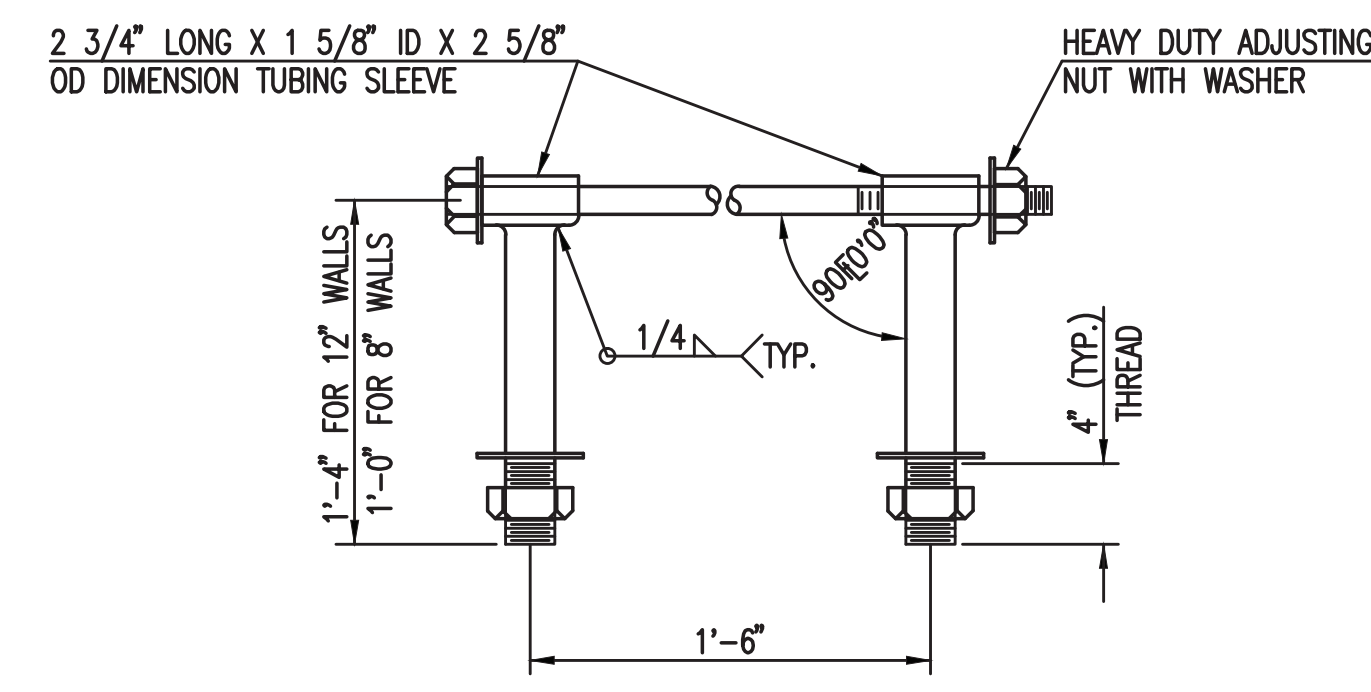

HEAVY DUTY (H.D.) COUPLER
NO SCALE


- NOTES
- BOLTS TO BE A-36 1 1/2" DIAMETER.
 - BOLTS, NUTS, WASHERS AND SLEEVES TO BE ZINC PLATED.
 - WASHERS TO BE 3 1/2" O.D. X 7 GAUGE.
 - SHIP WITH NUTS AND WASHERS PLACED ON BOLTS.

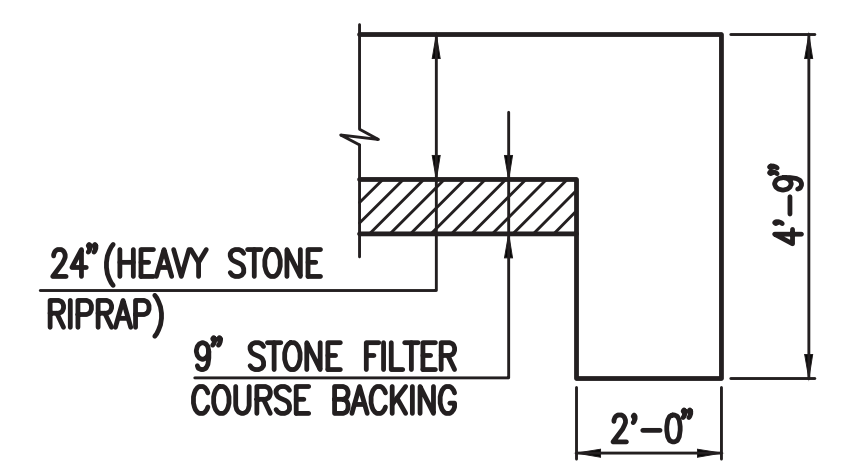

TYPICAL SECTION THRU TOEWALL
NO SCALE

- NOTES
- ALL RIPRAP FOR THIS PROJECT SHALL BE NATURAL STONE. NEITHER BROKEN CONCRETE, FABRIC ENVELOPE, NOR PREMIXED DRY PACKAGED CONCRETE BAG ALTERNATES WILL BE ALLOWED, UNLESS INDICATED OTHERWISE.
 - TOEWALLS SHALL BE INSTALLED ALONG ALL UNPROTECTED EDGES OF STONE RIPRAP.
 - GROUTING OF THE SURFACE OF THE RIPRAP SHALL NOT BE PERFORMED, UNLESS INDICATED OTHERWISE. GROUTING OF THE TOEWALLS SHALL BE PERFORMED PER CITY SPECIFICATIONS.


HEAVY STONE RIPRAP DETAILS

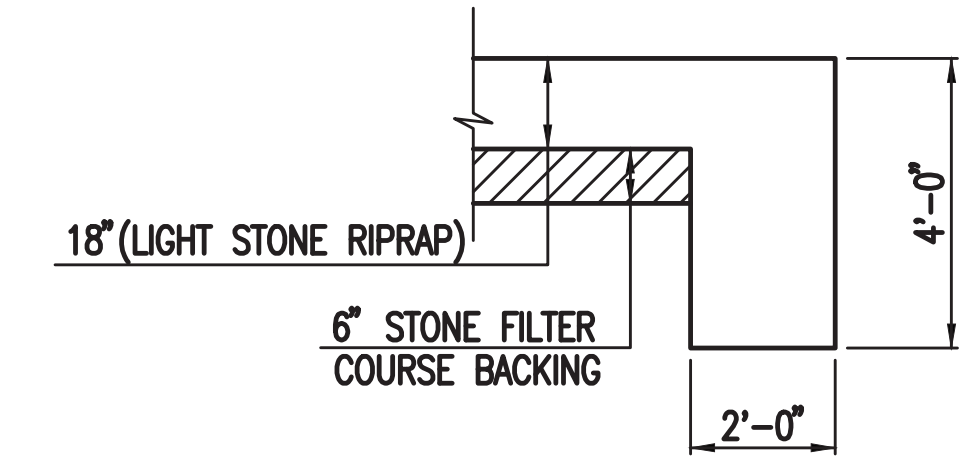


TYPICAL SECTION THRU TOEWALL
NO SCALE

- NOTES
- ALL RIPRAP FOR THIS PROJECT SHALL BE NATURAL STONE. NEITHER BROKEN CONCRETE, FABRIC ENVELOPE, NOR PREMIXED DRY PACKAGED CONCRETE BAG ALTERNATES WILL BE ALLOWED, UNLESS INDICATED OTHERWISE.
 - TOEWALLS SHALL BE INSTALLED ALONG ALL UNPROTECTED EDGES OF STONE RIPRAP.
 - GROUTING OF THE SURFACE OF THE RIPRAP SHALL NOT BE PERFORMED, UNLESS INDICATED OTHERWISE. GROUTING OF THE TOEWALLS SHALL BE PERFORMED PER CITY SPECIFICATIONS.

LIGHT STONE RIPRAP DETAILS

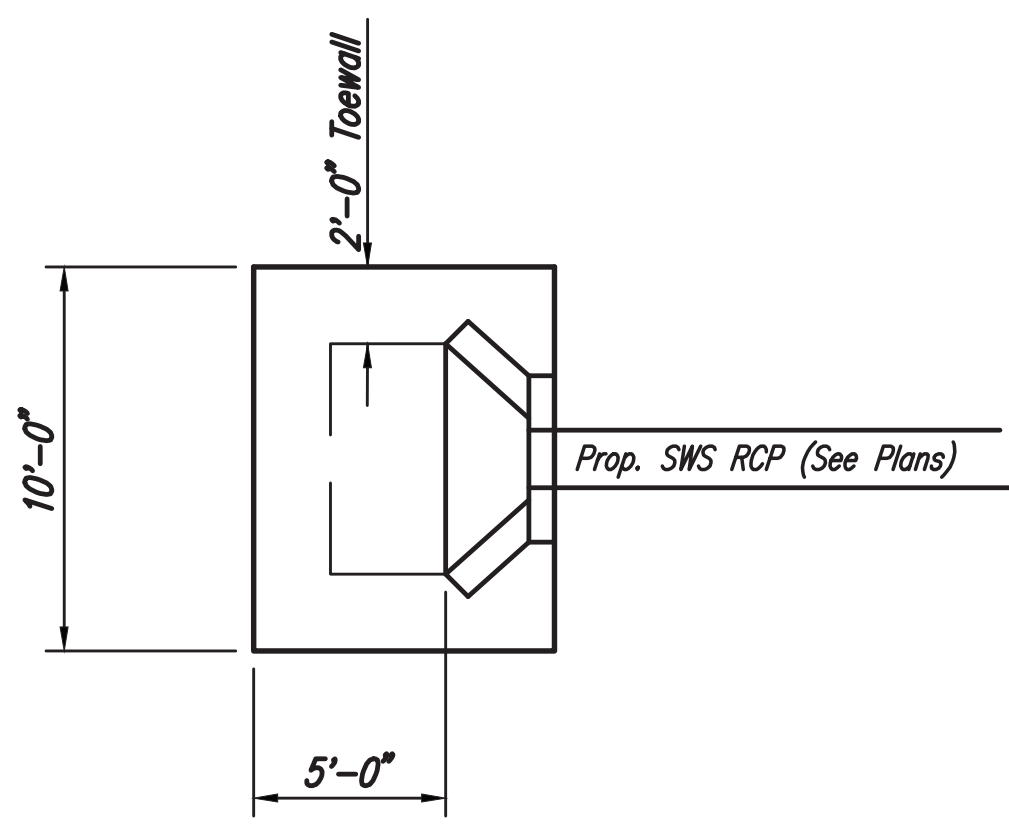

RIPRAP PLAN




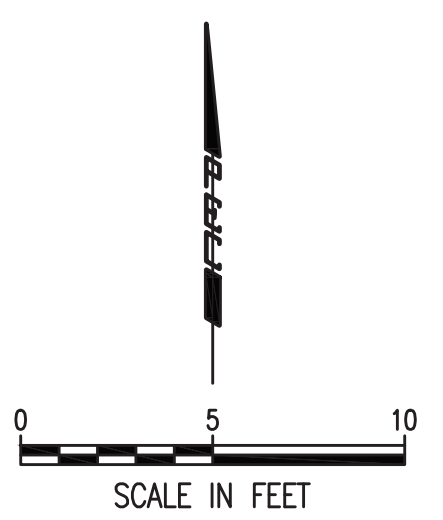


Sheet 06-10-2015 10:42:57 AM by RFT
 Plot Scale: 1" = 10'-0" (2015 2:36:46 PM by GARY JANZEN)
 U:\Wichita-Civil\2015\15120\000\Wm\Drawings\15120-005-C4.13-MISCELLANEOUS DETAILS

Saved: 08-10-2015 10:42:57 AM by RFT
 U:\Wichita-Civil\2015\15120\000\Wm\Drawings\15120-005-C4.13-MISCELLANEOUS DETAILS

PC 227-3

NEWMARKET OFFICE 2ND AN ADDITION TO WICHITA, SEDGWICK COUNTY, KANSAS

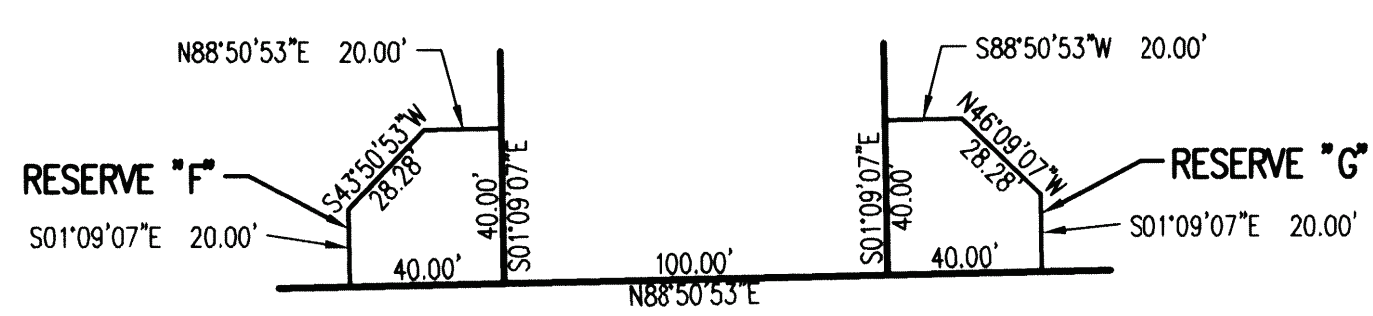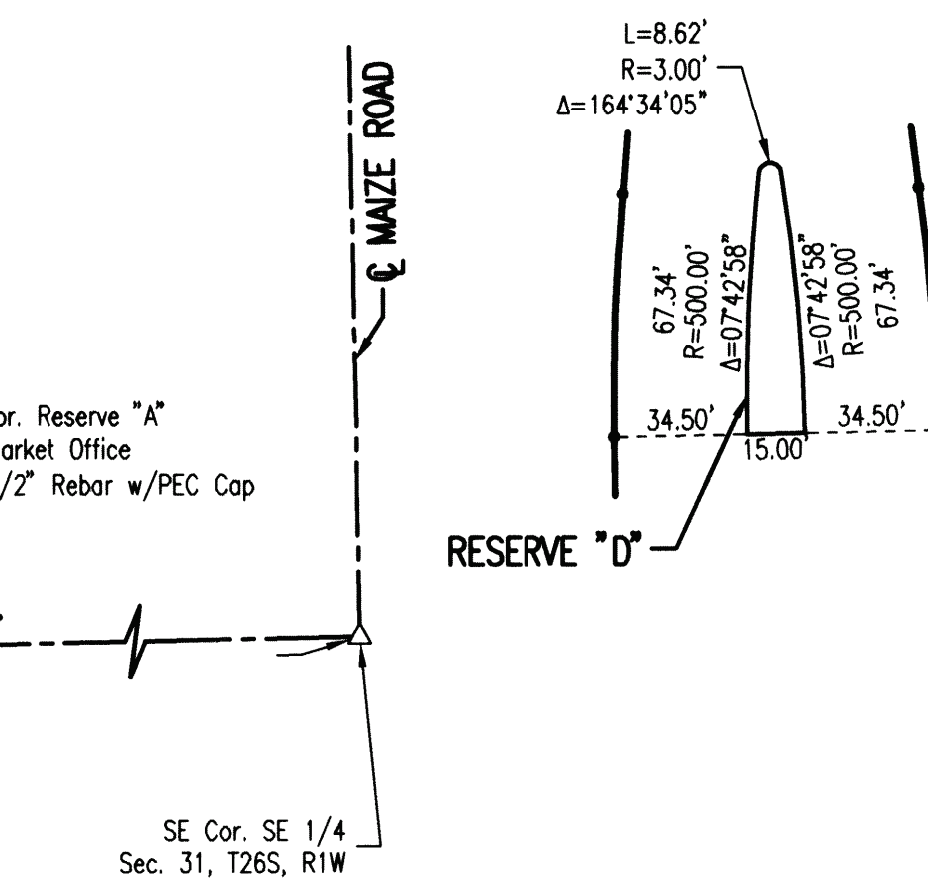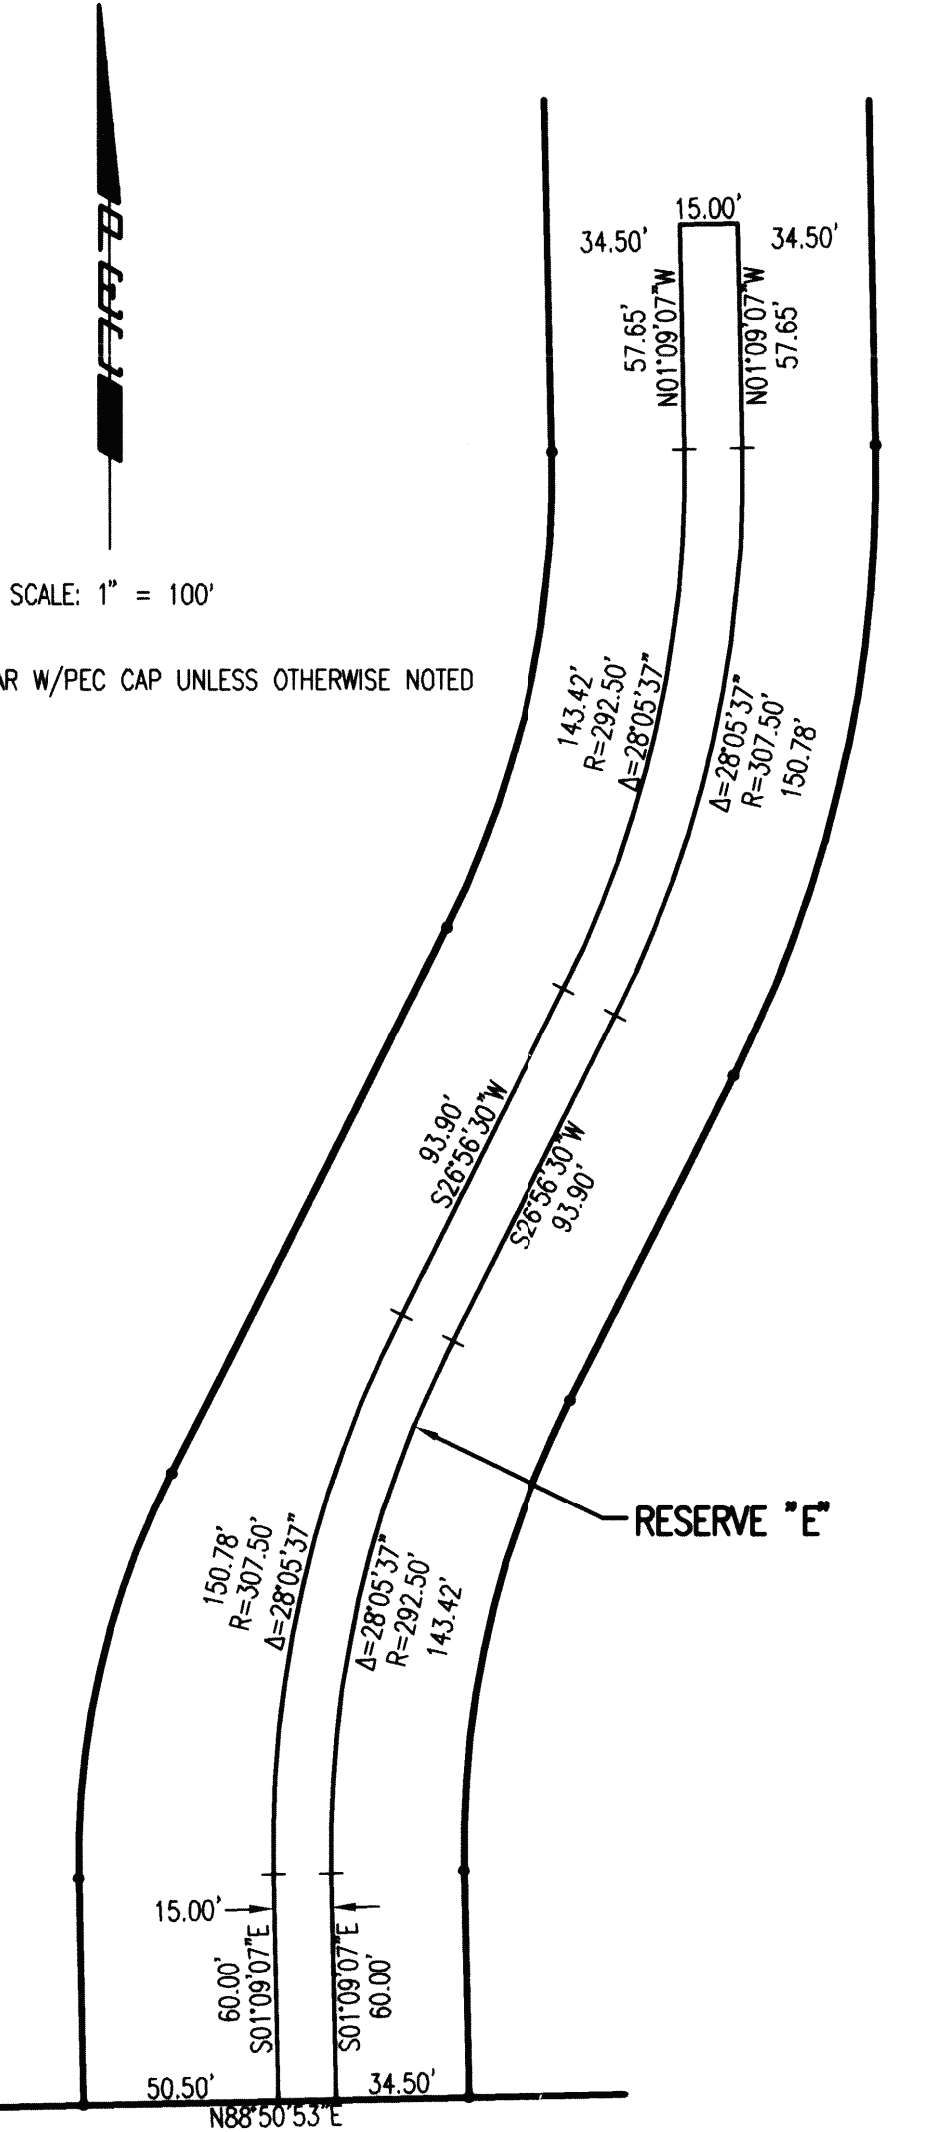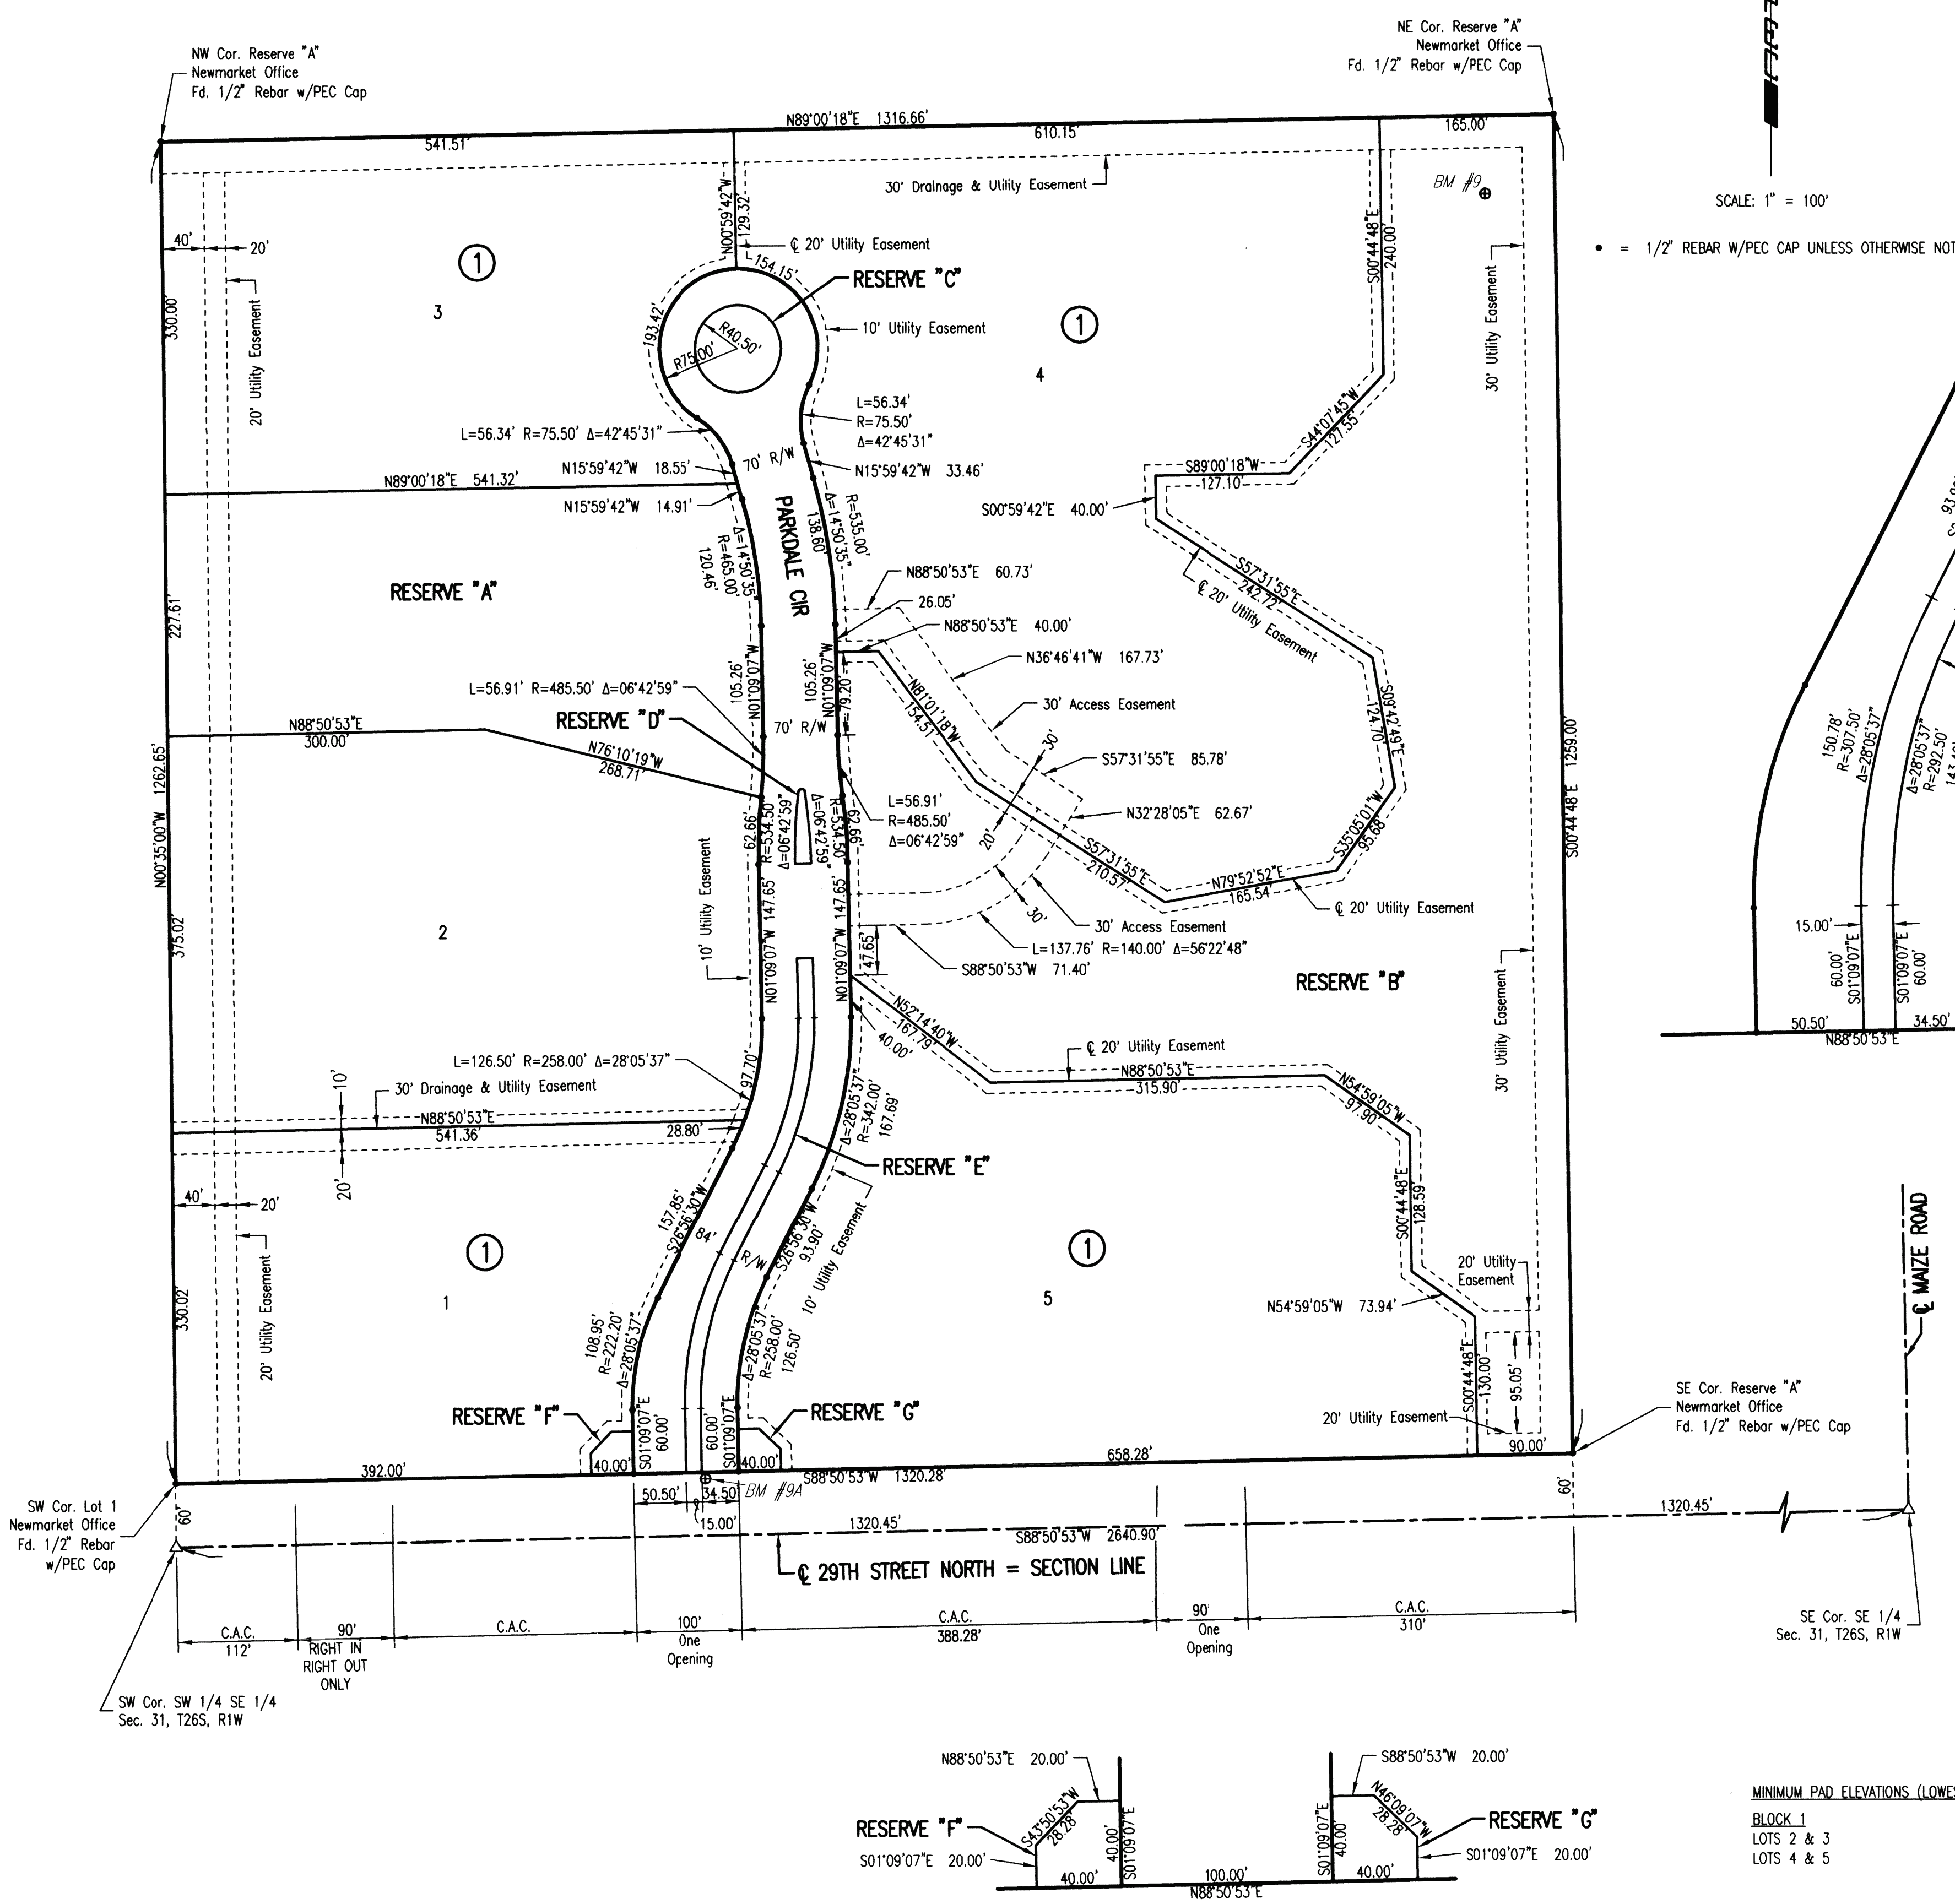

MINIMUM PAD ELEVATIONS (LOWEST OPENING) SHALL BE AS FOLLOWS:

BLOCK 1	NAVD 88
LOTS 2 & 3	1355.0
LOTS 4 & 5	1354.0

BENCHMARKS:
 BM #9
 T-POST 70' +/- WEST AND 75' SOUTH OF NORTHEAST CORNER SW 1/4 SE 1/4 SEC. 31, T26S, R1W
 ELEV. 1351.58 NAVD 88
 BM #9A
 CHISELED SQUARE AT NORTHEAST CORNER OF CONCRETE DRIVE APPROACH, SOUTH SIDE OF SIDEWALK ON NORTH SIDE OF 29TH STREET, AT INTERSECTION OF 29TH AND PARKDALE
 ELEV. 1359.26 NAVD 88

STATE OF KANSAS } SS
 COUNTY OF SEDGWICK }
 WE, PROFESSIONAL ENGINEERING CONSULTANTS, P.A. ENGINEERS AND SURVEYORS IN AFORESAID STATE AND COUNTY, DO HEREBY CERTIFY THAT ON THIS 8TH DAY OF MARCH, 2011, WE HAVE SURVEYED AND PLATTED NEWMARKET OFFICE 2ND, AN ADDITION TO WICHITA, SEDGWICK COUNTY, KANSAS, INTO LOTS, A BLOCK, AND RESERVES THE SAME BEING DESCRIBED AS FOLLOWS:
 A REPLAT OF LOT 1, BLOCK 1, AND RESERVE "A" OF NEWMARKET OFFICE AN ADDITION TO WICHITA, SEDGWICK COUNTY, KANSAS.

ALL PUBLIC EASEMENTS LYING WITHIN THE ABOVE DESCRIBED TRACT OF LAND ARE HEREBY VACATED AND REPLATED BY VIRTUE OF KSA 12-512(b) AMENDED.

ALL ABUTTERS RIGHT OF ACCESS TO AND FROM 29TH STREET NORTH OVER AND ACROSS THE SOUTH PROPERTY LINE IS HEREBY GRANTED TO THE CITY OF WICHITA, PROVIDED HOWEVER THAT THERE SHALL BE ACCESS TO 29TH STREET NORTH AT THREE OPENINGS AS SHOWN.



JAMES R. BECKETT, R.L.S. NO. 832
 PROFESSIONAL ENGINEERING CONSULTANTS, P.A.

FEMA FLOOD PLAN AND REGULATORY FLOODWAY BOUNDARIES ARE SUBJECT TO PERIODIC CHANGE, AND SUCH CHANGE MAY AFFECT THE INTENDED LAND USE WITHIN THE SUBDIVISION.

RESERVES "A" AND "B" ARE HEREBY PLATTED FOR DRAINAGE, LAKES, LANDSCAPING, SIDEWALKS, AND UTILITIES, CONFINED TO EASEMENTS. RESERVES "C", "D", AND "E" ARE HEREBY PLATTED FOR DRAINAGE, LANDSCAPING, AND ACCESS DRIVES. RESERVE "F" SHALL ALLOW FOR PUBLIC ACCESS ACROSS AT VARIOUS LOCATIONS FOR DRIVEWAYS, AS APPROVED BY THE CITY ENGINEER. RESERVES "F" AND "G" ARE HEREBY PLATTED FOR ENTRY MONUMENTS, LANDSCAPING, AND SIGNS. RESERVES "A" THRU "G" SHALL BE OWNED AND MAINTAINED BY AN OWNER'S ASSOCIATION TO BE FORMED WITHIN NEWMARKET OFFICE 2ND ADDITION.

EASEMENTS FOR THE CONSTRUCTION AND MAINTENANCE OF PUBLIC UTILITIES ARE HEREBY GRANTED.
 THE 30 FOOT ACCESS EASEMENT IS HEREBY GRANTED TO THE CITY OF WICHITA FOR INGRESS, EGRESS AND DRIVEWAY PURPOSES TO LOT 4, BLOCK 1. CONSTRUCTION AND MAINTENANCE OF DRIVES WITHIN THE EASEMENT SHALL BE BY THE OWNER, SUCCESSORS, AND ASSIGNS OF LOT 4, BLOCK 1.

A DRAINAGE PLAN HAS BEEN APPROVED FOR THIS PLAT. ALL DRAINAGE EASEMENTS, RIGHTS-OF-WAY, OR RESERVES SHALL REMAIN AT ESTABLISHED GRADES AND UNOBSERVED TO ALLOW FOR THE CONVEYANCE OF STORM WATER, UNLESS MODIFIED WITH THE APPROVAL OF THE CITY ENGINEER.

KNOW ALL MEN BY THESE PRESENTS THAT WE, THE UNDERSIGNED PROPERTY OWNERS OF THE LAND AS ABOVE SET FORTH IN THE SURVEYOR'S CERTIFICATE, HAVE CAUSED THE LAND TO BE SURVEYED AND PLATTED INTO LOTS, A BLOCK, AND RESERVES THE SAME TO BE KNOWN AS NEWMARKET OFFICE 2ND, AN ADDITION TO WICHITA, SEDGWICK COUNTY, KANSAS.

OWNERS:
 NEWMARKET OFFICE, LLC, A KANSAS LIMITED LIABILITY COMPANY

JERRY JONES, VICE PRESIDENT

STATE OF KANSAS } SS
 COUNTY OF SEDGWICK }

THIS INSTRUMENT WAS ACKNOWLEDGED BEFORE ME ON THIS 21ST DAY OF MARCH, 2011, BY JERRY JONES, VICE PRESIDENT OF NEWMARKET OFFICE, LLC, A KANSAS LIMITED LIABILITY COMPANY

SARAH E. HATRUP, NOTARY PUBLIC
 MY APPOINTMENT EXPIRES: December 16, 2012

STATE OF KANSAS } SS
 COUNTY OF SEDGWICK }

THIS PLAT OF NEWMARKET OFFICE 2ND, AN ADDITION TO WICHITA, SEDGWICK COUNTY, KANSAS, HAS BEEN SUBMITTED TO AND APPROVED BY THE WICHITA, SEDGWICK COUNTY METROPOLITAN AREA PLANNING COMMISSION, WICHITA, KANSAS.

DATED THIS 24TH DAY OF FEBRUARY, 2011.

WICHITA-SEGWICK COUNTY METROPOLITAN AREA PLANNING COMMISSION, WICHITA, KANSAS

Debra Miller Stevens, CHAIRMAN
 DEBRA MILLER STEVENS
 John L. Schlegel, SECRETARY

REVIEWED IN ACCORDANCE WITH K.S.A. 58-2005 ON THIS _____ DAY OF _____, 2011.

TRICIA L. ROBELLO, LS #1246
 DEPUTY COUNTY SURVEYOR
 SEDGWICK COUNTY KANSAS

ENTERED ON TRANSFER RECORD THIS 18 DAY OF MAY, 2011.
 KELLY B. ARNOLD, COUNTY CLERK

THIS IS TO CERTIFY THAT THIS INSTRUMENT WAS FILED FOR RECORD IN THE REGISTER OF DEEDS OFFICE AT 10:19:34 A.M. ON THE 19TH DAY OF MAY, 2011.

BILL MEEX, REGISTER OF DEEDS

TONYA BUCKINGHAM, DEPUTY

THIS PLAT IS APPROVED AND ALL DEDICATIONS SHOWN HEREON, IF ANY ARE ACCEPTED BY THE CITY COUNCIL OF THE CITY OF WICHITA, KANSAS, THIS 26TH DAY OF APRIL, 2011.

Carl Brewer, MAYOR
 Karen Sorensen, NAAC, CITY CLERK

WICHITA, KANSAS

WICHITA, KANSAS

FOR INFORMATION ONLY




PRINTS ISSUED

DATE	PURPOSE	NO.
05.11.2015	75% OWNER REVIEW	
05.29.2015	PERMIT SET/BID SET	
06.12.2015	ADDENDUM 1	1
08.10.2015	ADDENDUM 2	2
08.17.2015	ADDENDUM 3	3
09.15.2015	CCD 1	4
09.30.2015	CCD 2	5
10.19.2015	CCD 3	6

**OXFORD VILLA
 WICHITA, KS**


LKArchitecture

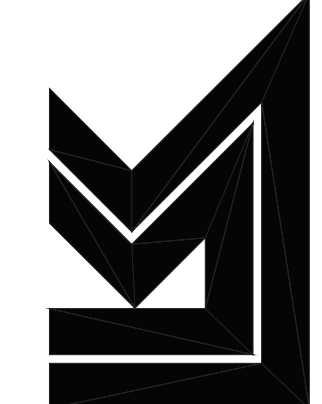

Architecture • Engineering • Planning • Interior Design • Landscape Architecture

LKArchitecture, Inc.®
 345 Riverview Wichita, KS 67203
 T 316.268.0230 F 316.268.0205
 CONTACT: Isaac Krumme
 DRAWN: Roy Thomas
 CHECKED: Ben Mabry
 PROJECT NUMBER:
14619
 SHEET TITLE:
 COPY OF PLAT
 SHEET NUMBER:
C2.3

Save: 01-08-2011 11:27:40 AM by CSJ
 PC: 201108011025317001.DWG
 Saved: 06-08-2015 3:45:49 PM by CSJ
 U:\Projects - 2011\15101025317001\15101025317001-006-C2.3-COPY OF PLAT

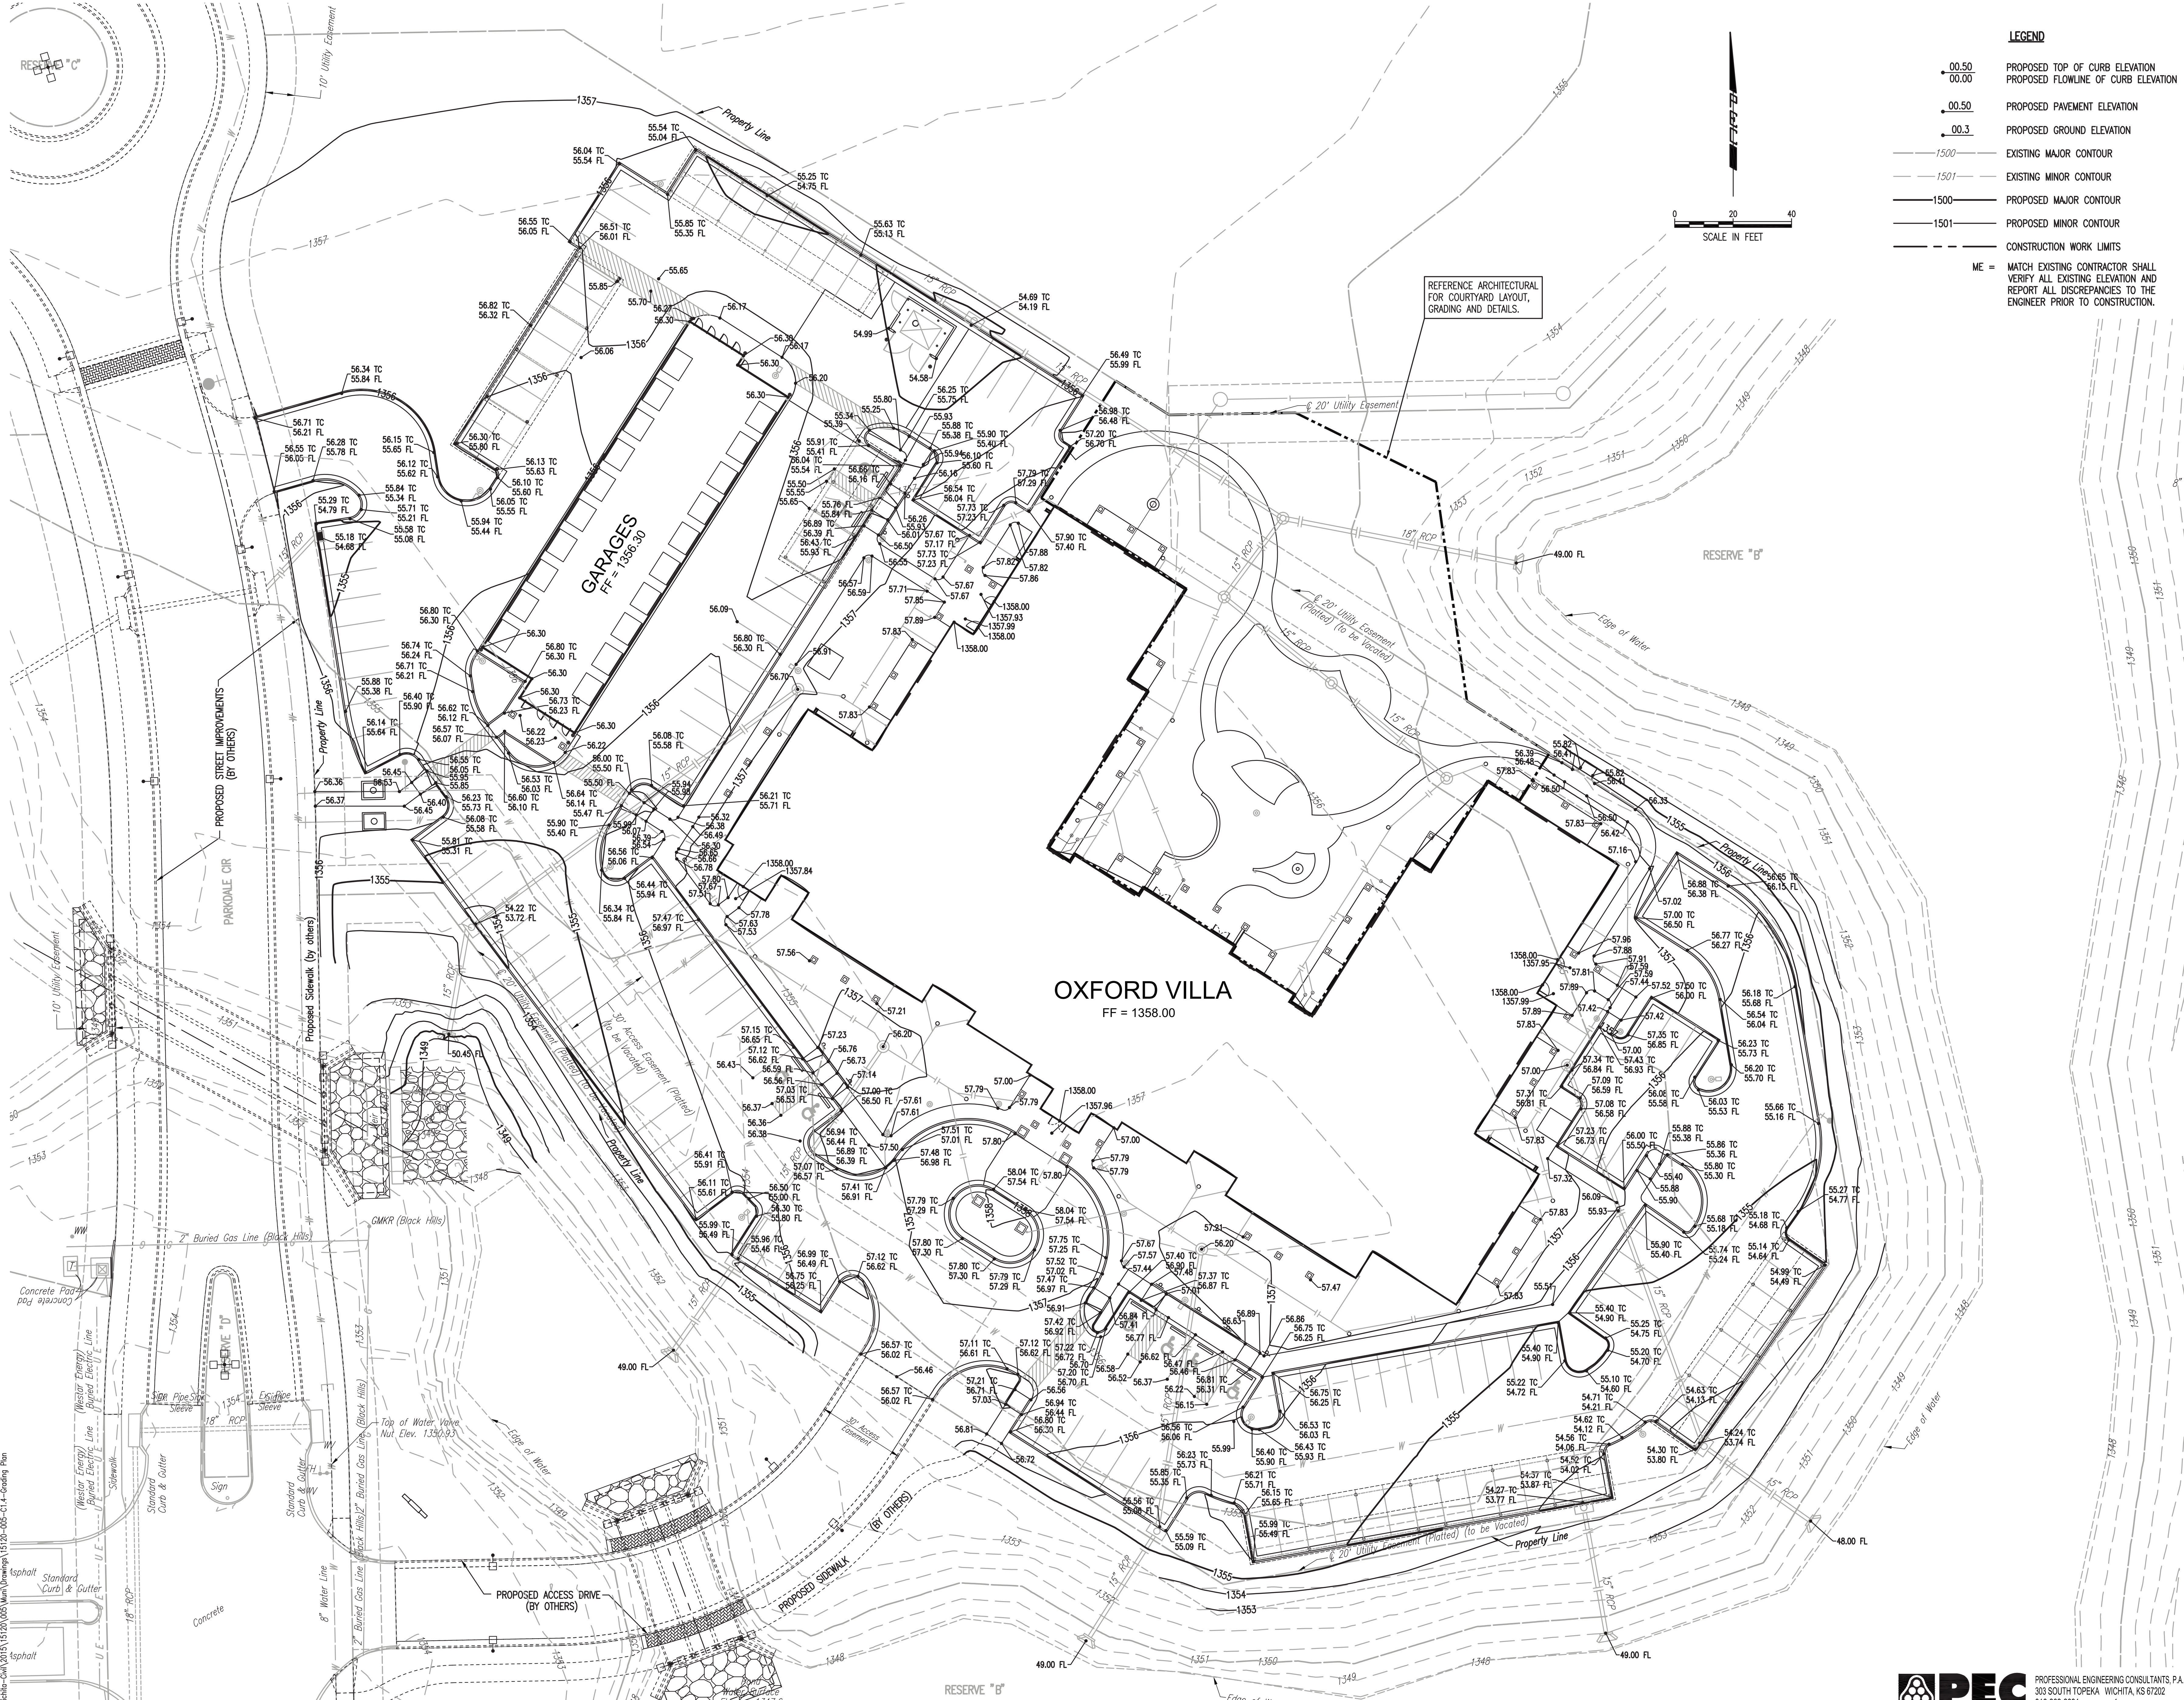

LEGEND

00.50	PROPOSED TOP OF CURB ELEVATION
00.00	PROPOSED FLOWLINE OF CURB ELEVATION
00.50	PROPOSED PAVEMENT ELEVATION
00.3	PROPOSED GROUND ELEVATION
1500	EXISTING MAJOR CONTOUR
1501	EXISTING MINOR CONTOUR
1500	PROPOSED MAJOR CONTOUR
1501	PROPOSED MINOR CONTOUR
---	CONSTRUCTION WORK LIMITS

ME = MATCH EXISTING CONTRACTOR SHALL VERIFY ALL EXISTING ELEVATION AND REPORT ALL DISCREPANCIES TO THE ENGINEER PRIOR TO CONSTRUCTION.

PRINTS ISSUED


DATE	PURPOSE	NO.
05.11.2015	75% OWNER REVIEW	
05.29.2015	PERMIT SET/BD SET	
06.12.2015	ADDENDUM 1	1
08.10.2015	ADDENDUM 2	2
08.17.2015	ADDENDUM 3	3
09.15.2015	CCD 1	4
09.30.2015	CCD 2	5
10.19.2015	CCD 3	6

REVISED ENTIRE SHEET
 REVISED ENTIRE SHEET
 REVISED ENTIRE SHEET

**OXFORD VILLA
WICHITA, KS**



Architecture • Engineering • Planning • Interior Design • Landscape Architecture

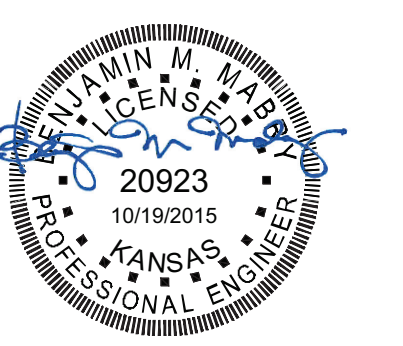


LKArchitecture, Inc.®
 345 Riverview Wichita, KS 67203
 T 316.268.0230 F 316.268.0205
 CONTACT: Isaac Krumme
 DRAWN: Roy Thomas
 CHECKED: Ben Mabry
**PROJECT NUMBER:
14619**
 SHEET TITLE:
GRADING PLAN

SHEET NUMBER:
C1.4



Saved 10-01-2015 8:33:37 AM by TREVOR KAUFMAN
 U:\Projects\2015\14619\14619_014_Grading_Plan

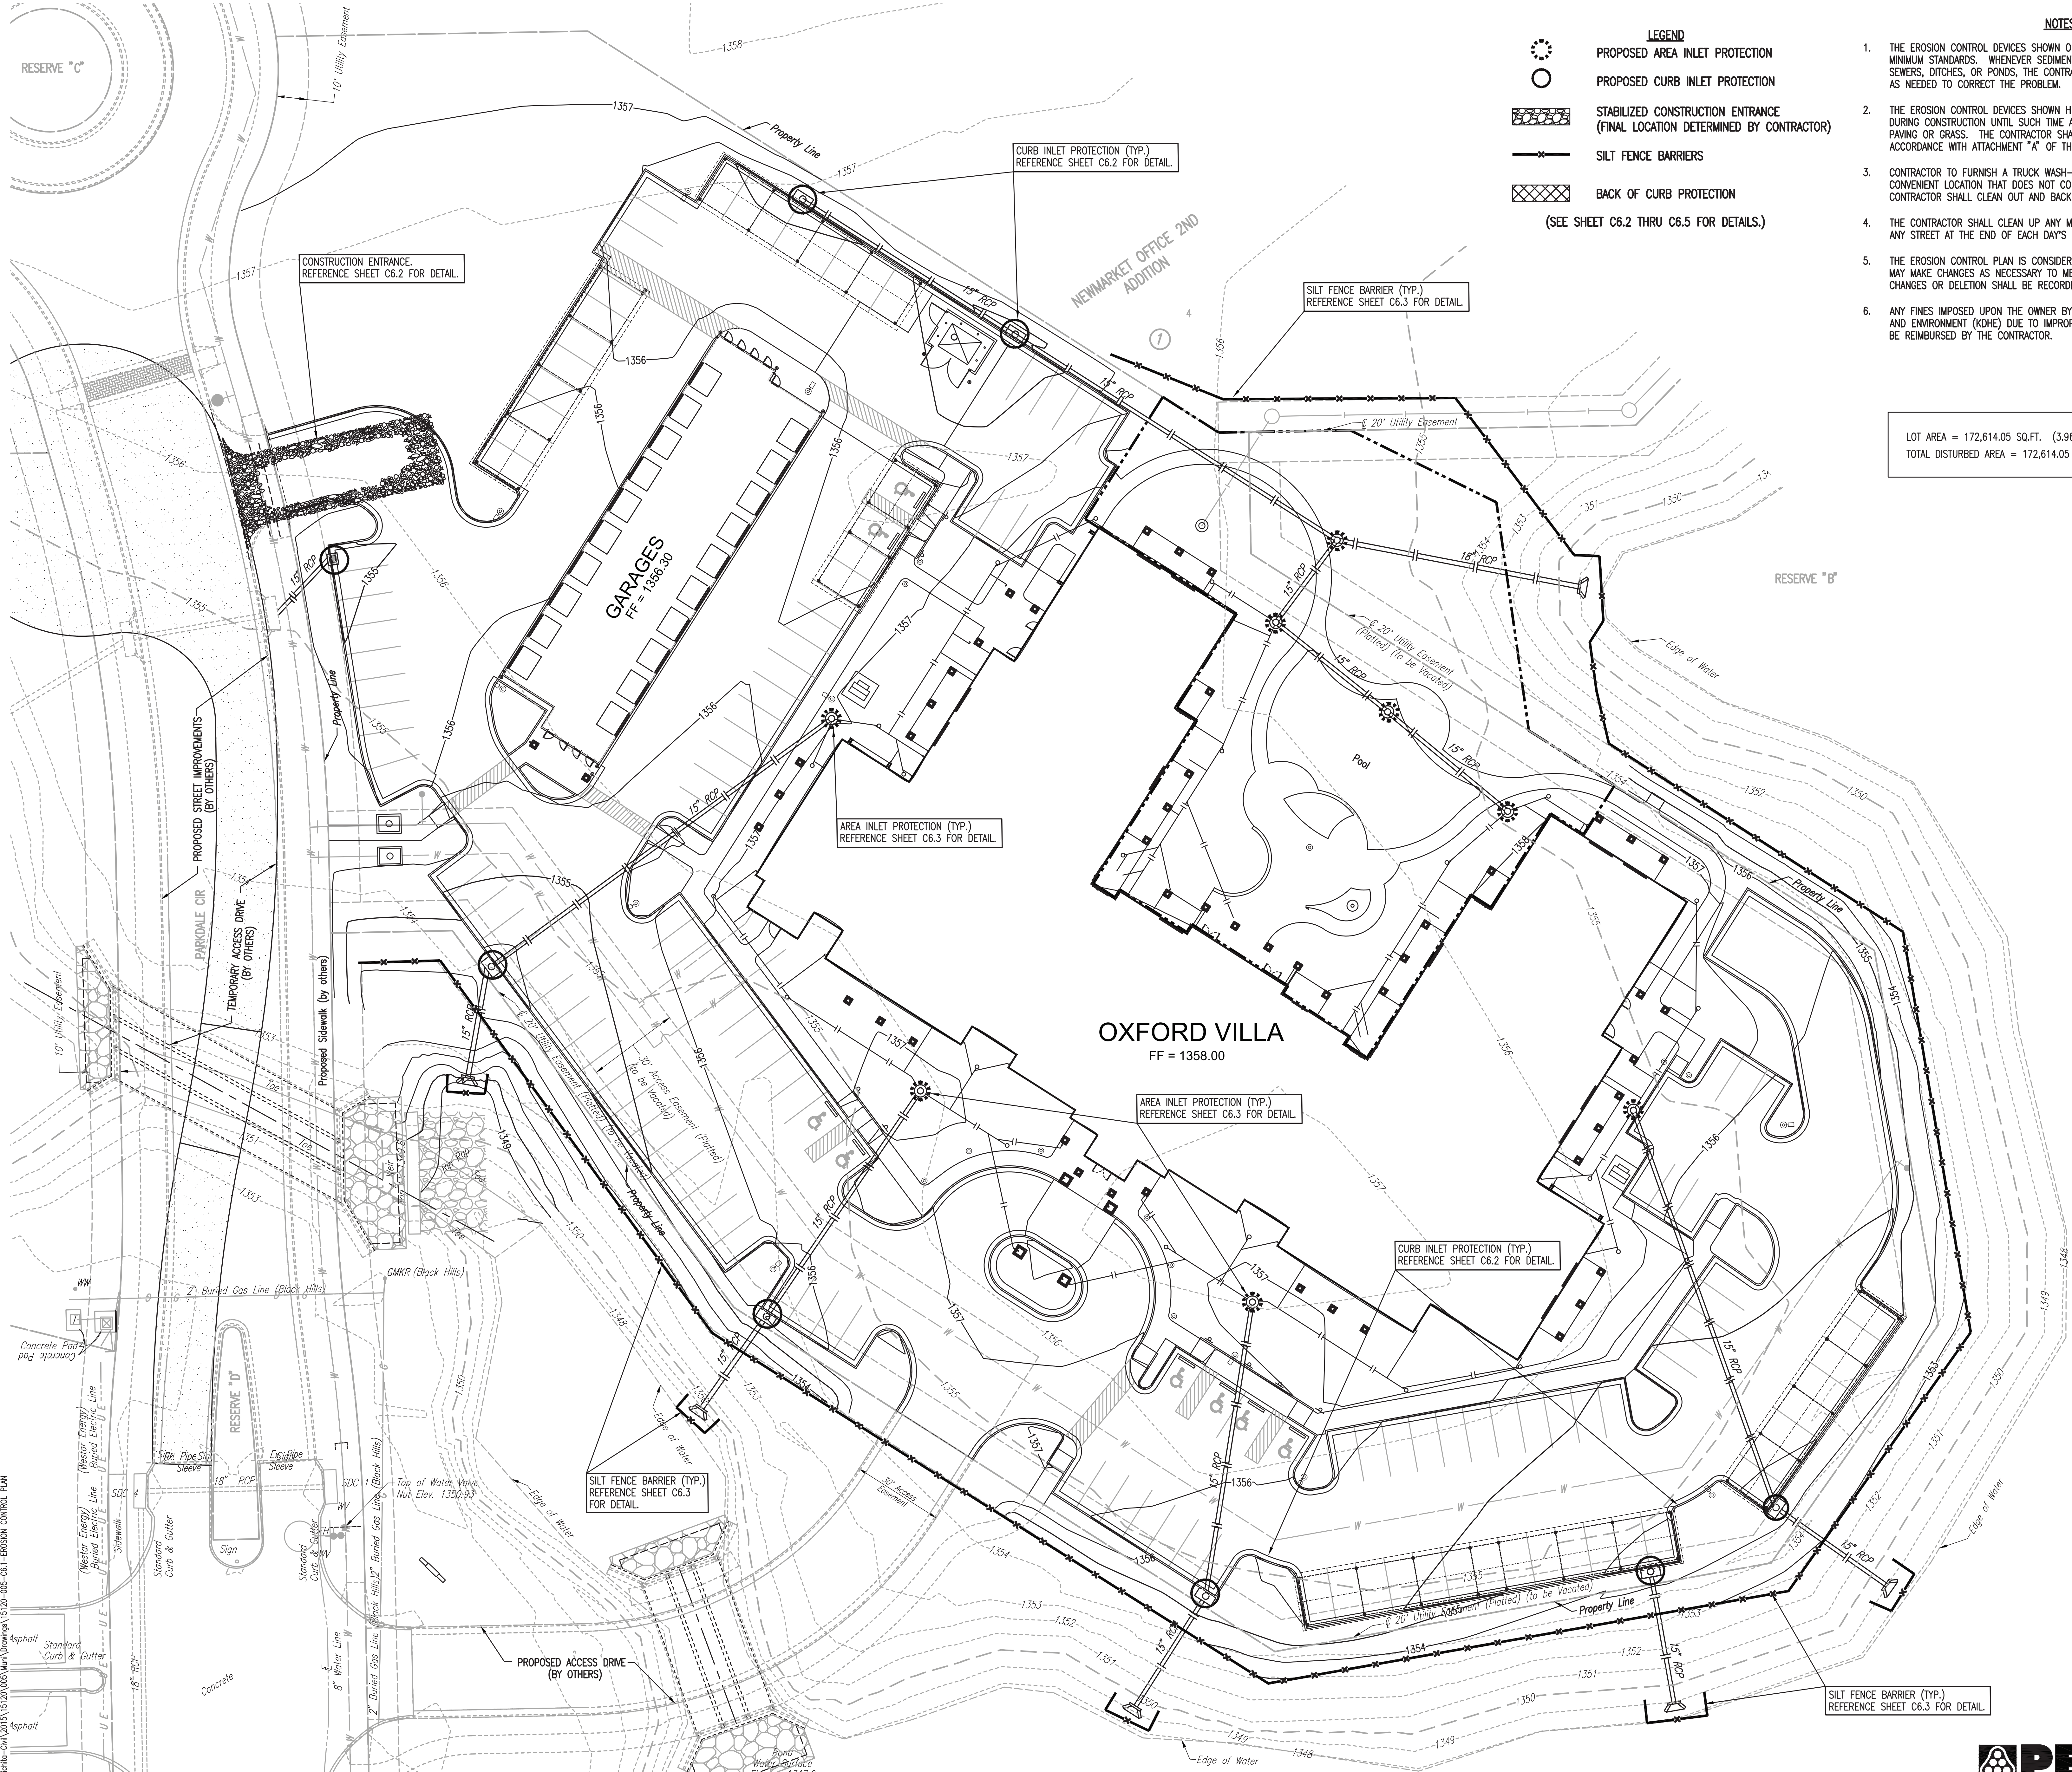

- LEGEND**
- PROPOSED AREA INLET PROTECTION
 - PROPOSED CURB INLET PROTECTION
 - STABILIZED CONSTRUCTION ENTRANCE (FINAL LOCATION DETERMINED BY CONTRACTOR)
 - SILT FENCE BARRIERS
 - BACK OF CURB PROTECTION (SEE SHEET C6.2 THRU C6.5 FOR DETAILS.)

- NOTES**
- THE EROSION CONTROL DEVICES SHOWN ON THIS SHEET ARE CONSIDERED MINIMUM STANDARDS. WHENEVER SEDIMENT ENTERS STREETS, STORM SEWERS, DITCHES, OR PONDS, THE CONTRACTOR WILL INSTALL ADDITIONAL DEVICES AS NEEDED TO CORRECT THE PROBLEM.
 - THE EROSION CONTROL DEVICES SHOWN HEREON MUST BE IN PLACE AT ALL TIMES DURING CONSTRUCTION UNTIL SUCH TIME AS THE SITE IS REESTABLISHED WITH PAVING OR GRASS. THE CONTRACTOR SHALL INSTALL TEMPORARY OR PERMANENT SEED IN ACCORDANCE WITH ATTACHMENT "A" OF THE KDHE NOTICE OF INTENT PERMIT.
 - CONTRACTOR TO FURNISH A TRUCK WASH-OUT PIT TO BE PLACED AT A CONVENIENT LOCATION THAT DOES NOT CONFLICT WITH CONSTRUCTION. THE CONTRACTOR SHALL CLEAN OUT AND BACKFILL PIT PRIOR TO FINAL INSPECTION.
 - THE CONTRACTOR SHALL CLEAN UP ANY MUD INADVERTENTLY TRACKED ONTO ANY STREET AT THE END OF EACH DAY'S WORK.
 - THE EROSION CONTROL PLAN IS CONSIDERED A DYNAMIC PLAN. THE CONTRACTOR MAY MAKE CHANGES AS NECESSARY TO MEET PERMIT REQUIREMENTS. ANY CHANGES OR DELETION SHALL BE RECORDED AND KEPT ON SITE AT ALL TIMES.
 - ANY FINES IMPOSED UPON THE OWNER BY THE KANSAS DEPARTMENT OF HEALTH AND ENVIRONMENT (KDHE) DUE TO IMPROPER EROSION CONTROL PRACTICES SHALL BE REIMBURSED BY THE CONTRACTOR.


LOT AREA = 172,614.05 SQ.FT. (3.96 AC.)
 TOTAL DISTURBED AREA = 172,614.05 SQ.FT. (3.96 AC.)

PRINTS ISSUED


DATE	PURPOSE	NO.
05.11.2015	75% OWNER REVIEW	
05.29.2015	PERMIT SET/BD SET	1
06.12.2015	ADDENDUM 1	1
08.10.2015	ADDENDUM 2	2
08.17.2015	ADDENDUM 3	3
09.15.2015	CD 1	4
09.30.2015	CD 2	5
10.19.2015	CD 3	6

- ADDED SHEET
- REVISED ENTIRE SHEET
- REVISED ENTIRE SHEET


**OXFORD VILLA
 WICHITA, KS**

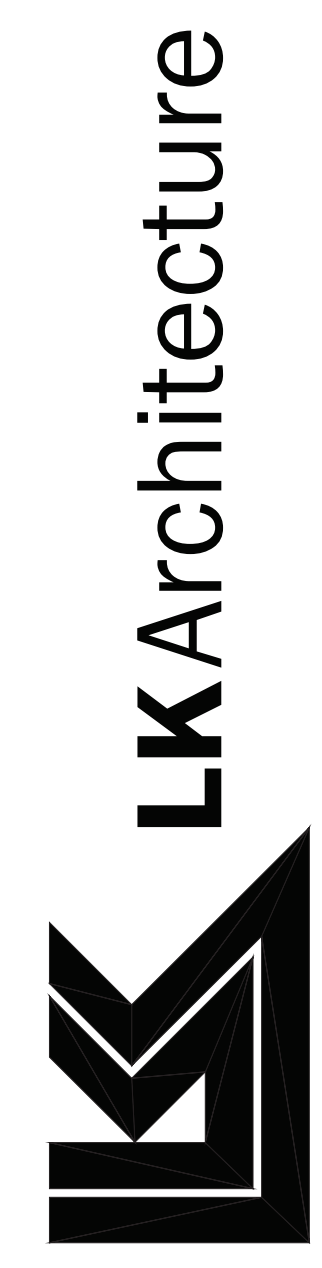

Architecture • Engineering • Planning • Interior Design • Landscape Architecture

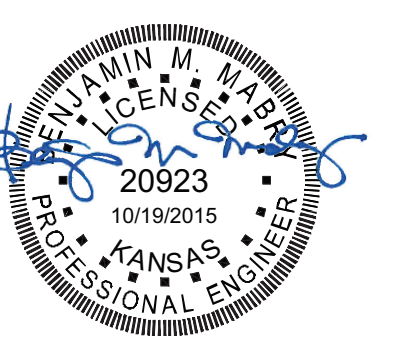

LKArchitecture, Inc.®
 345 Riverview Wichita, KS 67203
 T 316.268.0230 F 316.268.0205
 CONTACT: Isaac Krumme
 DRAWN: Roy Thomas
 CHECKED: Ben Mabry
**PROJECT NUMBER:
 14619**
 SHEET TITLE:
 EROSION CONTROL PLAN

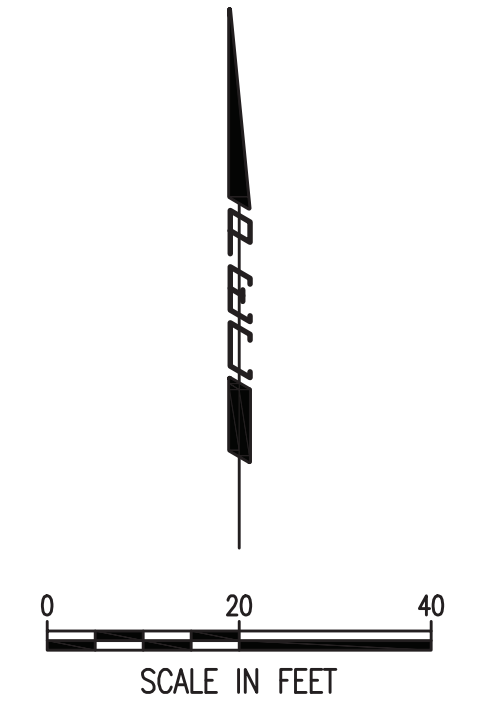

SHEET NUMBER:
C6.1

Saved: 10-19-2015 1:47:54 PM by: CSJ
 U:\Projects\2015\14619\14619-005-06-1-EROSION CONTROL PLAN


DATE	PURPOSE	NO.
05.11.2015	75% OWNER REVIEW	
05.29.2015	PERMIT SET/BID SET	
06.12.2015	ADDENDUM 1	1
08.10.2015	ADDENDUM 2	2
08.17.2015	ADDENDUM 3	3
09.15.2015	CCD 1	4
09.30.2015	CCD 2	5
10.19.2015	CCD 3	6

**OXFORD VILLA
WICHITA, KS**


LKArchitecture




Architecture • Engineering • Planning • Interior Design • Landscape Architecture

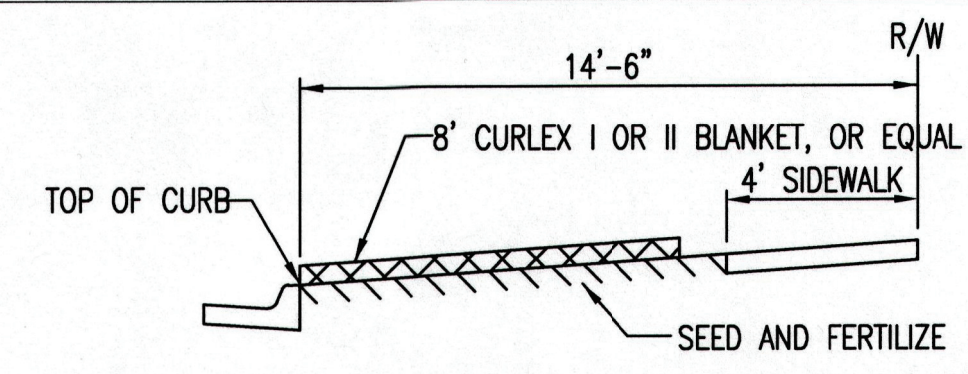


SECTION B-B

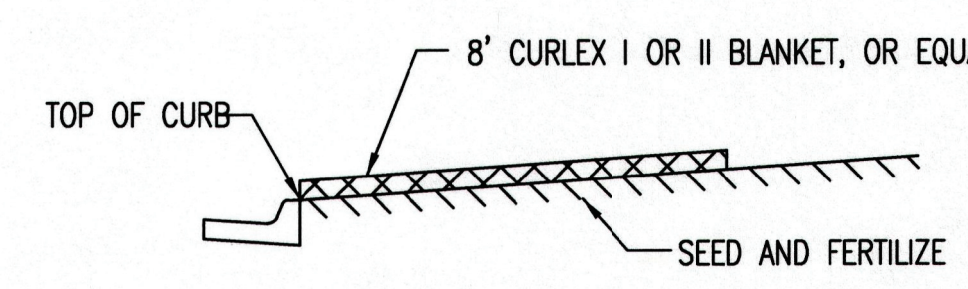

SECTION A-A

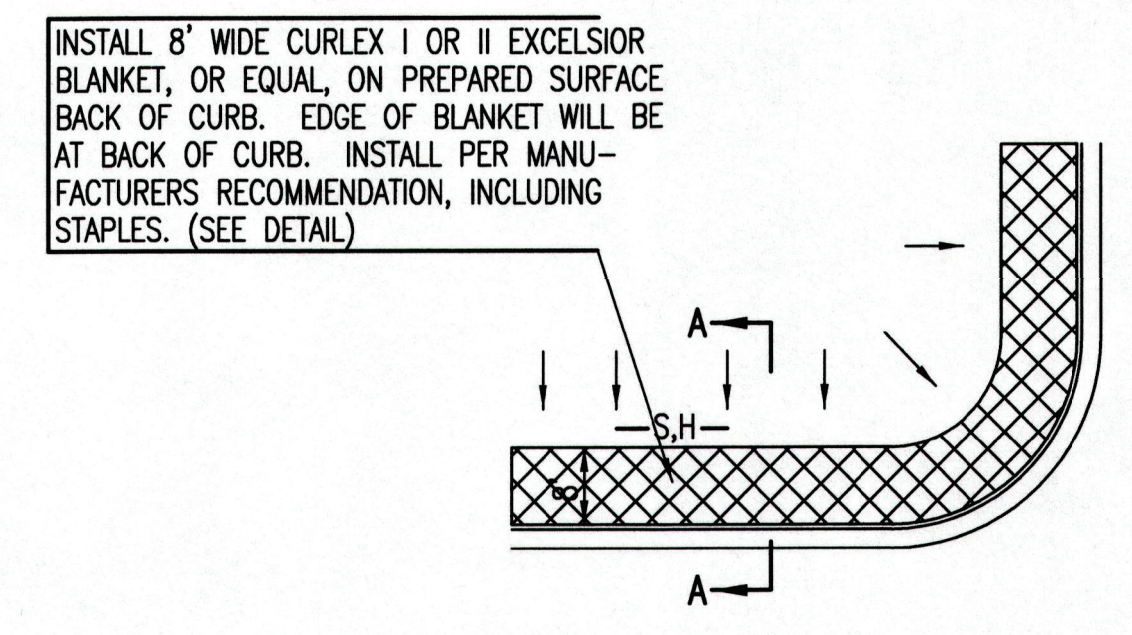


SOUTH STREET

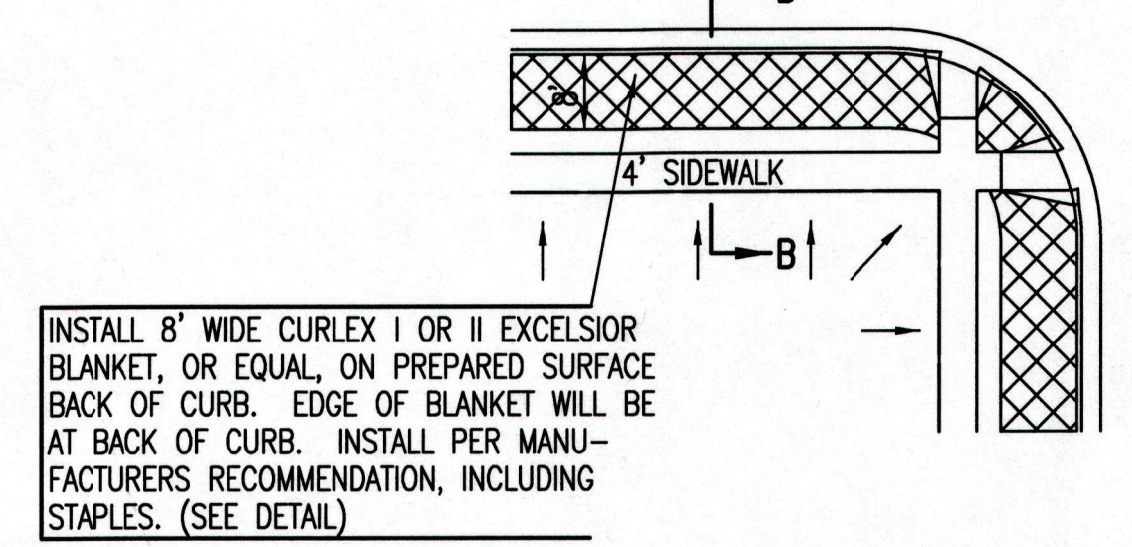


- GENERAL NOTES**
- EXCELSIOR MAT TO BE INSTALLED WHEN SOD IS NOT SPECIFIED ON PROJECT.
 - EXCELSIOR BLANKET TO BE INSTALLED OVER SEED AND FERTILIZER, AS SPECIFIED IN THE PROJECT SPECIFICATIONS.
 - AFTER INSTALLATION OF EXCELSIOR BLANKET, AT LOCATIONS WHERE CONCENTRATED FLOW CARRIES SEDIMENT OVER THE CURB AND INTO THE GUTTER, SUPPLEMENTAL EROSION CONTROL DEVICES WILL BE INSTALLED BY THE CONTRACTOR AS NEEDED, TO FIX THE PROBLEM.

BACK OF CURB PROTECTION DETAIL

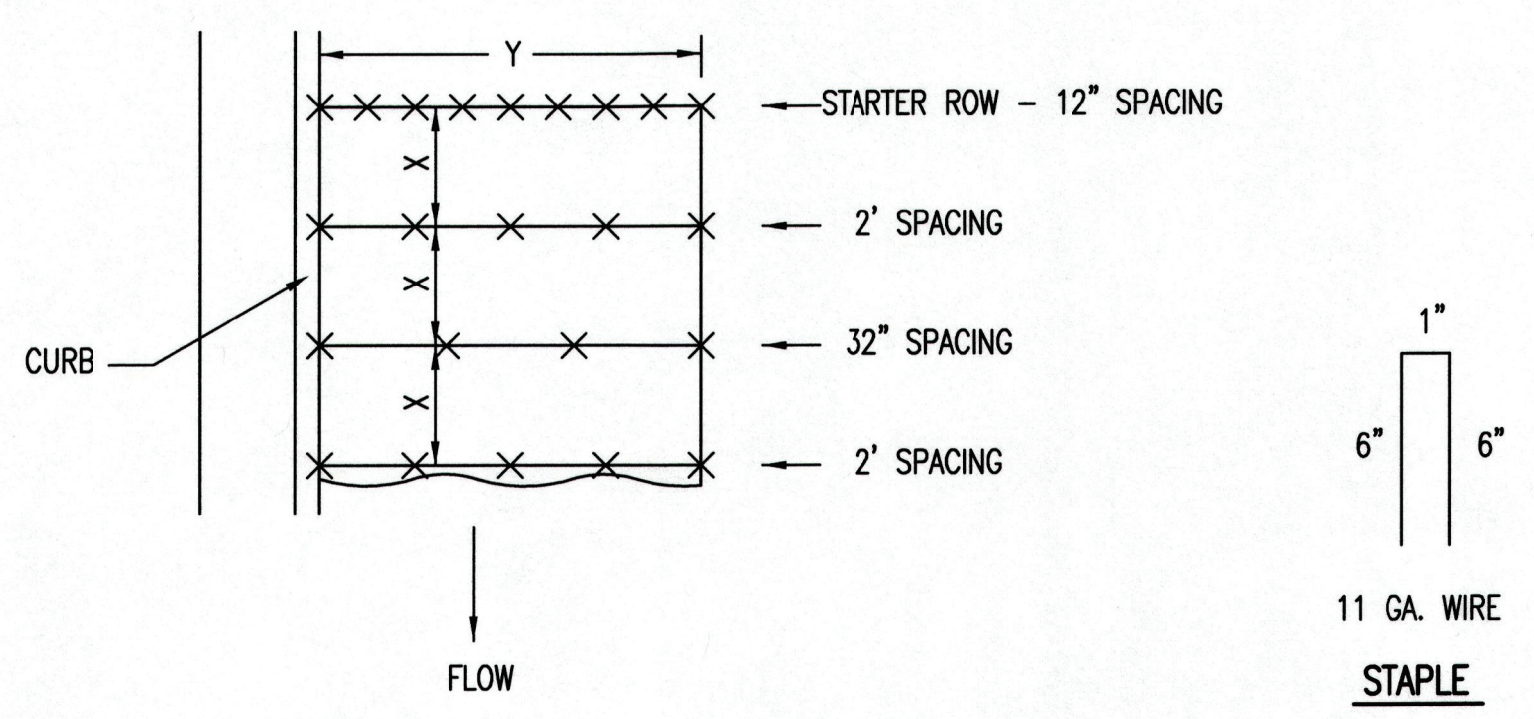


STAPLE PATTERN
NOTES: USE 6" SEAM OVERLAP
(X & Y = RECOMMENDED BY MANUFACTURE)
DETAILS FOR APPROVED EROSION CONTROL MAT

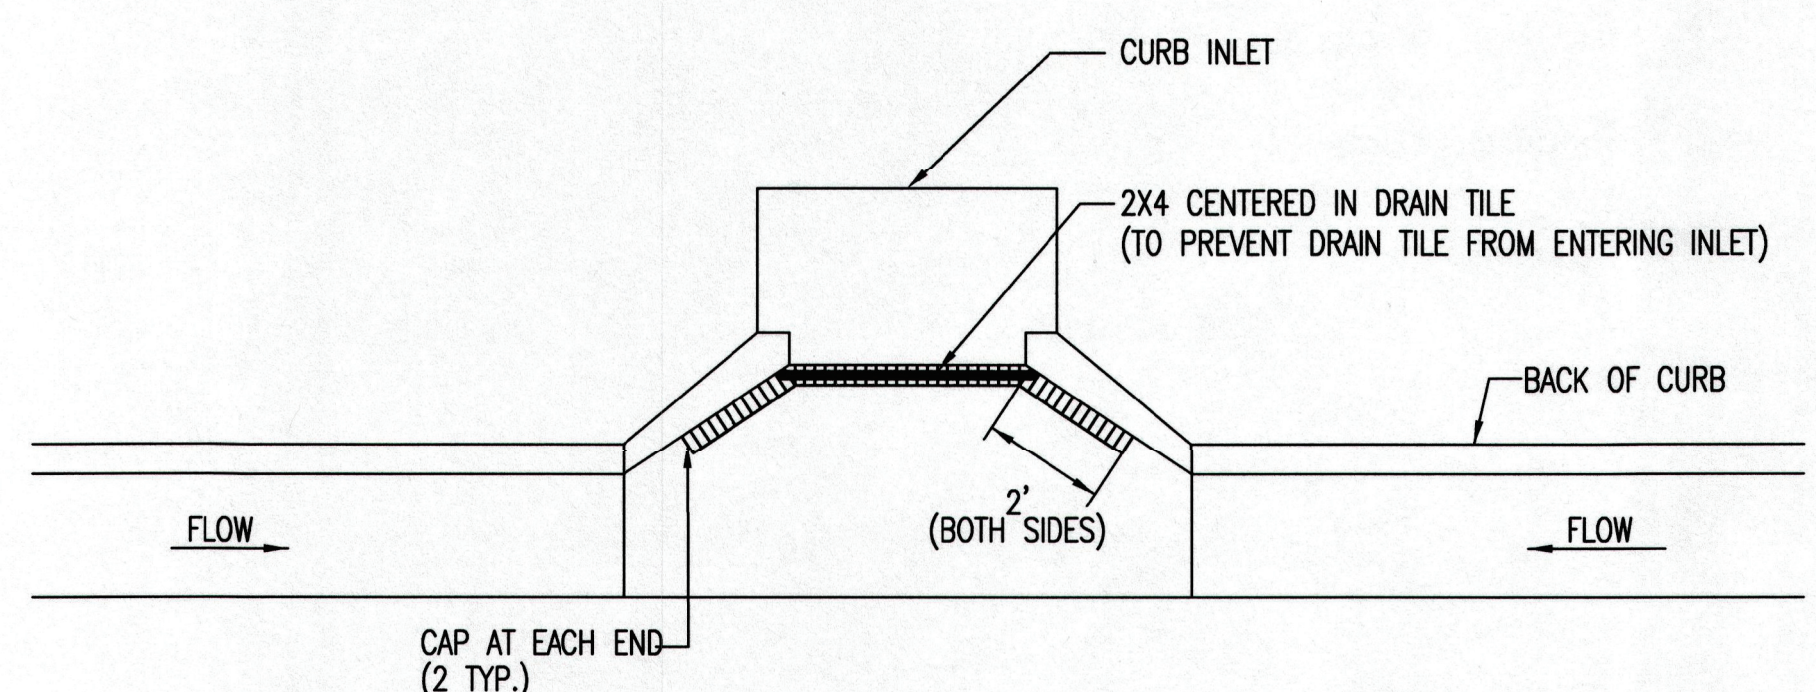


NOTE: PLACE 4" PERFORATED PVC PIPE, FILLED WITH 1/2"-1" DIA. GRAVEL, IN FRONT OF CURB INLET AS SHOWN.

2X4 LENGTH	INLET TYPE	INLET OPENING
5'-6"	1-A	5'-0"
10'-6"	1-A	10'-0"
15'-6"	1-A	15'-0"

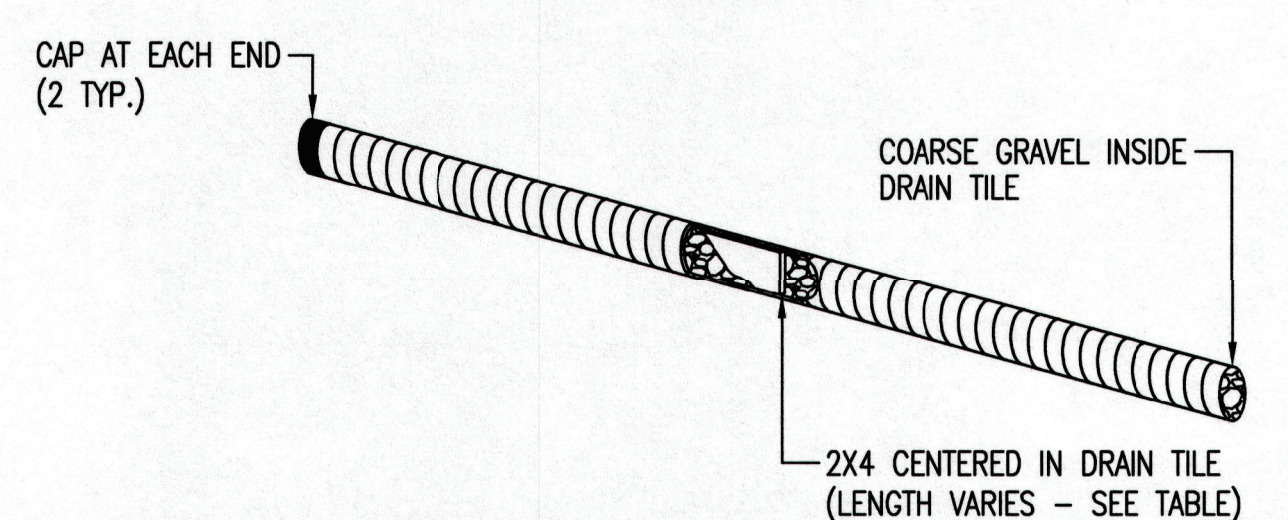

CURB INLET PROTECTION
4" PERFORATED PIPE W/ GRAVEL

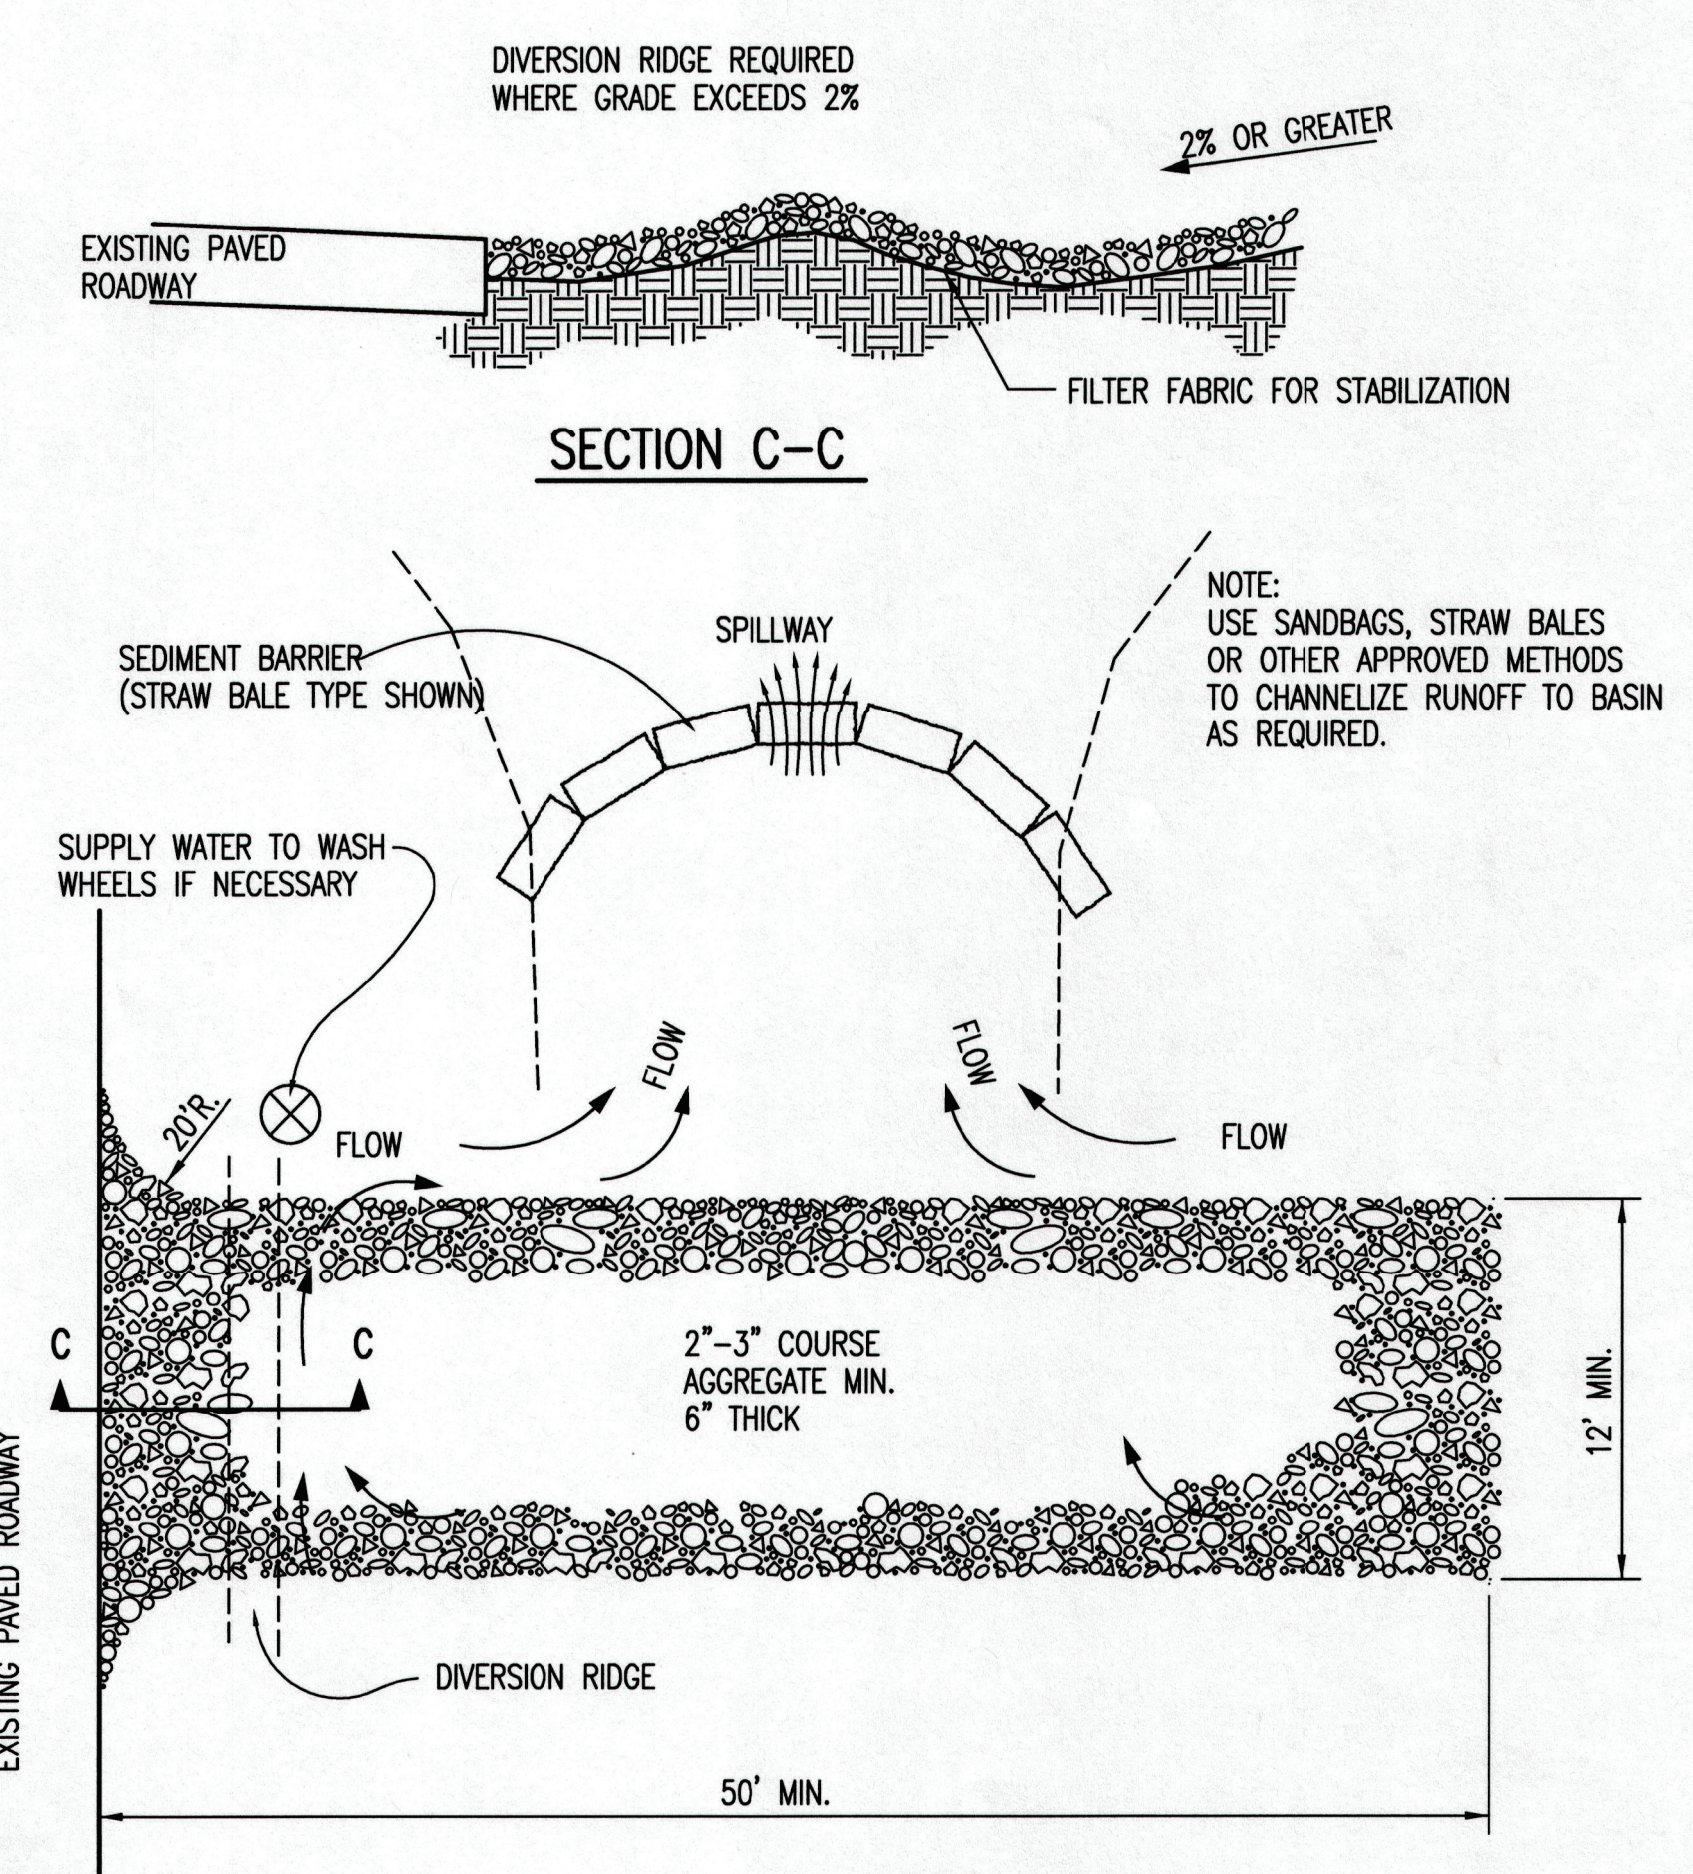

STABILIZED CONSTRUCTION ENTRANCE

- GENERAL NOTES**
- THE ENTRANCE SHALL BE MAINTAINED IN A CONDITION THAT WILL PREVENT TRACKING OR FLOWING OF SEDIMENT ONTO PUBLIC RIGHTS-OF-WAY. THIS MAY REQUIRE TOP DRESSING, REPAIR AND/OR CLEANOUT OF ANY MEASURES USED TO TRAP SEDIMENT.
 - WHEN NECESSARY, WHEELS SHALL BE CLEANED PRIOR TO ENTRANCE ONTO PUBLIC RIGHT-OF-WAY.
 - WHEN WASHING IS REQUIRED, IT SHALL BE DONE ON AN AREA STABILIZED WITH CRUSHED STONE THAT DRAINS INTO AN APPROVED SEDIMENT TRAP OR SEDIMENT BASIN, AS SHOWN ABOVE.
 - DRIVE ENTRANCES ONTO RESIDENTIAL LOTS WILL NOT BE REQUIRED TO HAVE THE SEDIMENT BARRIER SHOWN, BUT WHEEL WASHING MAY BE REQUIRED IF STABILIZED ENTRANCE IS NOT SUFFICIENT TO KEEP MUD FROM BEING TRACKED ONTO ADJACENT STREET. ENTRANCE SHALL EXTEND FROM BACK OF CURB TO DWELLING.

REVISION DATE: MAY 2013



BACK OF CURB PROTECTION, CURB INLET PROTECTION AND CONSTRUCTION ENTRANCE

CITY ENGINEER
GARY JANZEN, P.E.

PROJECT NUMBER	OCA NUMBER	DATE

CITY ENGINEER'S OFFICE
CITY HALL - SEVENTH FLOOR
455 NORTH MAIN STREET
WICHITA, KANSAS 67202-1620
(316) 268-4501

SHEET



05/20/13

SW-501

Saved: 06-01-2015, 4:44:26 PM by: CSL
U:\Projects - 2015\15120\15120\15120-005-02-EROSION CONTROL DETAILS

DATE	PURPOSE	NO.
05.11.2015	75% OWNER REVIEW	
05.29.2015	PERMIT SET/BID SET	
06.12.2015	ADDENDUM 1	1
08.10.2015	ADDENDUM 2	2
08.17.2015	ADDENDUM 3	3
09.15.2015	CCD 1	4
09.30.2015	CCD 2	5
10.19.2015	CCD 3	6

OXFORD VILLA
WICHITA, KS

LKArchitecture

Architecture • Engineering • Planning • Interior Design • Landscape Architecture



LKArchitecture, Inc.®
345 Riverview Wichita, KS 67203
T 316.268.0230 F 316.268.0205
CONTACT: Isaac Krumm
DRAWN: Roy Thomas
CHECKED: Ben Mabry
PROJECT NUMBER:
14619
SHEET TITLE:
EROSION CONTROL DETAILS
SHEET NUMBER:
C6.3

NOTE: POINT A MUST BE HIGHER THAN POINT B SO THAT WATER FLOWS OVER THE SILT FENCE FABRIC AND NOT AROUND IT.

**ELEVATION
SILT FENCE DITCH CHECKS
(STREAM PROTECTION)**

MATERIAL SPECIFICATION:
SILT FENCE FABRIC SHOULD CONFORM TO THE AASHTO M288 96 SILT FENCE SPECIFICATION. THE POSTS USED TO SUPPORT THE SILT FENCE FABRIC SHOULD BE A HARDWOOD MATERIAL WITH THE FOLLOWING MINIMUM DIMENSIONS: 2" SQUARE (NOMINAL) BY 4" LONG. SILT FENCE FABRIC SHOULD BE ATTACHED TO THE WOODEN POSTS WITH STAPLES, WIRE, ZIP TIES, OR NAILS.

PLACEMENT:
PLACE SILT FENCE IN DITCHES WHERE IT IS UNLIKELY THAT IT WILL BE OVERTOPPED. WATER SHOULD FLOW THROUGH A SILT FENCE DITCH CHECK, NOT OVER IT. SILT FENCE DITCH CHECKS OFTEN FAIL WHEN OVERTOPPED. SILT FENCE DITCH CHECKS SHOULD BE PLACED PERPENDICULAR TO THE FLOWLINE OF THE DITCH. THE SILT FENCE SHOULD EXTEND FAR ENOUGH SO THAT THE GROUND LEVEL AT THE ENDS OF THE FENCE IS HIGHER THAN THE TOP OF THE LOW POINT OF THE FENCE. THIS PREVENTS WATER FROM FLOWING AROUND THE CHECK. SILT FENCE DITCH CHECKS SHOULD NOT BE PLACED IN DITCHES WHERE HIGH FLOWS ARE EXPECTED. ROCK CHECKS SHOULD BE USED INSTEAD. SILT FENCE SHOULD BE PLACED IN DITCHES WITH SLOPES OF 6% OR LESS. FOR SLOPES STEEPER THAN 6%, ROCK CHECKS SHOULD BE USED.

THE FOLLOWING TABLE PROVIDES CHECK SPACING FOR A GIVEN DITCH GRADE:

DITCH CHECK DITCH GRADE (%)	SPACING CHECK SPACING (FEET)
0.5	200
1.0	200
2.0	100
3.0	65
4.0	50
5.0	40
6.0	30

PROPER INSTALLATION METHOD:
EXCAVATE A TRENCH PERPENDICULAR TO THE DITCH FLOWLINE THAT IS AT LEAST 12" DEEP BY 6" WIDE. EXTEND THE TRENCH IN A STRAIGHT LINE ALONG THE ENTIRE LENGTH OF THE PROPOSED DITCH CHECK. PLACE THE SOIL ON THE UPSTREAM SIDE OF THE TRENCH FOR LATER USE. ROLL OUT A CONTINUOUS LENGTH OF SILT FENCE FABRIC ON THE DOWNSLOPE SIDE OF THE TRENCH. PLACE THE EDGE OF THE FABRIC IN THE TRENCH STARTING AT THE TOP UPSLOPE EDGE OF THE TRENCH. LINE TWO SIDES OF THE TRENCH WITH THE FABRIC AS SHOWN ON DETAIL. BACKFILL OVER THE FABRIC IN THE TRENCH WITH THE EXCAVATED SOIL AND COMPACT. AFTER FILLING THE TRENCH, APPROXIMATELY 24" TO 36" OF SILT FENCE FABRIC SHOULD REMAIN EXPOSED. LAY THE EXPOSED SILT FENCE ON THE UPSLOPE SIDE OF THE TRENCH TO CLEAR AN AREA FOR DRIVING IN THE POSTS. JUST DOWNSLOPE OF THE TRENCH, DRIVE POSTS INTO THE GROUND TO A DEPTH OF AT LEAST 24". PLACE POSTS NO MORE THAN 4' APART. ATTACH THE SILT FENCE TO THE ANCHORED POST WITH STAPLES, WIRE, ZIP TIES, OR NAILS.

LIST OF COMMON PLACEMENT/INSTALLATION MISTAKES TO AVOID:
WATER SHOULD FLOW THROUGH A SILT FENCE DITCH CHECK—NOT OVER IT. PLACE SILT FENCE IN DITCHES WHERE IT IS UNLIKELY THAT IT WILL BE OVERTOPPED. SILT FENCE INSTALLATIONS QUICKLY DETERIORATE WHEN WATER OVERTOPS THEM. DO NOT PLACE SILT FENCE POSTS ON THE UPSLOPE SIDE OF THE SILT FENCE FABRIC. IN THIS CONFIGURATION, THE FORCE OF THE WATER IS NOT RESTRICTED BY THE POSTS, BUT ONLY BY THE STAPLES (WIRE, ZIP TIES, NAILS, ETC.). THE SILT FENCE WILL RIP AND FAIL. DO NOT PLACE A SILT FENCE DITCH CHECK DIRECTLY IN FRONT OF A CULVERT OUTLET. IT WILL NOT STAND UP TO THE CONCENTRATED FLOW. DO NOT PLACE SILT FENCE DITCH CHECKS IN DITCHES THAT WILL LIKELY EXPERIENCE HIGH FLOWS. THEY WILL NOT STAND UP TO CONCENTRATED FLOW. FOLLOW PRESCRIBED DITCH CHECK SPACING GUIDELINES. IF SPACING GUIDELINES ARE EXCEEDED, EROSION WILL OCCUR BETWEEN THE DITCH CHECKS. DO NOT ALLOW WATER TO FLOW AROUND THE DITCH CHECK. MAKE SURE THAT THE DITCH CHECK IS LONG ENOUGH SO THAT THE GROUND LEVEL AT THE ENDS OF THE FENCE IS HIGHER THAN THE LOW POINT ON THE TOP OF THE FENCE. DO NOT PLACE SILT FENCE DITCH CHECKS IN CHANNELS WITH SHALLOW SOILS UNDERLAIN BY ROCK. IF THE CHECK IS NOT ANCHORED SUFFICIENTLY, IT WILL WASH OUT.

INSPECTION AND MAINTENANCE:
SILT FENCE DITCH CHECKS SHOULD BE INSPECTED EVERY 7 DAYS AND WITHIN 24 HOURS OF A RAINFALL OF 1/2" OR MORE. THE FOLLOWING IS A LIST OF QUESTIONS THAT SHOULD BE ADDRESSED DURING EACH INSPECTION:
DOES WATER FLOW AROUND THE DITCH CHECK?
DOES WATER FLOW UNDER THE DITCH CHECK?
DOES THE SILT FENCE SAG EXCESSIVELY?
HAS THE SILT FENCE TORN OR BECOME DETACHED FROM THE POSTS?
DOES SEDIMENT NEED TO BE REMOVED FROM BEHIND THE DITCH CHECK?

ANCHOR TRENCH DETAIL

**SILT FENCE BARRIERS FOR AREA INLETS
(INLET PROTECTION)**

MATERIAL SPECIFICATION:
SILT FENCE FABRIC SHOULD CONFORM TO THE AASHTO M288 96 SILT FENCE SPECIFICATION. THE WIRE OR POLYMERIC MESH BACKING USED TO HELP SUPPORT THE SILT FENCE FABRIC SHOULD CONFORM TO THE AASHTO M288 96 SILT FENCE SPECIFICATION. THE POSTS USED TO SUPPORT THE SILT FENCE FABRIC SHOULD BE A HARDWOOD MATERIAL WITH THE FOLLOWING MINIMUM DIMENSIONS: 2" SQUARE (NOMINAL) BY 4" LONG. THE MATERIAL USED TO FRAME THE TOPS OF THE POSTS SHOULD BE 1" BY 4" BOARDS. SILT FENCE FABRIC AND SUPPORT BACKING SHOULD BE ATTACHED TO THE WOODEN POSTS AND FRAME WITH STAPLES, WIRE, ZIP TIES, OR NAILS.

PLACEMENT:
PLACE A SILT FENCE DROP INLET BARRIER IN A LOCATION WHERE IT IS UNLIKELY TO BE OVERTOPPED. WATER SHOULD FLOW THROUGH SILT FENCE, NOT OVER IT. SILT FENCE BARRIERS FOR AREA INLETS OFTEN FAIL WHEN REPEATEDLY OVERTOPPED. WHEN USED AS A BARRIER FOR AREA INLETS, SILT FENCE FABRIC AND POSTS MUST BE SUPPORTED AT THE TOP BY A WOODEN FRAME. WHEN A SILT FENCE BARRIER FOR AREA INLETS IS LOCATED NEAR AN INLET THAT HAS STEEP APPROACH SLOPES, THE STORAGE CAPACITY BEHIND THE BARRIER IS DRAMATICALLY REDUCED. TIMELY REMOVAL OF SEDIMENT MUST OCCUR FOR A BARRIER TO OPERATE PROPERLY IN THIS LOCATION.

PROPER INSTALLATION METHOD:
EXCAVATE A TRENCH AROUND THE PERIMETER OF THE AREA INLET THAT IS AT LEAST 8" DEEP BY 8" WIDE. DRIVE POSTS TO A DEPTH OF AT LEAST 18" AROUND THE PERIMETER OF THE AREA INLET. THE DISTANCE BETWEEN POSTS SHOULD BE 4' OR LESS. IF THE DISTANCE BETWEEN TWO ADJACENT CORNER POSTS IS MORE THAN 4', ADD ANOTHER POST(S) BETWEEN THEM. CONNECT THE TOPS OF ALL THE POSTS WITH A WOODEN FRAME MADE OF 1" BY 4" BOARDS. USE NAILS OR SCREWS FOR FASTENING. ATTACH THE WIRE OR POLYMERIC-MESH BACKING TO THE OUTSIDE OF THE POST/FRAME STRUCTURE WITH STAPLES, WIRE, ZIP TIES, OR NAILS. ROLL OUT A CONTINUOUS LENGTH OF SILT FENCE FABRIC LONG ENOUGH TO WRAP AROUND THE PERIMETER OF THE AREA INLET. ADD MORE LENGTH FOR OVERLAPPING THE FABRIC JOINT. PLACE THE EDGE OF THE FABRIC IN THE TRENCH, STARTING AT THE OUTSIDE EDGE OF THE TRENCH. LINE ALL THREE SIDES OF THE TRENCH WITH THE FABRIC. BACKFILL OVER THE FABRIC IN THE TRENCH WITH THE EXCAVATED SOIL AND COMPACT. AFTER FILLING THE TRENCH, APPROXIMATELY 24" TO 36" OF SILT FENCE FABRIC SHOULD REMAIN EXPOSED. ATTACH THE SILT FENCE TO THE OUTSIDE OF THE POST/FRAME STRUCTURE WITH STAPLES, WIRE, ZIP TIES, OR NAILS. THE JOINT SHOULD BE OVERLAPPED TO THE NEXT POST.

NOTE: WHEN A SILT FENCE BARRIER FOR AREA INLET IS PLACED IN A SHALLOW MEDIAN DITCH, MAKE SURE THAT THE TOP OF THE BARRIER IS NOT HIGHER THAN THE PAVED ROAD. IN THIS CONFIGURATION, WATER MAY SPREAD ONTO THE ROADWAY CAUSING A HAZARDOUS CONDITION.

LIST OF COMMON PLACEMENT/INSTALLATION MISTAKES TO AVOID:
WATER SHOULD FLOW THROUGH A SILT FENCE BARRIER FOR AREA INLET—NOT OVER IT. PLACE A SILT FENCE BARRIER FOR AREA INLET IN A LOCATION WHERE IT IS UNLIKELY TO BE OVERTOPPED. SILT FENCE BARRIER FOR AREA INLETS OFTEN FAIL WHEN REPEATEDLY OVERTOPPED. DO NOT PLACE POSTS ON THE OUTSIDE OF THE SILT FENCE BARRIER FOR AREA INLET. IN THIS CONFIGURATION, THE FORCE OF THE WATER IS NOT RESTRICTED BY THE POSTS, BUT ONLY BY THE STAPLES (WIRE, ZIP TIES, NAILS, ETC.). THE SILT FENCE WILL RIP AND FAIL. DO NOT INSTALL SILT FENCE BARRIER FOR AREA INLETS WITHOUT FRAMING THE TOP OF THE POSTS. THE CORNER POSTS AROUND AREA INLETS ARE STRESSED IN TWO DIRECTIONS WHEREAS A NORMAL SILT FENCE IS ONLY STRESSED IN ONE DIRECTION. THIS ADDED STRESS REQUIRES MORE SUPPORT.

INSPECTION AND MAINTENANCE:
SILT FENCE BARRIER FOR AREA INLETS SHOULD BE INSPECTED EVERY 7 DAYS AND WITHIN 24 HOURS OF A RAINFALL OF 1/2" OR MORE. THE FOLLOWING IS A LIST OF QUESTIONS THAT SHOULD BE ADDRESSED DURING EACH INSPECTION:
DOES WATER FLOW UNDER THE SILT FENCE?
DOES THE SILT FENCE SAG EXCESSIVELY?
HAS THE SILT FENCE TORN OR BECOME DETACHED FROM THE POSTS?
DOES SEDIMENT NEED TO BE REMOVED FROM BEHIND THE AREA INLET BARRIER?

SILT FENCE BARRIERS

MATERIAL SPECIFICATION:
SILT FENCE FABRIC SHOULD CONFORM TO THE AASHTO M288 96 SILT FENCE SPECIFICATION. THE POSTS USED TO SUPPORT THE SILT FENCE FABRIC SHOULD BE A HARDWOOD MATERIAL WITH THE FOLLOWING MINIMUM DIMENSIONS: 2" SQUARE (NOMINAL) BY 4" LONG. SILT FENCE FABRIC SHOULD BE ATTACHED TO THE WOODEN POSTS WITH STAPLES, WIRE, ZIP TIES, OR NAILS.

PLACEMENT:
A SLOPE BARRIER SHOULD BE USED AT THE TOE OF A SLOPE WHEN A DITCH DOES NOT EXIST. THE SLOPE BARRIER SHOULD BE PLACED ON NEARLY LEVEL GROUND 5' TO 10' AWAY FROM THE TOE OF A SLOPE. THE BARRIER IS PLACED AWAY FROM THE TOE OF THE SLOPE TO PROVIDE ADEQUATE STORAGE FOR SETTLING OUT SEDIMENT. WHEN PRACTICABLE, SILT FENCE SLOPE BARRIERS SHOULD BE PLACED ALONG CONTOURS TO AVOID A CONCENTRATION OF FLOW. SILT FENCE SLOPE BARRIERS CAN ALSO BE PLACED ALONG RIGHT-OF-WAY FENCE LINES TO KEEP SEDIMENT FROM CROSSING ONTO ADJACENT PROPERTY. WHEN PLACED IN THIS MANNER, THE SLOPE BARRIER WILL NOT LIKELY FOLLOW CONTOURS.

PROPER INSTALLATION METHOD:
EXCAVATE A TRENCH THE LENGTH OF THE PLANNED SLOPE BARRIER THAT IS 6" DEEP BY 4" WIDE. MAKE SURE THAT THE TRENCH IS EXCAVATED ALONG A SINGLE CONTOUR. WHEN PRACTICABLE, SLOPE BARRIERS SHOULD BE PLACED ALONG CONTOURS TO AVOID A CONCENTRATION OF FLOW. PLACE THE SOIL ON THE UPSLOPE SIDE OF THE TRENCH FOR LATER USE. ROLL OUT A CONTINUOUS LENGTH OF SILT FENCE FABRIC ON THE DOWNSLOPE SIDE OF THE TRENCH. PLACE THE EDGE OF THE FABRIC IN THE TRENCH STARTING AT THE TOP UPSLOPE EDGE. LINE ALL THREE SIDES OF THE TRENCH WITH THE FABRIC. BACKFILL OVER THE FABRIC IN THE TRENCH WITH THE EXCAVATED SOIL AND COMPACT. AFTER FILLING THE TRENCH, APPROXIMATELY 24" TO 36" OF SILT-FENCE FABRIC SHOULD REMAIN EXPOSED. LAY THE EXPOSED SILT FENCE UPSLOPE OF THE TRENCH TO CLEAR AN AREA FOR DRIVING IN THE POSTS. JUST DOWNSLOPE OF THE TRENCH, DRIVE POSTS INTO THE GROUND TO A DEPTH OF AT LEAST 18". PLACE POSTS NO MORE THAN 4' APART. ATTACH THE SILT FENCE TO THE ANCHORED POST WITH STAPLES, WIRE, ZIP TIES, OR NAILS.

LIST OF COMMON PLACEMENT/INSTALLATION MISTAKES TO AVOID:
WHEN PRACTICABLE, DO NOT PLACE SILT FENCE SLOPE BARRIERS ACROSS CONTOURS. SLOPE BARRIERS SHOULD BE PLACED ALONG CONTOURS TO AVOID A CONCENTRATION OF FLOW. WHEN THE FLOW CONCENTRATES, IT OVERTOPS THE BARRIER AND THE SILT FENCE SLOPE BARRIER QUICKLY DETERIORATES. DO NOT PLACE SILT-FENCE POSTS ON THE UPSLOPE SIDE OF THE SILT FENCE FABRIC. IN THIS CONFIGURATION, THE FORCE OF THE WATER IS NOT RESTRICTED BY THE POSTS, BUT ONLY BY THE STAPLES (WIRE, ZIP TIES, NAILS, ETC.). THE SILT FENCE WILL RIP AND FAIL. DO NOT PLACE SILT FENCE SLOPE BARRIERS IN AREAS WITH SHALLOW SOILS UNDERLAIN BY ROCK. IF THE BARRIER IS NOT SUFFICIENTLY ANCHORED, IT WILL WASH OUT. SILT FENCE SLOPE BARRIERS MUST BE DUG INTO THE GROUND—SILT FENCE AT GROUND LEVEL DOES NOT WORK BECAUSE WATER WILL FLOW UNDERNEATH.

INSPECTION AND MAINTENANCE:
SILT FENCE SLOPE BARRIERS SHOULD BE INSPECTED EVERY 7 DAYS AND WITHIN 24 HOURS OF A RAINFALL OF 1/2" OR MORE. THE FOLLOWING IS A LIST OF QUESTIONS THAT SHOULD BE ADDRESSED DURING EACH INSPECTION:
ARE THERE ANY POINTS ALONG THE SLOPE BARRIER WHERE WATER IS CONCENTRATING?
DOES WATER FLOW UNDER THE SLOPE BARRIER?
DOES THE SILT FENCES SAG EXCESSIVELY?
HAS THE SILT FENCE TORN OR BECOME DETACHED FROM THE POSTS?
DOES SEDIMENT NEED TO BE REMOVED FROM BEHIND THE SLOPE BARRIER?

CITY OF WICHITA

PUBLIC WORKS & UTILITIES
ENGINEERING DIVISION

**SILT FENCE DITCH CHECK
AND BARRIER DETAILS**

CITY ENGINEER
GARY JANZEN, P.E.

PROJECT NUMBER	OCA NUMBER	DATE

CITY ENGINEER'S OFFICE
CITY HALL SEVENTH FLOOR
438 NORTH MAIN STREET
WICHITA, KANSAS 67202-1620
(316) 268-4501

SHEET

REVISION DATE: MAY 2013

5W-502

Saved 05-29-2015 8:01:34 AM by: CJS
U:\Projects\2015\15102\02\151020202\151020202-006-063-EROSION CONTROL DETAILS

DATE	PURPOSE	NO.
05.11.2015	75% OWNER REVIEW	1
05.29.2015	PERMIT SET/BID SET	2
06.12.2015	ADDENDUM 1	1
08.19.2015	ADDENDUM 2	2
08.17.2015	ADDENDUM 3	3
09.15.2015	CCD 1	4
09.30.2015	CCD 2	5
10.19.2015	CCD 3	6

ENTIRE SHEET

**OXFORD VILLA
WICHITA, KS**



LKArchitecture



Architecture • Engineering • Planning • Interior Design • Landscape Architecture

GENERAL NOTES

- THIS SHEET IS INTENDED TO PROVIDE GUIDELINES AS TO WHAT TYPES OF EROSION CONTROL DEVICES WILL BE INSTALLED DURING THE CONSTRUCTION PROCESS. CONTRACTORS ARE EXPECTED TO BID PROJECTS ACCORDINGLY.
- EROSION CONTROL DEVICES MUST BE MAINTAINED BY THE CONTRACTOR THROUGHOUT THE CONSTRUCTION PROCESS AND UNTIL THE DISTURBED EARTH IS RESTABILIZED.
- IF THE PROJECT WILL DISTURB 1 ACRE OR MORE, A FEDERAL/STATE NPDES STORMWATER PERMIT IS REQUIRED. A DETAILED STORMWATER POLLUTION PREVENTION PLAN IS REQUIRED. THE EROSION CONTROL DEVICES SHOWN ON THIS SHEET ARE CONSIDERED TO BE THE MINIMUM TO BE SHOWN IN THE POLLUTION PREVENTION PLAN.
- FOR PROJECTS DISTURBING LESS THAN 1 ACRE, CONTRACTORS ARE ENCOURAGED TO PREPARE STORMWATER POLLUTION PREVENTION PLANS PRIOR TO CONSTRUCTION. EROSION CONTROL DEVICES MUST BE USED ON ALL PROJECTS.
- FAILURE TO USE AND MAINTAIN EROSION CONTROL DEVICES IS A VIOLATION OF SECTION 16.32 OF THE CITY CODE AND WILL SUBJECT THE CONTRACTOR TO THE PENALTIES PROVIDED FOR THEREIN.
- THE APPLICATION OF EROSION CONTROL DEVICES SHOWN ON THIS SHEET IS FOR SITUATIONS NORMALLY ENCOUNTERED. FROM TIME TO TIME, SITUATIONS WILL ARISE THAT MAY REQUIRE A DIFFERENT DEVICE OTHER THAN THOSE SHOWN. EROSION CONTROL DEVICES, OTHER THAN THOSE SHOWN, MAY BE UTILIZED AS LONG AS THEY ARE EFFECTIVE AND MAINTAINED.

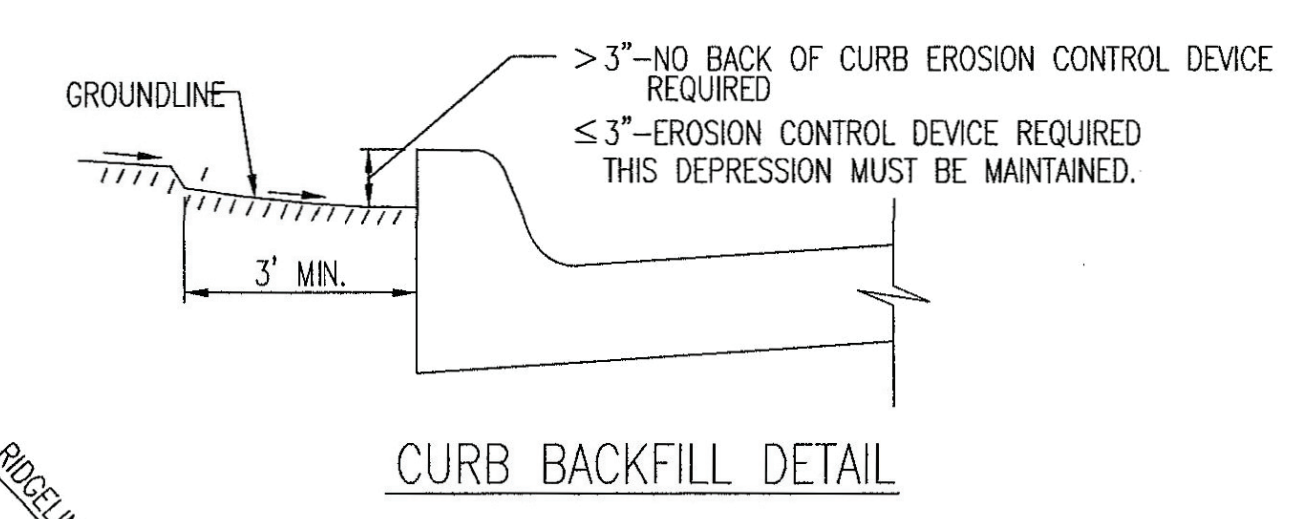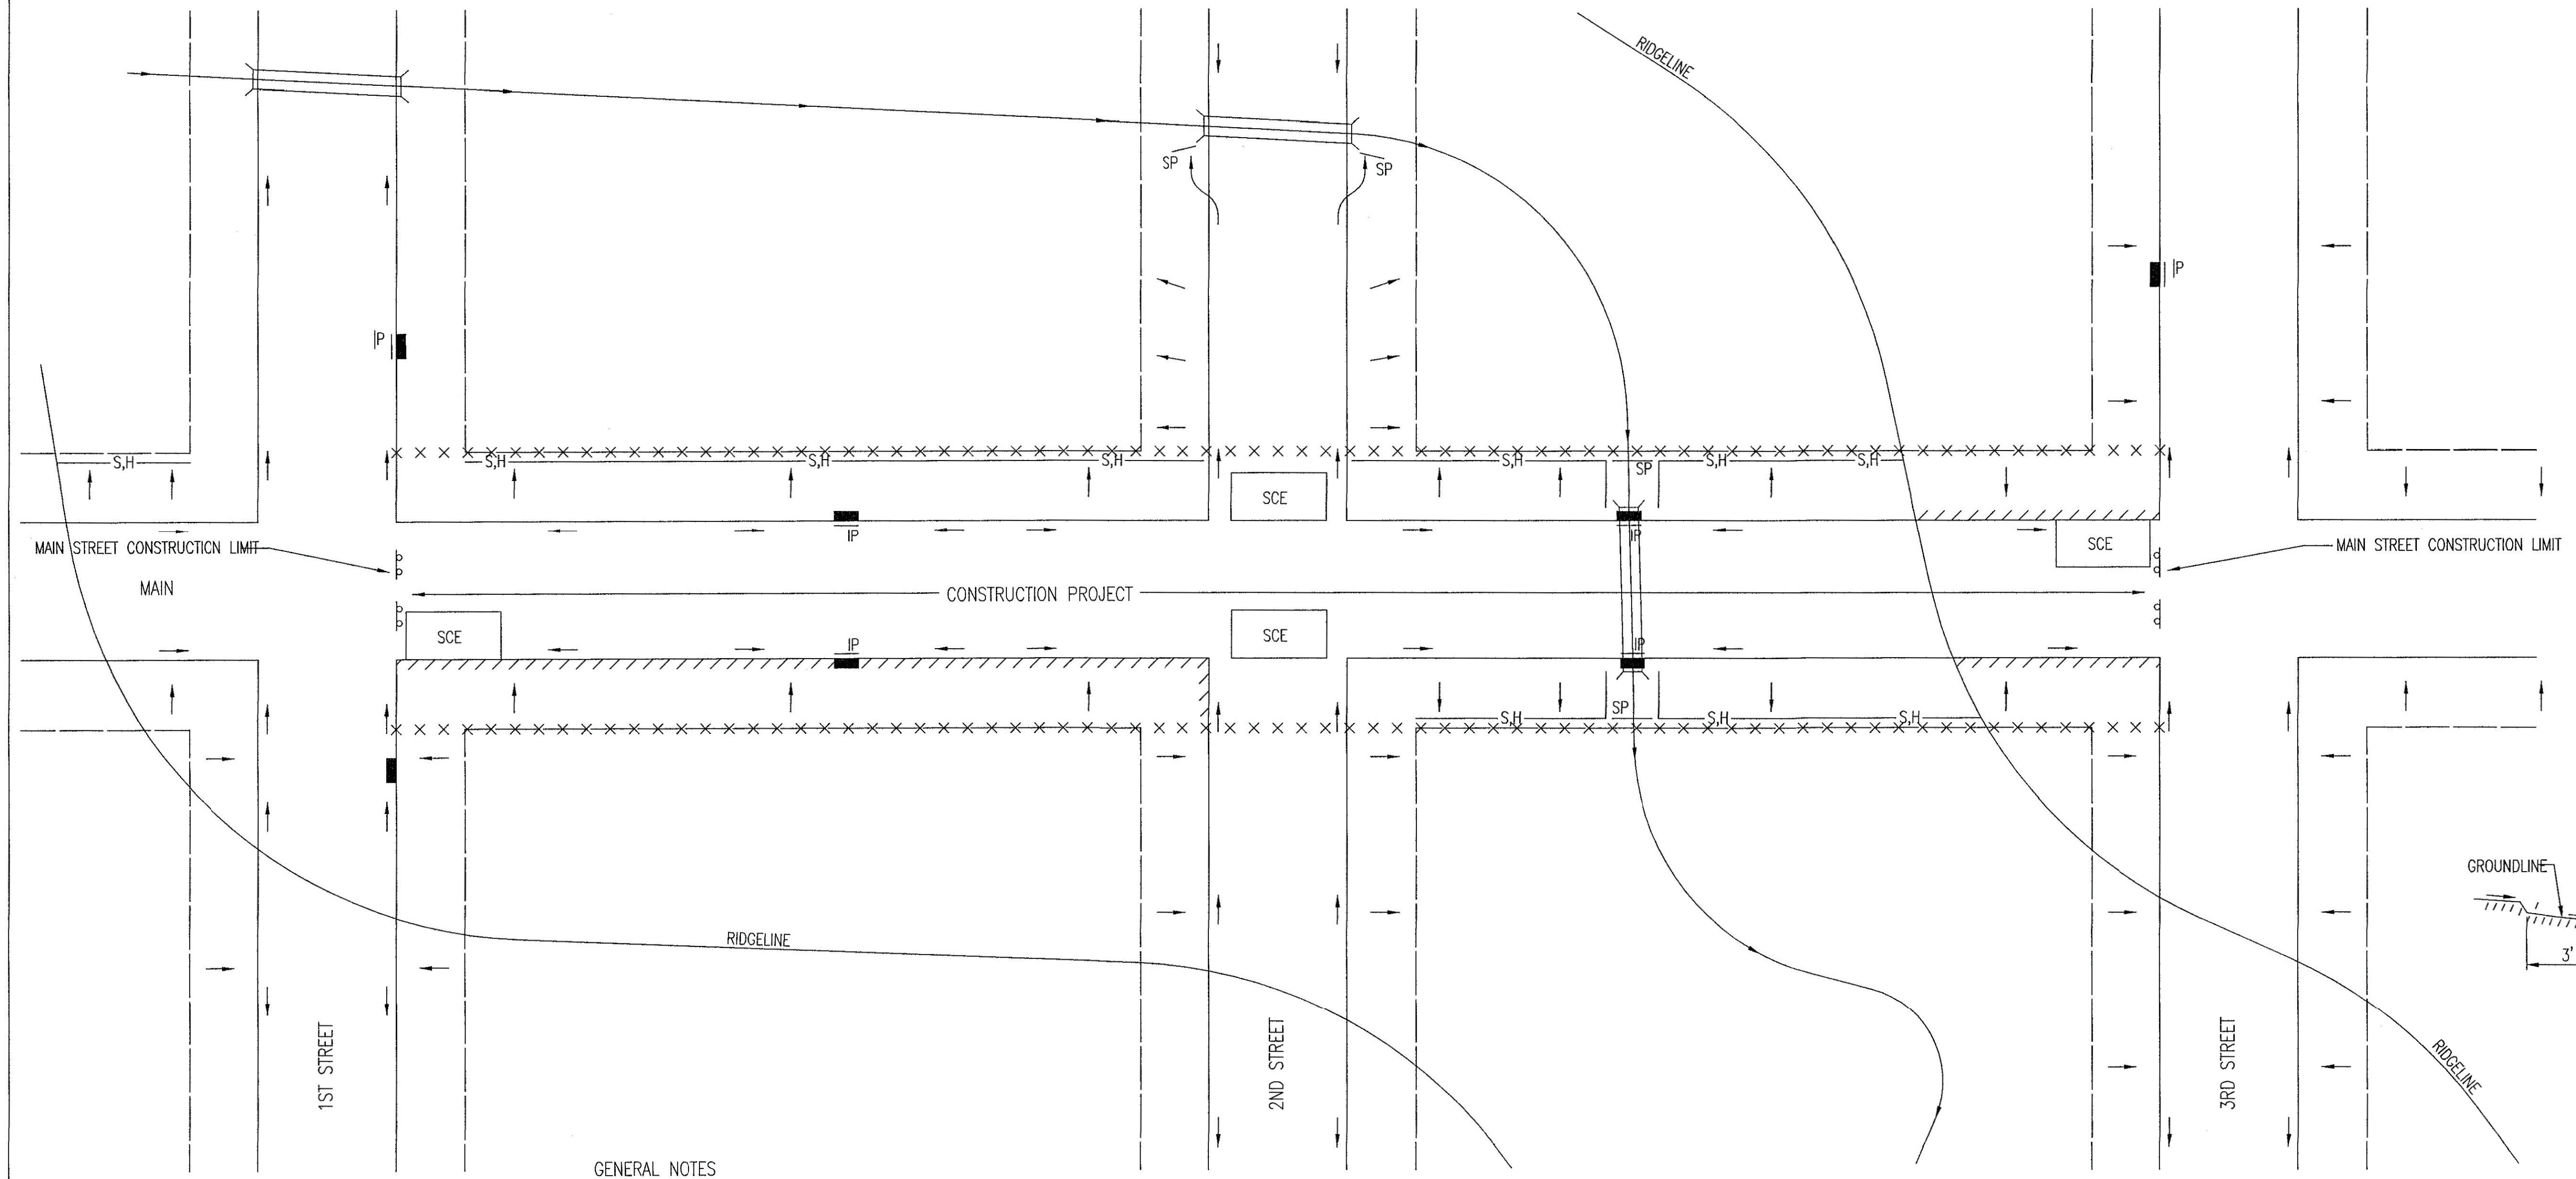


LEGEND

- R-O-W LIMITS
- DRAINAGE FLOW PATH
- x x x x x R/W LIMIT WITHIN CONSTRUCTION LIMIT
- STORM WATER INLETS
- IP INLET PROTECTION
- S.H SILT FENCE OR HAY BALE BARRIER
- SP STREAM PROTECTION
- SCE STABILIZED CONSTRUCTION ENTRANCE
- //// BACK OF CURB PROTECTION

GENERAL NOTES

- THE INTENT OF ALL EROSION CONTROL DEVICES IS TO KEEP ALL SEDIMENT CONFINED TO THE CONSTRUCTION SITE, AND OUT OF ALL UNDERGROUND PIPES, DITCHES, LAKES, AND OTHER DRAINAGE FACILITIES, AND OFF OF STREETS.
- THE POINT OF COMPLIANCE IS GENERALLY THE RIGHT-OF-WAY LINES WITHIN THE LIMITS OF CONSTRUCTION.
- EROSION CONTROL DEVICES WILL BE REQUIRED AT ALL POINTS ALONG THE PROJECT WHERE DISTURBED EARTH CAN DRAIN ONTO PRIVATE PROPERTY.
- INLET PROTECTION DEVICES WILL BE REQUIRED WHEREVER WATER CAN DRAIN OFF THE PROJECT SITE INTO AN INLET, INCLUDING ANY SIDE STREET INLETS.
- EROSION CONTROL DEVICES SHALL BE INSTALLED AT CREEK CROSSINGS SO AS TO PREVENT SEDIMENT FROM ENTERING THEREIN.
- STABILIZED CONSTRUCTION ENTRANCES SHALL BE PROVIDED, AS NEEDED, TO PREVENT MUD FROM TRACKING ONTO STREETS NOT UNDER CONSTRUCTION AND ON STREETS WITHIN THE PROJECT LIMITS IF TRAFFIC IS BEING MAINTAINED THROUGH THE PROJECT.
- ANY MUD TRACKED ONTO STREETS MUST BE REMOVED AT THE END OF EACH WORK DAY.
- THE CONTRACTOR WILL BE REQUIRED TO PLACE EROSION CONTROL DEVICES BACK OF CURB, WHENEVER WATER CAN DRAIN OVER CURB, TO KEEP ERODED SOIL OUT OF THE GUTTERLINES, IN ACCORDANCE WITH THE FOLLOWING:
 - THE DEVICE REQUIRED WILL BE APPROVED EROSION CONTROL MAT LISTED ON THE CITY'S APPROVED MATERIAL LIST. SAID BLANKET SHALL BE PLACED OVER THE APPROPRIATE SEED AND FERTILIZER, AS SPECIFIED IN THE PROJECT SPECIFICATIONS. (SEE SOIL EROSION BMPs - BACK OF CURB SEDIMENT BARRIER DETAILS)
 - THIS DEVICE SHALL BE INSTALLED IMMEDIATELY WHENEVER THE CURB IS BACKFILLED TO WITHIN 3" OF THE TOP OF CURB. (SEE CURB BACKFILL DETAIL)
 - OTHER BMP'S MAY BE REQUIRED AT LOCATIONS WHERE CONCENTRATED FLOW CARRIES SEDIMENT OVER THE CURB.
 - ADDITIONALLY, OTHER EROSION CONTROL DEVICES (HAY BALES, SILT FENCE, ETC.) WILL BE INSTALLED AT LOCATIONS OF CONCENTRATED FLOW RESULTING IN SEDIMENT OVERRUNNING THE MAT.
 - SHOULD THE PROJECT PLANS SPECIFY THAT THE RIGHT-OF-WAY IS TO BE SODDED, THE EXCELSIOR MAT WILL NOT BE REQUIRED SO LONG AS THE SOD IS PLACED WITHIN 48 HOURS AFTER CURB BACKFILL REACHES A HEIGHT OF 3" OR LESS FROM TOP OF CURB. (SEE CURB BACKFILL DETAIL)

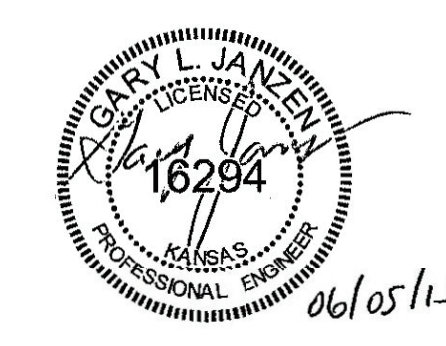

REVISION: JUNE 2015


STREET IMPROVEMENT PROJECTS		
CITY ENGINEER GARY JANZEN, P.E.		
PROJECT NUMBER	OCA NUMBER	DATE
CITY ENGINEER'S OFFICE		SHEET
CITY HALL - SEVENTH FLOOR 455 NORTH MAIN STREET WICHITA, KANSAS 67202-1620 (316) 268-4501		

SW-504

Saved: 08-04-2015 2:12:05 PM by: CSL
 H:\Projects - 2015\15101\02\15101_02_005_005-065-EROSION CONTROL DETAILS


DATE	PURPOSE	NO.
05.11.2015	75% OWNER REVIEW	
05.29.2015	PERMIT SET/BID SET	
06.12.2015	ADDENDUM 1	1
08.10.2015	ADDENDUM 2	2
08.17.2015	ADDENDUM 3	3
09.15.2015	CCD 1	4
09.30.2015	CCD 2	5
10.19.2015	CCD 3	6

PHASE 1 – INITIAL EARTHWORK AND UTILITIES (EXCEPT STORM SEWER)

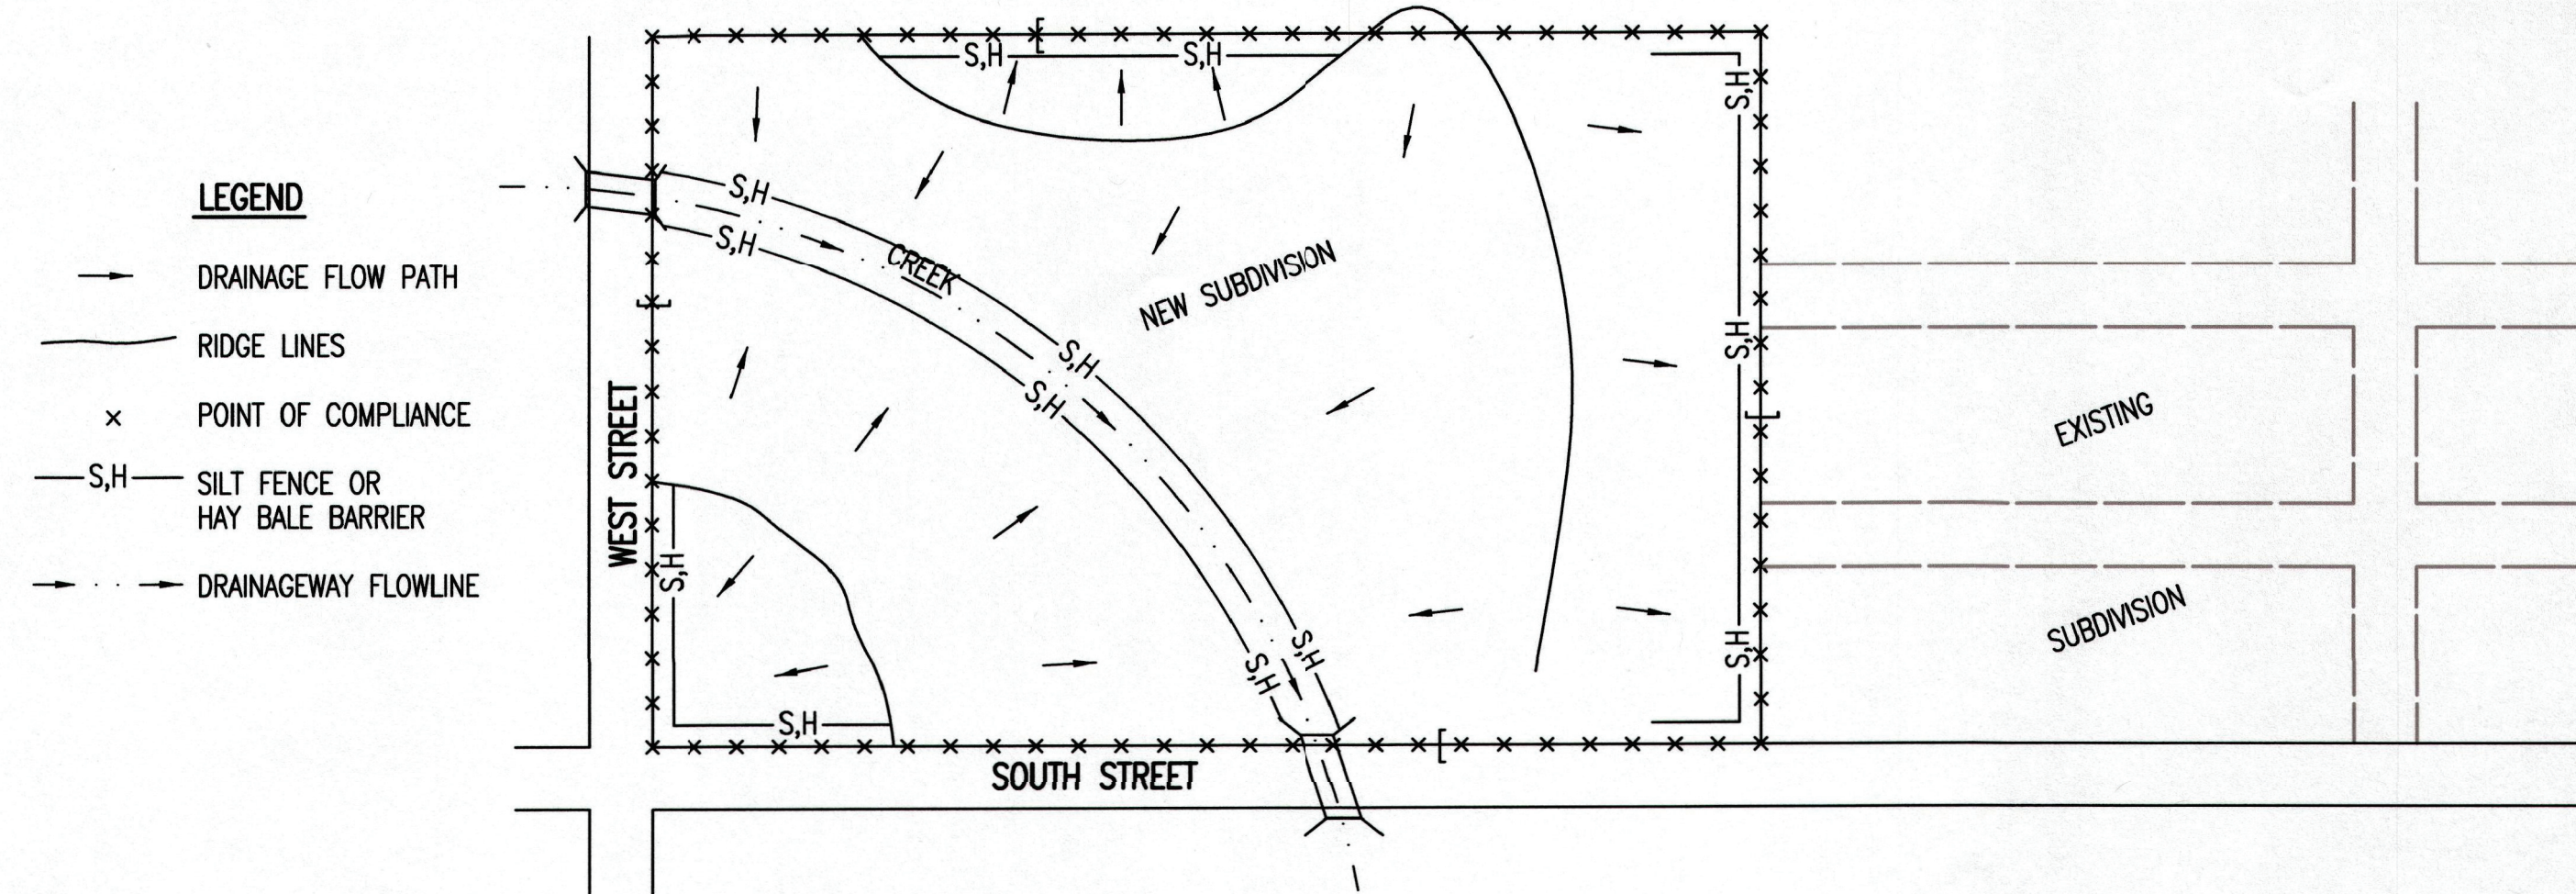


- DURING THIS PHASE OF SUBDIVISION CONSTRUCTION, THE POINTS OF COMPLIANCE ARE THE PERIMETER BOUNDARIES AND ANY DRAINAGE WAYS OR STORM SEWERS DRAINING THROUGH OR FROM THE SITE. SHOULD LAKES BE CONSTRUCTED WITHIN THE SUBDIVISION THAT WILL DISCHARGE DURING STORMS, THEY ARE ALSO A POINT OF COMPLIANCE.
- HAY BALES OR SILT FENCE MUST BE CONSTRUCTED ALONG THE PROPERTY LINE WHERE ON SITE WATER CAN DRAIN OFF THE PROPERTY. THESE EROSION CONTROL DEVICES WILL ALSO BE INSTALLED ALONG ANY DRAINAGE DITCH OR LAKE THAT CAN DISCHARGE.
- SHOULD SILT OR SEDIMENT ENTER THE DITCHES OR STREETS ON THE ADJACENT BOUNDARY STREETS, APPROPRIATE EROSION CONTROL DEVICES WILL BE PLACED WITHIN THE SUBDIVISION TO PREVENT THIS.
- ANY MUD TRACKED ONTO ADJACENT STREETS WILL BE REMOVED WITHIN 48 HOURS OR BY FRIDAY AT 6:00 PM, WHICHEVER IS EARLIER.
- CONTRACTORS WORKING WITHIN THE SITE WILL NOT BE REQUIRED TO USE INDIVIDUAL EROSION CONTROL DEVICES AS LONG AS THOSE SPECIFIED ABOVE ARE IN PLACE AND EFFECTIVE. CONTRACTORS WORKING ON THE BOUNDARY LINE STREETS OR ON ADJACENT PROPERTIES TO EXTEND UTILITIES ARE EXPECTED TO USE EROSION CONTROL DEVICES AT THEIR WORK LOCATIONS, AS NEEDED.
- UTILIZE STABILIZED CONSTRUCTION ENTRANCE AT ENTRANCE AND EXIT ONTO ANY EXISTING PUBLIC STREETS.
- IF THE INITIAL EARTH WORK AND UTILITIES ARE DONE AS PART OF A PUBLIC IMPROVEMENT PROJECT, THESE EROSION CONTROL DEVICES WILL BE INSTALLED BY THE CONTRACTOR AS SPECIFIED IN THE INDIVIDUAL PROJECT CONTRACTS. THE CONTRACTOR WILL MAINTAIN THE DEVICES UNTIL COMPLETION OF THE CONTRACT, AT WHICH TIME THE DEVELOPER WILL ASSUME MAINTENANCE RESPONSIBILITIES. IF THESE CONTRACTS ARE NOT PUBLIC IMPROVEMENT PROJECTS, THE DEVELOPER WILL BE RESPONSIBLE FOR INSTALLING AND MAINTAINING THESE DEVICES.
- WITHIN 14 DAYS OF COMPLETION OF EARTHWORK ACTIVITIES IN ANY GIVEN AREA, THAT AREA SHALL BE TEMPORARILY OR PERMANENTLY SEEDED AND MULCHED.

PHASE 3 – STREET CONSTRUCTION

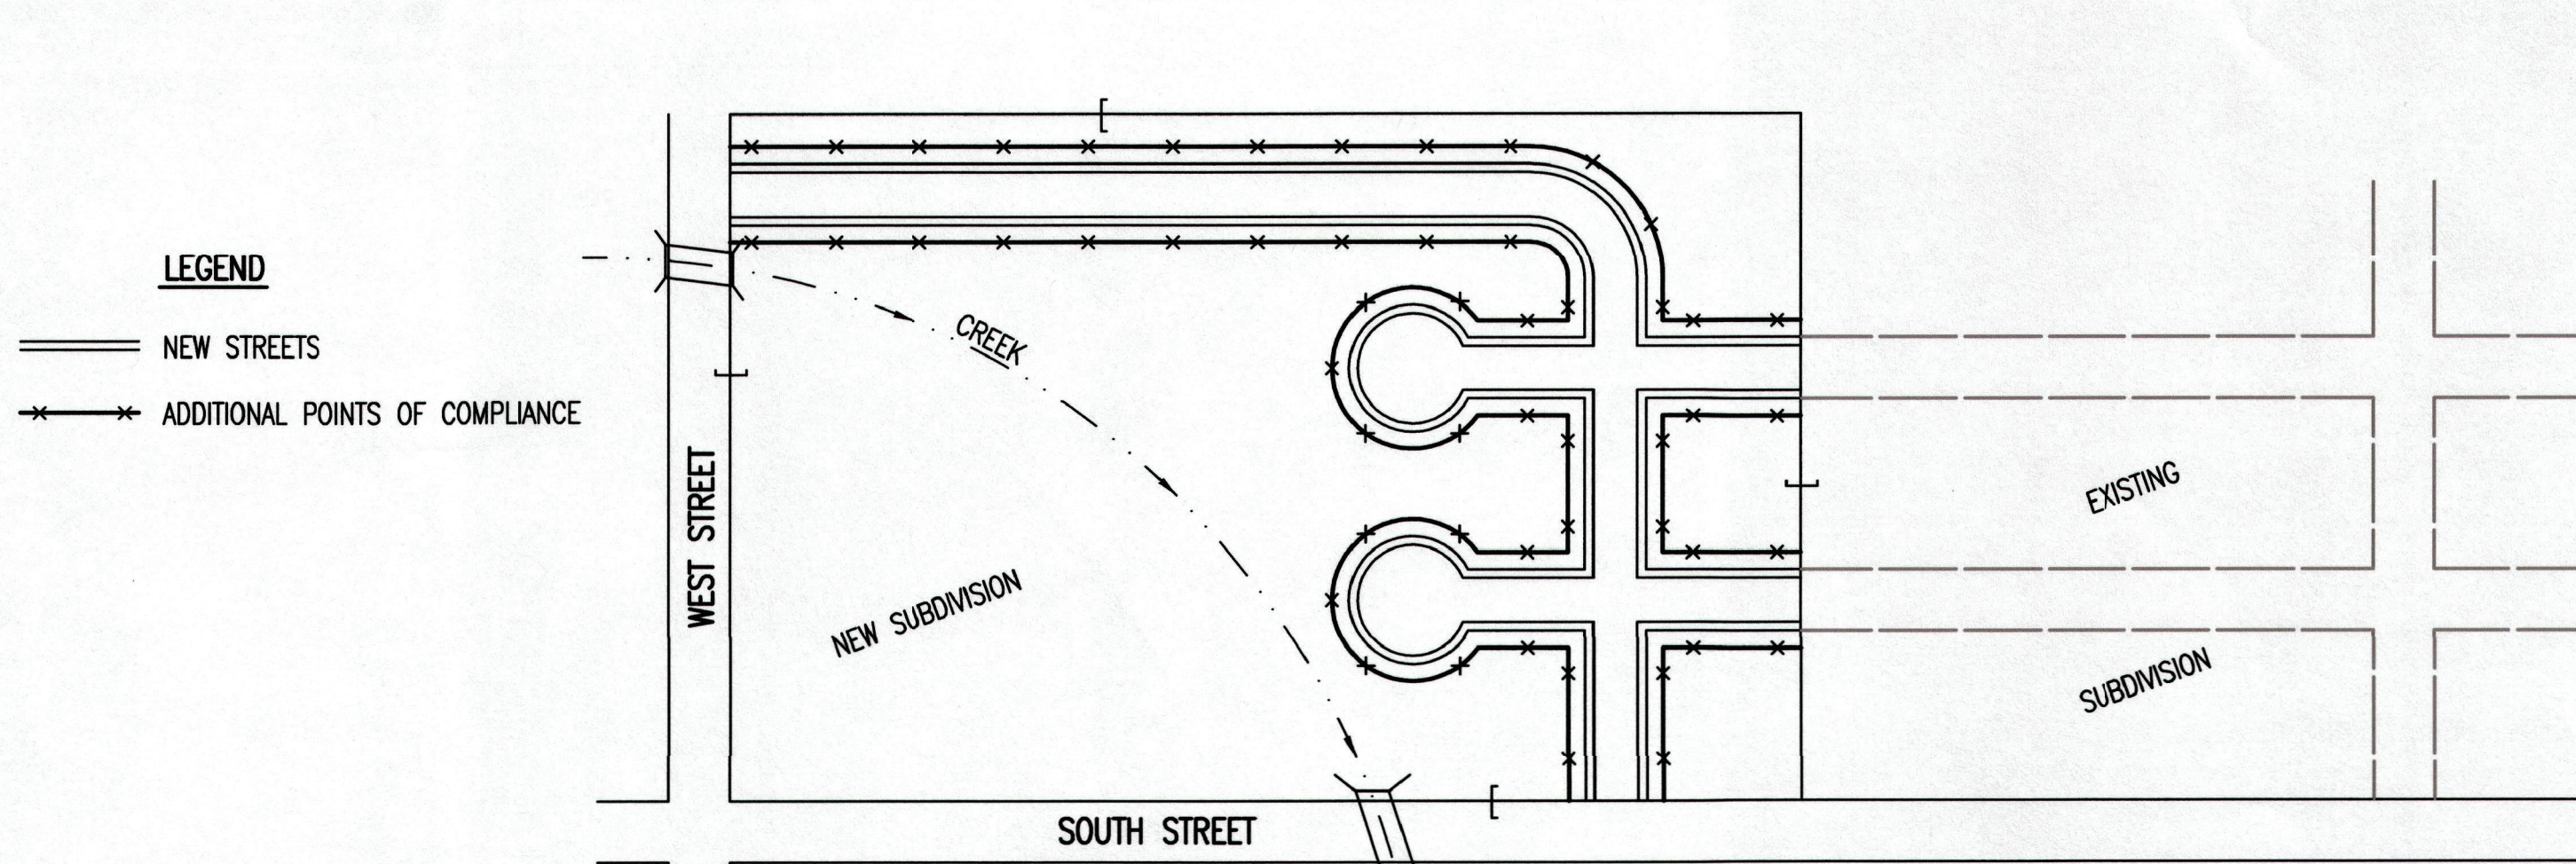

- DURING THIS PHASE OF SUBDIVISION CONSTRUCTION, NEW STREETS ARE INSTALLED. ALL EROSION CONTROL DEVICES INSTALLED DURING PHASE 1 AND 2 MUST STILL BE MAINTAINED. THE POINT OF COMPLIANCE NOW SHIFTS TO THE BACK OF CURB ALONG EACH STREET.
- CURB OPENING INLET PROTECTION:
 - SUMP AREAS – INLET PROTECTION SHALL BE PROVIDED WHEN STREET SUBGRADE WORK IS COMPLETED.
 - NON-SUMP LOCATIONS – PROVIDE INLET PROTECTION AS SOON AS BASE COURSE ASPHALT IS INSTALLED, BEFORE THE SURFACE COURSE LIFT.
- EROSION CONTROL DEVICES WILL BE REQUIRED BACK OF CURB WHEREVER WATER CAN FLOW OVER THE CURB AND THE CURB HAS BEEN BACKFILLED TO WITHIN 3" OR LESS OF THE TOP OF CURB (SEE CURB BACKFILL DETAIL). FOR CURBS NOT YET ENTIRELY BACKFILLED (3" OR MORE BELOW TOP OF CURB), ADDITIONAL DEVICES WILL BE REQUIRED AT POINTS WHERE WATER BREAKS OVER CURB WHICH COULD RESULT IN THE PLACEMENT OF SEDIMENT IN THE GUTTER.
- SEE DETAIL SHEET FOR BACK OF CURB PROTECTION.
- THE BACK OF CURB PROTECTION SPECIFIED ON THIS PLAN MAY HAVE TO BE SUPPLEMENTED WITH HAY BALE OR SILT FENCE EROSION CONTROL DEVICES AT LOCATIONS WHERE CONCENTRATED FLOW RESULTS IN SEDIMENT BEING CARRIED OVER THE EXCELSIOR MATS.
- THE STREET CONTRACTOR WILL BE RESPONSIBLE FOR INSTALLING BACK OF CURB EROSION CONTROL DEVICES.
- THE INDIVIDUAL LOT OWNERS WILL BE RESPONSIBLE FOR MAINTAINING THE BACK OF CURB EROSION CONTROL DEVICES IN FRONT OF THEIR LOTS UNTIL SUCH TIME AS ADJACENT DISTURBED EARTH IS STABILIZED WITH GRASS OR SOD.


PHASE 2 – INSTALLATION OF STORM SEWER

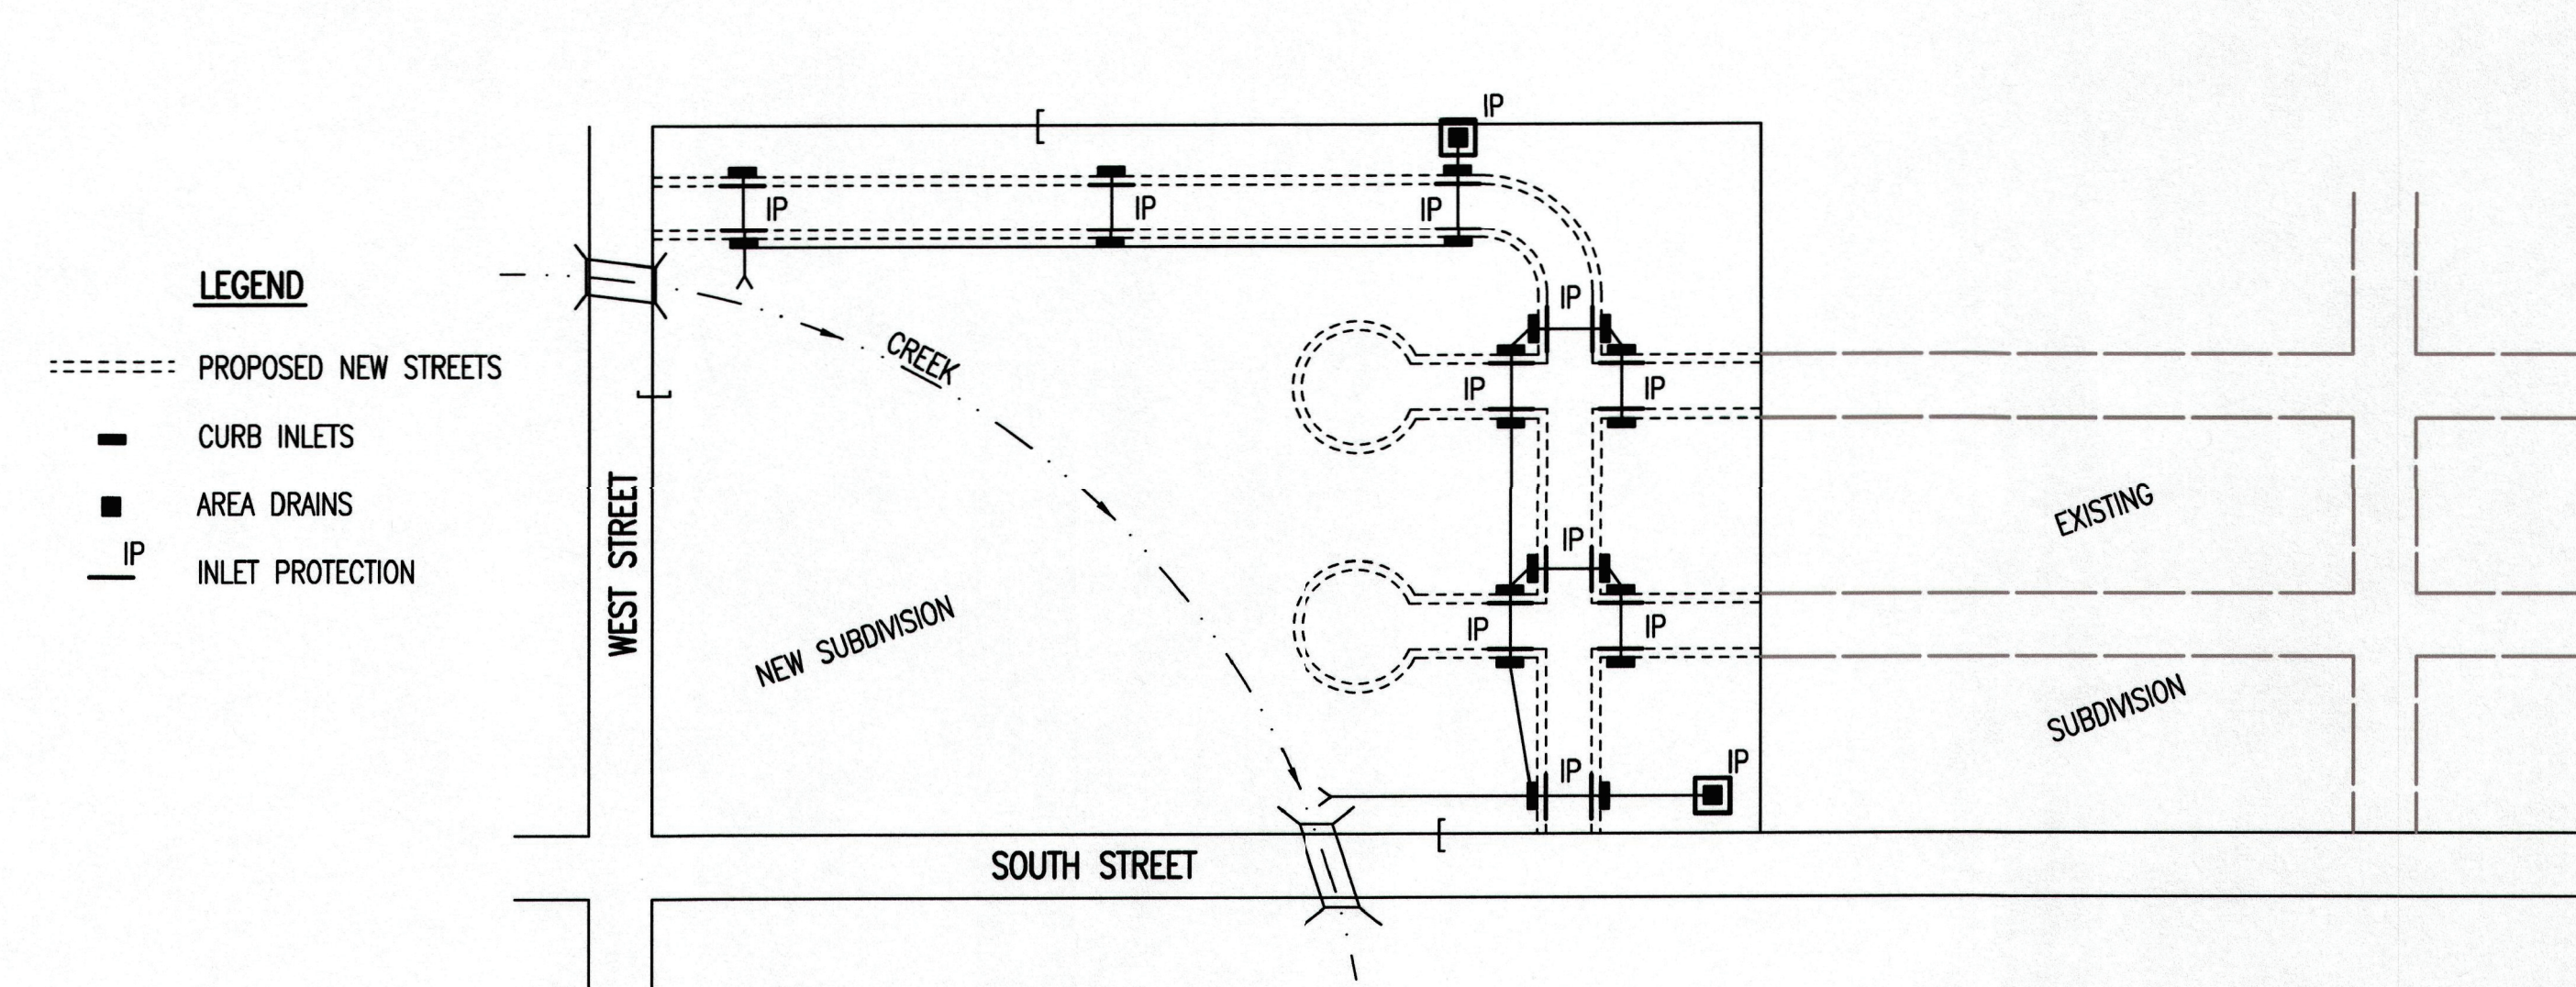

- DURING THIS PHASE OF SUBDIVISION DEVELOPMENT, ALL EROSION CONTROL DEVICES REQUIRED IN PHASE 1 SHALL REMAIN IN PLACE AND BE MAINTAINED.
- AS NEW STORM SEWERS, WITH INLETS, ARE INSTALLED, THE STORM SEWERS MUST NOW BE PROTECTED SO ALL NEW INLETS BECOME POINTS OF COMPLIANCE.
- AREA DRAINS – AS SOON AS WATER CAN FLOW INTO THESE DRAINS, HAY BALE OR SILT FENCE PROTECTION WILL BE INSTALLED AROUND THEM.
- CURB OPENING INLETS – AS SOON AS WATER CAN FLOW INTO THESE DRAINS, INLET PROTECTION DEVICES MUST BE INSTALLED. IF WATER CANNOT FLOW INTO CURB INLETS UNTIL STREET CONSTRUCTION IS COMPLETE, THEN STREET CONTRACTOR WILL INSTALL INLET PROTECTION. SEE PHASE 3 – STREET CONSTRUCTION.
- THE STORM SEWER CONTRACTOR WILL BE RESPONSIBLE FOR INSTALLING THESE DEVICES.
- THE SUBDIVISION DEVELOPER WILL MAINTAIN THESE EROSION CONTROL DEVICES ONCE INSTALLED.
- ALL DISTURBED GROUND WILL BE FINAL GRADED AND TEMPORARILY OR PERMANENTLY SEEDED WITHIN 14 DAYS IF COMPLETION OF WORK IN ANY GIVEN PART OF THE SUBDIVISION.
- ONCE ALL DISTURBED GROUND DRAINING TO AN INLET HAS BEEN RESTABILIZED WITH GRASS OR SOD, THE SUBDIVISION DEVELOPER WILL BE RESPONSIBLE FOR PERMANENTLY REMOVING THE INLET PROTECTION.


GENERAL NOTES

- THE INTENT OF ALL EROSION CONTROL DEVICES IS TO PREVENT ERODED SOIL FROM ENTERING DITCHES, STORM SEWERS, LAKES, STREETS OR ANY OTHER DRAINAGE FEATURE.
- THIS SHEET IS INTENDED TO PROVIDE GUIDELINES AS TO WHAT TYPE OF EROSION CONTROL DEVICES WILL BE INSTALLED DURING THE CONSTRUCTION PROCESS. CONTRACTORS ARE EXPECTED TO BID PROJECTS ACCORDINGLY.
- EROSION CONTROL DEVICES SHALL BE MAINTAINED DURING THE CONSTRUCTION PROCESS TO REMAIN EFFECTIVE. MAINTENANCE SHALL BE AS INDICATED ON SOIL EROSION EMP'S DETAIL SHEETS.
- PERSONS DESTROYING EROSION CONTROL DEVICES SHALL BE RESPONSIBLE FOR IMMEDIATELY REPAIRING THEM OR INSTALLING SUITABLE REPLACEMENT DEVICES.
- THE DEVELOPMENT OF ANY SUBDIVISION THAT DISTURBS 1 ACRE OR MORE WILL REQUIRE A FEDERAL/STATE NPDES STORMWATER PERMIT. THE PREPARATION OF A STORMWATER POLLUTION PREVENTION PLAN IS REQUIRED. EROSION CONTROL DEVICES ARE REQUIRED. THE DETAILS SHOWN ON THIS SHEET ARE THE MINIMUM STANDARDS TO BE SHOWN ON POLLUTION PREVENTION PLANS.
- FOR SUBDIVISIONS SMALLER THAN 1 ACRE, SOIL EROSION DEVICES ARE REQUIRED. ALSO, DEVELOPERS AND CONTRACTORS ARE ENCOURAGED TO DEVELOP POLLUTION PREVENTION PLANS FOR EACH PROJECT PRIOR TO CONSTRUCTION.
- FAILURE TO USE AND MAINTAIN SOIL EROSION DEVICES IS A VIOLATION OF SECTION 16.32 OF THE CITY CODE AND WILL SUBJECT THE SUBDIVISION DEVELOPER AND CONTRACTORS TO THE PENALTIES PROVIDED THEREIN.
- THE APPLICATION OF EROSION CONTROL DEVICES SHOWN ON THIS SHEET IS FOR SITUATIONS NORMALLY ENCOUNTERED. FROM TIME TO TIME, SITUATIONS WILL ARISE THAT MAY REQUIRE DEVICES OTHER THAN THAT SHOWN. EROSION CONTROL DEVICES, OTHER THAN THOSE SHOWN, MAY BE UTILIZED SO LONG AS THEY ARE EFFECTIVE AND MAINTAINED.
- A STABILIZED EARTH SURFACE IS DEFINED AS ONE THAT IS HARD SURFACED WITH CONCRETE, ASPHALT, OR THE LIKE, OR ONE ON WHICH 70% OF THE GRASS HAS GERMINATED ON THE ENTIRE SURFACE.

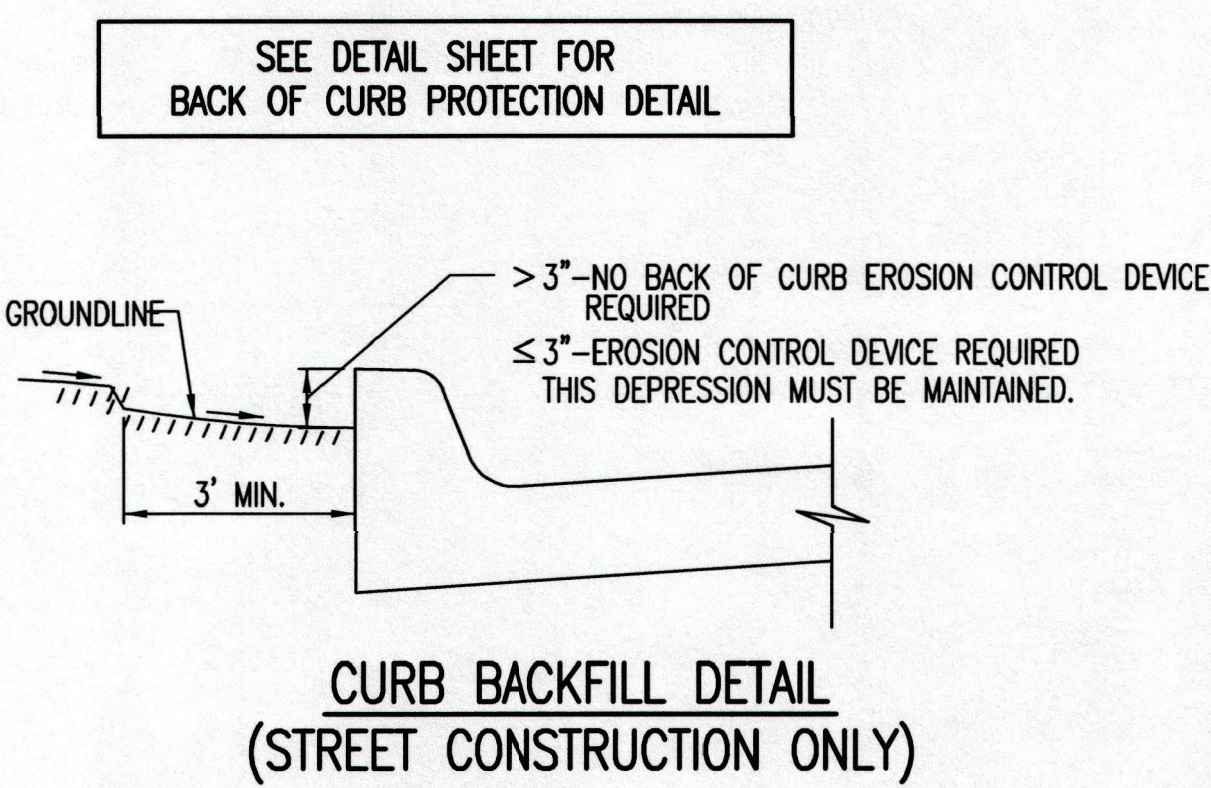

THIS IS A TEMPORARY MEASURE ONLY, WHEN APPROVED BY THE PROJECT ENGINEER. THE DIRT GRADE BEHIND THE CURB SHALL BE BROUGHT TO THE TOP OF CURB, WITH TEMPORARY EROSION CONTROL MAT OR PERMANENT VEGETATION PLACED, PRIOR TO THE COMPLETION OF ALL PROJECTS.

REVISION DATE: MAY 2013

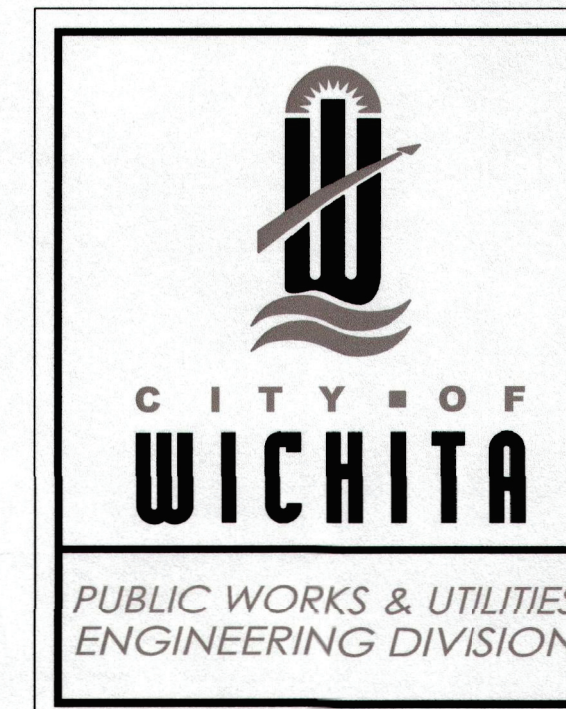

SUBDIVISION DEVELOPMENT PROCESS		
CITY ENGINEER GARY JANZEN, P.E.		
PROJECT NUMBER	OCA NUMBER	DATE
CITY ENGINEER'S OFFICE CITY HALL - SEVENTH FLOOR 455 NORTH MAIN STREET WICHITA, KANSAS 67202-1620 (316) 268-4501		SHEET

SW-505

Saved: 05-29-2015 8:01:52 AM by: CJS
 U:\Projects-2015\151210203\151210203\151210203-006-06.6-EROSION CONTROL DETAILS

**OXFORD VILLA
WICHITA, KS**

LKArchitecture
 Architecture • Engineering • Planning • Interior Design • Landscape Architecture

LKArchitecture, Inc.®
 345 Riverview Wichita, KS 67203
 T 316.268.0230 F 316.268.0205
 CONTACT: Isaac Krumme
 DRAWN: Roy Thomas
 CHECKED: Ben Mabry
PROJECT NUMBER:
14619
SHEET TITLE:
 EROSION CONTROL DETAILS
SHEET NUMBER:
C6.6

