


WATER VALVE BOX ELEVATIONS			
STREET	STATION	OFFSET	EXISTING ELEVATION
LINDBERG	56+08.00	23.50' Lt.	208.8
LINDBERG	56+33.00	23.50' Lt.	208.7

SCALE: 1"=20'

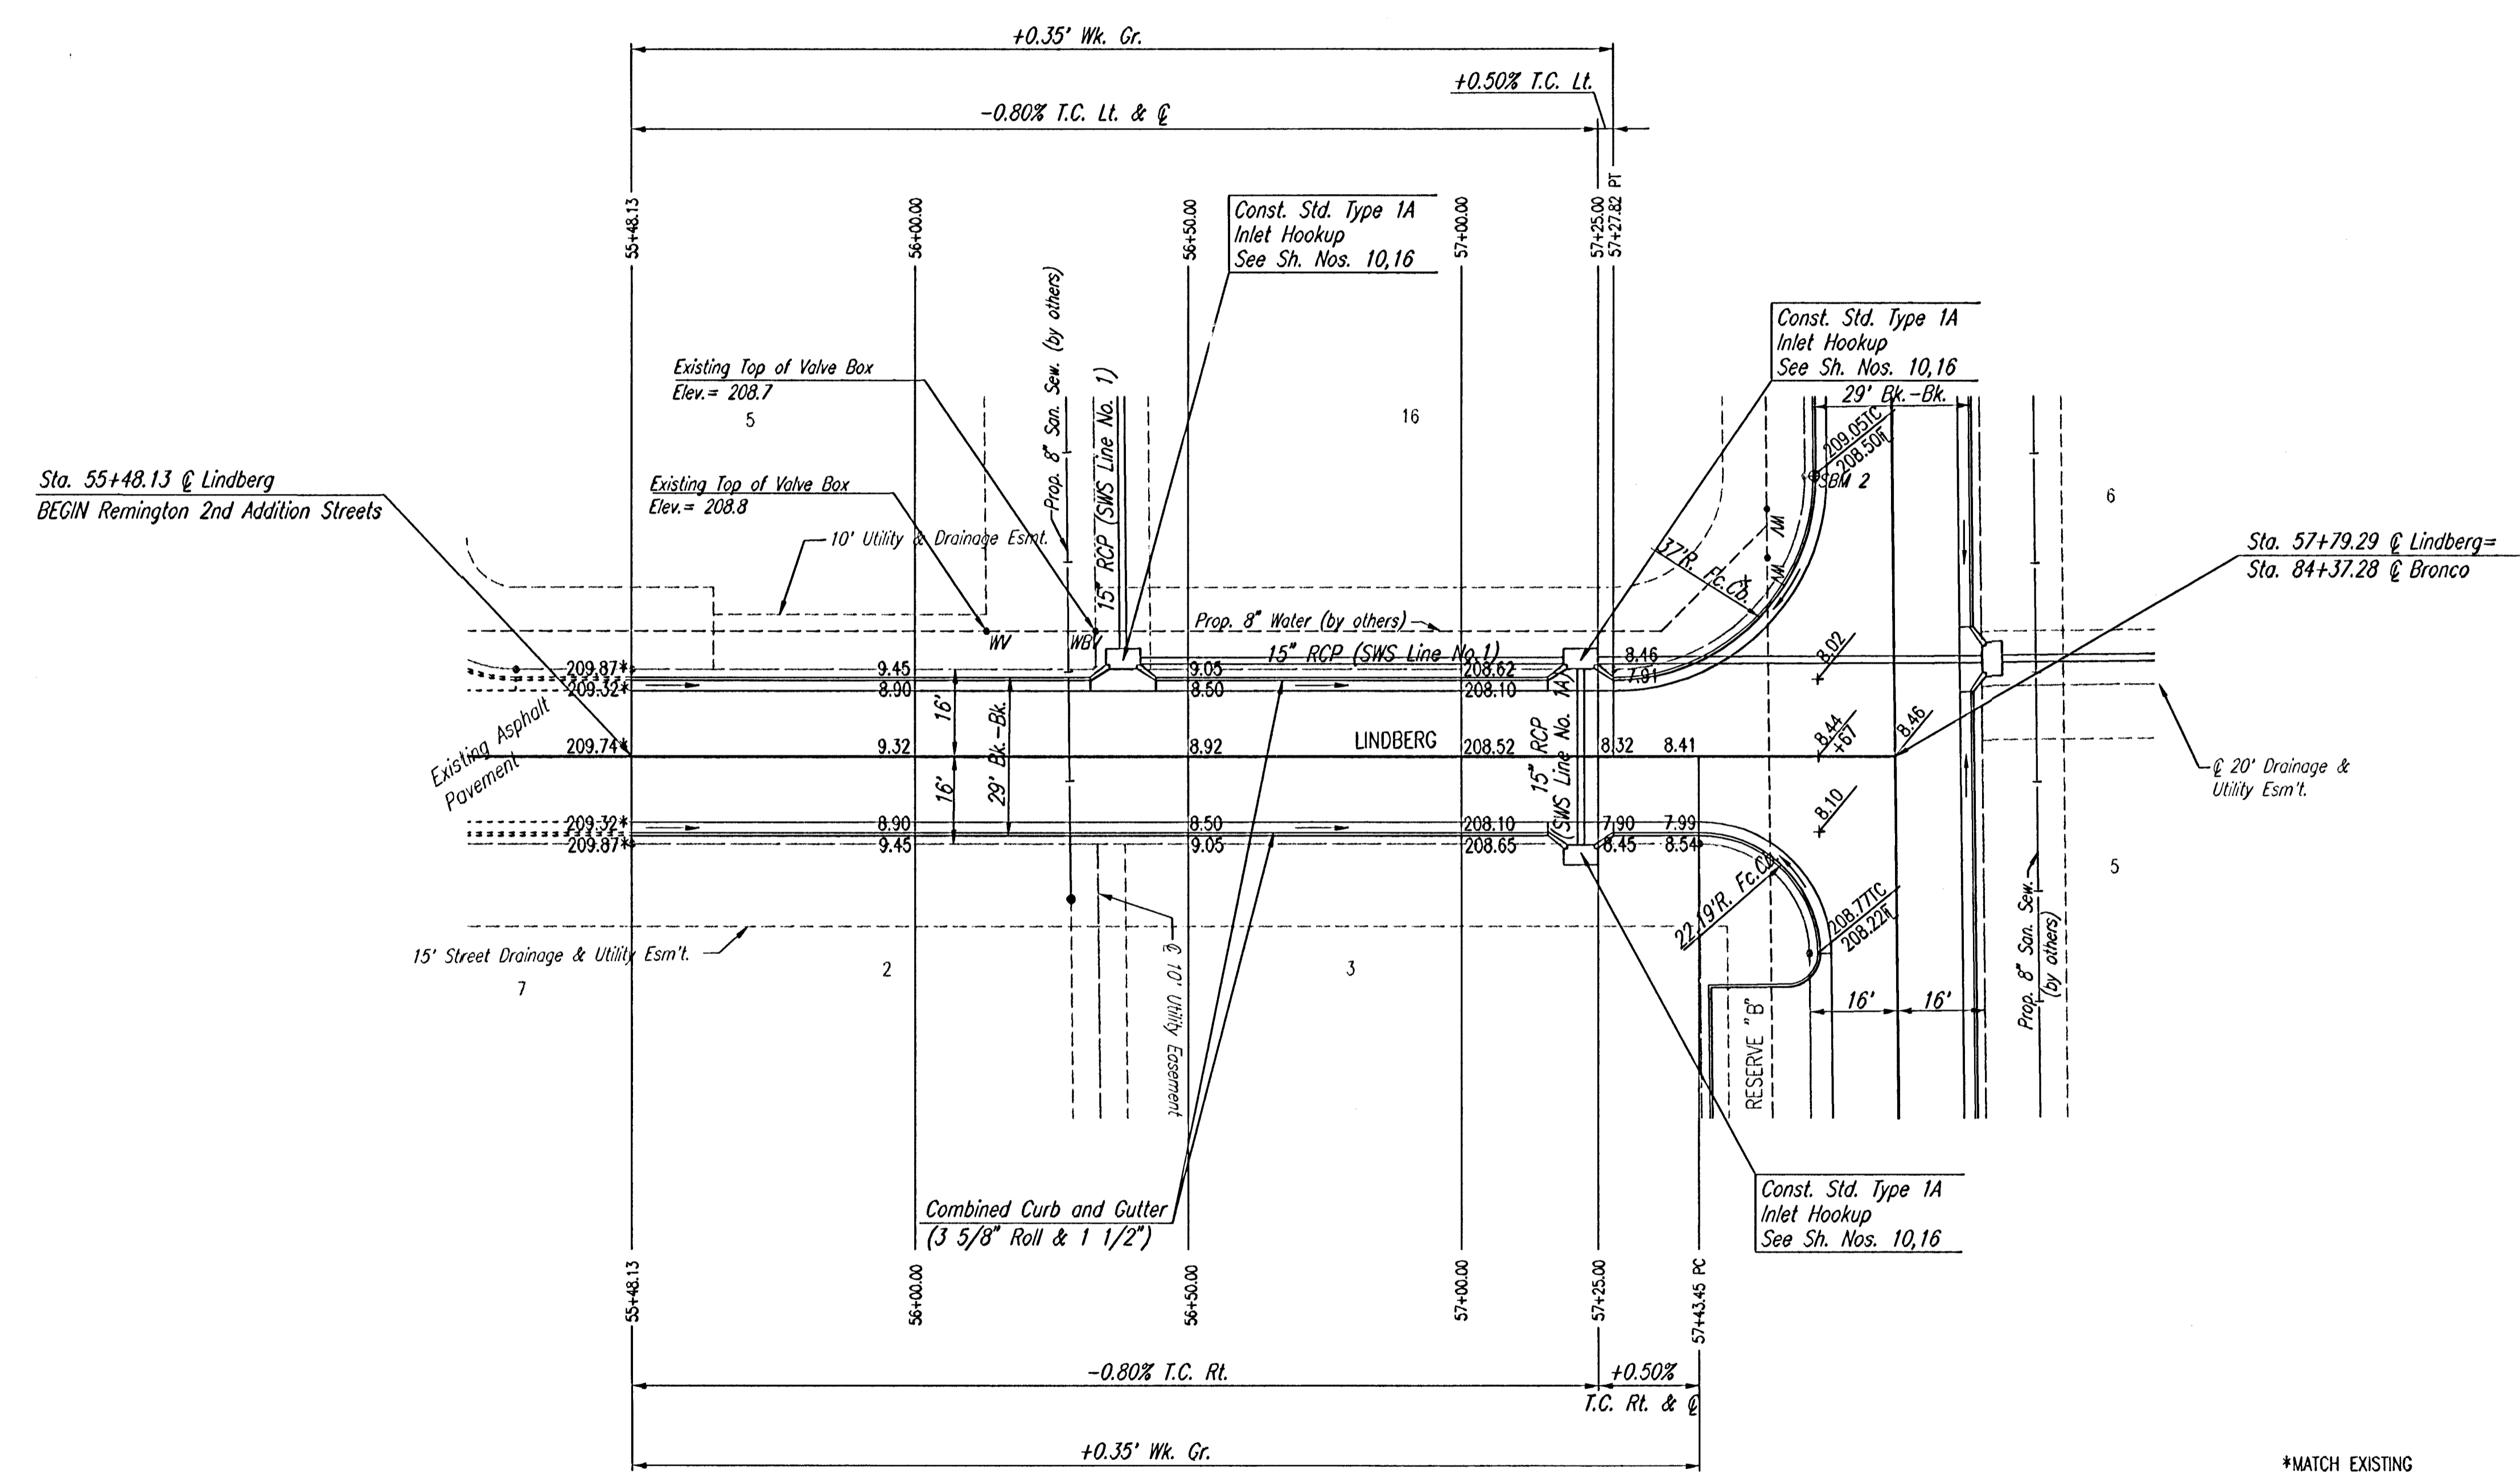


NOTE: THIS STREET TO BE CONSTRUCTED WITH ROLL-TYPE CURB. TOP OF CURB ELEVATIONS GIVEN ARE FOR FULL HEIGHT CURB.

*MATCH EXISTING

Richard E. Cable 28 NOV 03
RECORD DRAWING

DSMR: BER OPER: ILS SCALE: 1"=20.00
 C:\2002\02662\000\LINDBERG 03-04-2003 11:14:38 am

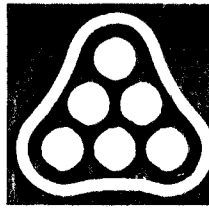	No. _____ Revision _____ By _____ Date _____	No. _____ Revision _____ By _____ Date _____
	REMINGTON PLACE 2ND ADDITION NEIL O. CABLE P.E. - CITY ENGINEER LINDBERG STA. 55+48.13 TO STA. 57+79.29 CITY OF WICHITA PROJECT NO. 472-83678	
	Professional Engineering Consultants, P.A. 303 S. TOPEKA • WICHITA, KANSAS 67202 316-262-2691 • FAX 316-262-3003	
	Designed by: BER, JJD Drawn by: TJS	Job No. 35-02662 Date January 2003