


TYPICAL SECTION — BRONCO CT.

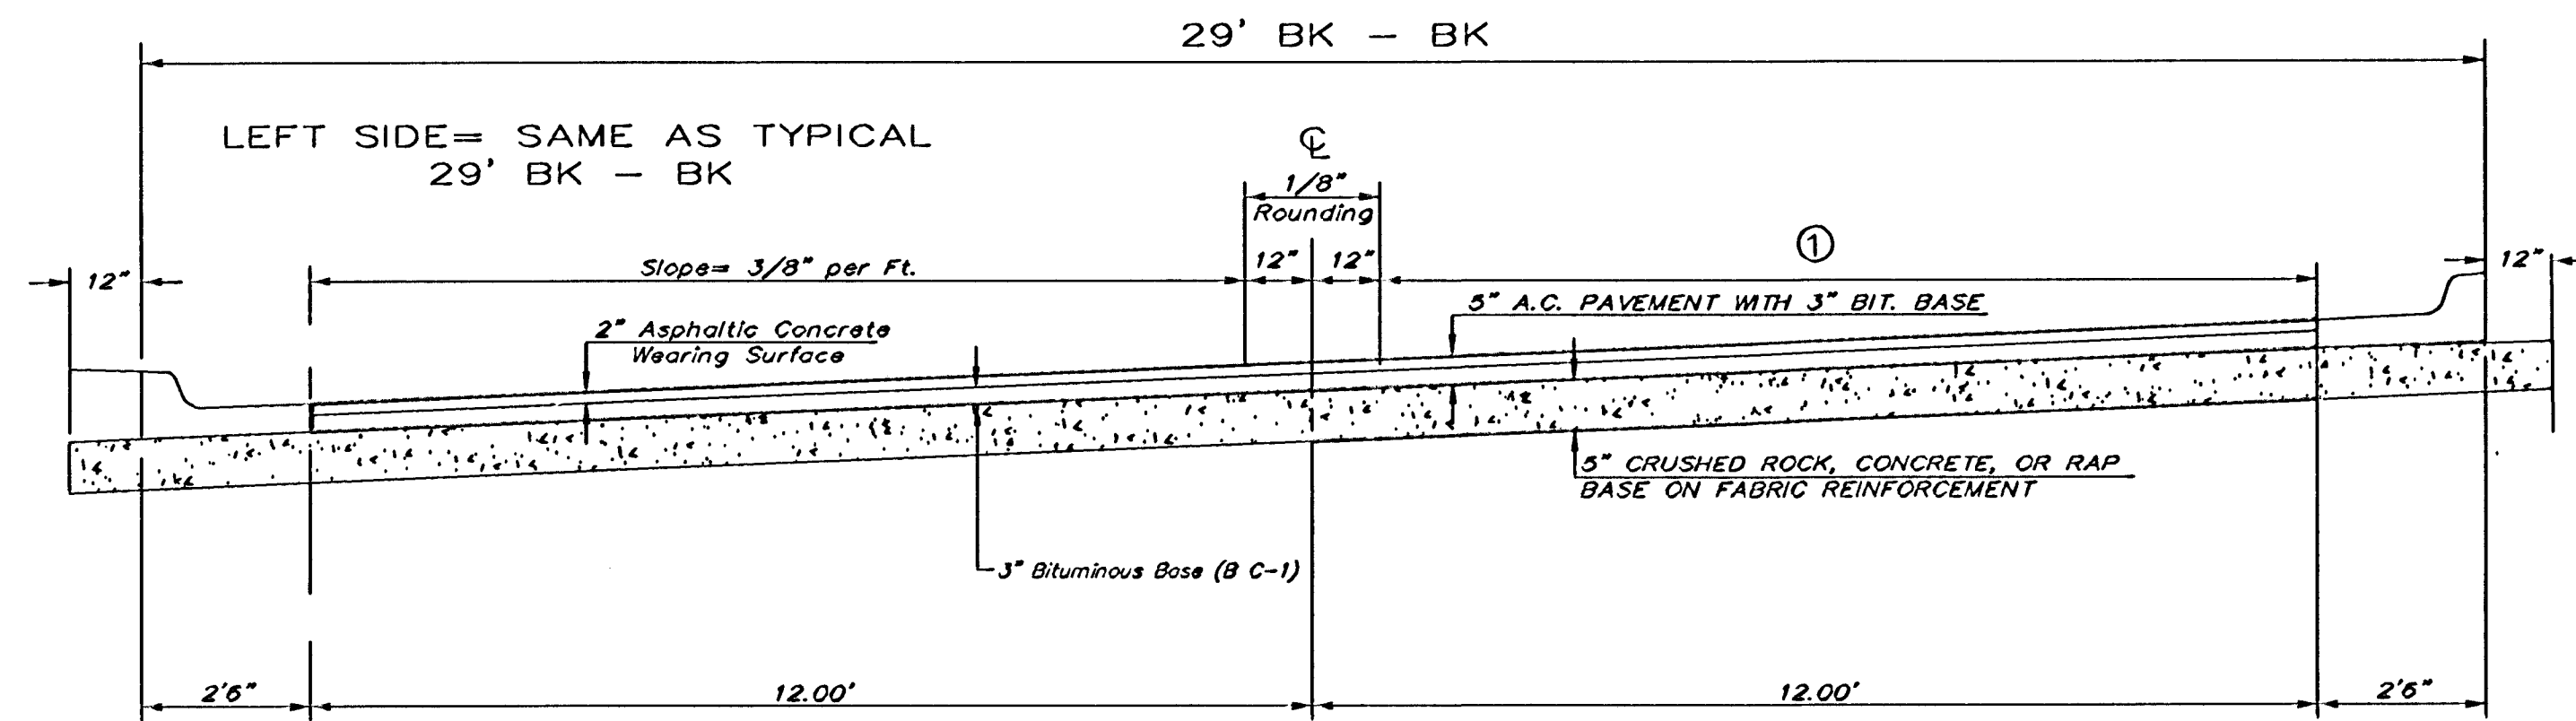

① CROSS SLOPE VARIES FROM 0% AT STA. 90+46 TO 0.5% AT STA. 90+00
SEE PLAN

NOTE: THIS STREET TO BE CONSTRUCTED WITH ROLL-TYPE CURB. TOP OF CURB ELEVATIONS GIVEN ARE FOR FULL HEIGHT CURB.

RECORD DRAWING

Neil D. Cable 24 Nov 03

| | | | |
|--|----------|---------|--------------|
| No. | Revision | By | Date |
| REMINGTON PLACE 2ND ADDITION NEIL D. CABLE P.E. - CITY ENGINEER BRONCO CT. STA. 90+00.00 TO STA. 90+97.08 CITY OF WICHITA PROJECT NO. 472-83678 | | | |
| Professional Engineering Consultants, P.A. 303 S. TOPEKA • WICHITA, KANSAS 67202 316-262-2691 • FAX 316-262-3003 | | | |
| Designed by | BER, JUD | Job No. | 35-02662 |
| Drawn by | TLS | Date | January 2003 |
| | | | SHL 6 of 17 |

