


PLAN
 CHECKED
 CHECKED
 BY
 DATE

PROFILE
 CHECKED
 CHECKED
 BY
 DATE


DSMR: BER OPER: ILS SCALE: 1"=20.00
 Q:\2002\02662\000\SWS\LINE2 03-04-2003 11:09:41 am

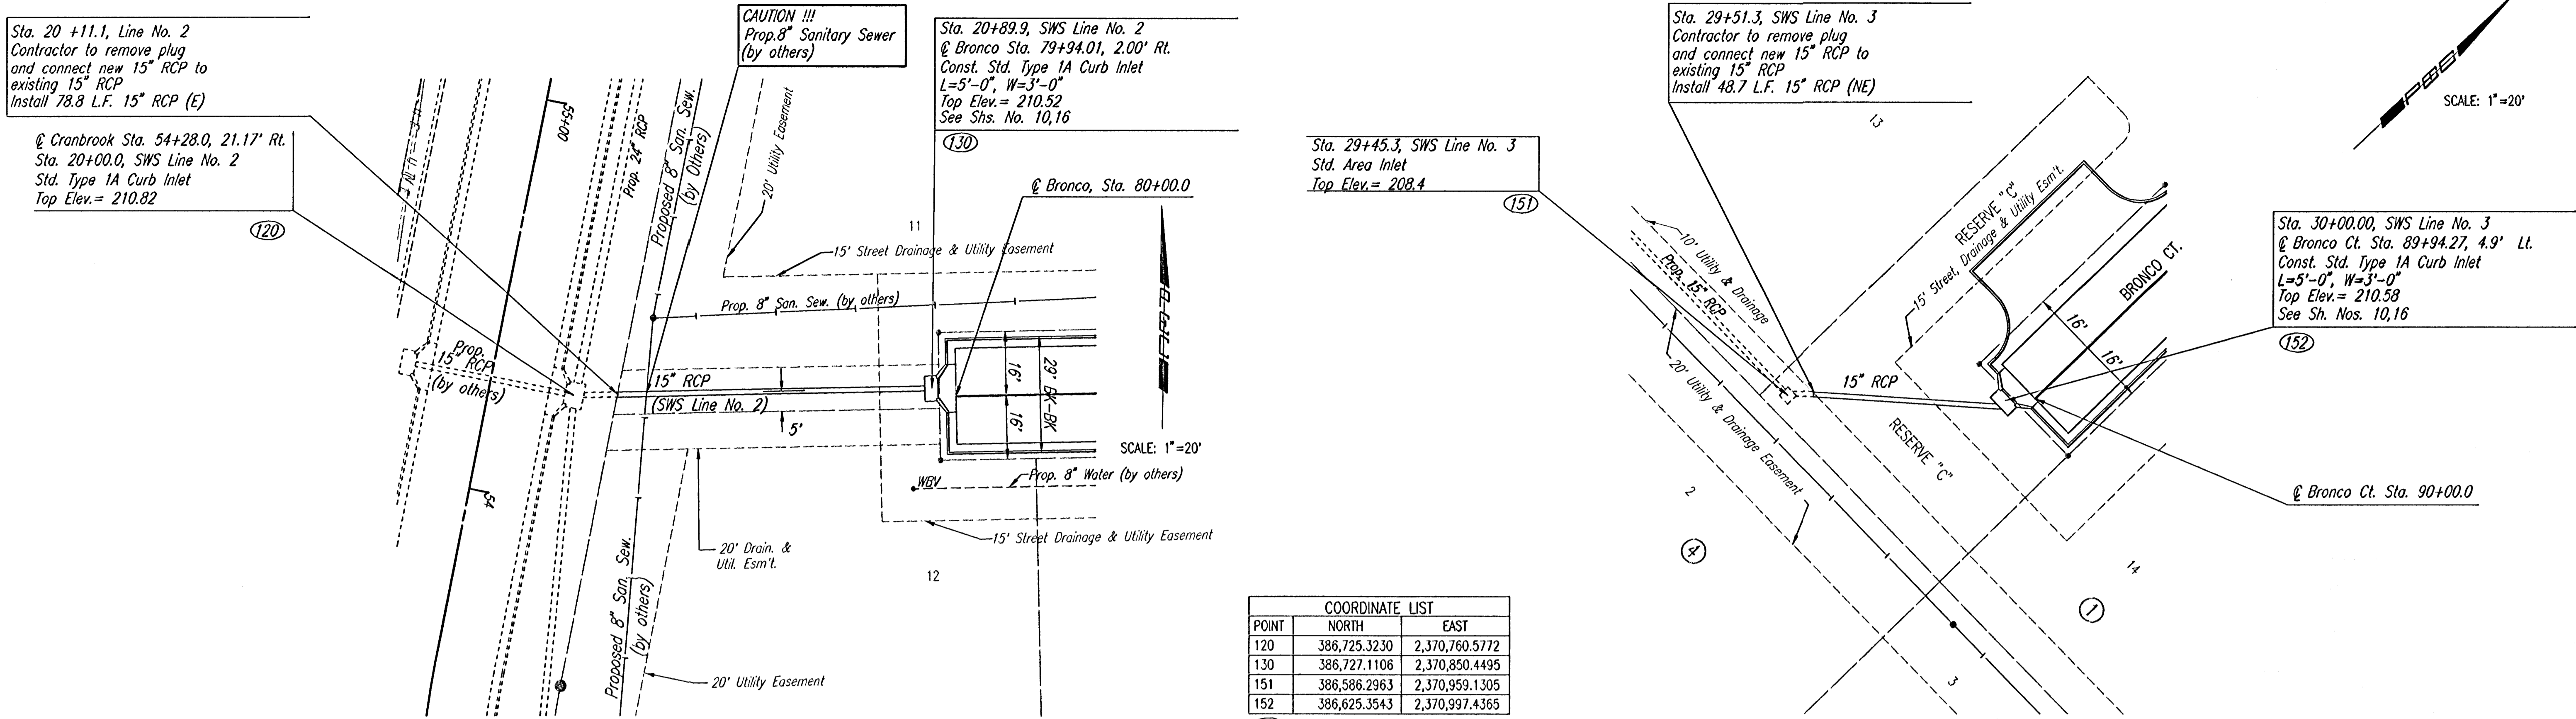

POINT	NORTH	EAST
120	386,725.3230	2,370,760.5772
130	386,727.1106	2,370,850.4495
151	386,586.2963	2,370,959.1305
152	386,625.3543	2,370,997.4365

(152) = COORDINATE POINT NO.

RECORD DRAWING
B. DeWitt 28 MAR 03

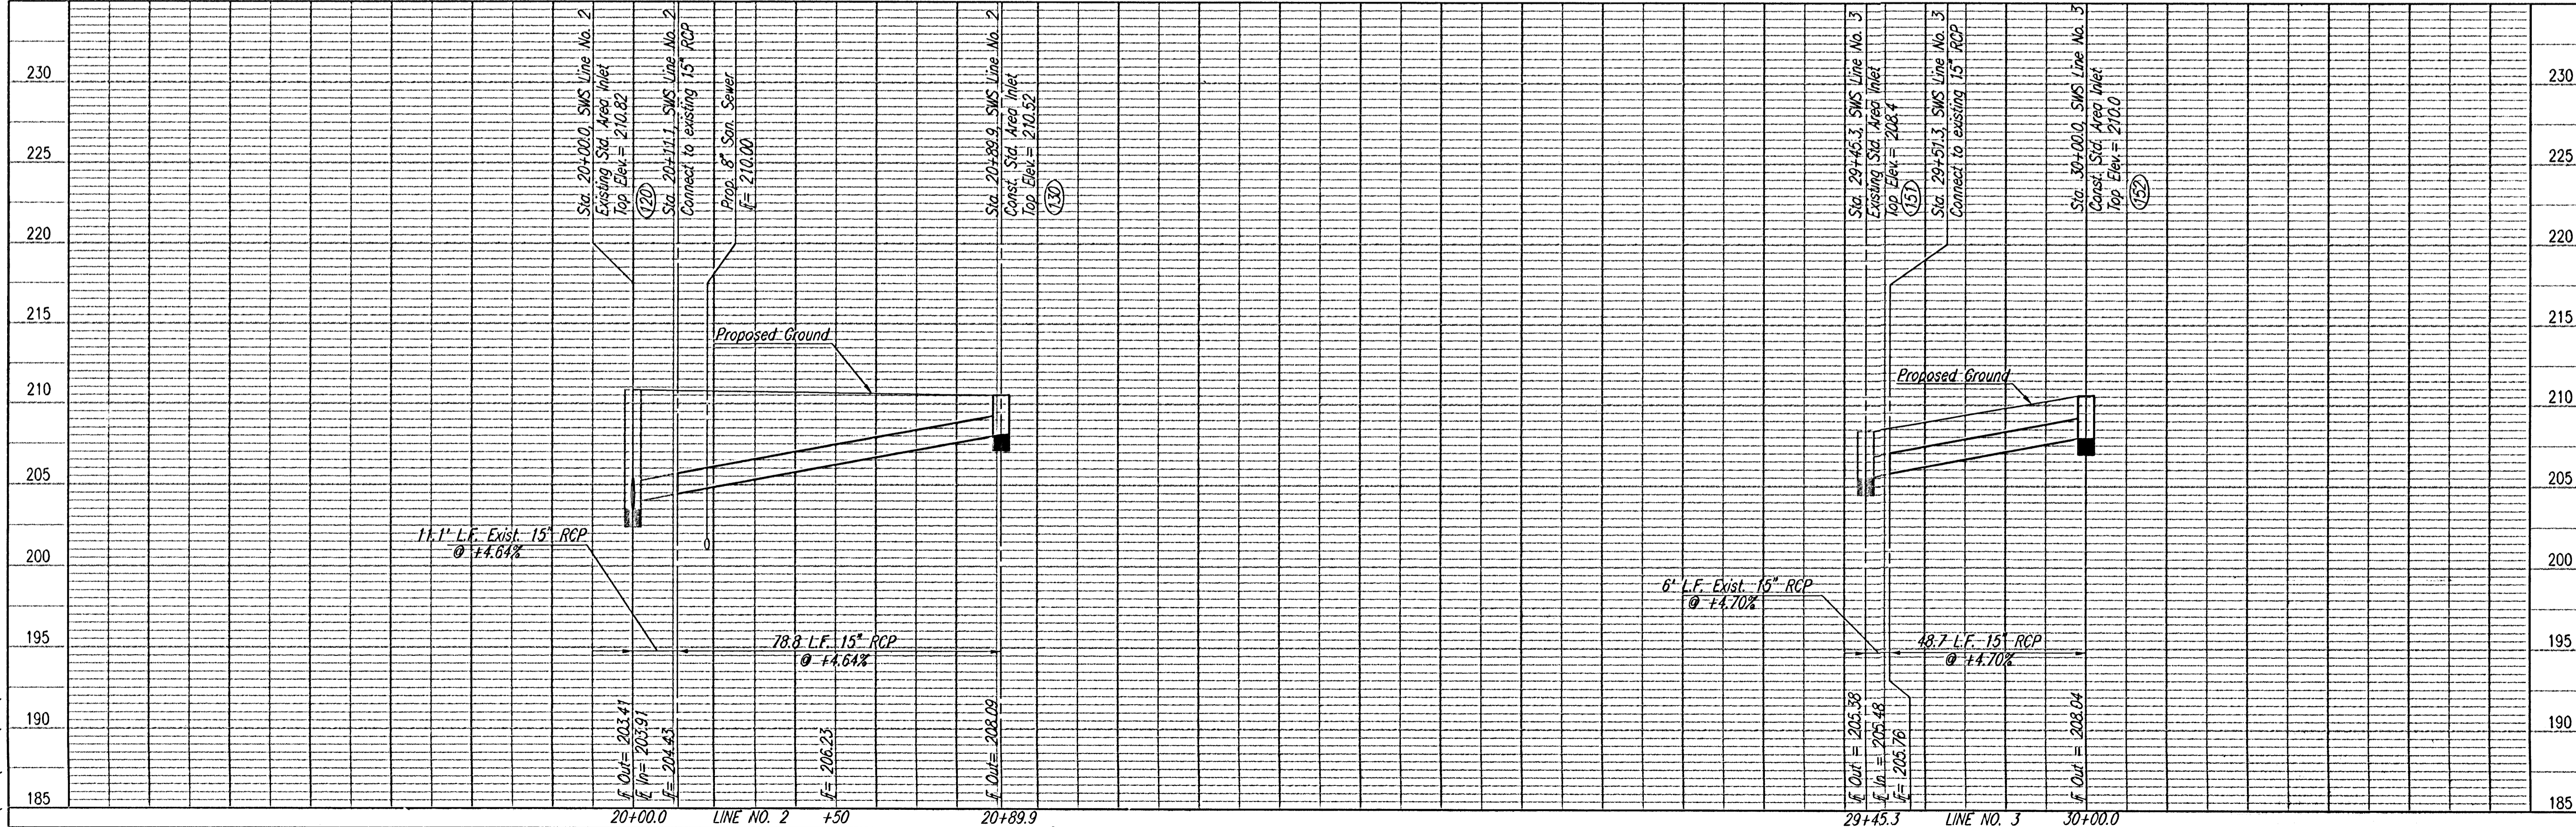

Professional Engineering Consultants, P.A.
 300 S. TORREA - WICHITA, KANSAS 67202
 316-262-2671 - FAX 316-262-2668

Designed By: BER, JUD
 Drawn By: TJS

Job No.: 35-02662
 Date: January 2003

Professional Engineering Consultants, P.A.
 STA. 20+00.0 TO STA. 20+89.9
 SWS LINE NO. 2
 STA. 29+45.3 TO STA. 30+00.0
 SWS LINE NO. 3
 NEW 15\"/>

REMININGTON 2ND ADDITION
 SWS LINE NO. 2
 STA. 20+00.0 TO STA. 20+89.9
 SWS LINE NO. 3
 STA. 29+45.3 TO STA. 30+00.0
 NEW 15\"/>

City of Wichita, Project No. 472-53378

Sheet 9 of 17