


DATE	PURPOSE	NO.
08.25.16	30% PROGRESS SET	
09.15.16	60% PROGRESS SET	
10.13.16	90% PROGRESS SET	
11.10.16	BID/FERMIT SET	
11.22.16	ADDENDUM #1	
12.07.16	CITY COMMENTS	

**HAMPTON INN  
CADILLAC LAKE  
WICHITA, KANSAS**



**LKArchitecture**  
Architecture • Engineering • Planning • Interior Design • Landscape Architecture

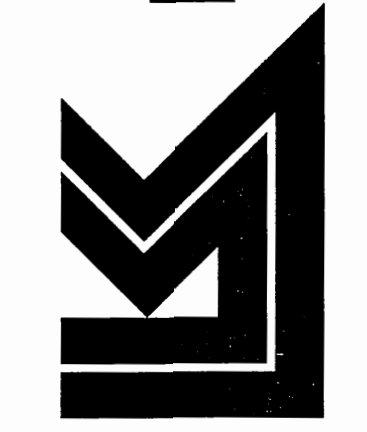

**LKArchitecture, Inc.**  
345 Riverview Wichita, KS 67203  
T 316.268.0230 F 316.268.0205  
CONTACT: LARRY GANN  
DRAWN: PEC  
CHECKED: PEC  
PROJECT NUMBER: **15433**  
SHEET TITLE: PPW TITLE SHEET  
SHEET NUMBER: **C3.01** OF X

# WATER DISTRIBUTION SYSTEM


to serve

## HAMPTON INN AT CADILLAC LAKE

10047 WEST 29TH STREET NORTH,  
WICHITA, KANSAS 67205

### CITY OF WICHITA, KANSAS

Gary Janzen, P.E. City Engineer  
Project Number  
2028 PPW (607853)

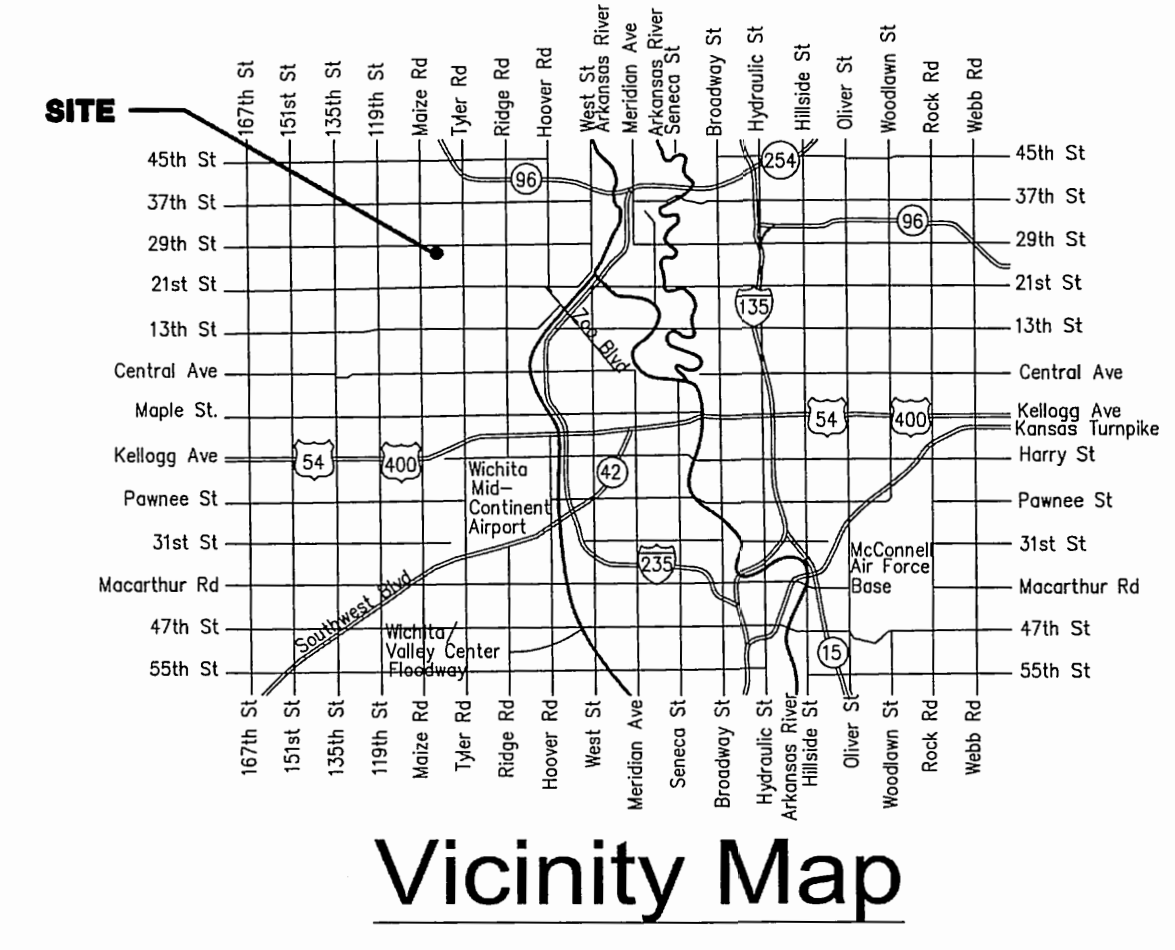

## GENERAL NOTES

- THE CONTRACTOR SHALL COMPLY WITH ALL APPLICABLE SAFETY REGULATIONS. ALL CONSTRUCTION SHALL BE COMPLETED FOLLOWING CURRENT CITY STANDARD SPECIFICATIONS AND SPECIAL PROVISIONS.
- CONTRACTOR WILL BE REQUIRED TO PROVIDE NOTICE TO UTILITY COMPANIES A MINIMUM OF SEVENTY-TWO (72) HOURS PRIOR TO ANY EXCAVATION, AS FOLLOWS:  
  
KANSAS ONE-CALL 687-2470  
  
THE CONTRACTOR MUST NOTIFY THE FOLLOWING IN CASE OF AN EMERGENCY:  
  
AT&T 1-800-246-8464  
BLACK HILLS ENERGY 1-800-694-8989  
CITY OF WICHITA WATER & SEWER 1-316-219-8921  
CITY OF WICHITA STORMWATER 1-316-268-4090  
CITY OF WICHITA TRAFFIC 1-316-268-4034  
COX COMMUNICATIONS 1-888-249-3530  
KANSAS GAS SERVICE 1-888-482-4950  
WESTAR ENERGY 1-800-544-4857
- UTILITY SERVICE LINES, POLES, ETC. ARE TO BE ADJUSTED AS NECESSARY BY OTHERS PRIOR TO CONSTRUCTION UNLESS THE PLANS SPECIFICALLY CALL FOR THEIR ADJUSTMENT BY THE CONTRACTOR OR UNLESS THE PLANS SPECIFICALLY IDENTIFY A UTILITY TO BE ADJUSTED BY ITS OWNER DURING CONSTRUCTION. EXISTING UTILITIES AND THEIR LOCATION, AS SHOWN ON THE PLANS, REPRESENT THE BEST INFORMATION OBTAINABLE FOR DESIGN. THE CONTRACTOR WILL BE REQUIRED TO WORK AROUND EXISTING UTILITIES WITHIN THE RIGHT-OF-WAY WHICH DO NOT CONFLICT WITH PROPOSED CONSTRUCTION.
- RUBBLE FROM THE REMOVAL OF MISCELLANEOUS STRUCTURES AND EXCESS EXCAVATION WHICH IS TO BE WASTED SHALL BE DISPOSED OF ON SITES TO BE PROVIDED BY THE CONTRACTOR. THESE SITES SHALL BE APPROVED BY THE ENGINEER AS TO SUITABILITY, APPEARANCE AND SITE LOCATION. LOCATIONS, IN THE OPINION OF THE ENGINEER, THAT WILL LEAVE AN UNSIGHTLY APPEARANCE WILL NOT BE APPROVED. ALL DISPOSAL SITES MUST BE APPROVED BY THE KANSAS DEPARTMENT OF HEALTH AND ENVIRONMENT. MATERIAL EITHER STOCKPILED OR DISPOSED OF IN A FLOOD PLAIN WILL REQUIRE A KANSAS STATE BOARD OF AGRICULTURE PERMIT. ANY MATERIAL DUMPED IN WATERS OF THE UNITED STATES OR WETLANDS IS SUBJECT TO U.S. CORPUS OF ENGINEERS PERMITTING REGULATIONS. ANY MATERIAL BURIED OR STOCKPILED BEYOND APPROVED CONSTRUCTION LIMITS WILL REQUIRE ADDITIONAL ARCHAEOLOGICAL INVESTIGATIONS UNLESS BURIED IN A PREVIOUSLY APPROVED BORROW LOCATION.
- TREES AND SHRUBS IN PUBLIC RIGHT-OF-WAY WHICH ARE IN DIRECT CONFLICT WITH PROPOSED NEW CONSTRUCTION SHALL BE REMOVED BY THE CONTRACTOR WITH THE CITY ENGINEER'S APPROVAL. TREES AND SHRUBS WHICH ARE NOT IN DIRECT CONFLICT WITH PROPOSED NEW CONSTRUCTION SHALL BE SAVED AND PROTECTED FROM DAMAGE.
- THE CONTRACTOR SHALL GIVE ALL PROPERTY OWNERS AND/OR TENANTS OF DEVELOPED PROPERTY ADJUTING THE CONSTRUCTION OF THIS PROJECT A MINIMUM OF TEN (10) DAYS NOTICE PRIOR TO START OF CONSTRUCTION.
- THE CONTRACTOR SHALL BE RESPONSIBLE FOR PRESERVING PROPERTY IRONS. THE CONTRACTOR WILL BE REQUIRED TO RE-ESTABLISH ANY PROPERTY IRONS WHICH ARE DAMAGED OR DESTROYED BY HIS CONSTRUCTION OPERATIONS. SUCH IRONS SHALL BE RE-ESTABLISHED BY A LICENSED LAND SURVEYOR IN ACCORDANCE WITH STATE LAWS.
- THE ENGINEERING DIVISION SHALL FIELD LOCATE WATER VALVES ONE TIME DURING CONSTRUCTION WHEN REQUESTED BY THE CONTRACTOR. IT SHALL BE THE CONTRACTOR'S RESPONSIBILITY TO PRESERVE SUCH FIELD LOCATIONS DURING THE CONSTRUCTION PROCESS. WATER VALVES, VALVE BOXES OR FIRE HYDRANTS DAMAGED DURING CONSTRUCTION SHALL BE REPAIRED BY CONTRACTOR AT HIS OWN EXPENSE. VALVE BOXES AND WATER METERS WITHIN THE PROJECT LIMITS SHALL BE ADJUSTED TO MATCH FINAL GRADES BY THE CONTRACTOR.
- THE CONTRACTOR SHALL NOTIFY THE CONSULTANT ENGINEER AND TOM MASON AT 316-268-4574 WITH THE CITY OF WICHITA WITH THE ANTICIPATED CONSTRUCTION START DATE AND NOTIFY THEM OF PROJECT COMPLETION. STAKING AND INSPECTION FOR THIS PROJECT WILL BE THE RESPONSIBILITY OF THE CONTRACTOR.
- IF TRAFFIC WILL BE IMPACTED BY CONSTRUCTION, A TRAFFIC CONTROL PLAN MUST BE SUBMITTED AND APPROVED BY THE CITY TRAFFIC ENGINEER, BRIAN COON AT TRAFFIC@WICHITA.GOV. BEFORE CONSTRUCTION CAN BEGIN. THE CONTRACTOR SHALL BE RESPONSIBLE FOR ALL TRAFFIC CONTROL MEASURES TO FACILITATE CONSTRUCTION. ALL CONSTRUCTION ZONE MARKINGS AND SIGNAGE SHALL CONFORM TO THE LATEST VERSION OF THE MANUAL ON UNIFORM TRAFFIC CONTROL DEVICES (MUTCD) AS PUBLISHED BY THE US DEPT. OF TRANSPORTATION, FEDERAL HIGHWAY ADMINISTRATION. ALL COSTS ASSOCIATED WITH CONSTRUCTION MARKINGS AND SIGNAGE SHALL BE THE CONTRACTORS RESPONSIBILITY.
- ALL ELEVATIONS SHOWN ARE NAVD 88.
- ALL AREAS DISTURBED DURING CONSTRUCTION THAT WILL NOT BE UNDER PROPOSED PAVEMENT SHALL BE RESTORED TO MATCH EXISTING CONDITIONS.
- ANY SIDEWALK, DRIVE APPROACH, CURB, OR STREET PAVEMENT REMOVED TO CONSTRUCT PROJECT MUST HAVE A PAVEMENT CUT PERMIT AND BE REPLACED BY THE CITY CONTRACTOR. PERMITS CAN BE OBTAINED BY CALLING 316-268-4501 OR 316-268-4480.
- ALL APPLICABLE FEES (TAP, EQUITY, IN LIEU OF & MAIN BENEFIT) MUST BE PAID BEFORE ANY CONNECTIONS CAN BE MADE ON THIS PROJECT. QUOTES CAN BE OBTAINED ON FEES BY CALLING 316-268-4555.
- CITY MAINTENANCE OF WATER MAINS ENDS AT RIGHT-OF-WAY OR EASEMENT LINE OR WITHIN TWO FEET OF VAULT.
- OPENING AND CLOSING OF WATER VALVES SHALL BE DONE SLOWLY TO PREVENT DAMAGE TO THE WATER DISTRIBUTION SYSTEM FROM WATER HAMMER. ALL VALVES CLOSED BY THE CONTRACTOR MUST BE REOPENED AS NEW CONSTRUCTION PERMITS. THE PROJECT INSPECTOR MUST ASCERTAIN THAT ANY VALVE CLOSED BY THE CONTRACTOR IS REOPENED. THE CONTRACTOR WILL BE PERMITTED TO OPERATE WATER VALVES ONLY WHEN THE PROJECT INSPECTOR ASSIGNED TO THE PROJECT IS PRESENT.
- THE CONTRACTOR SHALL LAY A TRACER WIRE AND SET TEST STATIONS ALONG ALL WATER PIPE INSTALLED IN ACCORDANCE WITH CITY SPECIFICATIONS AND TRACER WIRE DETAIL ON DETAIL SHEET WL-101, COST IS SUBSIDIARY TO PIPE INSTALLATION.
- THE CONTRACTOR SHALL PROVIDE MATERIALS FOR TEMPORARY BLOWOFF OF WATERLINES. CONNECTIONS TO THE EXISTING WATERLINES SHALL BE MADE WITH CLEAN, SWABBED PIPE AND FLUSHED UPON COMPLETION OF TIE-INS.
- REQUESTS FOR SHORT TERM WATER INTERRUPTIONS SHALL BE SUBJECT TO THEIR APPROVAL. THE CONTRACTOR SHALL GIVE WRITTEN NOTICE TO ANY PROPERTY OWNER, BUSINESS, AND/OR TENANTS THAT WILL HAVE WATER SERVICE INTERRUPTED AT LEAST 5 DAYS IN ADVANCE. SUCH NOTIFICATIONS SHOULD INDICATE THE TIME AND DATE THAT THE WATER WILL BE TURNED OFF AND WHEN THE SERVICE WILL BE RESTORED. NO BUSINESS, PROPERTY OWNER, AND/OR TENANTS SHALL BE WITHOUT WATER SERVICE FOR MORE THAN 8 HOURS. PROPOSED TIE IN LOCATIONS WHICH WILL AFFECT WATER SERVICE TO PROPERTY OWNERS SHALL BE PERFORMED DURING NON-PEAK HOURS.
- THE CONTRACTOR MUST SCHEDULE THE CONNECTIONS TO THE EXISTING MAIN WITH THE CITY SUCH THAT THERE IS A MINIMUM DISRUPTION OF SERVICE. CONNECTIONS SHALL BE MADE DURING PERIODS OF LOW WATER USAGE. THE CONTRACTOR SHALL SUBMIT HIS PROPOSED SCHEDULE FOR COMPLETING WORK FOR CITY APPROVAL AT LEAST 10 DAYS PRIOR TO BEGINNING CONSTRUCTION.
- DEFLECTIONS AT PIPE JOINT OR COUPLINGS SHALL NOT EXCEED THE PIPE MANUFACTURERS RECOMMENDED MAXIMUM. WHERE DEFLECTIONS ARE GREATER THAN THE MAXIMUM ALLOWED, THE CONTRACTOR SHALL UTILIZE FITTINGS.
- ANY EXTENSION GREATER THAN ONE LENGTH OF PIPE SHALL REQUIRE TESTING.
- ANY EXISTING JOINT EXPOSED DURING EXCAVATION SHALL BE REPLACED IF WITHIN FOUR FEET OF PROPOSED JOINT.
- ANY EXISTING JOINT EXPOSED DURING EXCAVATION SHALL BE REPLACED IF WITHIN FOUR FEET OF PROPOSED JOINT.
- ALL WET TAPS SHALL BE INSTALLED BY THE CITY OF WICHITA. THE CONTRACTOR WILL REIMBURSE THE CITY FOR TAPPING FEES PRIOR TO TAP BEING MADE. UNLESS NOTED ON PLANS.
- THE CONTRACTOR SHALL PROTECT FROM DAMAGE AND SUPPORT EXISTING UTILITIES THROUGH CONSTRUCTION AS APPROVED BY THE UTILITY OWNER AND THE ENGINEER AT THE CONTRACTORS EXPENSE.
- CONTRACTOR SHALL LIMIT THE EXTENT OF TRENCH OPENINGS OVERNIGHT AND WEEKENDS TO LESS THAN 50 FEET.
- WICHITA FIRE DEPARTMENT INSPECTIONS MAY BE SCHEDULED BY CALLING 316-268-4441.
- ALL APPROVED EXCESS EXCAVATION WHICH IS TO BE WASTED SHALL BE STOCKPILED AS DIRECTED BY THE ENGINEER AT NO ADDITIONAL COST TO THE OWNER. STOCKPILE LOCATIONS SHALL BE AS DIRECTED BY THE OWNER AND IN ACCORDANCE WITH GENERAL NOTE NO. 4 ABOVE.
- ALL LAWN/TURF AREAS DISTURBED BY CONSTRUCTION OF THE PROPOSED IMPROVEMENTS SHALL BE RESTORED WITH THE SAME GRASS/SOD AS EXISTING. RESTORATION OF DISTURBED AREAS SHALL INCLUDE, BUT NOT BE LIMITED TO, TOP SOIL PREPARATION, SEEDING, MULCH, AND/OR RESEEDING. ALL SEEDING/SODDING WORK SHALL BE IN ACCORDANCE WITH THE CITY OF WICHITA STANDARD SPECIFICATIONS AND THE CITY OF WICHITA ADMINISTRATIVE REGULATION NO. AR6.5 WHICH GOVERNS CLEANUP AND RESTORATION OR REPLACEMENT FOLLOWING CONSTRUCTION.
- THE CONTRACTOR SHALL SEED ALL AREAS DISTURBED BY CONSTRUCTION ACTIVITIES WITH TEMPORARY RYE GRASS. RYE GRASS SEED SHALL BE PLANTED AT A MINIMUM RATE OF SIX (6) POUNDS PER ONE THOUSAND (1,000) SQUARE FEET. THIS TEMPORARY SEEDING MAY BE OMITTED ONLY IF OTHER SEEDING IS REQUIRED IN ACCORDANCE WITH GENERAL NOTE NO. 30 ABOVE. TEMPORARY SEEDING OR PERMANENT SEEDING/SODDING SHALL BE APPLIED WITHIN 14 DAYS AFTER THE AREA HAS BEEN DISTURBED.
- EACH BIDDER SHALL VISIT THE SITE OF THE PROJECT BEFORE SUBMITTING THE PROPOSAL FOR THIS WORK SO THAT HE WILL BE FULLY INFORMED OF THE EXISTING FIELD CONDITIONS AND THE OBSTACLES WHICH MIGHT BE ENCOUNTERED. UPON AWARD OF THE CONTRACT THE CONTRACTOR WILL NOT BE GRANTED ANY ADDITIONAL COMPENSATION WITH REGARDS TO TIME AND MONEY FOR CONDITIONS THAT MAY HAVE BEEN EVALUATED DURING ANY INSPECTION OF THE SITE.
- THE CONTRACTOR SHALL INSTALL AND/OR MAINTAIN EROSION CONTROL METHODS AS SPECIFIED. THE GENERAL LOCATION OF THE REQUIRED EROSION CONTROL IS ILLUSTRATED ON THE EROSION CONTROL PLAN. THE CONTRACTOR SHALL BE RESPONSIBLE FOR MAINTAINING THE EROSION CONTROL SHOWN THROUGH THE COMPLETION OF THIS PROJECT. INSTALLATION OF THESE BMP'S DOES NOT RELIEVE THE CONTRACTOR OF THE RESPONSIBILITY OF ABATING SOIL EROSION.

North American Specialty Deflection collars  
SIP Industries MJ TRANS PACK  
American Flow Control Valves  
Pro-trace wire  
American Darling (storz) fire hydrant  
Vinylplex C-900  
Star fittings

## PPW SHEET INDEX

SHEET NO. C3.01	PPW TITLE SHEET
SHEET NO. C3.02	PPW KEY MAP
SHEET NO. C3.03	WATERLINE LINE NO. 1
SHEET NO. C3.04	WATERLINE LINE NO. 2
SHEET NO. C3.05	STANDARD WATER ASSEMBLY DETAILS
SHEET NO. C3.06	STANDARD WATER SERVICE DETAILS
SHEET NO. C3.07	MISCELLANEOUS WATER DETAILS
SHEET NO. C2.01	COPY OF PLAT
SHEET NO. C2.02	COPY OF LOT SPLIT
SHEET NO. C5.01	EROSION CONTROL PLAN
SHEET NO. C5.02 thru C5.06	EROSION CONTROL EMP DETAILS

## KEY MAP

SEE SHEET C3.02

## HORIZONTAL CONTROL

SEE SHEET C3.02

## BENCHMARKS

SEE SHEET C3.02

## AS BUILT

Contractor: Ewertz Excavation  5/24/2017	Project Inspector: Larry Gann  <b>KEMILLER</b> ENGINEERING PA 117 E. Lewis, Wichita, KS 67202 (316)268-0242
--	--

APPROVED AS NOTED  
BY WICHITA PUBLIC WORKS  
ENGINEERING DIVISION  
& BY WICHITA FIRE DEPARTMENT

Engineering Rebecca Dill 12/21/2016  
Utilities duzney 12-21-16  
Fire Dept. Shirley 12/20/16

NOTE TO CONTRACTORS

**Public Property:**  
Inspection and testing for the waterline is to be provided by a Licensed Consulting Engineering Firm under contract with the Owner/Developer. Said inspection is to be in accordance with the City of Wichita standard construction engineering practices and certified by a Professional Engineer Licensed in the state of Kansas. No work shall be performed in dedicated easements or public right-of-way by the Contractor without such inspection nor shall any work be commenced without written authorization by City Engineering. All Construction and Materials shall comply with the City or Wichita Specifications and Standards and Special Provision (on file and available in the City Engineer's Office) or on the City's Website.

**Private Property:**  
Installation and testing for the fire protection line is to be performed by a City of Wichita licensed fire protection contractor in accordance with the fire codes as adopted by the City of Wichita. All material and construction practices for the fire protection line shall comply with the fire codes as adopted by the City of Wichita (available from the City of Wichita Fire Department). The Contractor shall not commence work without notification and approval of the Wichita Fire Department. Inspection of the fire protection line is to be provided by a licensed Engineering Firm under contract with the Owner/Developer and the Fire Department. The contractor shall not start work until the project inspector is assigned to the project and present on the site. Any work done without inspection will be required to be uncovered for inspection.

An approved copy of these plans signed by City staff are required on-site.

DECEMBER 2016



Save: 11-30-2016 8:08:41 AM by: CSM  
Plot Scale: 1" = 1'-0" 11-30-2016 8:22:33 AM by: CSM  
C:\wchita\con\2016\15433\15433.dwg (User: juan Downings) 15433-000-C3-01-PPW TITLE SHEET




PRINTS ISSUED	
DATE	PURPOSE
08.25.16	30% PROGRESS SET
09.15.16	60% PROGRESS SET
10.13.16	90% PROGRESS SET
11.10.16	BID/PERMIT SET
11.22.16	ADDENDUM #1
12.07.16	CITY COMMENTS

HAMPTON INN  
CADILLAC LAKE  
WICHITA, KANSAS




LKArchitecture  
Architecture • Engineering • Planning • Interior Design • Landscape Architecture


LKArchitecture

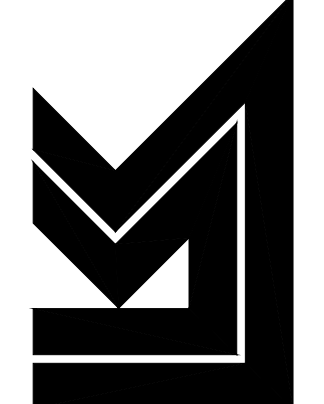

LKArchitecture, Inc.®  
345 Riverview Wichita, KS 67203  
T 316.268.0230 F 316.268.0205  
CONTACT: PEC  
DRAWN: PEC  
CHECKED: PEC  
PROJECT NUMBER:  
**15433**  
SHEET TITLE:  
PPW KEY MAP  
SHEET NUMBER:  
**C3.02** OF: X

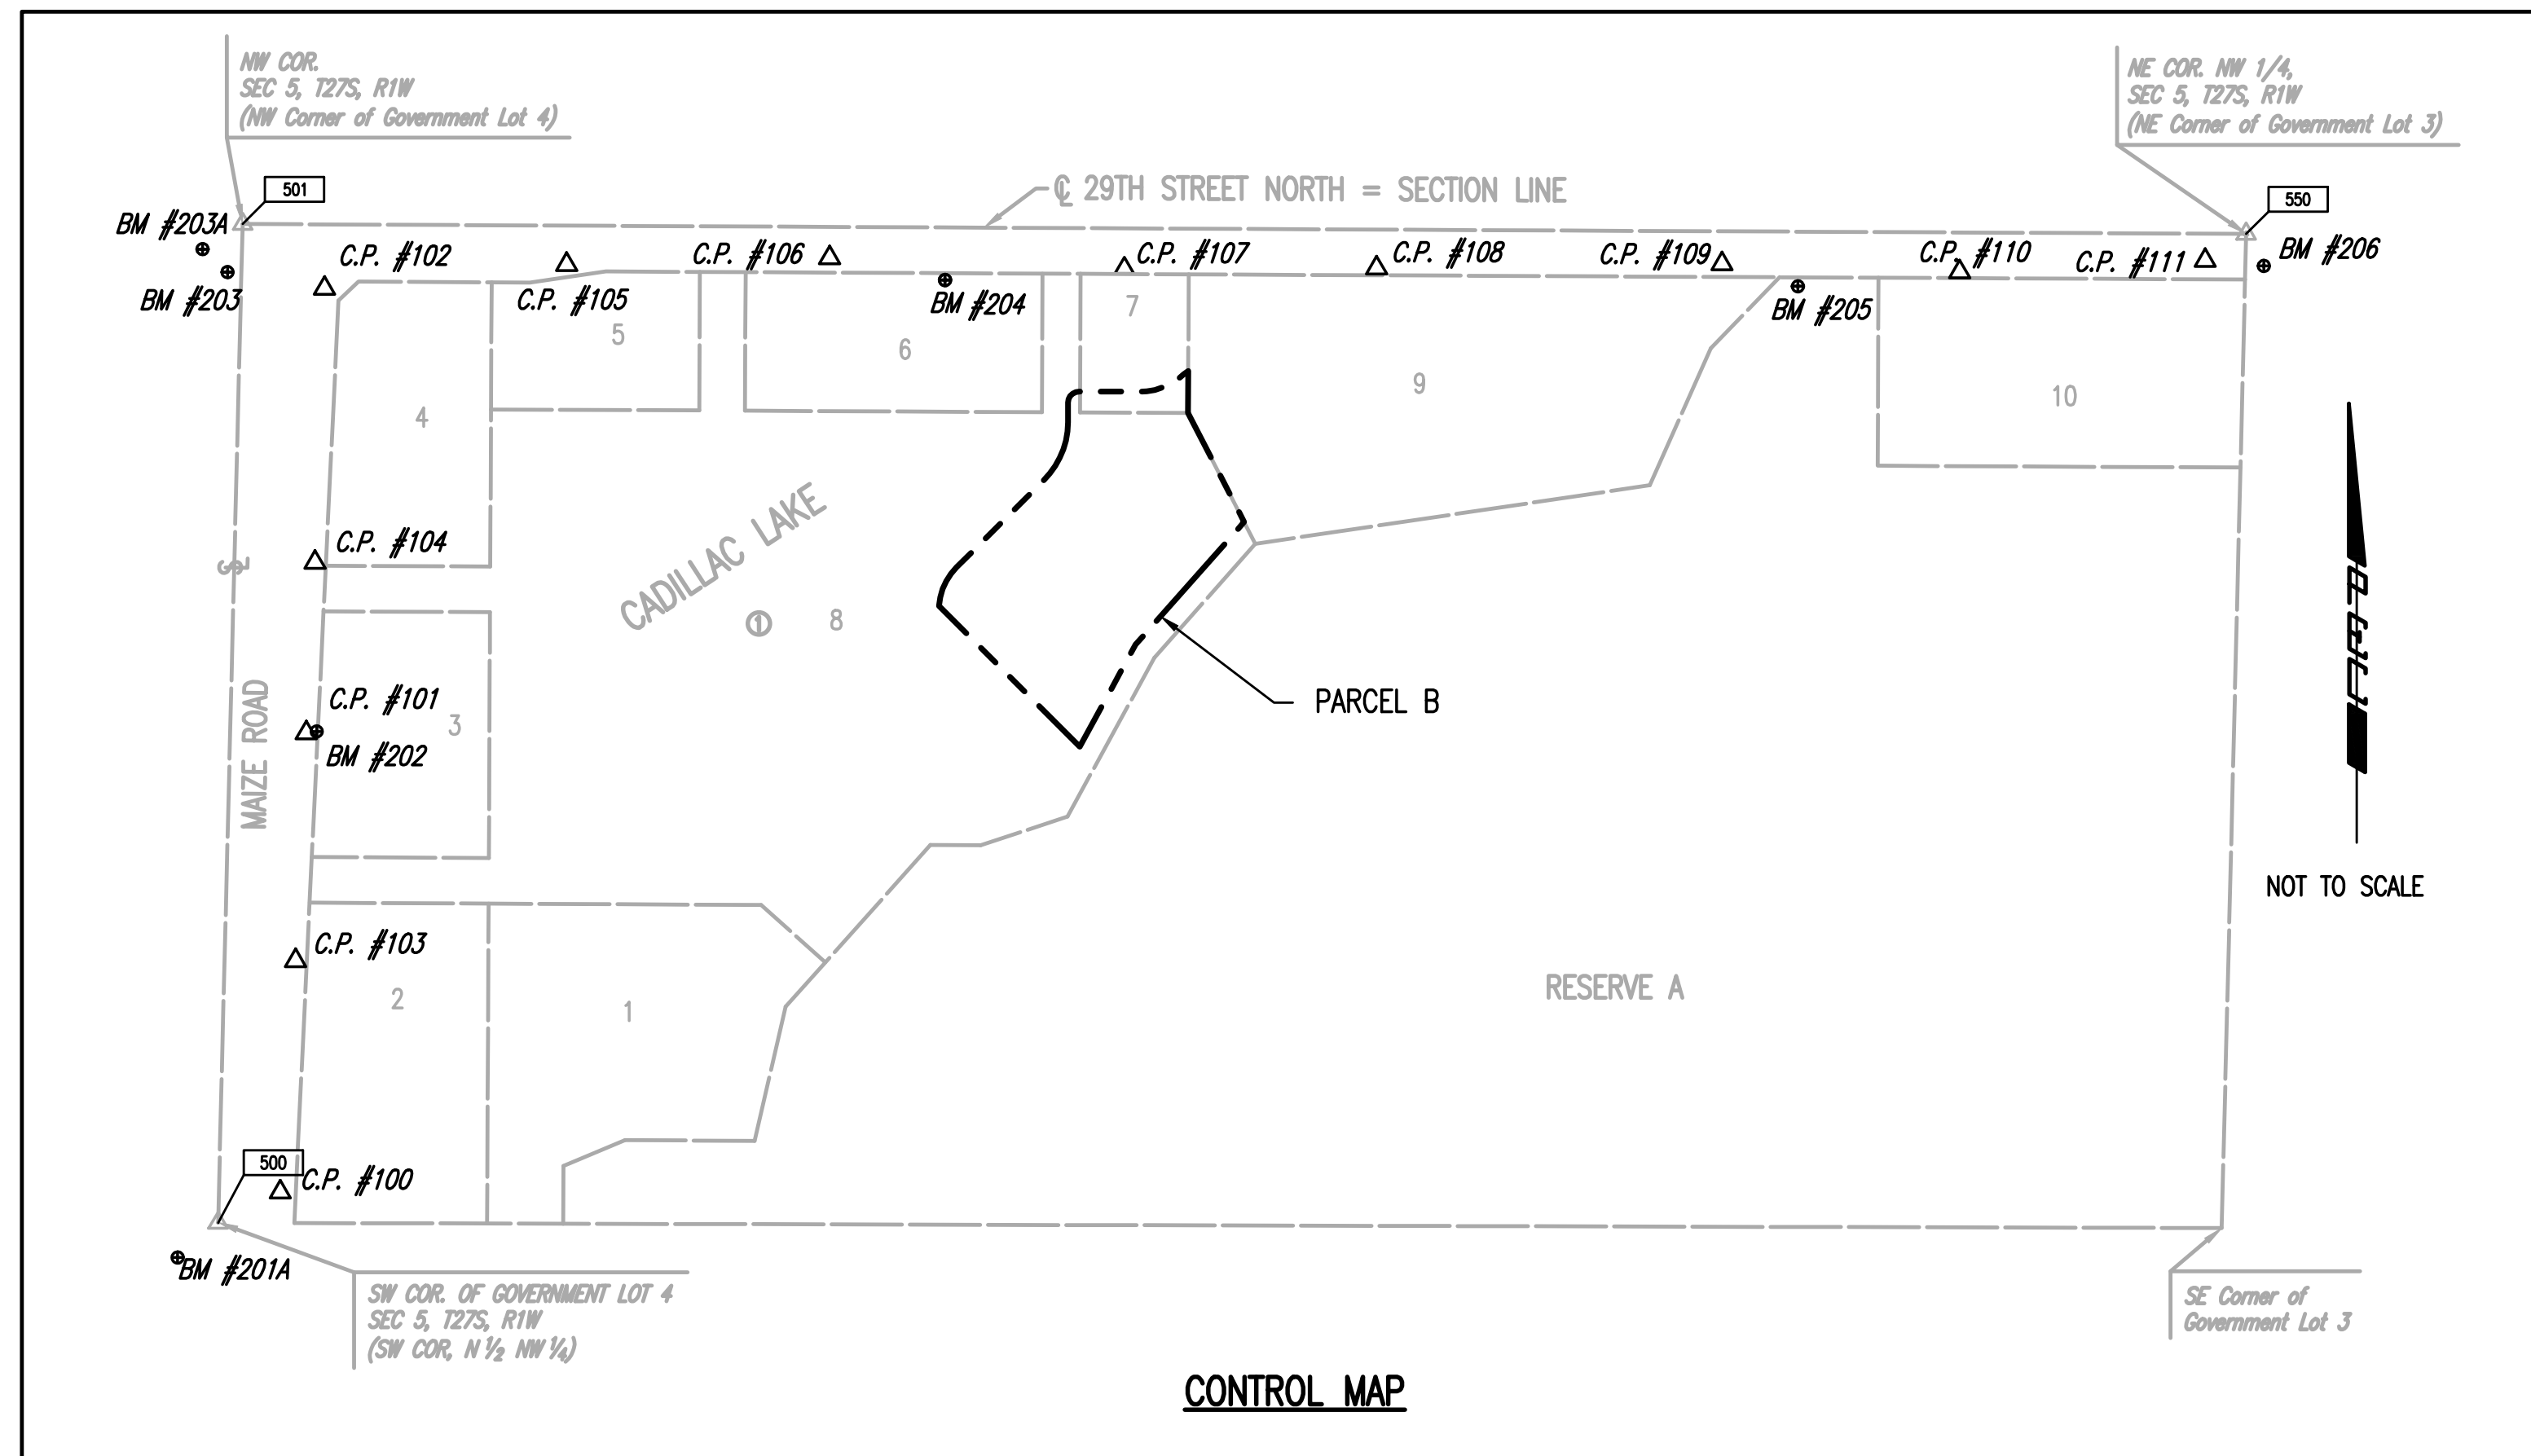

- BENCH MARK LIST**
- BM #201 - CHISELED SQUARE ON TOP OF CURB, NORTH SIDE OF DRIVE ENTRANCE TO NORTHEAST CORNER OF TARGET PARKING LOT AND SOUTHWEST OF SOUTHWEST CORNER OF GOVERNMENT LOT 4, SEC 5-27-1W. ELEV.=1352.79 (NAVD88)
  - BM #202 - CHISELED "X" ON NORTH RIM OF TELEPHONE MANHOLE AT PVC TELEPHONE MARKER POST, 35 FEET SOUTH OF POWER POLE #82115, ON EAST SIDE OF ASPHALT BIKE PATH ON EAST SIDE OF MAIZE ROAD, 4 POLES NORTH OF TARGET, 3 POLES SOUTH OF 29TH STREET NORTH. ELEV.= 1350.53 (NAVD88)
  - BM #203 - CHISELED SQUARE AT SOUTHEAST CORNER OF SOUTH HEADWALL FOR RCBC UNDER 29TH STREET, WEST OF MAIZE MAIZE ROAD (NOT THE CHISELED + AT THE SOUTHWEST CORNER OF SAME HEADWALL). ELEV.= 1353.32 (NAVD88)
  - BM #203A - CHISELED SQUARE ON TOP OF CURB INLET WEST SOUTHWEST OF 29H STREET AND MAIZE ROAD (DOES NOT INCLUDE ROUND PLASTIC DISK GLUED OVER PART OF SQUARE). ELEV.= 1351.98 (NAVD88)
  - BM #204 - CHISELED SQUARE ON TOP OF RETAINING WALL AT SOUTHEAST CORNER OF CONCRETE PAD FOR ELECTRIC TRANSFORMER #10105 ON SOUTH SIDE OF 29TH STREET AND 800 FEET EAST OF BIKE PATH ON EAST SIDE OF MAIZE ROAD. ELEV.= 1352.01 (NAVD88)
  - BM #205 - CHISELED SQUARE ON HIGH POINT OF EAST WINGWALL AT SOUTH END OF RCBC UNDER 29TH STREET, 600 FEET WEST OF NORTH 1/4 CORNER SECTION 5-27-1W, FOR POND GOING SOUTH. ELEV.= 1350.99 (NAVD88)
  - BM #206 - CHISELED SQUARE ON NORTH EDGE OF CURVE SIDEWALK AT FIRE HYDRANT ON SOUTH SIDE OF 29TH STREET, 1/2 MILE EAST OF MAIZE ROAD, SOUTHEAST OF N 1/4 CORNER SEC 5-27-1W. ELEV.= 1350.92 (NAVD88)
- CONTROL POINTS**
- Pl. No. 100 #4 BAR N: 8,994.2040, E: 5,177.5870
  - Pl. No. 101 #4 BAR N: 9,597.4580, E: 5,211.7520
  - Pl. No. 102 #4 BAR N: 10,181.5580, E: 5,235.6590
  - Pl. No. 103 #4 BAR N: 9,298.2310, E: 5,197.6390
  - Pl. No. 104 #4 BAR N: 9,821.4260, E: 5,223.2540
  - Pl. No. 105 #4 BAR N: 10,212.7870, E: 5,553.7820
  - Pl. No. 106 #4 BAR N: 10,221.5930, E: 5,899.2830
  - Pl. No. 107 #4 BAR N: 10,208.9100, E: 6,288.5020
  - Pl. No. 108 #4 BAR N: 10,208.1070, E: 6,617.7130
  - Pl. No. 109 #4 BAR N: 10,213.7460, E: 7,071.5560
  - Pl. No. 110 #4 BAR N: 10,202.9280, E: 7,383.7340
  - Pl. No. 111 #4 BAR N: 10,218.1220, E: 7,706.3080
- SECTION CORNER**
- PL No. 500 EAST 1/16, NORTHEAST 1/4, SEC6, T27S, R1W N: 8,950.4810, E: 5,005.8080 1/2" BAUGHMAN CAPPED REBAR IN ASPHALT 53.47' NORTHWEST TO 3 NAILS IN S.W.B. POLE 115.26' SOUTHWEST TO 3 NAILS IN S.W.B. POLE 83.59' SOUTHEAST TO 60M NAIL IN POWER POLE 36.30' W TO "4" CROSS ON TOP OF 12' C.M.P.
  - PL No. 501 NORTHEAST CORNER, SEC 6, T27S, R1W N: 10,266.0020, E: 5,128.1290 3/4" IRON PIPE IN ASPHALT 54.30' SOUTHEAST TO 3 NAILS IN UNDERGROUND MARKER POST 64.27' SOUTHWEST TO 60M NAIL IN TELEPHONE POLE 48.65' NORTHEAST TO 3 NAILS IN HIGH LINE POLE 46.40' NORTHWEST TO 3 NAILS IN HIGH LINE POLE
  - PL No. 550 EAST 1/4 CORNER, SEC6, T27S, R1W N: 10,253.0550, E: 7,780.2070 1/2" IRON PIPE IN ASPHALT 47.98' SOUTHEAST TO "4" CROSS ON SOUTH FACE OF STEEL GATE POST 69.20' EAST TO "4" CROSS ON NORTH FACE OF STEEL GATE POST 45.70' NORTHEAST TO 3 NAILS IN FENCE POST 39.67' WEST SOUTHWEST TO 2 NAILS IN TELEPHONE POLE

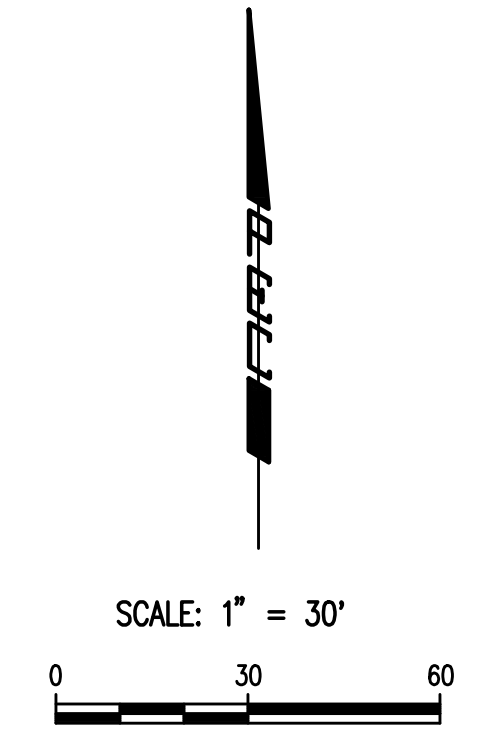


- LEGEND**
- EXISTING WATER MAIN
  - PROPOSED WATER MAIN
  - EXISTING WATER VALVE
  - PROPOSED WATER VALVE
  - EXISTING FIRE HYDRANT
  - PROPOSED FIRE HYDRANT

**PROPERTY COORDINATE LIST**

POINT	NORTH	EAST
1	10,045.9679	6,227.0301
2	10,045.5840	6,305.0744
3	10,068.3250	6,364.3094
4	10,072.8320	6,370.3439
5	10,017.8900	6,370.0737
6	9,874.5899	6,443.7422
7	9,713.5303	6,301.2376
8	9,579.3716	6,227.7456
9	9,784.4244	6,042.8851
10	9,814.8795	6,065.9883
11	9,929.2857	6,180.5135
12	10,005.5129	6,212.3310
13	10,031.5394	6,212.4590



① = COORDINATE POINT NO.

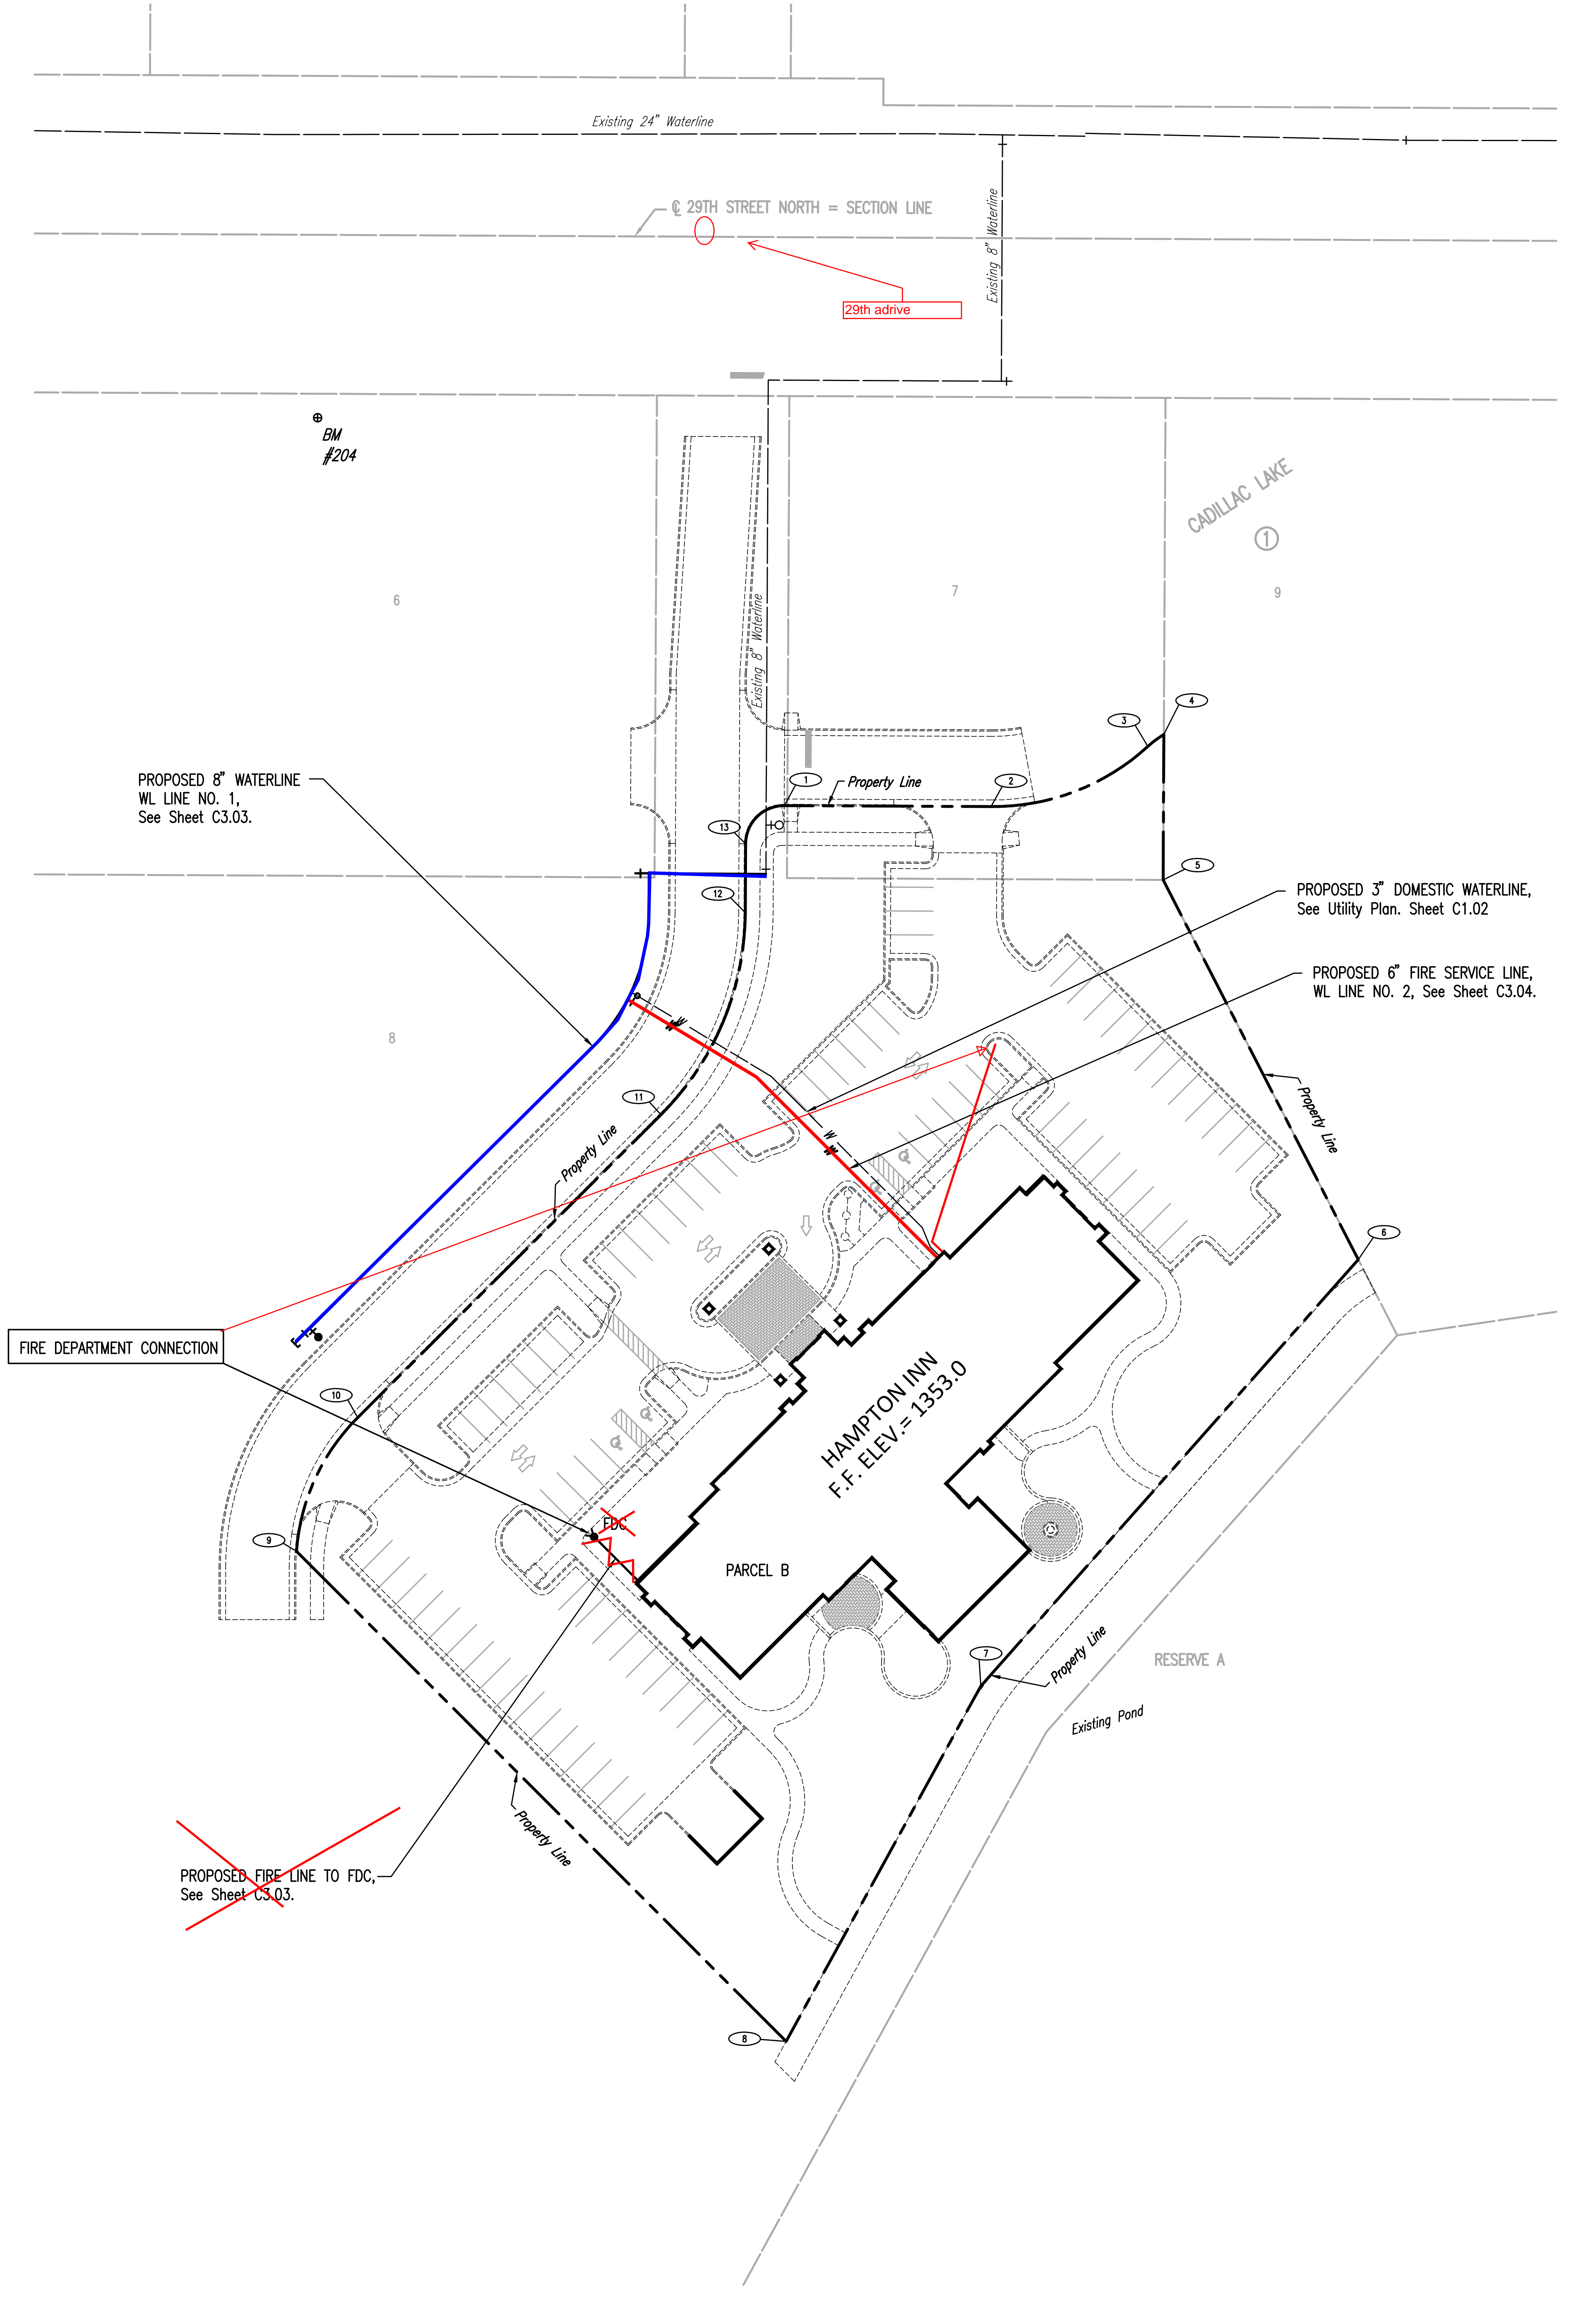

Sheet 11-18-2016 2:16:44 PM by CSI  
Plot Scale 1:1 = 30'-0"=2016 8:22:50 AM by CSI  
U:\Wichita-Cadillac Lake\160551\000\Main\Drawings\160551-000-C3-02-PPW KEY MAP



DATE	PURPOSE	NO.
08.25.16	30% PROGRESS SET	
09.15.16	60% PROGRESS SET	
10.13.16	90% PROGRESS SET	
11.10.16	BID/PERMIT SET	
11.22.16	ADDENDUM #1	
12.07.16	CITY COMMENTS	

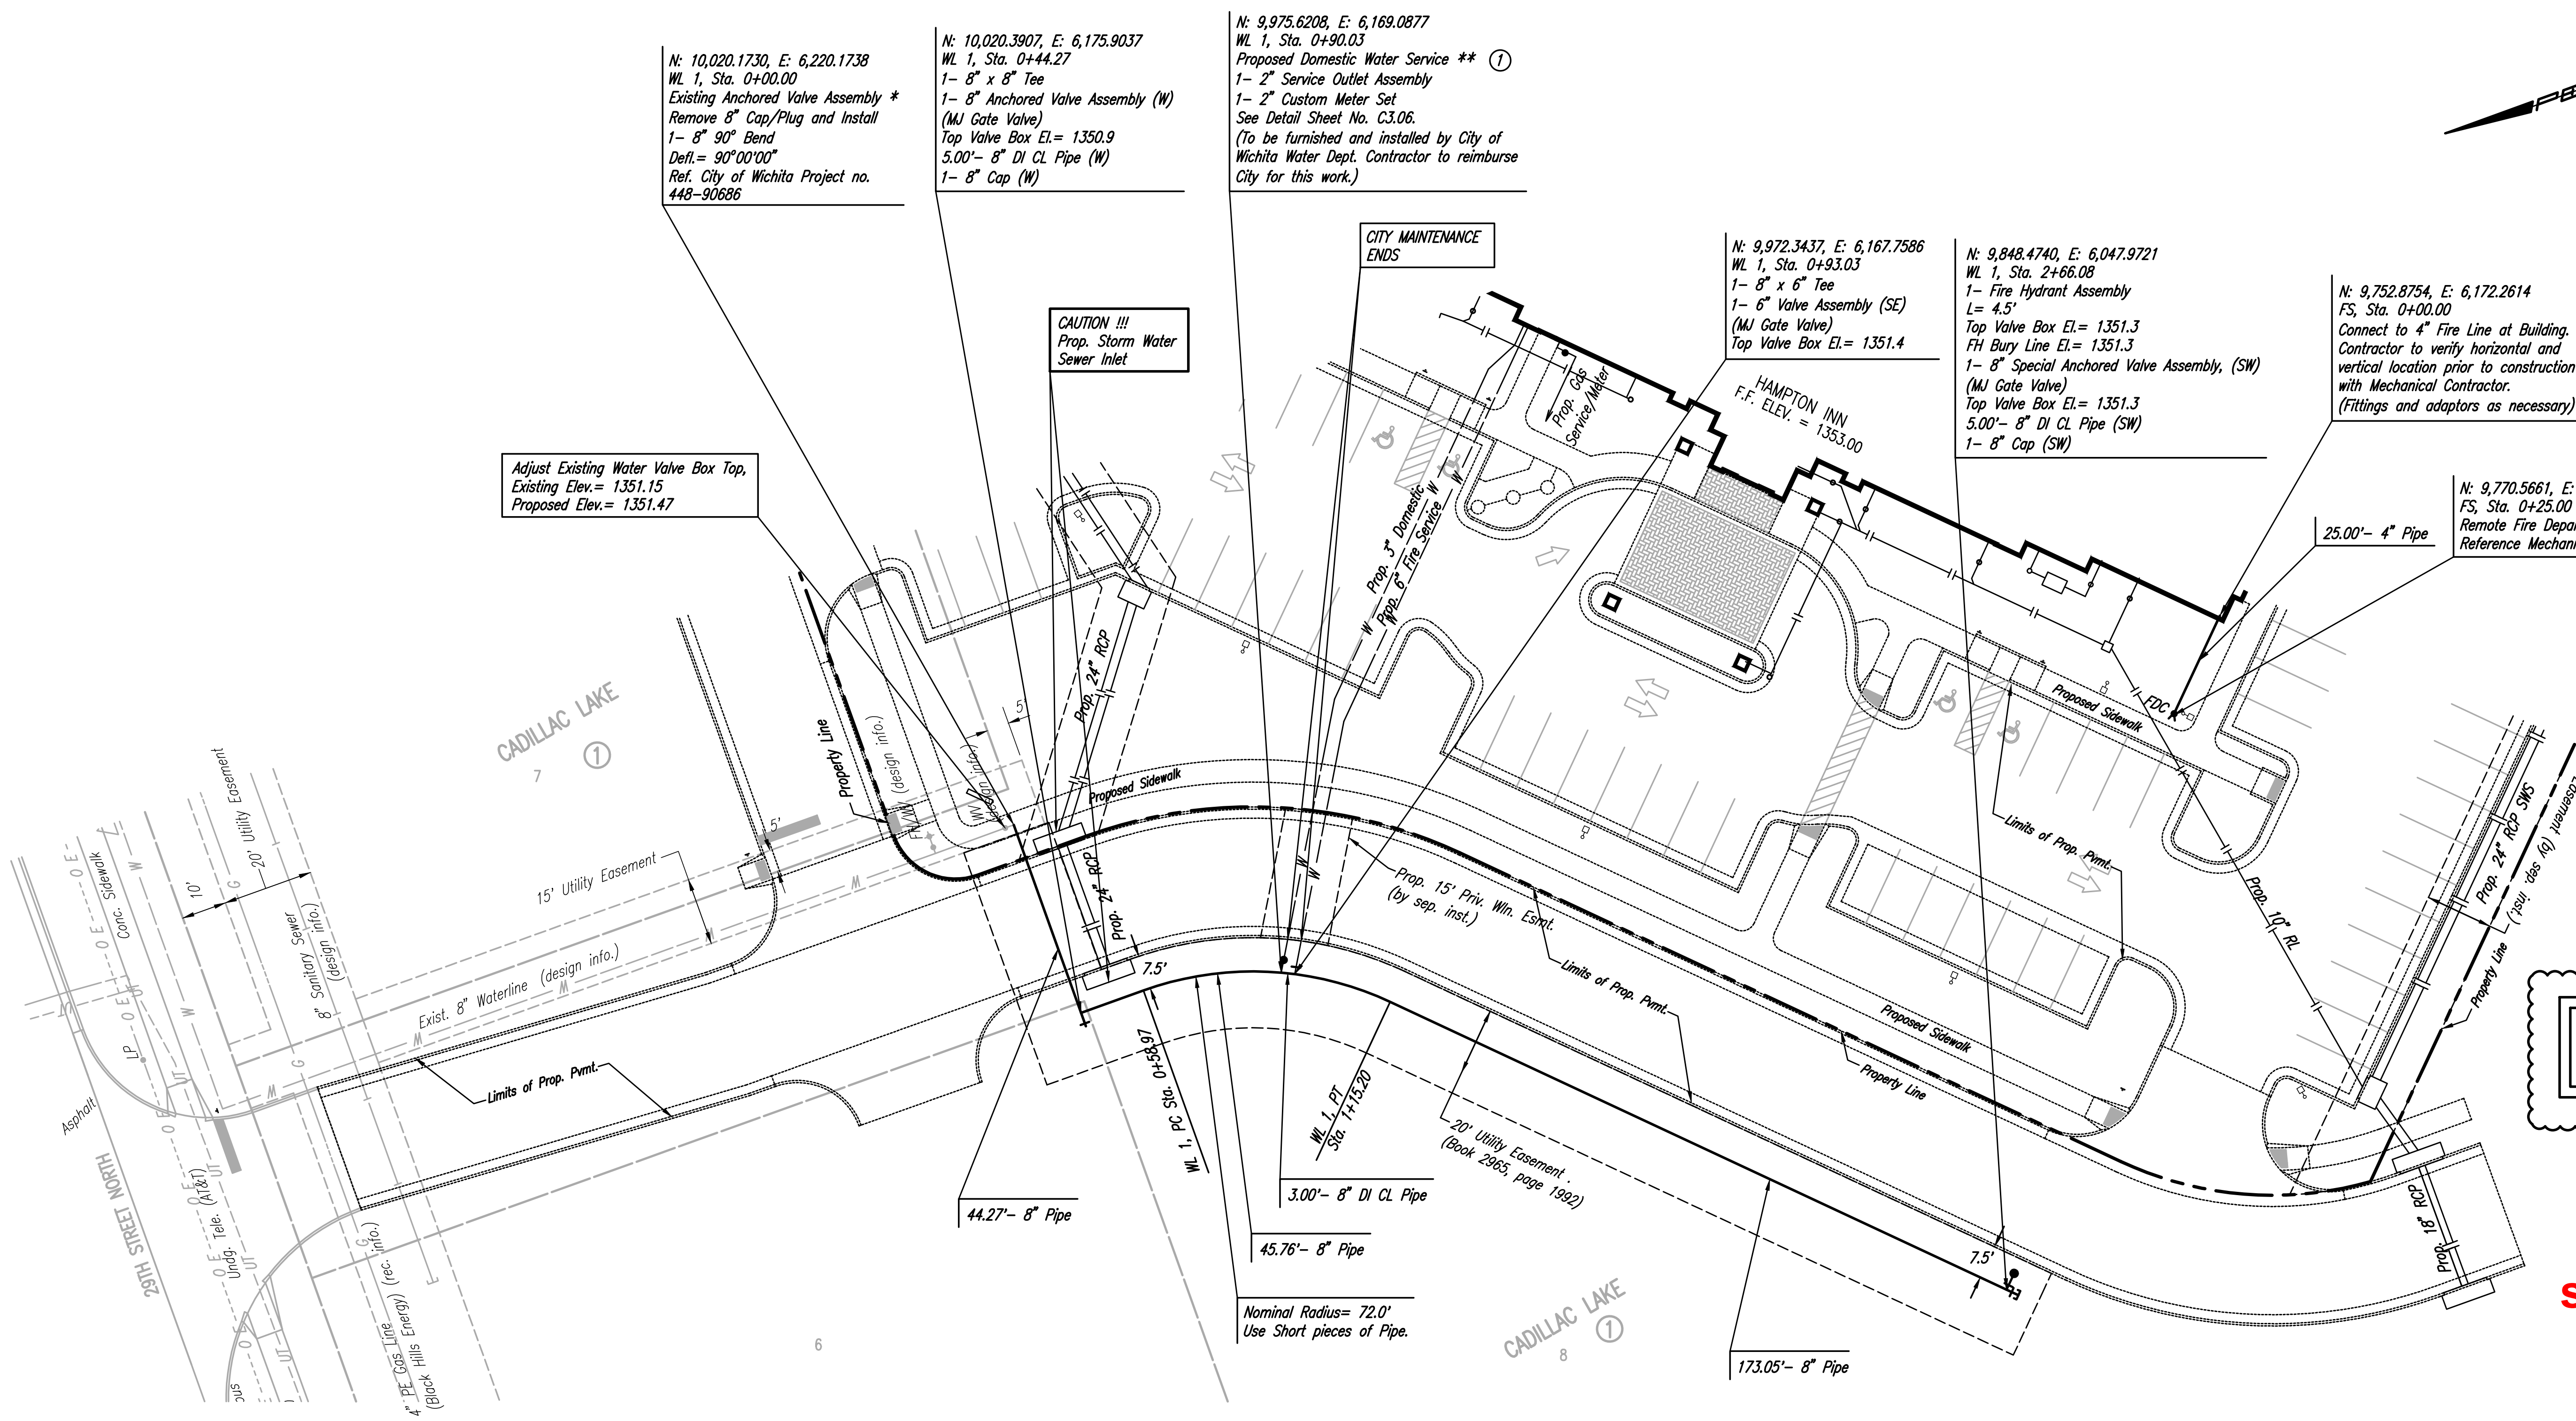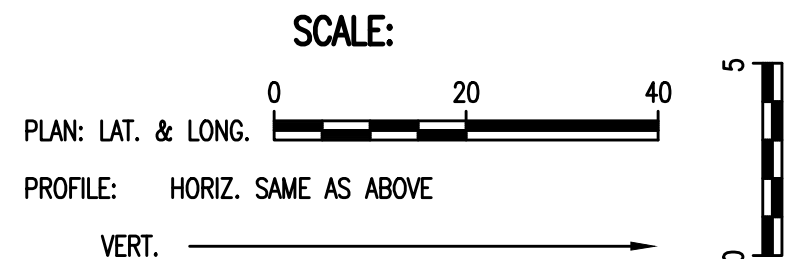

- \* PRIOR TO BEGINNING CONSTRUCTION, THE CONTRACTOR SHALL EXCAVATE THE EXISTING 8" WATERLINE AT STATION 0+00.00 TO VERIFY PIPE SIZE, TYPE, FITTINGS, AND HORIZONTAL AND VERTICAL LOCATION. THE CONTRACTOR SHALL REPORT HIS FINDINGS TO THE ENGINEER SO THAT ANY NECESSARY PLAN MODIFICATIONS CAN BE MADE. ANY ADDITIONAL LABOR OR MATERIALS NECESSARY TO COMPLETE THE CONNECTION SHALL BE CONSIDERED SUBSIDIARY TO THE PROJECT.
- \*\* FINAL METER LOCATION TO BE DETERMINED BY CITY OF WICHITA WATER DEPARTMENT. WATERLINE CONSTRUCTION SHALL OCCUR PRIOR TO NEW PAVEMENT CONSTRUCTION.
- ① FINAL VALVE BOX ELEVATION TO BE SET BY THE CONTRACTOR. FINAL VALVE BOX ELEVATION = 1351.5

NOTE:  
 CONTRACTOR SHALL COORDINATE WATERLINE INSTALLATION WITH THE WATER MAIN CONTRACTOR. THE CADILLAC LAKE WATER LINE - PHASE 1A - COW PROJECT NO. 448-90686 SHALL BE COMPLETED AND ACCEPTED BY THE CITY OF WICHITA PRIOR TO CONNECTION.

ALL WORK ON THIS SHEET SHALL BE INCLUDED IN THE BID ALTERNATE #1 PRICE ON THE BID FORM.


see revised sheet next page

HAMPTON INN  
 CADILLAC LAKE  
 WICHITA, KANSAS



LKArchitecture  
 Architecture • Engineering • Planning • Interior Design • Landscape Architecture

LKArchitecture

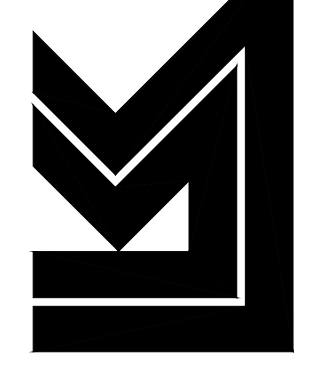

LKArchitecture, Inc.®  
 345 Riverview Wichita, KS 67203  
 T 316.268.0230 F 316.268.0205

CONTACT: PEC  
 DRAWN: PEC  
 CHECKED: PEC

PROJECT NUMBER:  
**15433**

SHEET TITLE:  
 WATERLINE NO. 1


SHEET NUMBER:  
**C3.03** OF: X

PROFESSIONAL ENGINEERING CONSULTANTS, P.A.  
 303 SOUTH TOPEKA WICHITA, KS 67202  
 316-262-2991 www.pec1.com



WATERLINE NO. 1


FIRE SERVICE LINE TO FDC

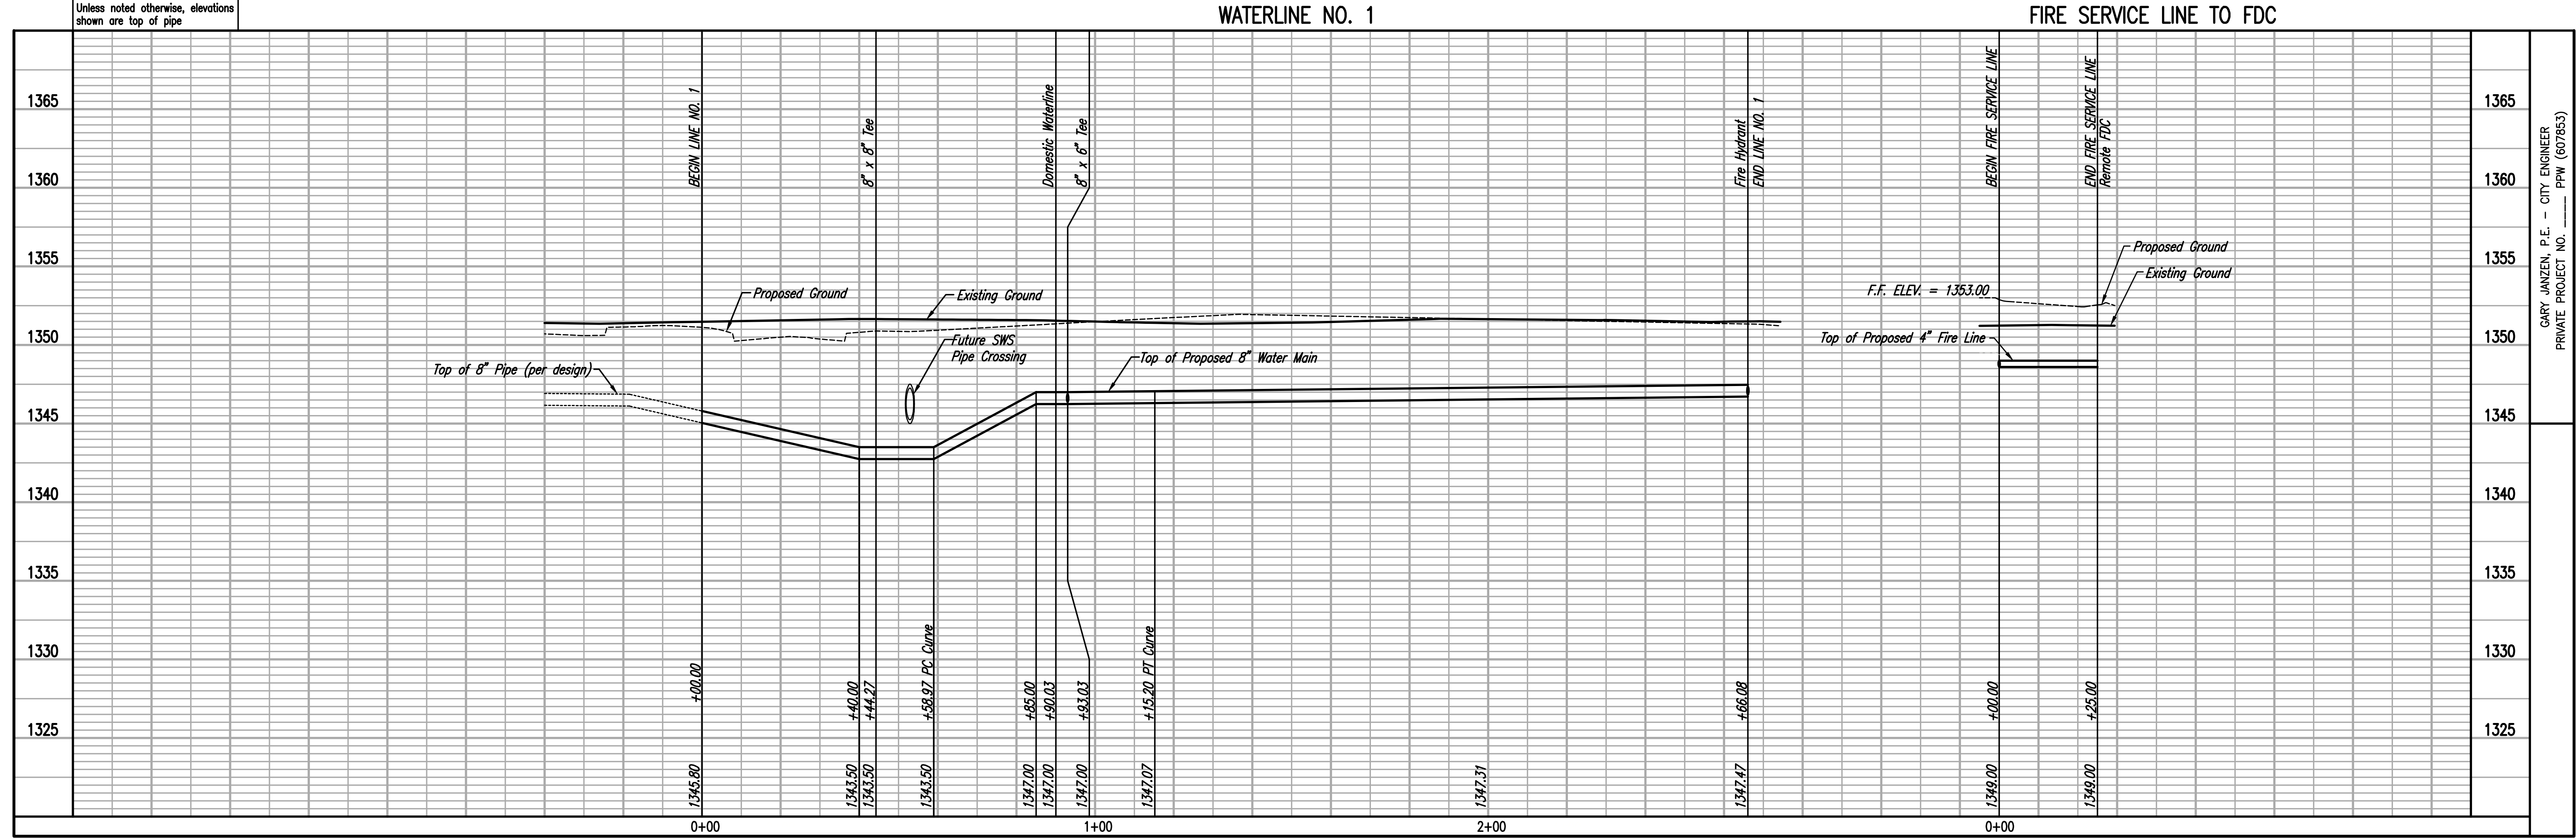

Sheet 11-30-2016 9:11:06 AM by CSI  
 Plot Scale 1:1 11-30-2016 9:11:23 AM by CSI  
 U:\Wichita-Cad\2016\160551\000\Main\Drawings\160551-000-C3-03-WATERLINE NO. 1

From center of 29th Street and center of South drive,  
240' South 29.4' East to existing valve.  
18' West to valve  
2' East of valve to tee from valve West 6' to cap

From same tee South 48.76' to Line 2 tee and 2' East  
of that tee is a valve  
From tee Line 2 North 7' is a deflection collar.

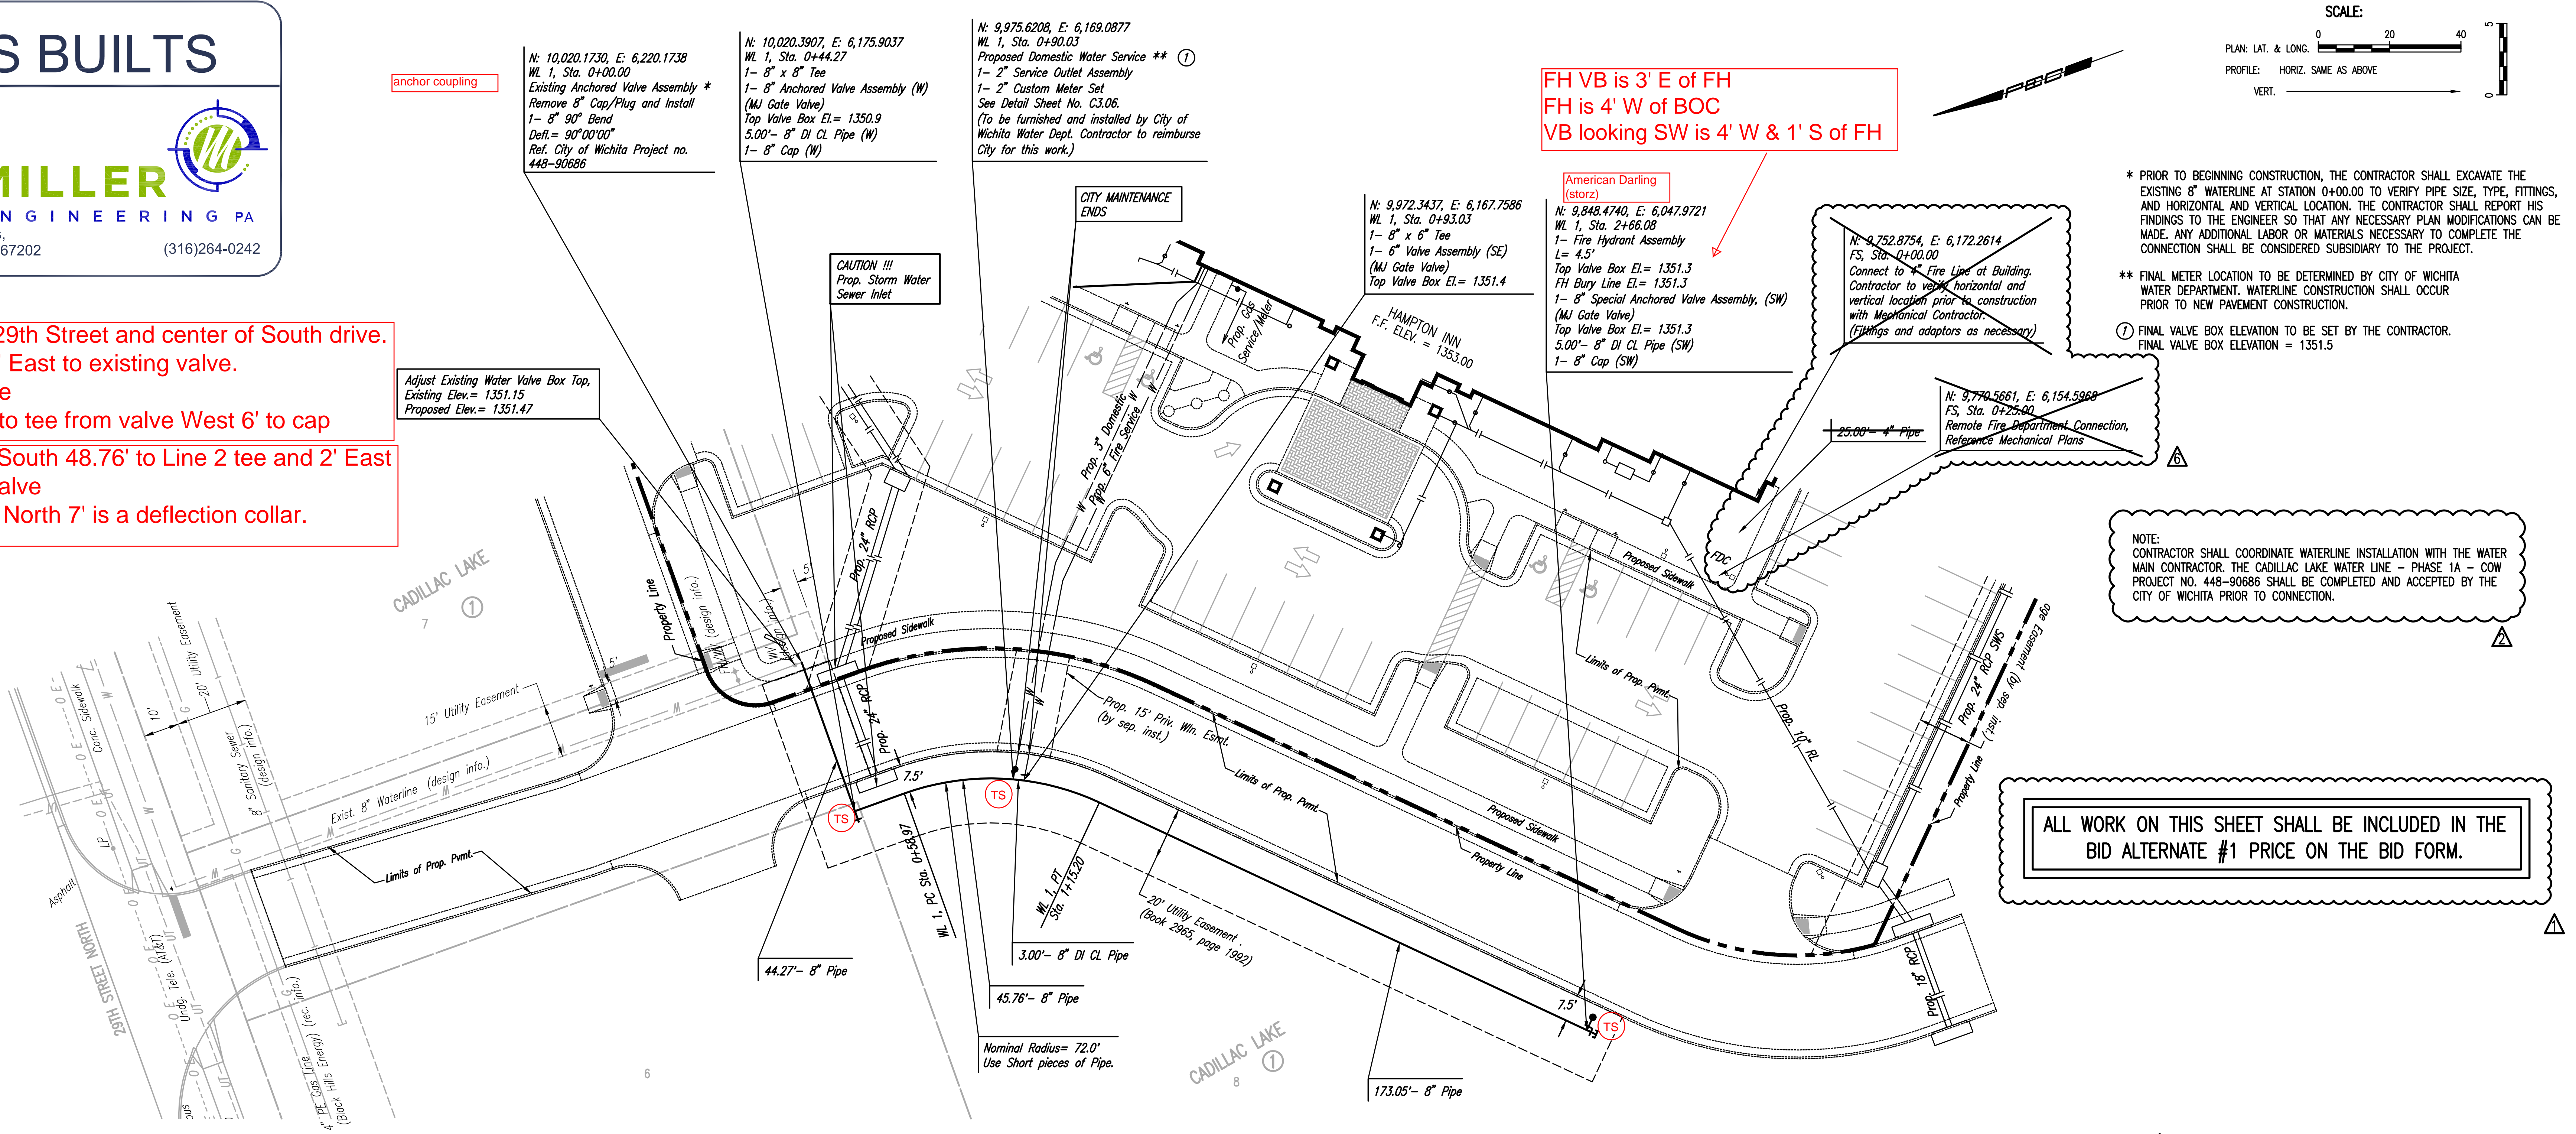


ALL WORK ON THIS SHEET SHALL BE INCLUDED IN THE  
BID ALTERNATE #1 PRICE ON THE BID FORM.

NOTE:  
CONTRACTOR SHALL COORDINATE WATERLINE INSTALLATION WITH THE WATER  
MAIN CONTRACTOR. THE CADILLAC LAKE WATER LINE - PHASE 1A - COW  
PROJECT NO. 448-90886 SHALL BE COMPLETED AND ACCEPTED BY THE  
CITY OF WICHITA PRIOR TO CONNECTION.

\* PRIOR TO BEGINNING CONSTRUCTION, THE CONTRACTOR SHALL EXCAVATE THE  
EXISTING 8" WATERLINE AT STATION 0+00.00 TO VERIFY PIPE SIZE, TYPE, FITTINGS,  
AND HORIZONTAL AND VERTICAL LOCATION. THE CONTRACTOR SHALL REPORT HIS  
FINDINGS TO THE ENGINEER SO THAT ANY NECESSARY PLAN MODIFICATIONS CAN BE  
MADE. ANY ADDITIONAL LABOR OR MATERIALS NECESSARY TO COMPLETE THE  
CONNECTION SHALL BE CONSIDERED SUBSIDIARY TO THE PROJECT.

\*\* FINAL METER LOCATION TO BE DETERMINED BY CITY OF WICHITA  
WATER DEPARTMENT. WATERLINE CONSTRUCTION SHALL OCCUR  
PRIOR TO NEW PAVEMENT CONSTRUCTION.

① FINAL VALVE BOX ELEVATION TO BE SET BY THE CONTRACTOR.  
FINAL VALVE BOX ELEVATION = 1351.5

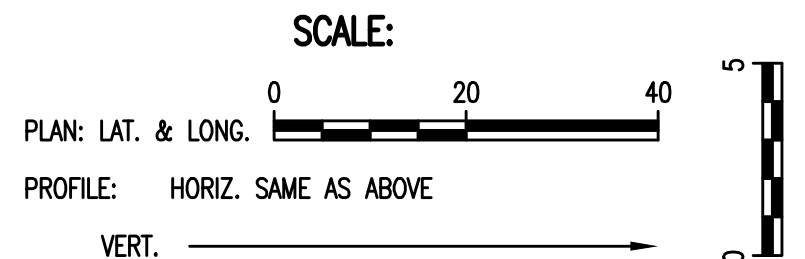


PRINTS ISSUED

DATE	PURPOSE	NO.
08.25.16	30% PROGRESS SET	1
09.15.16	60% PROGRESS SET	2
10.13.16	90% PROGRESS SET	3
11.10.16	BID/PERMIT SET	4
11.22.16	ADDENDUM #1	5
12.07.16	CITY COMMENTS	6
12.21.16	CITY COMMENTS	7
3.07.17	MISC. REVISIONS	8
3.17.17	MISC. REVISIONS	9

HAMPTON INN  
CADILLAC LAKE  
WICHITA, KANSAS



LKArchitecture  
Architecture • Engineering • Planning • Interior Design • Landscape Architecture




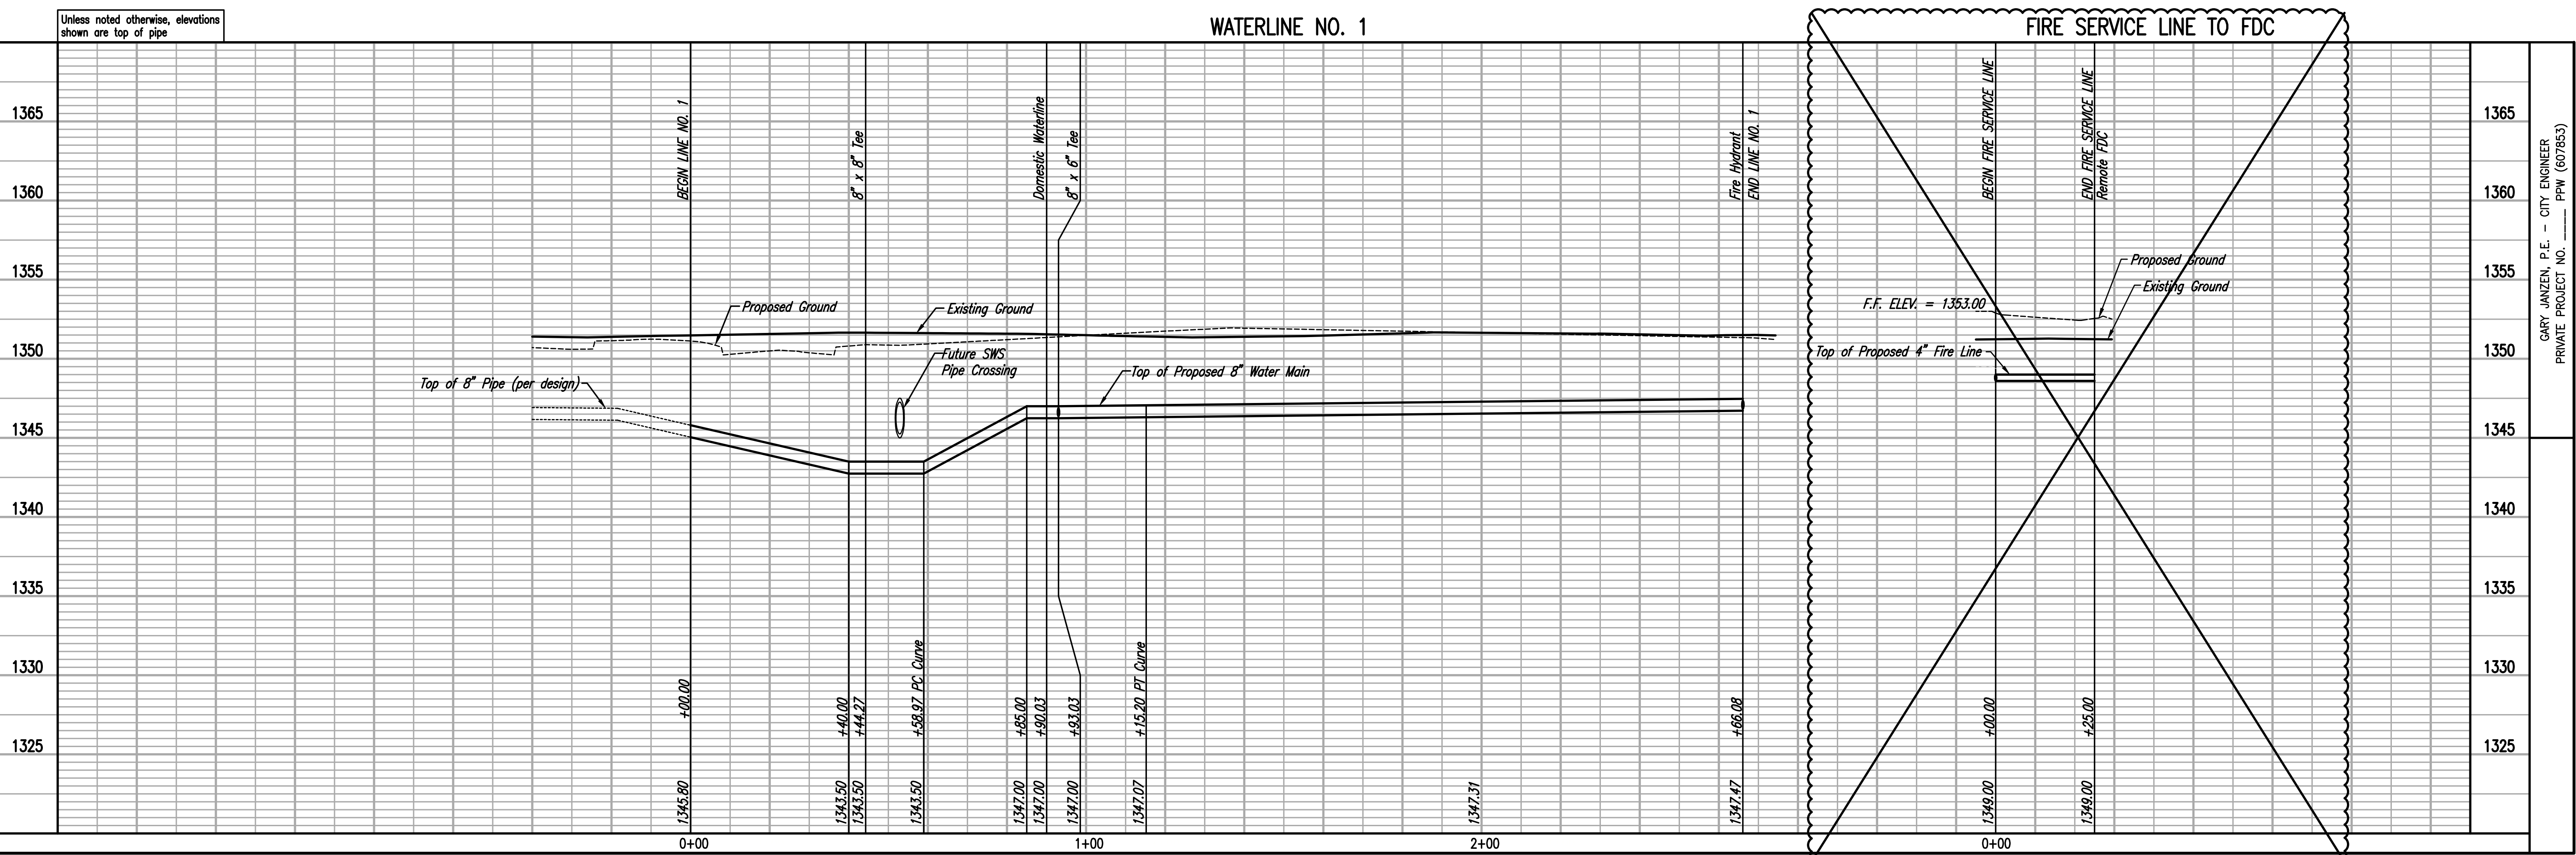


PROFESSIONAL ENGINEERING CONSULTANTS, P.A.  
303 SOUTH TOPEKA, WICHITA, KS 67202  
316-262-2991 www.pec1.com



Sheet: 03-31-2017, 3:54 PM by CSJ  
Plot: Scale: 1:1, 03-21-2017, 4:01:25 PM by CSJ  
U:\Wichita-Cad\2016\160551\000\Main\Drawings\160551-000-03-WATERLINE NO. 1



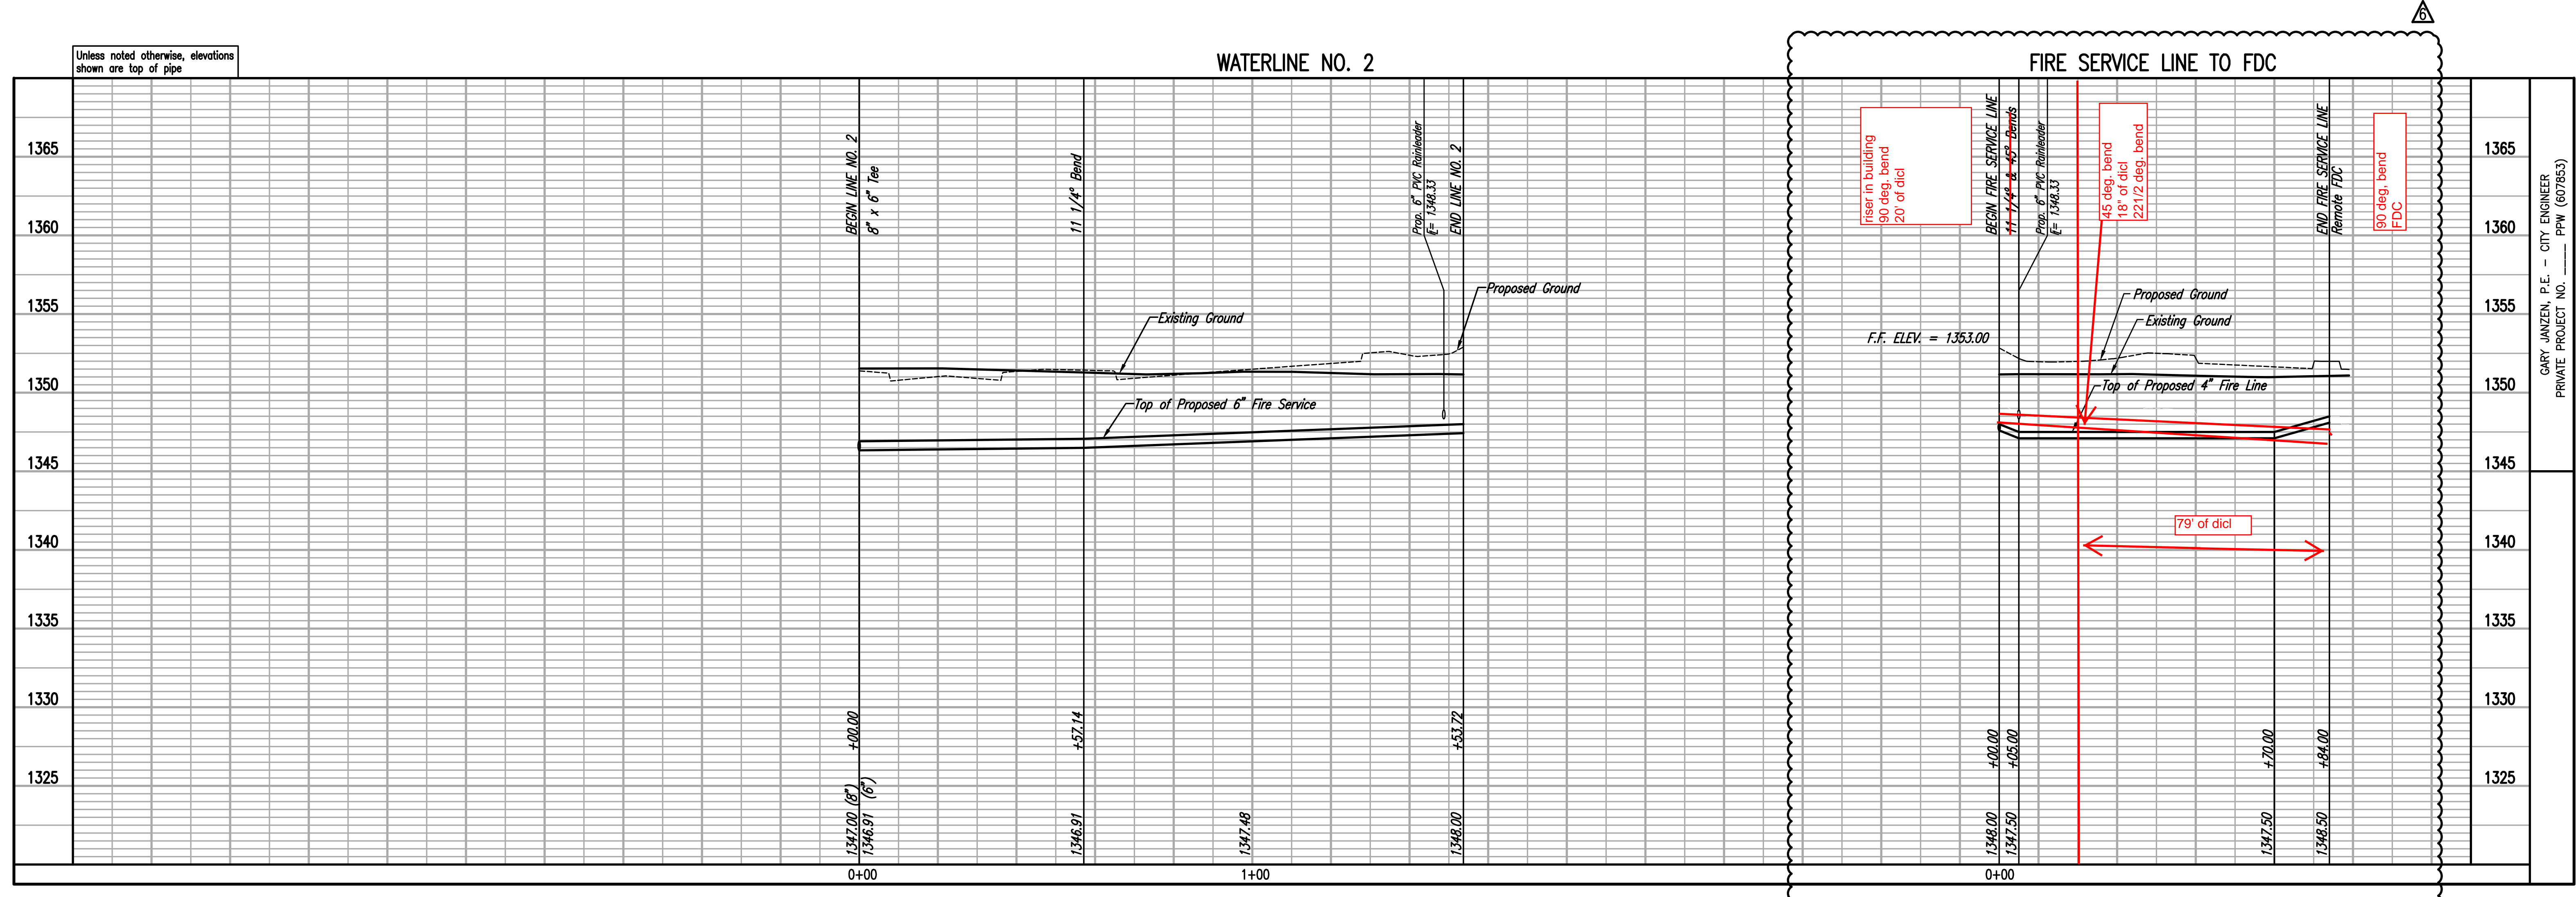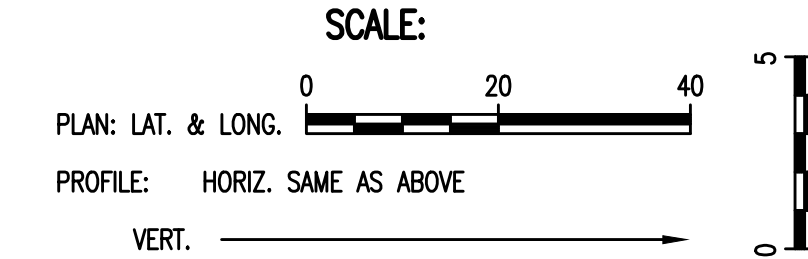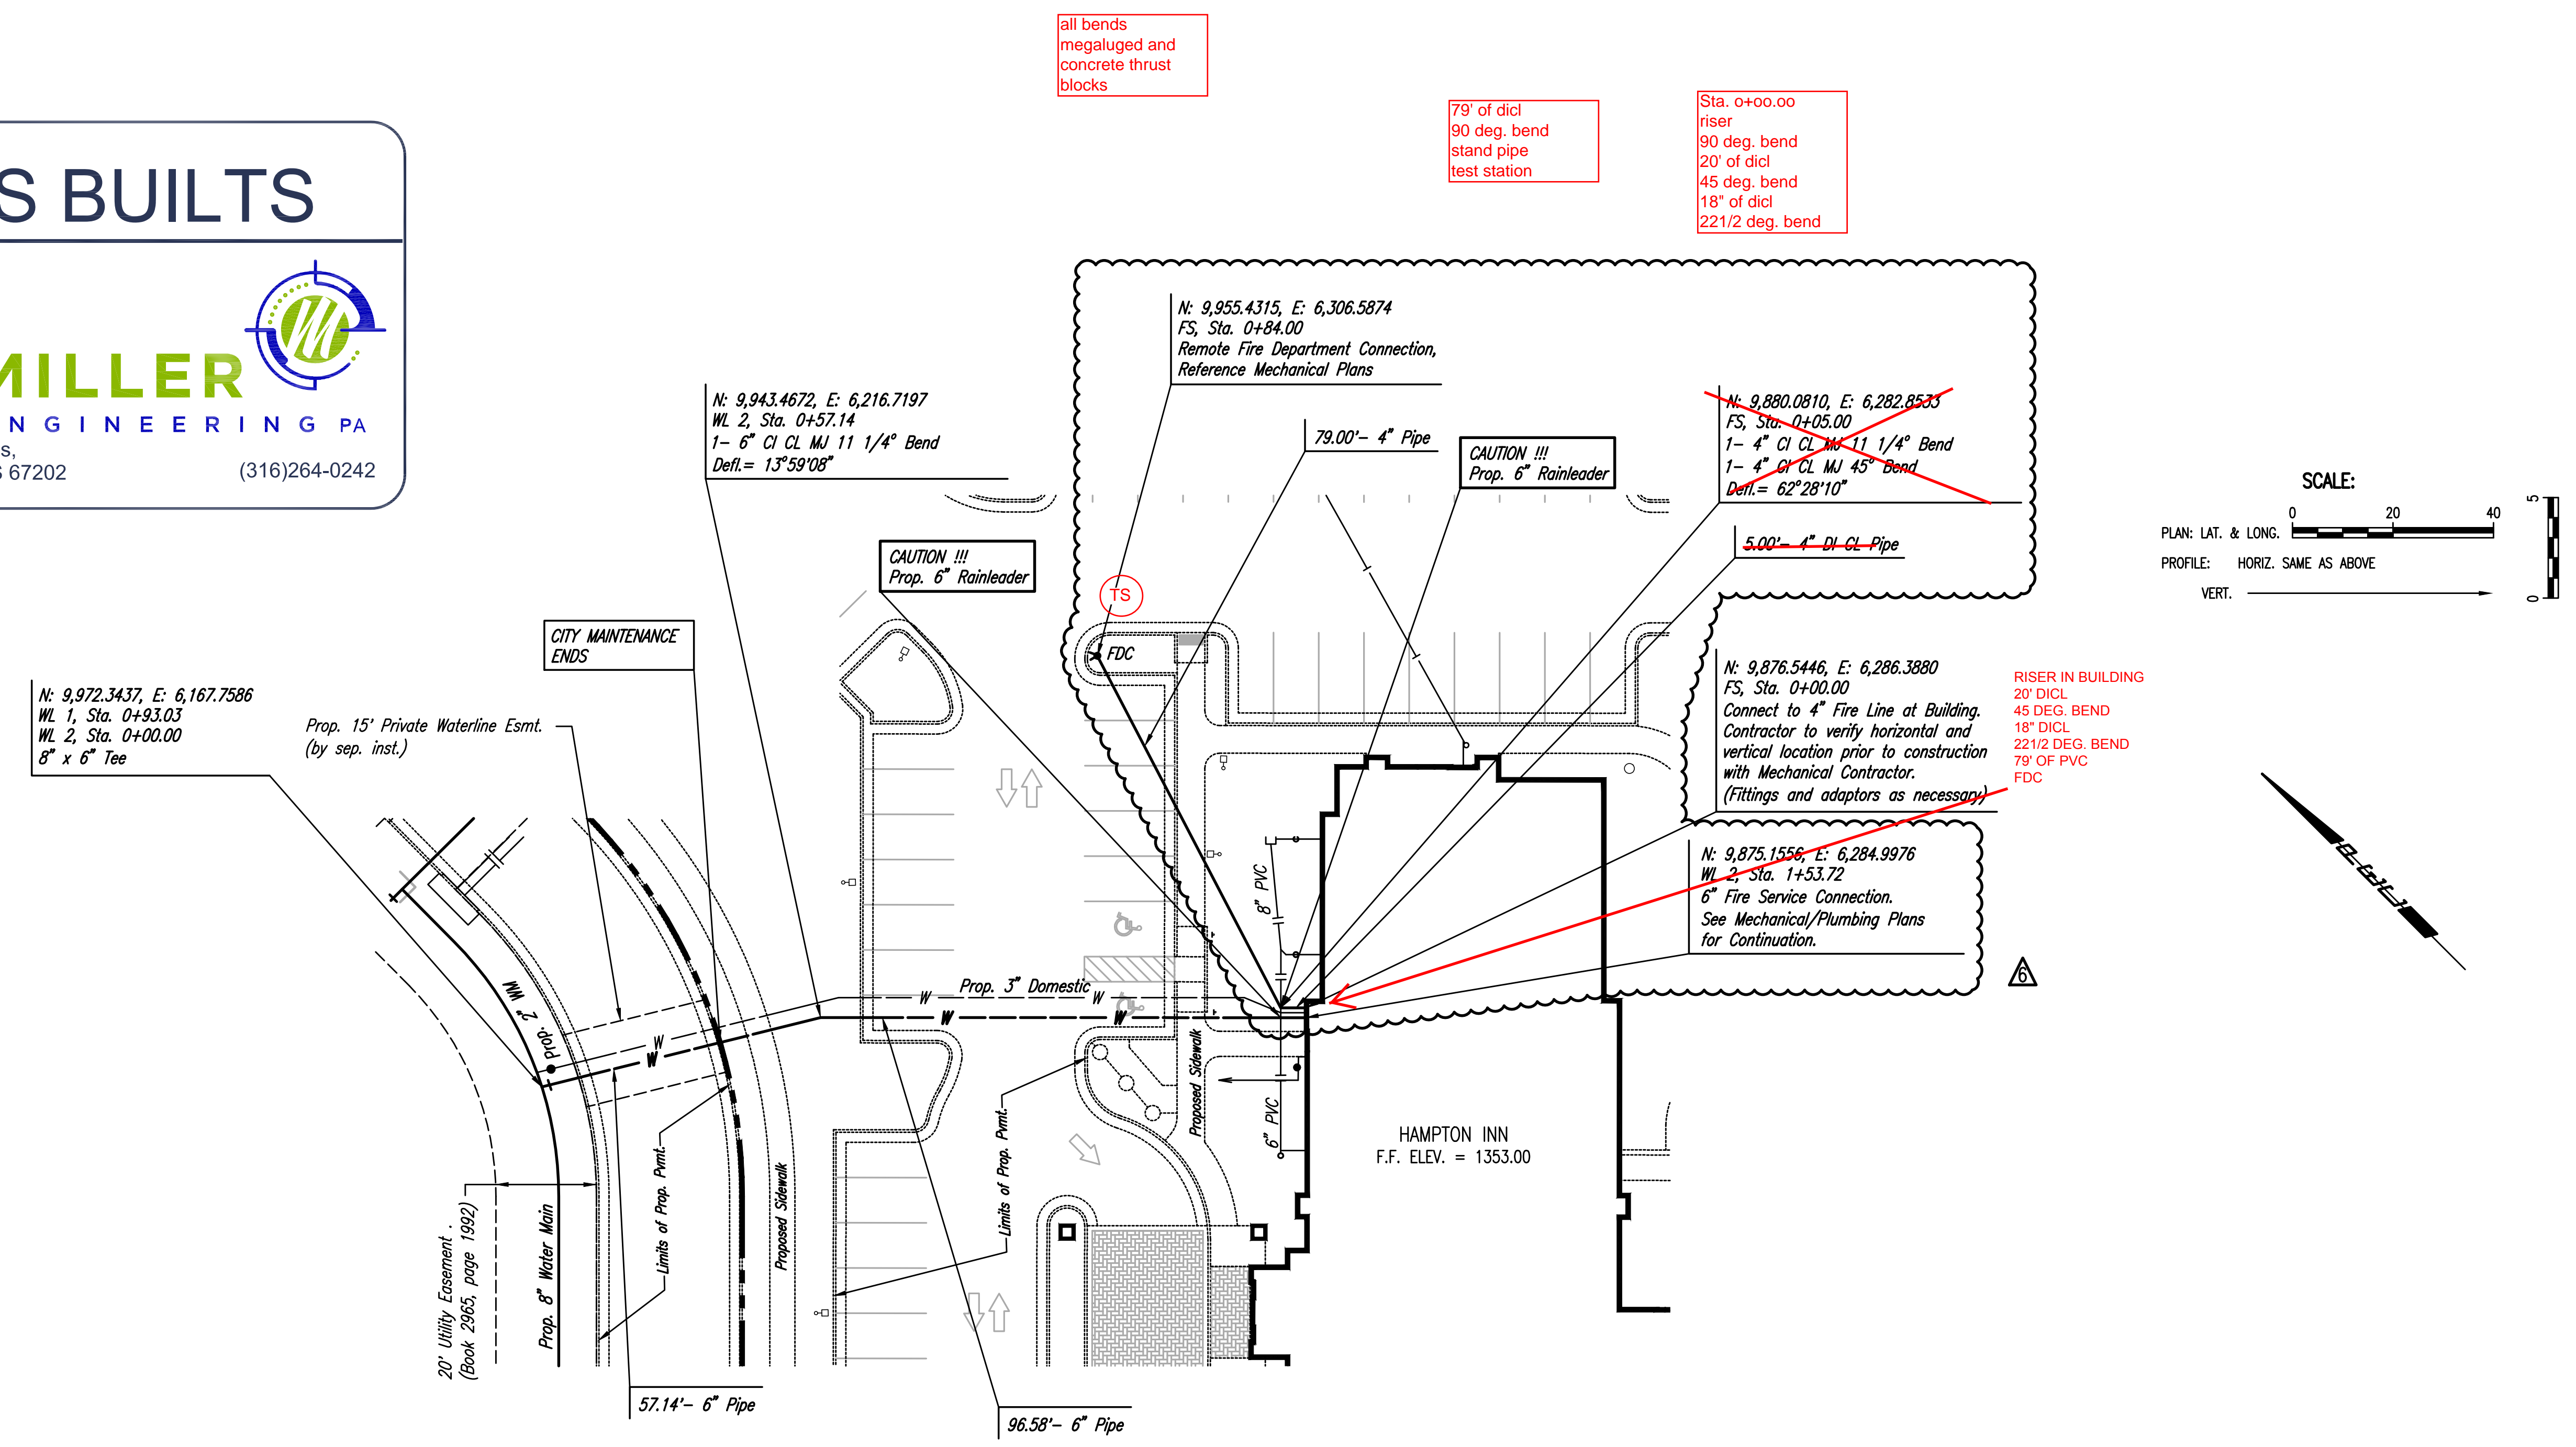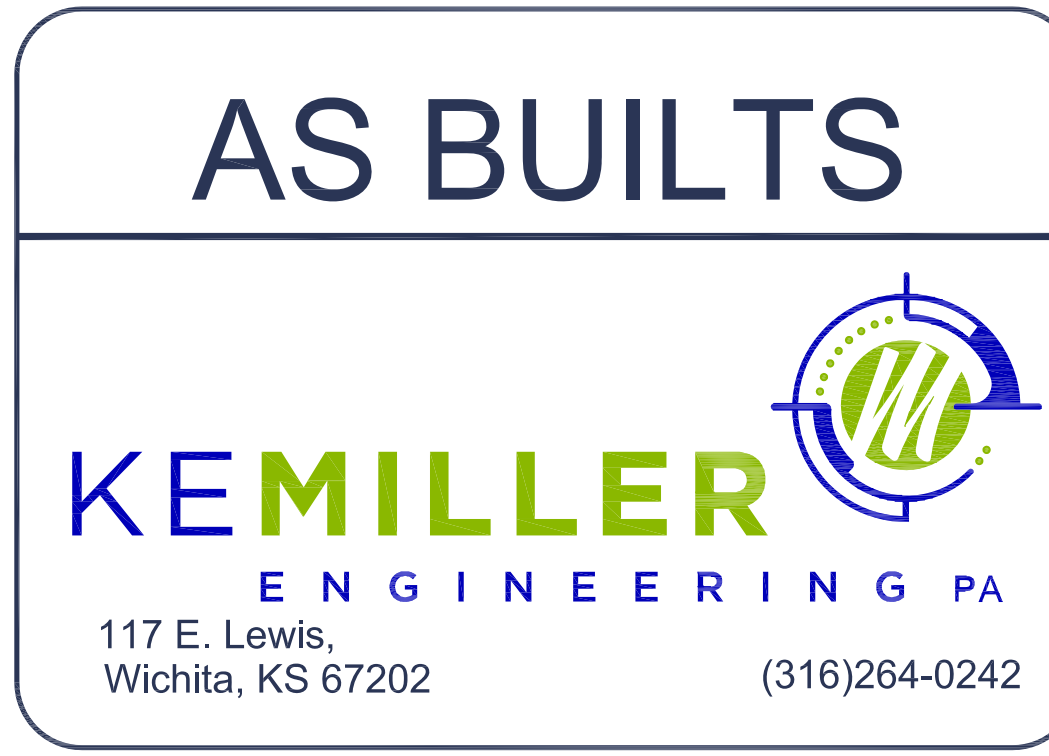

Unless noted otherwise, elevations shown are top of pipe.


PRINTS ISSUED

DATE	PURPOSE	NO.
08.25.16	30% PROGRESS SET	1
09.15.16	60% PROGRESS SET	2
10.13.16	90% PROGRESS SET	3
11.10.16	BID/PERMIT SET	4
11.22.16	ADDENDUM #1	5
12.07.16	CITY COMMENTS	6
12.21.16	CITY COMMENTS	7
3.07.17	MISC. REVISIONS	8
3.17.17	MISC. REVISIONS	9

HAMPTON INN  
 CADILLAC LAKE  
 WICHITA, KANSAS



LKArchitecture

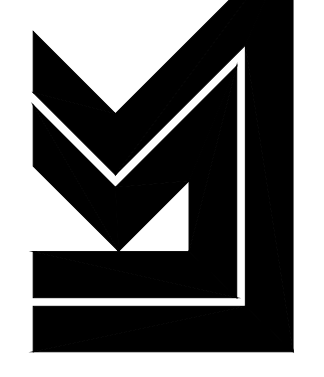

Architecture • Engineering • Planning • Interior Design • Landscape Architecture



LKArchitecture, Inc.  
 345 Riverview Wichita, KS 67203  
 T 316.268.0230 F 316.268.0205  
 CONTACT: PEC  
 DRAWN: PEC  
 CHECKED: PEC

PROJECT NUMBER:  
**15433**

SHEET TITLE:  
 WATERLINE NO. 2


SHEET NUMBER:  
**C3.04**

Sheet: 03-31--2017, 1:50=1, Rev. 4/1/17  
 Plot Scale: 1" = 30'-2" (1:360)  
 U:\Wichita-Cad\2016\160551\000\Main\Drawings\160551-000-C3-04-WATERLINE NO. 2

**HAMPTON INN  
CADILLAC LAKE  
WICHITA, KANSAS**




**LKArchitecture**  
Architecture • Engineering • Planning • Interior Design • Landscape Architecture

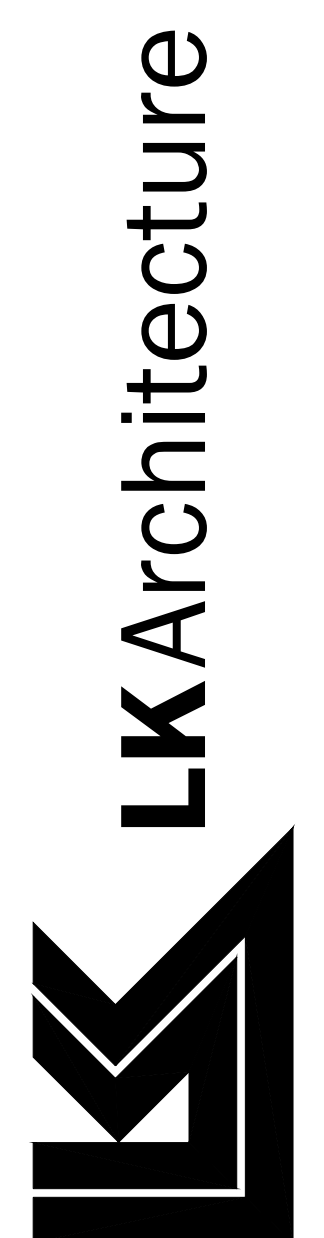


**LKArchitecture, Inc.**  
345 Riverview Wichita, KS 67203  
T 316.268.0230 F 316.268.0205  
CONTACT: PEC  
DRAWN: PEC  
CHECKED: PEC  
PROJECT NUMBER:  
**15433**  
SHEET TITLE:  
STANDARD WATER  
ASSEMBLY DETAILS  
SHEET NUMBER:  
**C3.05** OF: X

**PEC**  
PROFESSIONAL ENGINEERING CONSULTANTS, P.A.  
303 SOUTH TOWERS WICHITA, KANSAS 67202  
316-262-2881 www.pec1.com

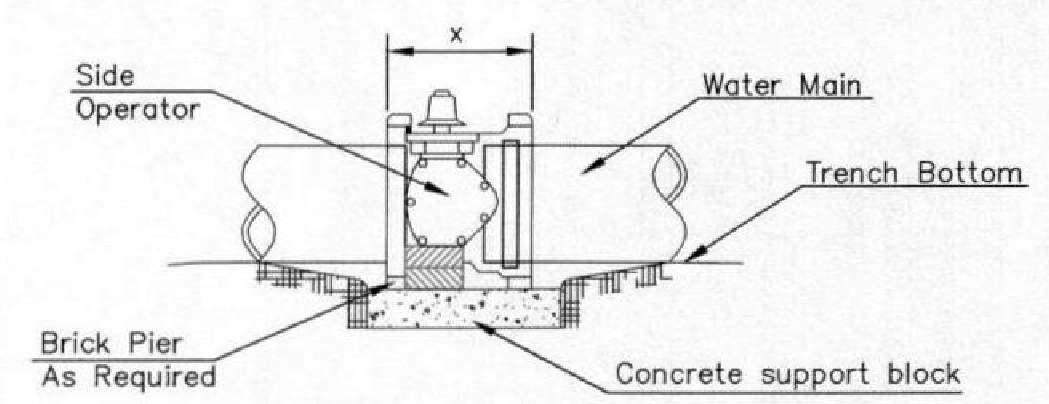

- NOTES**
- This detail covers Butterfly Valve installation, inclusive, regardless of type of pipe or joint used. 24" and larger lines to be detailed on plans.
  - 6" Valve Box and Cover required per City of Wichita Std. Specifications.
  - Conc. Support Block to be full width of trench.


**CONCRETE SUPPORT BLOCKING FOR BUTTERFLY VALVE INSTALLATION**

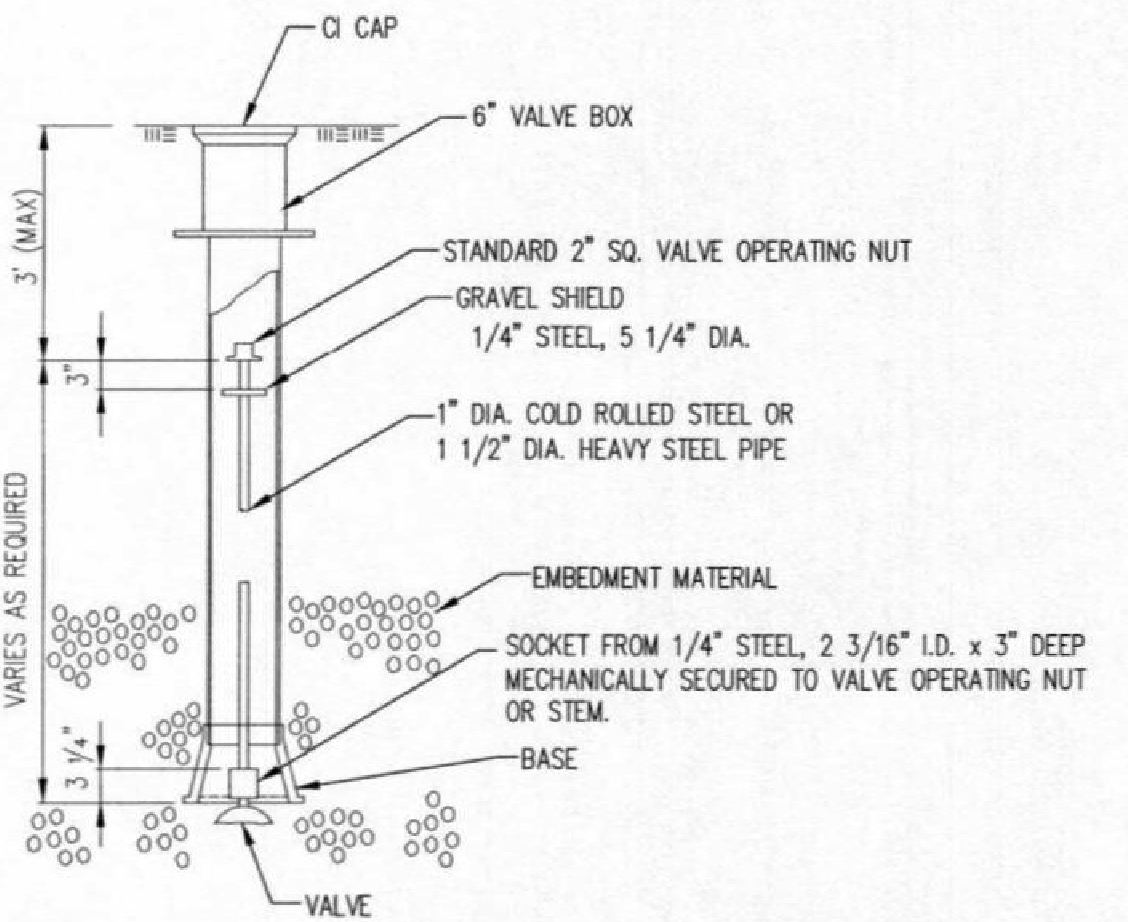


**VALVE STEM EXTENSION DETAIL**

NOTE: ONE VALVE STEM EXTENSION FOR EACH VALVE BURIED GREATER THAN 5'.


FIRE HYDRANTS REQUIRED				
STATION	BURY LINE ELEVATION	TOP OF PIPE ELEVATION	FIRE HYDRANT BURY REQUIRED*	VALVE STEM EXT. REQUIRED (ft)*
WL 1, Sta. 2+66.08	1351.3	1347.47	4.5'	

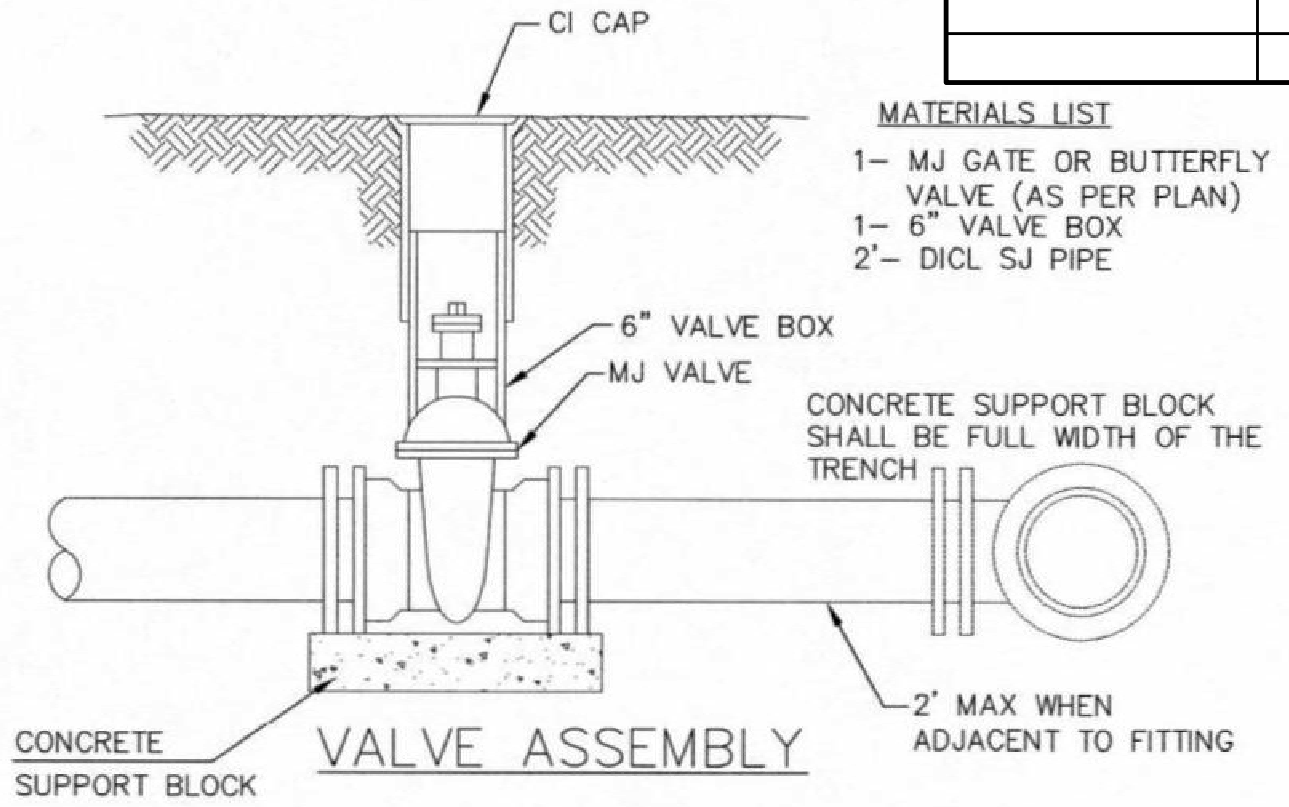

- MATERIALS LIST**
- 1- MJ GATE OR BUTTERFLY VALVE (AS PER PLAN)
  - 1- MJ ANCHOR COUPLING (12" OR SMALLER)
  - 1- 6" VALVE BOX
  - CONCRETE SUPPORT BLOCK SHALL BE FULL WIDTH OF THE TRENCH

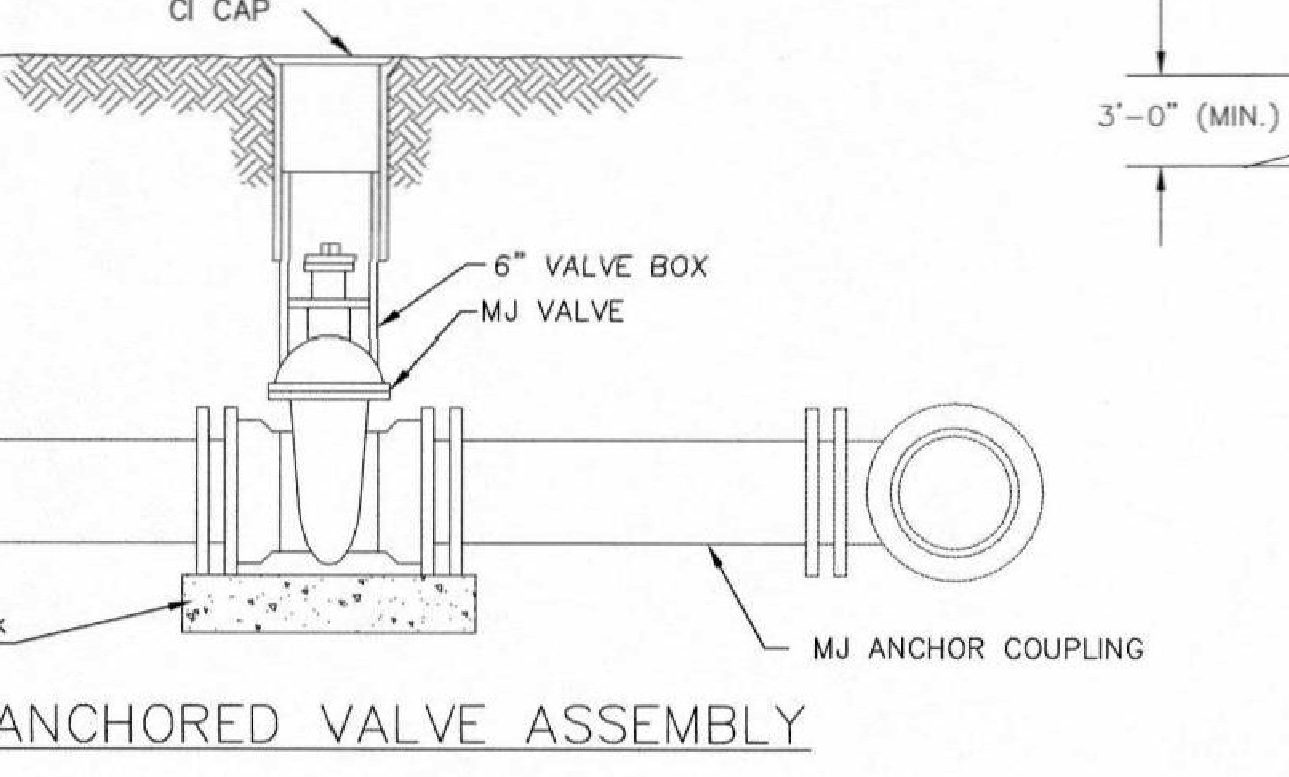


- MATERIALS LIST**
- 1- MJ GATE OR BUTTERFLY VALVE (AS PER PLAN)
  - 1- CI MJ CAP WHEN NECESSARY
  - 1- 6" VALVE BOX
  - 20" OF PIPE (BID WITH PIPE)
  - 2 - #6 REIN. BARS
  - CONCRETE SUPPORT BLOCK SHALL BE FULL WIDTH OF THE TRENCH

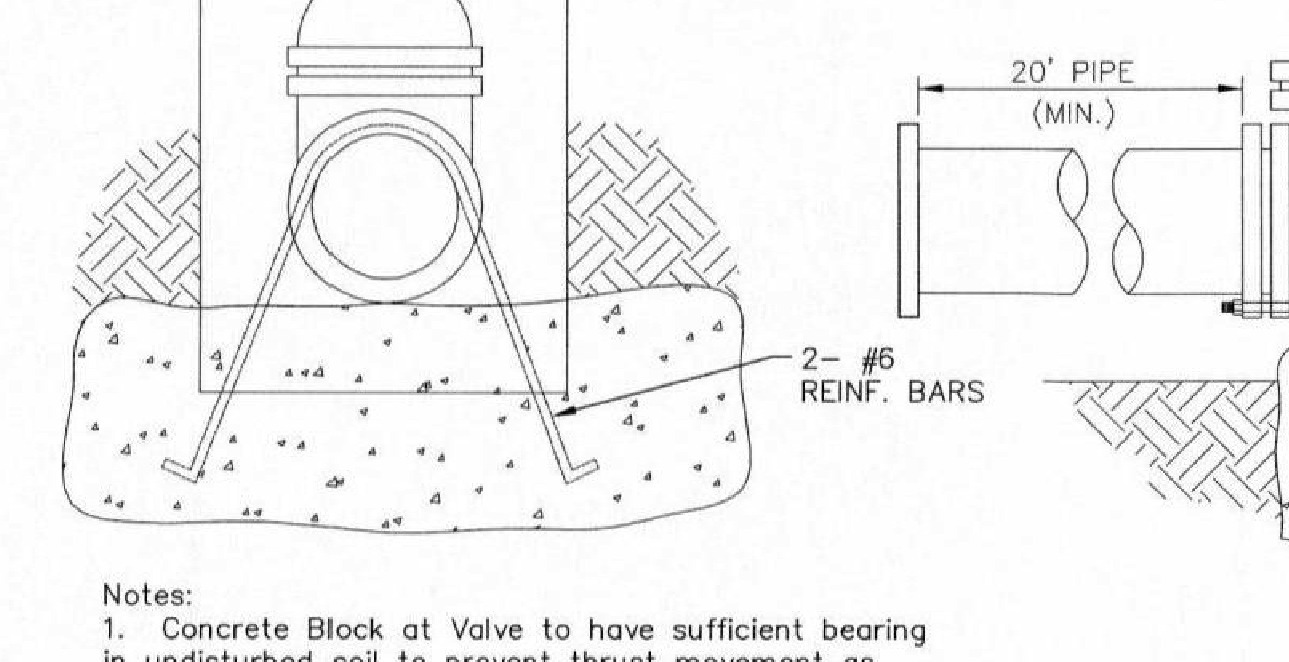


- Notes:**
- Concrete Block at Valve to have sufficient bearing in undisturbed soil to prevent thrust movement as shown in table at right. Field Engineer to determine thrust loading of undisturbed soil and final size of thrust block.
  - The thrust block shall be constructed such that bolts, nuts, and other MJ accessories are kept clear of concrete.
  - All valves at dead ends and at other locations as called out on the plans shall be blocked as shown here.

VALVE	THRUST AT 150 #/sq
4"	1809 lbs.
6"	4245 lbs.
8"	7540 lbs.
12"	16965 lbs.


**ANCHORED VALVE ASSEMBLY, SPECIAL**

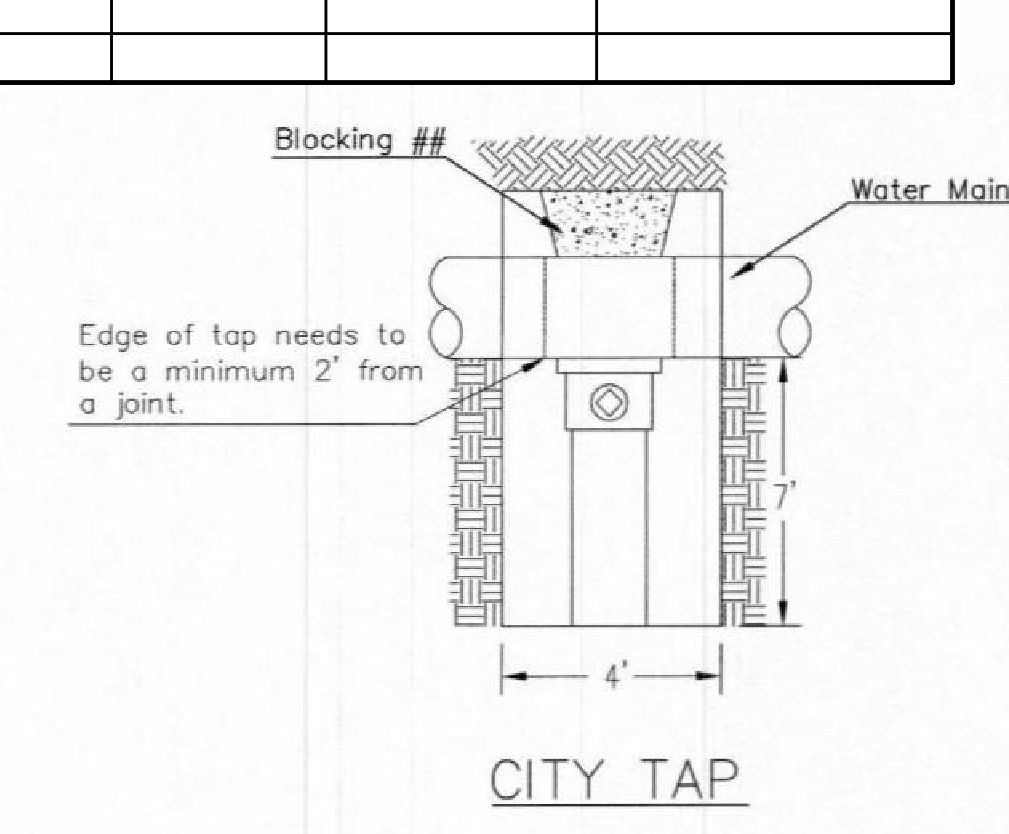

- MATERIALS LIST**
- 1- MJ GATE OR BUTTERFLY VALVE (AS PER PLAN)
  - 1- 6" VALVE BOX
  - 2"- DI CL SJ PIPE

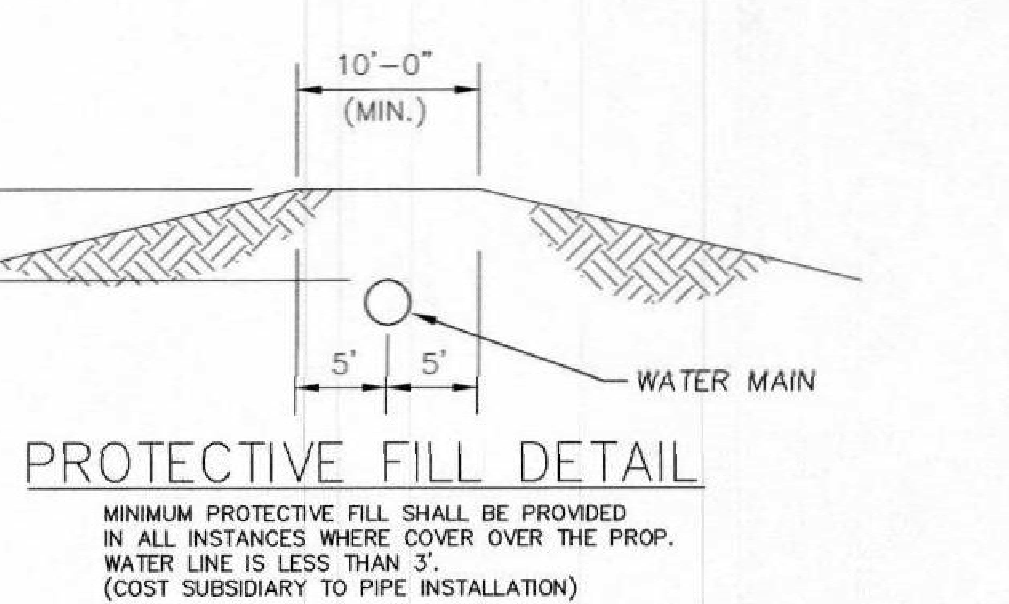

MINIMUM PROTECTIVE FILL SHALL BE PROVIDED BY ALL INSTANCES WHERE COVER OVER THE PROP. WATER LINE IS LESS THAN 3". (COST SUBSIDIARY TO PIPE INSTALLATION)

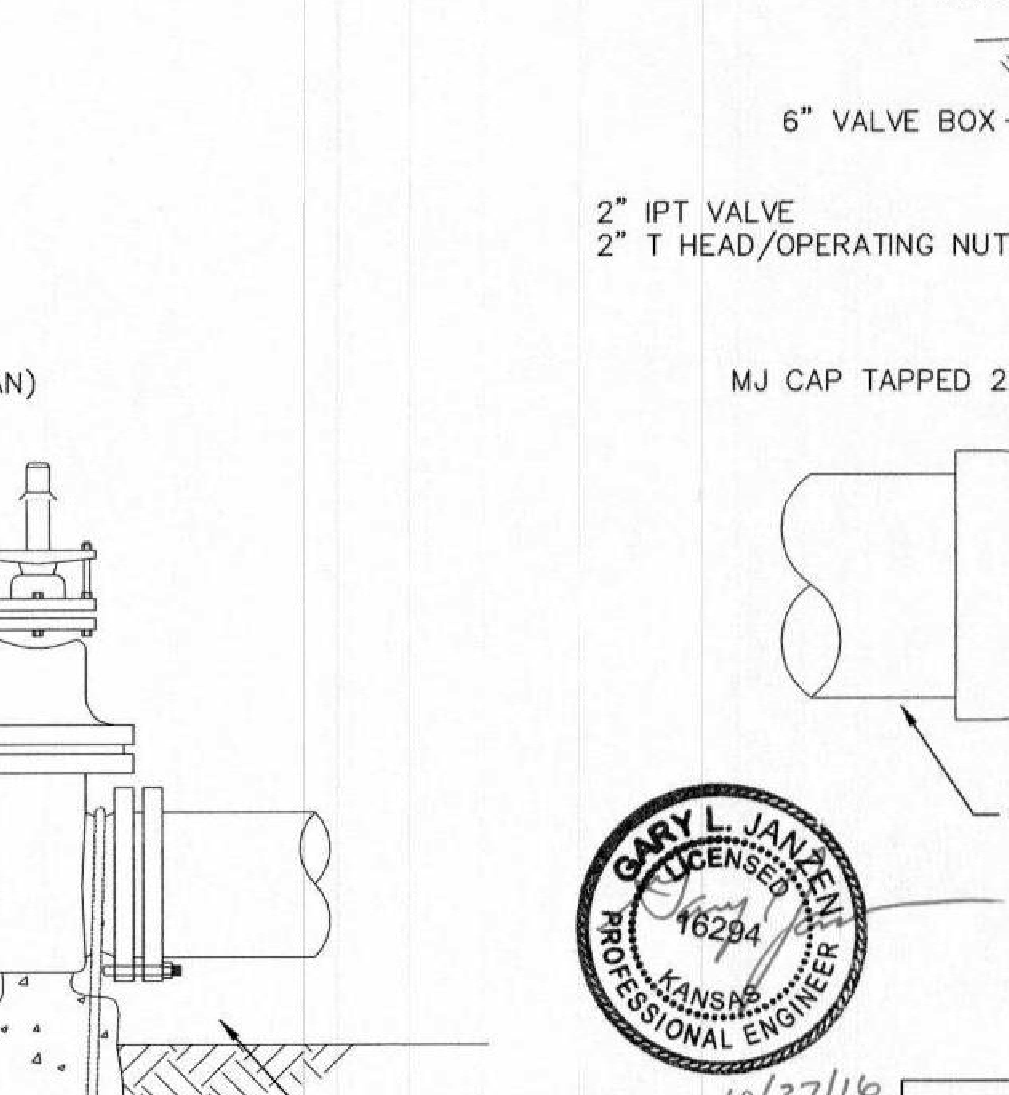

**2" BLOWOFF ASSEMBLY**

**CITY OF WICHITA**  
PUBLIC WORKS & UTILITIES  
ENGINEERING DIVISION


**STANDARD WATER ASSEMBLY DETAIL**

CITY ENGINEER  
**GARY JANZEN, P.E.**

PROJECT NUMBER 2028 PPW	OCA NUMBER (607853)	DATE
----------------------------	------------------------	------


CITY ENGINEER'S OFFICE  
CITY HALL - SEVENTH FLOOR  
455 NORTH MAIN STREET  
WICHITA, KANSAS 67202-1620  
(316) 268-4501

SHEET

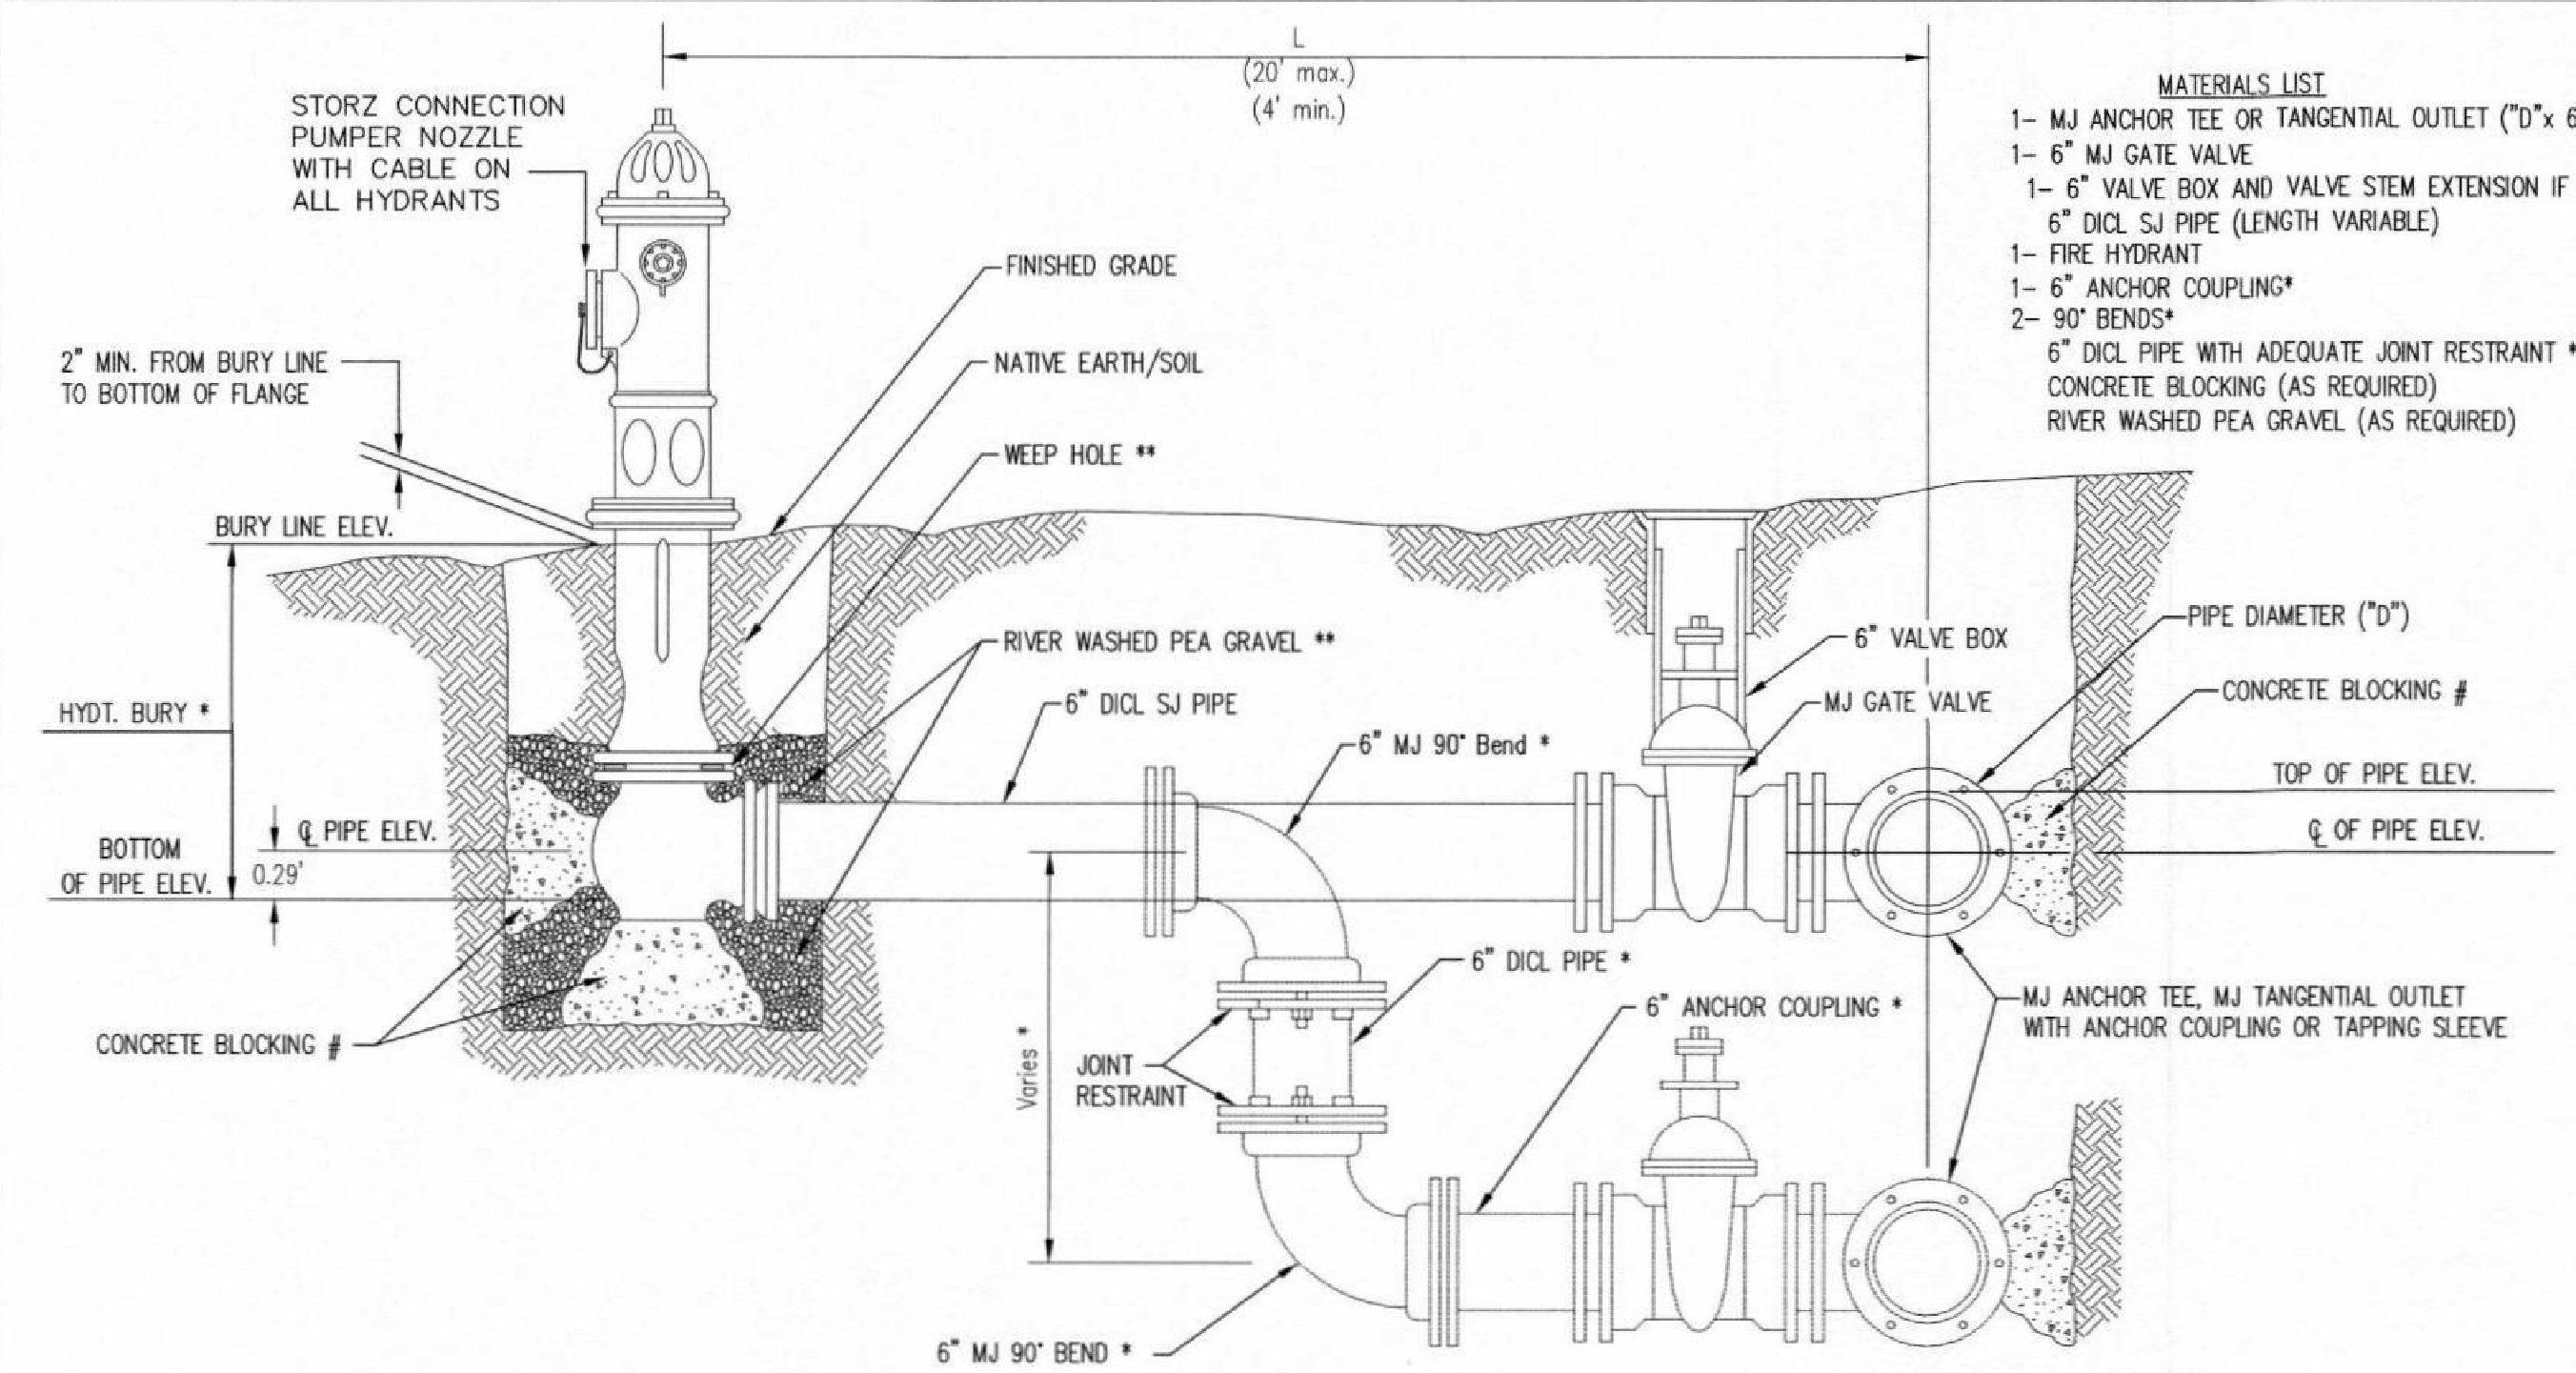

- MATERIALS LIST**
- 1- MJ ANCHOR TEE OR TANGENTIAL OUTLET (10" x 6")
  - 1- 6" MJ GATE VALVE
  - 1- 6" VALVE BOX AND VALVE STEM EXTENSION IF REQUIRED \*
  - 6" DI CL SJ PIPE (LENGTH VARIABLE)
  - 1- FIRE HYDRANT
  - 1- 6" ANCHOR COUPLING\*
  - 2- 90° BENDS\*
  - 6" DI CL PIPE WITH ADEQUATE JOINT RESTRAINT \*
  - CONCRETE BLOCKING (AS REQUIRED)
  - RIVER WASHED PEA GRAVEL (AS REQUIRED)
- \* IF THE REQUIRED HYDRANT BURY IS IN EXCESS OF 5', BUT LESS THAN 7', CONTRACTOR SHALL USE STANDARD 5' HYDRANT BURY AND HYDRANT BARREL EXTENSIONS AS NECESSARY. IF THE REQUIRED HYDRANT BURY IS GREATER THAN 7', CONTRACTOR SHALL USE 5' HYDRANT BURY, 2-MJ 90° BENDS, 6" ANCHOR COUPLING AND 6" DI CL PIPE AS NECESSARY FOR VERTICAL ADJUSTMENT. THE CONTRACTOR SHALL PROVIDE ADEQUATE THRUST BLOCKING AT HYDRANT AND MEGALUGS, OR SIMILAR RESTRAINT BETWEEN 90° BENDS TO SECURE ALL FITTINGS DURING TESTING AND OPERATION. THE CONTRACTOR SHALL PROVIDE A VALVE STEM EXTENSION PER DETAIL THIS SHEET.
- \*\* CAUTION: WEEP HOLES TO BE KEPT CLEAR DURING CONSTRUCTION AND BACKFILL. CONCRETE FOR THRUST BLOCKING SHALL NOT OBSTRUCT WEEP HOLES. PLACE 1 CUBIC FOOT OF RIVER WASHED PEA GRAVEL AROUND EACH WEEP HOLE.
- # CONCRETE THRUST BLOCKING SHALL BE KEPT CLEAR OF BOLTS, NUTS, AND MJ ACCESSORIES.

**FIRE HYDRANT ASSEMBLY**  
PER CITY OF WICHITA SPECIFICATIONS

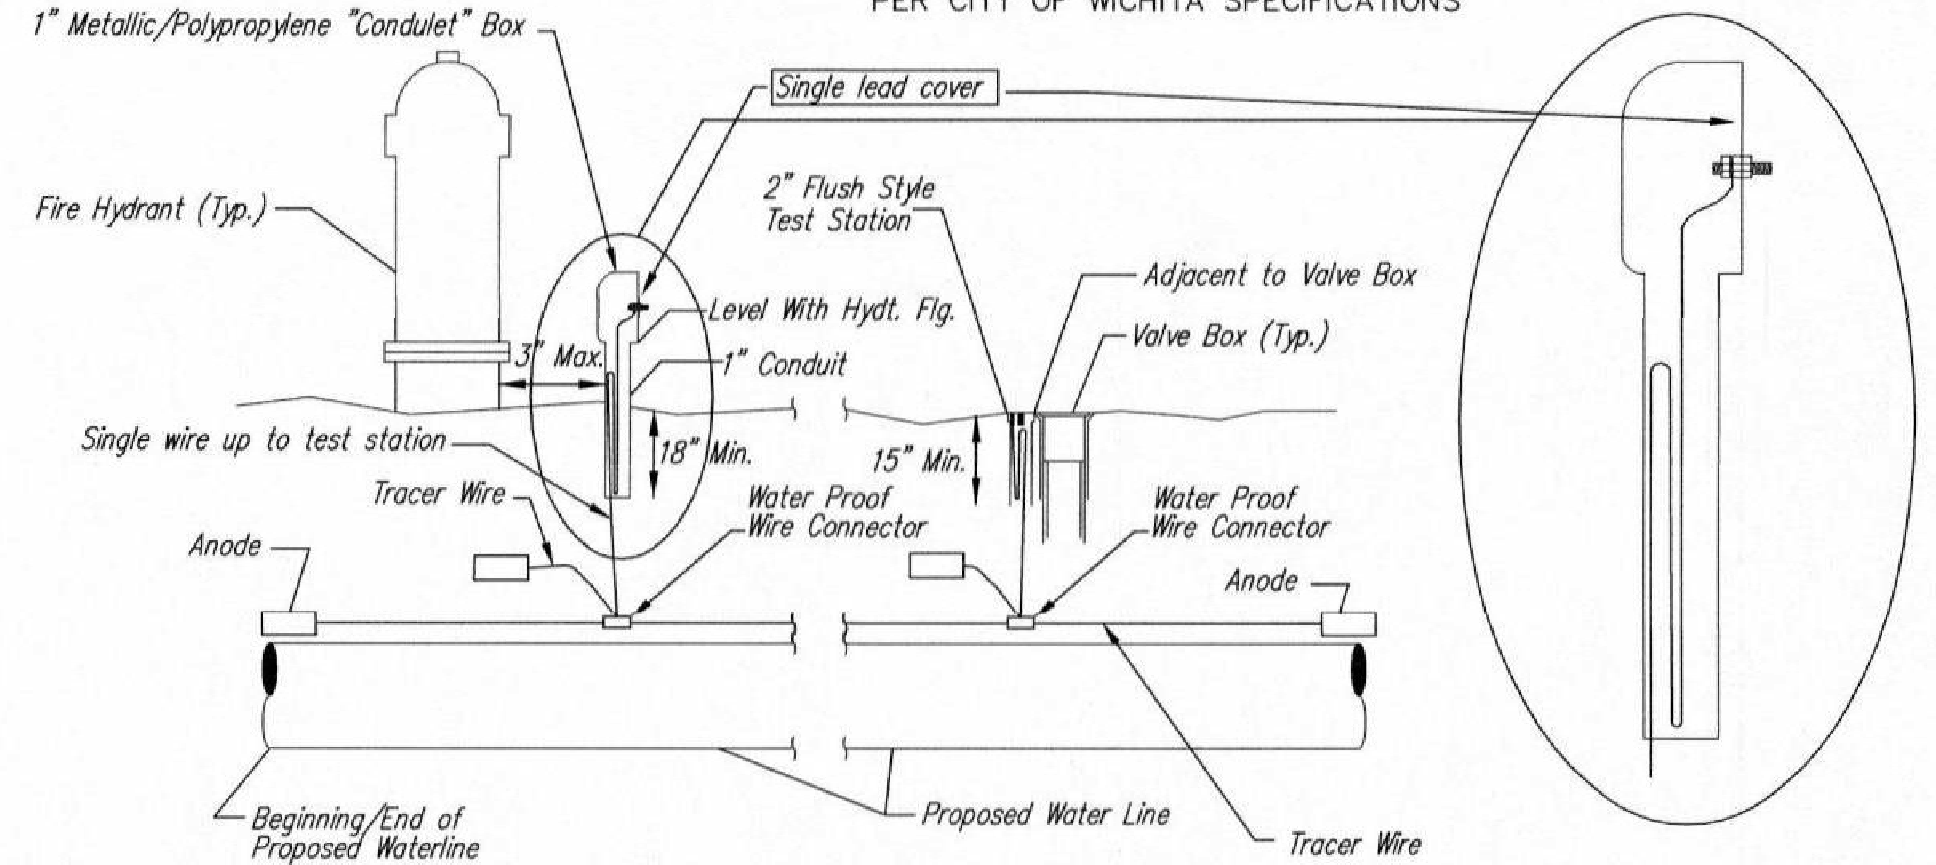

**TRACER WIRE**  
Conductive type pipe locator/tracer wire shall be installed to locate all waterline pipe regardless of pipe material. The wire shall extend the entire length of the proposed pipe. The wire shall be taped to the waterline and pulled with the pipe. A waterproof connector shall be used at splice locations. A complete list of approved tracer wire and waterproof connectors can be found on the City of Wichita's website at [www.wichita.gov](http://www.wichita.gov).

**WIRE**  
The tracer wire shall be Blue No. 12 AWG CCS with 45 mil HDPE insulation. To allow for grade adjustment, a minimum of 12" of excess wire shall be coiled at the bottom of the test station for all wires. Wire connectors shall be installed per manufacturer recommendations. Contractor shall attach wire being installed with proposed water main to any tracer wire installed with adjacent waterline projects.

**TEST STATIONS**  
The test station for fire hydrant application shall be a 1" "conduit" style station as manufactured by AGRA Industries with a removable solid cover having a single lead extending from the face or approved equal. The "conduit" style test station shall be attached to a 1" rigid galvanized conduit with a minimum length of 36" and plastic end bushing. The flush style shall have the word "WATER" stamped or molded into the lid. The test station for valve applications shall be a 2" flush style test station with wire connector on lid. Model # 12PH7B1LP Handley Industries or approved equal. The flush style shall have the word "WATER" stamped or molded into the lid. All test stations shall be manufactured using molded blue tops or sufficiently coated with blue enamel paint. The tracer wire and the anode wire shall be installed to allow 12" of wire within the test station. The location of all test stations shall be recorded, and shown in the as-built drawings. Flush style test stations shall not be installed in pavement or sidewalk unless approved by the Engineer. Contractor shall extend tracer wire & move flush mount test station to nearest location out of pavement or sidewalk.

**ANODES**  
The anodes shall be 3 lb. bare zinc or magnesium. The anodes shall be buried at the same elevation as the waterline at each test station. The anodes shall be connected to 12 AWG CCS which shall be extended to the test station.


**TRACER WIRE DETAIL**  
COST IS SUBSIDIARY TO PIPE INSTALLATION

DATE	PURPOSE	NO.
08.25.16	30% PROGRESS SET	
09.15.16	60% PROGRESS SET	
10.13.16	90% PROGRESS SET	
11.10.16	BID/PERMIT SET	
11.22.16	ADDENDUM #1	1
12.07.16	CITY COMMENTS	2


HAMPTON INN  
CADILLAC LAKE  
WICHITA, KANSAS




LKArchitecture  
Architecture • Engineering • Planning • Interior Design • Landscape Architecture

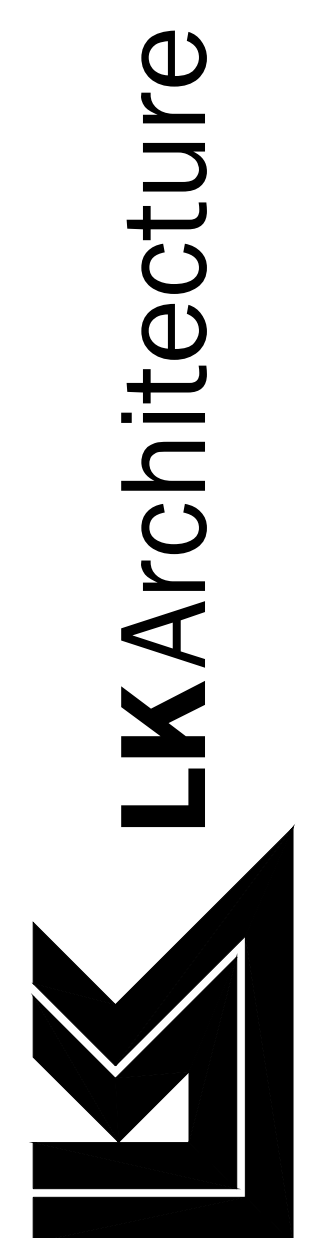


PROFESSIONAL ENGINEERING CONSULTANTS, P.A.  
300 SOUTH TOPEKA, WICHITA, KS 67202  
316-268-2981 www.pec.com

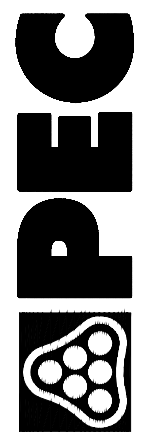

LKArchitecture, Inc.®  
345 Riverview Wichita, KS 67203  
T 316.268.0230 F 316.268.0205  
CONTACT: PEC  
DRAWN: PEC  
CHECKED: PEC  
PROJECT NUMBER:  
**15433**  
SHEET TITLE:  
STANDARD WATER SERVICE DETAILS  
SHEET NUMBER:  
**C3.06** OF: X

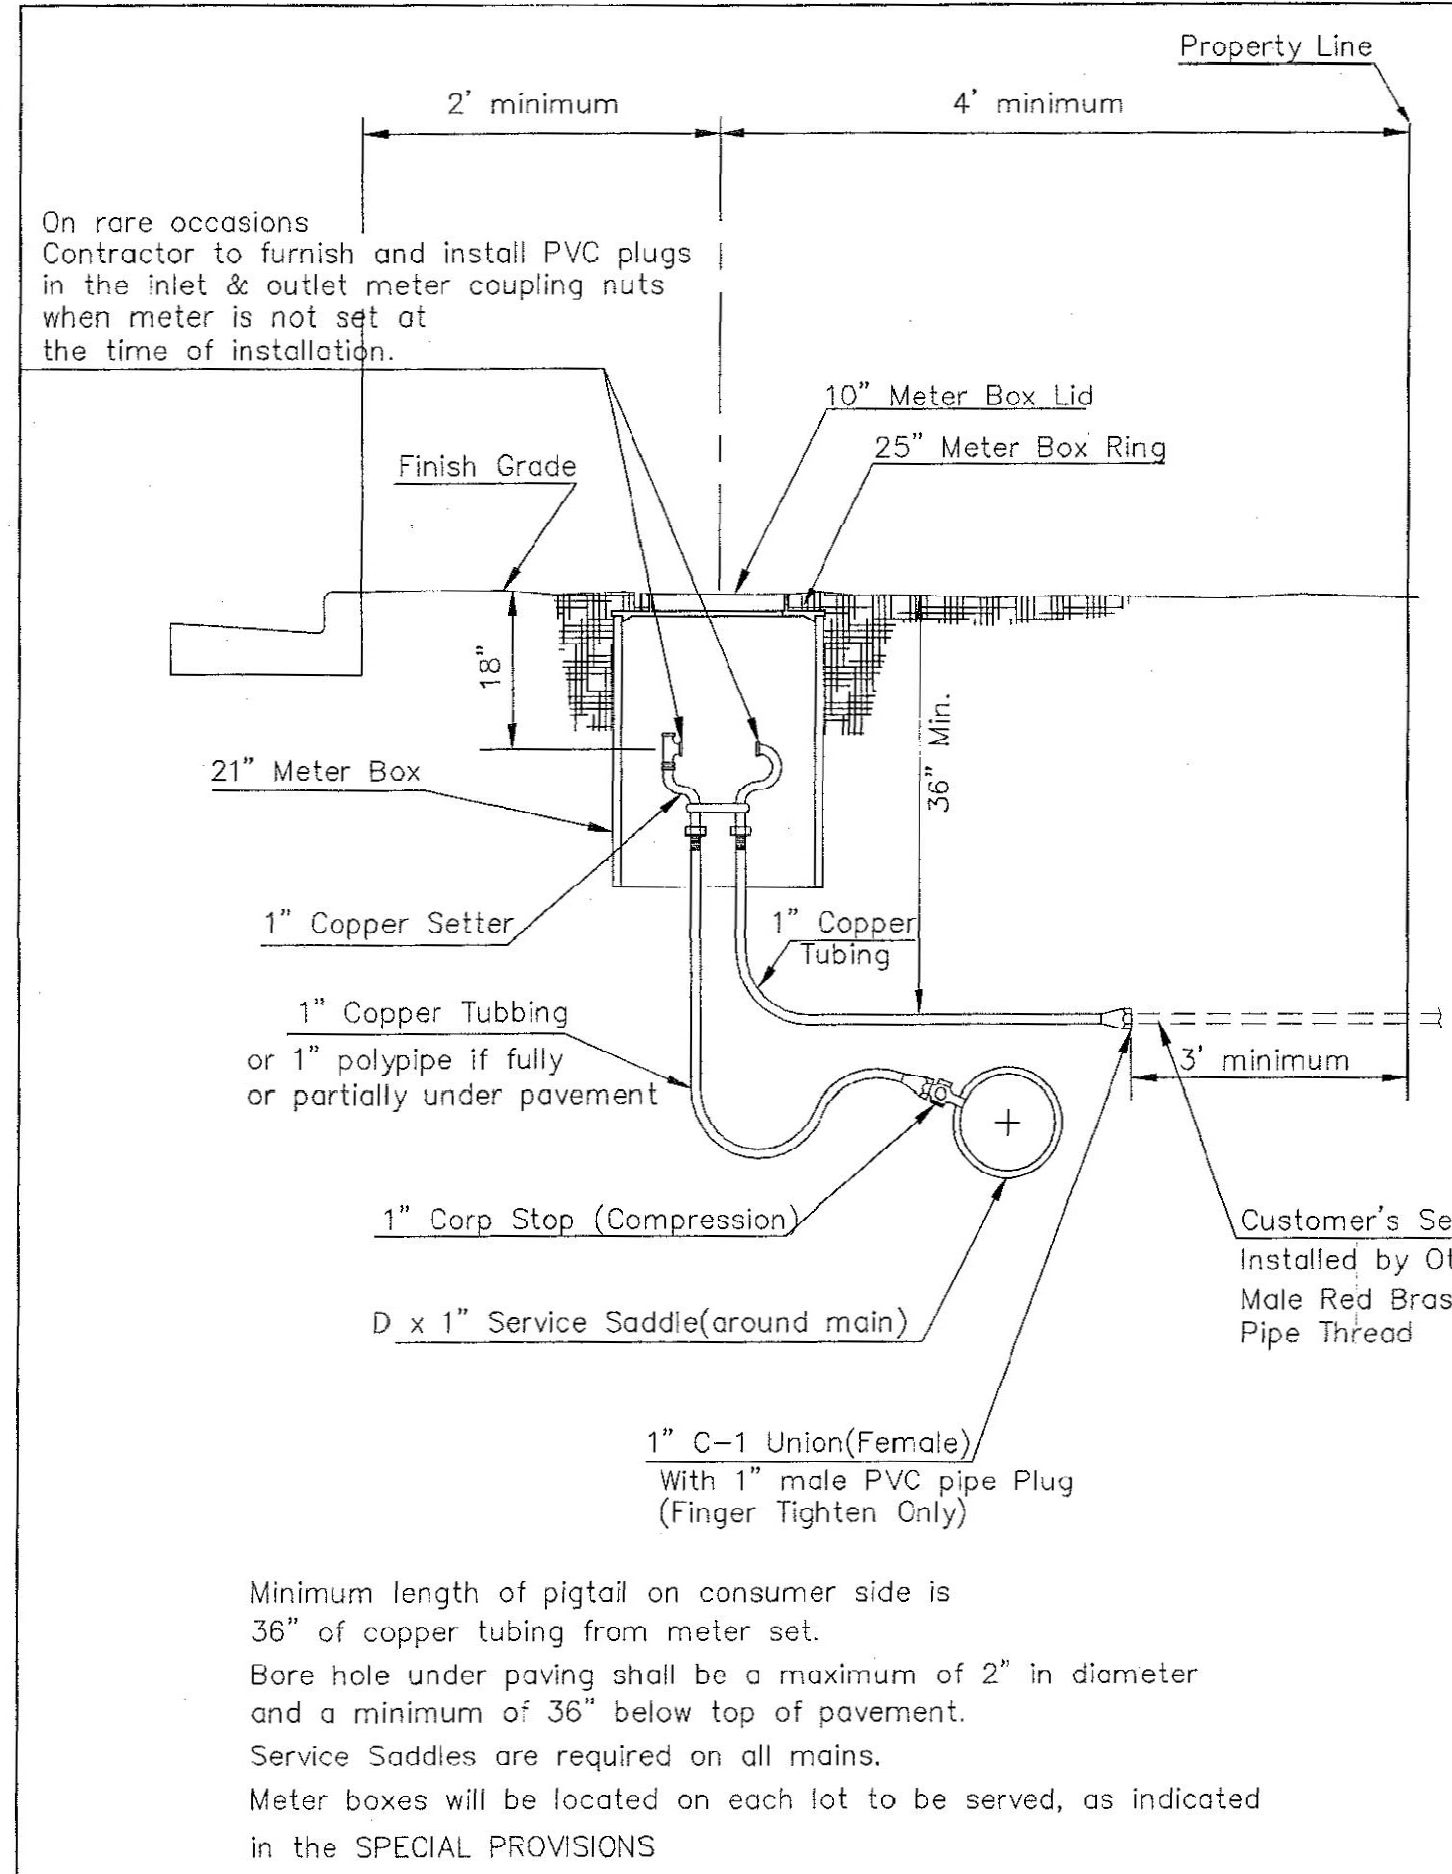


TYPICAL 1" METER SETTING

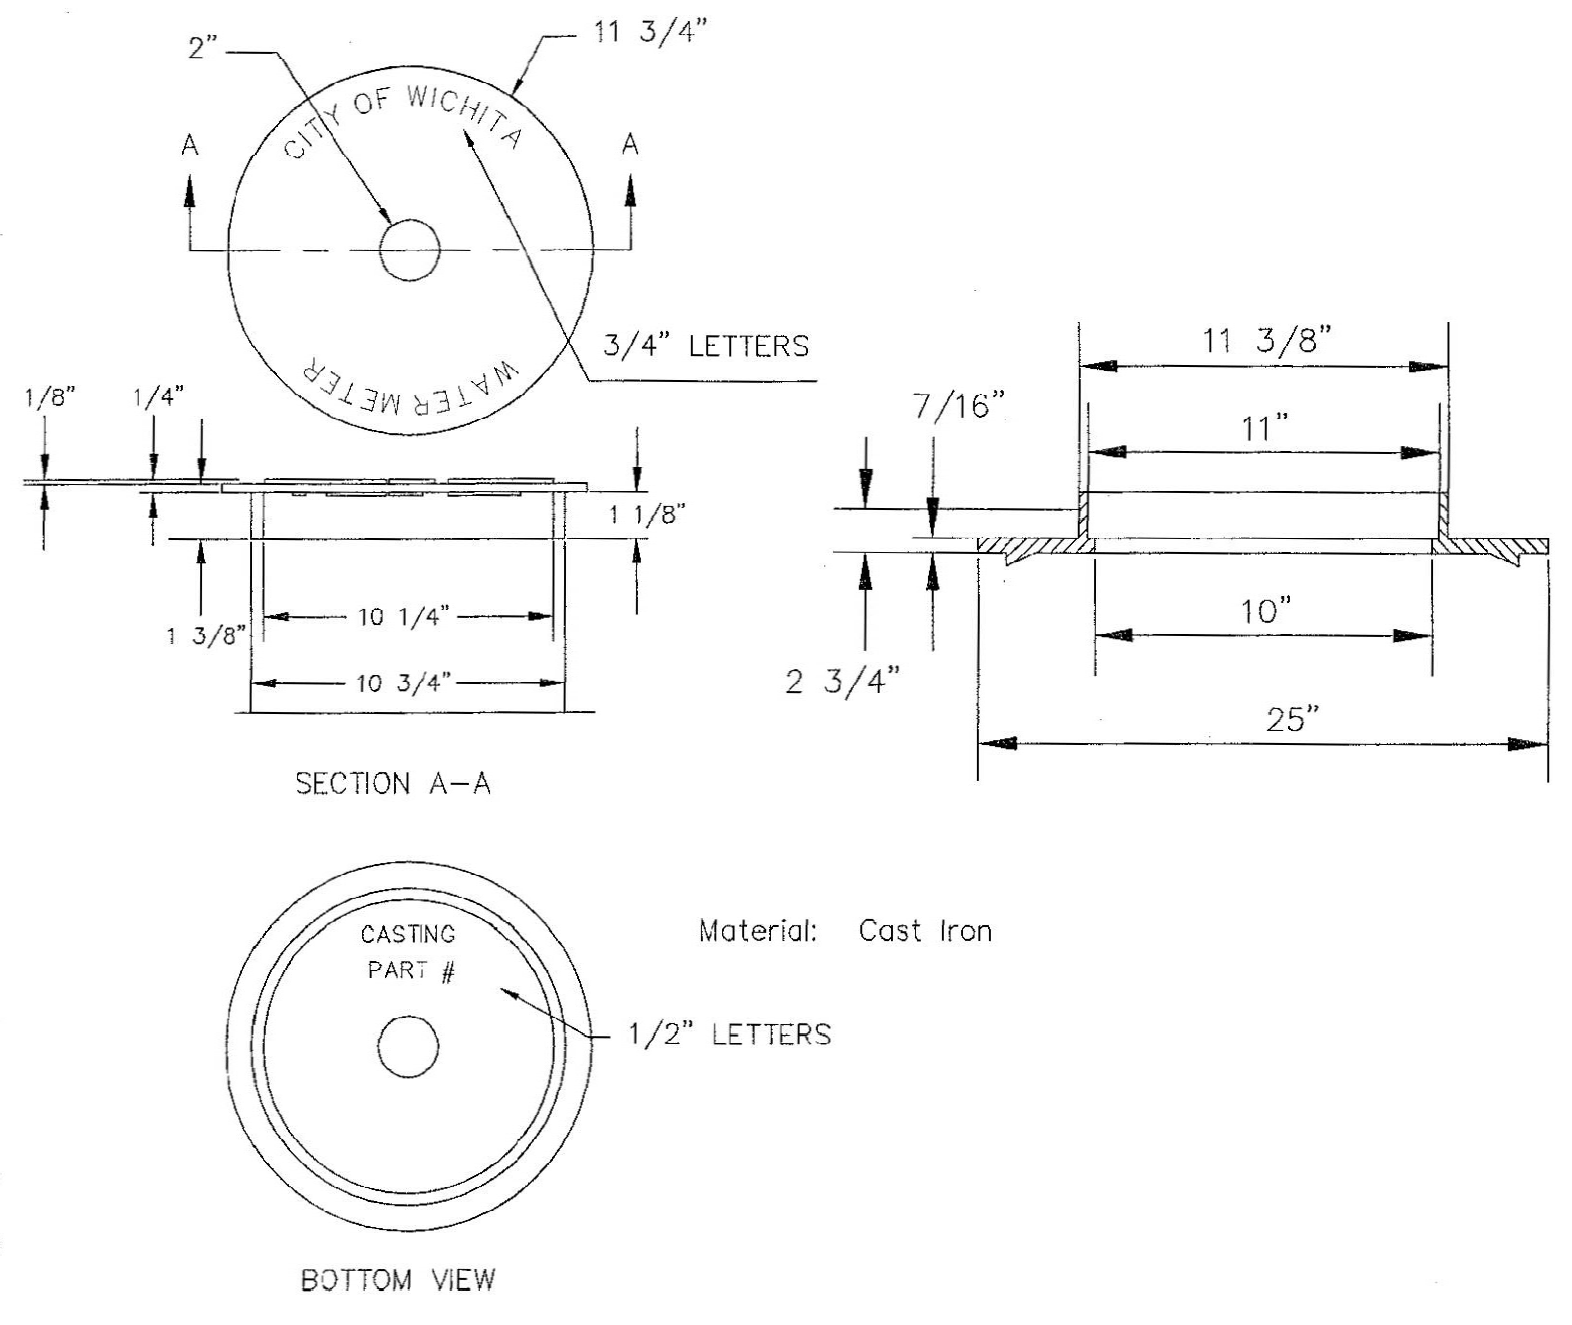


- 1 - Ø Mueller Thread Corporation Stop
- Ø Type "K" Copper Tubing
- 1 - Ø Copper to Iron Union (Male)
- 1 - Ø Brass Curb Stop (Iron to Iron)
- 2 - Øx4" Brass Nipple
- Air Release
- 2 - Ø Brass Elbows (90°)
- 1 - 1"x6" Brass Nipple
- 1 - 30" Monitor Cover
- 1 - 20" Meter Lid


NOTE:  
THE 1/2" AIR RELEASE ASSEMBLY WILL TYPICALLY BE USED ON WATER MAINS 24" AND SMALLER, AS SPECIFICALLY DESIGNATED IN THE PLANS. COMBINATION AIR RELAEASE ASSEMBLIES WILL BE SPECIFICALLY DESIGNED FOR PROJECTS WITH LARGER MAINS, AND WILL BE INCLUDED IN THE PLANS.

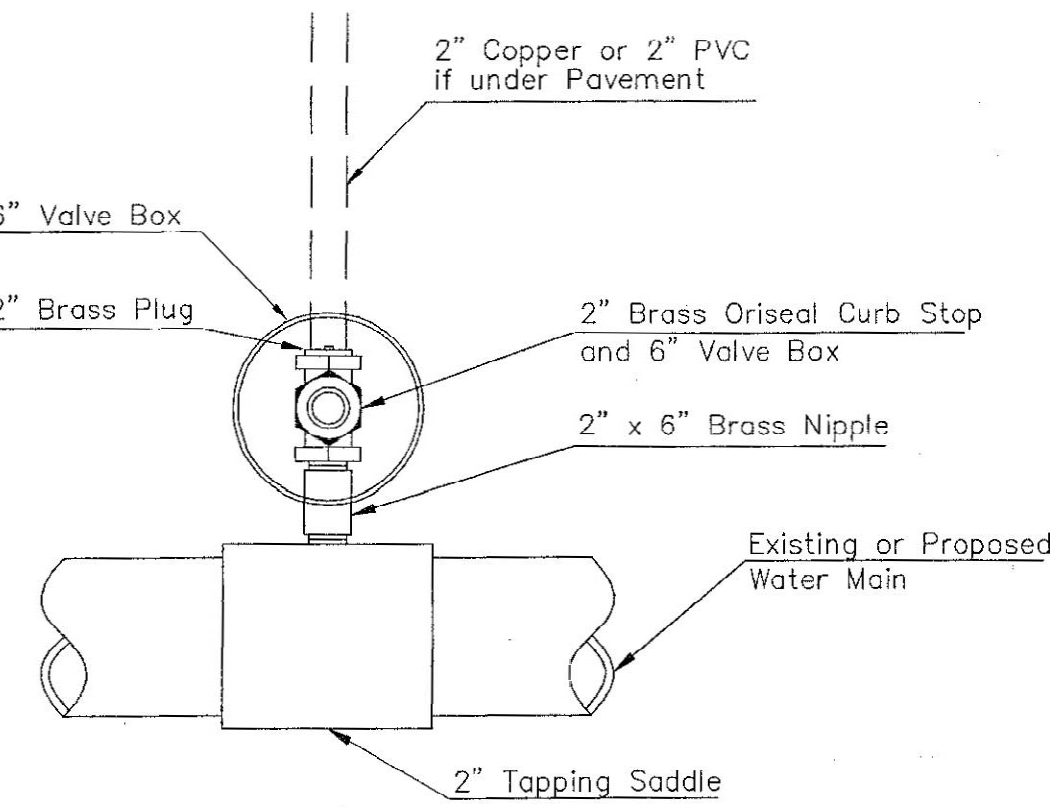

2" SERVICE OUTLET ASSEMBLY  
TOP VIEW

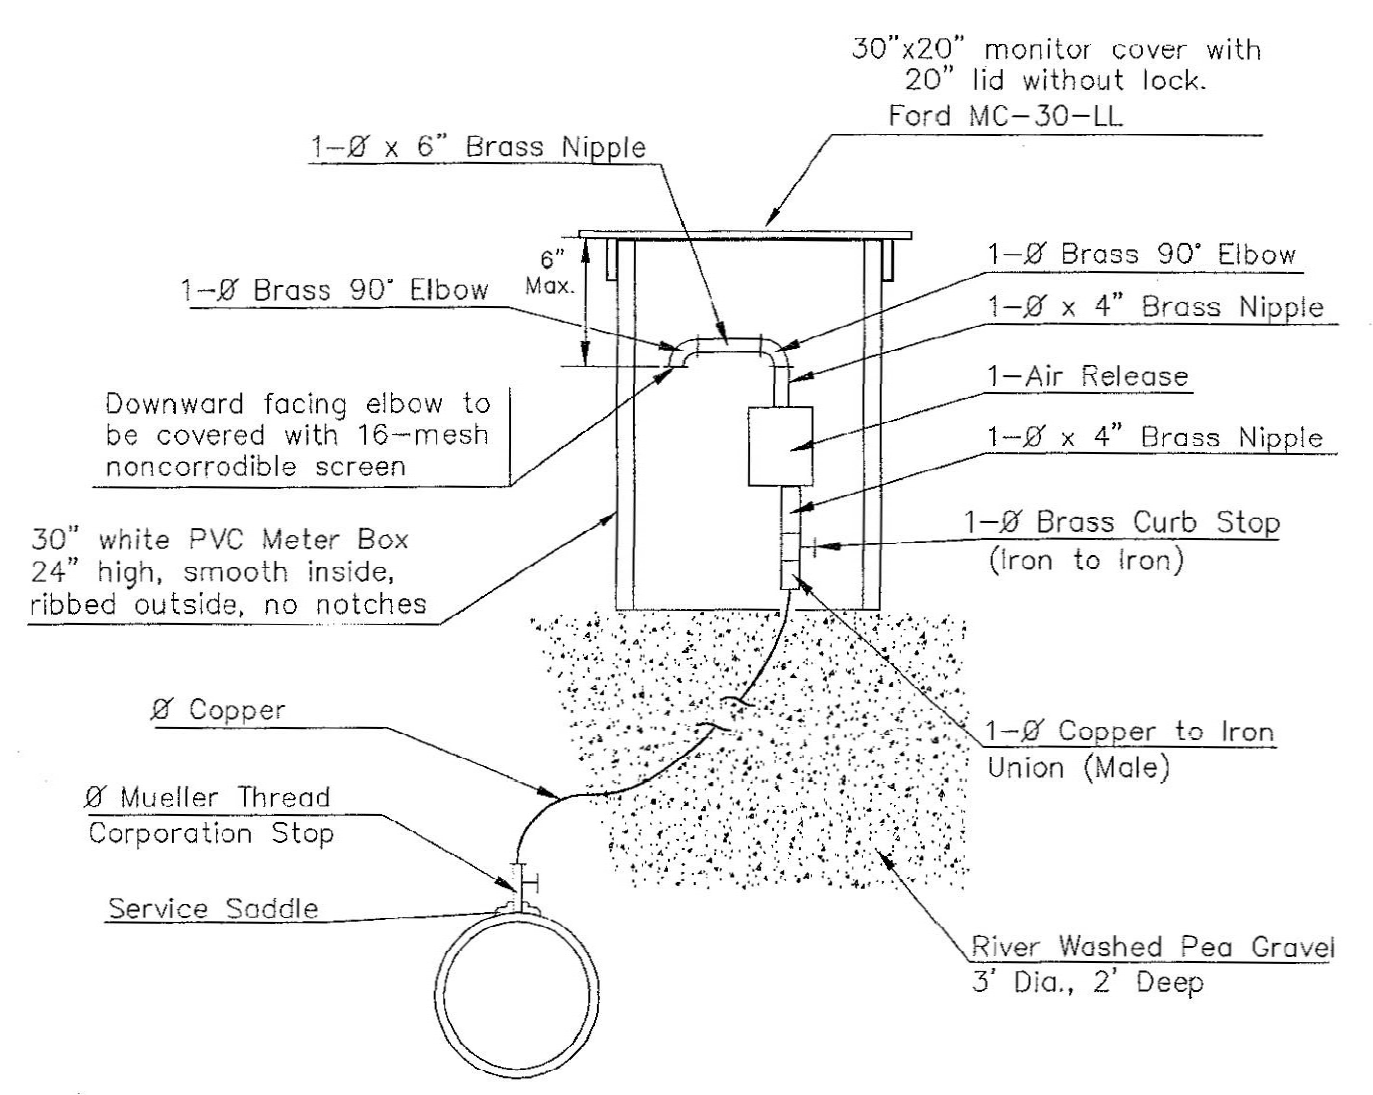

MATERIALS FOR 1" or 2" AIR RELEASE ASSEMBLY  
Ø = 1" or 2"

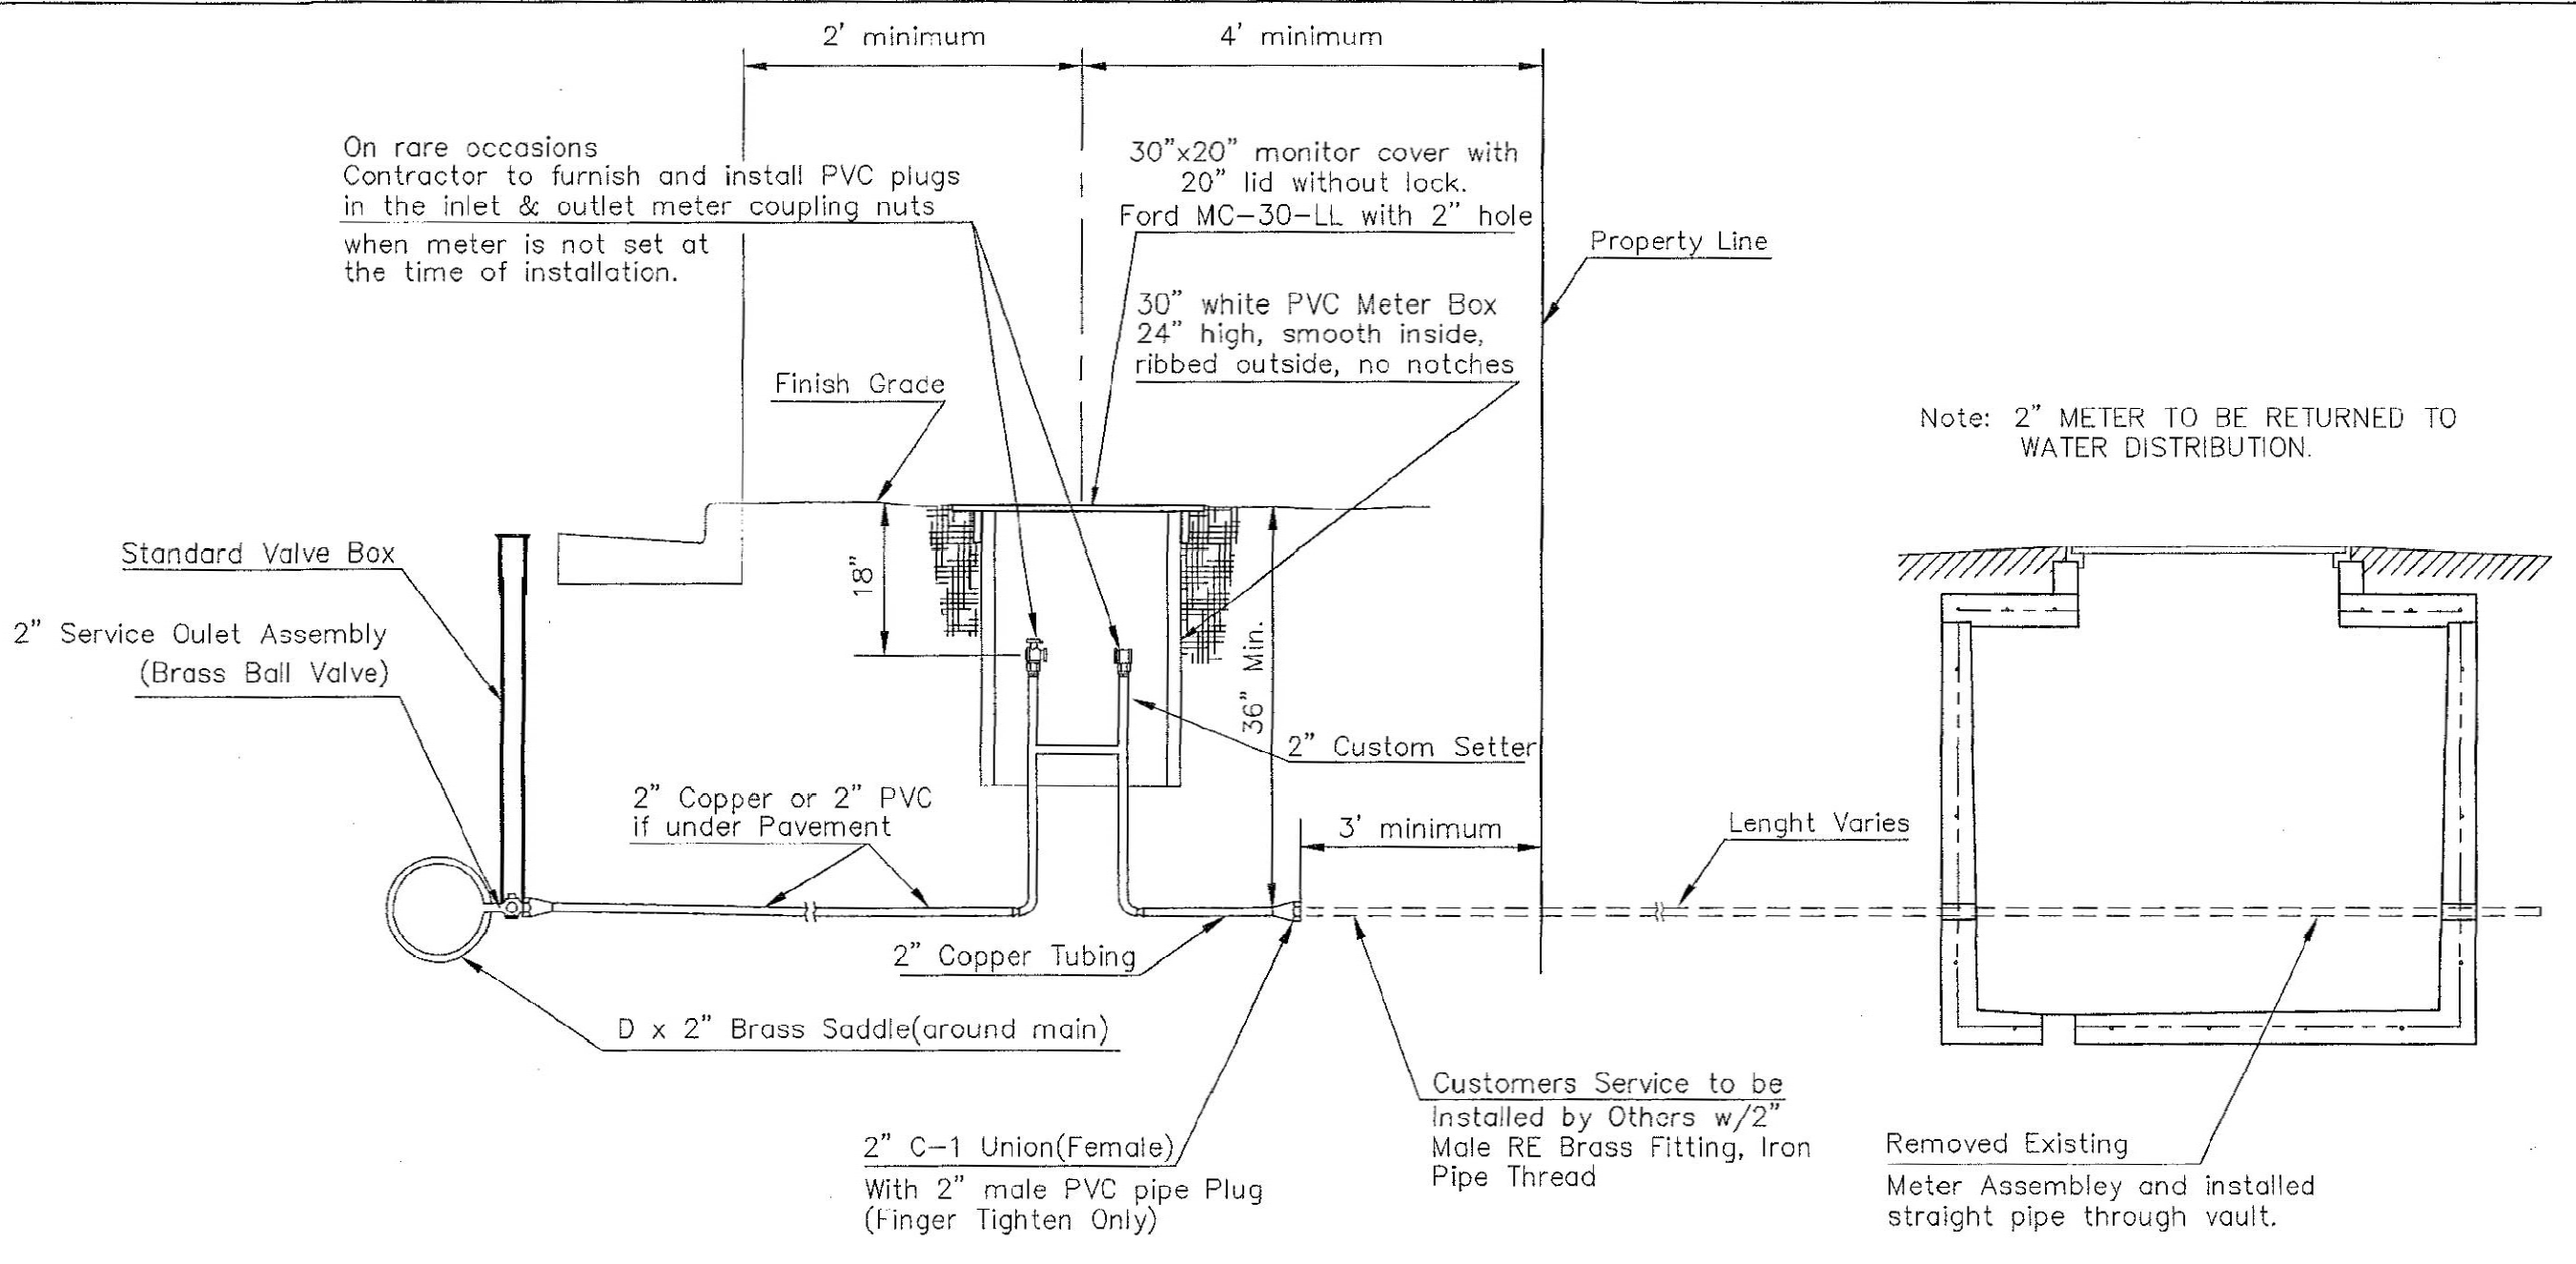


TYPICAL 2" METER SETTING


TYPICAL 2" METER SETTING INVOLVING EXISTING 2" METER VAULT

Note: ONE VALVE STEM EXTENSION FOR EACH VALVE BURIED GREATER THAN 5'.

Note: ONE VALVE STEM EXTENSION FOR EACH VALVE BURIED GREATER THAN 5'.

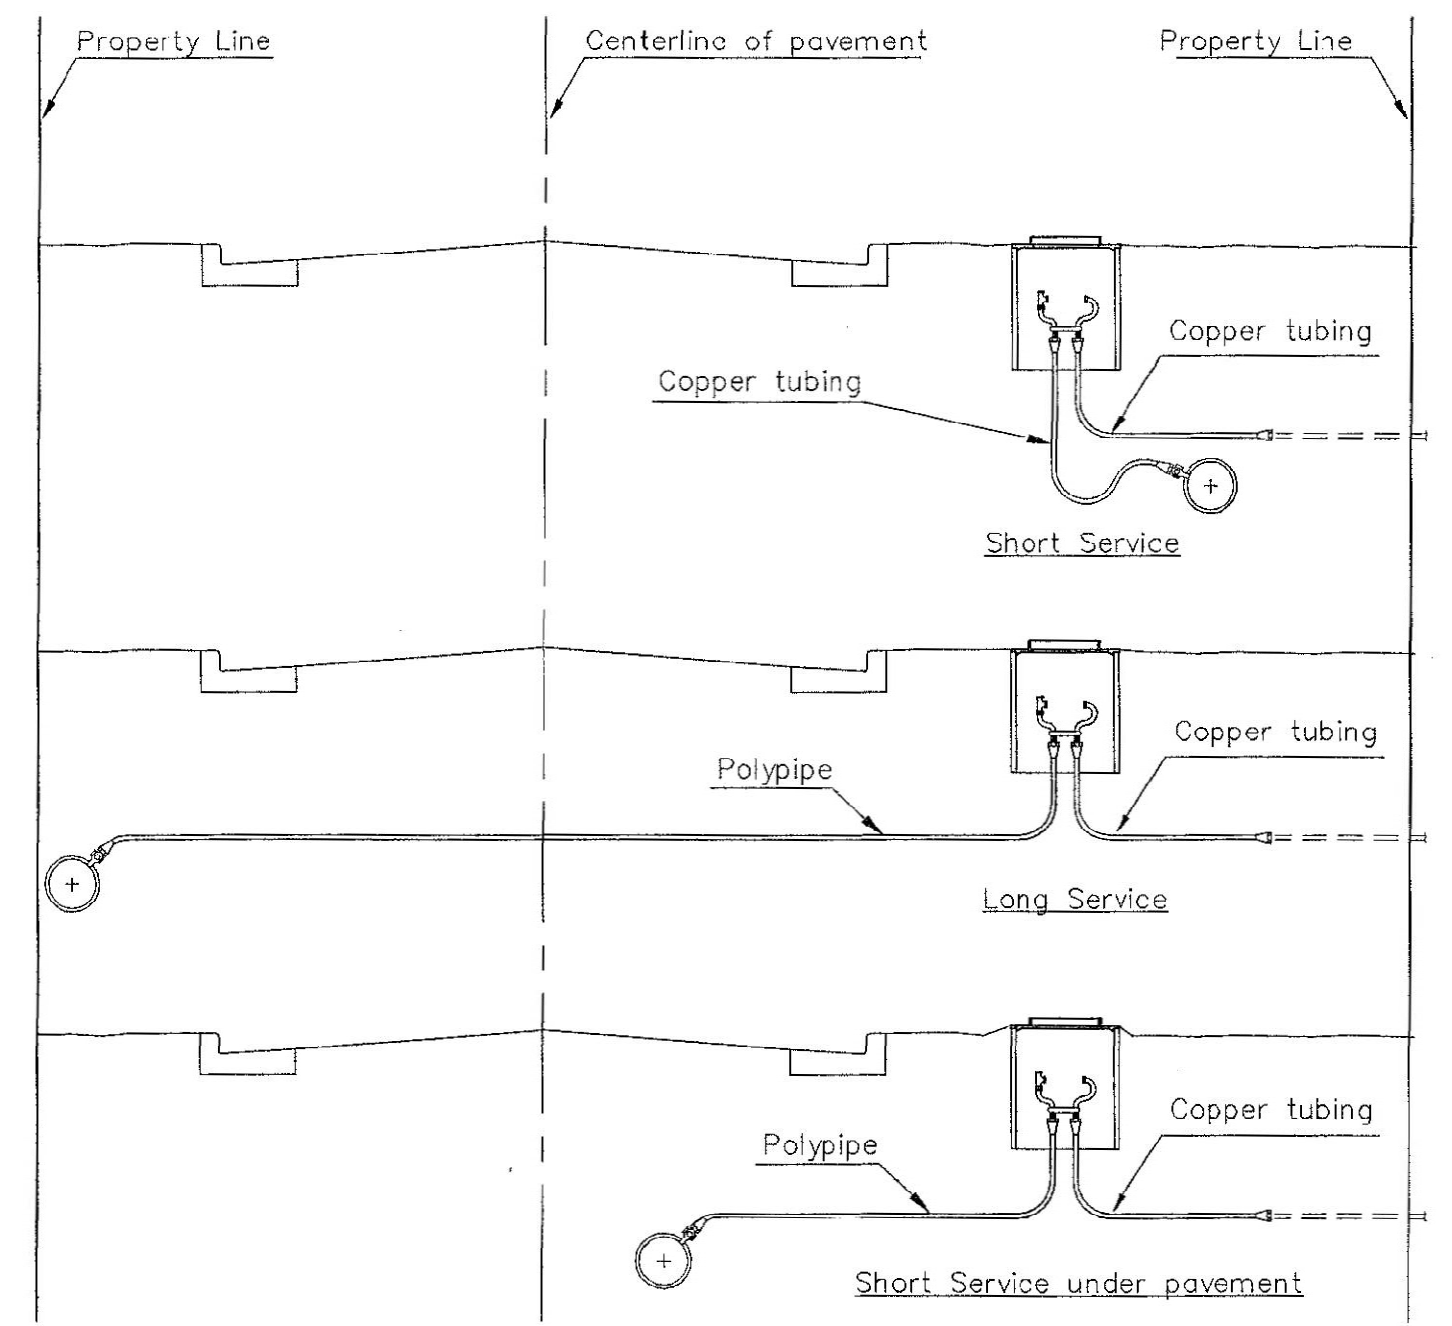

SERVICE TYPES

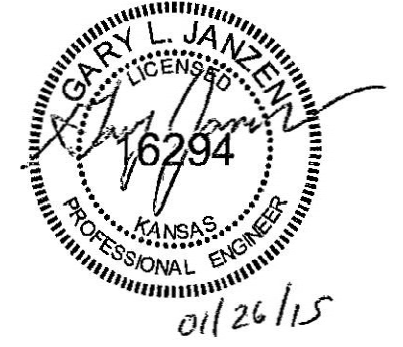

<b>STANDARD WATER SERVICE DETAIL</b>		
CITY ENGINEER <b>GARY JANZEN, P.E.</b>		
PROJECT NUMBER 2028 PPW	OCA NUMBER (607853)	DATE
CITY ENGINEER'S OFFICE CITY HALL - SEVENTH FLOOR 455 NORTH MAIN STREET WICHITA, KANSAS 67202-1620 (316) 268-4501		SHEET

WL-102


Sheet 11-09-2016 4:50:59 PM by CSI  
Plot Scale 1:1 11-20-2016 8:24:43 AM by CSI  
U:\Wichita-Cad\2016\160551\000\Main\Drawings\160551-000-C3-06-STANDARD WATER SERVICE DETAILS

DATE	PURPOSE	NO.
08.25.16	30% PROGRESS SET	
09.15.16	60% PROGRESS SET	
10.13.16	90% PROGRESS SET	
11.10.16	BID/PERMIT SET	
11.22.16	ADDENDUM #1	1
12.07.16	CITY COMMENTS	2

HAMPTON INN  
CADILLAC LAKE  
WICHITA, KANSAS




LKArchitecture  
Architecture • Engineering • Planning • Interior Design • Landscape Architecture

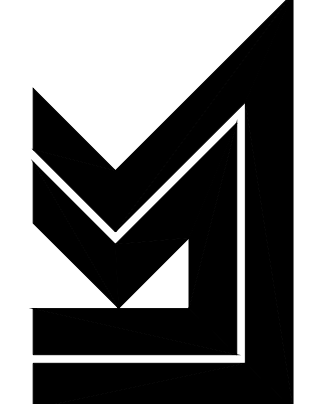

PROFESSIONAL ENGINEERING CONSULTANTS, P.A.  
300 SOUTH TOPEKA  
WICHITA, KANSAS 67202  
316-268-2981 www.pec.com


PEC

LKArchitecture, Inc.®  
345 Riverview Wichita, KS 67203  
T 316.268.0230 F 316.268.0205  
CONTACT: PEC  
DRAWN: PEC  
CHECKED: PEC  
PROJECT NUMBER:  
**15433**  
SHEET TITLE:  
MISCELLANEOUS  
WATER DETAILS  
SHEET NUMBER:  
**C3.07** OF: X

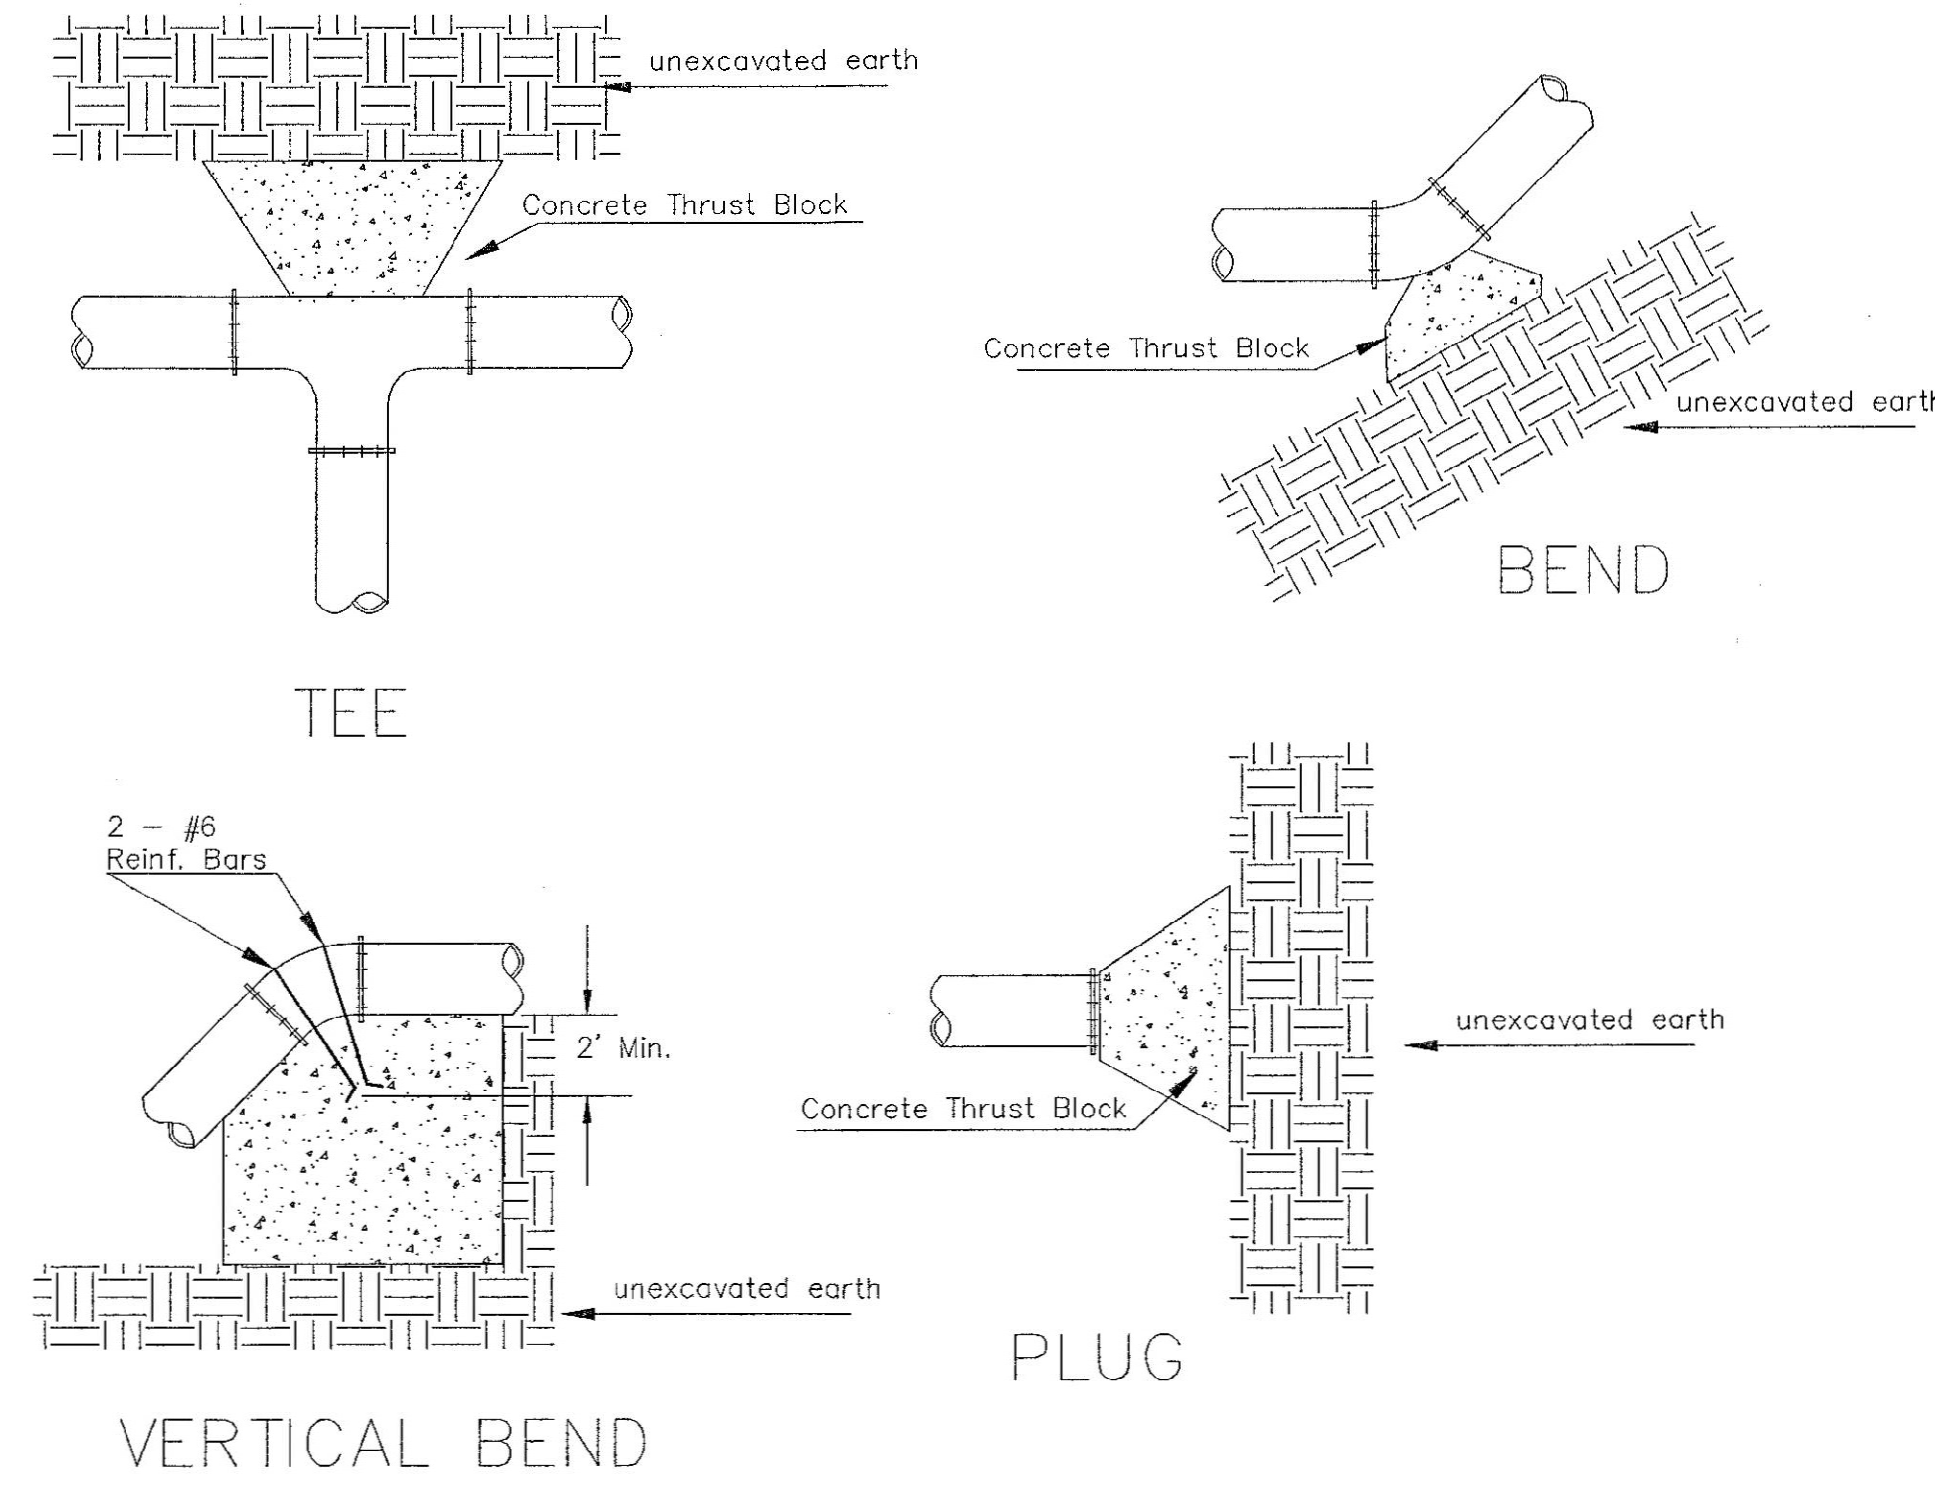


PIPE SIZE	PLUG	THRUST AT FITTINGS IN TONS-AT 150#/IN <sup>2</sup> P					
		90°	45°	22 1/2°	11 1/4°	TEE	
6"	2.8	3.95	2.15	1.09	.55	2.8	
8"	4.9	6.95	3.75	1.90	.96	4.9	
12"	11.4	16.1	8.75	4.45	2.25	11.4	
16"	20.15	28.5	15.4	7.85	3.95	20.15	
20"	31.15	44.0	23.85	12.15	6.10	31.15	
24"	44.55	63.0	34.1	17.4	8.75	44.55	

TYPICAL THRUST BLOCKS

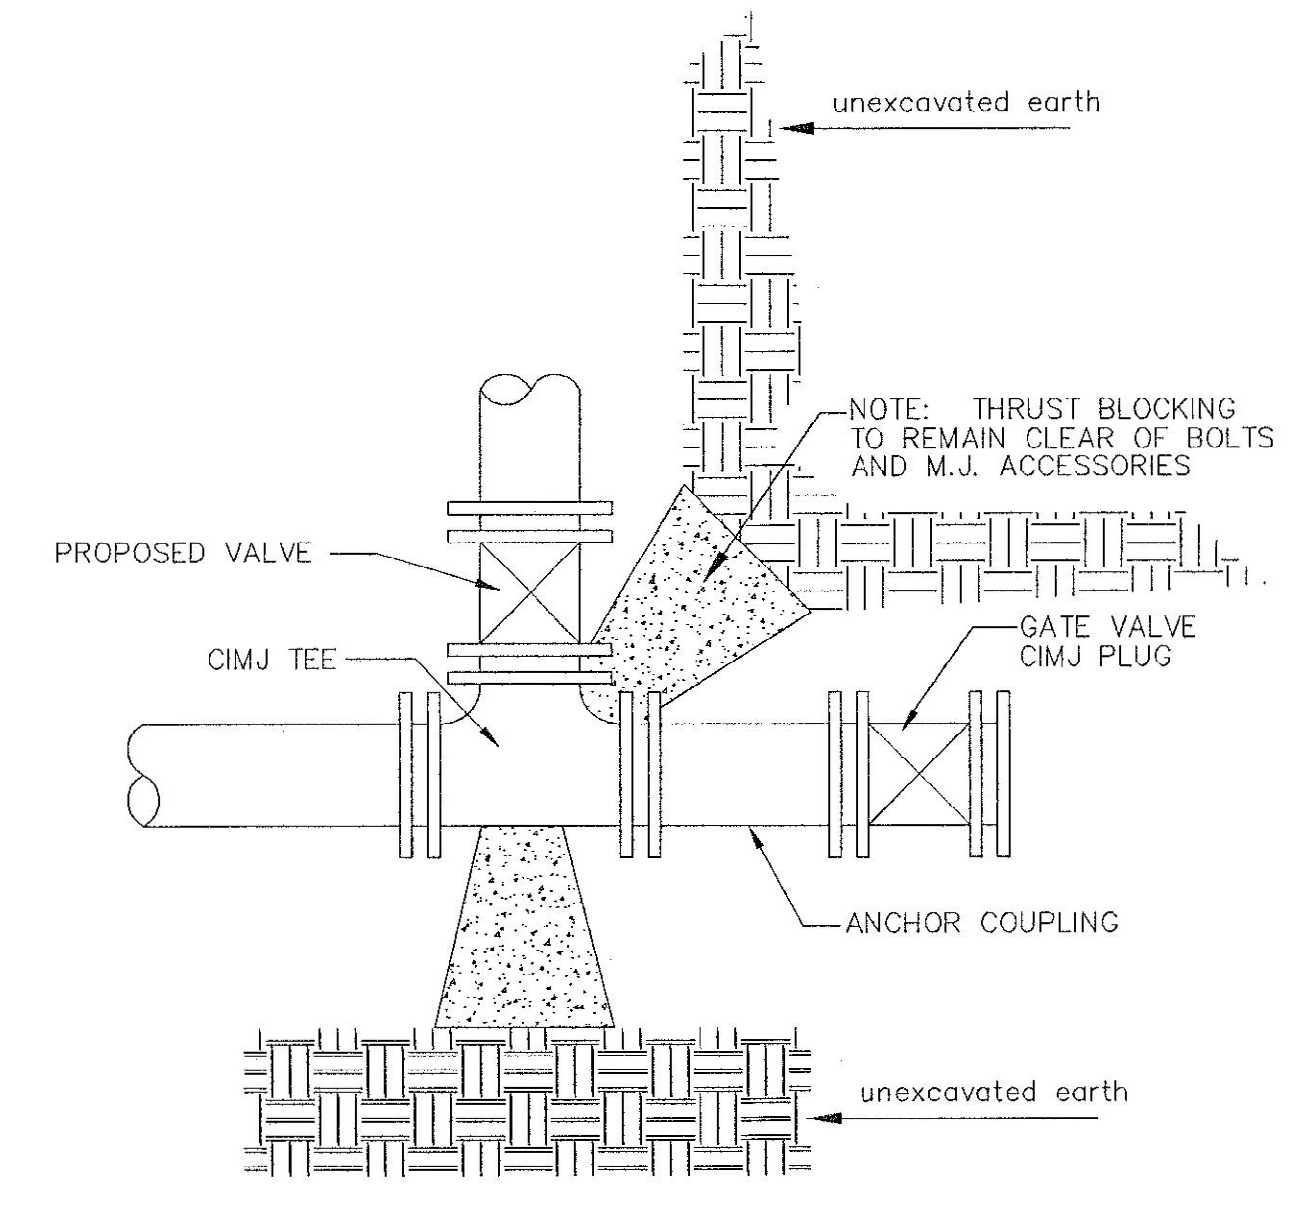


KEY BLOCK DETAIL

\* PLANS GOVERN  
UNLESS OTHERWISE NOTED ON PLANS

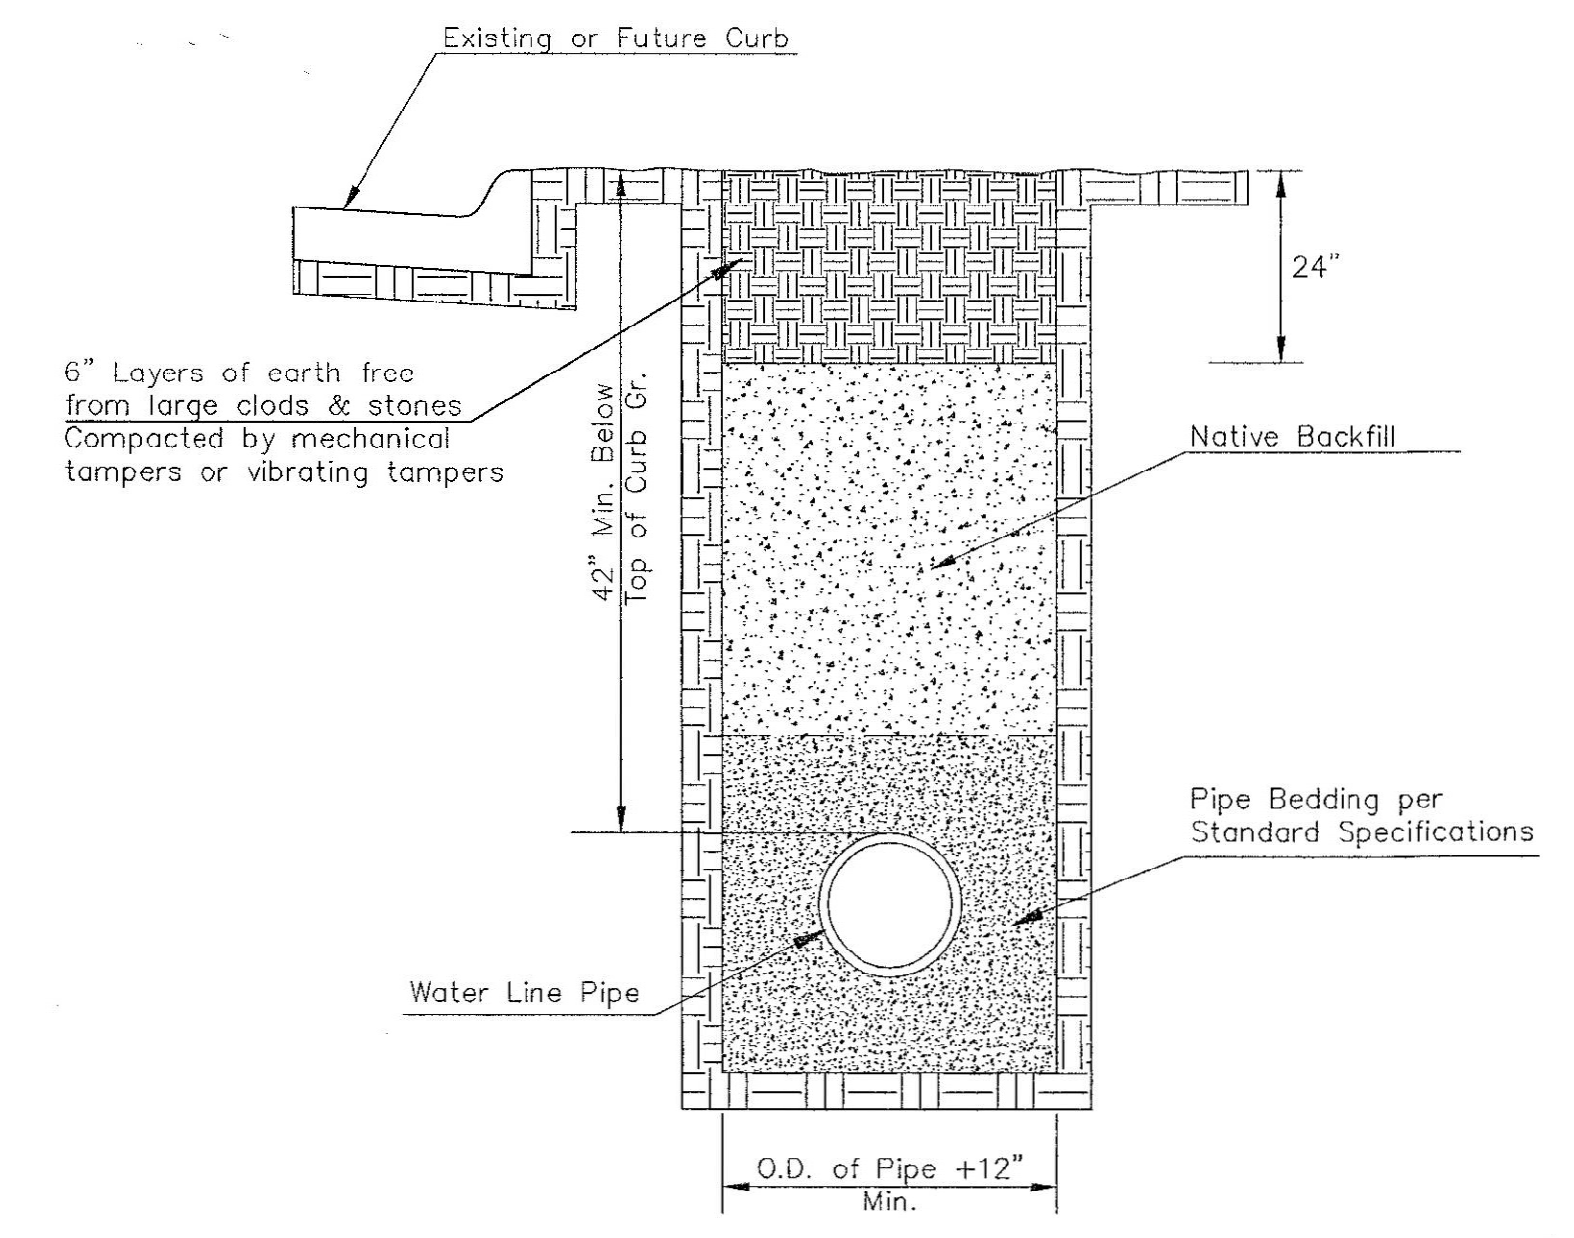


TRENCH COMPACTION IN ROAD RIGHT-OF-WAY

SIDE VIEW

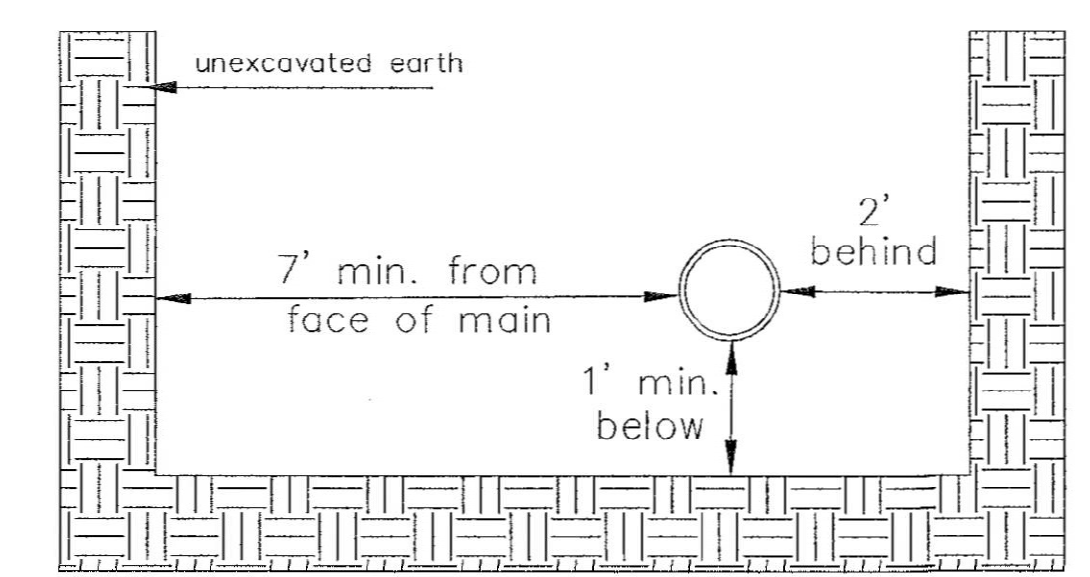


TOP VIEW

Note: When shoring is required it is to be per The City of Wichita Standard Specifications.

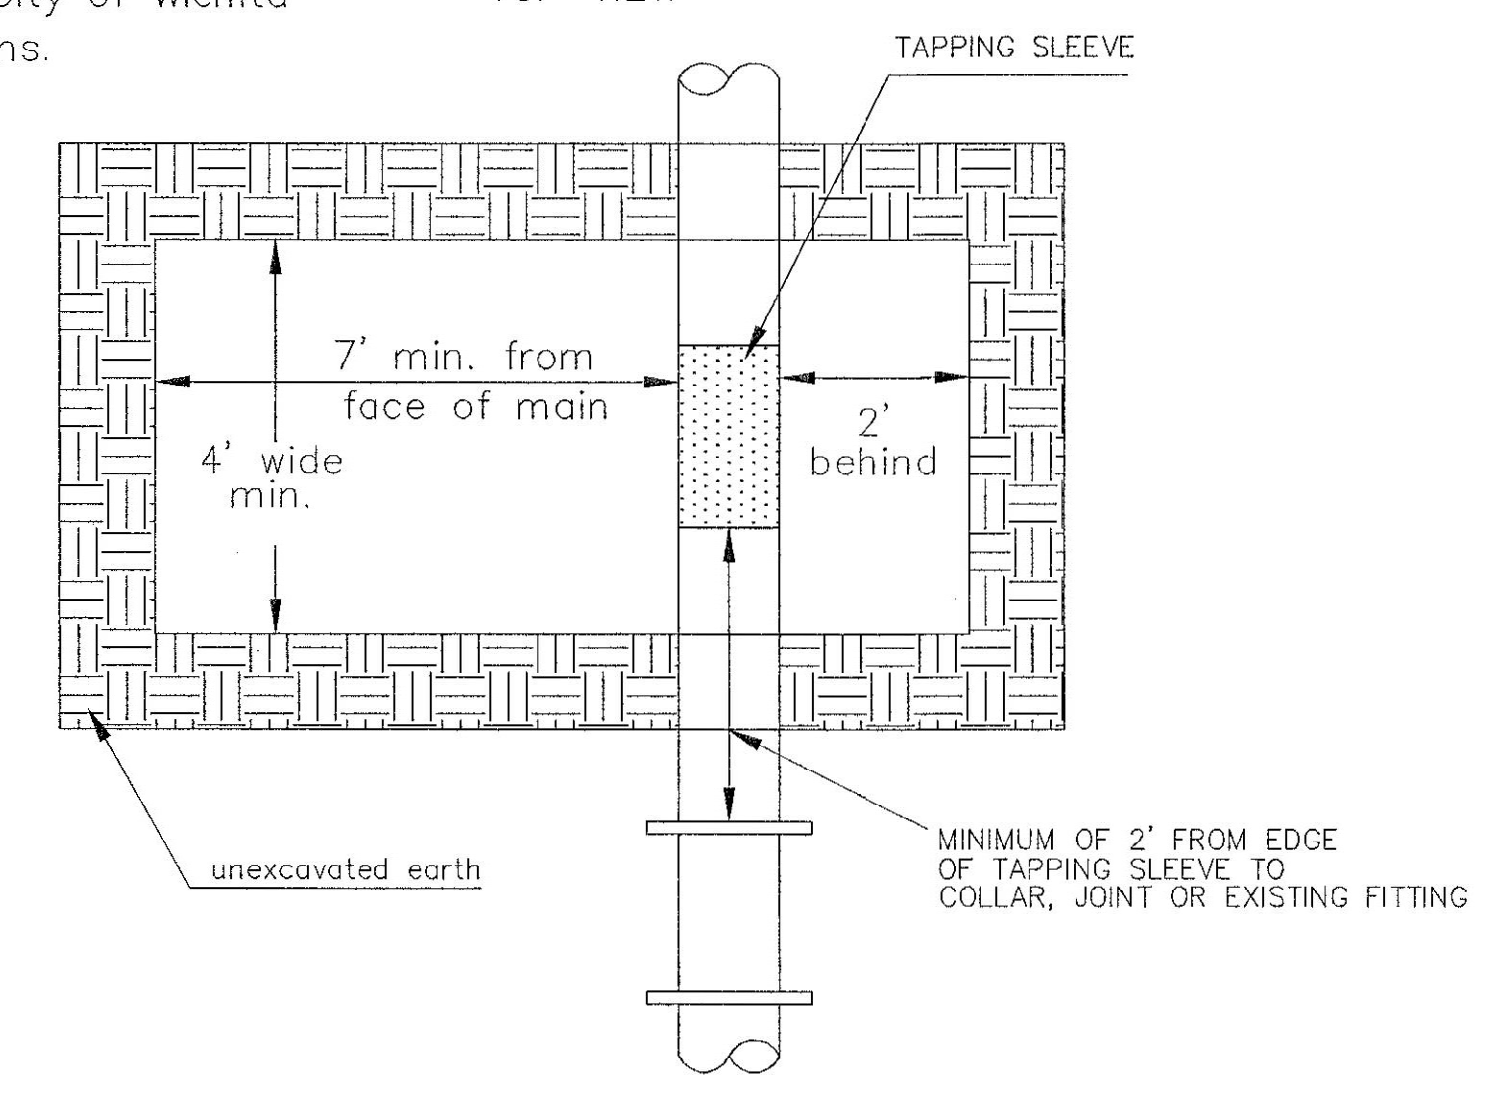


EXCAVATION FOR WET TAP

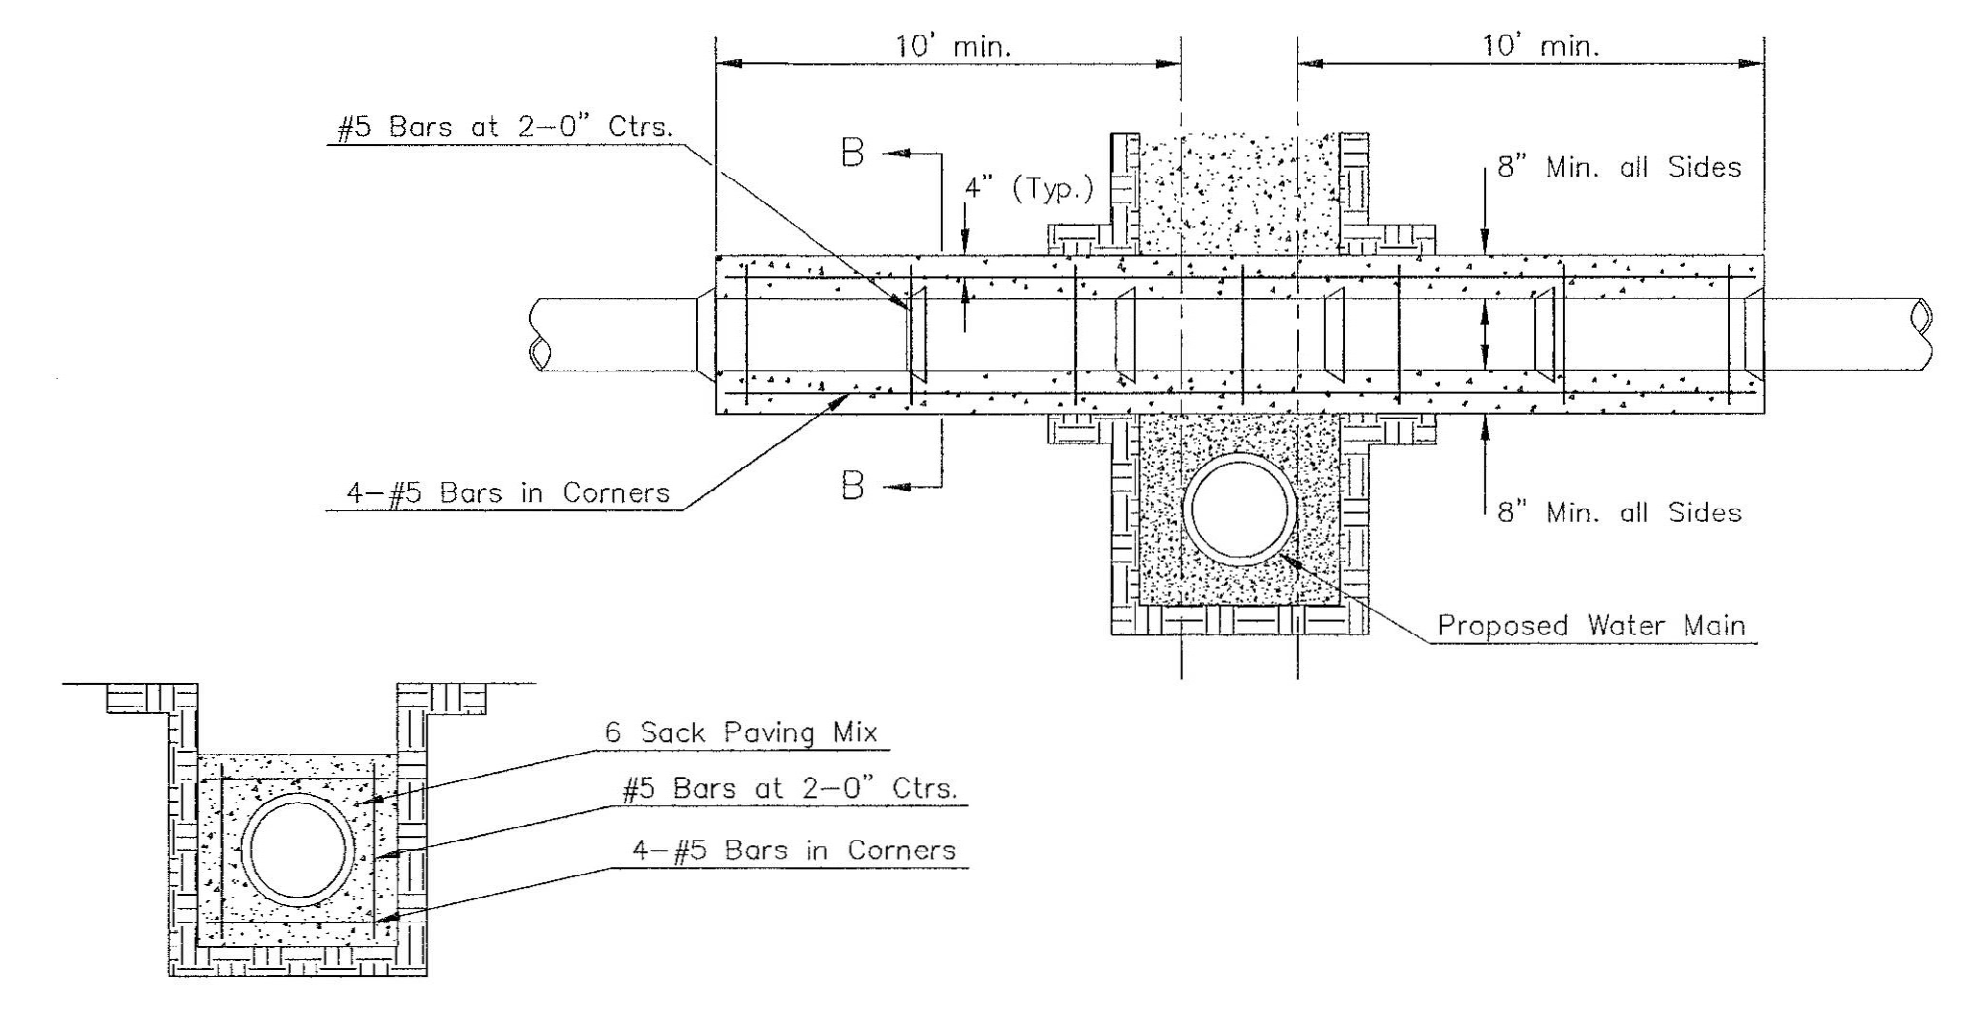

SECTION B-B


Note: Encasement to begin and end at a Bell on Sanitary Sewer Pipe.

REINFORCED CONCRETE ENCASEMENT OF SANITARY SEWER

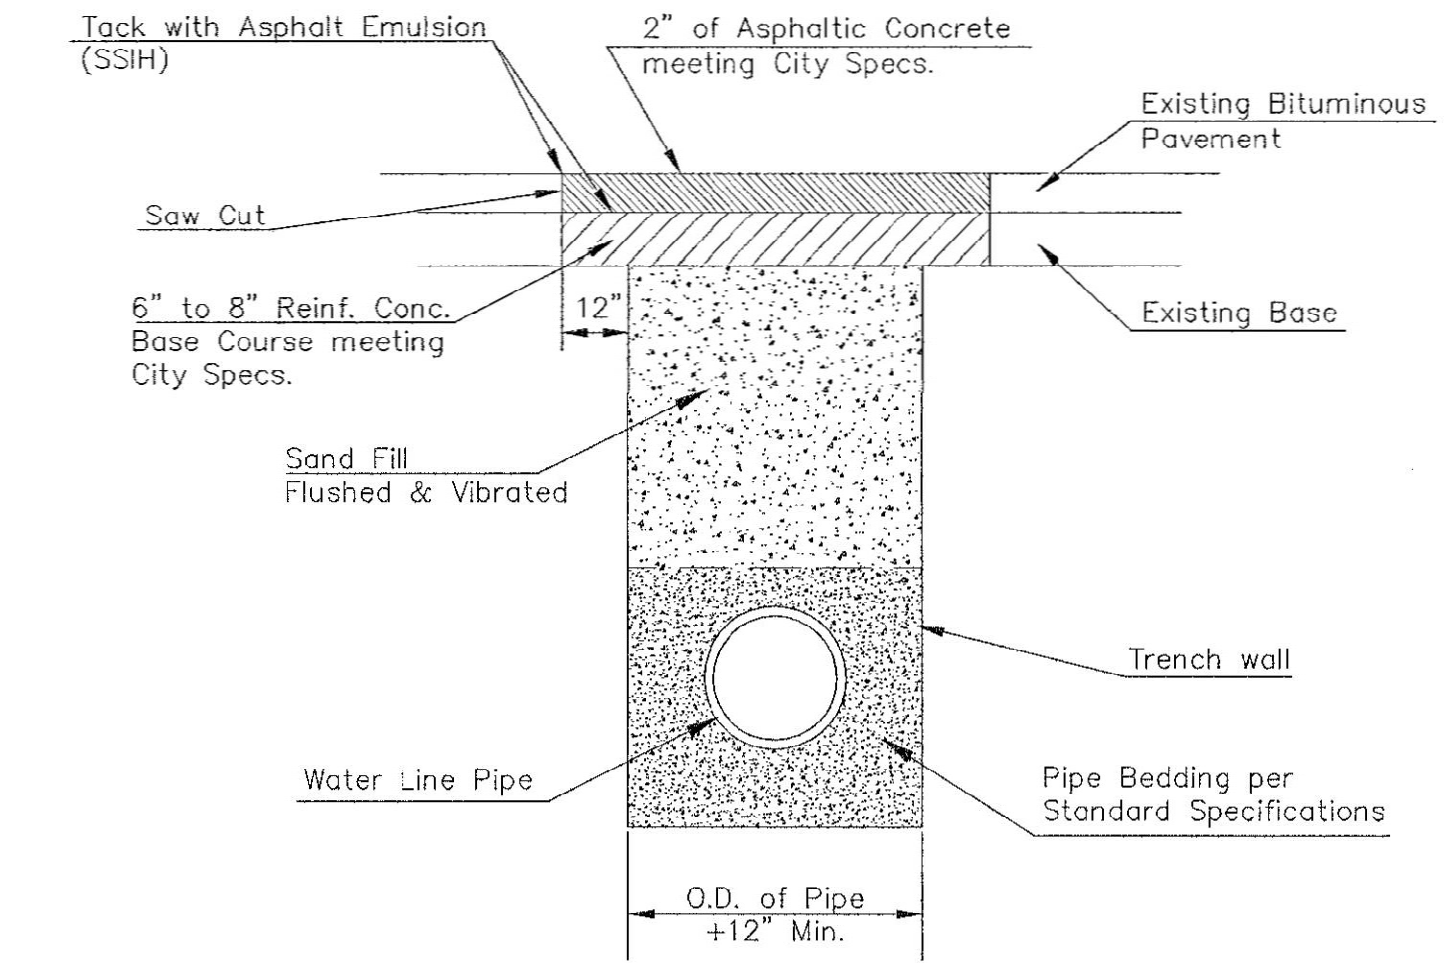

PAVEMENT REPLACEMENT & TRENCH COMPACTION UNDER EXISTING AND PROPOSED CITY ROADS

REVISED: JULY 2015

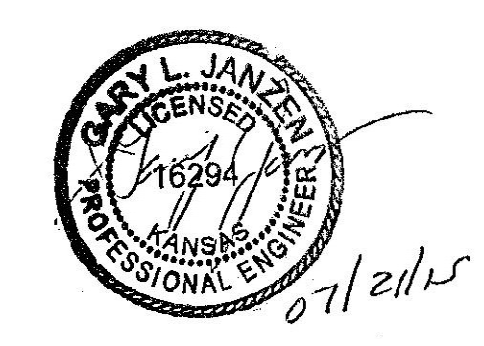

 <b>CITY OF WICHITA</b> PUBLIC WORKS & UTILITIES ENGINEERING DIVISION	<b>MISCELLANEOUS WATER DETAILS</b> CITY ENGINEER <b>GARY JANZEN, P.E.</b>		DATE
	PROJECT NUMBER 2028 PPW	OCA NUMBER (607853)	SHEET
	CITY ENGINEER'S OFFICE CITY HALL - SEVENTH FLOOR 435 NORTH MAIN STREET WICHITA, KANSAS 67202-1620 (316) 268-4501		

WL-104

Sheet 11-09-2016 4:51:13 PM by CSI  
 Plot Scale 1:1 11-30-2016 8:25:59 AM by CSI  
 U:\Wichita-Civil\2016\160551\000\Main\Drawings\160551-000-C3-07-MISCELLANEOUS WATER DETAILS


DATE	PURPOSE	NO.
08.25.16	30% PROGRESS SET	
09.15.16	60% PROGRESS SET	
10.13.16	90% PROGRESS SET	
11.10.16	BID/PERMIT SET	1
11.22.16	ADDENDUM #1	1
12.07.16	CITY COMMENTS	2

# CADILLAC LAKE

## AN ADDITION TO WICHITA, SEDGWICK COUNTY, KANSAS

### FINAL PLAT

Sedgwick County  
 Register of Deeds  
 Doc #/Flm-Pg: 25660357  
 Record #: 194921  
 Page Recorded: 1  
 Date Recorded: 09/29/2015 02:07:10 PM  
 Recording Fee: \$23.00

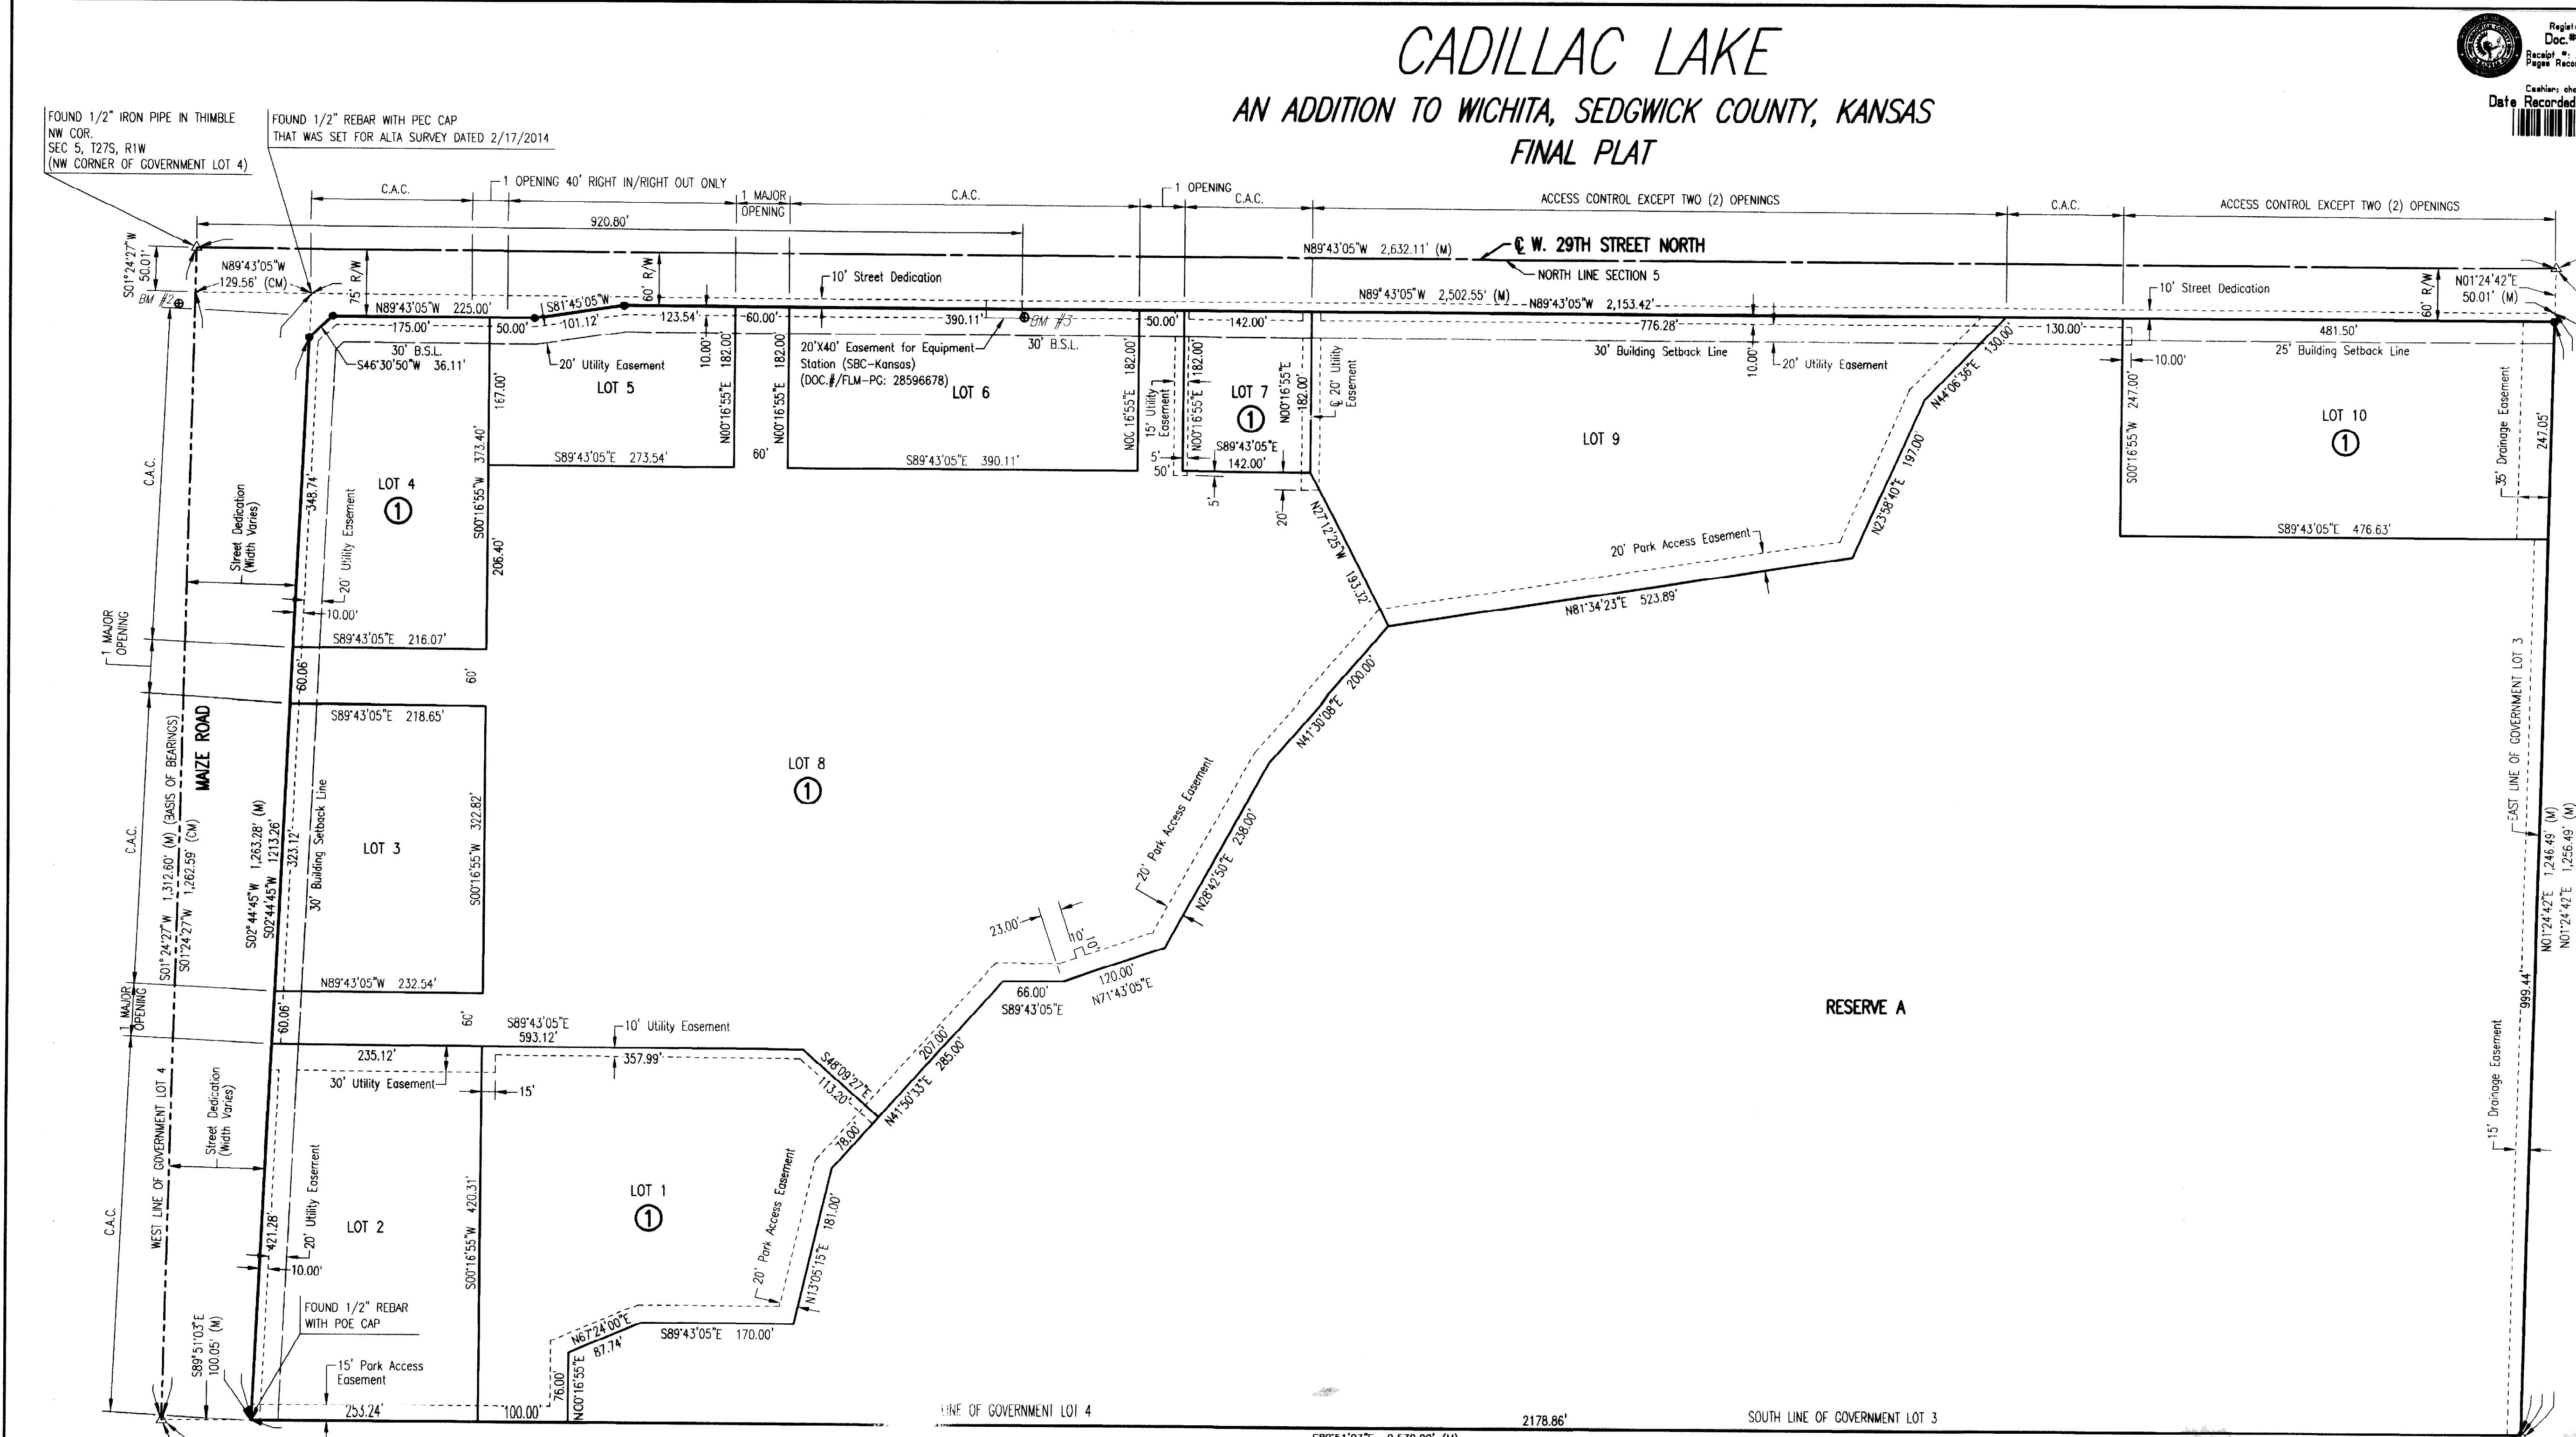

FOUND 1/2" IRON PIPE IN THIMBLE  
 NE COR. NW 1/4,  
 SEC 5, T27S, R1W  
 (NE CORNER OF GOVERNMENT LOT 3)

FOUND 1/2" REBAR WITH TERRA TECH CAP  
 WITH TERRA TECH CAP

FOUND 1/2" REBAR WITH PEC CAP  
 THAT WAS SET FOR ALTA SURVEY DATED 2/17/2014

FOUND 1/2" IRON PIPE IN THIMBLE  
 SW COR., N 1/2, NW 1/4,  
 SEC 5, T27S, R1W  
 (SW CORNER OF GOVERNMENT LOT 4)

FOUND 1/2" REBAR WITH TERRA TECH CAP  
 WITH TERRA TECH CAP

FOUND 1/2" REBAR WITH PEC CAP  
 THAT WAS SET FOR ALTA SURVEY DATED 2/17/2014

- LEGEND**
- SET 1/2" REBAR w/PEC CAP
  - △ SECTION CORNER
  - M MEASURED
  - CM CALCULATED FROM MEASURED
  - P-PCA PLATED MEASUREMENT FROM PEARSON COMMERCIAL ADDITION COMPLETE ACCESS CONTROL
  - C.A.C. COMPLETE ACCESS CONTROL
- BENCH MARK LIST** BM #3
- BM #1 - CHISELED SQUARE ON TOP OF CURB, SOUTH SIDE OF DRIVE ENTRANCE TO NORTHEAST CORNER OF TARGET PARKING LOT AND SOUTHWEST OF SOUTHWEST CORNER OF GOVERNMENT LOT 4, SEC 5-27-1W. ELEV.=1352.44 (NAVD88)
  - BM #2 - CHISELED SQUARE AT SOUTHWEST CORNER OF SOUTH HEADWALL FOR RIBC UNDER 29TH STREET, WEST OF MAIZE ROAD (NOT THE CHISELED + AT THE SOUTHWEST CORNER OF SAME HEADWALL). ELEV.=1353.32 (NAVD88)
  - BM #3 - CHISELED SQUARE ON TOP OF RETAINING WALL AT SOUTHWEST CORNER OF CONCRETE PAD FOR ELECTRIC TRANSFORMER #10105 ON SOUTH SIDE OF 29TH STREET AND 800 FEET EAST OF BIKE PATH ON EAST SIDE OF MAIZE ROAD. ELEV.=1352.01 (NAVD88)

THIS PLAT OF CADILLAC LAKE HAS BEEN SUBMITTED TO AND APPROVED BY THE WICHITA-SEDGWICK COUNTY METROPOLITAN AREA PLANNING COMMISSION, WICHITA, KANSAS, APPROVED THE 14th DAY OF July, 2015.

MATTHEW J. OSOBY, CHAIRMAN  
 W.D. BARBER, INTERIM SECRETARY  
 W. DAVID BARBER

REVIEWED IN ACCORDANCE WITH K.S.A. 58-2005 ON THIS \_\_\_\_\_ DAY OF \_\_\_\_\_, 2015.

TRICIA L. ROBELLO, LS #1246  
 DEPUTY COUNTY SURVEYOR  
 SEDGWICK COUNTY, KANSAS

THIS PLAT IS APPROVED AND ALL DEDICATIONS SHOWN HEREON ACCEPTED BY THE CITY COUNCIL OF THE CITY OF WICHITA, KANSAS, THIS 1st DAY OF September, 2015.

Jeff Longwell, MAYOR  
 Jeff Longwell  
 Karen Sublett, CITY CLERK

ENTERED ON TRANSFER RECORD THIS 29th DAY OF September, 2015.

Kelly Arnold, COUNTY CLERK

THIS IS TO CERTIFY THAT THIS INSTRUMENT WAS FILED FOR RECORD IN THE REGISTER OF DEEDS OFFICE AT 02:03:10 P.M. ON THE 29 DAY OF September, 2015.

Bill Meek, REGISTER OF DEEDS  
 TONYA BUCKINGHAM, DEPUTY

**PEC** PROFESSIONAL ENGINEERING CONSULTANTS, P.A.  
 303 SOUTH TOPEKA WICHITA, KS 67202  
 316-262-2691 www.pec1.com

STATE OF KANSAS )  
 ) SS  
 COUNTY OF SEDGWICK )

WE, PROFESSIONAL ENGINEERING CONSULTANTS, P.A., ENGINEERS AND SURVEYORS IN AFORESAID STATE AND COUNTY, DO HEREBY CERTIFY ON THIS 12th DAY OF August, 2015, THAT WE HAVE SURVEYED AND PLATTED CADILLAC LAKE, AN ADDITION TO WICHITA, SEDGWICK COUNTY, KANSAS, INTO LOTS, STREETS, A BLOCK, AND A RESERVE, DESCRIBED AS FOLLOWS:

**LEGAL DESCRIPTION:**  
 GOVERNMENT LOTS 3 AND 4 IN THE NORTHWEST QUARTER OF SECTION 5, TOWNSHIP 27 SOUTH, RANGE 1 WEST OF THE 6TH P.M., SEDGWICK COUNTY, KANSAS, EXCEPT THE NORTH 50 FEET THEREOF.

ALL PUBLIC EASEMENTS LYING WITHIN ABOVE DESCRIBED TRACT OF LAND ARE HEREBY VACATED AND REPLATED BY VIRTUE OF K.S.A. 12-512b, AS AMENDED.

Ernest Cantu Jr.  
 AUG 12, 2015

ERNEST CANTU JR., P.E. NO. 1407  
 PROFESSIONAL ENGINEERING CONSULTANTS, P.A.

THIS ADDITION IS SUBJECT TO THE CONDITIONS OF THE CADILLAC LAKE COMMUNITY UNIT PLAN (CUP2015-00005, DP-336).

THE PARK ACCESS EASEMENT AS SHOWN FOR CITY PARKS AND RECREATION DEPARTMENT IS HEREBY GRANTED.

UTILITY EASEMENTS AS SHOWN FOR THE CONSTRUCTION AND MAINTENANCE OF PUBLIC UTILITIES ARE HEREBY GRANTED.

DRAINAGE EASEMENTS AS SHOWN FOR THE CONSTRUCTION AND MAINTENANCE OF DRAINAGE IMPROVEMENTS ARE HEREBY GRANTED.

ALL ADJUTERS' RIGHT OF ACCESS TO AND FROM MAIZE ROAD AND 29TH STREET NORTH ARE HEREBY GRANTED TO THE APPROPRIATE GOVERNING BODY, PROVIDED HOWEVER THAT LOT 8, BLOCK 1, SHALL HAVE ACCESS TO MAIZE ROAD AT TWO (2) LOCATIONS AND THAT LOTS 4 AND 5, BLOCK 1, SHALL HAVE ONE JOINT ACCESS TO 29TH STREET NORTH (RIGHT IN/RIGHT OUT ONLY); LOT 8 SHALL HAVE ACCESS TO 29TH STREET NORTH AT TWO (2) LOCATIONS; LOT 9, BLOCK 1, SHALL HAVE ACCESS TO 29TH STREET AT TWO (2) LOCATIONS; AND LOT 10, BLOCK 1, SHALL HAVE ACCESS TO 29TH STREET NORTH AT TWO (2) LOCATIONS. FINAL LOCATIONS TO BE AS APPROVED BY THE CITY ENGINEER. ALL ACCESS OPENINGS ALONG 29TH STREET NORTH ARE TO BE IN ACCORDANCE WITH WICHITA-SEDGWICK COUNTY ACCESS MANAGEMENT STANDARDS.

THE STREET DEDICATIONS ALONG MAIZE ROAD AND 29TH STREET NORTH ARE HEREBY DEDICATED TO AND FOR THE USE OF THE PUBLIC.

A DRAINAGE PLAN HAS BEEN APPROVED FOR THIS PLAT. ALL DRAINAGE EASEMENTS, RIGHTS-OF-WAY OR RESERVES SHALL REMAIN AT ESTABLISHED GRADES AND UNOBTSTRUCTED TO ALLOW FOR THE CONVEYANCE OF STORMWATER, UNLESS MODIFIED WITH THE APPROVAL OF THE CITY ENGINEER.

MINIMUM OPENING	ELEVATION (NAVD88)
BLOCK 1	1352.7
LOTS 1 - 10	1352.7

FEMA FLOODPLAIN AND REGULATORY FLOODWAY BOUNDARIES ARE SUBJECT TO PERIODIC CHANGE, AND SUCH CHANGE MAY AFFECT THE INTENDED LAND USE WITHIN THE SUBDIVISION.

RESERVE A IS HEREBY PLATTED FOR OPEN SPACE, WETLANDS, CITY PARK AND ASSOCIATED AMENITIES, PEDESTRIAN TRAILS, DRAINAGE, STORMWATER DETENTION, LANDSCAPING, AND UTILITIES CONFINED TO EASEMENTS. RESERVE A SHALL BE OWNED AND MAINTAINED BY CADILLAC LAKE, LLC, ITS SUCCESSORS OR ASSIGNS.

KNOW ALL MEN BY THESE PRESENTS THAT WE, THE UNDERSIGNED PROPERTY OWNERS OF THE LAND AS ABOVE SET FORTH IN THE SURVEYOR'S CERTIFICATE, HAVE CAUSED THE LAND TO BE SURVEYED AND PLATTED INTO LOTS, STREETS, A BLOCK, AND A RESERVE, THE SAME TO BE KNOWN AS CADILLAC LAKE, AN ADDITION TO WICHITA, SEDGWICK COUNTY, KANSAS.

OWNER: CADILLAC LAKE, LLC  
 Jerry Jones, VICE PRESIDENT

STATE OF KANSAS )  
 ) SS  
 COUNTY OF SEDGWICK )

THIS INSTRUMENT WAS ACKNOWLEDGED BEFORE ME THIS 12th DAY OF August, 2015, BY JERRY JONES, VICE PRESIDENT OF CADILLAC LAKE, LLC.

Sarah E. Hatrup, NOTARY PUBLIC  
 MY APPOINTMENT EXPIRES: 12/16/16

LEGACY BANK, HOLDER OF A MORTGAGE ON THE ABOVE DESCRIBED PROPERTY, DO HEREBY CONSENT TO THE PLATING OF CADILLAC LAKE, AN ADDITION TO WICHITA, SEDGWICK COUNTY, KANSAS.

Frank A. Suelletrop, PRESIDENT  
 Frank Suelletrop

STATE OF KANSAS )  
 ) SS  
 COUNTY OF SEDGWICK )

THIS INSTRUMENT WAS ACKNOWLEDGED BEFORE ME ON THIS 12th DAY OF August, 2015, BY FRANK SUELLETROP, PRESIDENT OF LEGACY BANK.


Cathy L. White, NOTARY PUBLIC  
 MY APPOINTMENT EXPIRES: 2-1-2018

FOUND 1/2" REBAR WITH TERRA TECH CAP  
 SE COR., N 1/2, NW 1/4,  
 SEC 5, T27S, R1W  
 (SE CORNER OF GOVERNMENT LOT 3)

HAMPTON INN  
 CADILLAC LAKE  
 WICHITA, KANSAS



LKArchitecture  
 Architecture • Engineering • Planning • Interior Design • Landscape Architecture

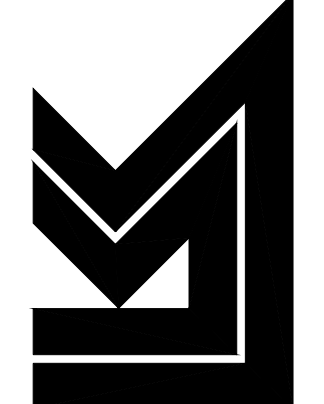


LKArchitecture, Inc. ©  
 345 Riverview Wichita, KS 67203  
 T 316.268.0230 F 316.268.0205  
 CONTACT: PEC  
 DRAWN: PEC  
 CHECKED: PEC  
 PROJECT NUMBER:  
**15433**  
 SHEET TITLE:  
 COPY OF PLAT  
 SHEET NUMBER:  
**C2.01** OF 2

DATE	PURPOSE	NO.
08.25.16	30% PROGRESS SET	
09.15.16	60% PROGRESS SET	
10.13.16	90% PROGRESS SET	
11.10.16	BID/PERMIT SET	
11.22.16	ADDENDUM #1	1
12.07.16	CITY COMMENTS	2


HAMPTON INN  
CADILLAC LAKE  
WICHITA, KANSAS



Architecture • Engineering • Planning • Interior Design • Landscape Architecture

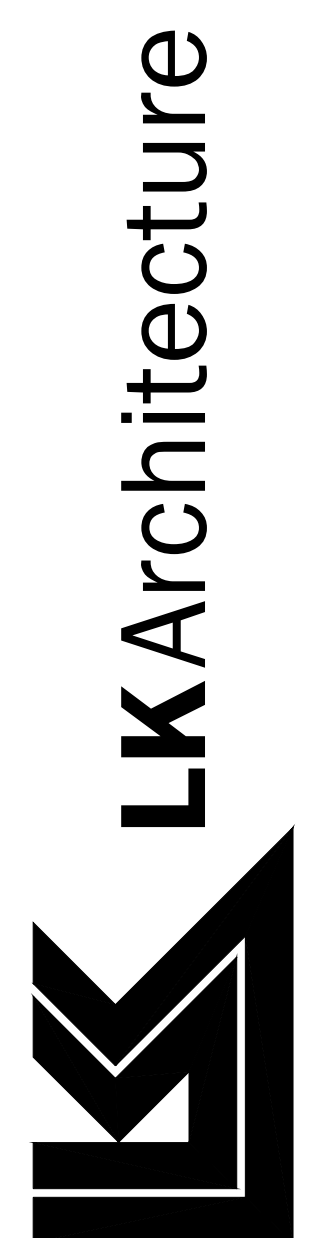

LKArchitecture, Inc.®  
345 Riverview Wichita, KS 67203  
T 316.268.0230 F 316.268.0205  
CONTACT: PEC  
DRAWN: PEC  
CHECKED: PEC  
PROJECT NUMBER:  
**15433**  
SHEET TITLE:  
COPY OF LOT SPLIT  
SHEET NUMBER:  
**C2.02** OF 2

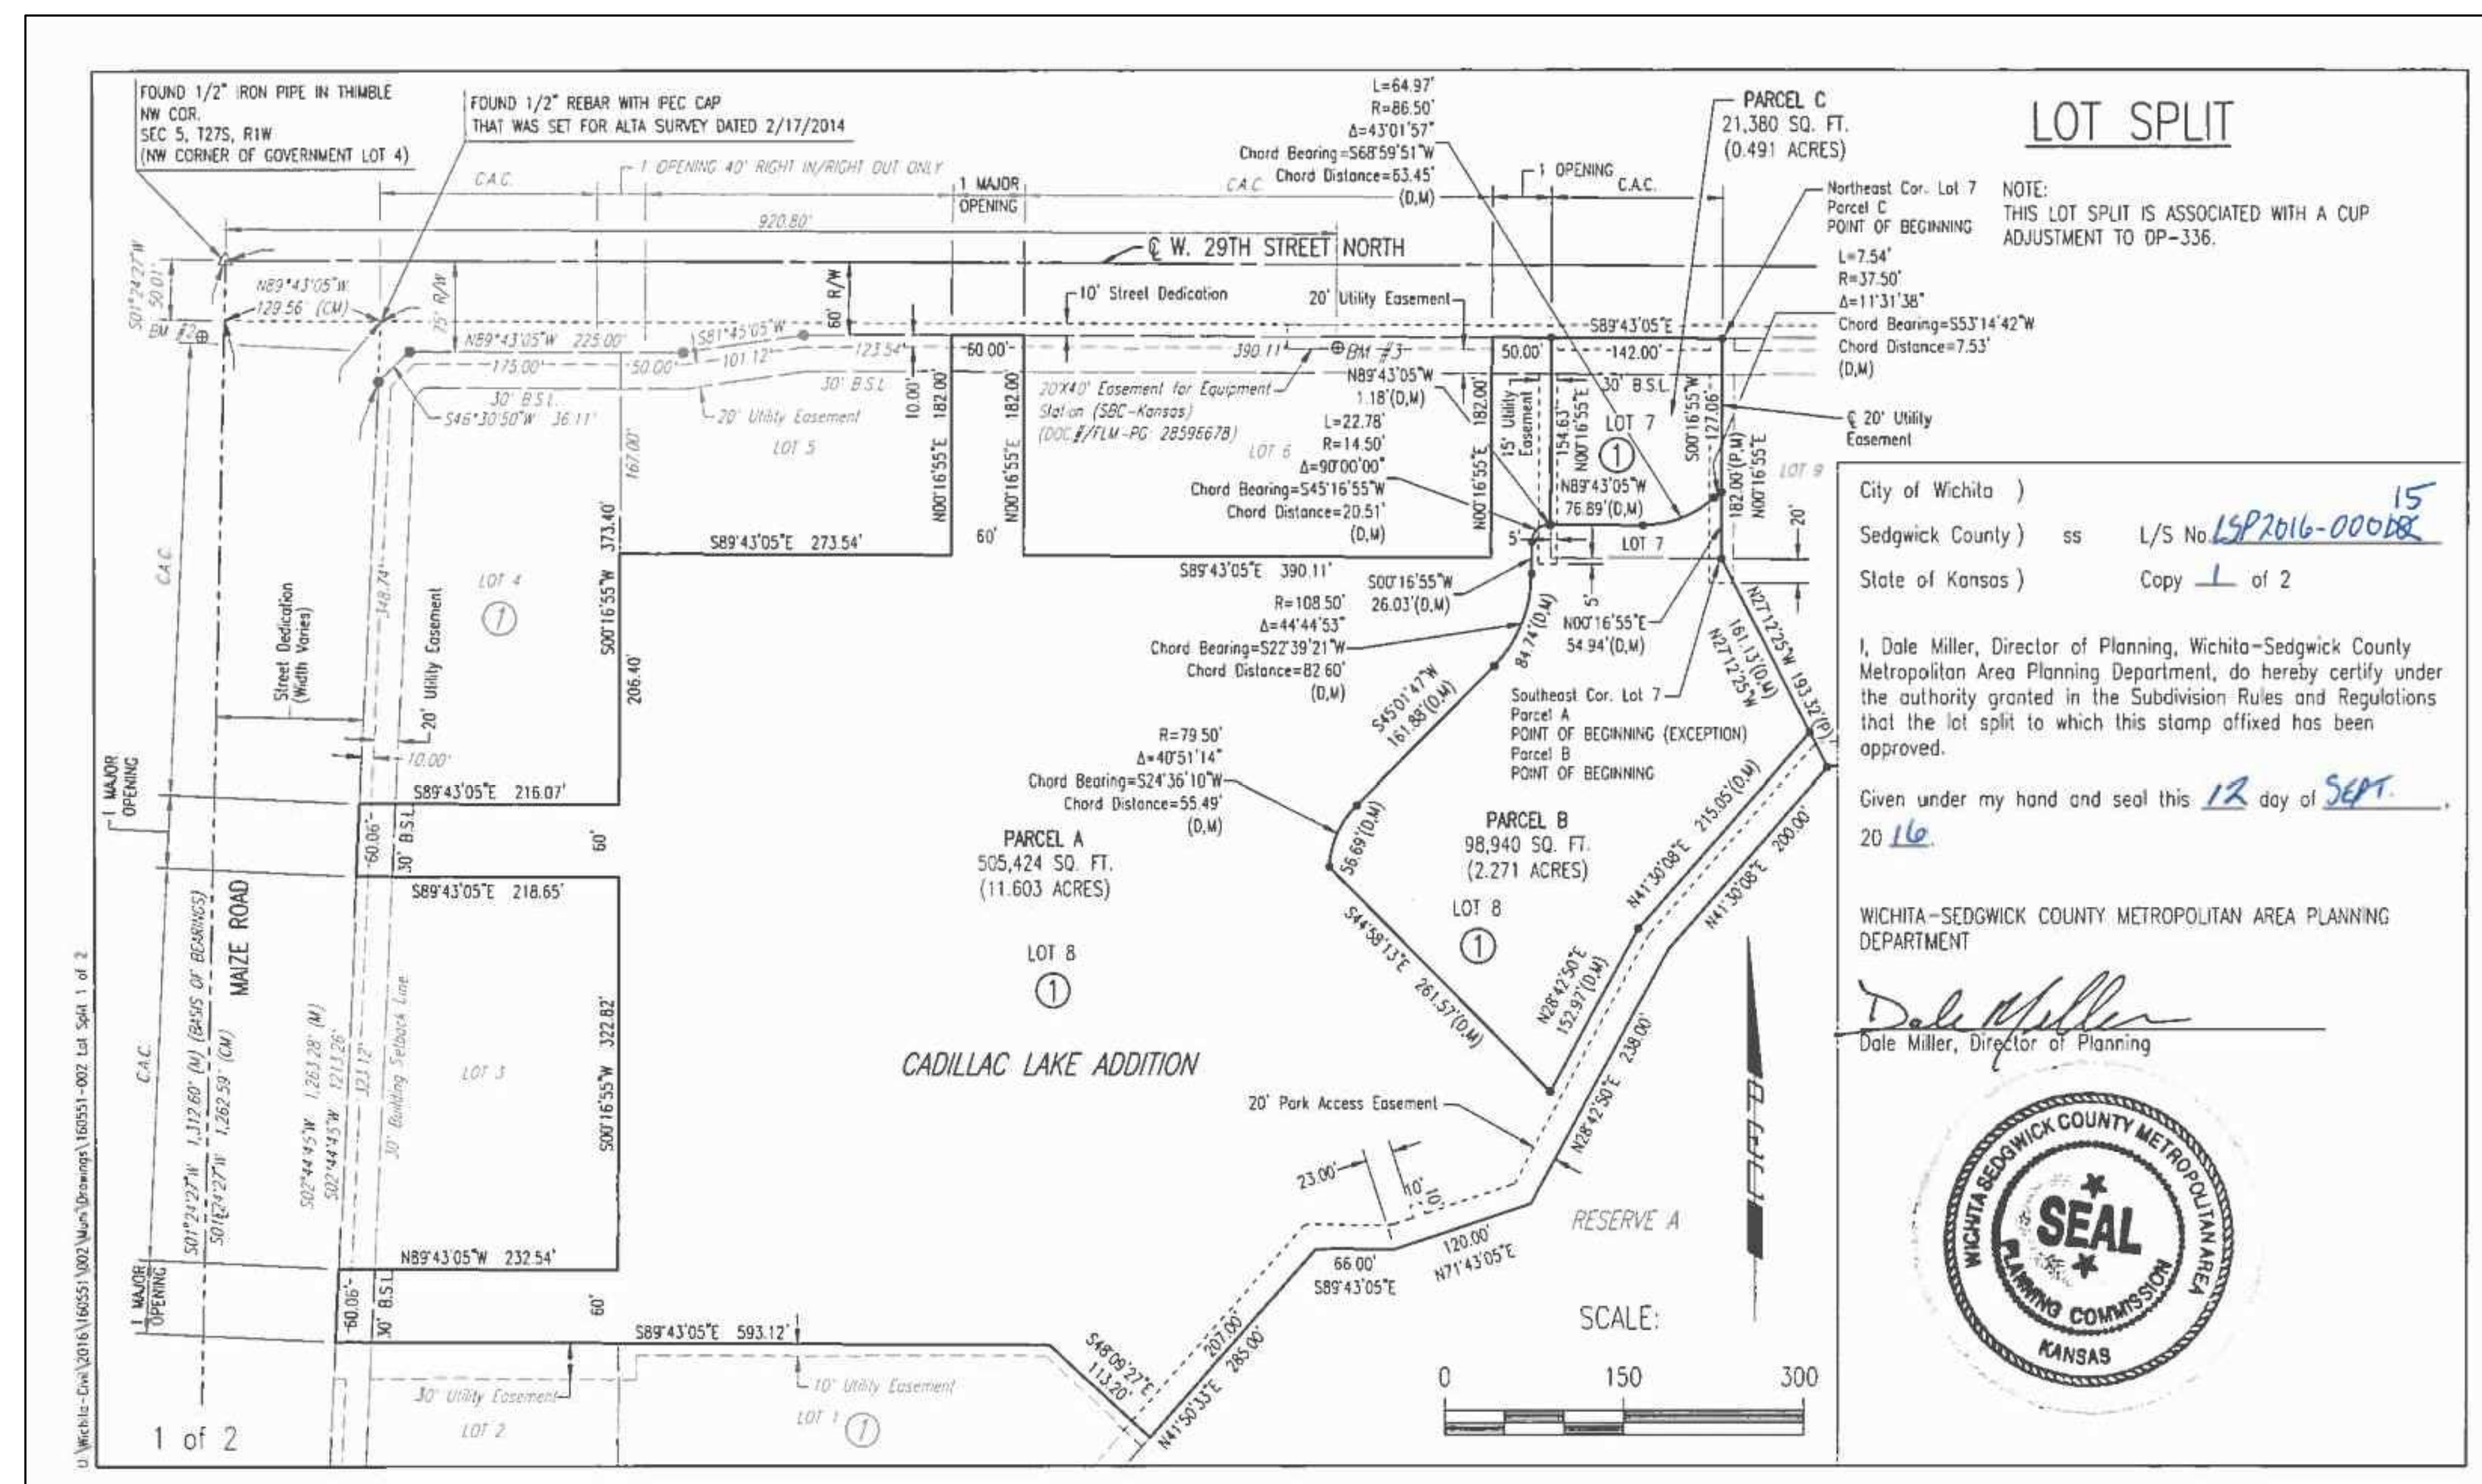

**LEGAL DESCRIPTION**  
For Parcel 'A'  
Lot 8, Block 1, Cadillac Lake, an addition to Wichita, Sedgewick County, Kansas,  
EXCEPT a Tract described as follows:  
BEGINNING at the southeast corner of Lot 7, Block 1, Cadillac Lake, an addition to Wichita, Sedgewick County, Kansas; thence bearing North 00°16'55" East, along the east line of said Lot 7, a distance of 54.94 feet to a non-tangent curve to the left; thence along said curve to the left, having a radius of 37.50 feet, a chord bearing of South 53°14'42" West and a chord distance of 7.53 feet, through a central angle of 11°31'38" for an arc distance of 7.54 feet to a point of Reverse curvature; thence in a westerly direction along a tangent curve turning to the right, having a radius of 86.50 feet, a chord bearing of South 68°59'51" West and a chord distance of 63.45 feet, through a central angle of 43°01'57" for an arc distance of 64.97 feet; thence bearing North 89°43'05" West, a distance of 76.89 feet to a point on the west line of said Lot 7, said point being 27.37 feet north of the southwest corner of said Lot 7, said point also being on the boundary of Lot 8, Block 1, of said Cadillac Lake; thence continuing bearing North 89°43'05" West, a distance of 1.18 feet to a tangent curve to the left; thence along said curve to the left, having a radius of 14.50 feet, a chord bearing of South 45°16'55" West and a chord distance of 20.51 feet, through a central angle of 90°00'00" for an arc distance of 22.78 feet; thence bearing South 00°16'55" West, a distance of 26.03 feet to a tangent curve to the right; thence along said curve to the right, having a radius of 108.50 feet, a chord bearing of South 22°39'21" West and a chord distance of 82.60 feet, through a central angle of 44°44'53" for an arc distance of 84.74 feet; thence bearing South 45°01'47" West, a distance of 161.88 feet to a tangent curve to the left; thence along said curve to the left, having a radius of 79.50 feet, a chord bearing of South 24°36'10" West and a chord distance of 55.49 feet, through a central angle of 40°51'14" for an arc distance of 56.69 feet; thence bearing S44°58'13" East, a distance of 261.57 feet; thence bearing North 28°42'50" East, parallel with and 30.00 feet northwesterly (measured perpendicularly) from the southeasterly boundary of said Lot 8, a distance of 152.97 feet; thence bearing North 41°30'08" East, parallel with and 30.00 feet northwesterly (measured perpendicularly) from the southeasterly boundary of said Lot 8, a distance of 215.05 feet to the northeasterly boundary of said Lot 8; thence bearing North 27°12'25" West, along the northeasterly boundary of said Lot 8, a distance of 161.13 feet to the POINT OF BEGINNING. (said Parcel 'A' containing 11.603 acres, more or less)



**LEGAL DESCRIPTION**  
For Parcel 'B'  
A Tract of land in Lot 7 and Lot 8, Block 1, Cadillac Lake, an addition to Wichita, Sedgewick County, Kansas,  
described as follows:  
BEGINNING at the southeast corner of Lot 7, Block 1, Cadillac Lake, an addition to Wichita, Sedgewick County, Kansas; thence bearing North 00°16'55" East, along the east line of said Lot 7, a distance of 54.94 feet to a non-tangent curve to the left; thence along said curve to the left, having a radius of 37.50 feet, a chord bearing of South 53°14'42" West and a chord distance of 7.53 feet, through a central angle of 11°31'38" for an arc distance of 7.54 feet to a point of Reverse curvature; thence in a westerly direction along a tangent curve turning to the right, having a radius of 86.50 feet, a chord bearing of South 68°59'51" West and a chord distance of 63.45 feet, through a central angle of 43°01'57" for an arc distance of 64.97 feet; thence bearing North 89°43'05" West, a distance of 76.89 feet to a point on the west line of said Lot 7, said point being 27.37 feet north of the southwest corner of said Lot 7, said point also being on the boundary of Lot 8, Block 1, of said Cadillac Lake; thence continuing bearing North 89°43'05" West, a distance of 1.18 feet to a tangent curve to the left; thence along said curve to the left, having a radius of 14.50 feet, a chord bearing of South 45°16'55" West and a chord distance of 20.51 feet, through a central angle of 90°00'00" for an arc distance of 22.78 feet; thence bearing South 00°16'55" West, a distance of 26.03 feet to a tangent curve to the right; thence along said curve to the right, having a radius of 108.50 feet, a chord bearing of South 22°39'21" West and a chord distance of 82.60 feet, through a central angle of 44°44'53" for an arc distance of 84.74 feet; thence bearing South 45°01'47" West, a distance of 161.88 feet to a tangent curve to the left; thence along said curve to the left, having a radius of 79.50 feet, a chord bearing of South 24°36'10" West and a chord distance of 55.49 feet, through a central angle of 40°51'14" for an arc distance of 56.69 feet; thence bearing S44°58'13" East, a distance of 261.57 feet; thence bearing North 28°42'50" East, parallel with and 30.00 feet northwesterly (measured perpendicularly) from the southeasterly boundary of said Lot 8, a distance of 152.97 feet; thence bearing North 41°30'08" East, parallel with and 30.00 feet northwesterly (measured perpendicularly) from the southeasterly boundary of said Lot 8, a distance of 215.05 feet to the northeasterly boundary of said Lot 8; thence bearing North 27°12'25" West, along the northeasterly boundary of said Lot 8, a distance of 161.13 feet to the POINT OF BEGINNING. (said Parcel 'B' containing 2.271 acres, more or less)

**LEGAL DESCRIPTION**  
For Parcel 'C'  
A Tract of land in Lot 7, Block 1, Cadillac Lake, an addition to Wichita, Sedgewick County, Kansas,  
described as follows:  
BEGINNING at the northeast corner of Lot 7, Block 1, Cadillac Lake, an addition to Wichita, Sedgewick County, Kansas; thence bearing South 00°16'55" West, along the east line of said Lot 7, a distance of 127.06 feet to a non-tangent curve to the left; thence along said curve to the left, having a radius of 37.50 feet, a chord bearing of South 53°14'42" West and a chord distance of 7.53 feet, through a central angle of 11°31'38" for an arc distance of 7.54 feet to a point of Reverse curvature; thence in a westerly direction along a tangent curve turning to the right, having a radius of 86.50 feet, a chord bearing of South 68°59'51" West and a chord distance of 63.45 feet, through a central angle of 43°01'57" for an arc distance of 64.97 feet; thence bearing North 89°43'05" West, a distance of 76.89 feet to a point on the west line of said Lot 7, said point being 27.37 feet north of the southwest corner of said Lot 7; thence bearing North 00°16'55" East, along said west line, a distance of 154.63 feet to the northwest corner of said Lot 7; thence bearing South 89°43'05" East, along the north line of said Lot 7, a distance of 142.00 feet to the POINT OF BEGINNING. (said Parcel 'C' containing 0.491 acres, more or less)

Sheet 11-16-2016 7:56:53 AM by CSI  
Plot Scale 1:1 11-30-2016 8:25:34 AM by CSI  
U:\Wichita-Cad\2016\160551\002\Map\Drawings\160551-002-C2-02-COPY OF LOT SPLIT

U:\Wichita-Cad\2016\160551\002\Map\Drawings\160551-002-Lot Split 2 of 2

PRINTS ISSUED		
DATE	PURPOSE	NO.
08.25.16	30% PROGRESS SET	
09.15.16	60% PROGRESS SET	
10.13.16	90% PROGRESS SET	
11.10.16	BID/PERMIT SET	1
11.22.16	ADDENDUM #1	1
12.07.16	CITY COMMENTS	2

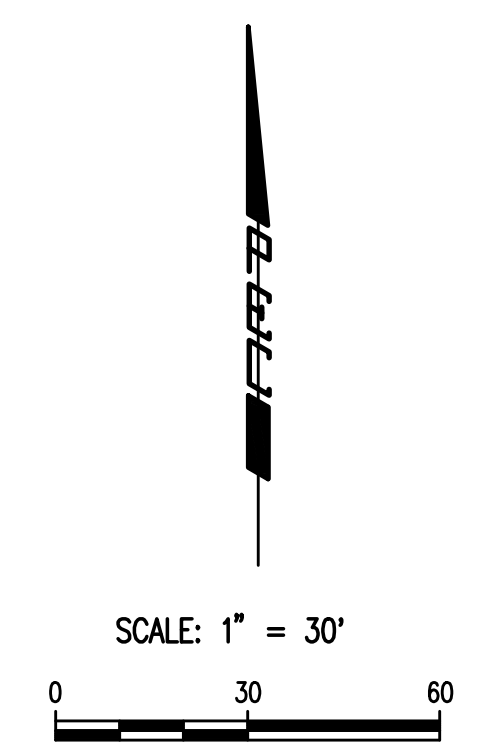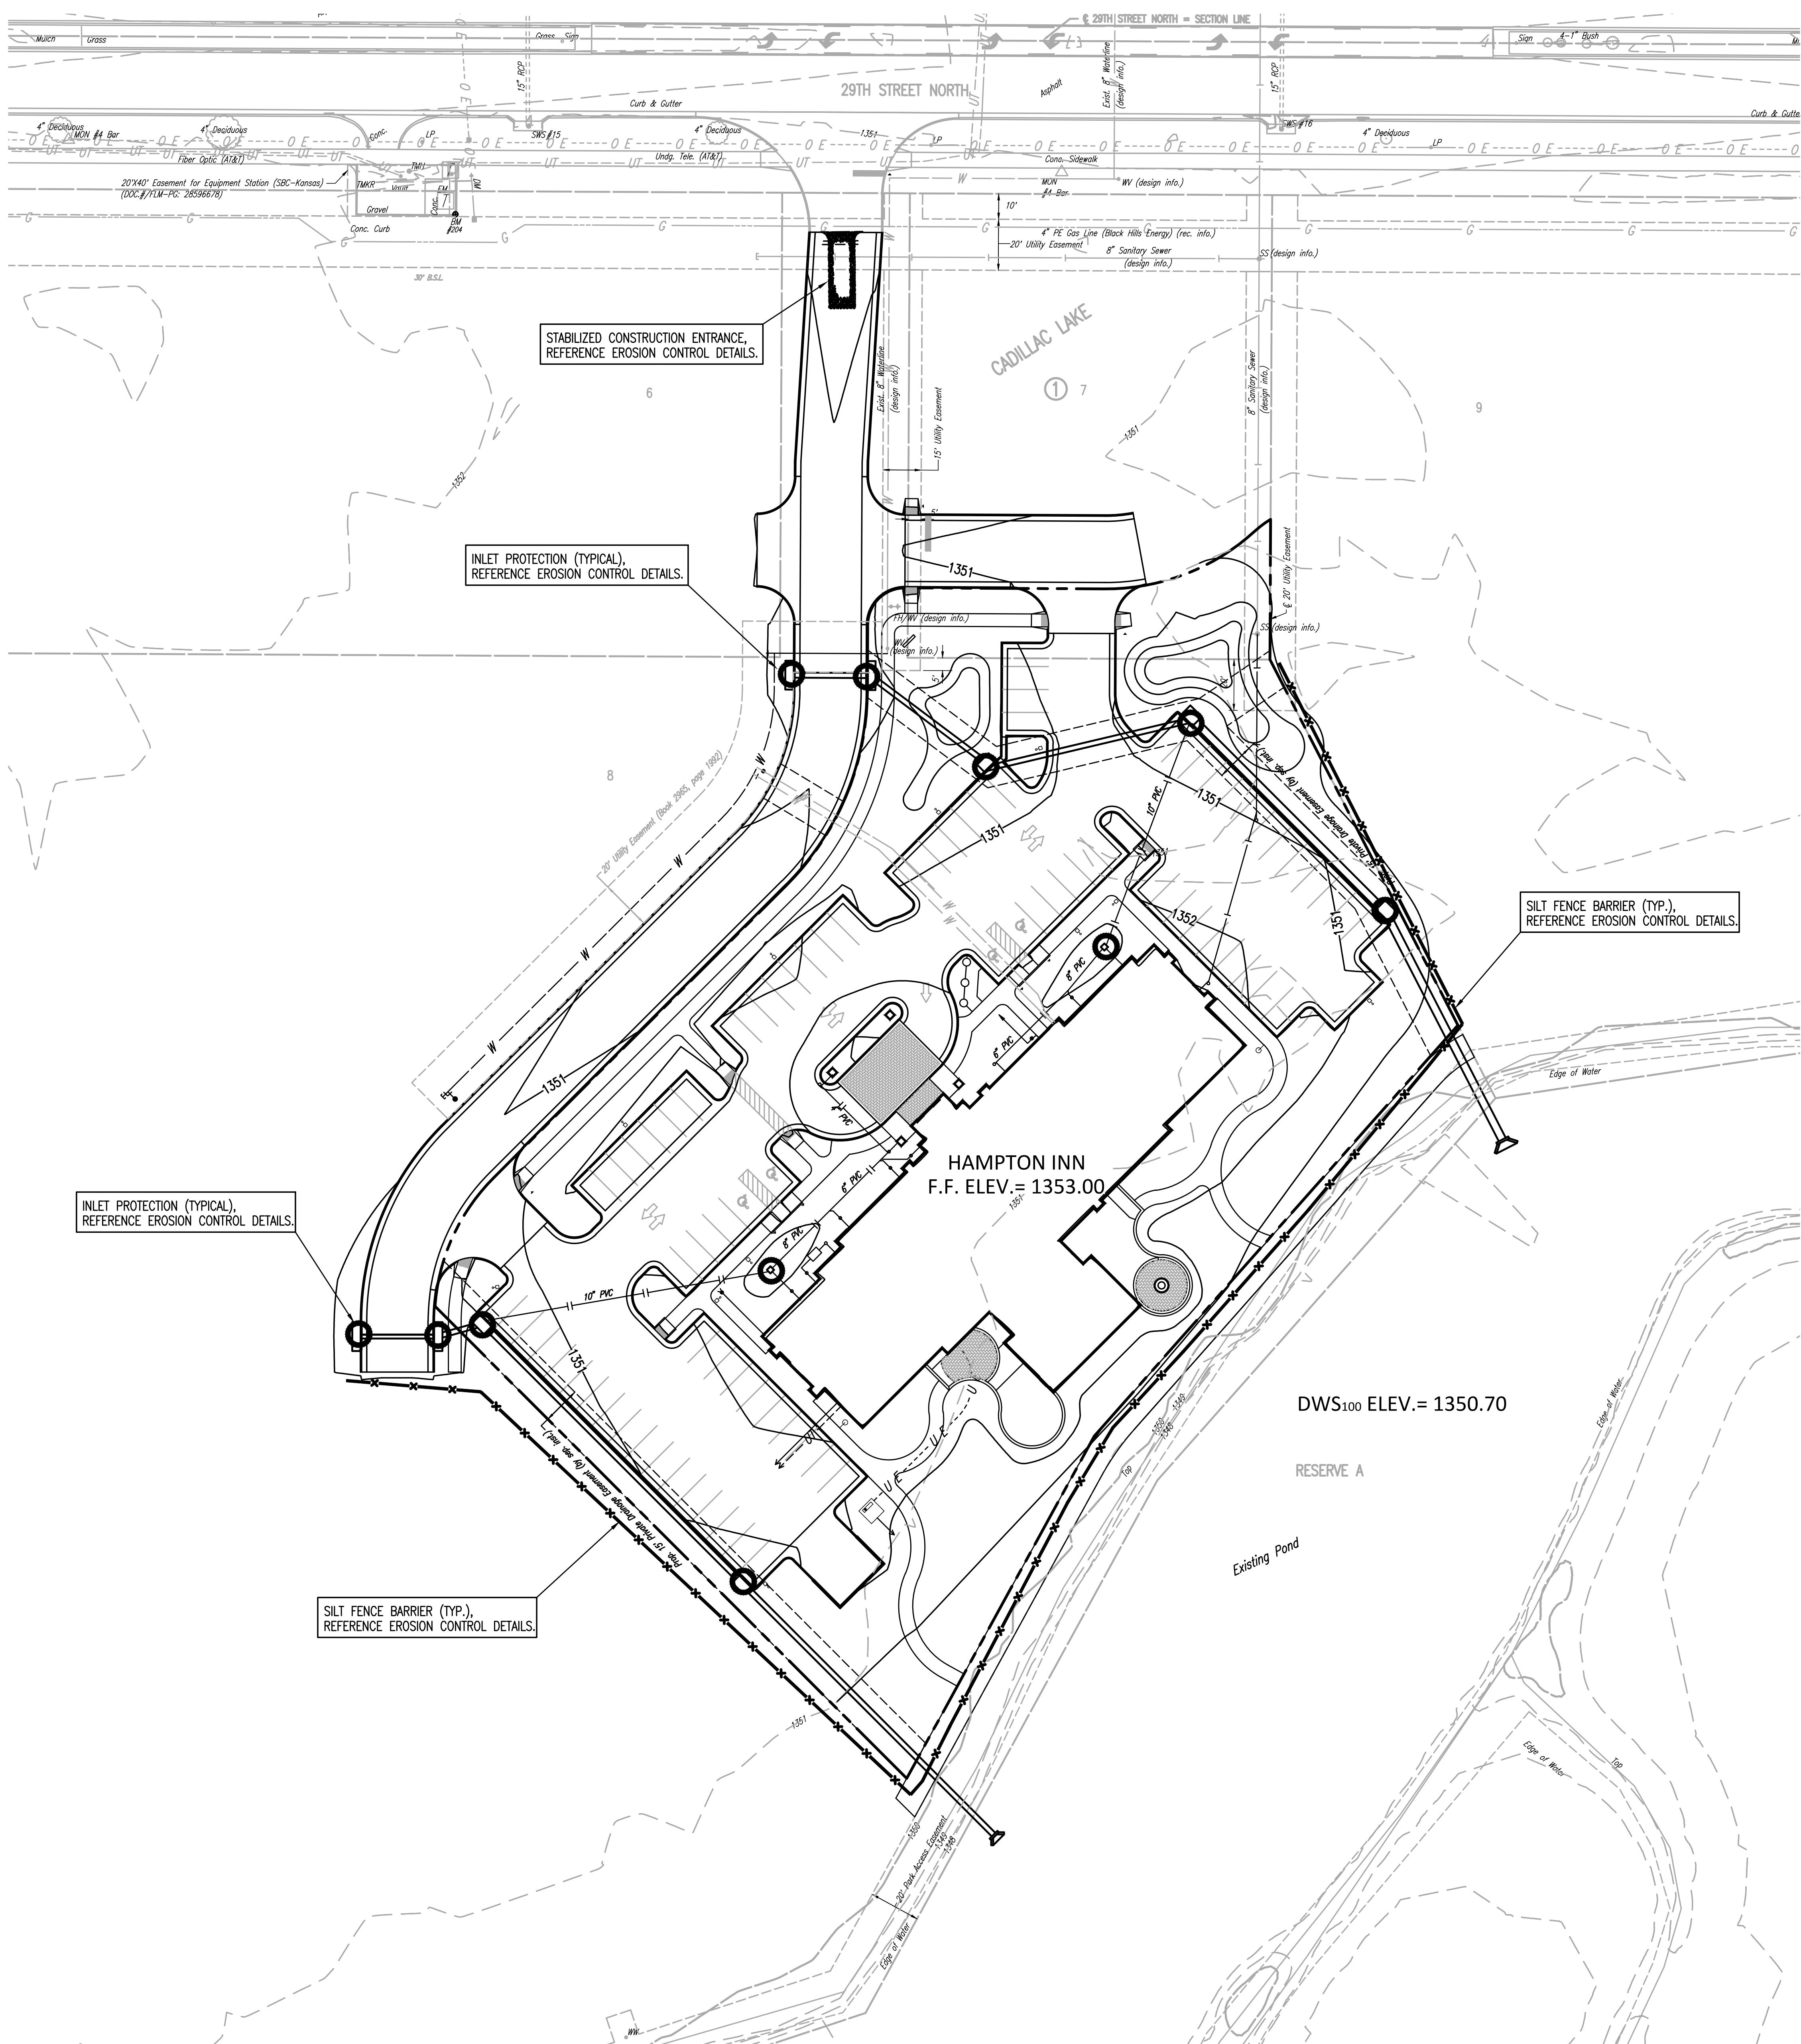

- LEGEND**
- PROPOSED INLET PROTECTION
  - STABILIZED CONSTRUCTION ENTRANCE (FINAL LOCATION DETERMINED BY CONTRACTOR)
  - SILT FENCE BARRIERS

**INSPECTION AND MAINTENANCE:**  
 SILT FENCE DITCH CHECKS SHOULD BE INSPECTED EVERY 7 DAYS AND WITHIN 24 HOURS OF A RAINFALL OF 1/2" OR MORE.

INLET PROTECTION (TYPICAL),  
 REFERENCE EROSION CONTROL DETAILS.

INLET PROTECTION (TYPICAL),  
 REFERENCE EROSION CONTROL DETAILS.

STABILIZED CONSTRUCTION ENTRANCE,  
 REFERENCE EROSION CONTROL DETAILS.

SILT FENCE BARRIER (TYP.),  
 REFERENCE EROSION CONTROL DETAILS.

SILT FENCE BARRIER (TYP.),  
 REFERENCE EROSION CONTROL DETAILS.

HAMPTON INN  
 F.F. ELEV. = 1353.00


DWS<sub>100</sub> ELEV. = 1350.70

RESERVE A

Existing Pond

Sheet 11 - 09 - 2016 2:51:28 PM by CSI  
 Plot Scale 1:1 = 30' 8/26/16 8:26:45 AM by CSI  
 U:\Wichita-Cad\2016\160551\000\Main\Drawings\160551-000-C5-01-EROSION CONTROL PLAN

PROFESSIONAL ENGINEERING CONSULTANTS, P.A.  
 300 SOUTH TOPEKA WICHITA, KS 67202  
 316-262-2991 www.pec1.com

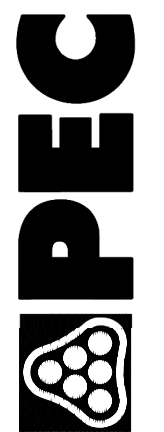

**LKArchitecture, Inc.**  
 345 Riverview Wichita, KS 67203  
 T 316.268.0230 F 316.268.0205  
 CONTACT: PEC  
 DRAWN: PEC  
 CHECKED: PEC  
 PROJECT NUMBER:  
**15433**  
 SHEET TITLE:  
 EROSION CONTROL PLAN  
 SHEET NUMBER:  
**C5.01** OF X

**HAMPTON INN**  
**CADILLAC LAKE**  
**WICHITA, KANSAS**



**LKArchitecture**  
 Architecture • Engineering • Planning • Interior Design • Landscape Architecture

DATE	PURPOSE	NO.
08.25.16	30% PROGRESS SET	
09.15.16	60% PROGRESS SET	
10.13.16	90% PROGRESS SET	
11.10.16	BID/PERMIT SET	
11.22.16	ADDENDUM #1	1
12.07.16	CITY COMMENTS	2



HAMPTON INN  
CADILLAC LAKE  
WICHITA, KANSAS




LKArchitecture  
Architecture • Engineering • Planning • Interior Design • Landscape Architecture




LKArchitecture, Inc.®  
345 Riverview Wichita, KS 67203  
T 316.268.0230 F 316.268.0205  
CONTACT: PEC  
DRAWN: PEC  
CHECKED: PEC  
PROJECT NUMBER:  
**15433**  
SHEET TITLE:  
EROSION CONTROL DETAILS  
SHEET NUMBER:  
**C5.02** OF: X

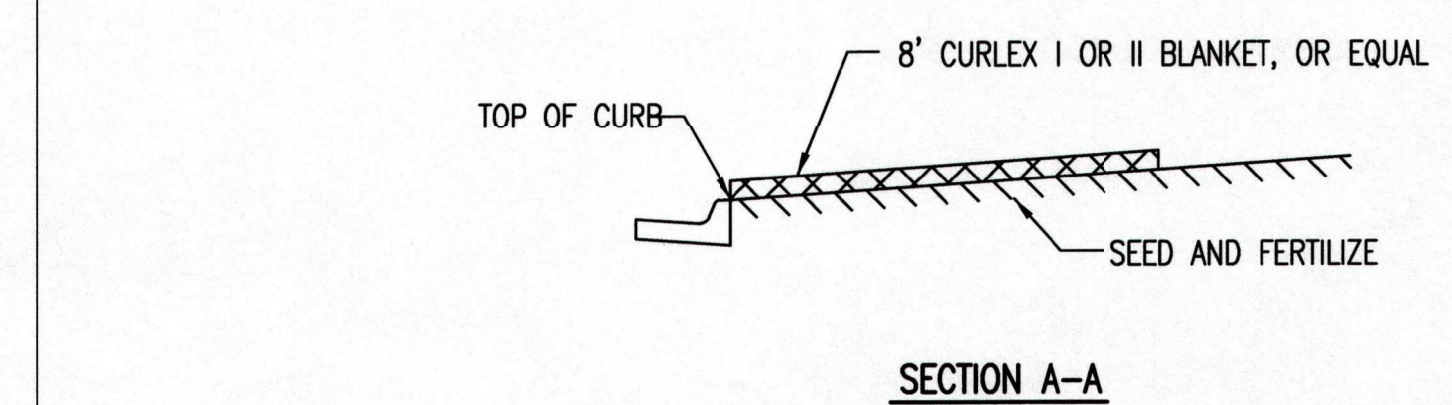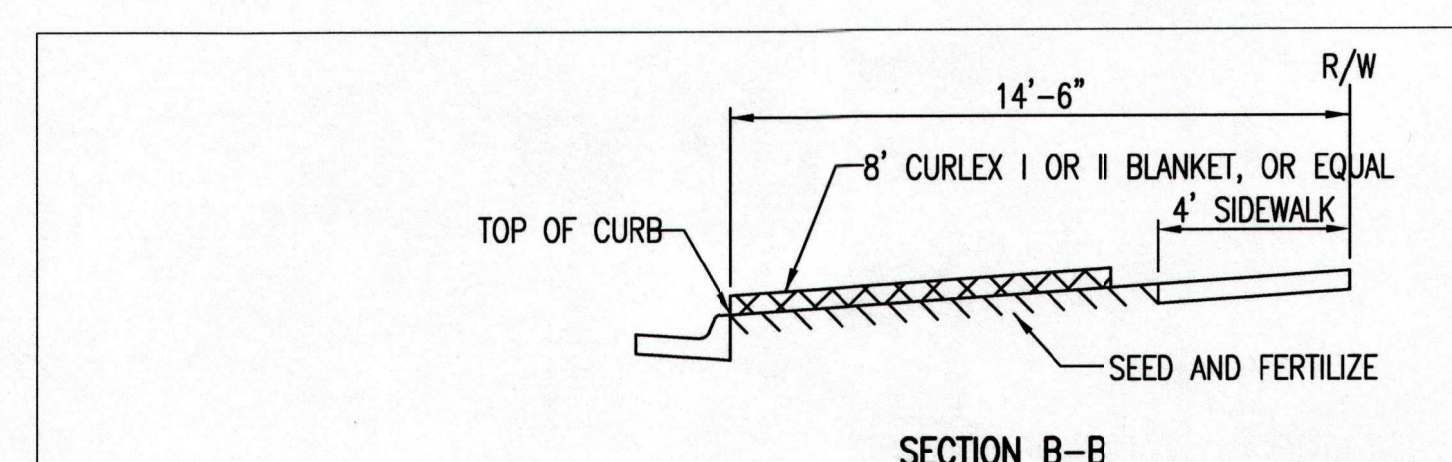

INSTALL 8' WIDE CURLEX I OR II EXCELSIOR BLANKET, OR EQUAL, ON PREPARED SURFACE BACK OF CURB. EDGE OF BLANKET WILL BE AT BACK OF CURB. INSTALL PER MANUFACTURER'S RECOMMENDATION, INCLUDING STAPLES. (SEE DETAIL)

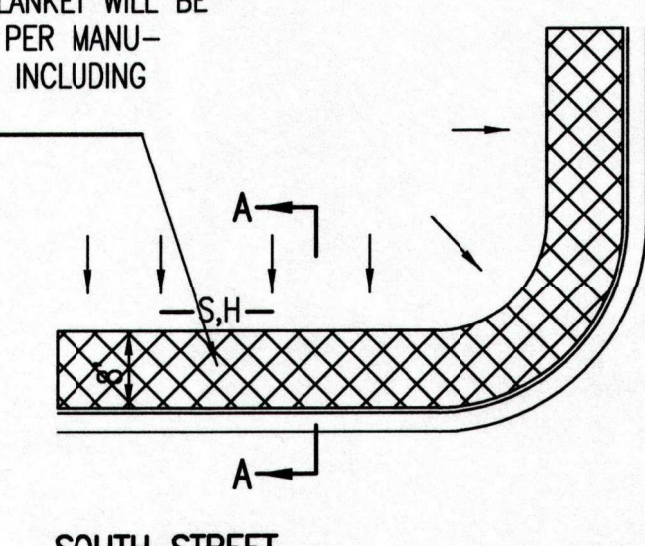


INSTALL 8' WIDE CURLEX I OR II EXCELSIOR BLANKET, OR EQUAL, ON PREPARED SURFACE BACK OF CURB. EDGE OF BLANKET WILL BE AT BACK OF CURB. INSTALL PER MANUFACTURER'S RECOMMENDATION, INCLUDING STAPLES. (SEE DETAIL)

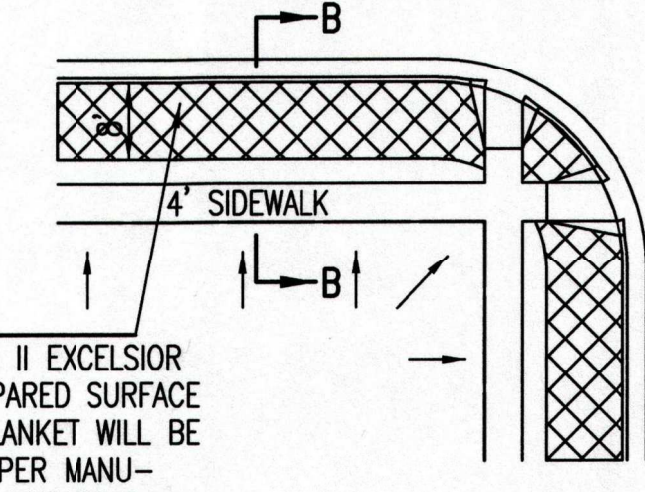


- GENERAL NOTES**
- EXCELSIOR MAT TO BE INSTALLED WHEN SOD IS NOT SPECIFIED ON PROJECT.
  - EXCELSIOR BLANKET TO BE INSTALLED OVER SEED AND FERTILIZER, AS SPECIFIED IN THE PROJECT SPECIFICATIONS.
  - AFTER INSTALLATION OF EXCELSIOR BLANKET, AT LOCATIONS WHERE CONCENTRATED FLOW CARRIES SEDIMENT OVER THE CURB AND INTO THE GUTTER, SUPPLEMENTAL EROSION CONTROL DEVICES WILL BE INSTALLED BY THE CONTRACTOR AS NEEDED, TO FIX THE PROBLEM.

**BACK OF CURB PROTECTION DETAIL**

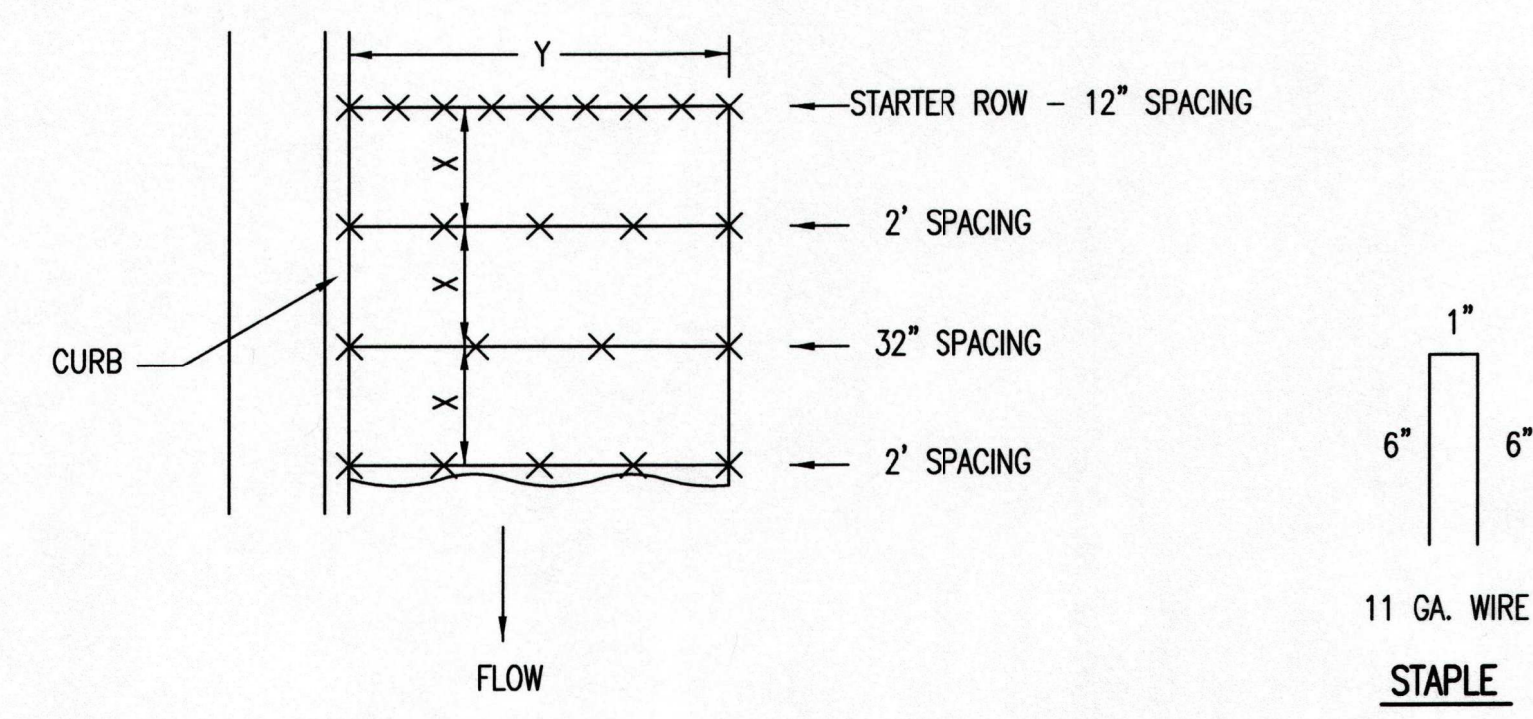


**DETAILS FOR APPROVED EROSION CONTROL MAT**

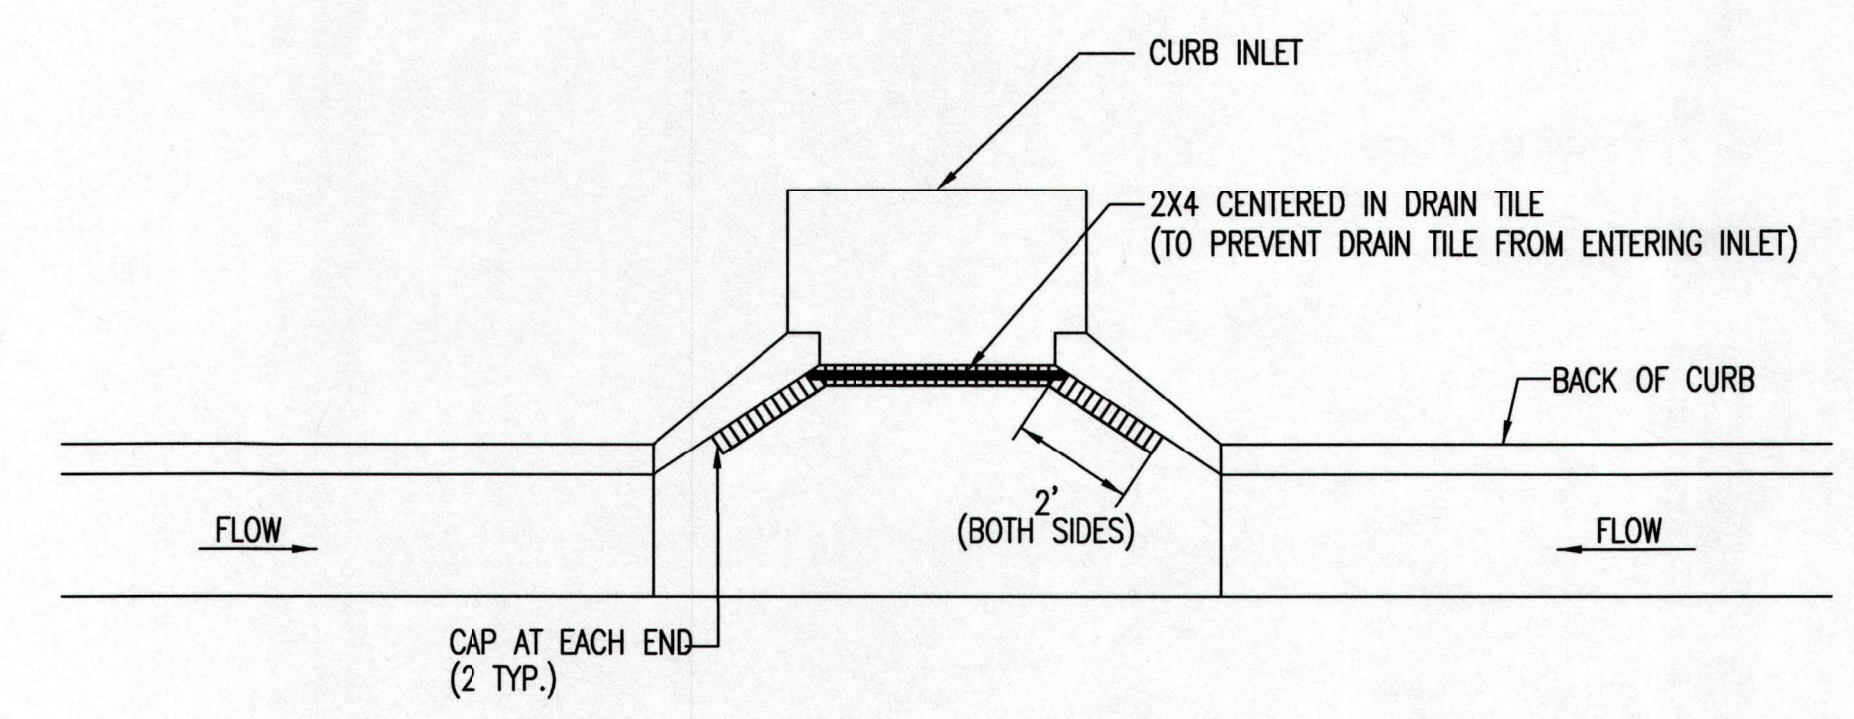


NOTE: PLACE 4" PERFORATED PVC PIPE, FILLED WITH 1/2"-1" DIA. GRAVEL, IN FRONT OF CURB INLET AS SHOWN.

2X4 LENGTH	INLET TYPE	INLET OPENING
5'-6"	1-A	5'-0"
10'-6"	1-A	10'-0"
15'-6"	1-A	15'-0"

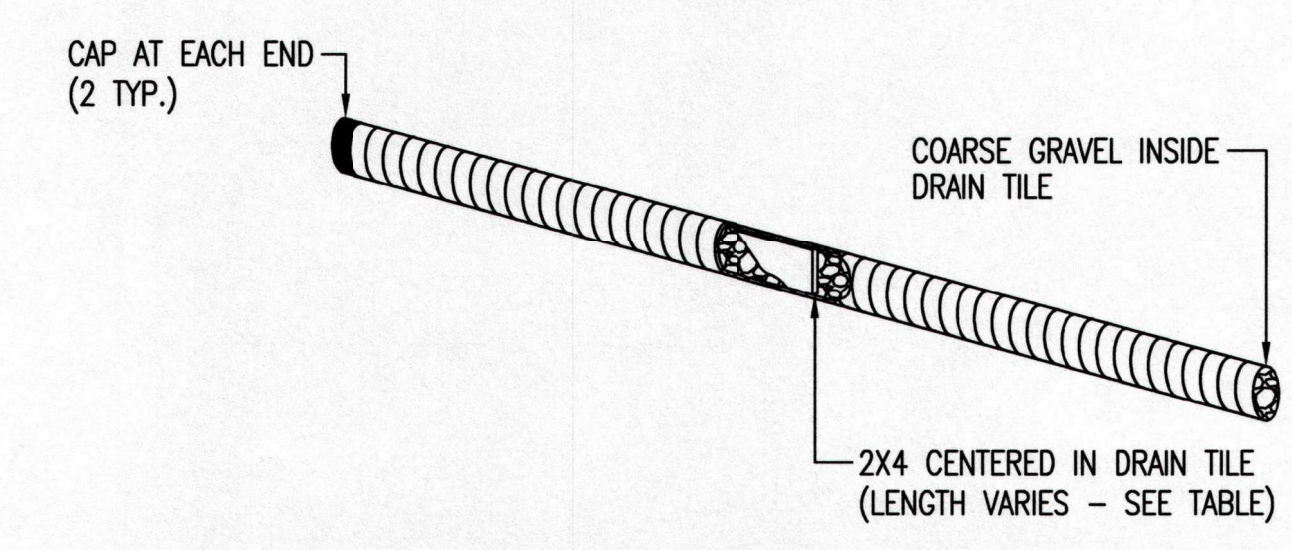


**CURB INLET PROTECTION**  
4" PERFORATED PIPE W/ GRAVEL

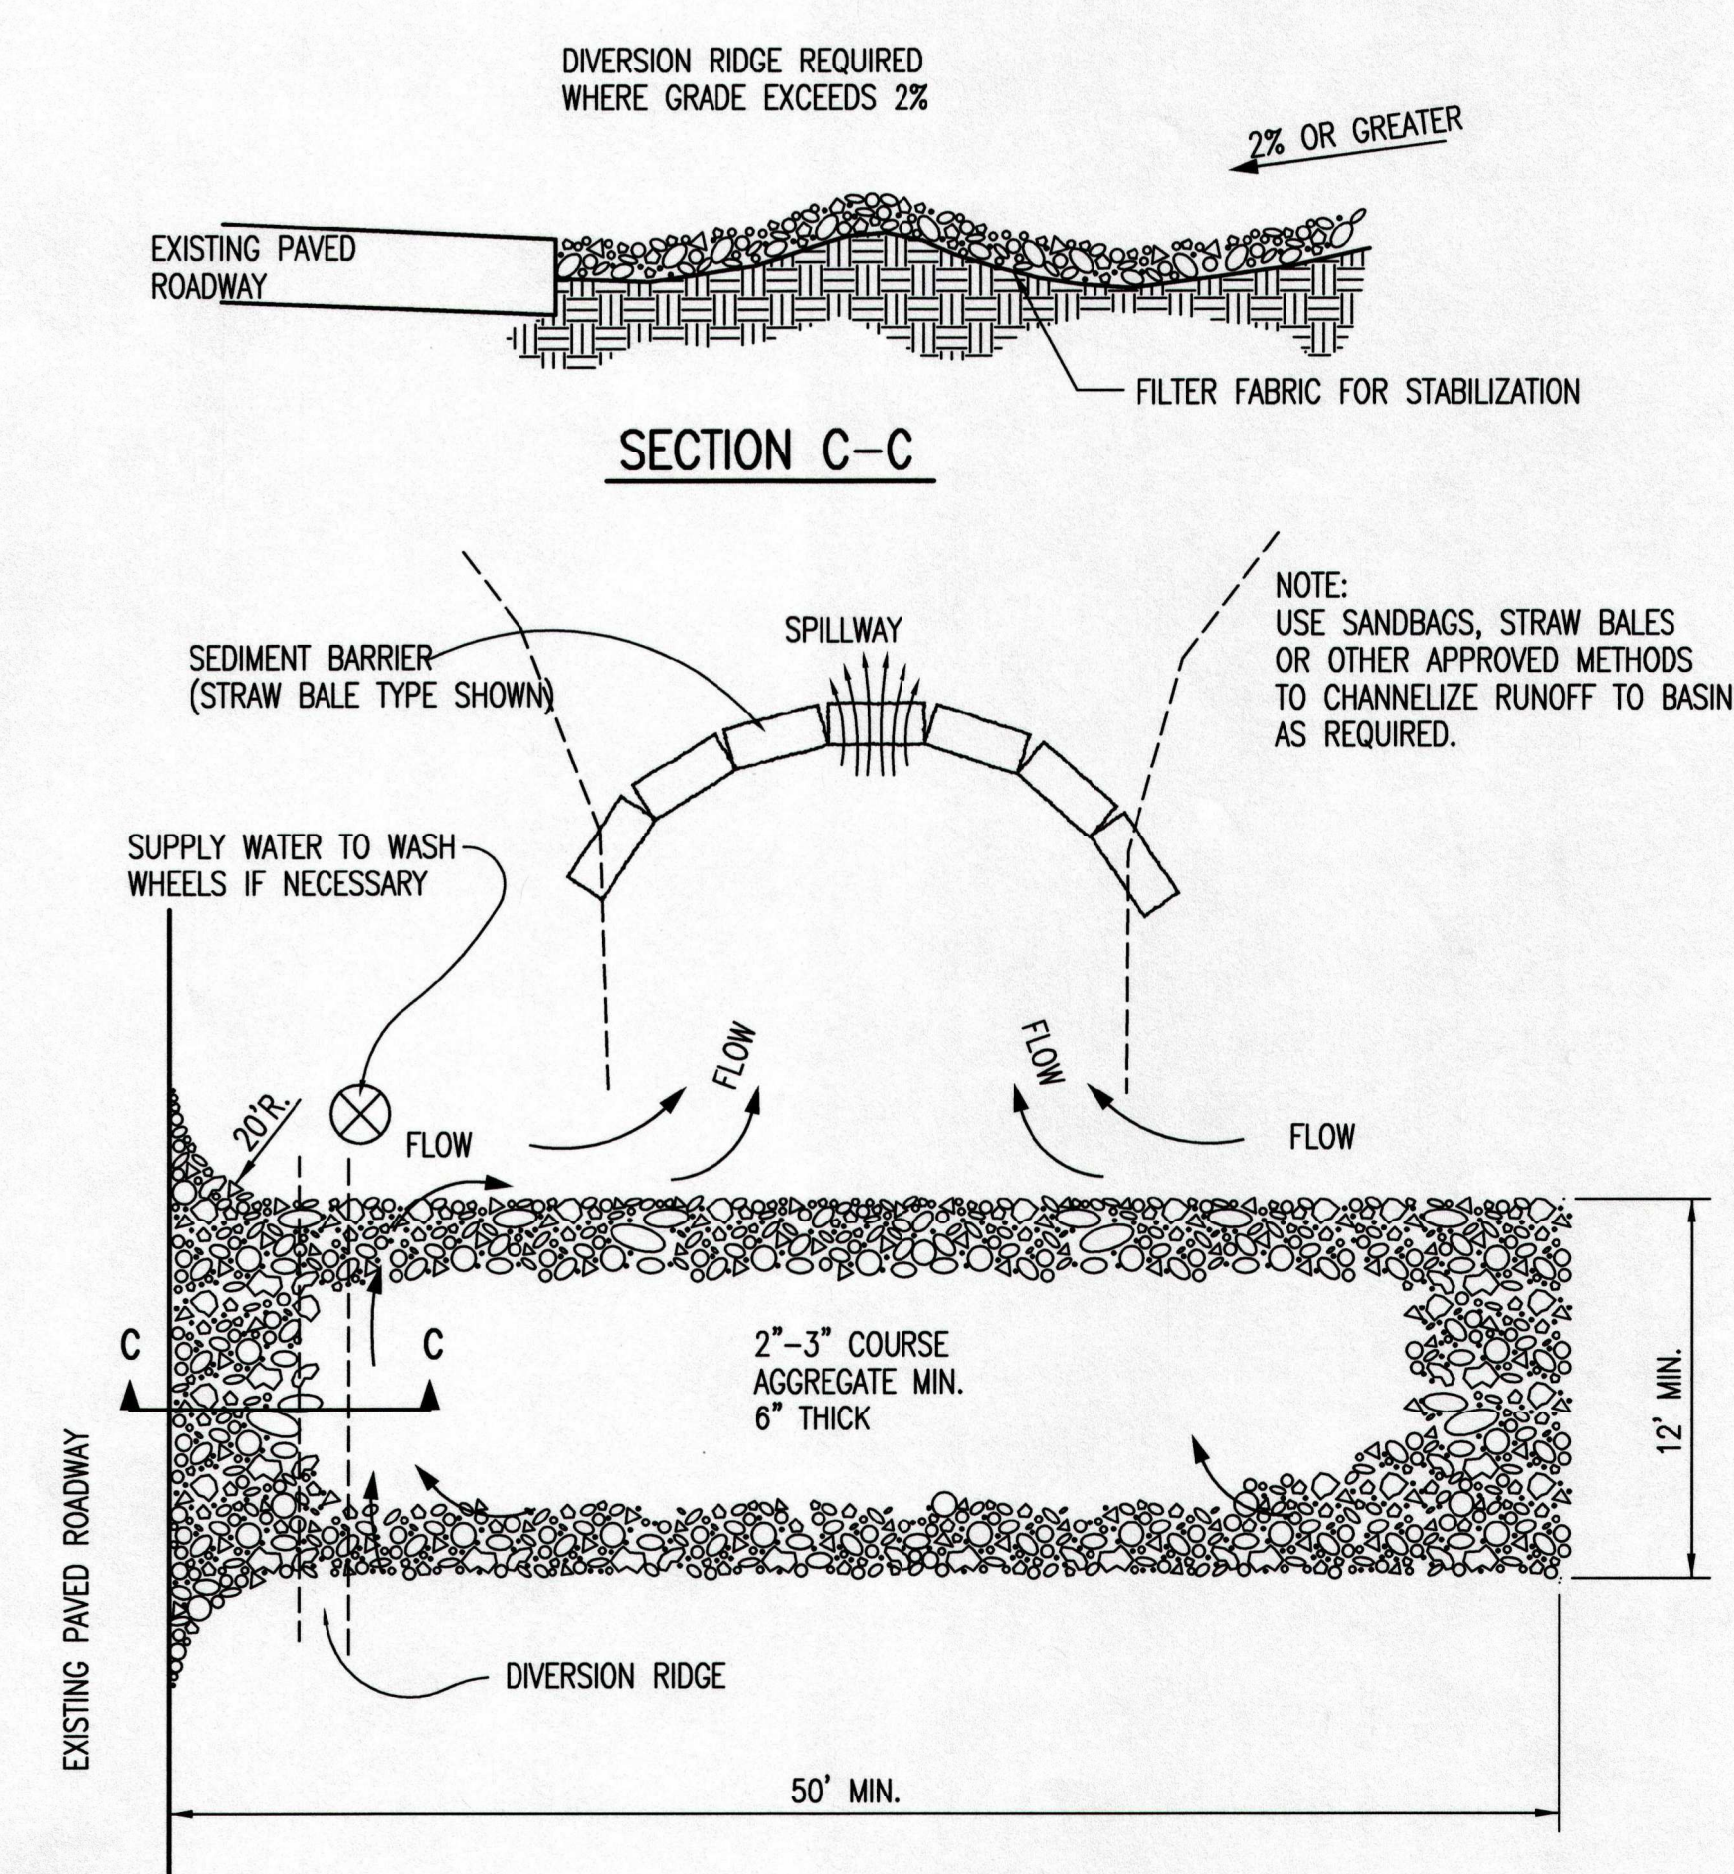

**STABILIZED CONSTRUCTION ENTRANCE**

- GENERAL NOTES**
- THE ENTRANCE SHALL BE MAINTAINED IN A CONDITION THAT WILL PREVENT TRACKING OR FLOWING OF SEDIMENT ONTO PUBLIC RIGHTS-OF-WAY. THIS MAY REQUIRE TOP DRESSING, REPAIR AND/OR CLEANOUT OF ANY MEASURES USED TO TRAP SEDIMENT.
  - WHEN NECESSARY, WHEELS SHALL BE CLEANED PRIOR TO ENTRANCE ONTO PUBLIC RIGHT-OF-WAY.
  - WHEN WASHING IS REQUIRED, IT SHALL BE DONE ON AN AREA STABILIZED WITH CRUSHED STONE THAT DRAINS INTO AN APPROVED SEDIMENT TRAP OR SEDIMENT BASIN, AS SHOWN ABOVE.
  - DRIVE ENTRANCES ONTO RESIDENTIAL LOTS WILL NOT BE REQUIRED TO HAVE THE SEDIMENT BARRIER SHOWN, BUT WHEEL WASHING MAY BE REQUIRED IF STABILIZED ENTRANCE IS NOT SUFFICIENT TO KEEP MUD FROM BEING TRACKED ONTO ADJACENT STREET. ENTRANCE SHALL EXTEND FROM BACK OF CURB TO DWELLING.

REVISION DATE: MAY 2013

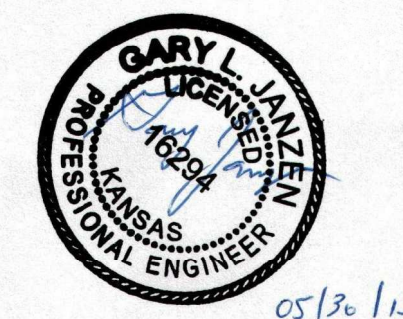

**CITY OF WICHITA**  
PUBLIC WORKS & UTILITIES  
ENGINEERING DIVISION

**BACK OF CURB PROTECTION, CURB INLET PROTECTION AND CONSTRUCTION ENTRANCE**

CITY ENGINEER  
**GARY JANZEN, P.E.**

PROJECT NUMBER	OCA NUMBER	DATE
2028 PPW	(607853)	

CITY ENGINEER'S OFFICE  
CITY HALL - SEVENTH FLOOR  
455 NORTH MAIN STREET  
WICHITA, KANSAS 67202-1620  
(316) 268-4501

Sheet: 08-27-2016, 10:45 AM, 1/2" = 1'-0", 8/27/16, 8:27:59 AM by CSI  
U:\Wichita-Civil\2016\160551\000\Main\Drawings\160551-000-C5-02-EROSION CONTROL DETAILS




DATE	PURPOSE	NO.
08.25.16	30% PROGRESS SET	
09.15.16	60% PROGRESS SET	
10.13.16	90% PROGRESS SET	
11.10.16	BID/PERMIT SET	1
11.22.16	ADDENDUM #1	1
12.07.16	CITY COMMENTS	2

HAMPTON INN  
CADILLAC LAKE  
WICHITA, KANSAS



LKArchitecture

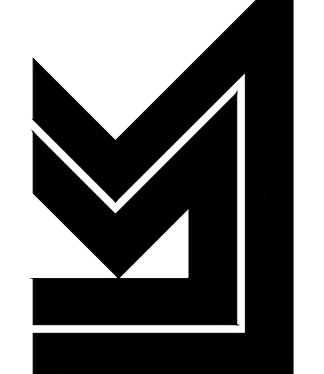

Architecture • Engineering • Planning • Interior Design • Landscape Architecture

LKArchitecture, Inc.®  
345 Riverview Wichita, KS 67203  
T 316.268.0230 F 316.268.0205  
CONTACT: PEC  
DRAWN: PEC  
CHECKED: PEC  
PROJECT NUMBER:  
**15433**  
SHEET TITLE:  
EROSION CONTROL DETAILS  
SHEET NUMBER:  
**C5.03** OF: X

**NOTE:** POINT A MUST BE HIGHER THAN POINT B SO THAT WATER FLOWS OVER THE SILT FENCE FABRIC AND NOT AROUND IT.

**ELEVATION  
SILT FENCE DITCH CHECKS  
(STREAM PROTECTION)**

**MATERIAL SPECIFICATION:**  
SILT FENCE FABRIC SHOULD CONFORM TO THE AASHTO M288 96 SILT FENCE SPECIFICATION. THE POSTS USED TO SUPPORT THE SILT FENCE FABRIC SHOULD BE A HARDWOOD MATERIAL WITH THE FOLLOWING MINIMUM DIMENSIONS: 2" SQUARE (NOMINAL) BY 4' LONG. SILT FENCE FABRIC SHOULD BE ATTACHED TO THE WOODEN POSTS WITH STAPLES, WIRE, ZIP TIES, OR NAILS.

**PLACEMENT:**  
PLACE SILT FENCE IN DITCHES WHERE IT IS UNLIKELY THAT IT WILL BE OVERTOPPED. WATER SHOULD FLOW THROUGH A SILT FENCE DITCH CHECK, NOT OVER IT. SILT FENCE DITCH CHECKS OFTEN FAIL WHEN OVERTOPPED. SILT FENCE DITCH CHECKS SHOULD BE PLACED PERPENDICULAR TO THE FLOWLINE OF THE DITCH. THE SILT FENCE SHOULD EXTEND FAR ENOUGH SO THAT THE GROUND LEVEL AT THE ENDS OF THE FENCE IS HIGHER THAN THE TOP OF THE LOW POINT OF THE FENCE. THIS PREVENTS WATER FROM FLOWING AROUND THE CHECK. SILT FENCE DITCH CHECKS SHOULD NOT BE PLACED IN DITCHES WHERE HIGH FLOWS ARE EXPECTED. ROCK CHECKS SHOULD BE USED INSTEAD. SILT FENCE SHOULD BE PLACED IN DITCHES WITH SLOPES OF 6% OR LESS. FOR SLOPES STEEPER THAN 6%, ROCK CHECKS SHOULD BE USED.

THE FOLLOWING TABLE PROVIDES CHECK SPACING FOR A GIVEN DITCH GRADE:

DITCH CHECK DITCH GRADE (%)	SPACING CHECK SPACING (FEET)
0.5	200
1.0	200
2.0	100
3.0	65
4.0	50
5.0	40
6.0	30

**PROPER INSTALLATION METHOD:**  
EXCAVATE A TRENCH PERPENDICULAR TO THE DITCH FLOWLINE THAT IS AT LEAST 12" DEEP BY 6" WIDE. EXTEND THE TRENCH IN A STRAIGHT LINE ALONG THE ENTIRE LENGTH OF THE PROPOSED DITCH CHECK. PLACE THE SOIL ON THE UPSTREAM SIDE OF THE TRENCH FOR LATER USE. ROLL OUT A CONTINUOUS LENGTH OF SILT FENCE FABRIC ON THE DOWNSLOPE SIDE OF THE TRENCH. PLACE THE EDGE OF THE FABRIC IN THE TRENCH STARTING AT THE TOP UPSTREAM EDGE OF THE TRENCH. LINE TWO SIDES OF THE TRENCH WITH THE FABRIC AS SHOWN ON DETAIL. BACKFILL OVER THE FABRIC IN THE TRENCH WITH THE EXCAVATED SOIL AND COMPACT. AFTER FILLING THE TRENCH, APPROXIMATELY 24" TO 36" OF SILT FENCE FABRIC SHOULD REMAIN EXPOSED. LAY THE EXPOSED SILT FENCE ON THE UPSTREAM SIDE OF THE TRENCH TO CLEAR AN AREA FOR DRIVING IN THE POSTS. JUST DOWNSLOPE OF THE TRENCH, DRIVE POSTS INTO THE GROUND TO A DEPTH OF AT LEAST 24". PLACE POSTS NO MORE THAN 4' APART. ATTACH THE SILT FENCE TO THE ANCHORED POST WITH STAPLES, WIRE, ZIP TIES, OR NAILS.

**LIST OF COMMON PLACEMENT/INSTALLATION MISTAKES TO AVOID:**  
WATER SHOULD FLOW THROUGH A SILT FENCE DITCH CHECK—NOT OVER IT. PLACE SILT FENCE IN DITCHES WHERE IT IS UNLIKELY THAT IT WILL BE OVERTOPPED. SILT FENCE INSTALLATIONS QUICKLY DETERIORATE WHEN WATER OVERTOPS THEM. DO NOT PLACE SILT FENCE POSTS ON THE UPSTREAM SIDE OF THE SILT FENCE FABRIC. IN THIS CONFIGURATION, THE FORCE OF THE WATER IS NOT RESTRICTED BY THE POSTS, BUT ONLY BY THE STAPLES (WIRE, ZIP TIES, NAILS, ETC.). THE SILT FENCE WILL RIP AND FAIL. DO NOT PLACE A SILT FENCE DITCH CHECK DIRECTLY IN FRONT OF A CULVERT OUTLET. IT WILL NOT STAND UP TO THE CONCENTRATED FLOW. DO NOT PLACE SILT FENCE DITCH CHECKS IN DITCHES THAT WILL LIKELY EXPERIENCE HIGH FLOWS. THEY WILL NOT STAND UP TO CONCENTRATED FLOW. FOLLOW PRESCRIBED DITCH CHECK SPACING GUIDELINES. IF SPACING GUIDELINES ARE EXCEEDED, EROSION WILL OCCUR BETWEEN THE DITCH CHECKS. DO NOT ALLOW WATER TO FLOW AROUND THE DITCH CHECK. MAKE SURE THAT THE DITCH CHECK IS LONG ENOUGH SO THAT THE GROUND LEVEL AT THE ENDS OF THE FENCE IS HIGHER THAN THE LOW POINT ON THE TOP OF THE FENCE. DO NOT PLACE SILT FENCE DITCH CHECKS IN CHANNELS WITH SHALLOW SOILS UNDERLAIN BY ROCK. IF THE CHECK IS NOT ANCHORED SUFFICIENTLY, IT WILL WASH OUT.

**INSPECTION AND MAINTENANCE:**  
SILT FENCE DITCH CHECKS SHOULD BE INSPECTED EVERY 7 DAYS AND WITHIN 24 HOURS OF A RAINFALL OF 1/2" OR MORE. THE FOLLOWING IS A LIST OF QUESTIONS THAT SHOULD BE ADDRESSED DURING EACH INSPECTION:  
DOES WATER FLOW AROUND THE DITCH CHECK?  
DOES WATER FLOW UNDER THE DITCH CHECK?  
DOES THE SILT FENCE SAG EXCESSIVELY?  
HAS THE SILT FENCE TORN OR BECOME DETACHED FROM THE POSTS?  
DOES SEDIMENT NEED TO BE REMOVED FROM BEHIND THE DITCH CHECK?

**ANCHOR TRENCH DETAIL**

**SILT FENCE BARRIERS FOR AREA INLETS  
(INLET PROTECTION)**

**MATERIAL SPECIFICATION:**  
SILT FENCE FABRIC SHOULD CONFORM TO THE AASHTO M288 96 SILT FENCE SPECIFICATION. THE WIRE OR POLYMERIC MESH BACKING USED TO HELP SUPPORT THE SILT FENCE FABRIC SHOULD CONFORM TO THE AASHTO M288 96 SILT FENCE SPECIFICATION. THE POSTS USED TO SUPPORT THE SILT FENCE FABRIC SHOULD BE A HARDWOOD MATERIAL WITH THE FOLLOWING MINIMUM DIMENSIONS: 2" SQUARE (NOMINAL) BY 4' LONG. THE MATERIAL USED TO FRAME THE TOPS OF THE POSTS SHOULD BE 1" BY 4" BOARDS. SILT FENCE FABRIC AND SUPPORT BACKING SHOULD BE ATTACHED TO THE WOODEN POSTS AND FRAME WITH STAPLES, WIRE, ZIP TIES, OR NAILS.

**PLACEMENT:**  
PLACE A SILT FENCE DROP INLET BARRIER IN A LOCATION WHERE IT IS UNLIKELY TO BE OVERTOPPED. WATER SHOULD FLOW THROUGH SILT FENCE, NOT OVER IT. SILT FENCE BARRIERS FOR AREA INLETS OFTEN FAIL WHEN REPEATEDLY OVERTOPPED. WHEN USED AS A BARRIER FOR AREA INLETS, SILT FENCE FABRIC AND POSTS MUST BE SUPPORTED AT THE TOP BY A WOODEN FRAME. WHEN A SILT FENCE BARRIER FOR AREA INLETS IS LOCATED NEAR AN INLET THAT HAS STEEP APPROACH SLOPES, THE STORAGE CAPACITY BEHIND THE BARRIER IS DRAMATICALLY REDUCED. TIMELY REMOVAL OF SEDIMENT MUST OCCUR FOR A BARRIER TO OPERATE PROPERLY IN THIS LOCATION.

**PROPER INSTALLATION METHOD:**  
EXCAVATE A TRENCH AROUND THE PERIMETER OF THE AREA INLET THAT IS AT LEAST 8" DEEP BY 8" WIDE. DRIVE POSTS TO A DEPTH OF AT LEAST 18" AROUND THE PERIMETER OF THE AREA INLET. THE DISTANCE BETWEEN POSTS SHOULD BE 4' OR LESS. IF THE DISTANCE BETWEEN TWO ADJACENT CORNER POSTS IS MORE THAN 4', ADD ANOTHER POST(S) BETWEEN THEM. CONNECT THE TOPS OF ALL THE POSTS WITH A WOODEN FRAME MADE OF 1" BY 4" BOARDS. USE NAILS OR SCREWS FOR FASTENING. ATTACH THE WIRE OR POLYMERIC-MESH BACKING TO THE OUTSIDE OF THE POST/FRAME STRUCTURE WITH STAPLES, WIRE, ZIP TIES, OR NAILS. ROLL OUT A CONTINUOUS LENGTH OF SILT FENCE FABRIC LONG ENOUGH TO WRAP AROUND THE PERIMETER OF THE AREA INLET. ADD MORE LENGTH FOR OVERLAPPING THE FABRIC JOINT. PLACE THE EDGE OF THE FABRIC IN THE TRENCH, STARTING AT THE OUTSIDE EDGE OF THE TRENCH. LINE ALL THREE SIDES OF THE TRENCH WITH THE FABRIC. BACKFILL OVER THE FABRIC IN THE TRENCH WITH THE EXCAVATED SOIL AND COMPACT. AFTER FILLING THE TRENCH, APPROXIMATELY 24" TO 36" OF SILT FENCE FABRIC SHOULD REMAIN EXPOSED. ATTACH THE SILT FENCE TO THE OUTSIDE OF THE POST/FRAME STRUCTURE WITH STAPLES, WIRE, ZIP TIES, OR NAILS. THE JOINT SHOULD BE OVERLAPPED TO THE NEXT POST.

**NOTE:** WHEN A SILT FENCE BARRIER FOR AREA INLET IS PLACED IN A SHALLOW MEDIAN DITCH, MAKE SURE THAT THE TOP OF THE BARRIER IS NOT HIGHER THAN THE PAVED ROAD. IN THIS CONFIGURATION, WATER MAY SPREAD ONTO THE ROADWAY CAUSING A HAZARDOUS CONDITION.

**LIST OF COMMON PLACEMENT/INSTALLATION MISTAKES TO AVOID:**  
WATER SHOULD FLOW THROUGH A SILT FENCE BARRIER FOR AREA INLET—NOT OVER IT. PLACE A SILT FENCE BARRIER FOR AREA INLET IN A LOCATION WHERE IT IS UNLIKELY TO BE OVERTOPPED. SILT FENCE BARRIER FOR AREA INLETS OFTEN FAIL WHEN REPEATEDLY OVERTOPPED. DO NOT PLACE POSTS ON THE OUTSIDE OF THE SILT FENCE BARRIER FOR AREA INLET. IN THIS CONFIGURATION, THE FORCE OF THE WATER IS NOT RESTRICTED BY THE POSTS, BUT ONLY BY THE STAPLES (WIRE, ZIP TIES, NAILS, ETC.). THE SILT FENCE WILL RIP AND FAIL. DO NOT INSTALL SILT FENCE BARRIER FOR AREA INLETS WITHOUT FRAMING THE TOP OF THE POSTS. THE CORNER POSTS AROUND AREA INLETS ARE STRESSED IN TWO DIRECTIONS WHEREAS A NORMAL SILT FENCE IS ONLY STRESSED IN ONE DIRECTION. THIS ADDED STRESS REQUIRES MORE SUPPORT.

**INSPECTION AND MAINTENANCE:**  
SILT FENCE BARRIER FOR AREA INLETS SHOULD BE INSPECTED EVERY 7 DAYS AND WITHIN 24 HOURS OF A RAINFALL OF 1/2" OR MORE. THE FOLLOWING IS A LIST OF QUESTIONS THAT SHOULD BE ADDRESSED DURING EACH INSPECTION:  
DOES WATER FLOW UNDER THE SILT FENCE?  
DOES THE SILT FENCE SAG EXCESSIVELY?  
HAS THE SILT FENCE TORN OR BECOME DETACHED FROM THE POSTS?  
DOES SEDIMENT NEED TO BE REMOVED FROM BEHIND THE AREA INLET BARRIER?

**SILT FENCE BARRIERS**

**MATERIAL SPECIFICATION:**  
SILT FENCE FABRIC SHOULD CONFORM TO THE AASHTO M288 96 SILT FENCE SPECIFICATION. THE POSTS USED TO SUPPORT THE SILT FENCE FABRIC SHOULD BE A HARDWOOD MATERIAL WITH THE FOLLOWING MINIMUM DIMENSIONS: 2" SQUARE (NOMINAL) BY 4' LONG. SILT FENCE FABRIC SHOULD BE ATTACHED TO THE WOODEN POSTS WITH STAPLES, WIRE, ZIP TIES, OR NAILS.

**PLACEMENT:**  
A SLOPE BARRIER SHOULD BE USED AT THE TOE OF A SLOPE WHEN A DITCH DOES NOT EXIST. THE SLOPE BARRIER SHOULD BE PLACED ON NEARLY LEVEL GROUND 5' TO 10' AWAY FROM THE TOE OF A SLOPE. THE BARRIER IS PLACED AWAY FROM THE TOE OF THE SLOPE TO PROVIDE ADEQUATE STORAGE FOR SETTLING OUT SEDIMENT. WHEN PRACTICABLE, SILT FENCE SLOPE BARRIERS SHOULD BE PLACED ALONG CONTOURS TO AVOID A CONCENTRATION OF FLOW. SILT FENCE SLOPE BARRIERS CAN ALSO BE PLACED ALONG RIGHT-OF-WAY FENCE LINES TO KEEP SEDIMENT FROM CROSSING ONTO ADJACENT PROPERTY. WHEN PLACED IN THIS MANNER, THE SLOPE BARRIER WILL NOT LIKELY FOLLOW CONTOURS.

**PROPER INSTALLATION METHOD:**  
EXCAVATE A TRENCH THE LENGTH OF THE PLANNED SLOPE BARRIER THAT IS 6" DEEP BY 4" WIDE. MAKE SURE THAT THE TRENCH IS EXCAVATED ALONG A SINGLE CONTOUR. WHEN PRACTICABLE, SLOPE BARRIERS SHOULD BE PLACED ALONG CONTOURS TO AVOID A CONCENTRATION OF FLOW. PLACE THE SOIL ON THE UPSLOPE SIDE OF THE TRENCH FOR LATER USE. ROLL OUT A CONTINUOUS LENGTH OF SILT FENCE FABRIC ON THE DOWNSLOPE SIDE OF THE TRENCH. PLACE THE EDGE OF THE FABRIC IN THE TRENCH STARTING AT THE TOP UPSLOPE EDGE. LINE ALL THREE SIDES OF THE TRENCH WITH THE FABRIC. BACKFILL OVER THE FABRIC IN THE TRENCH WITH THE EXCAVATED SOIL AND COMPACT. AFTER FILLING THE TRENCH, APPROXIMATELY 24" TO 36" OF SILT-FENCE FABRIC SHOULD REMAIN EXPOSED. LAY THE EXPOSED SILT FENCE UPSLOPE OF THE TRENCH TO CLEAR AN AREA FOR DRIVING IN THE POSTS. JUST DOWNSLOPE OF THE TRENCH, DRIVE POSTS INTO THE GROUND TO A DEPTH OF AT LEAST 18". PLACE POSTS NO MORE THAN 4' APART. ATTACH THE SILT FENCE TO THE ANCHORED POST WITH STAPLES, WIRE, ZIP TIES, OR NAILS.

**LIST OF COMMON PLACEMENT/INSTALLATION MISTAKES TO AVOID:**  
WHEN PRACTICABLE, DO NOT PLACE SILT FENCE SLOPE BARRIERS ACROSS CONTOURS. SLOPE BARRIERS SHOULD BE PLACED ALONG CONTOURS TO AVOID A CONCENTRATION OF FLOW. WHEN THE FLOW CONCENTRATES, IT OVERTOPS THE BARRIER AND THE SILT FENCE SLOPE BARRIER QUICKLY DETERIORATES. DO NOT PLACE SILT-FENCE POSTS ON THE UPSLOPE SIDE OF THE SILT FENCE FABRIC. IN THIS CONFIGURATION, THE FORCE OF THE WATER IS NOT RESTRICTED BY THE POSTS, BUT ONLY BY THE STAPLES (WIRE, ZIP TIES, NAILS, ETC.). THE SILT FENCE WILL RIP AND FAIL. DO NOT PLACE SILT FENCE SLOPE BARRIERS IN AREAS WITH SHALLOW SOILS UNDERLAIN BY ROCK. IF THE BARRIER IS NOT SUFFICIENTLY ANCHORED, IT WILL WASH OUT. SILT FENCE SLOPE BARRIERS MUST BE DUG INTO THE GROUND—SILT FENCE AT GROUND LEVEL DOES NOT WORK BECAUSE WATER WILL FLOW UNDERNEATH.

**INSPECTION AND MAINTENANCE:**  
SILT FENCE SLOPE BARRIERS SHOULD BE INSPECTED EVERY 7 DAYS AND WITHIN 24 HOURS OF A RAINFALL OF 1/2" OR MORE. THE FOLLOWING IS A LIST OF QUESTIONS THAT SHOULD BE ADDRESSED DURING EACH INSPECTION:  
ARE THERE ANY POINTS ALONG THE SLOPE BARRIER WHERE WATER IS CONCENTRATING?  
DOES WATER FLOW UNDER THE SLOPE BARRIER?  
DO THE SILT FENCES SAG EXCESSIVELY?  
HAS THE SILT FENCE TORN OR BECOME DETACHED FROM THE POSTS?  
DOES SEDIMENT NEED TO BE REMOVED FROM BEHIND THE SLOPE BARRIER?

REVISION DATE: MAY 2013

**CITY OF WICHITA**  
PUBLIC WORKS & UTILITIES  
ENGINEERING DIVISION

**SILT FENCE DITCH CHECK  
AND BARRIER DETAILS**

CITY ENGINEER  
**GARY JANZEN, P.E.**

PROJECT NUMBER 2028 PPW	GCA NUMBER (607853)	DATE
----------------------------	------------------------	------

CITY ENGINEER'S OFFICE  
CITY HALL - SEVENTH FLOOR  
455 NORTH MAIN STREET  
WICHITA, KANSAS 67202-1620  
(316) 268-4501

SW-502


Sheet: 08-27-2016, 1:28:46 PM, by: CSI  
Plot: State 11, 11-30-2016, 8:27:32 AM, by: CSI  
U:\Wichita-Civil\2016\160551\000\Main\Drawings\160551-000-C5-03-EROSION CONTROL DETAILS

DATE	PURPOSE	NO.
08.25.16	30% PROGRESS SET	
09.15.16	60% PROGRESS SET	
10.13.16	90% PROGRESS SET	
11.10.16	BID/PERMIT SET	
11.22.16	ADDENDUM #1	1
12.07.16	CITY COMMENTS	2


HAMPTON INN  
CADILLAC LAKE  
WICHITA, KANSAS




LKArchitecture  
Architecture • Engineering • Planning • Interior Design • Landscape Architecture

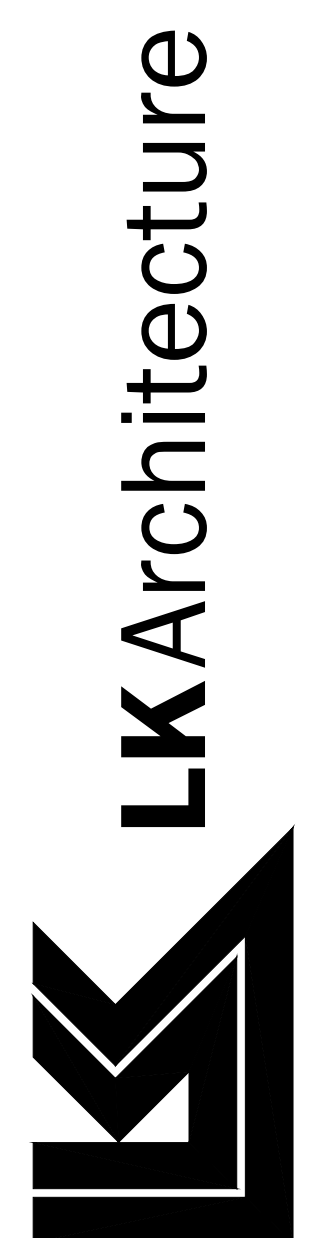


LKArchitecture, Inc.®  
345 Riverview Wichita, KS 67203  
T 316.268.0230 F 316.268.0205  
CONTACT: PEC  
DRAWN: PEC  
CHECKED: PEC  
PROJECT NUMBER:  
**15433**  
SHEET TITLE:  
EROSION CONTROL DETAILS  
SHEET NUMBER:  
**C5.04** OF: X

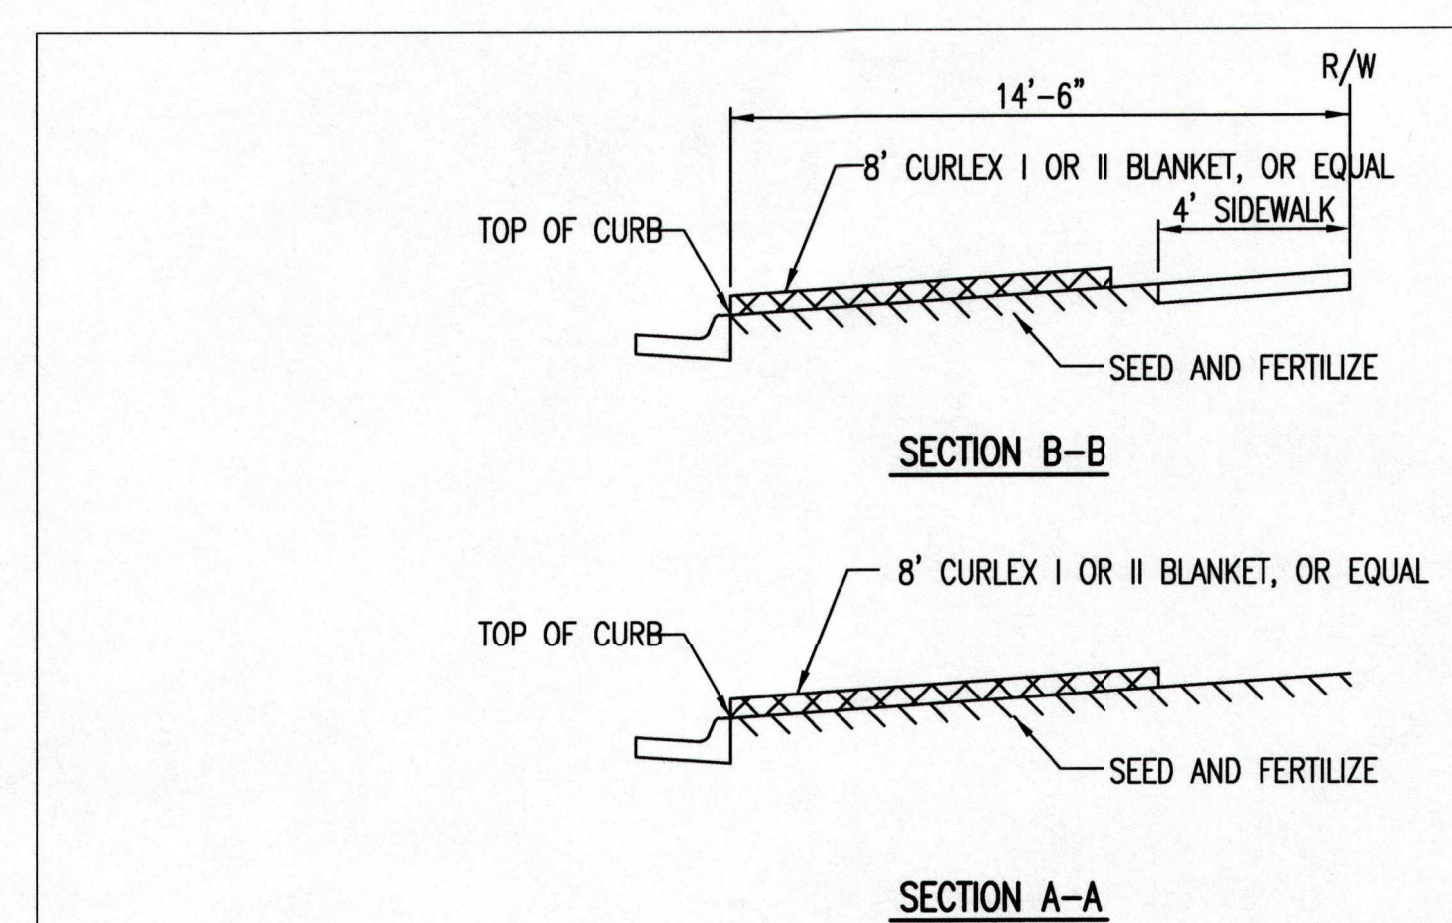

INSTALL 8" WIDE CURLEX I OR II EXCELSIOR BLANKET, OR EQUAL, ON PREPARED SURFACE BACK OF CURB. EDGE OF BLANKET WILL BE AT BACK OF CURB. INSTALL PER MANUFACTURER'S RECOMMENDATION, INCLUDING STAPLES. (SEE DETAIL)

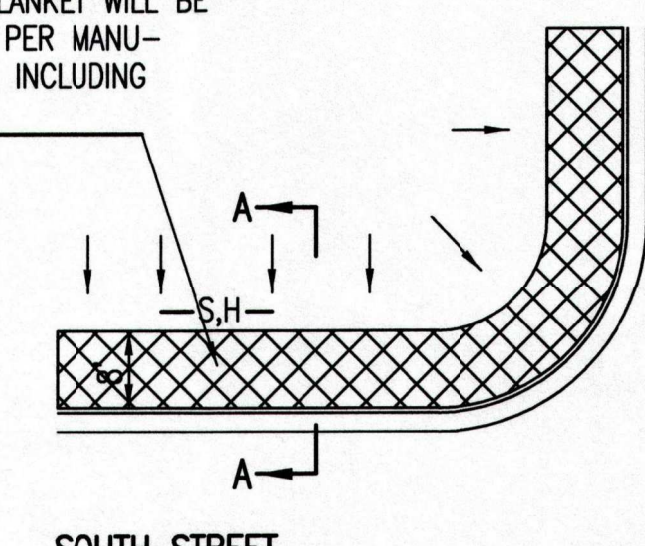


INSTALL 8" WIDE CURLEX I OR II EXCELSIOR BLANKET, OR EQUAL, ON PREPARED SURFACE BACK OF CURB. EDGE OF BLANKET WILL BE AT BACK OF CURB. INSTALL PER MANUFACTURER'S RECOMMENDATION, INCLUDING STAPLES. (SEE DETAIL)

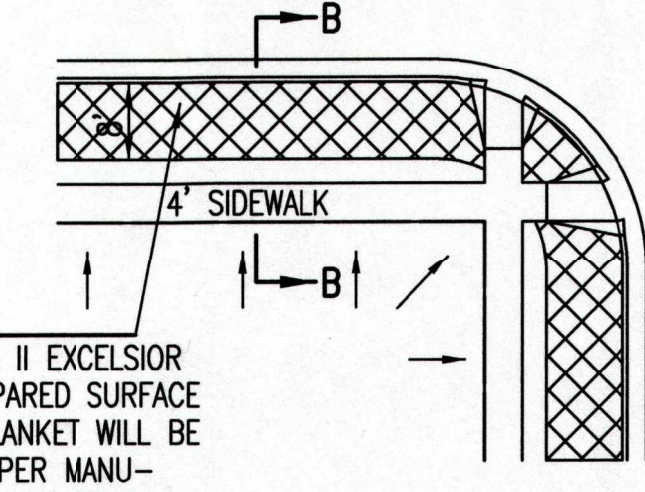

- GENERAL NOTES**
- EXCELSIOR MAT TO BE INSTALLED WHEN SOD IS NOT SPECIFIED ON PROJECT.
  - EXCELSIOR BLANKET TO BE INSTALLED OVER SEED AND FERTILIZER, AS SPECIFIED IN THE PROJECT SPECIFICATIONS.
  - AFTER INSTALLATION OF EXCELSIOR BLANKET, AT LOCATIONS WHERE CONCENTRATED FLOW CARRIES SEDIMENT OVER THE CURB AND INTO THE GUTTER, SUPPLEMENTAL EROSION CONTROL DEVICES WILL BE INSTALLED BY THE CONTRACTOR AS NEEDED, TO FIX THE PROBLEM.

**BACK OF CURB PROTECTION DETAIL**

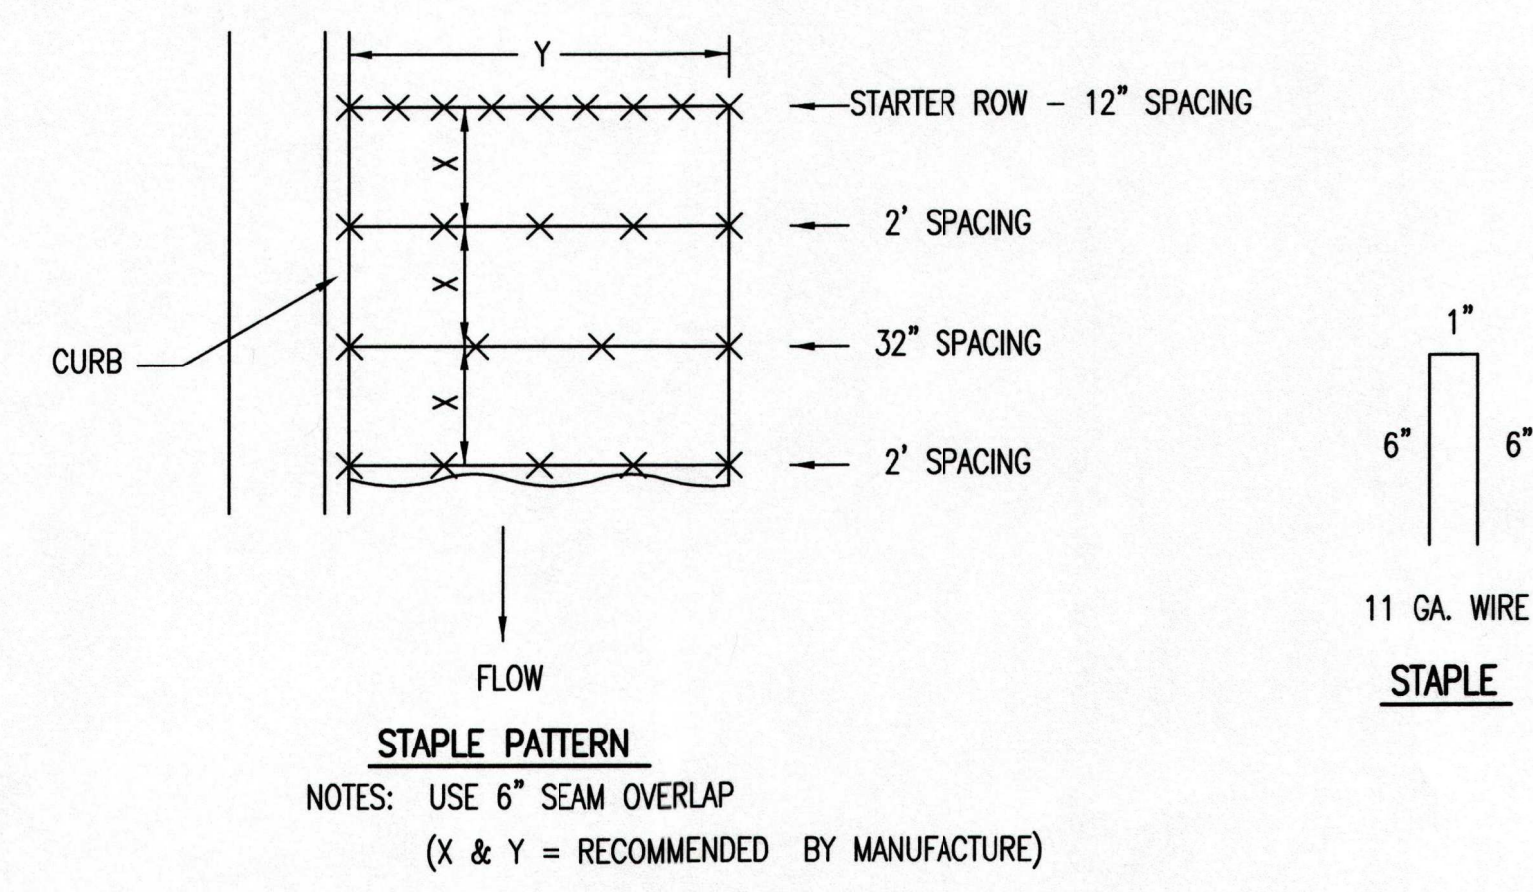


STAPLE PATTERN  
NOTES: USE 6" SEAM OVERLAP  
(X & Y = RECOMMENDED BY MANUFACTURE)




NOTE: PLACE 4" PERFORATED PVC PIPE, FILLED WITH 1/2"-1" DIA. GRAVEL, IN FRONT OF CURB INLET AS SHOWN.

2X4 LENGTH	INLET TYPE	INLET OPENING
5'-6"	1-A	5'-0"
10'-6"	1-A	10'-0"
15'-6"	1-A	15'-0"

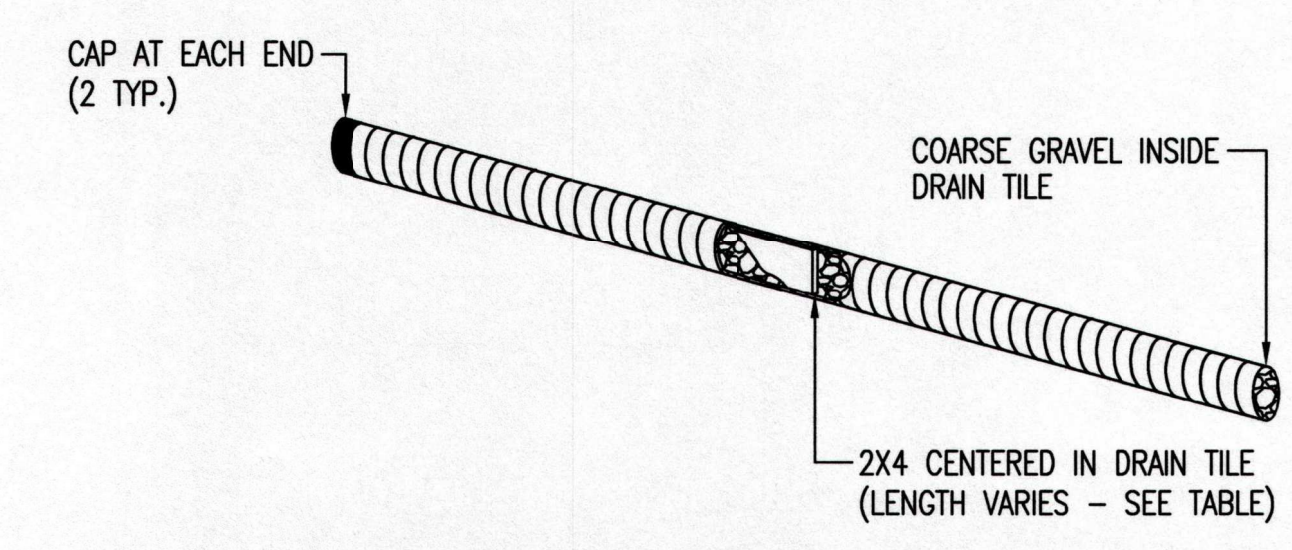

**CURB INLET PROTECTION**  
4" PERFORATED PIPE W/ GRAVEL

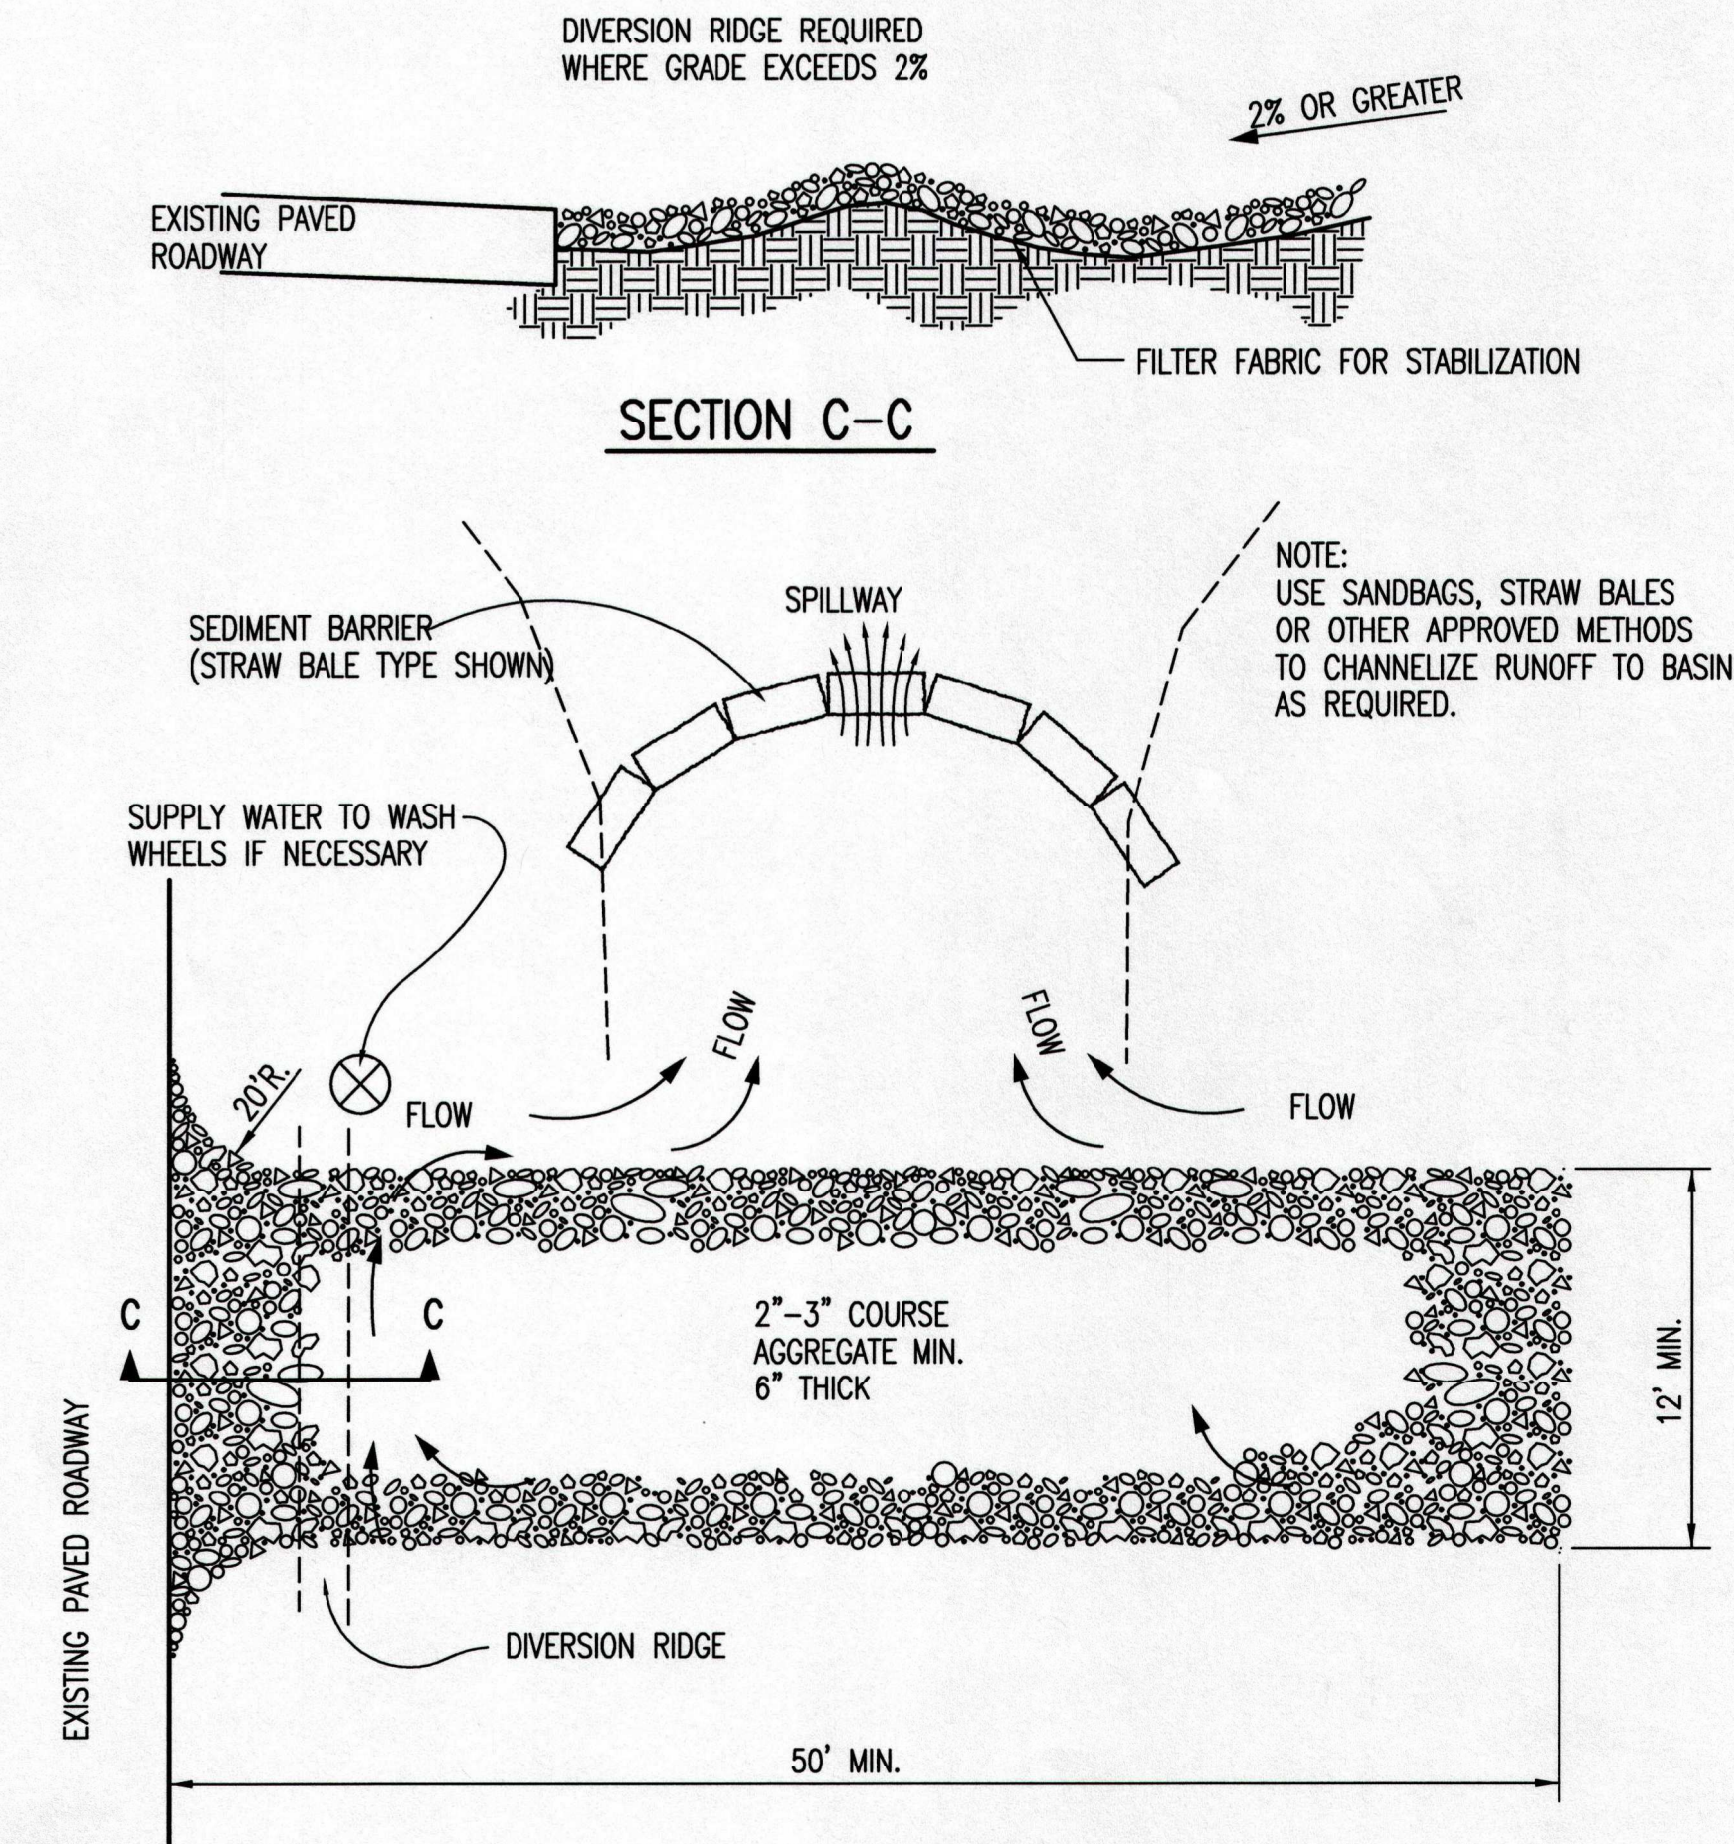

- GENERAL NOTES**
- THE ENTRANCE SHALL BE MAINTAINED IN A CONDITION THAT WILL PREVENT TRACKING OR FLOWING OF SEDIMENT ONTO PUBLIC RIGHTS-OF-WAY. THIS MAY REQUIRE TOP DRESSING, REPAIR AND/OR CLEANOUT OF ANY MEASURES USED TO TRAP SEDIMENT.
  - WHEN NECESSARY, WHEELS SHALL BE CLEANED PRIOR TO ENTRANCE ONTO PUBLIC RIGHT-OF-WAY.
  - WHEN WASHING IS REQUIRED, IT SHALL BE DONE ON AN AREA STABILIZED WITH CRUSHED STONE THAT DRAINS INTO AN APPROVED SEDIMENT TRAP OR SEDIMENT BASIN, AS SHOWN ABOVE.
  - DRIVE ENTRANCES ONTO RESIDENTIAL LOTS WILL NOT BE REQUIRED TO HAVE THE SEDIMENT BARRIER SHOWN, BUT WHEEL WASHING MAY BE REQUIRED IF STABILIZED ENTRANCE IS NOT SUFFICIENT TO KEEP MUD FROM BEING TRACKED ONTO ADJACENT STREET. ENTRANCE SHALL EXTEND FROM BACK OF CURB TO DWELLING.



**CITY OF WICHITA**  
PUBLIC WORKS & UTILITIES  
ENGINEERING DIVISION

**BACK OF CURB PROTECTION, CURB INLET PROTECTION AND CONSTRUCTION ENTRANCE**

CITY ENGINEER  
**GARY JANZEN, P.E.**

PROJECT NUMBER 2028 PPW	OCA NUMBER (607853)	DATE
CITY ENGINEER'S OFFICE CITY HALL - SEVENTH FLOOR 455 NORTH MAIN STREET WICHITA, KANSAS 67202-1620 (316) 268-4501		SHEET

Sheet: 08-27-2016, 1:06:01 PM by CSI  
Plot: State 1:11-30-2016, 8:27:54 AM by CSI  
U:\Wichita-Cad\2016\160551\000\Main\Drawings\160551-000-C5-04-EROSION CONTROL DETAILS


SIW-501

DATE	PURPOSE	NO.
08.25.16	30% PROGRESS SET	
09.15.16	60% PROGRESS SET	
10.13.16	90% PROGRESS SET	
11.10.16	BID/PERMIT SET	
11.22.16	ADDENDUM #1	1
12.07.16	CITY COMMENTS	2

HAMPTON INN  
CADILLAC LAKE  
WICHITA, KANSAS





LKArchitecture  
Architecture • Engineering • Planning • Interior Design • Landscape Architecture

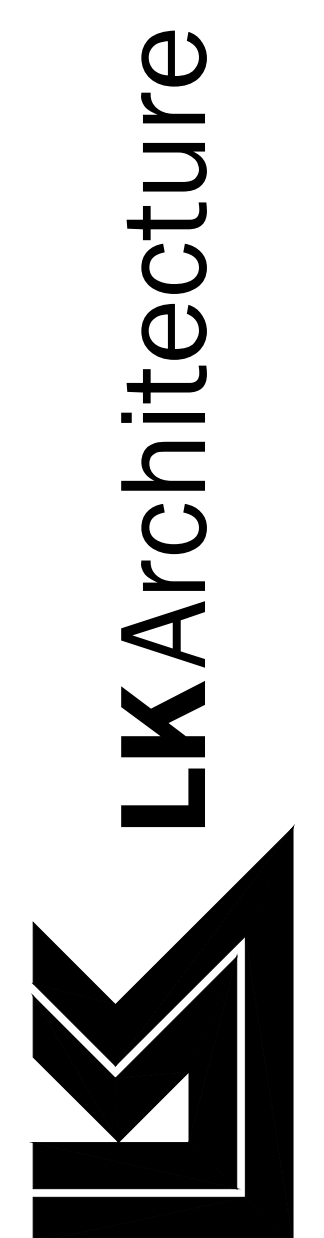

LKArchitecture, Inc.®  
345 Riverview Wichita, KS 67203  
T 316.268.0230 F 316.268.0205  
CONTACT: PEC  
DRAWN: PEC  
CHECKED: PEC  
PROJECT NUMBER:  
**15433**  
SHEET TITLE:  
EROSION CONTROL DETAILS  
SHEET NUMBER:  
**C5.05** OF: X

GENERAL NOTES

- THIS SHEET IS INTENDED TO PROVIDE GUIDELINES AS TO WHAT TYPES OF EROSION CONTROL DEVICES WILL BE INSTALLED DURING THE CONSTRUCTION PROCESS. CONTRACTORS ARE EXPECTED TO BID PROJECTS ACCORDINGLY.
- EROSION CONTROL DEVICES MUST BE MAINTAINED BY THE CONTRACTOR THROUGHOUT THE CONSTRUCTION PROCESS AND UNTIL THE DISTURBED EARTH IS RESTABILIZED.
- IF THE PROJECT WILL DISTURB 1 ACRE OR MORE, A FEDERAL/STATE NPDES STORMWATER PERMIT IS REQUIRED. A DETAILED STORMWATER POLLUTION PREVENTION PLAN, IS REQUIRED. THE EROSION CONTROL DEVICES SHOWN ON THIS SHEET ARE CONSIDERED TO BE THE MINIMUM TO BE SHOWN IN THE POLLUTION PREVENTION PLAN.
- FOR PROJECTS DISTURBING LESS THAN 1 ACRE, CONTRACTORS ARE ENCOURAGED TO PREPARE STORMWATER POLLUTION PREVENTION PLANS PRIOR TO CONSTRUCTION. EROSION CONTROL DEVICES MUST BE USED ON ALL PROJECTS.
- FAILURE TO USE AND MAINTAIN EROSION CONTROL DEVICES IS A VIOLATION OF SECTION 16.32 OF THE CITY CODE AND WILL SUBJECT THE CONTRACTOR TO THE PENALTIES PROVIDED FOR THEREIN.
- THE APPLICATION OF EROSION CONTROL DEVICES SHOWN ON THIS SHEET IS FOR SITUATIONS NORMALLY ENCOUNTERED. FROM TIME TO TIME, SITUATIONS WILL ARISE THAT MAY REQUIRE A DIFFERENT DEVICE OTHER THAN THOSE SHOWN. EROSION CONTROL DEVICES, OTHER THAN THOSE SHOWN, MAY BE UTILIZED AS LONG AS THEY ARE EFFECTIVE AND MAINTAINED.

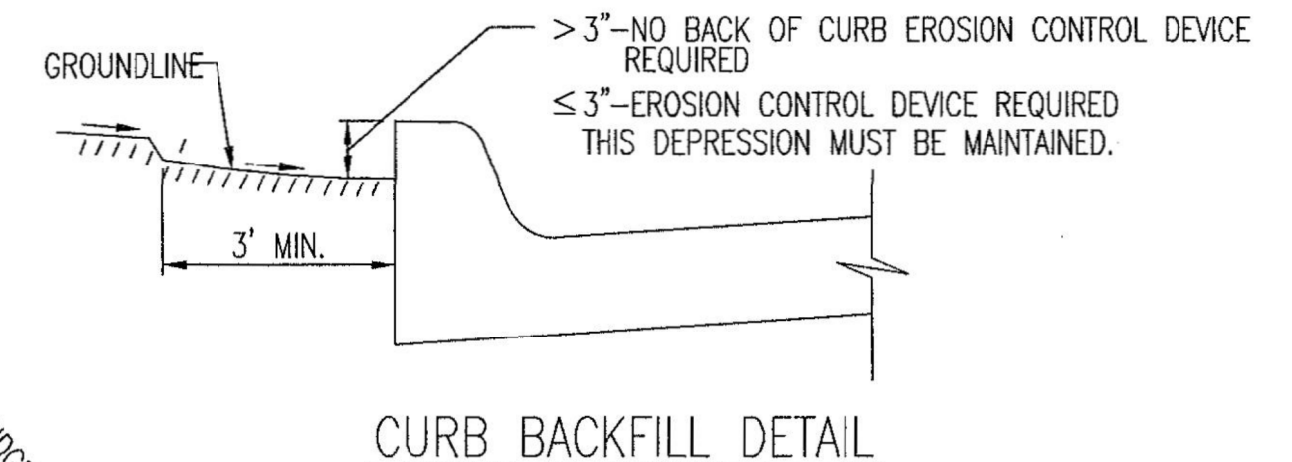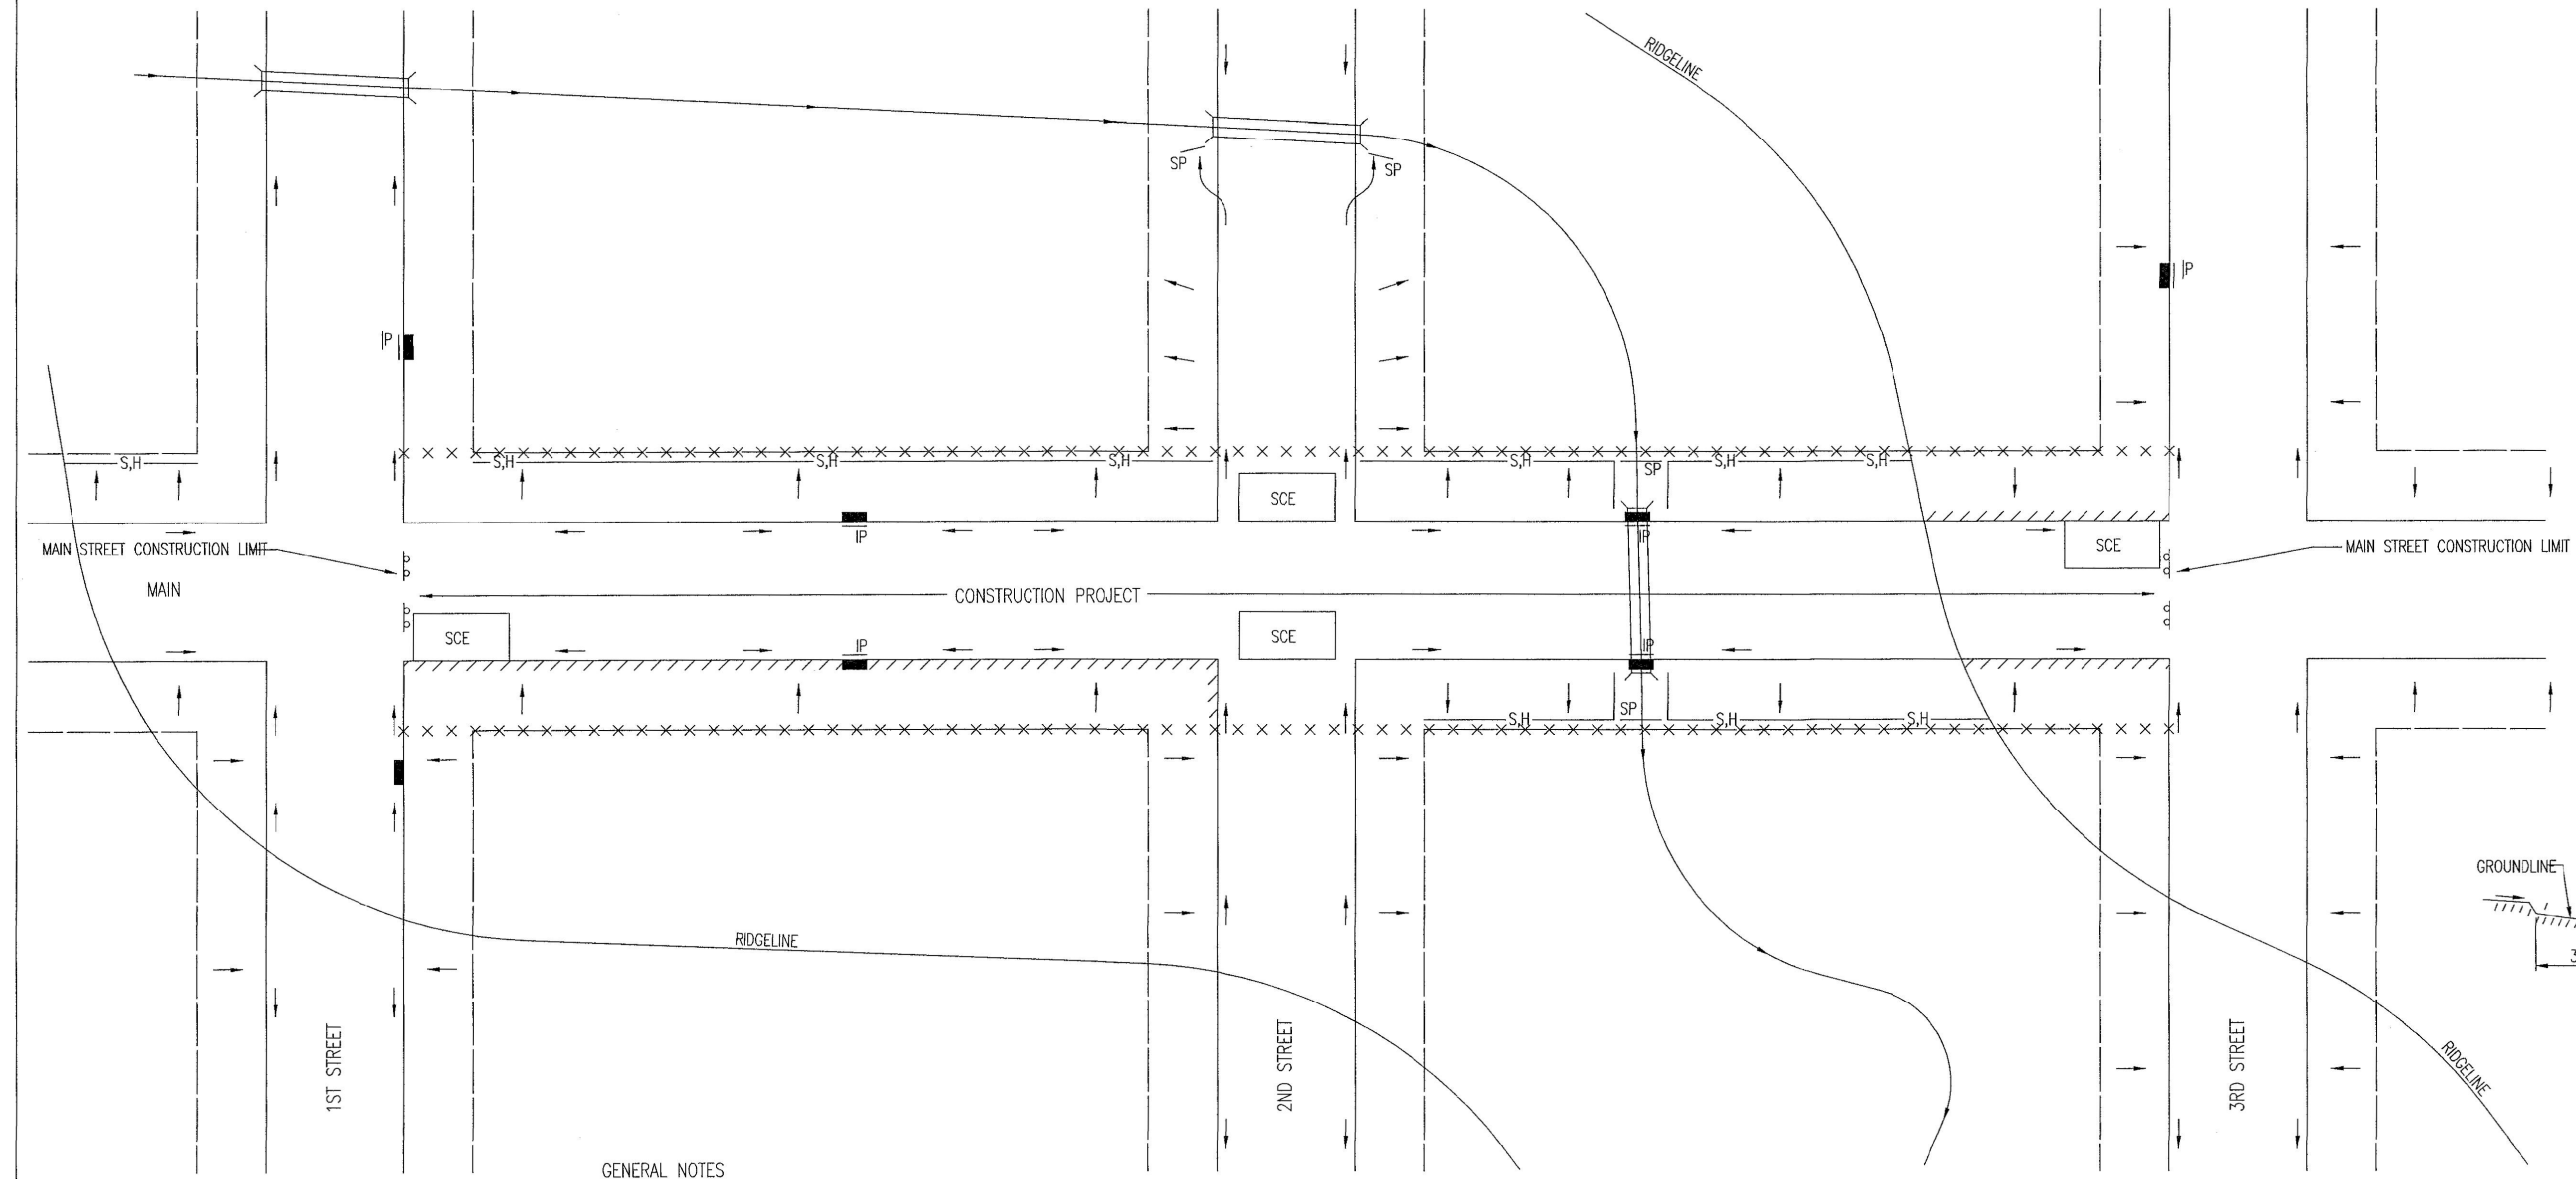

CURB BACKFILL DETAIL

THIS IS A TEMPORARY MEASURE ONLY, WHEN APPROVED BY THE PROJECT ENGINEER. THE DIRT GRADE BEHIND THE CURB SHALL BE BROUGHT TO THE TOP OF CURB, WITH TEMPORARY EROSION CONTROL MAT OR PERMANENT VEGETATION PLACED, PRIOR TO THE COMPLETION OF ALL PROJECTS.

LEGEND

---	R-O-W LIMITS
→	DRAINAGE FLOW PATH
× × × × ×	R/W LIMIT WITHIN CONSTRUCTION LIMIT
■	STORM WATER INLETS
IP	INLET PROTECTION
S.H	SILT FENCE OR HAY BALE BARRIER
SP	STREAM PROTECTION
SCE	STABILIZED CONSTRUCTION ENTRANCE
////	BACK OF CURB PROTECTION

GENERAL NOTES

- THE INTENT OF ALL EROSION CONTROL DEVICES IS TO KEEP ALL SEDIMENT CONFINED TO THE CONSTRUCTION SITE, AND OUT OF ALL UNDERGROUND PIPES, DITCHES, LAKES, AND OTHER DRAINAGE FACILITIES, AND OFF OF STREETS.
- THE POINT OF COMPLIANCE IS GENERALLY THE RIGHT-OF-WAY LINES WITHIN THE LIMITS OF CONSTRUCTION.
- EROSION CONTROL DEVICES WILL BE REQUIRED AT ALL POINTS ALONG THE PROJECT WHERE DISTURBED EARTH CAN DRAIN ONTO PRIVATE PROPERTY.
- INLET PROTECTION DEVICES WILL BE REQUIRED WHEREVER WATER CAN DRAIN OFF THE PROJECT SITE INTO AN INLET, INCLUDING ANY SIDE STREET INLETS.
- EROSION CONTROL DEVICES SHALL BE INSTALLED AT CREEK CROSSINGS SO AS TO PREVENT SEDIMENT FROM ENTERING THEREIN.
- STABILIZED CONSTRUCTION ENTRANCES SHALL BE PROVIDED, AS NEEDED, TO PREVENT MUD FROM TRACKING ONTO STREETS NOT UNDER CONSTRUCTION AND ON STREETS WITHIN THE PROJECT LIMITS IF TRAFFIC IS BEING MAINTAINED THROUGH THE PROJECT.
- ANY MUD TRACKED ONTO STREETS MUST BE REMOVED AT THE END OF EACH WORK DAY.
- THE CONTRACTOR WILL BE REQUIRED TO PLACE EROSION CONTROL DEVICES BACK OF CURB, WHENEVER WATER CAN DRAIN OVER CURB, TO KEEP ERODED SOIL OUT OF THE GUTTERLINES, IN ACCORDANCE WITH THE FOLLOWING:
  - THE DEVICE REQUIRED WILL BE APPROVED EROSION CONTROL MAT LISTED ON THE CITY'S APPROVED MATERIAL LIST. SAID BLANKET SHALL BE PLACED OVER THE APPROPRIATE SEED AND FERTILIZER, AS SPECIFIED IN THE PROJECT SPECIFICATIONS. (SEE SOIL EROSION BMPs - BACK OF CURB SEDIMENT BARRIER DETAILS)
  - THIS DEVICE SHALL BE INSTALLED IMMEDIATELY WHENEVER THE CURB IS BACKFILLED TO WITHIN 3" OF THE TOP OF CURB. (SEE CURB BACKFILL DETAIL) OTHER BMP'S MAY BE REQUIRED AT LOCATIONS WHERE CONCENTRATED FLOW CARRIES SEDIMENT OVER THE CURB.
  - ADDITIONALLY, OTHER EROSION CONTROL DEVICES (HAY BALES, SILT FENCE, ETC.) WILL BE INSTALLED AT LOCATIONS OF CONCENTRATED FLOW RESULTING IN SEDIMENT OVERRUNNING THE MAT.
  - SHOULD THE PROJECT PLANS SPECIFY THAT THE RIGHT-OF-WAY IS TO BE SODDED, THE EXCELSIOR MAT WILL NOT BE REQUIRED SO LONG AS THE SOD IS PLACED WITHIN 48 HOURS AFTER CURB BACKFILL REACHES A HEIGHT OF 3" OR LESS FROM TOP OF CURB. (SEE CURB BACKFILL DETAIL)




REVISION: JUNE 2015

STREET IMPROVEMENT PROJECTS		
CITY ENGINEER		
GARY JANZEN, P.E.		
PROJECT NUMBER	OCA NUMBER	DATE
2028 PPW	1607853	
CITY ENGINEER'S OFFICE		SHEET
CITY HALL - SEVENTH FLOOR		
455 NORTH MAIN STREET		
WICHITA, KANSAS 67202-1620		
(316) 268-4501		


SW-504

Sheet: 08-27-2016, 1:27:16 PM, 4:51 PM, Scale: 1:1, 11-30-2016, 8:28:51 AM by: CSI, U:\Wichita-Cad\2016\160551\000\Main\Drawings\160551-000-C5-05-EROSION CONTROL DETAILS

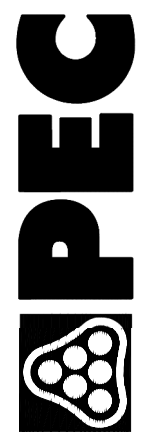


DATE	PURPOSE	NO.
08.25.16	30% PROGRESS SET	
09.15.16	60% PROGRESS SET	
10.13.16	90% PROGRESS SET	
11.10.16	BID/PERMIT SET	
11.22.16	ADDENDUM #1	1
12.07.16	CITY COMMENTS	2

**PHASE 1 – INITIAL EARTHWORK AND UTILITIES (EXCEPT STORM SEWER)**

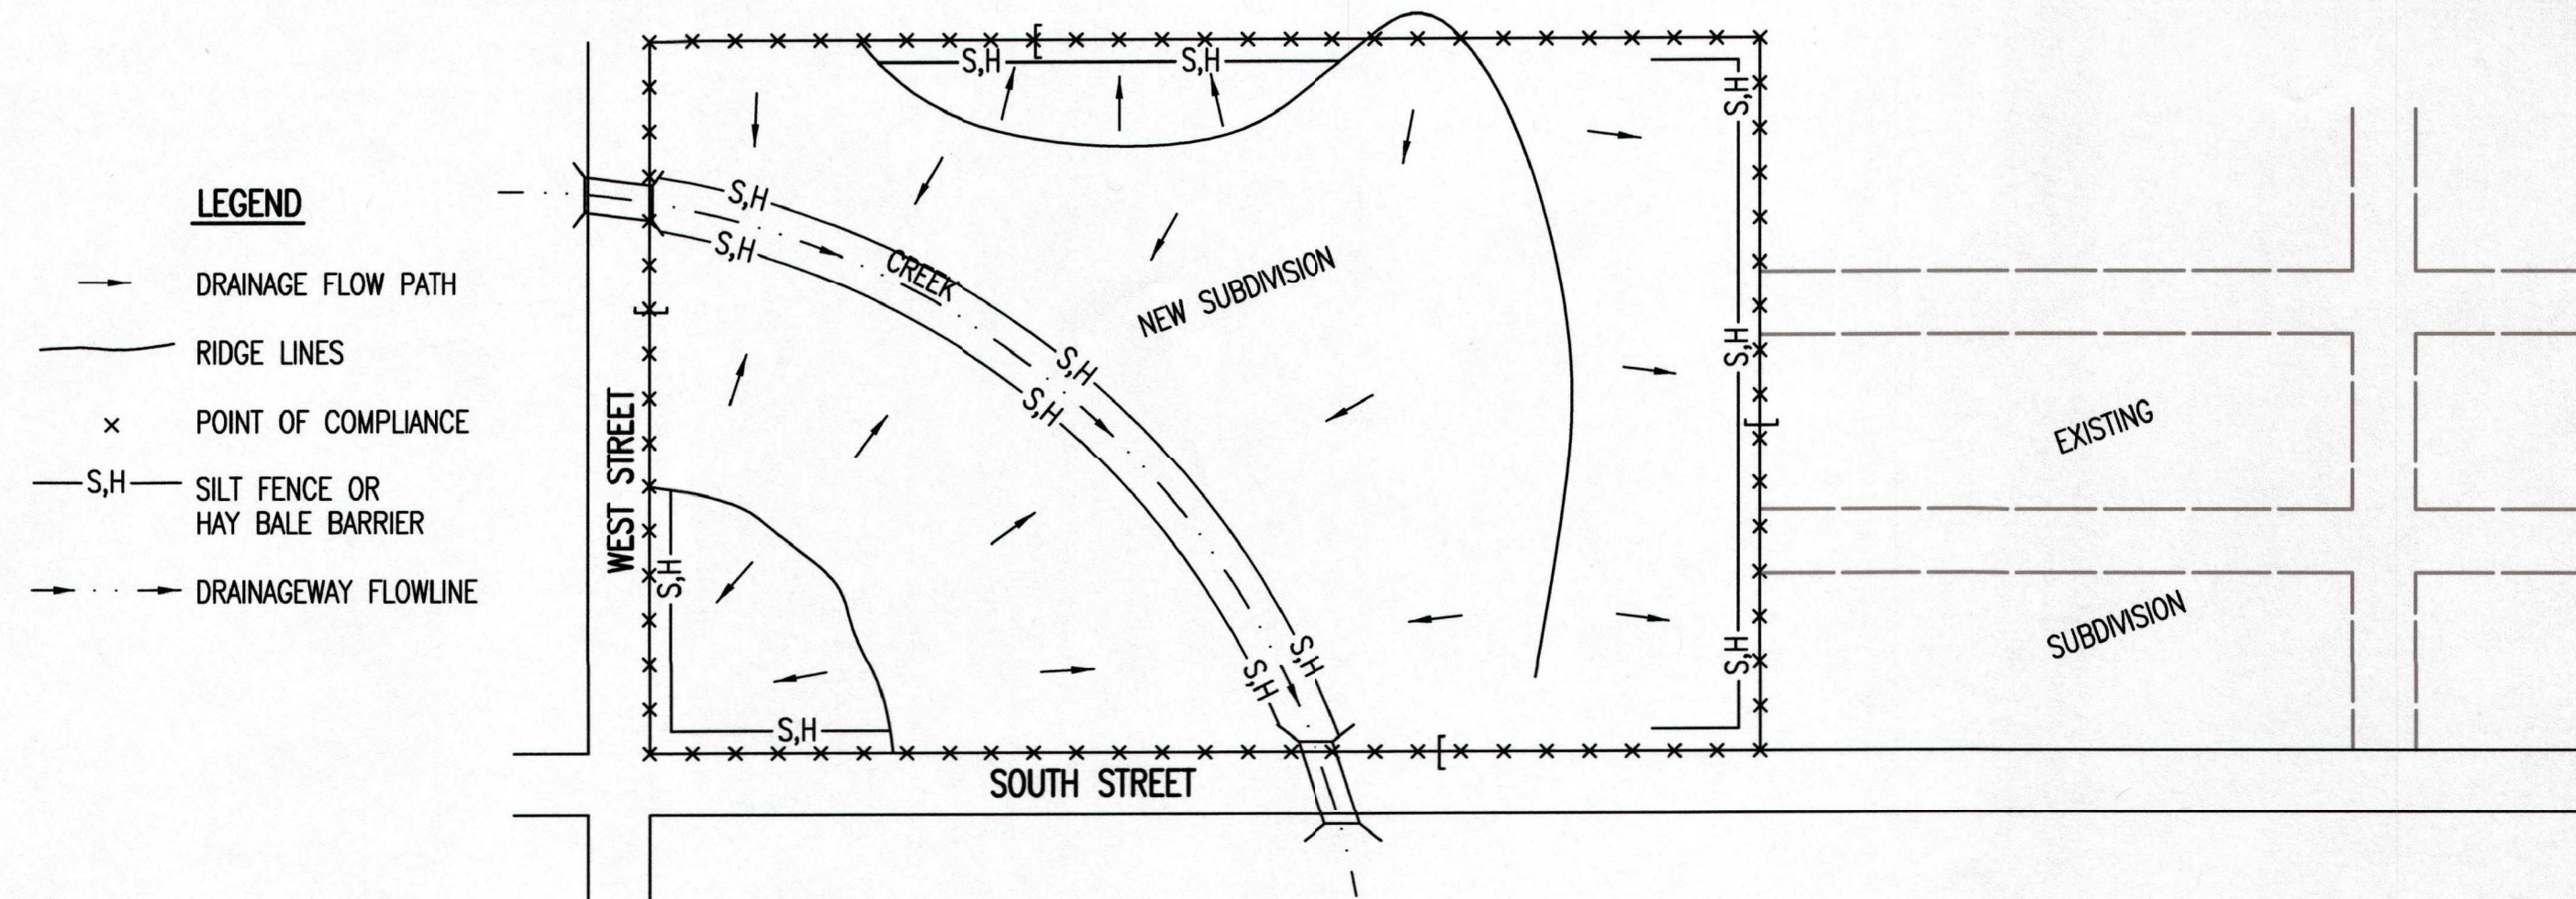


- DURING THIS PHASE OF SUBDIVISION CONSTRUCTION, THE POINTS OF COMPLIANCE ARE THE PERIMETER BOUNDARIES AND ANY DRAINAGE WAYS OR STORM SEWERS DRAINING THROUGH OR FROM THE SITE. SHOULD LAKES BE CONSTRUCTED WITHIN THE SUBDIVISION THAT WILL DISCHARGE DURING STORMS, THEY ARE ALSO A POINT OF COMPLIANCE.
- HAY BALES OR SILT FENCE MUST BE CONSTRUCTED ALONG THE PROPERTY LINE WHERE ON SITE WATER CAN DRAIN OFF THE PROPERTY. THESE EROSION CONTROL DEVICES WILL ALSO BE INSTALLED ALONG ANY DRAINAGE DITCH OR LAKE THAT CAN DISCHARGE.
- SHOULD SILT OR SEDIMENT ENTER THE DITCHES OR STREETS ON THE ADJACENT BOUNDARY STREETS, APPROPRIATE EROSION CONTROL DEVICES WILL BE PLACED WITHIN THE SUBDIVISION TO PREVENT THIS.
- ANY MUD TRACKED ONTO ADJACENT STREETS WILL BE REMOVED WITHIN 48 HOURS OR BY FRIDAY AT 6:00 PM, WHICHEVER IS EARLIER.
- CONTRACTORS WORKING WITHIN THE SITE WILL NOT BE REQUIRED TO USE INDIVIDUAL EROSION CONTROL DEVICES AS LONG AS THOSE SPECIFIED ABOVE ARE IN PLACE AND EFFECTIVE. CONTRACTORS WORKING ON THE BOUNDARY LINE STREETS OR ON ADJACENT PROPERTIES TO EXTEND UTILITIES ARE EXPECTED TO USE EROSION CONTROL DEVICES AT THEIR WORK LOCATIONS, AS NEEDED.
- UTILIZE STABILIZED CONSTRUCTION ENTRANCE AT ENTRANCE AND EXIT ONTO ANY EXISTING PUBLIC STREETS.
- IF THE INITIAL EARTH WORK AND UTILITIES ARE DONE AS PART OF A PUBLIC IMPROVEMENT PROJECT, THESE EROSION CONTROL DEVICES WILL BE INSTALLED BY THE CONTRACTOR AS SPECIFIED IN THE INDIVIDUAL PROJECT CONTRACTS. THE CONTRACTOR WILL MAINTAIN THE DEVICES UNTIL COMPLETION OF THE CONTRACT, AT WHICH TIME THE DEVELOPER WILL ASSUME MAINTENANCE RESPONSIBILITIES. IF THESE CONTRACTS ARE NOT PUBLIC IMPROVEMENT PROJECTS, THE DEVELOPER WILL BE RESPONSIBLE FOR INSTALLING AND MAINTAINING THESE DEVICES.
- WITHIN 14 DAYS OF COMPLETION OF EARTHWORK ACTIVITIES IN ANY GIVEN AREA, THAT AREA SHALL BE TEMPORARILY OR PERMANENTLY SEEDED AND MULCHED.

**PHASE 3 – STREET CONSTRUCTION**

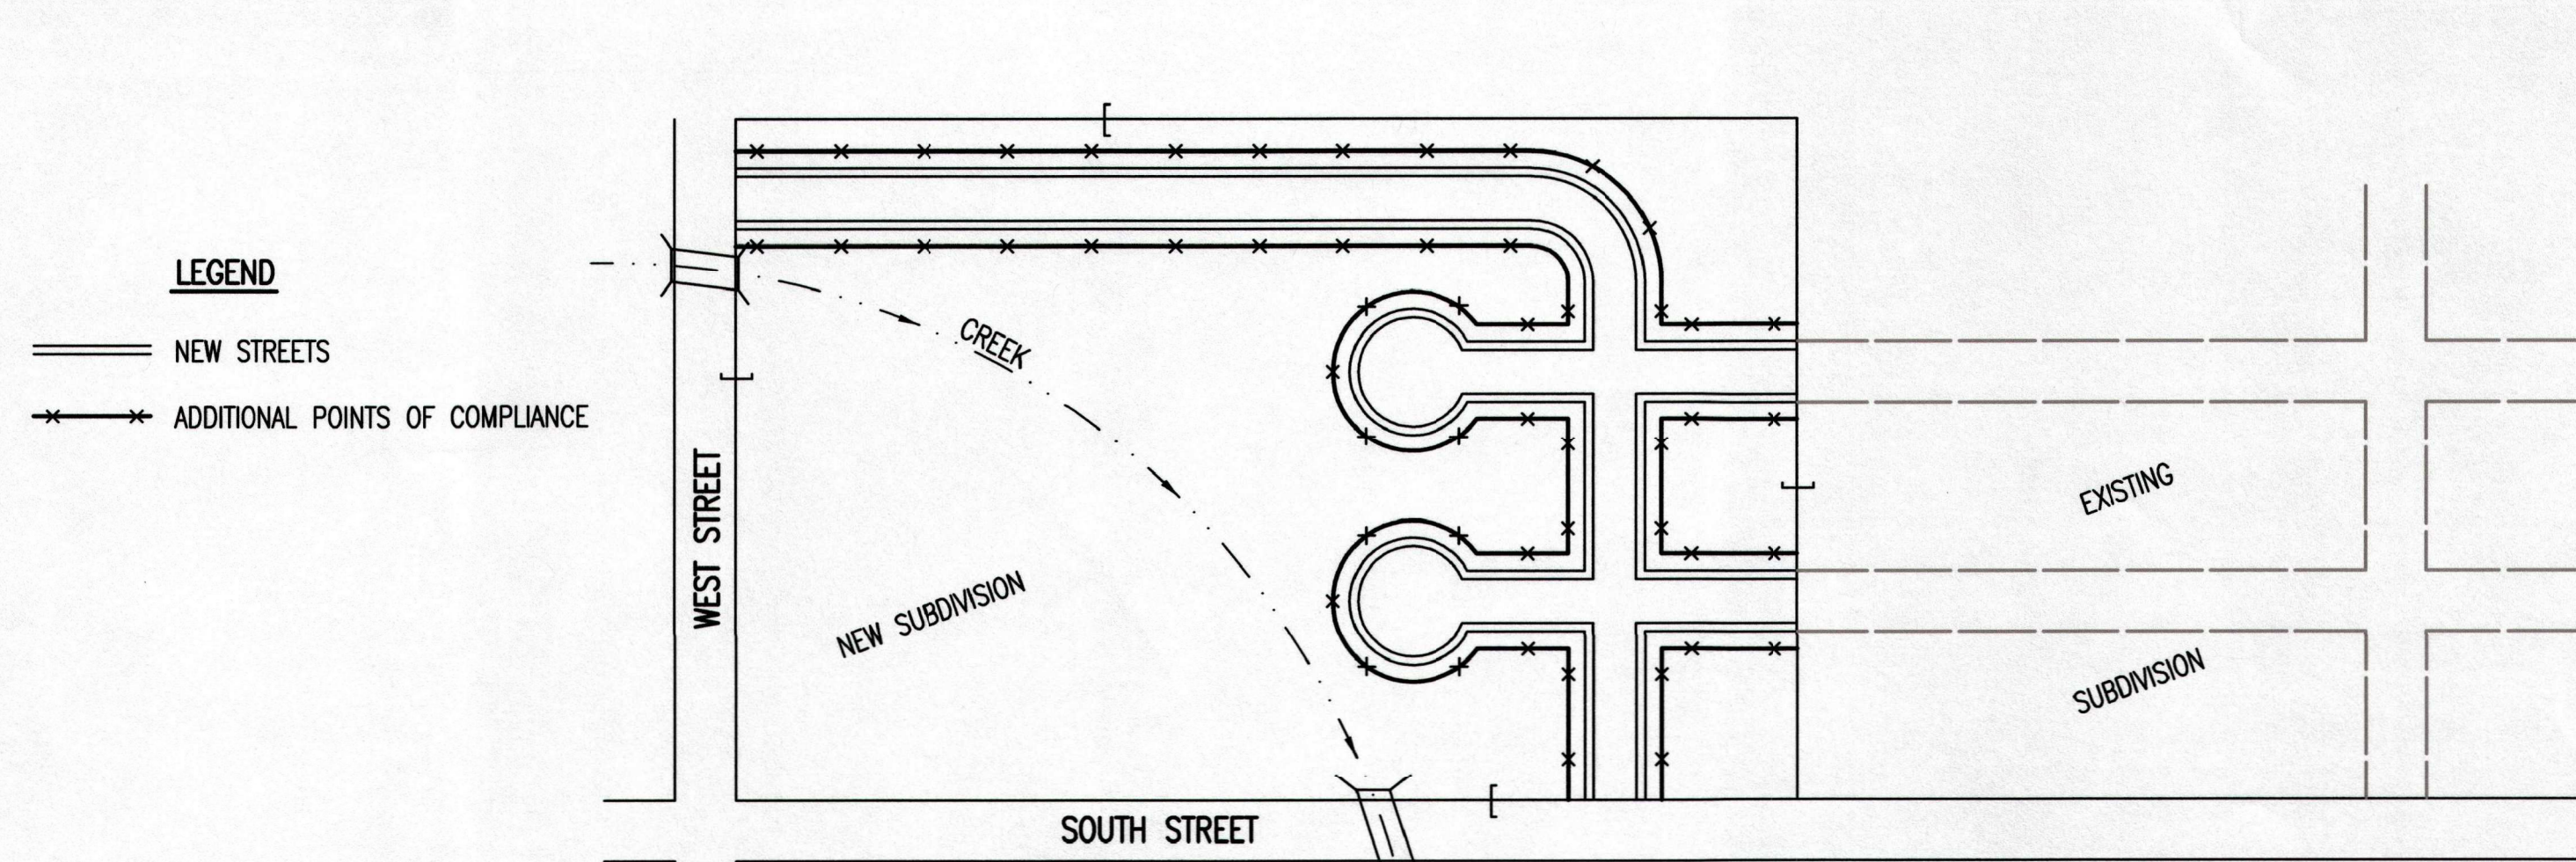

- DURING THIS PHASE OF SUBDIVISION CONSTRUCTION, NEW STREETS ARE INSTALLED. ALL EROSION CONTROL DEVICES INSTALLED DURING PHASE 1 AND 2 MUST STILL BE MAINTAINED. THE POINT OF COMPLIANCE NOW SHIFTS TO THE BACK OF CURB ALONG EACH STREET.
- CURB OPENING INLET PROTECTION:
  - SUMP AREAS – INLET PROTECTION SHALL BE PROVIDED WHEN STREET SUBGRADE WORK IS COMPLETED.
  - NON-SUMP LOCATIONS – PROVIDE INLET PROTECTION AS SOON AS BASE COURSE ASPHALT IS INSTALLED, BEFORE THE SURFACE COURSE LIFT.
- EROSION CONTROL DEVICES WILL BE REQUIRED BACK OF CURB WHEREVER WATER CAN FLOW OVER THE CURB AND THE CURB HAS BEEN BACKFILLED TO WITHIN 3" OR LESS OF THE TOP OF CURB (SEE CURB BACKFILL DETAIL). FOR CURBS NOT YET ENTIRELY BACKFILLED (3" OR MORE BELOW TOP OF CURB), ADDITIONAL DEVICES WILL BE REQUIRED AT POINTS WHERE WATER BREAKS OVER CURB WHICH COULD RESULT IN THE PLACEMENT OF SEDIMENT IN THE GUTTER.
- SEE DETAIL SHEET FOR BACK OF CURB PROTECTION.
- THE BACK OF CURB PROTECTION SPECIFIED ON THIS PLAN MAY HAVE TO BE SUPPLEMENTED WITH HAY BALE OR SILT FENCE EROSION CONTROL DEVICES AT LOCATIONS WHERE CONCENTRATED FLOW RESULTS IN SEDIMENT BEING CARRIED OVER THE EXCELSIOR MATS.
- THE STREET CONTRACTOR WILL BE RESPONSIBLE FOR INSTALLING BACK OF CURB EROSION CONTROL DEVICES.
- THE INDIVIDUAL LOT OWNERS WILL BE RESPONSIBLE FOR MAINTAINING THE BACK OF CURB EROSION CONTROL DEVICES IN FRONT OF THEIR LOTS UNTIL SUCH TIME AS ADJACENT DISTURBED EARTH IS STABILIZED WITH GRASS OR SOD.


**PHASE 2 – INSTALLATION OF STORM SEWER**

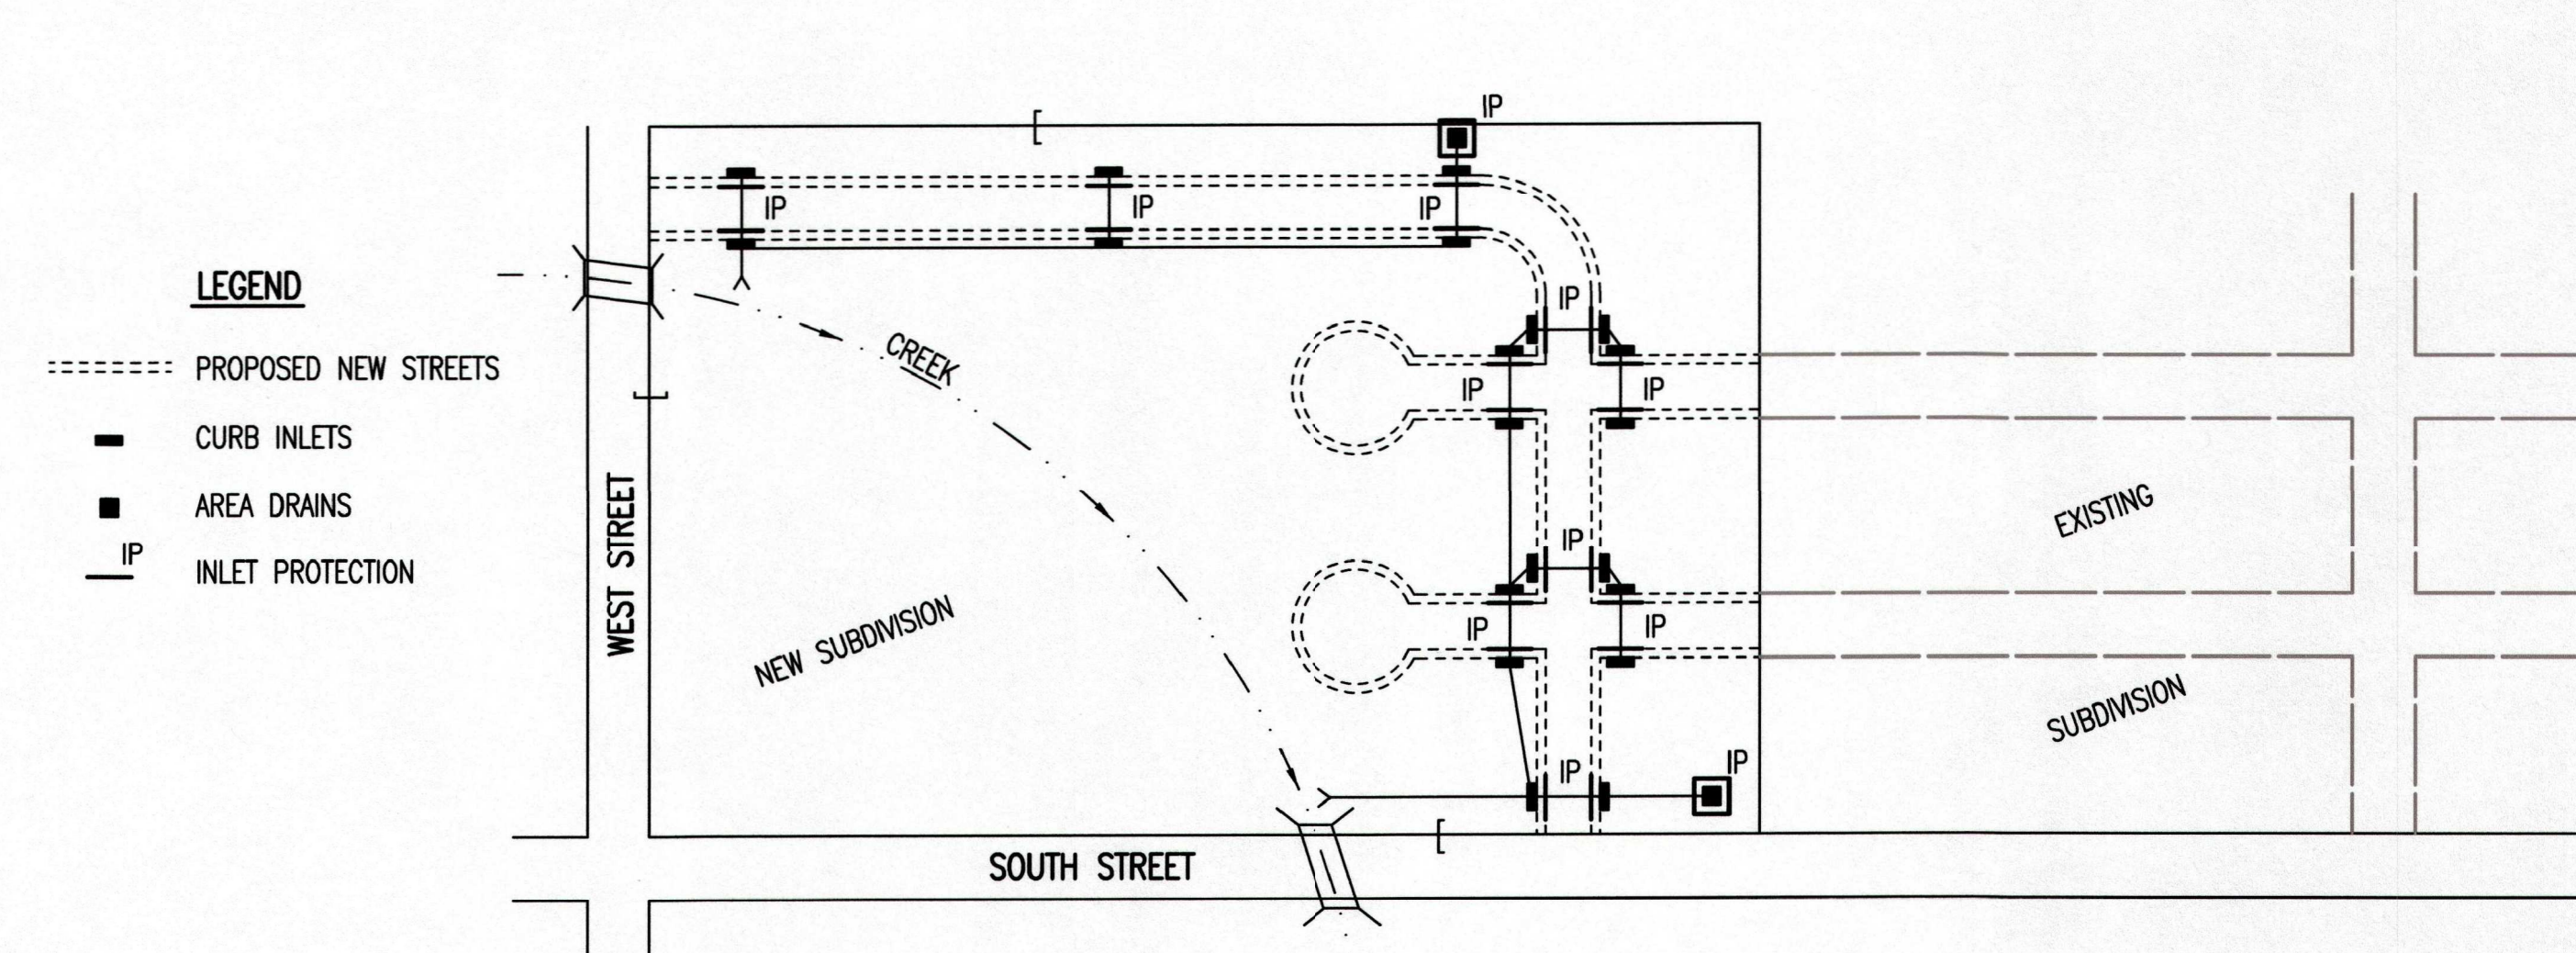

- DURING THIS PHASE OF SUBDIVISION DEVELOPMENT, ALL EROSION CONTROL DEVICES REQUIRED IN PHASE 1 SHALL REMAIN IN PLACE AND BE MAINTAINED.
- AS NEW STORM SEWERS, WITH INLETS, ARE INSTALLED, THE STORM SEWERS MUST NOW BE PROTECTED SO ALL NEW INLETS BECOME POINTS OF COMPLIANCE.
- AREA DRAINS – AS SOON AS WATER CAN FLOW INTO THESE DRAINS, HAY BALE OR SILT FENCE PROTECTION WILL BE INSTALLED AROUND THEM.
- CURB OPENING INLETS – AS SOON AS WATER CAN FLOW INTO THESE DRAINS, INLET PROTECTION DEVICES MUST BE INSTALLED. IF WATER CANNOT FLOW INTO CURB INLETS UNTIL STREET CONSTRUCTION IS COMPLETE, THEN STREET CONTRACTOR WILL INSTALL INLET PROTECTION. SEE PHASE 3 – STREET CONSTRUCTION.
- THE STORM SEWER CONTRACTOR WILL BE RESPONSIBLE FOR INSTALLING THESE DEVICES.
- THE SUBDIVISION DEVELOPER WILL MAINTAIN THESE EROSION CONTROL DEVICES ONCE INSTALLED.
- ALL DISTURBED GROUND WILL BE FINAL GRADED AND TEMPORARILY OR PERMANENTLY SEEDED WITHIN 14 DAYS IF COMPLETION OF WORK IN ANY GIVEN PART OF THE SUBDIVISION.
- ONCE ALL DISTURBED GROUND DRAINING TO AN INLET HAS BEEN RESTABILIZED WITH GRASS OR SOD, THE SUBDIVISION DEVELOPER WILL BE RESPONSIBLE FOR PERMANENTLY REMOVING THE INLET PROTECTION.

**GENERAL NOTES**



- THE INTENT OF ALL EROSION CONTROL DEVICES IS TO PREVENT ERODED SOIL FROM ENTERING DITCHES, STORM SEWERS, LAKES, STREETS OR ANY OTHER DRAINAGE FEATURE.
- THIS SHEET IS INTENDED TO PROVIDE GUIDELINES AS TO WHAT TYPE OF EROSION CONTROL DEVICES WILL BE INSTALLED DURING THE CONSTRUCTION PROCESS. CONTRACTORS ARE EXPECTED TO BID PROJECTS ACCORDINGLY.
- EROSION CONTROL DEVICES SHALL BE MAINTAINED DURING THE CONSTRUCTION PROCESS TO REMAIN EFFECTIVE. MAINTENANCE SHALL BE AS INDICATED ON SOIL EROSION BMP'S DETAIL SHEETS.
- PERSONS DESTROYING EROSION CONTROL DEVICES SHALL BE RESPONSIBLE FOR IMMEDIATELY REPAIRING THEM OR INSTALLING SUITABLE REPLACEMENT DEVICES.
- THE DEVELOPMENT OF ANY SUBDIVISION THAT DISTURBS 1 ACRE OR MORE WILL REQUIRE A FEDERAL/STATE NPDES STORMWATER PERMIT. THE PREPARATION OF A STORMWATER POLLUTION PREVENTION PLAN IS REQUIRED. EROSION CONTROL DEVICES ARE REQUIRED. THE DETAILS SHOWN ON THIS SHEET ARE THE MINIMUM STANDARDS TO BE SHOWN ON POLLUTION PREVENTION PLANS.
- FOR SUBDIVISIONS SMALLER THAN 1 ACRE, SOIL EROSION DEVICES ARE REQUIRED. ALSO, DEVELOPERS AND CONTRACTORS ARE ENCOURAGED TO DEVELOP POLLUTION PREVENTION PLANS FOR EACH PROJECT PRIOR TO CONSTRUCTION.
- FAILURE TO USE AND MAINTAIN SOIL EROSION DEVICES IS A VIOLATION OF SECTION 16.32 OF THE CITY CODE AND WILL SUBJECT THE SUBDIVISION DEVELOPER AND CONTRACTORS TO THE PENALTIES PROVIDED THEREIN.
- THE APPLICATION OF EROSION CONTROL DEVICES SHOWN ON THIS SHEET IS FOR SITUATIONS NORMALLY ENCOUNTERED. FROM TIME TO TIME, SITUATIONS WILL ARISE THAT MAY REQUIRE DEVICES OTHER THAN THAT SHOWN. EROSION CONTROL DEVICES, OTHER THAN THOSE SHOWN, MAY BE UTILIZED SO LONG AS THEY ARE EFFECTIVE AND MAINTAINED.
- A STABILIZED EARTH SURFACE IS DEFINED AS ONE THAT IS HARD SURFACED WITH CONCRETE, ASPHALT, OR THE LIKE, OR ONE ON WHICH 70% OF THE GRASS HAS GERMINATED ON THE ENTIRE SURFACE.

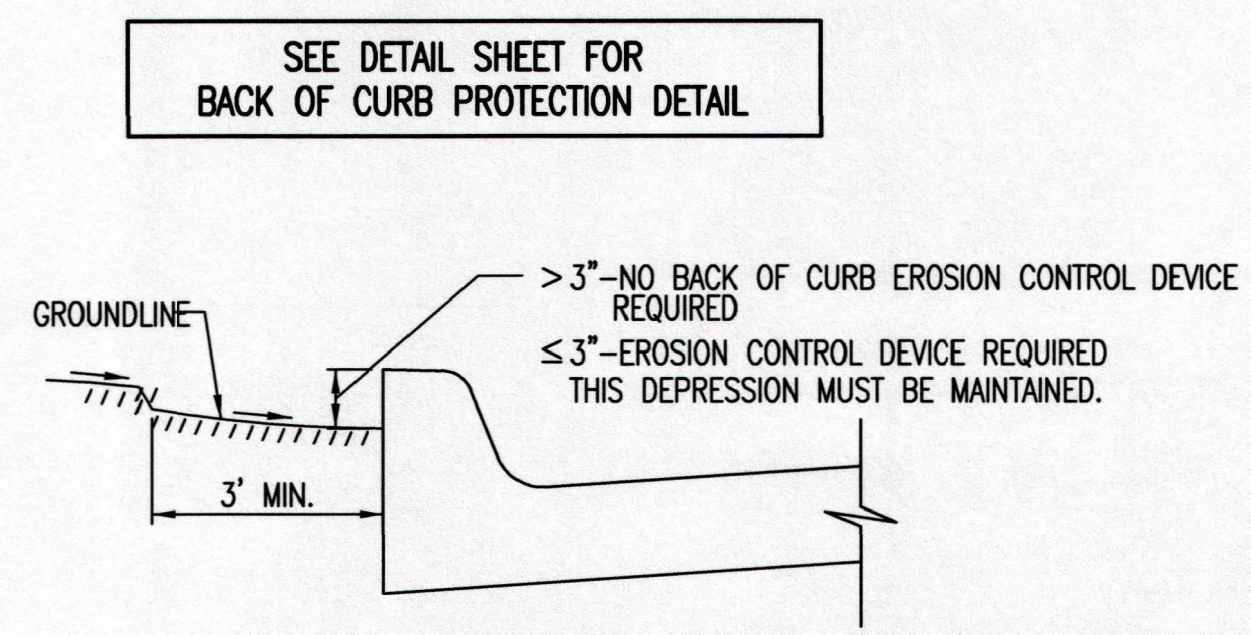

**CURB BACKFILL DETAIL (STREET CONSTRUCTION ONLY)**

THIS IS A TEMPORARY MEASURE ONLY, WHEN APPROVED BY THE PROJECT ENGINEER. THE DIRT GRADE BEHIND THE CURB SHALL BE BROUGHT TO THE TOP OF CURB, WITH TEMPORARY EROSION CONTROL MAT OR PERMANENT VEGETATION PLACED, PRIOR TO THE COMPLETION OF ALL PROJECTS.

REVISION DATE: MAY 2013

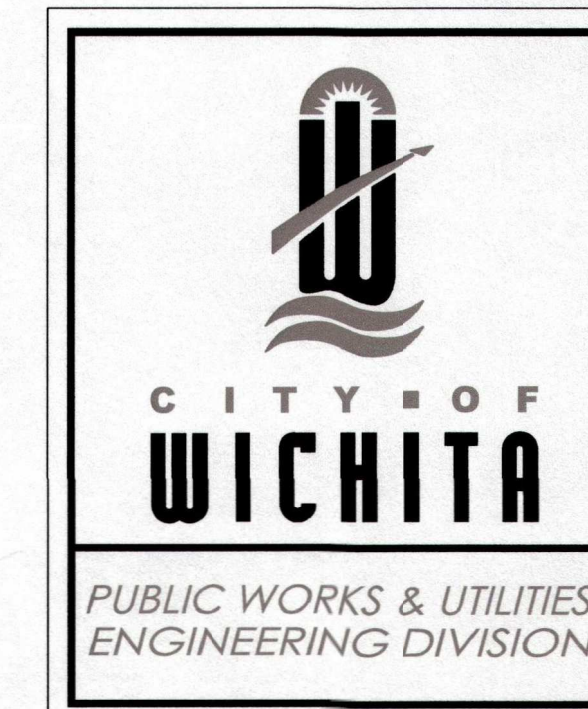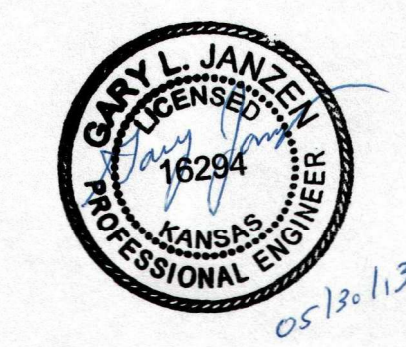

<b>SUBDIVISION DEVELOPMENT PROCESS</b>		
CITY ENGINEER <b>GARY JANZEN, P.E.</b>		
PROJECT NUMBER 2028 PPW	OCA NUMBER (607853)	DATE
CITY ENGINEER'S OFFICE CITY HALL - SEVENTH FLOOR 455 NORTH MAIN STREET WICHITA, KANSAS 67202-1620 (316) 268-4501		SHEET

SW-505

**HAMPTON INN  
CADILLAC LAKE  
WICHITA, KANSAS**



**LKArchitecture**



Architecture • Engineering • Planning • Interior Design • Landscape Architecture

**LKArchitecture, Inc.**  
345 Riverview Wichita, KS 67203  
T 316.268.0230 F 316.268.0205  
CONTACT: PEC  
DRAWN: PEC  
CHECKED: PEC  
PROJECT NUMBER:  
**15433**  
SHEET TITLE:  
EROSION CONTROL DETAILS  
SHEET NUMBER:  
**C5.06** OF: X

Sheet: 08-27-2016, 1:06:17 PM, by CSI  
Plot: State 11, 11-30-2016, 8:28:32 AM, by CSI  
U:\Wichita-Cad\160551\1000\Main\Drawings\160551-000-C5-06-EROSION CONTROL DETAILS

