

**GENERAL NOTES:**

- The Contractor shall comply with all applicable safety regulations. All construction shall be completed following current City Standard Specifications and Special Provisions.
- Contractor will be required to provide notice to utility companies a minimum of seventy-two (72) hours prior to any excavation, as follows:  
Kansas One-Call 687-2470  
The Contractor must notify the following in case of an emergency:  
Cox Communications 260-7204  
Kansas Gas Service 1-888-482-4950  
Westar 383-8600  
AT&T 1-800-286-8313  
City of Wichita Water Department 262-6000  
City of Wichita Sewer Maintenance 262-6000
- Utility service lines, poles, etc. are to be adjusted as necessary by others prior to construction unless the plans specifically call for their adjustment by the Contractor or unless the plans specifically identify a utility to be adjusted by its owner during construction. Existing utilities and their location, as shown on the plans, represent the best information obtainable for design. The Contractor will be required to work around existing utilities within the right-of-way which do not conflict with proposed construction.
- Rubble from the removal of miscellaneous structures and excess excavation which is to be wasted shall be disposed of on sites to be provided by the Contractor. These sites shall be approved by the Engineer as to suitability, appearance and site location. Locations, in the opinion of the Engineer, that will leave an unsightly appearance will not be approved. All disposal sites must be approved by the Kansas Department of Health and Environment. Material either stockpiled or disposed of in a flood plain would require a Kansas State Board of Agriculture permit. Any material dumped in waters of the United States or wetlands is subject to U.S. Corps. of Engineers permitting regulations. Any material buried or stockpiled beyond approved construction limits would require additional archaeological investigations unless buried in a previously approved borrow location.
- Trees and shrubs in public right-of-way which are in direct conflict with proposed new construction shall be removed by the Contractor with the Engineer's approval. Trees and shrubs which are not in direct conflict with proposed new construction shall be saved and protected from damage.
- The Contractor shall give all property owners and/or tenants of developed property abutting the construction of this project a minimum of ten (10) days notice prior to start of construction.
- The Contractor shall be responsible for preserving property irons. The Contractor will be required to re-establish any property irons which are damaged or destroyed by his construction operations. Such irons shall be re-established by a licensed land surveyor in accordance with state laws.
- The Water Distribution Division shall field locate water valves one time during construction when requested by the Contractor. It shall be the Contractor's responsibility to preserve such field locations during the construction process. Water valves, valve boxes or fire hydrants damaged during construction shall be repaired by Contractor at his own expense. Valve boxes and water meters within the project limits shall be adjusted to match field grades.
- The Contractor shall notify the consultant engineer and Tom Mason with the City at 316-268-4574 with the anticipated construction start date and notify them of project completion. Staking and inspection for this project will be the responsibility of the Contractor.
- If traffic is impacted by construction, a traffic control plan must be submitted and approved by the City Traffic Engineer, Bran Coon at [traffic@wichita.gov](mailto:traffic@wichita.gov) before construction can begin. The Contractor shall be responsible for all traffic control measures to facilitate construction. All construction zone markings and signage shall conform to the latest version of the Manual on Uniform Traffic Control Devices (MUTCD) as published by the US Dept. of Transportation, Federal Highway Administration. All costs associated with construction markings and signage shall be the Contractors responsibility.
- All elevations shown are NAVD88 Datum.
- All areas disturbed during construction that will not be under proposed pavement shall be restored to match existing conditions.


- A portion of excess excavated material shall be mounded around manholes which extend more than one (1) foot above the existing ground. Such mound shall be constructed with new development a six (6) foot diameter flat top with 4 to 1 side slopes down to the original ground. The elevation of the flat top of the mound shall be 0.4 foot below the top to the manhole.
- Geotechnical report available upon request.
- Contractor shall limit the extent of trench openings overnight and weekends to less than 50 feet.
- Contractor shall provide positive drainage away from all manhole covers.
- Storm Sewer System is privately owned and maintained.
- Any sidewalk, drive approach, or street pavement removed to construct project must have a pavement cut permit and be replaced by the City contractor. Permits can be obtained by calling 316-268-4501 or 316-268-4480.
- The inspecting firm shall submit to the City Stormwater Maintenance Division a digital copy of the CCTV inspection of the conduits and structures following construction. The digital file formation shall be compatible with the City input template. A copy of the template is available upon request at 316-268-4090.

**PRIVATE STORM WATER**  
to serve  
**FOLEY EQUIPMENT**  
**1550 S. WEST STREET**  
**CITY OF WICHITA, KANSAS**



Gary Janzen, P.E. City Engineer  
Project Number  
0390 PPD (607861)

AS BUILT PLANS  
CONTRACTOR: PEARSON CONSTRUCTION  
INSPECTOR: LEVI TURNER  
RUGGLES & BOHM  
PDF BY: LCT 08/10/2016

PROJECT LOCATION

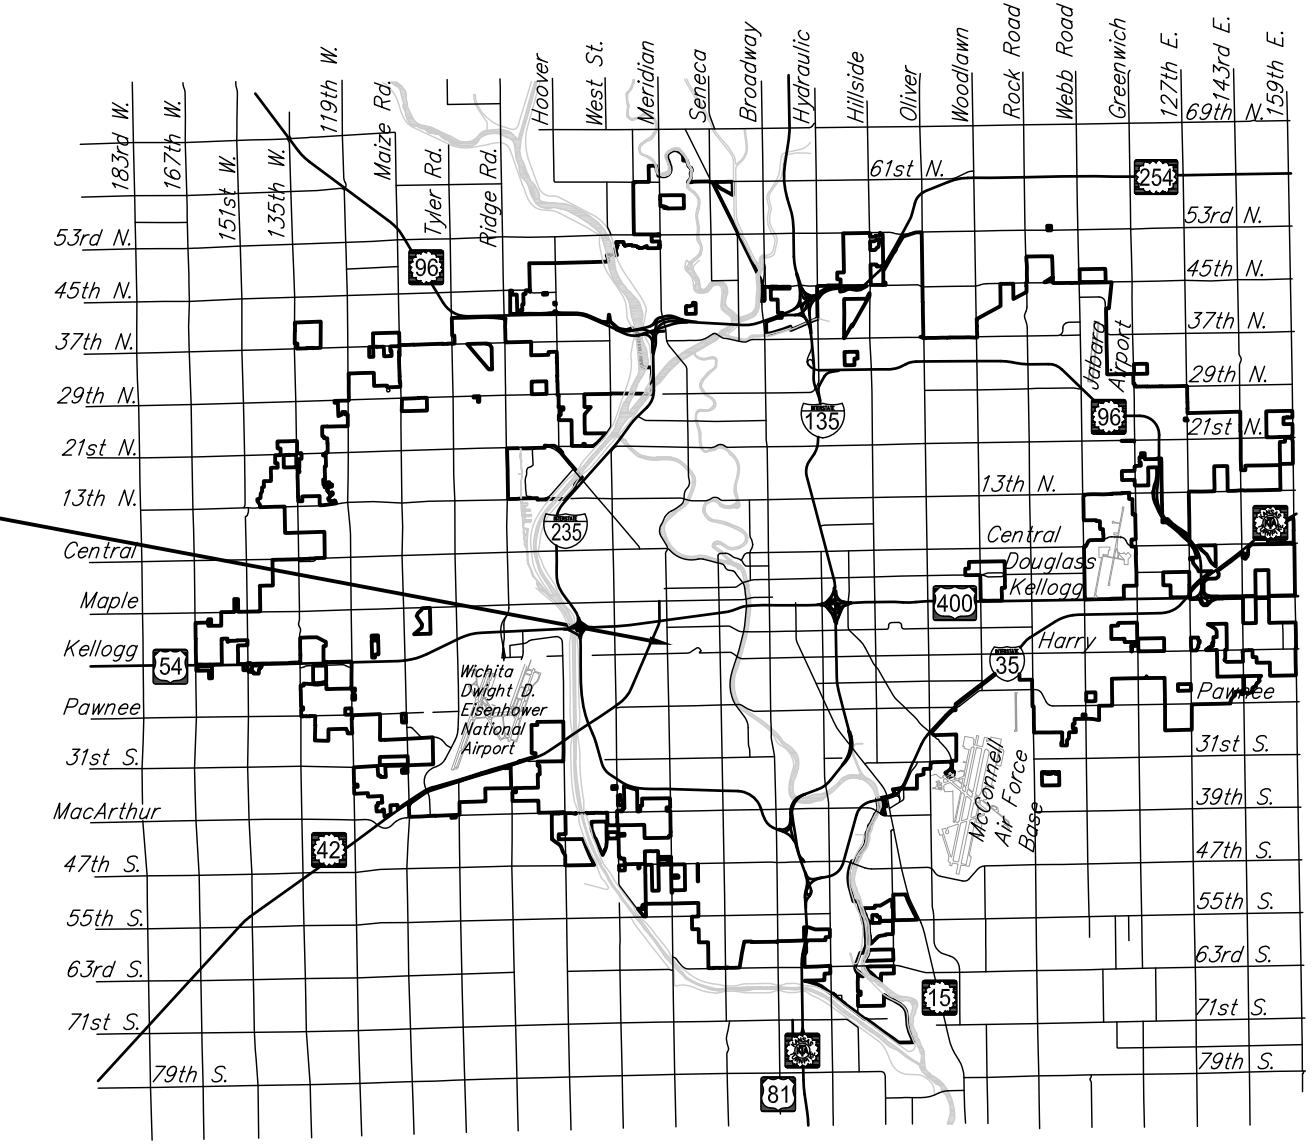

Vicinity Map

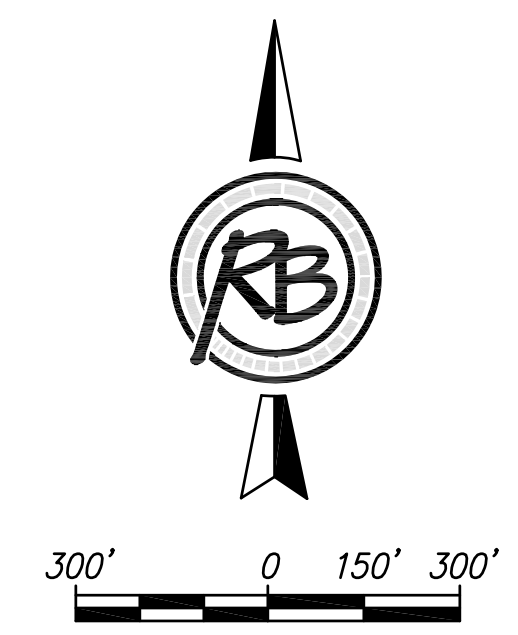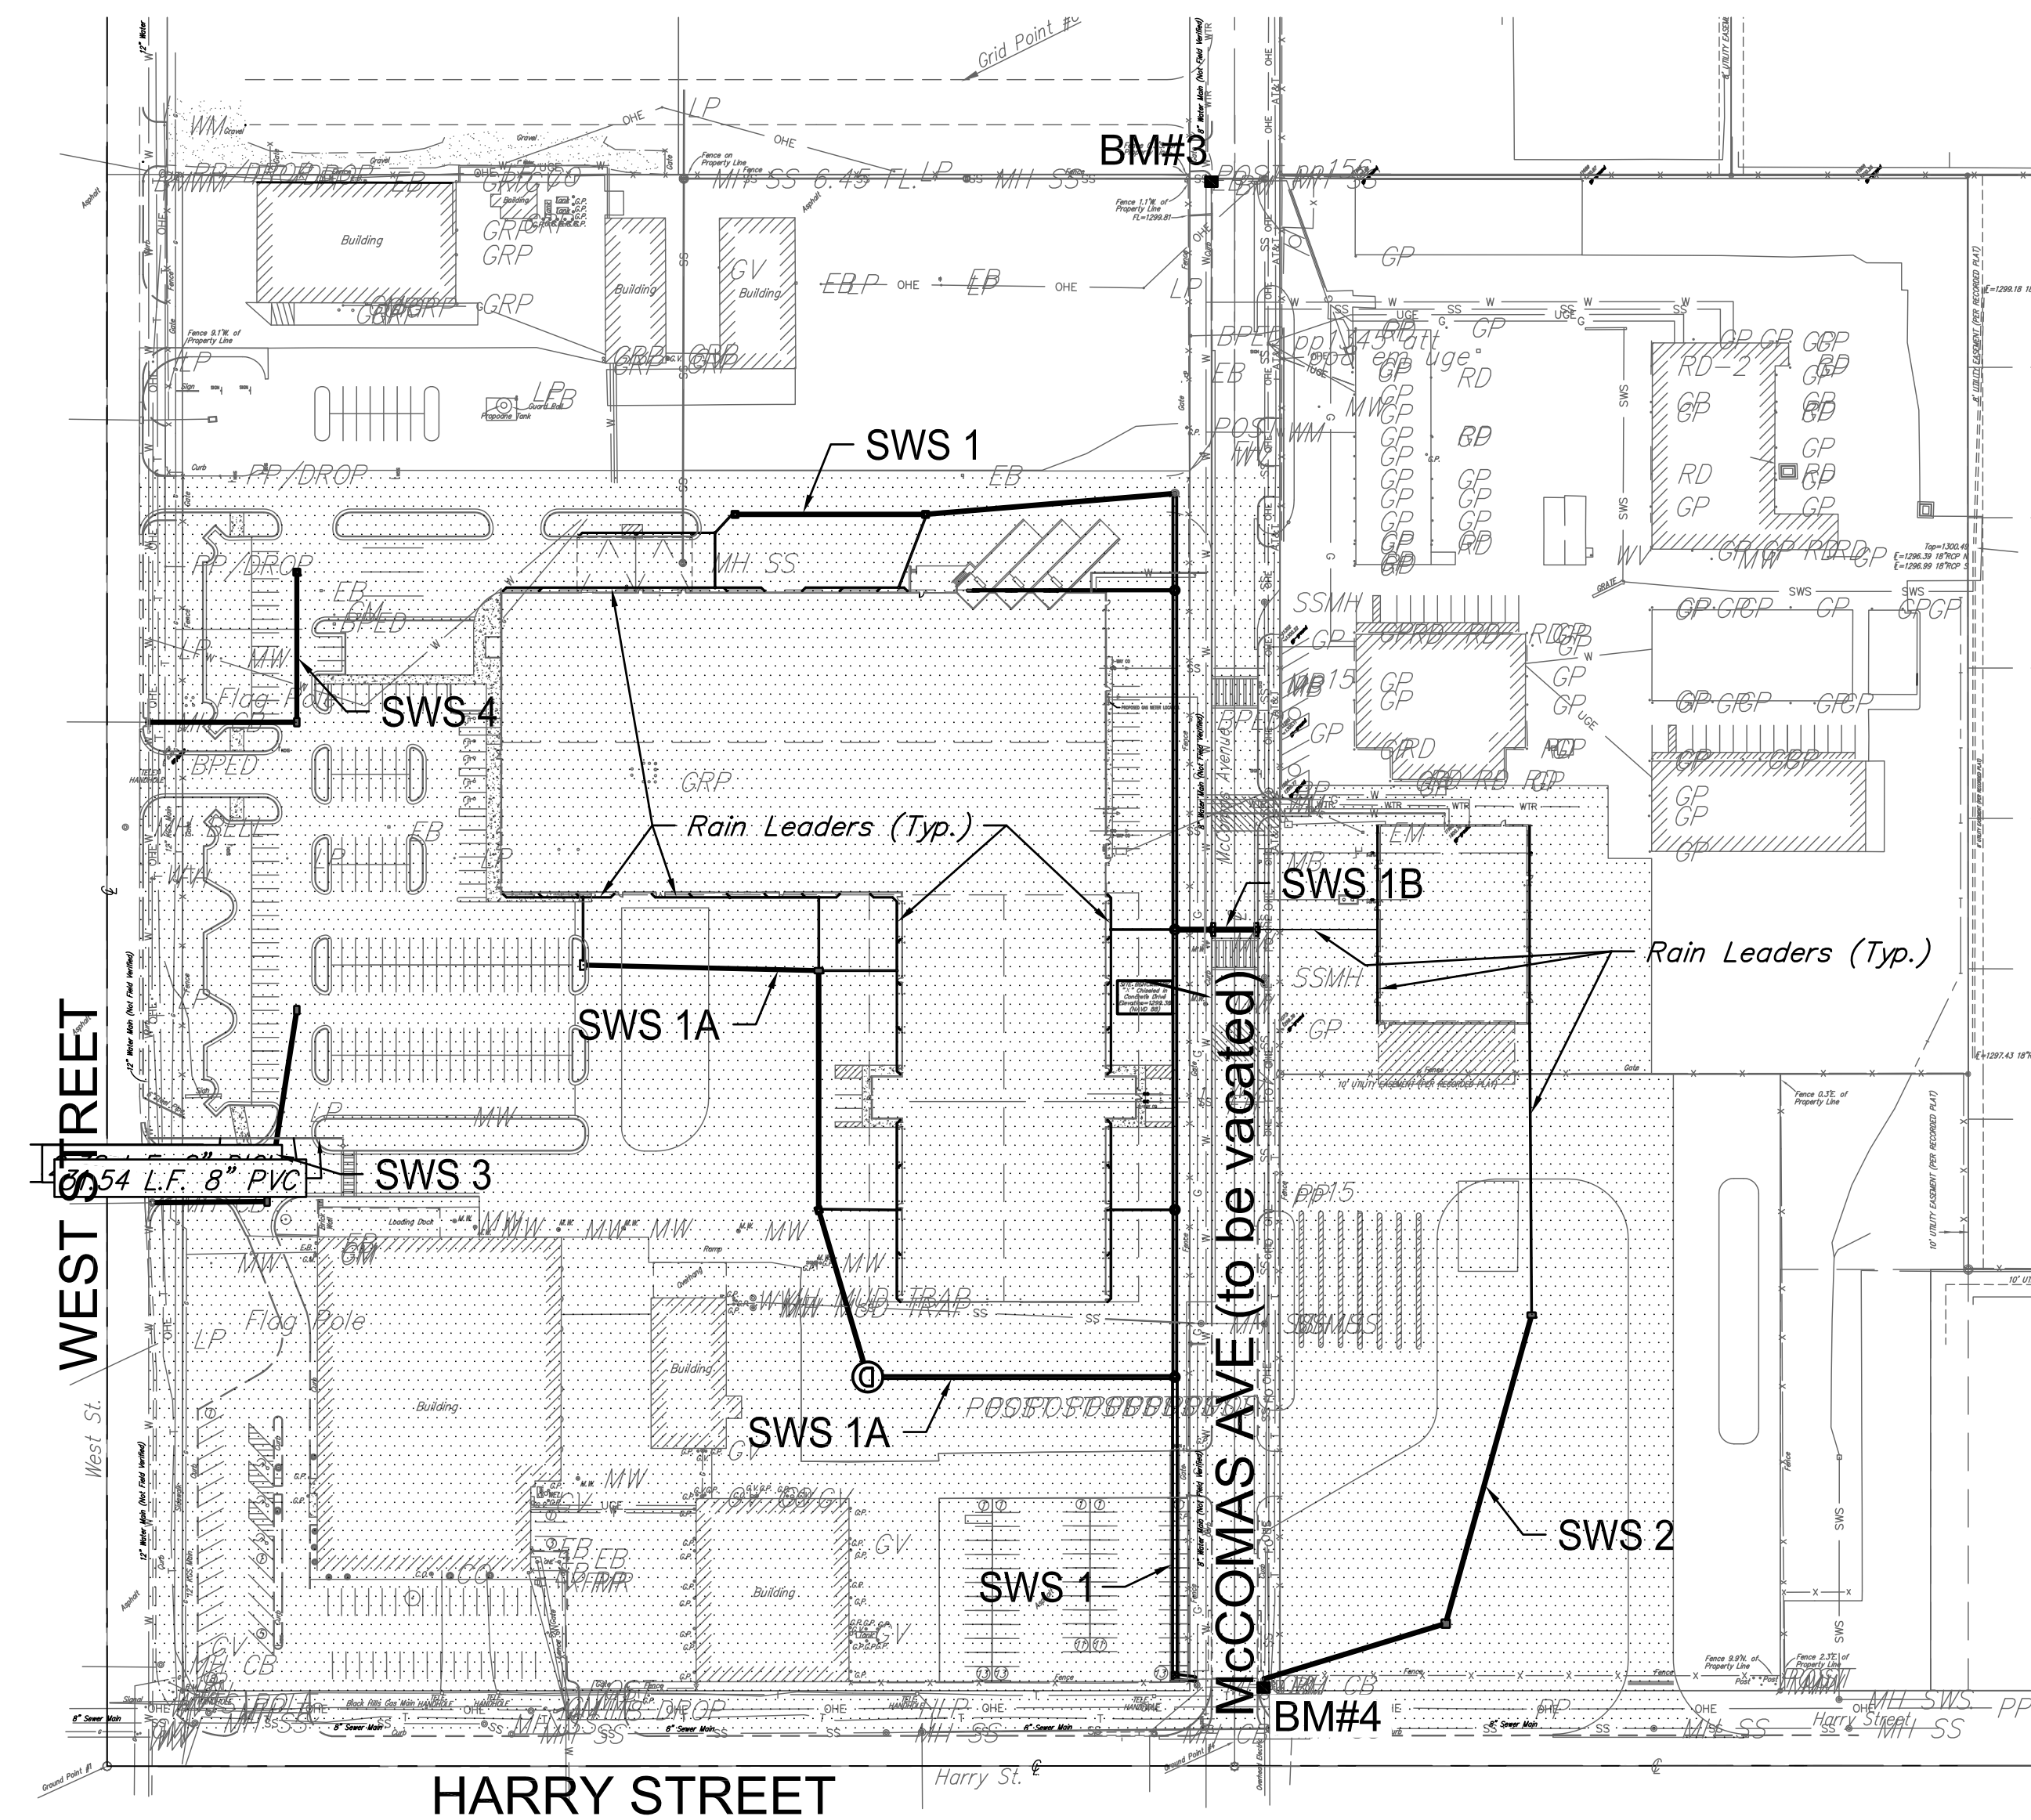

**Sheet Index**

- TITLE SHEET
- 9. PLAN & PROFILES
- EROSION CONTROL PLAN
- PRECAST MANHOLE DETAILS
- MH FRAME & COVER DETAILS
- REINFORCED CONCRETE MH
- SNOUT DETAILS
- ERU PLAN

Erosion Control Details SW-501 thru SW-505 are available on the City's website.



APPROVED AS NOTED  
BY WICHITA PUBLIC WORKS ENGINEERING  
AND STORMWATER DIVISION

Engineering *Rebecca Sivil 4/29/16*  
Stormwater *Joe Hinkle PE 5/13/16*

NOTE TO CONTRACTORS

Installation, inspection and testing for this project is to be provided by a Licensed Consulting Engineering Firm under contract with the Owner/Developer. Said inspection to be in accordance with the City of Wichita standard construction engineering practices and certified by a Licensed Professional Engineer in the state of Kansas. No work shall be performed the Contractor without such inspection nor shall any work be commenced without written authorization by the City Engineer. All Construction and Materials shall comply with the current City of Wichita Specifications and Standards and Special Provisions. (on file and available at Wichita.gov).

An approved copy of these plans signed by City staff are required on-site.

**Benchmarks**

BENCHMARK:  
BM#3  
CHISELED SQUARE ON THE TOP OF CURB  
14.5' EAST & 4.5' SOUTH OF THE N.E. CORNER PARCEL #1  
ELEVATION = 1299.98 (NAVD88)

BENCHMARK:  
BM#4  
CHISELED SQUARE ON THE TOP OF SWS INLET 11.4' WEST & 2'  
NORTH OF THE SW CORNER PARCEL #2  
ELEVATION = 1299.05 (NAVD88)

IMPROVEMENT DISTRICT

NOTE:  
THE CURRENT MCCOMAS STREET R/W HAS BEEN DEDICATED AS A DRAINAGE & UTILITY EASEMENT AS A REQUIREMENT OF THE STREET VACATION.

**Stormwater Certification:**  
New Development or Redevelopment

These construction plans were prepared in accordance with the current Stormwater Management Regulations as set forth in the City of Wichita's Stormwater Management Ordinance 16.32 and the policies/guidelines presented in the Wichita/Sedgwick County Stormwater Manual.


Disturbed Area = 14.2  
Water Quality Treatment: Snout Water Quality Hoods  
Downstream Channel Protection: N/A  
Detention: Not Required  
The BMP used for this development is Inlet Protection.

April 2016




PLANS PREPARED BY  
**RUGGLES & BOHM**

F:\Projects\Projects 4200-4299\42650 (Foley Equipment Drainage West St-Compus)\42650 Engineering Base.dwg

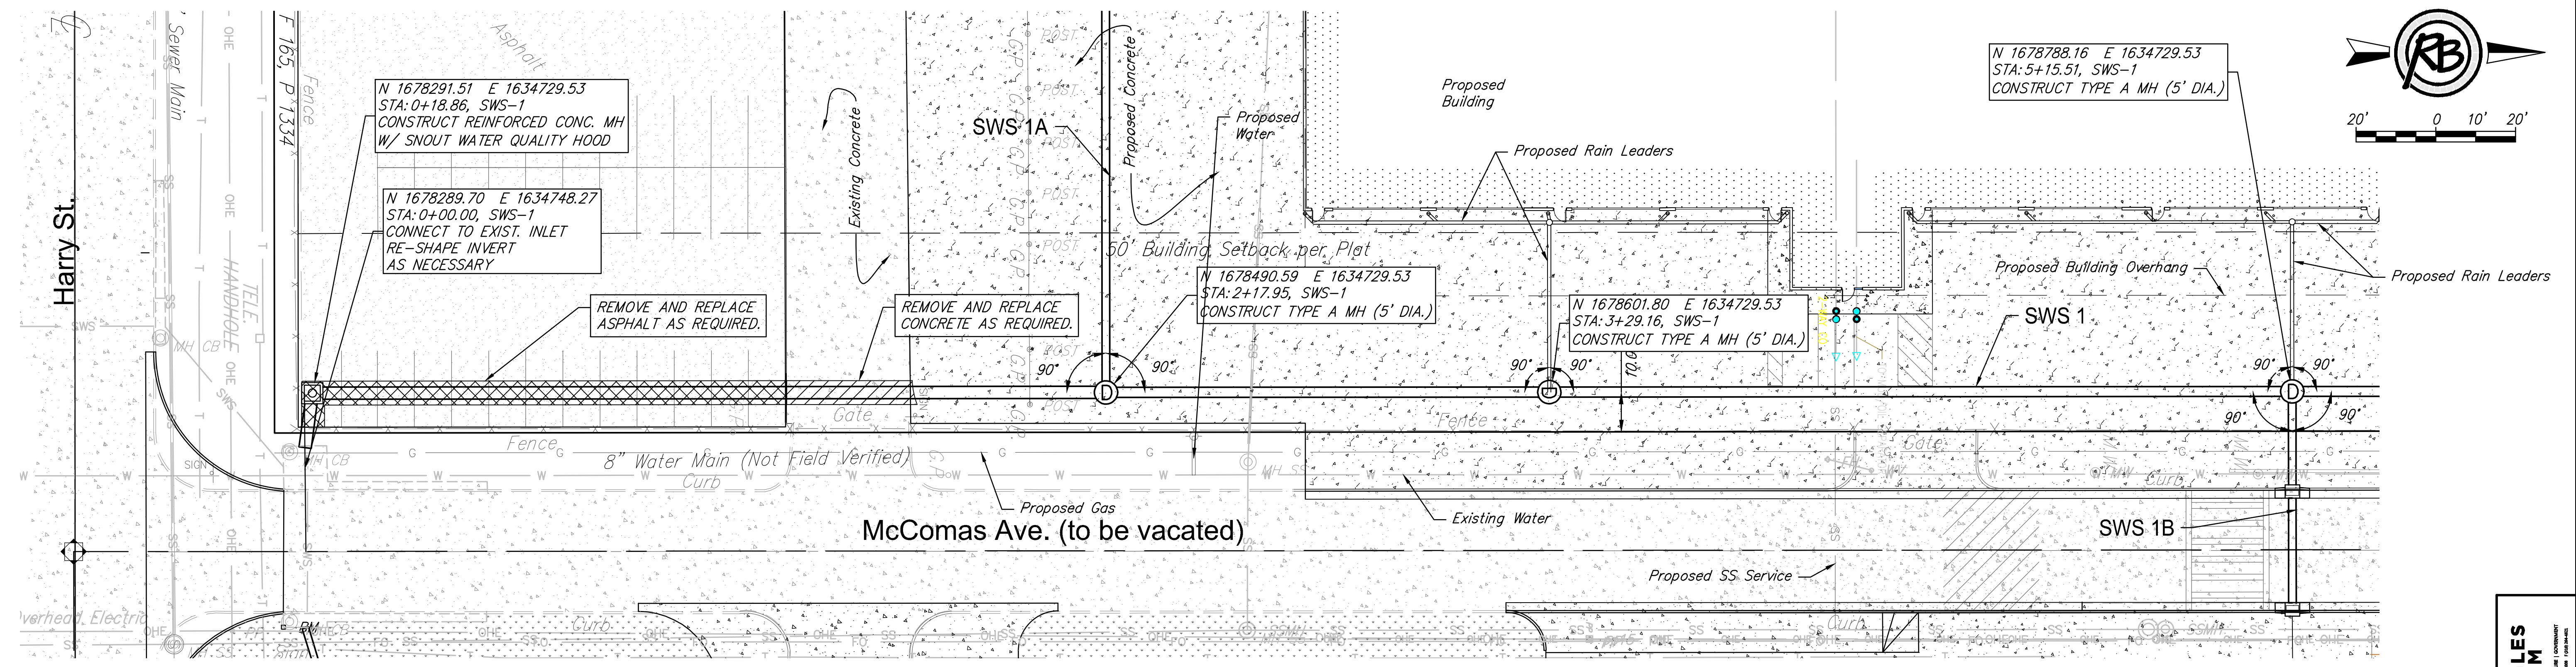

NOTE:  
Stubs for rain leaders may be deleted if rain leaders are installed at the same time as the storm sewer system.

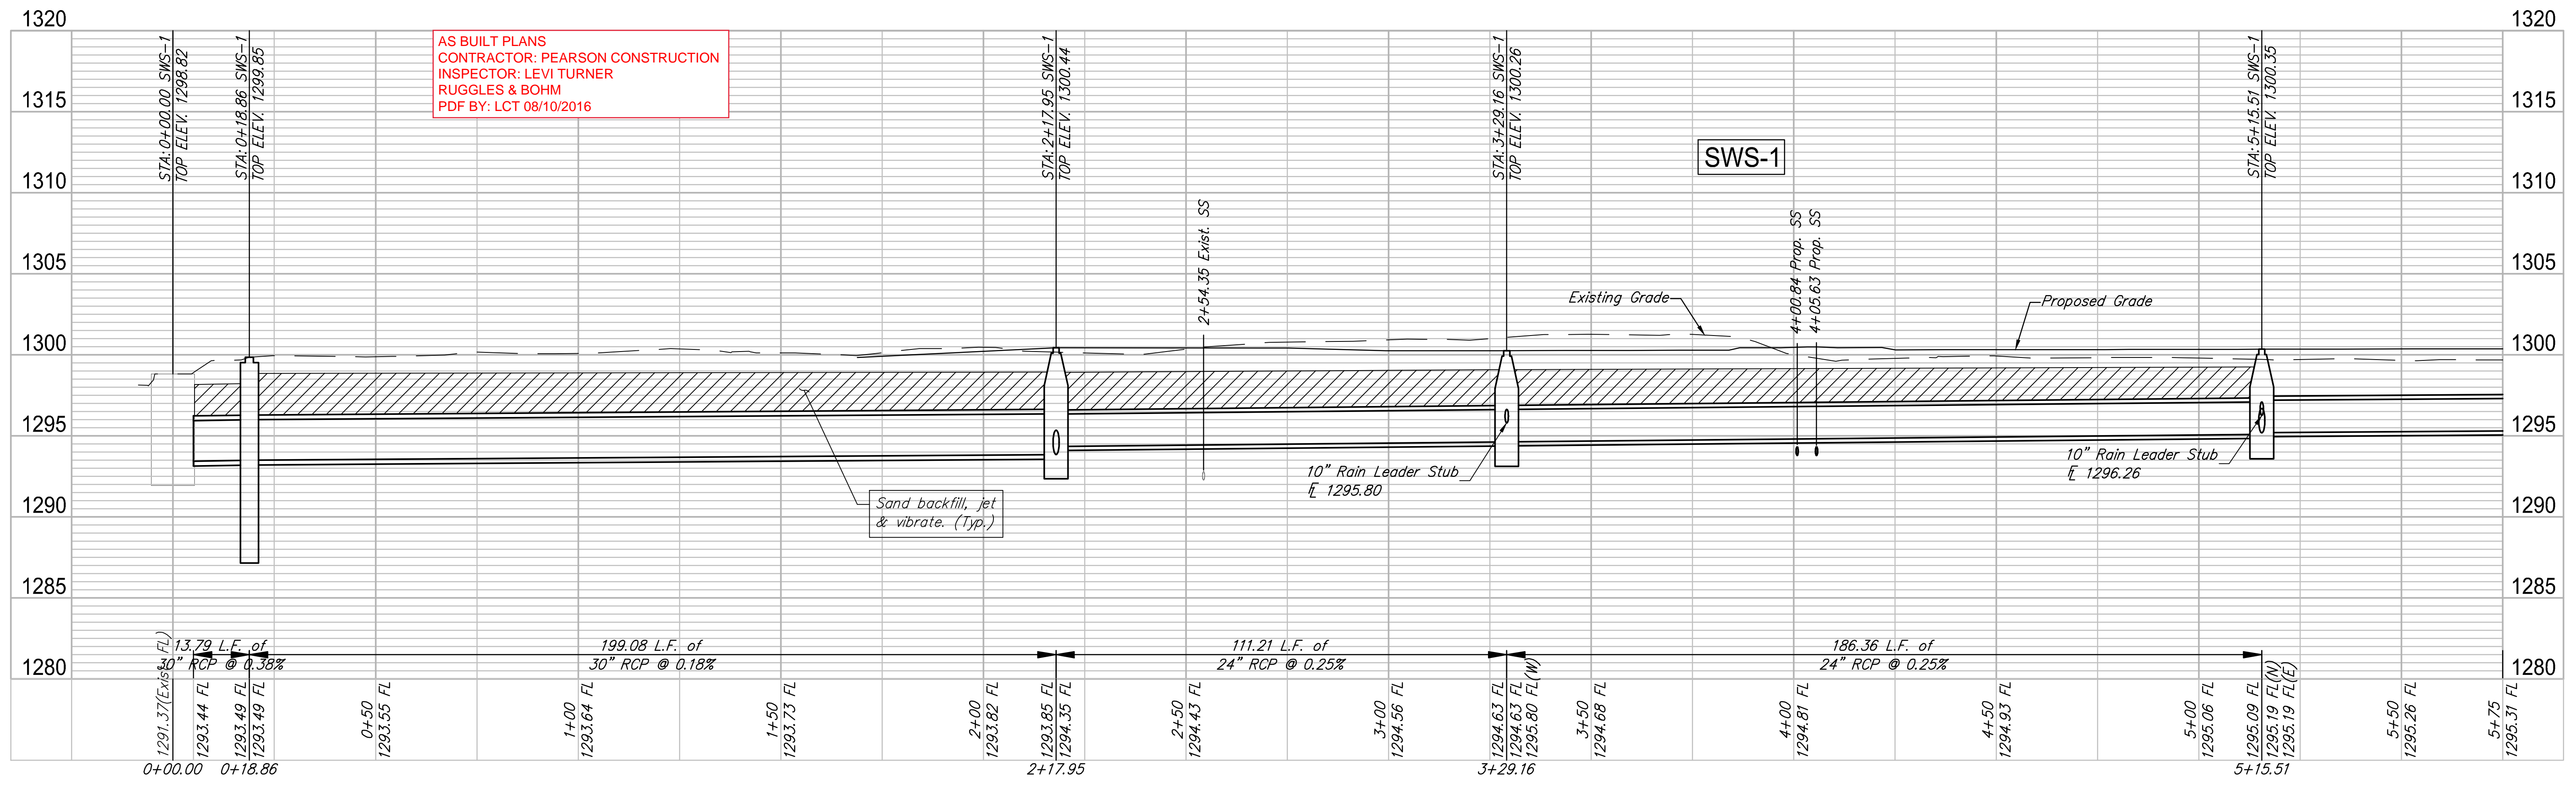

AS BUILT PLANS  
CONTRACTOR: PEARSON CONSTRUCTION  
INSPECTOR: LEVI TURNER  
RUGGLES & BOHM  
PDF BY: LCT 08/10/2016

**RUGGLES BOHM**  
ENGINEERING ARCHITECTURE LANDSCAPE ARCHITECTURE PLANNING  
1000 W. 17th St., Suite 100, Wichita, KS 67202  
PH: 316.261.1111 FAX: 316.261.1112



**FOLEY EQUIPMENT**  
**SWS-1**  
Wichita, Kansas

PROJECT NUMBER: 0390 PPD  
DESIGNING FILE: 42650 Engineering Base

DESIGN: KWL  
DRAWN: DRS

REVIEW: 3-2-2016  
DATE: 4-25-2016

RB JOB: 42650  
SHEET: 2  
OF: 15

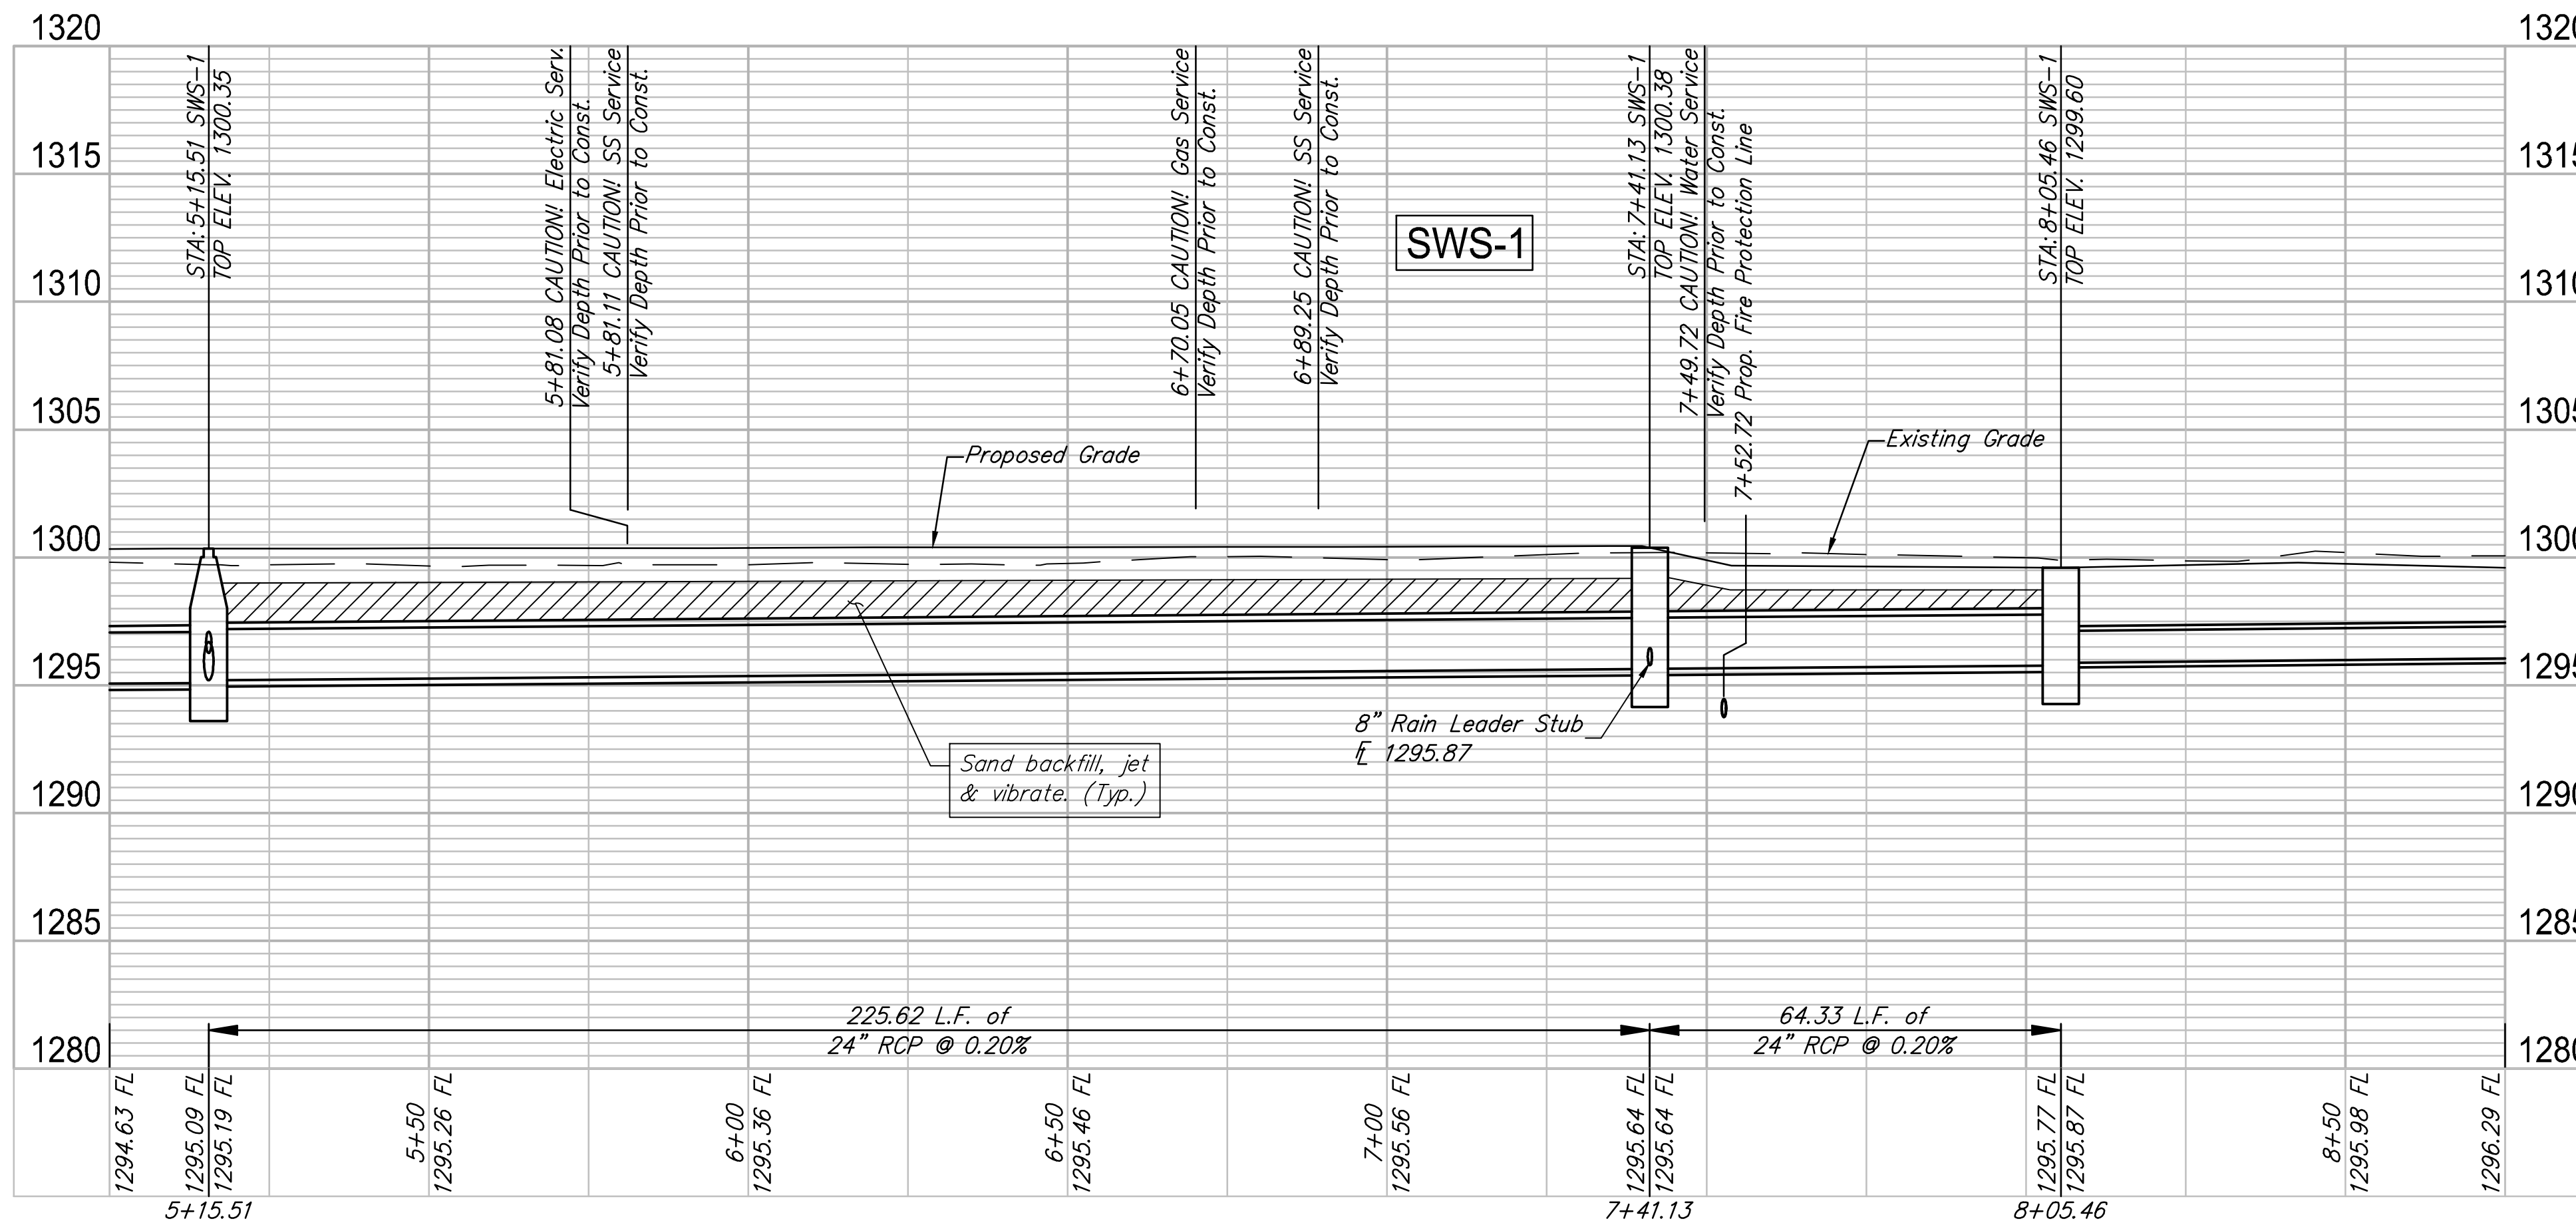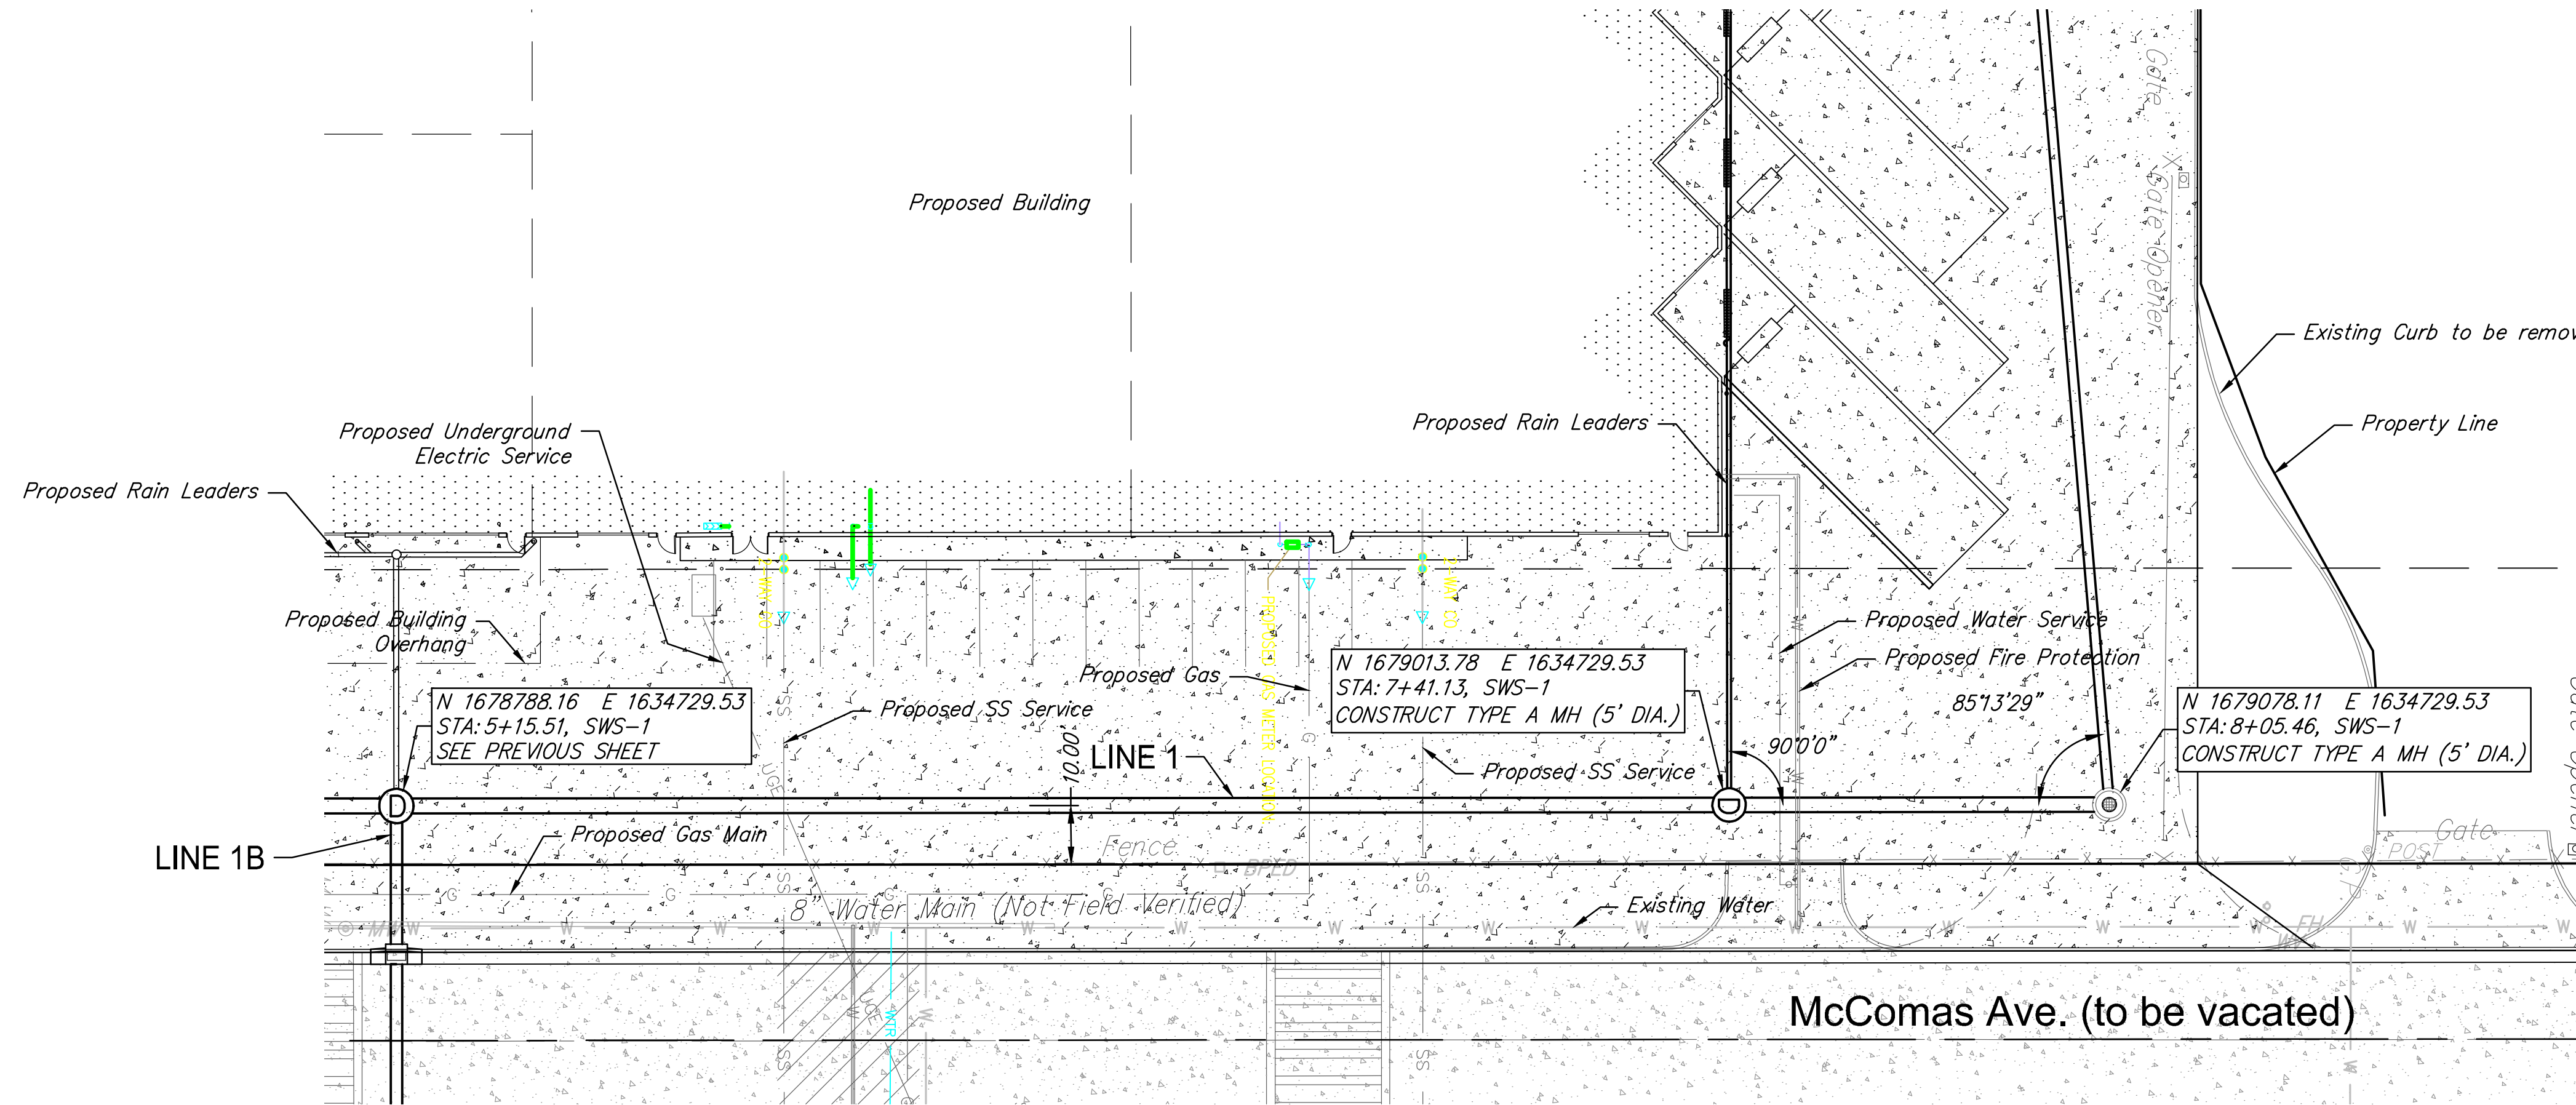

AS BUILT PLANS  
 CONTRACTOR: PEARSON CONSTRUCTION  
 INSPECTOR: LEVI TURNER  
 RUGGLES & BOHM  
 PDF BY: LCT 08/10/2016



**RUGGLES BOHM**  
 ARCHITECTS & ENGINEERS  
 1000 W. WASHINGTON ST., SUITE 100  
 WICHITA, KANSAS 67202  
 TEL: 316.262.1234 FAX: 316.262.1235

**FOLEY EQUIPMENT**  
**SWS-1 2**  
 Wichita, Kansas

PROJECT NUMBER: 0390 PPD  
 DESIGNER: KWL  
 DRAWING FILE: 42650\_Engineering\_Base  
 REVIEW: 3-2-2016  
 DATE: 4-25-2016  
 DESIGNER: DRS  
 DRAWN: DRS

RB JOB: 42650  
 SHEET: 3 OF 15

AS BUILT PLANS  
 CONTRACTOR: PEARSON CONSTRUCTION  
 INSPECTOR: LEVI TURNER  
 RUGGLES & BOHM  
 PDF BY: LCT 08/10/2016

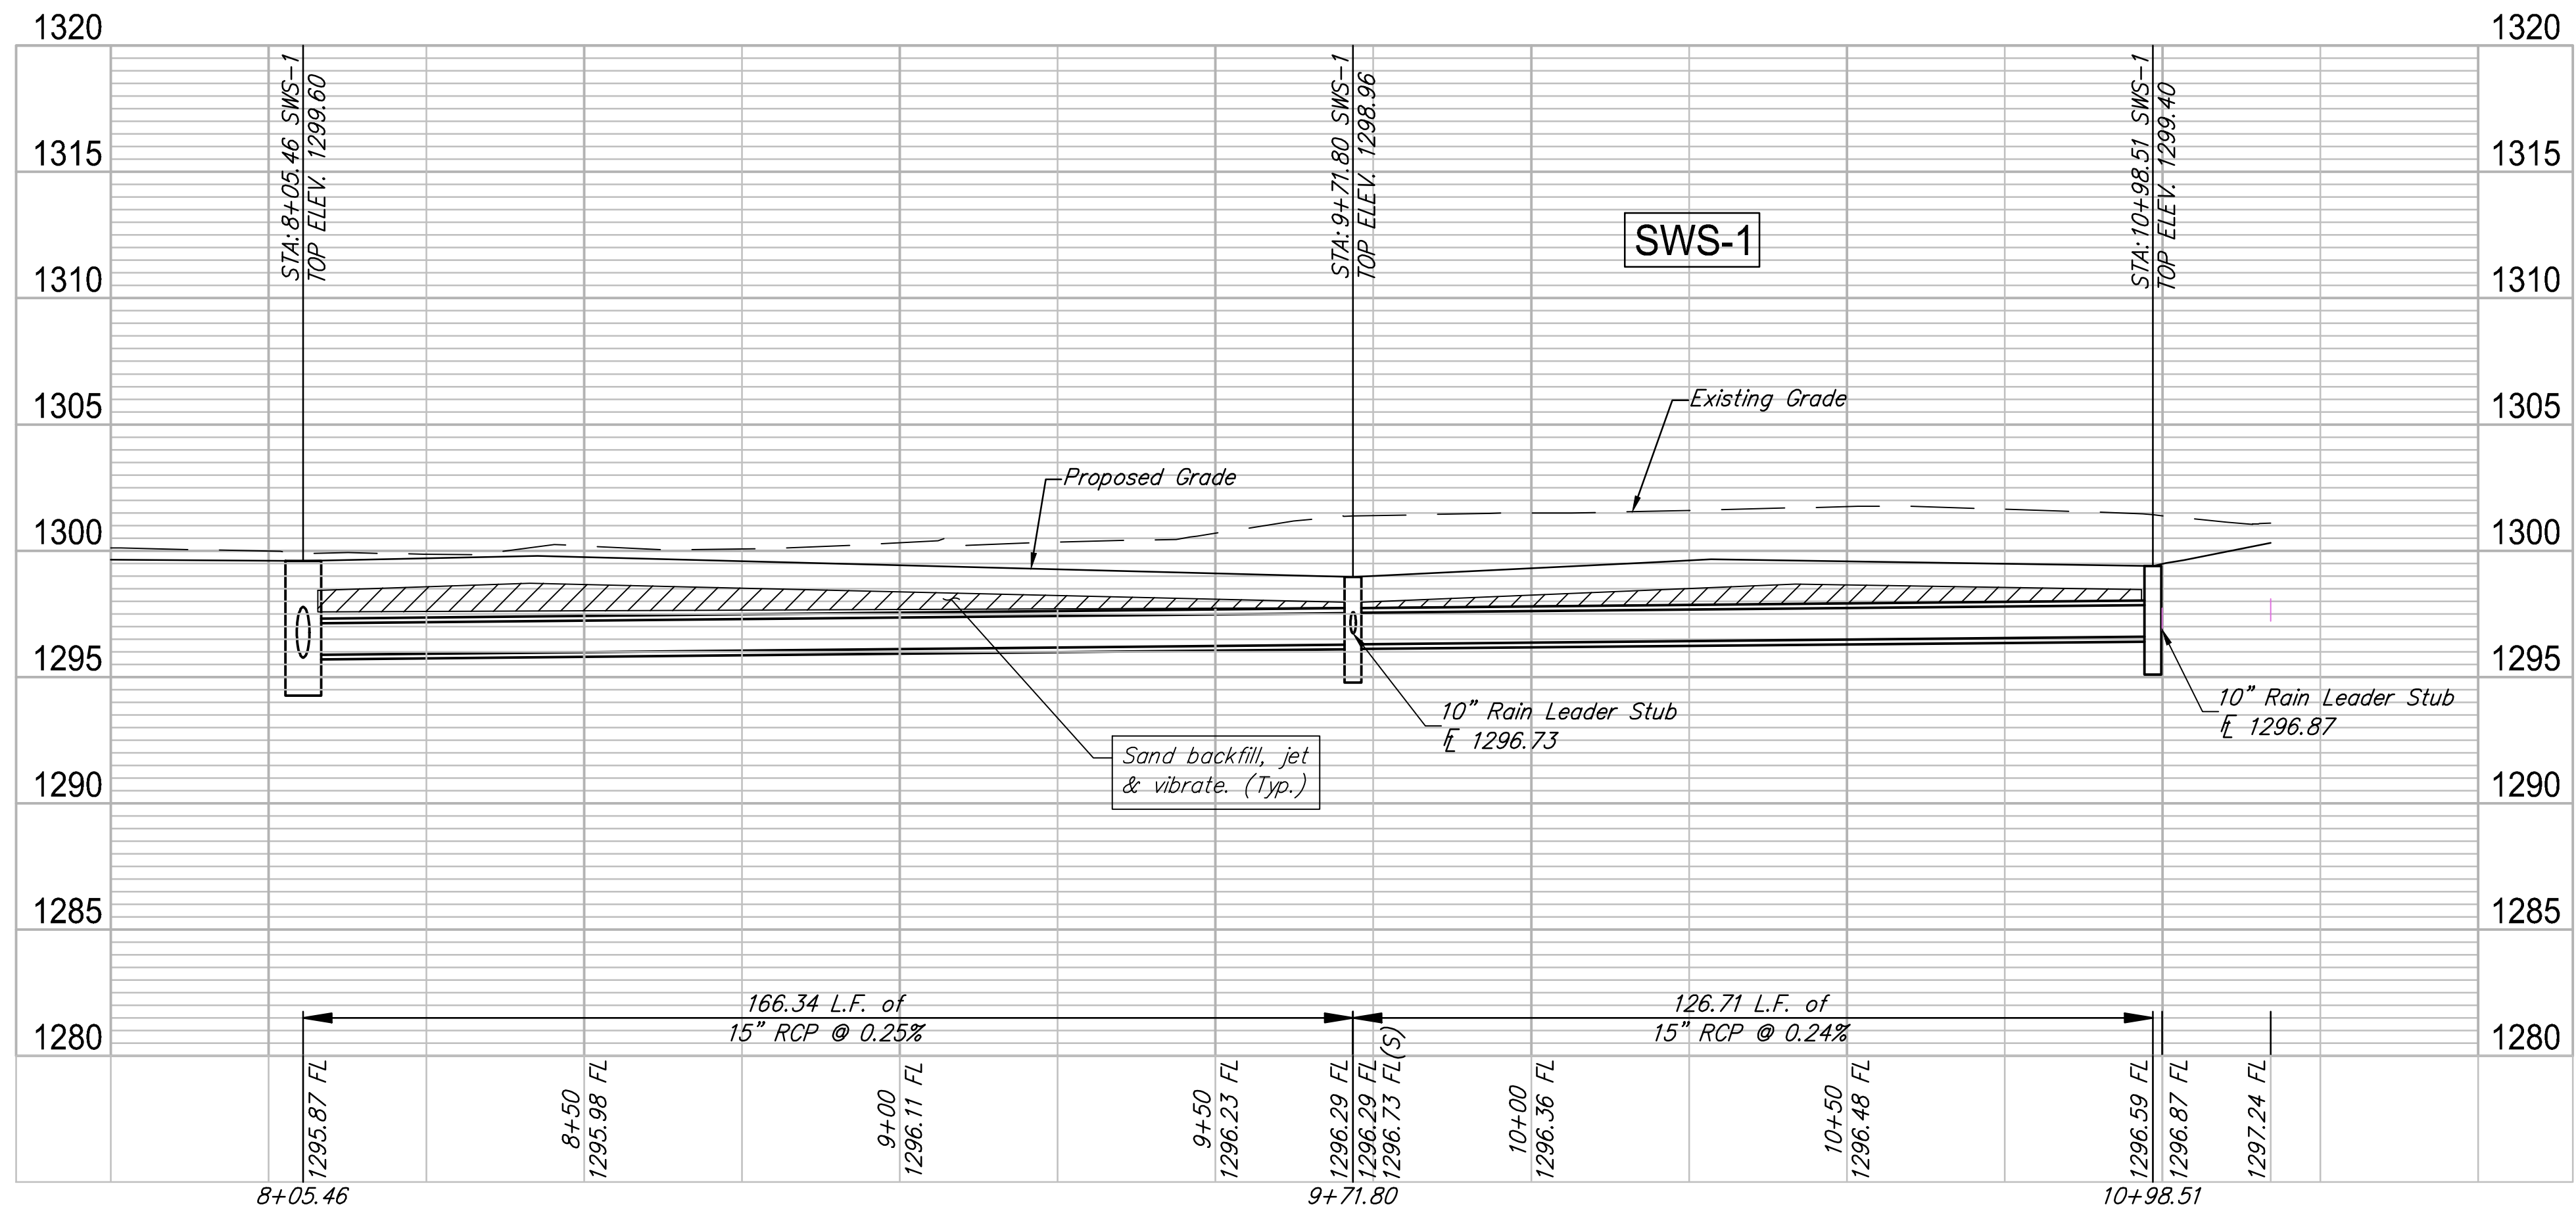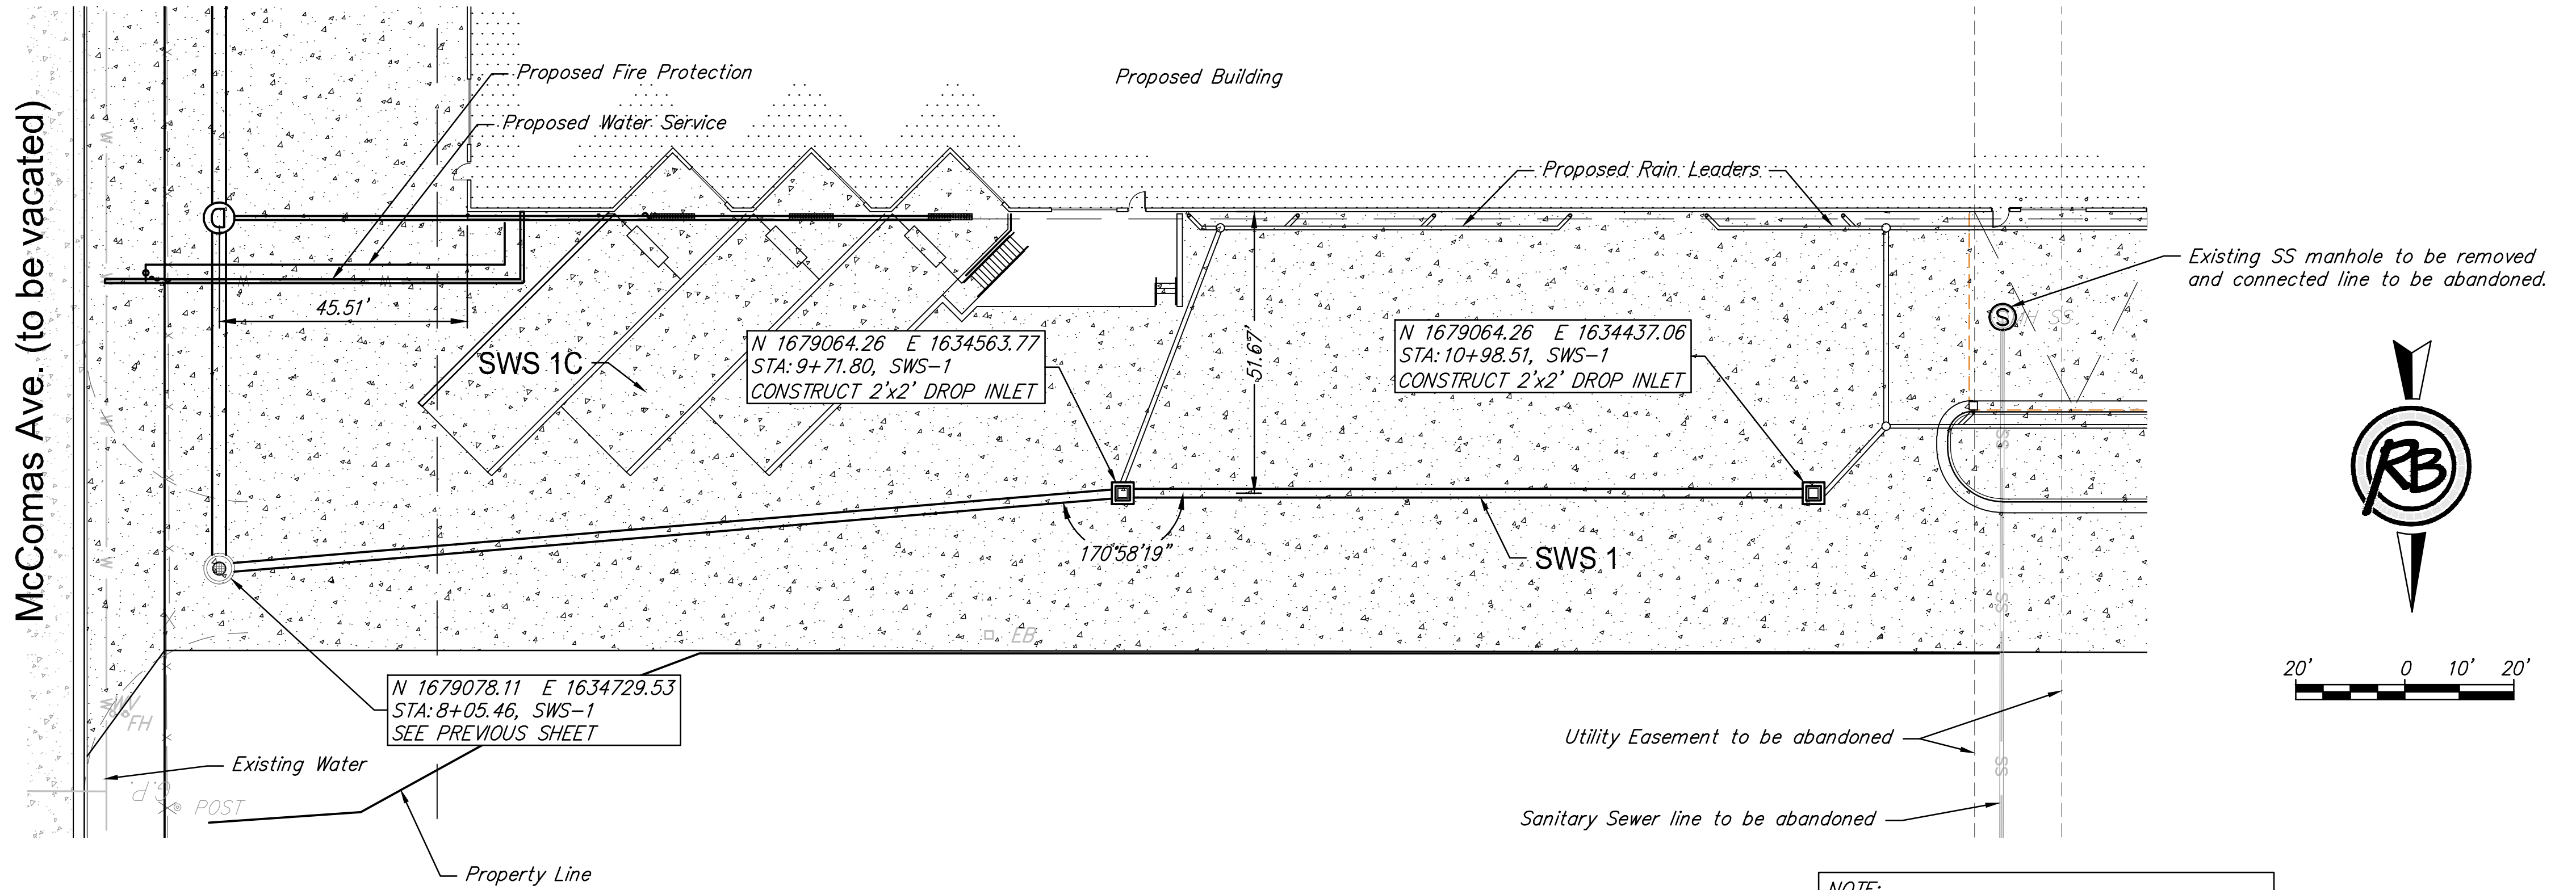

**RUGGLES BOHM**  
 ARCHITECTS & ENGINEERS  
 1000 W. 17th St., Suite 100  
 Wichita, Kansas 67202  
 Phone: 316.262.1234  
 Fax: 316.262.1235  
 www.rugglesbohm.com




DESIGN: KWL  
 DRAWN: DRS

PROJECT NUMBER: 0390 PPD  
 DRAWING FILE: 42650 Engineering Base

REVIEW: 3-2-2016  
 DATE: 4-25-2016

**FOLEY EQUIPMENT**  
**SWS-1 3**  
 Wichita, Kansas

RD JOB: 42650  
 SHEET: 4 OF 15

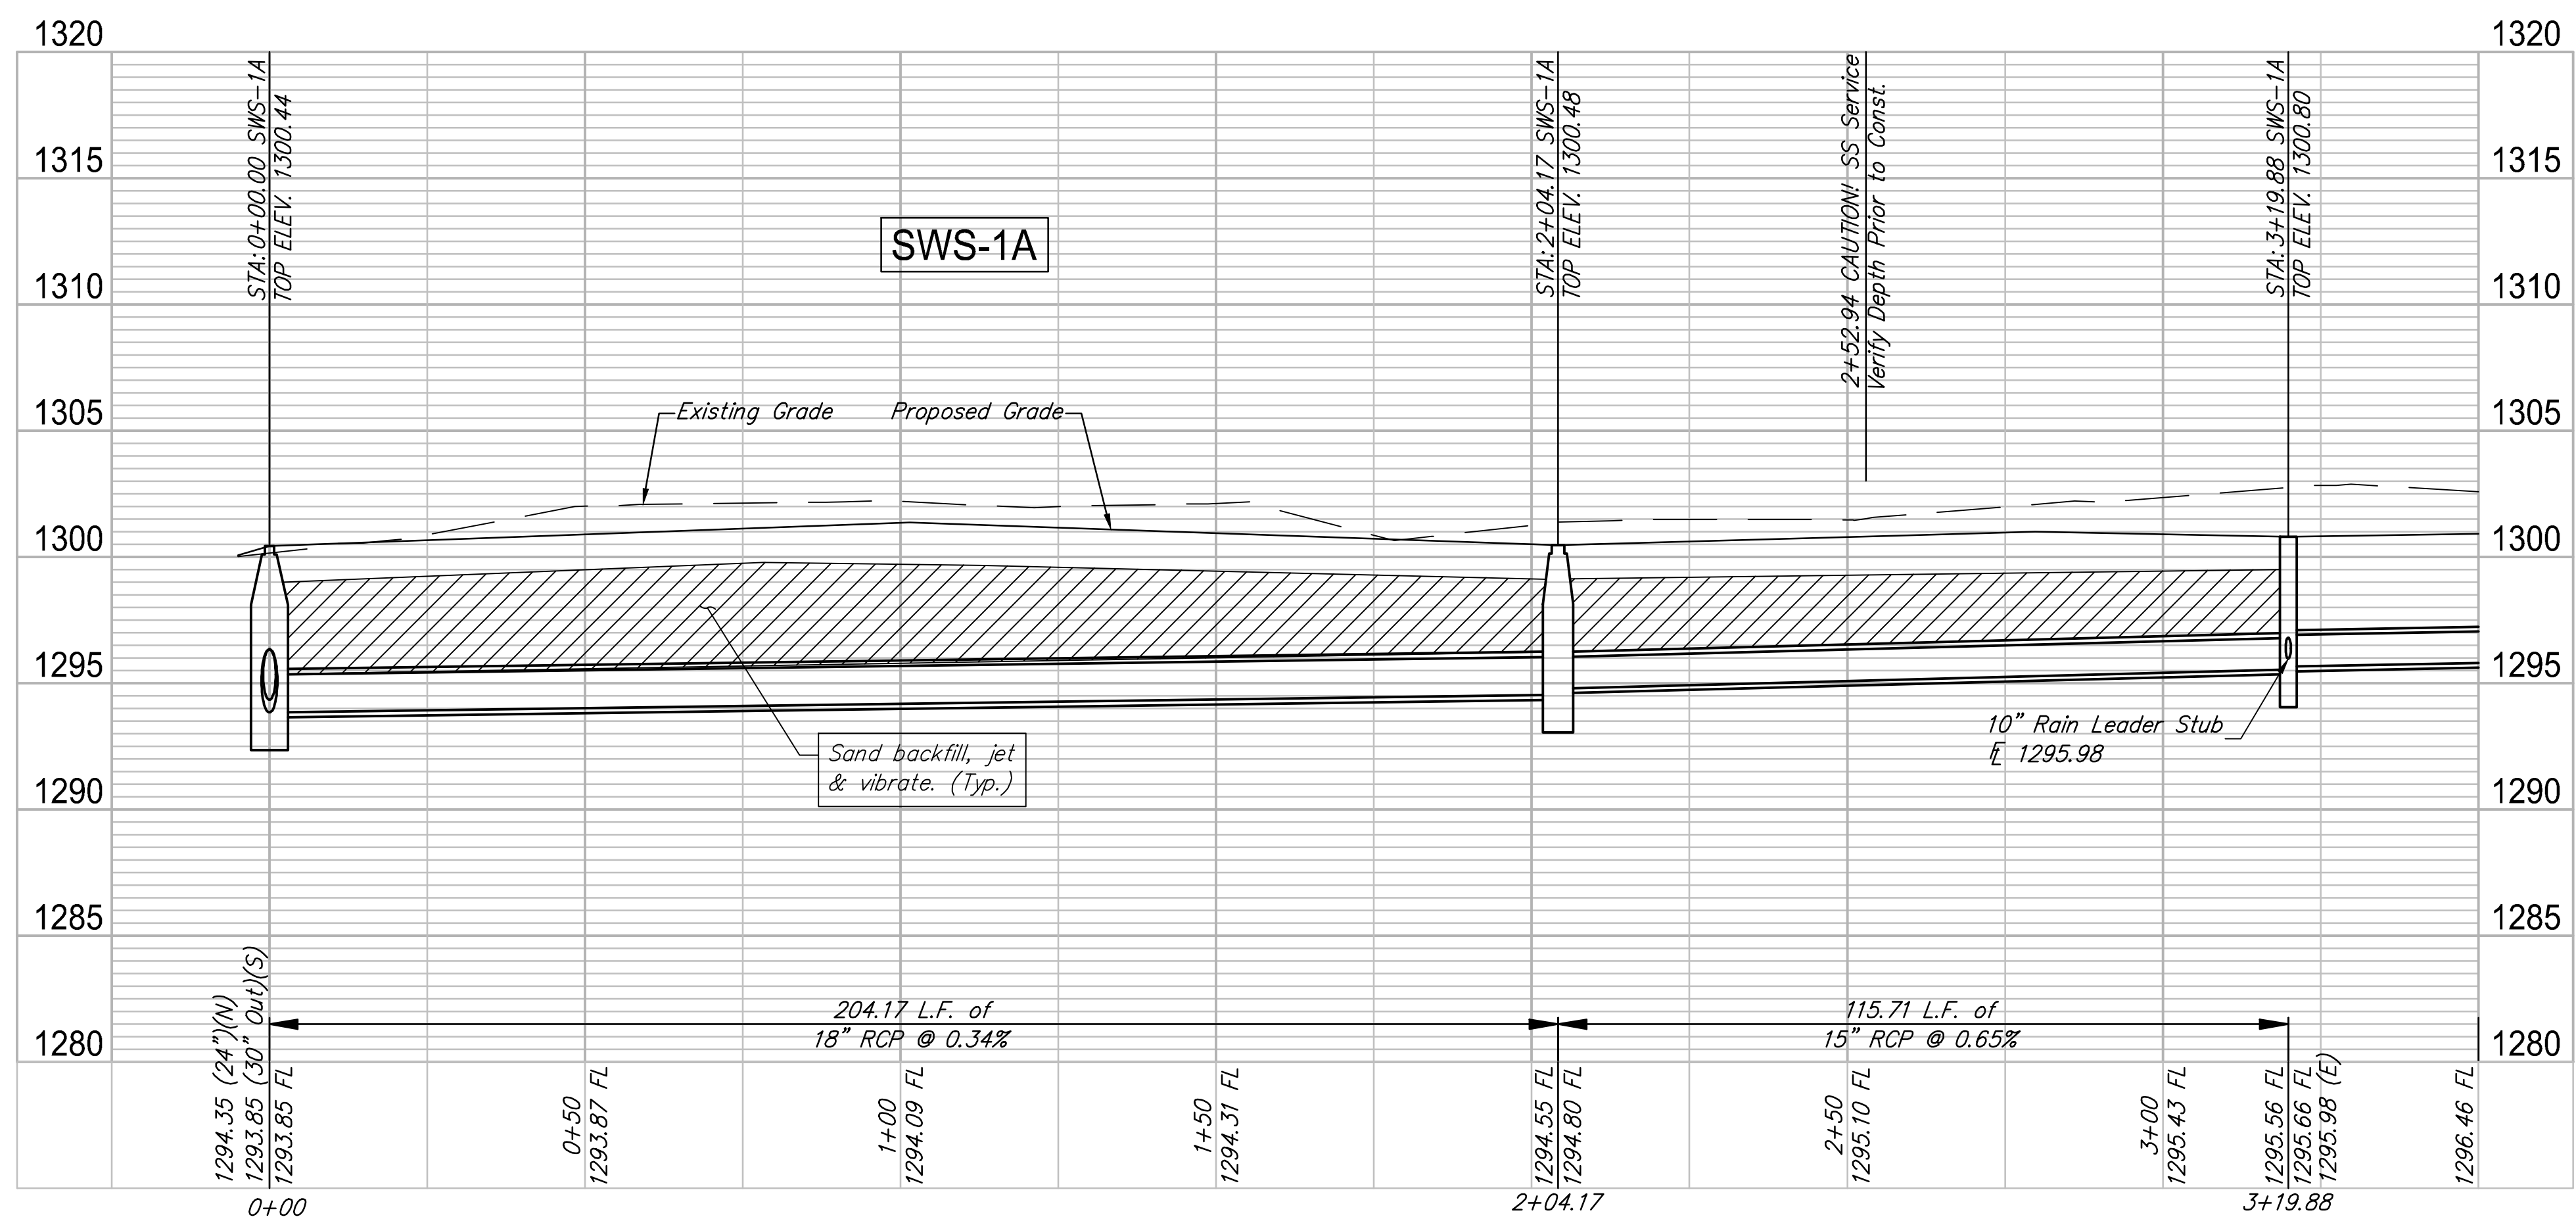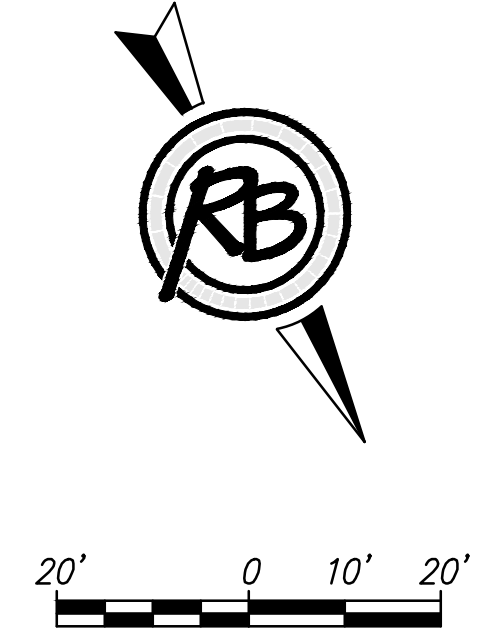
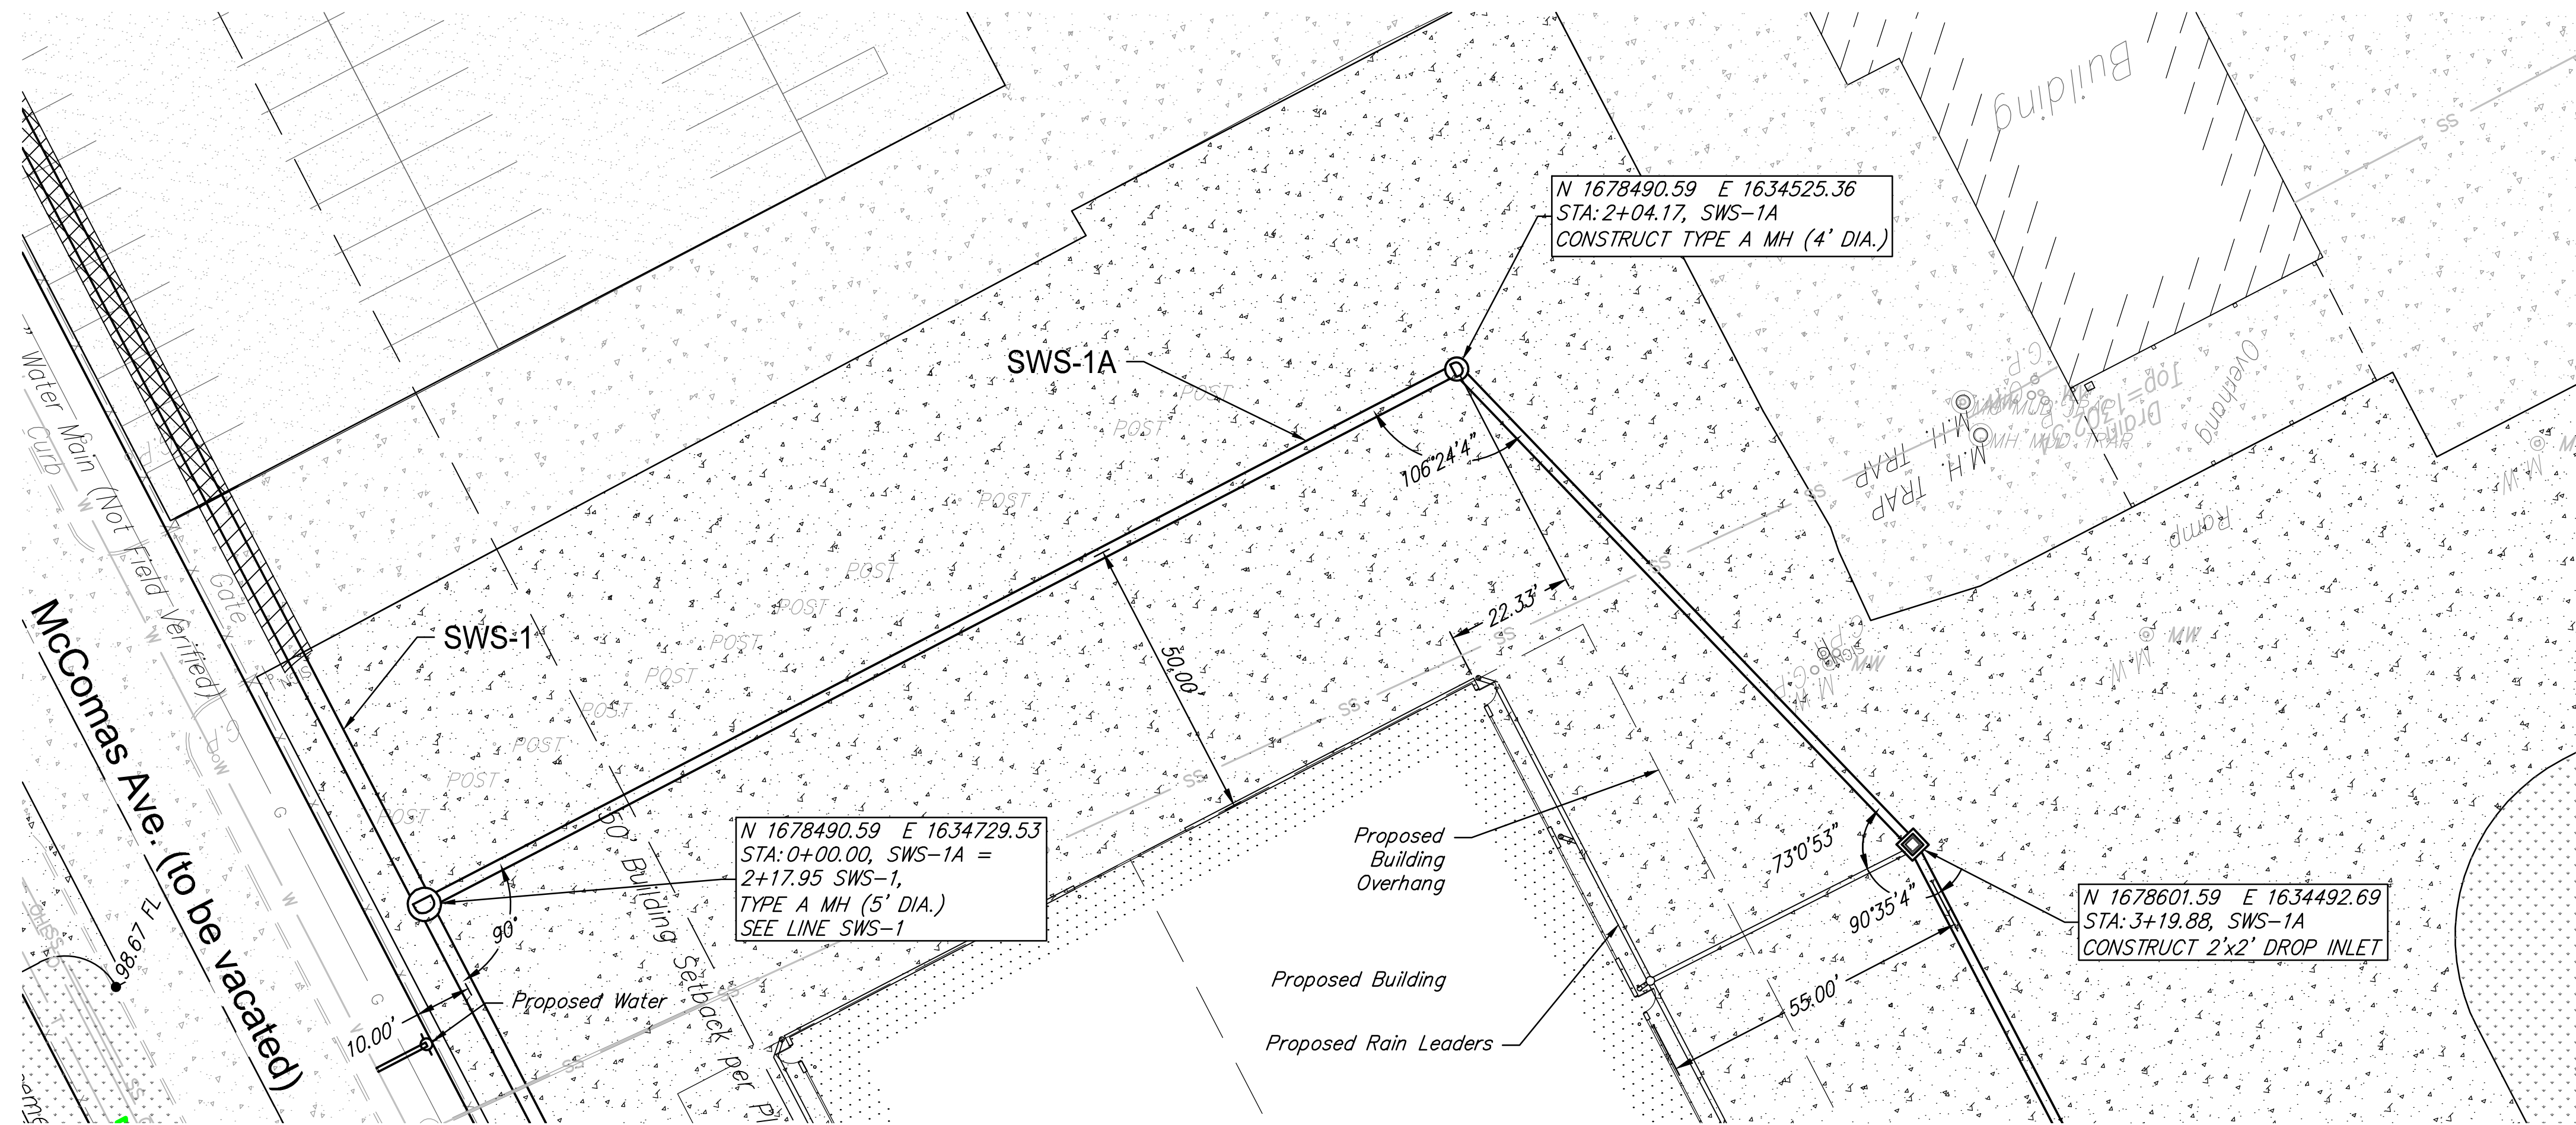


NOTE:  
 Stubs for rain leaders may be deleted if rain leaders are installed at the same time as the storm sewer system.


AS BUILT PLANS  
 CONTRACTOR: PEARSON CONSTRUCTION  
 INSPECTOR: LEVI TURNER  
 RUGGLES & BOHM  
 PDF BY: LCT 08/10/2016

PROJECT NUMBER	0390 PPD
DESIGNING FILE	42650 Engineering Base
DESIGN	KWL DRAWN
REVIEW	3-2-2016 DATE
	4-25-2016 DATE
<b>FOLEY EQUIPMENT</b> <b>SWS-1A 1</b> Wichita, Kansas	
RB JOB SHEET	42650
OF	5
	15





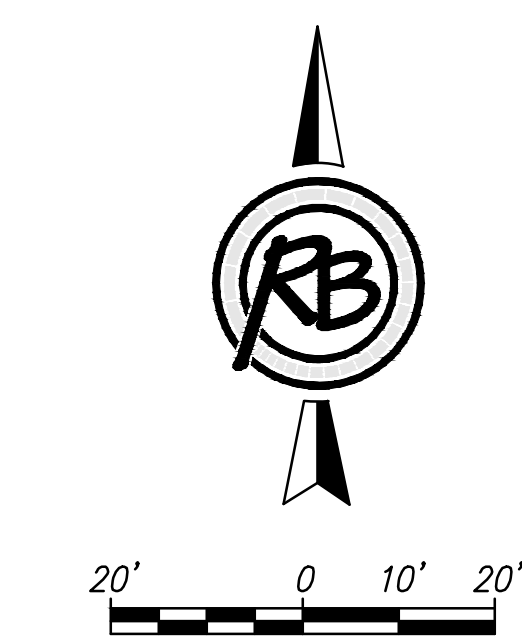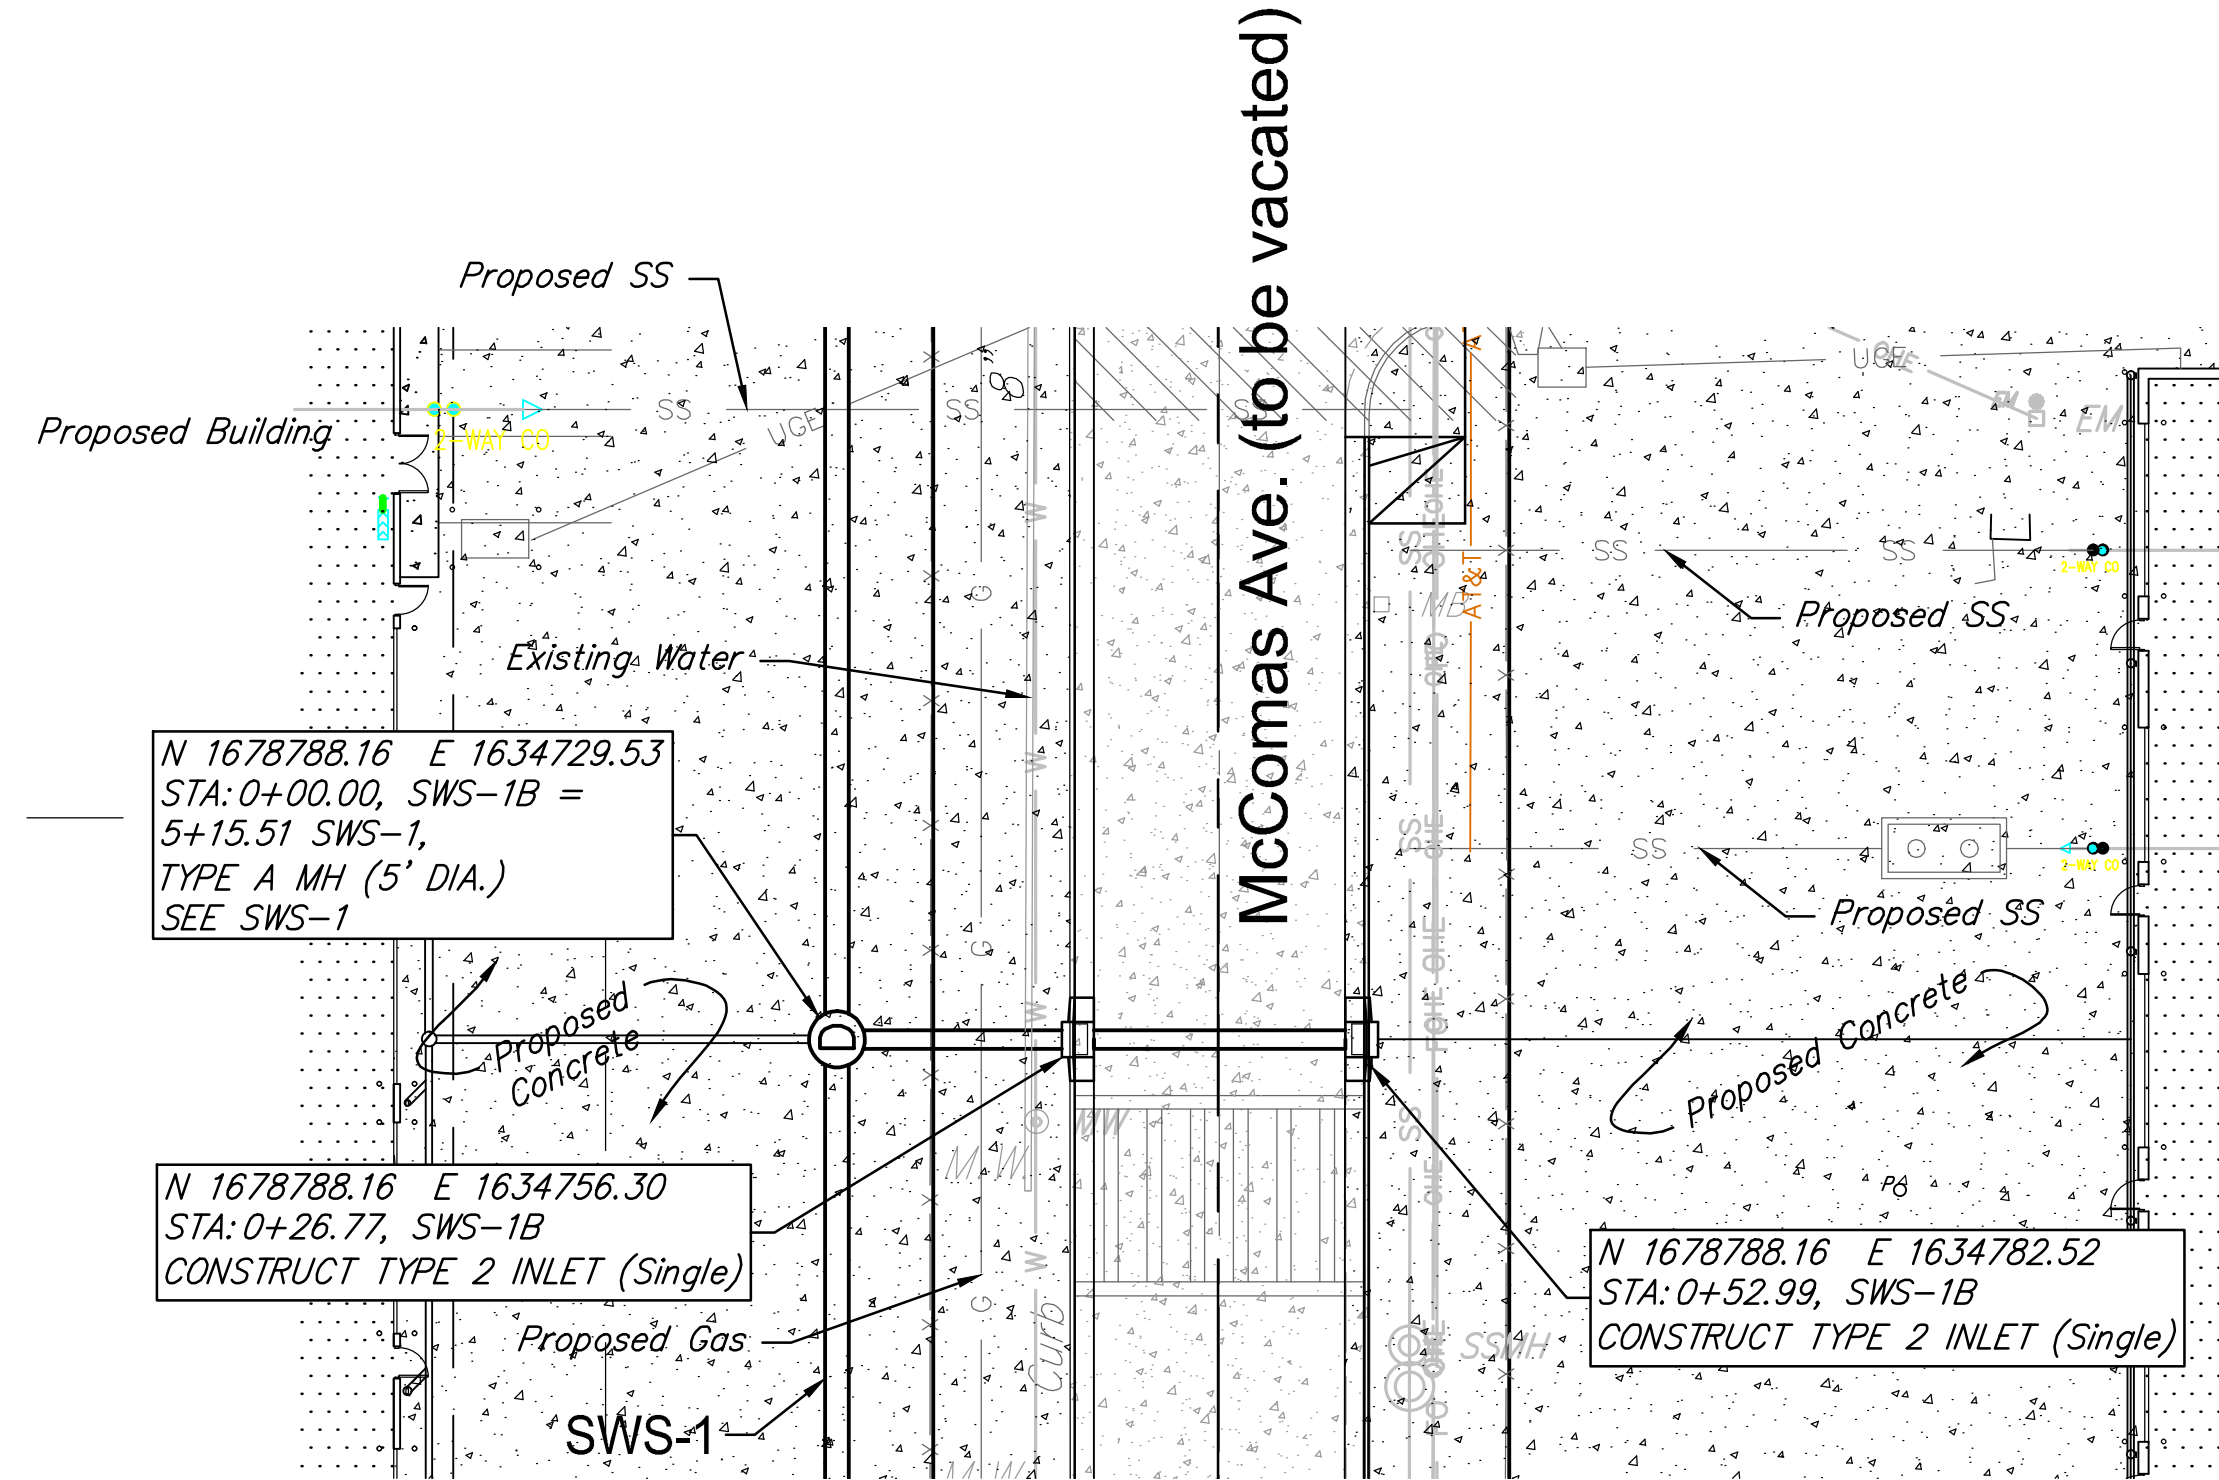


AS BUILT PLANS  
CONTRACTOR: PEARSON CONSTRUCTION  
INSPECTOR: LEVI TURNER  
RUGGLES & BOHM  
PDF BY: LCT 08/10/2016

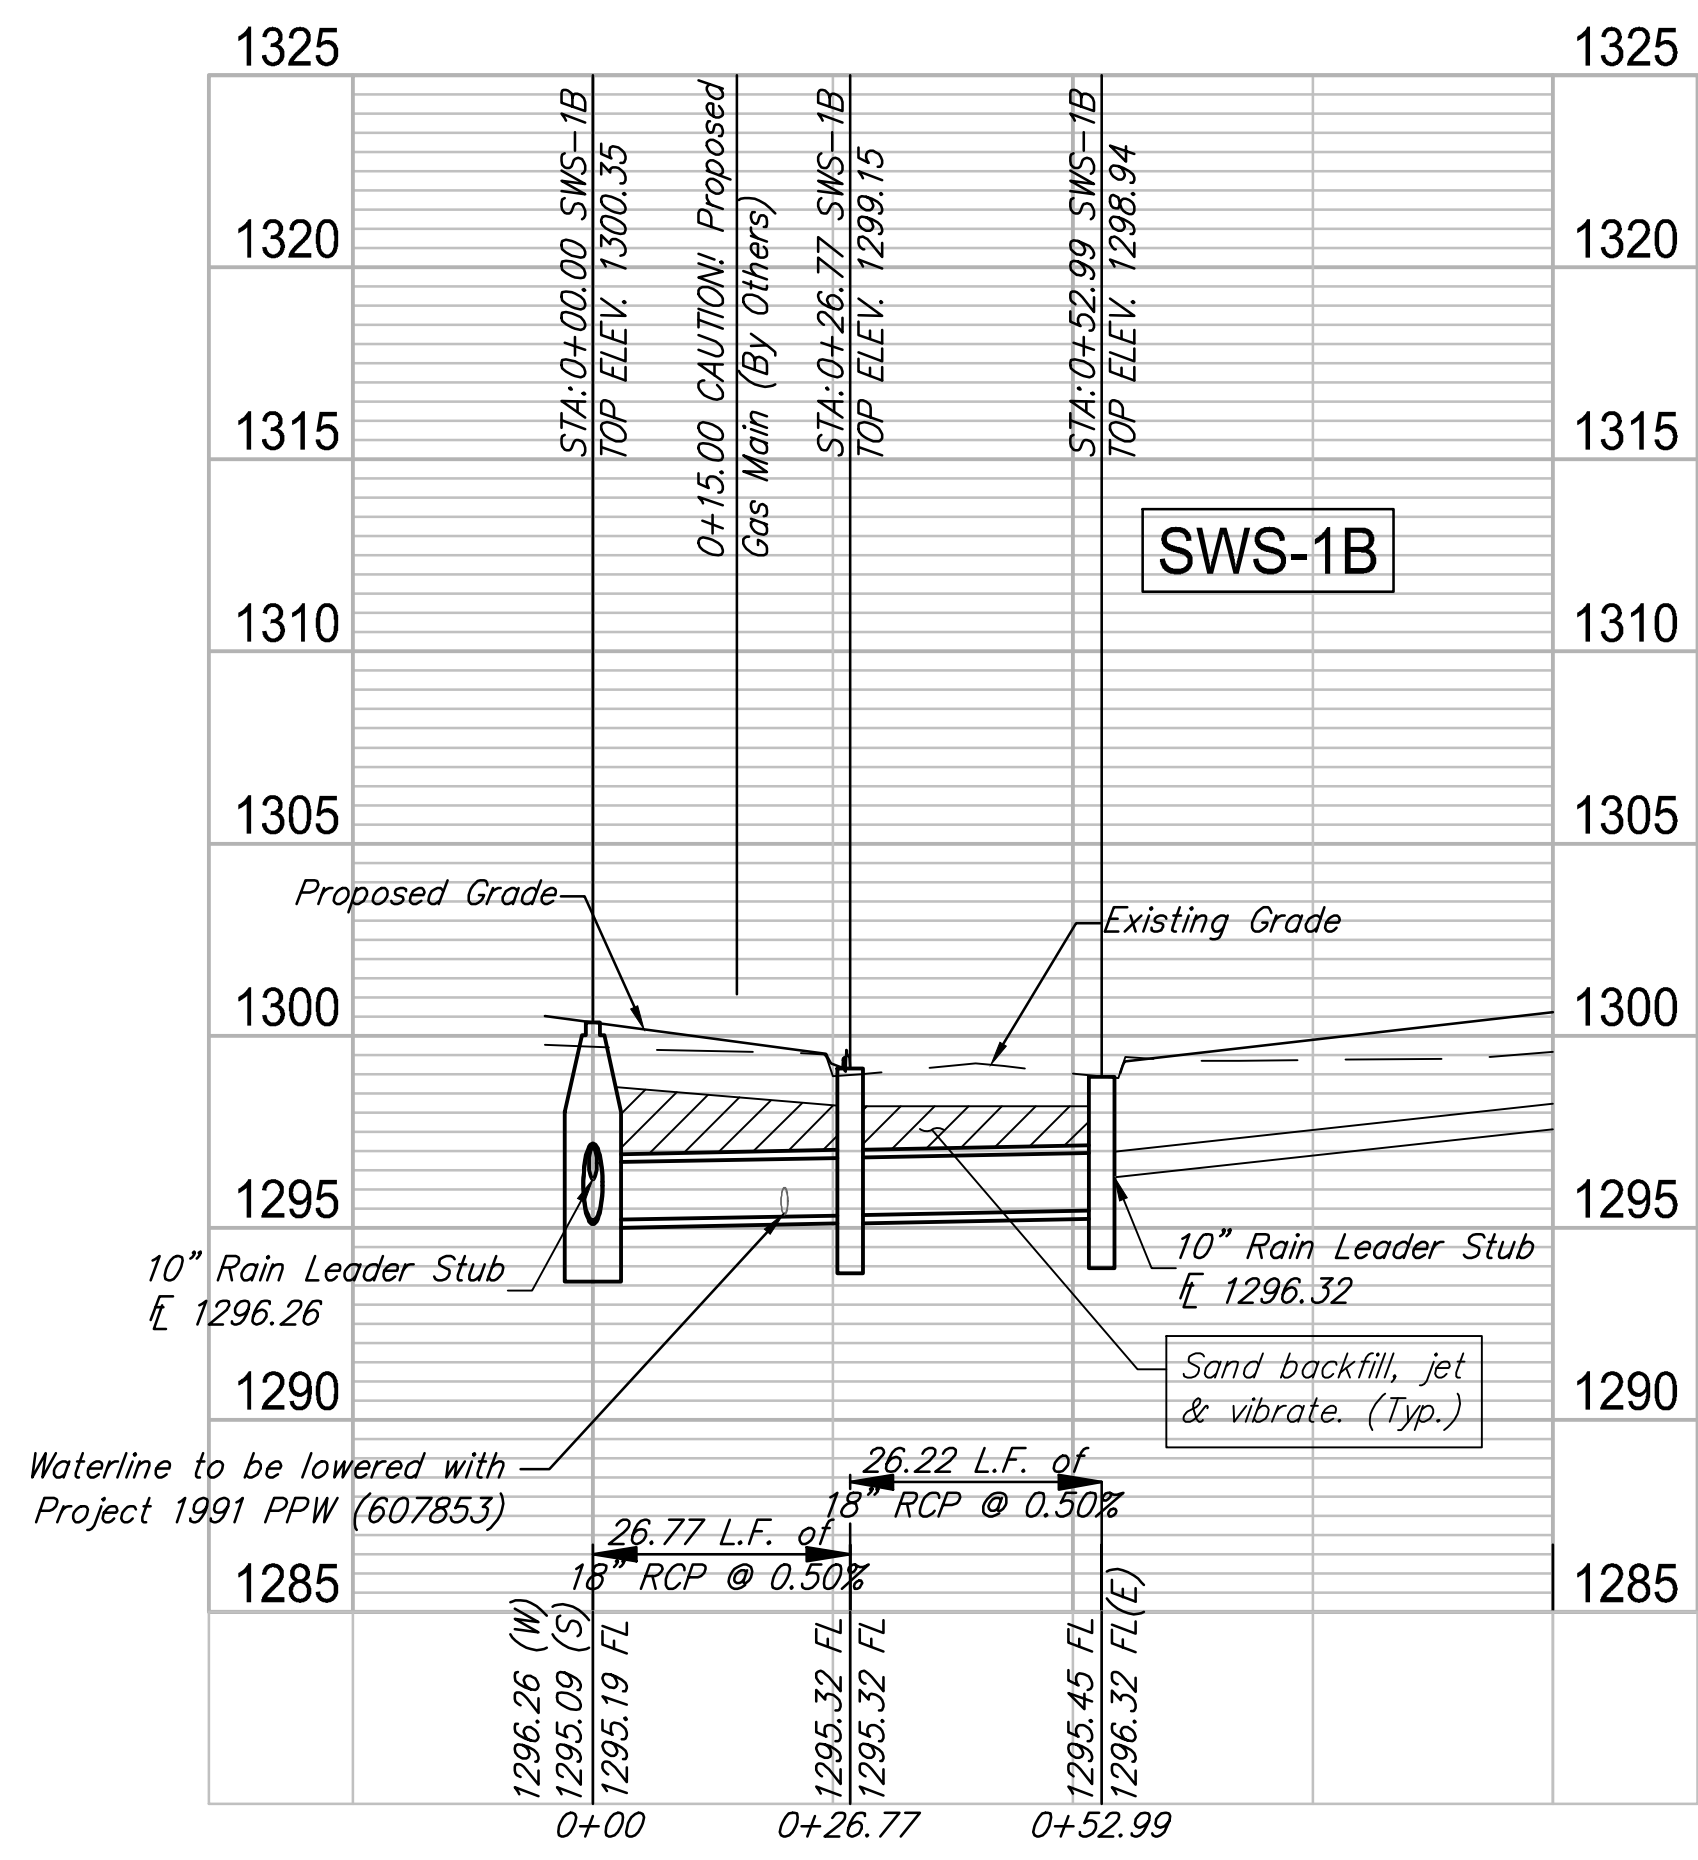

DESIGN	DESIGN
PROJECT NUMBER	REVIEW
0390 PPD	3-2-2016
DRAWING FILE	DATE
4265D Engineering Base	4-25-2016
<b>FOLEY EQUIPMENT</b> <b>SWS-1B</b> Wichita, Kansas	
RB JOB	SHEET
4265D	7
	OF
	15

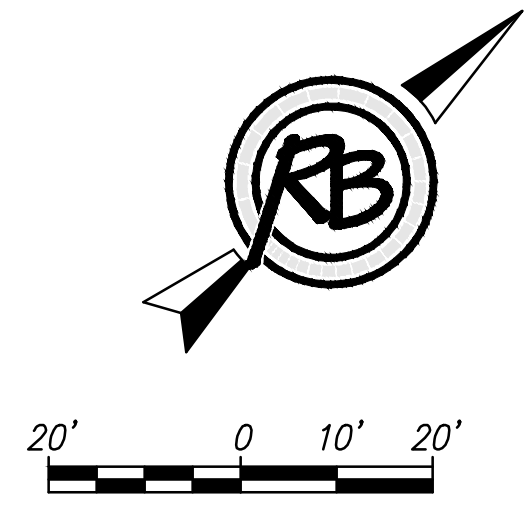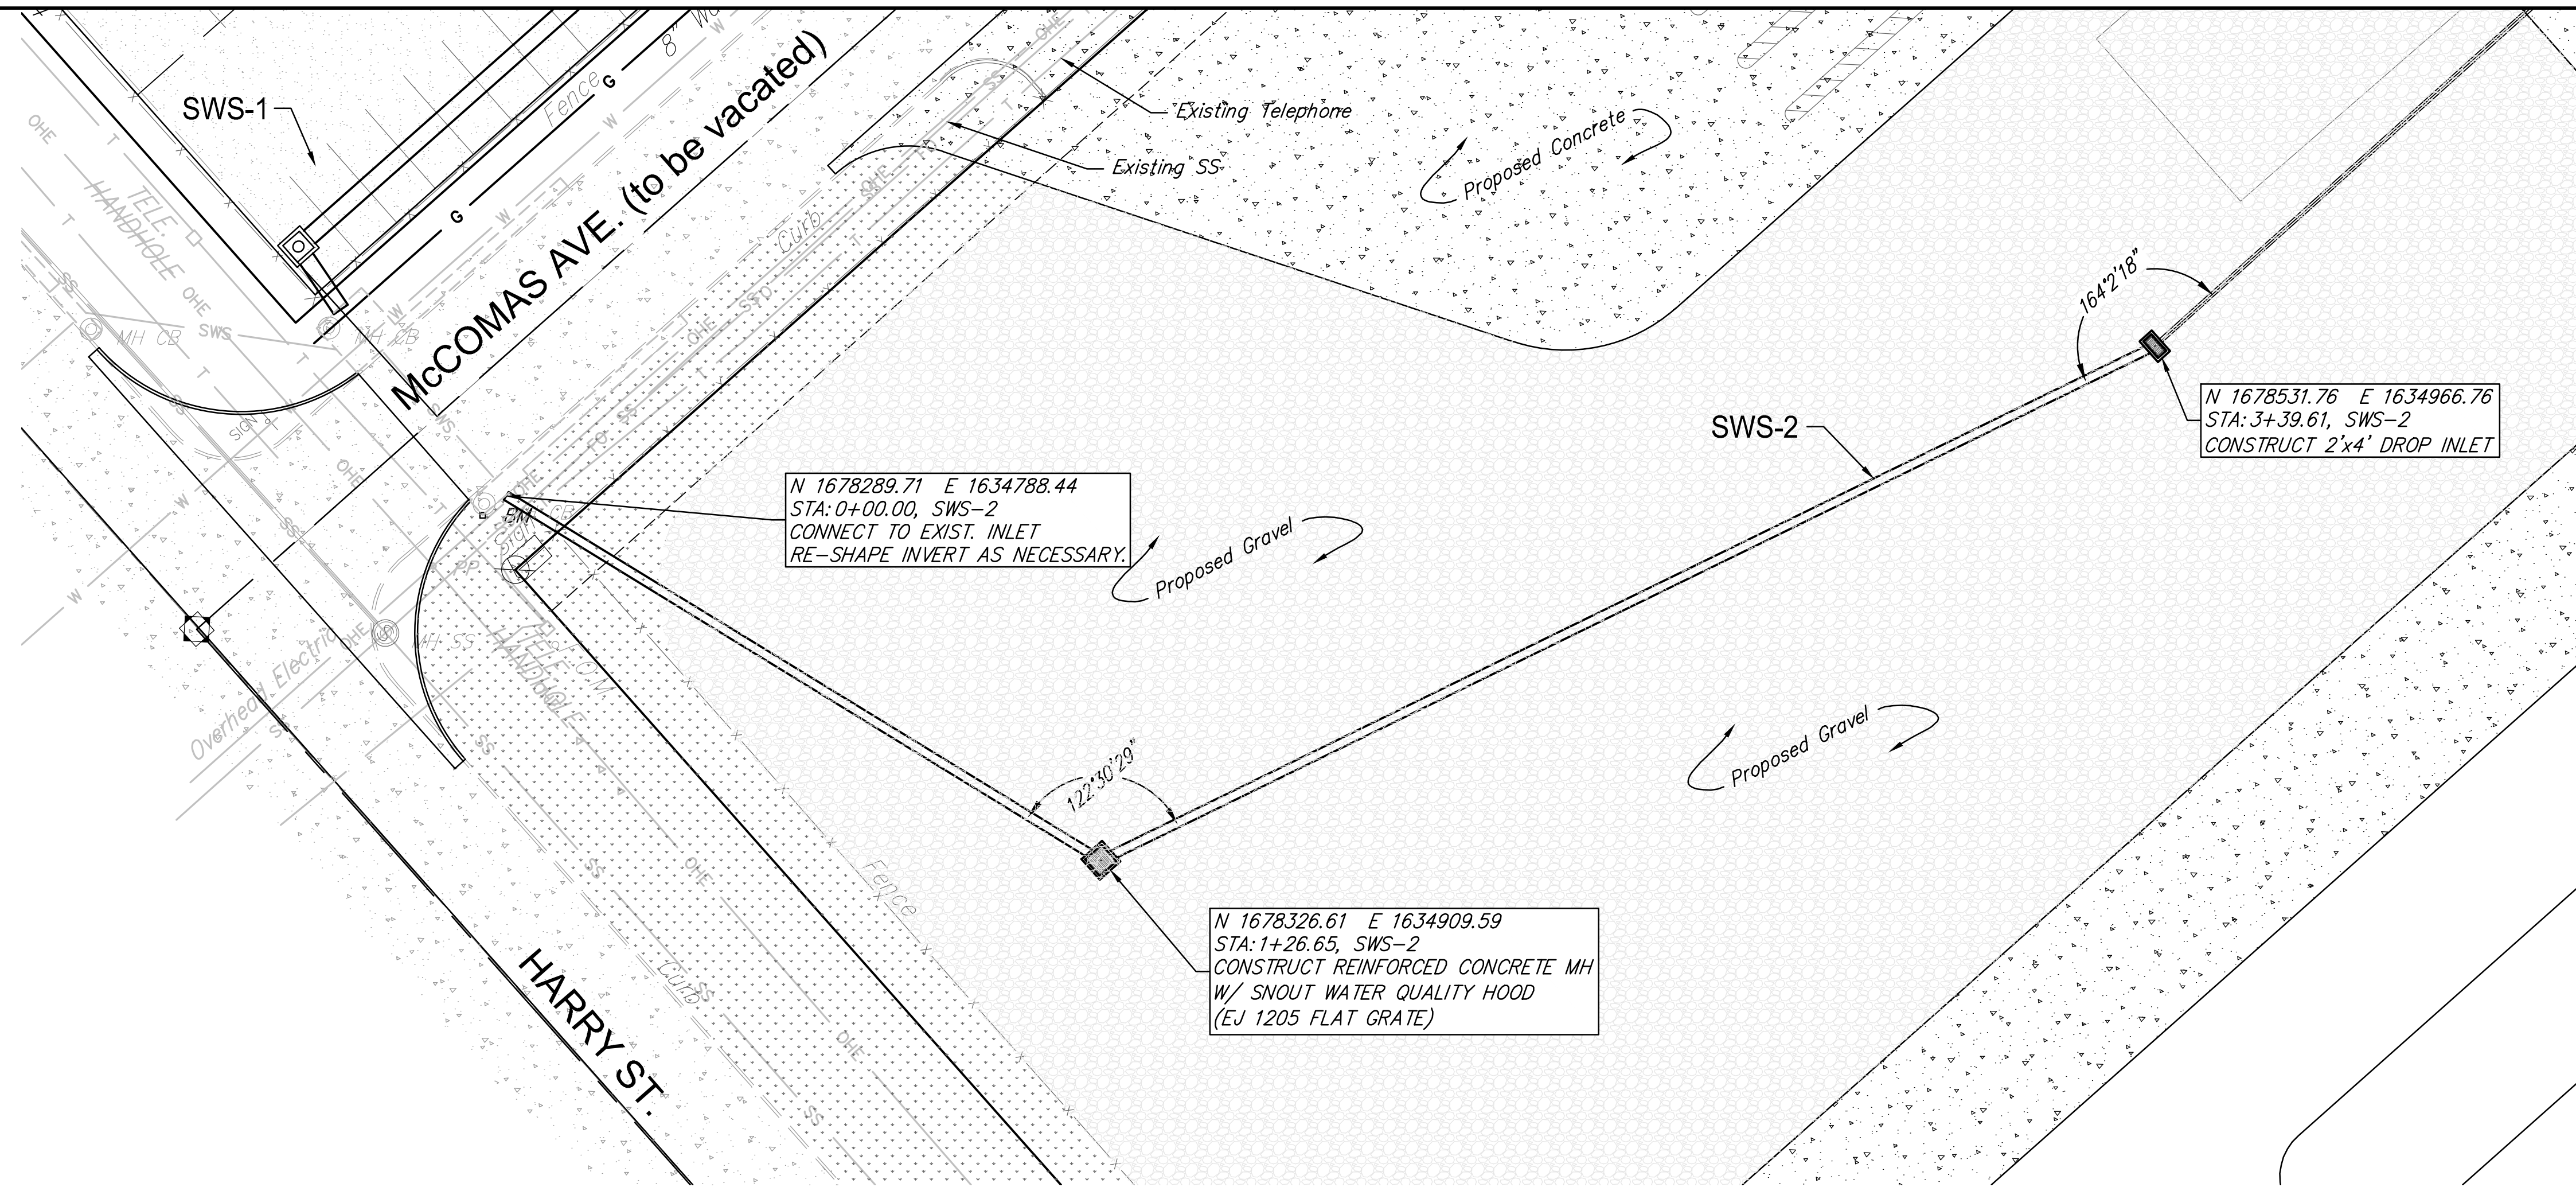

AS BUILT PLANS  
CONTRACTOR: PEARSON CONSTRUCTION  
INSPECTOR: LEVI TURNER  
RUGGLES & BOHM  
PDF BY: LCT 08/10/2016

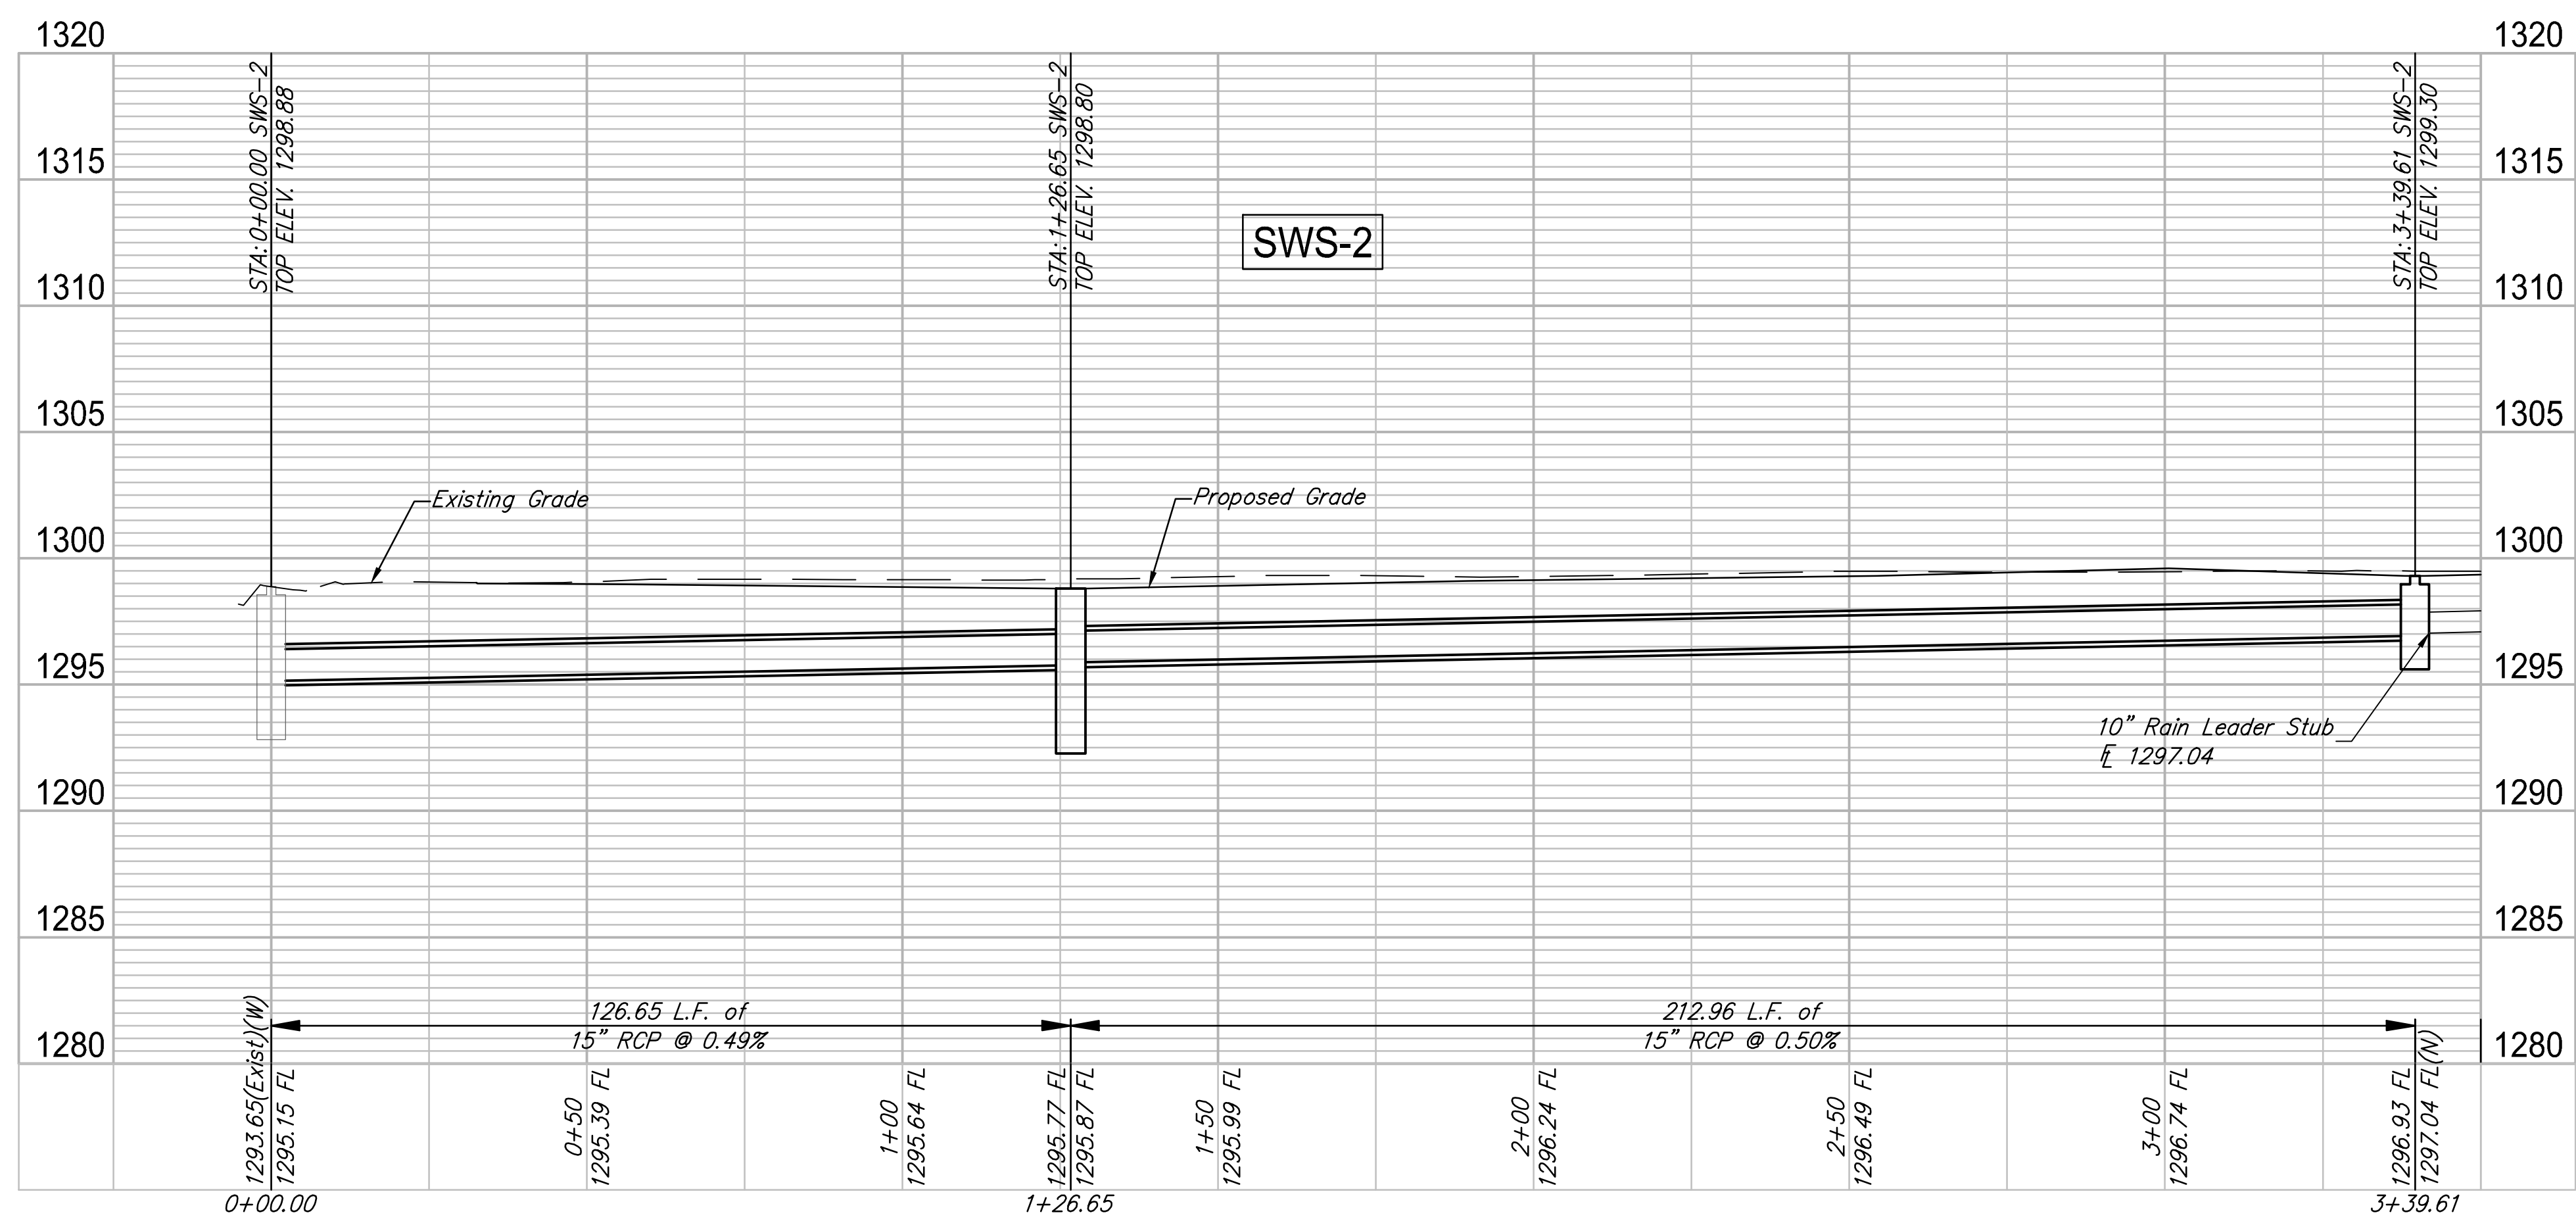

**RUGGLES & BOHM**

DESIGN: KWL  
PROJECT NUMBER: 0390 PPD  
DRAWING TITLE: 42650 Engineering Base






REVIEW: 3-2-2016  
DATE: 4-25-2016

DESIGN: KWL  
DRAWN: DRS

**FOLEY EQUIPMENT**  
**SWS-2**  
Wichita, Kansas

RB JOB: 42650  
SHEET: 8 OF 15

F:\Projects\Projects 4200-4299\42650 (Foley Equipment Drainage West St-Campus)\42650\_Engineering\_Base.dwg

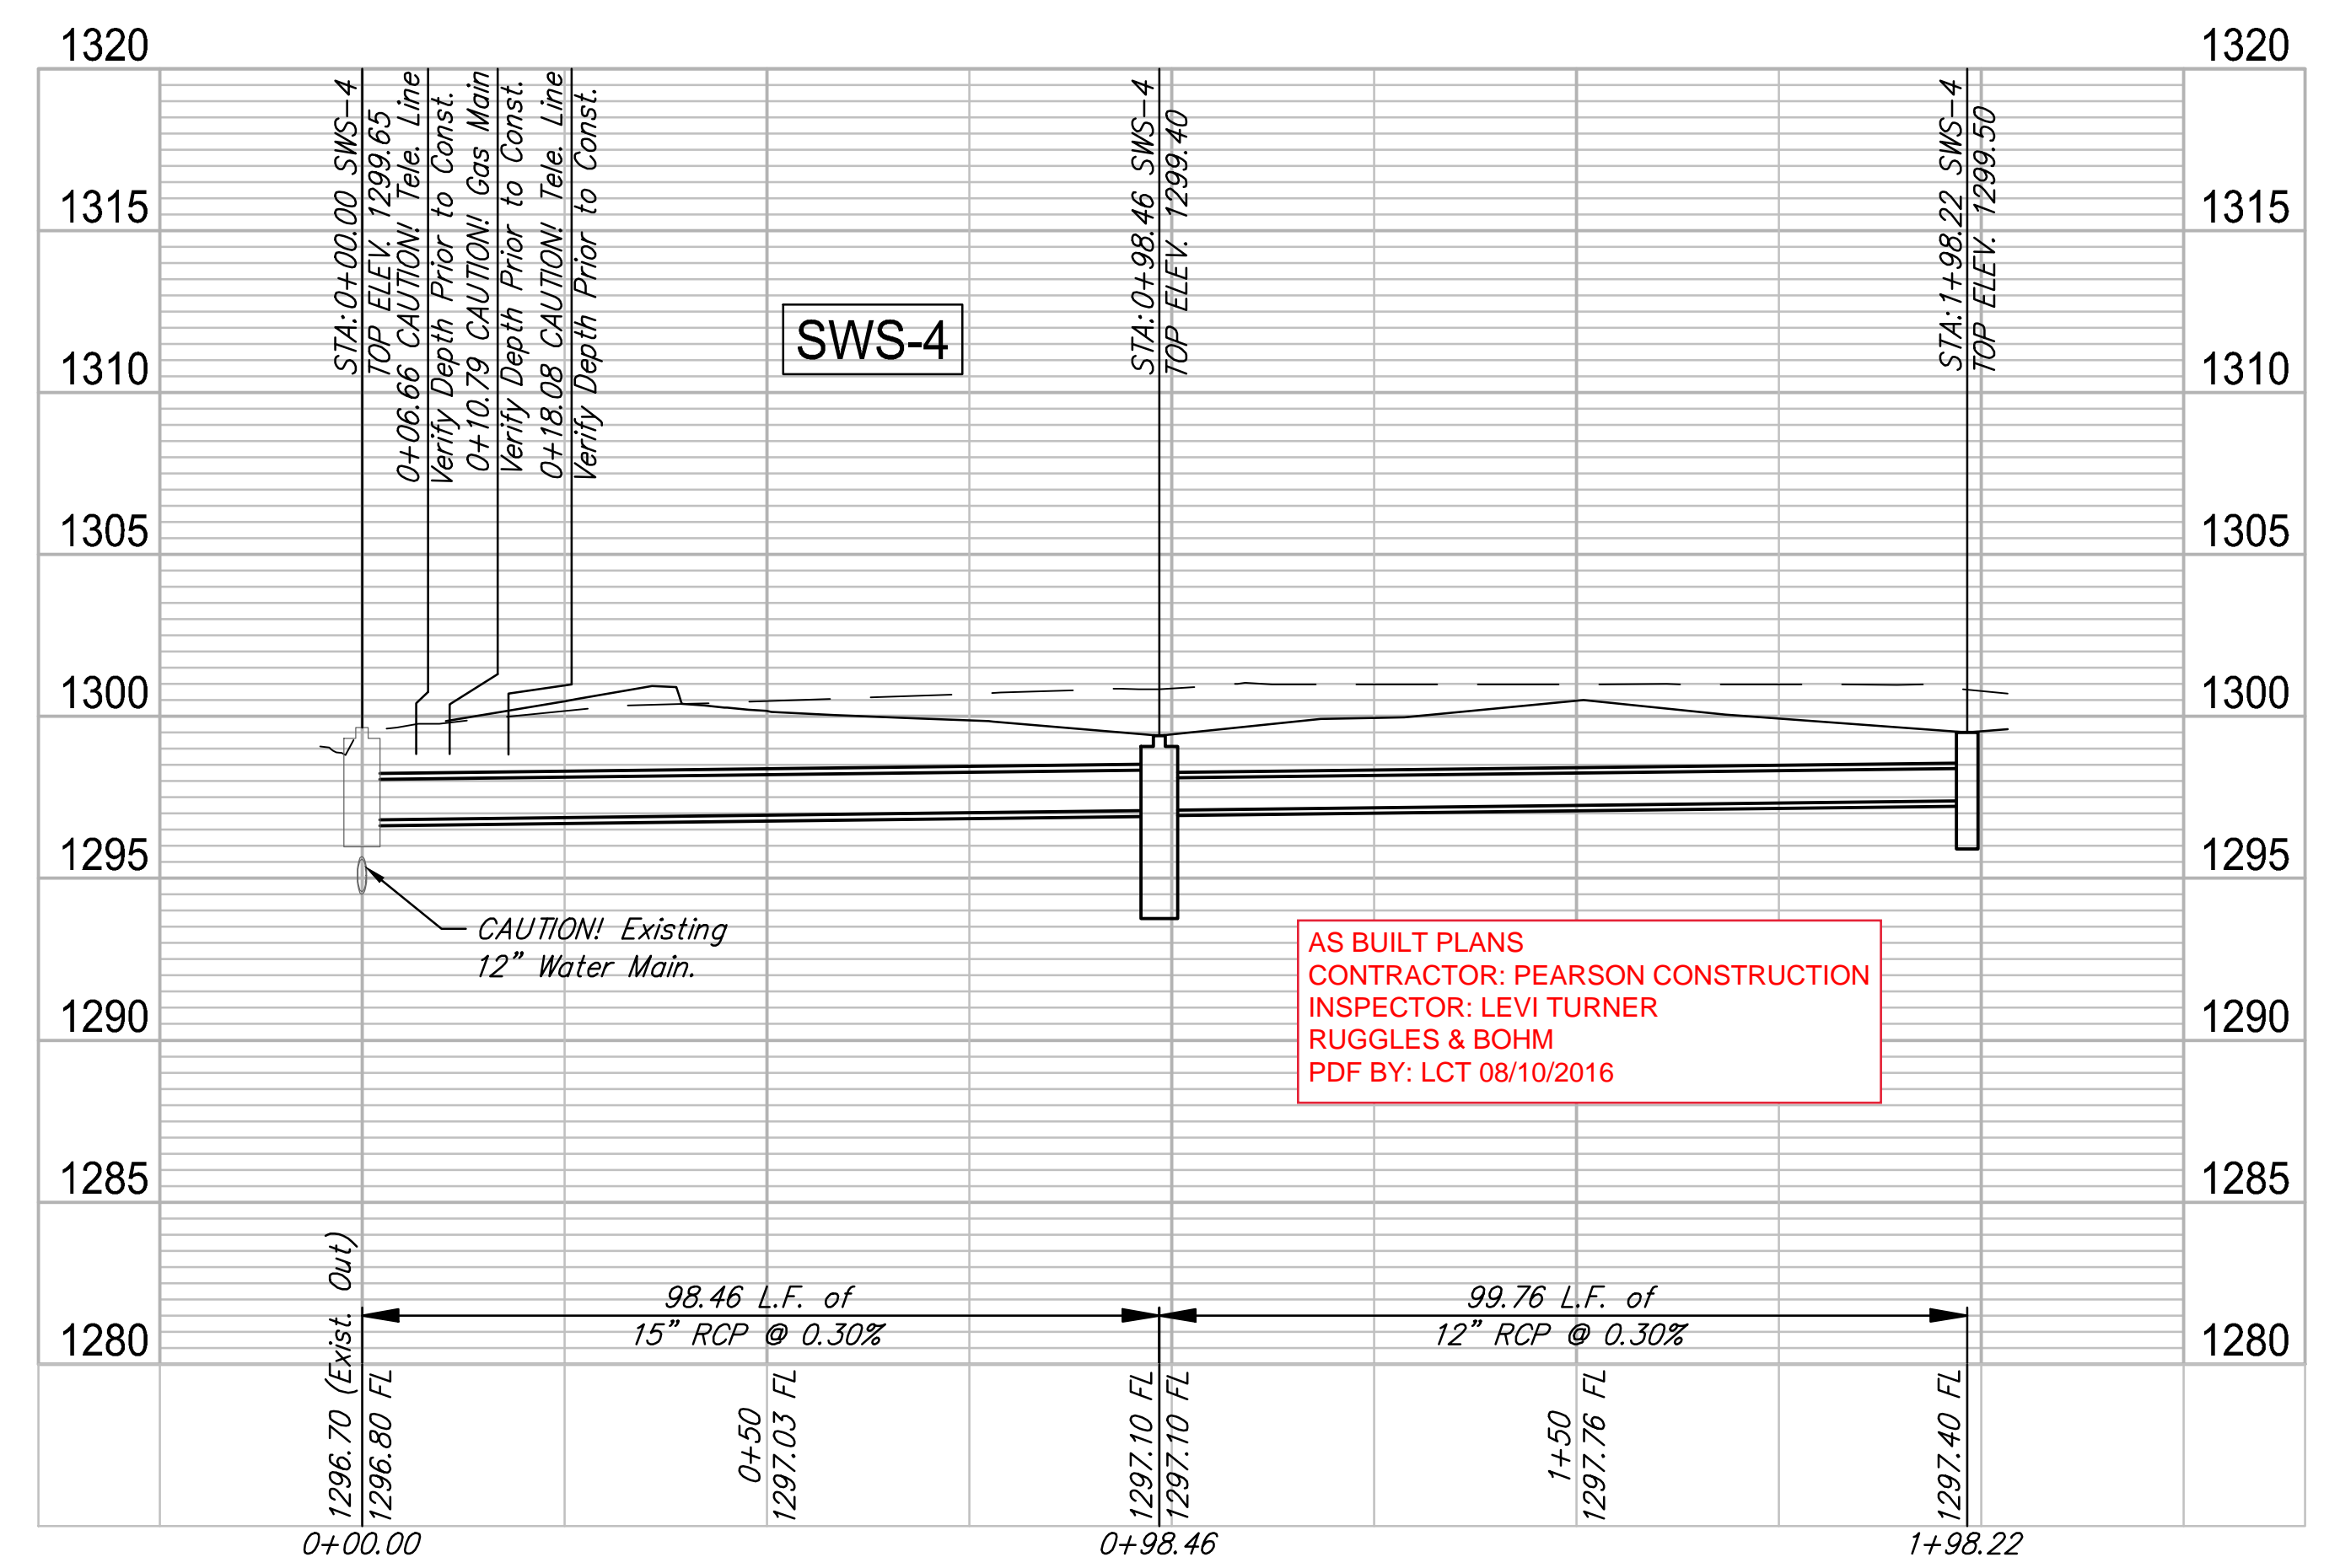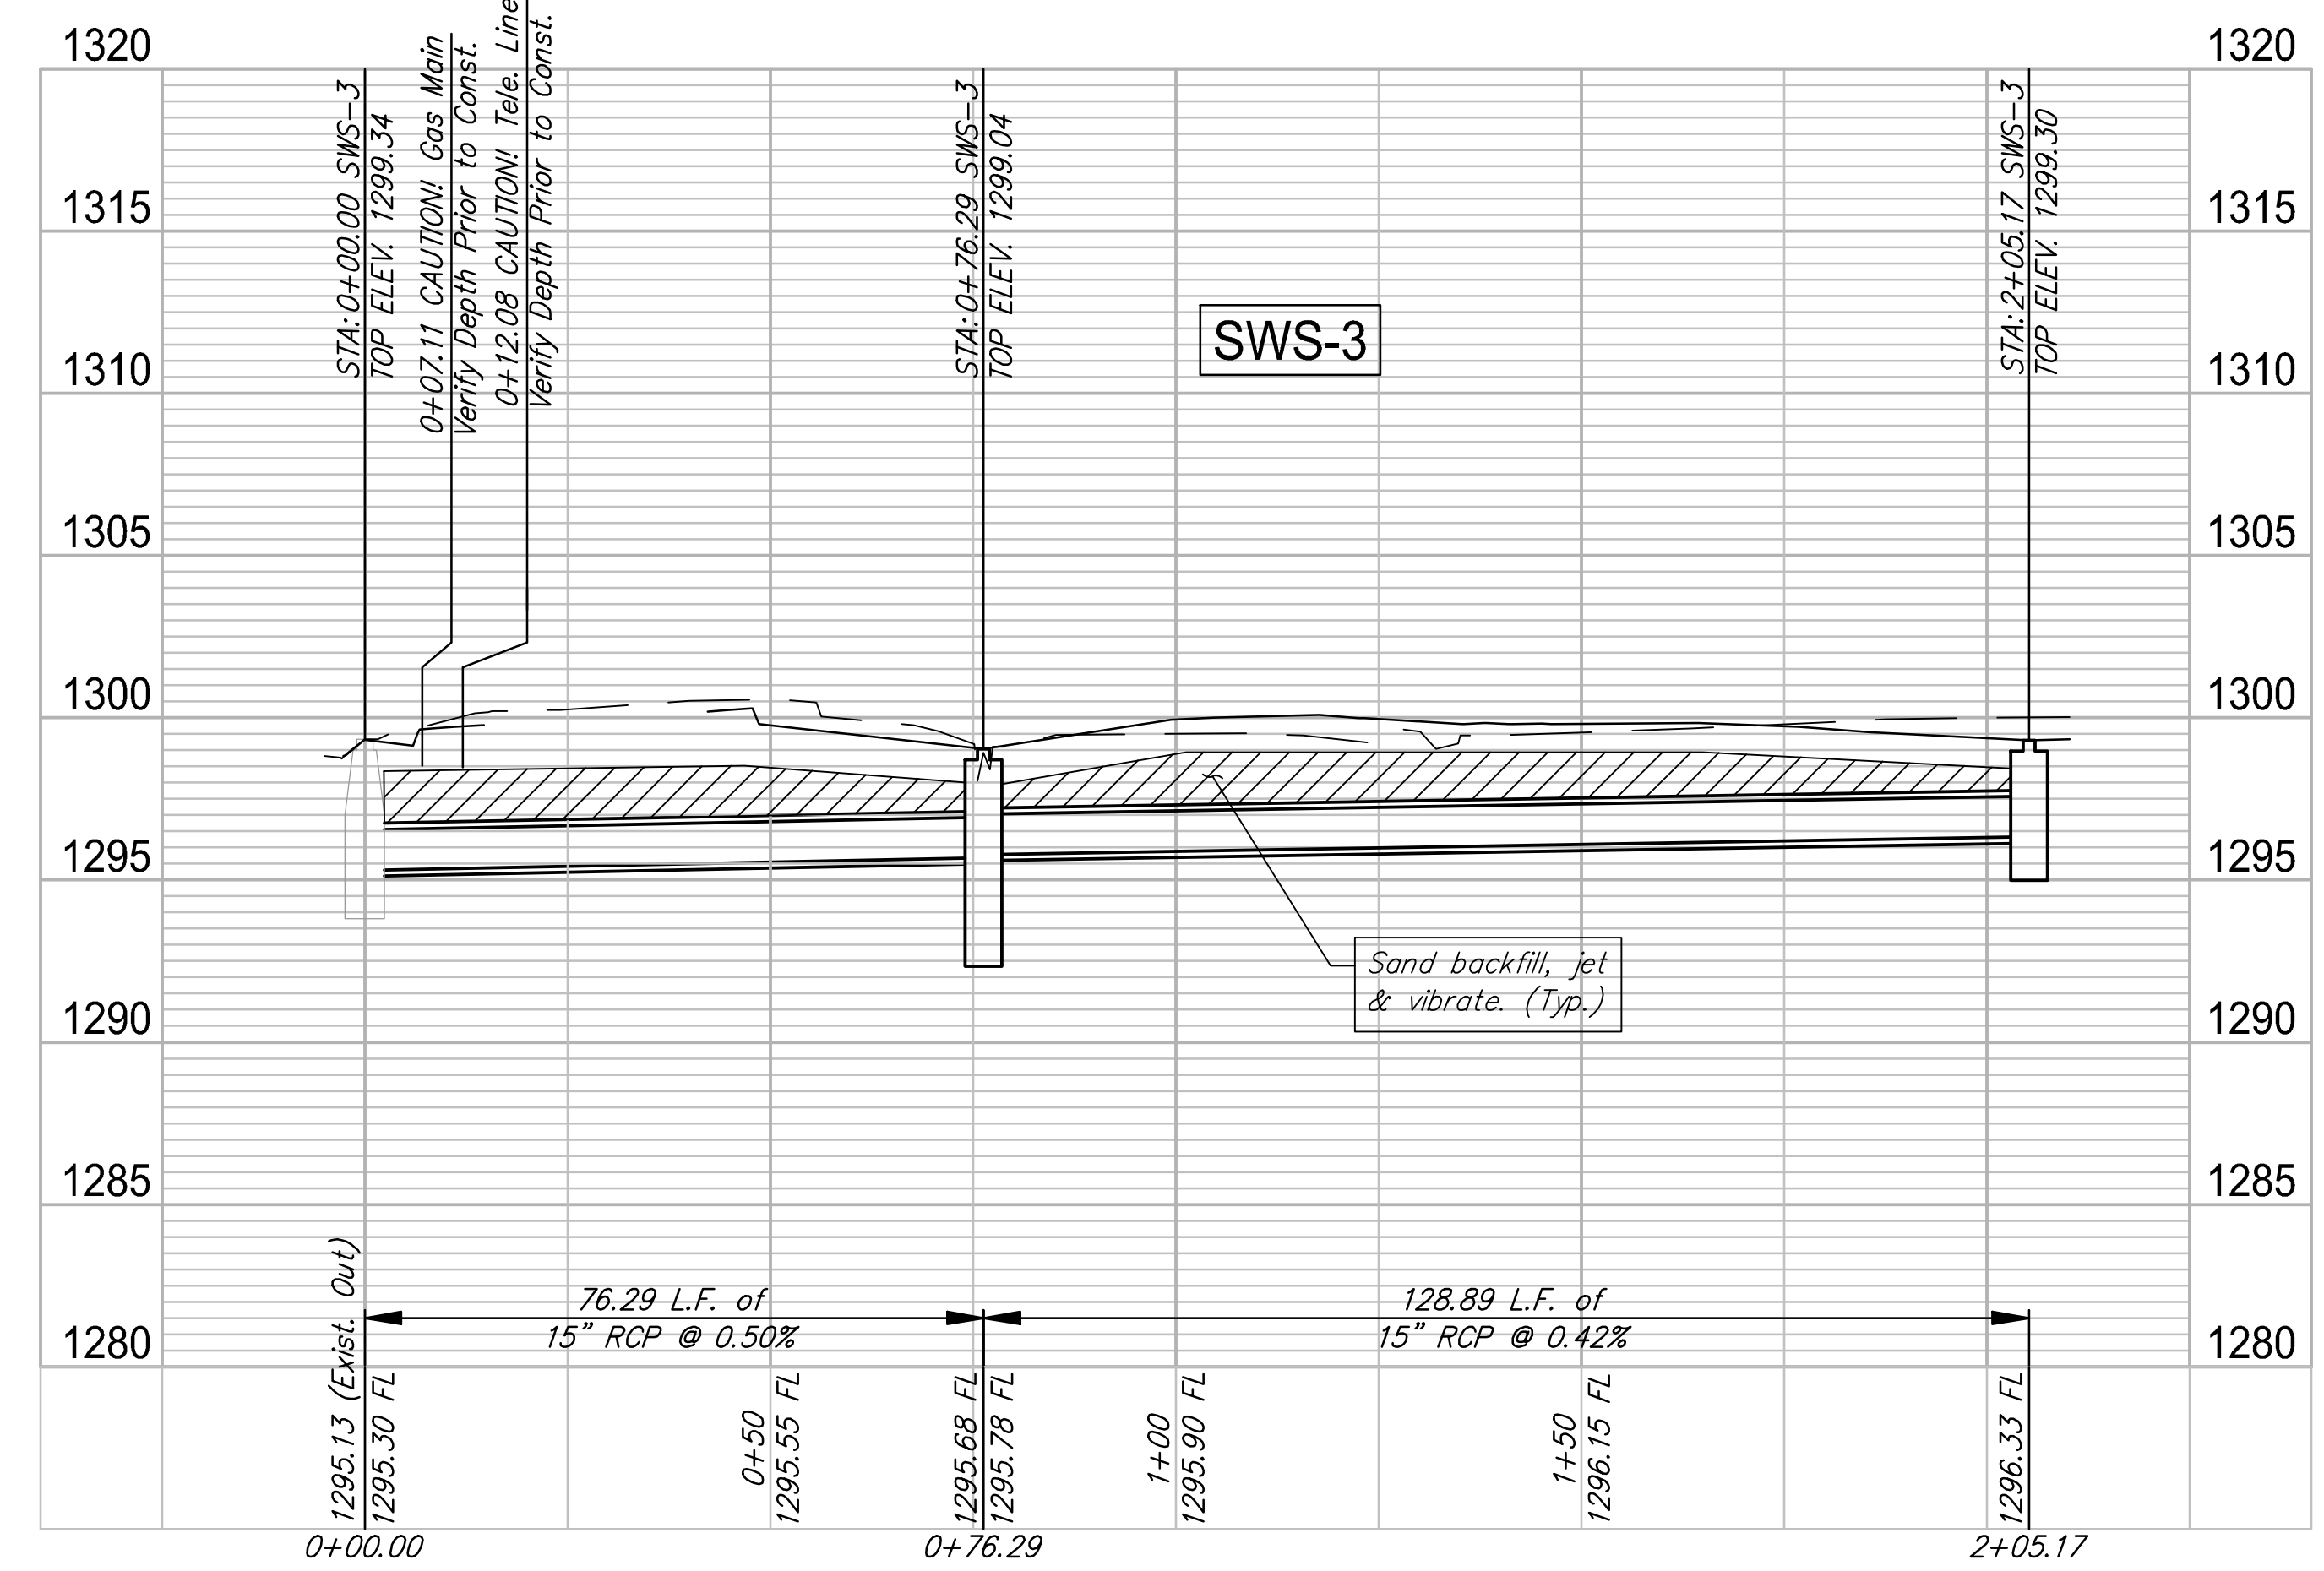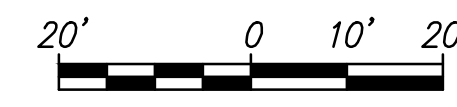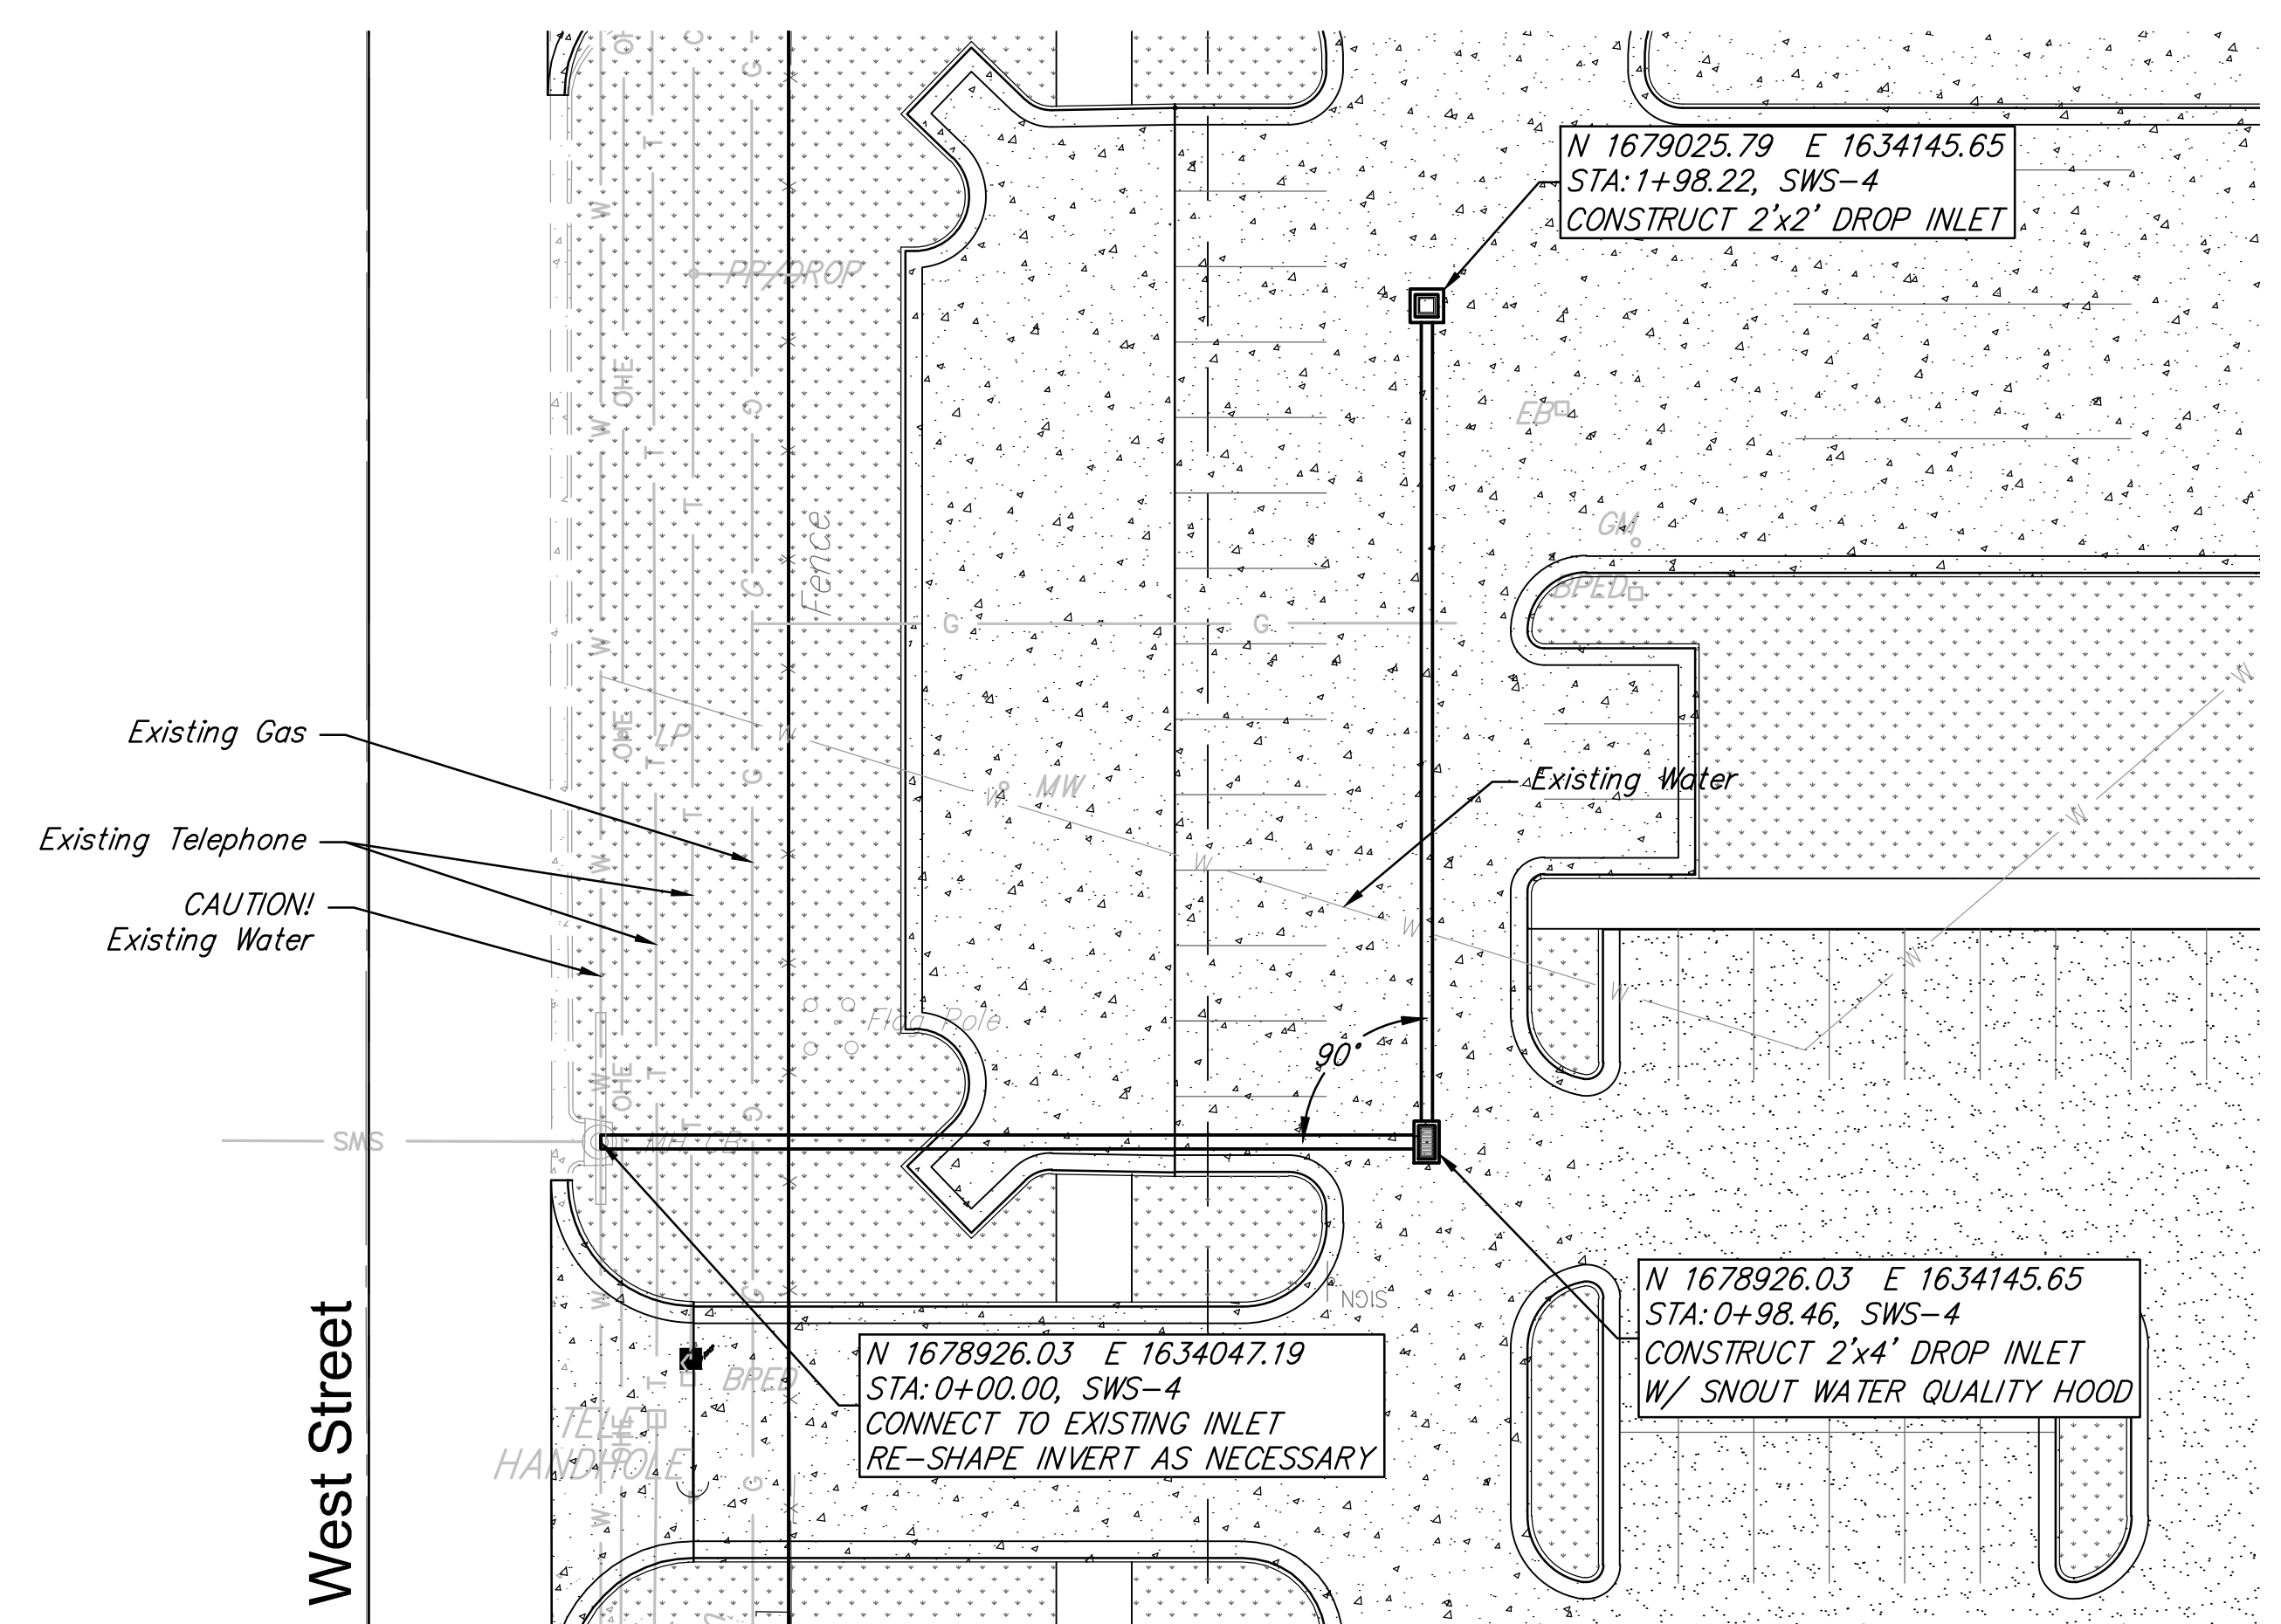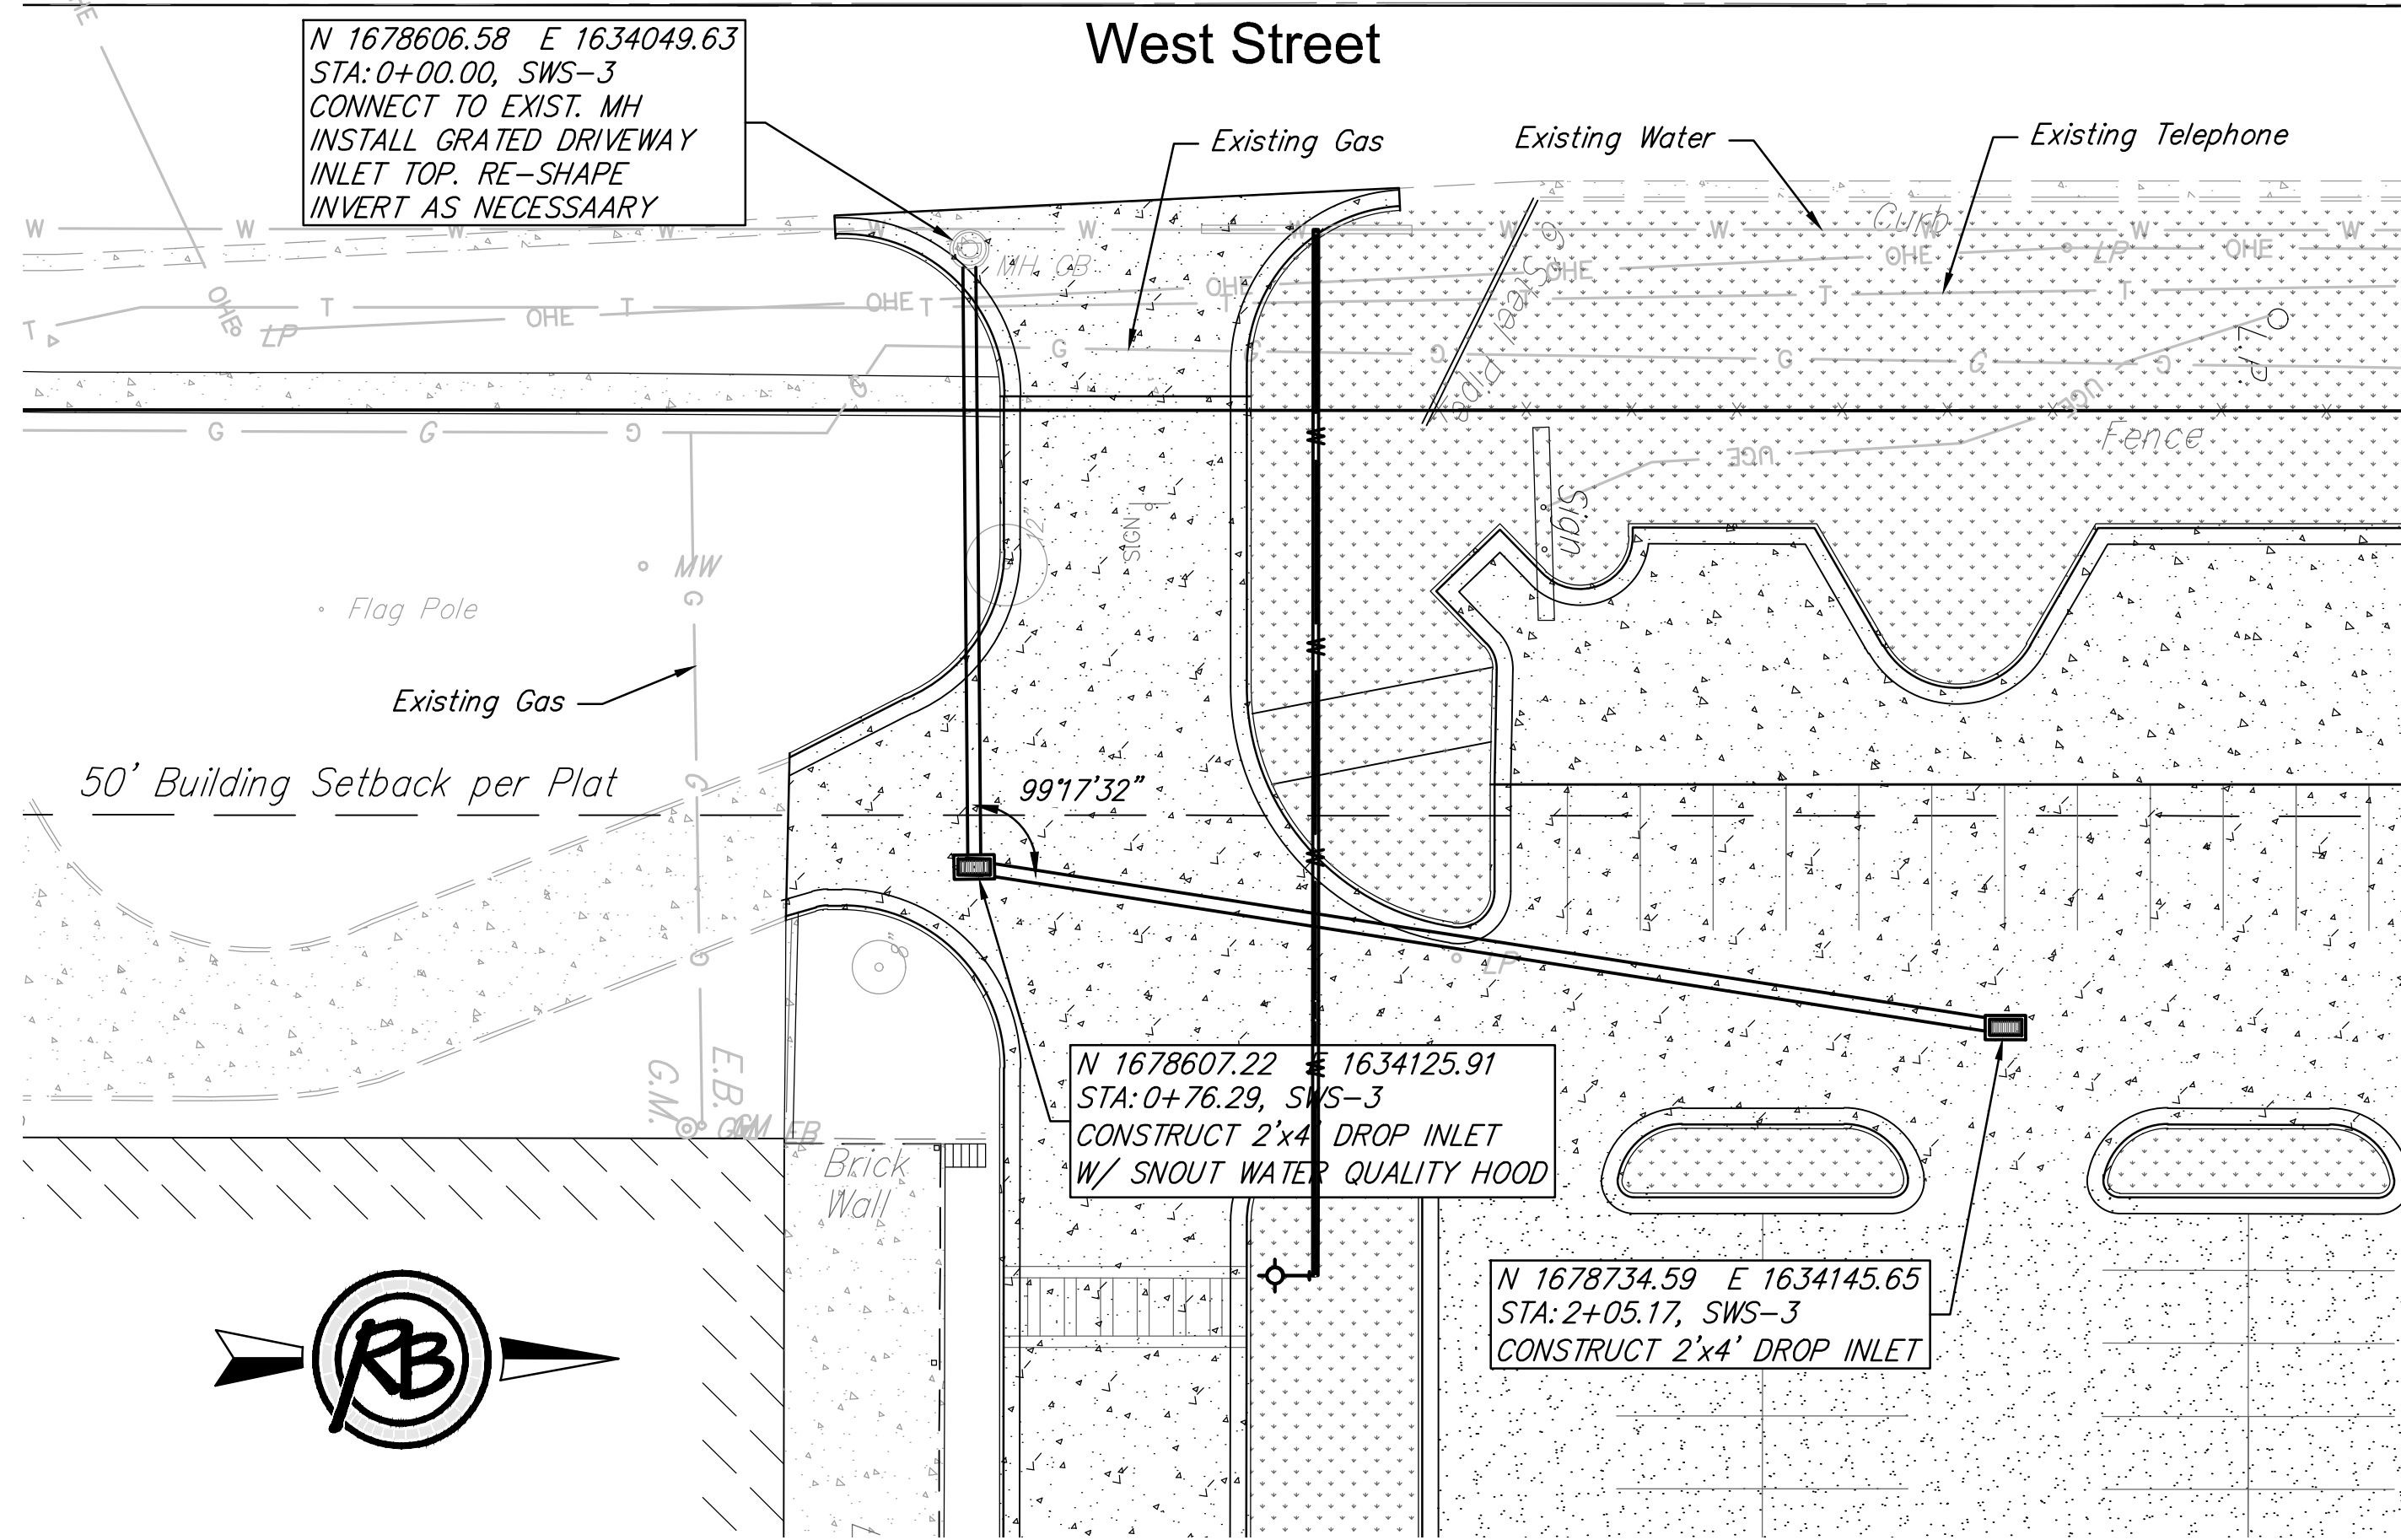



**RUGGLES BOHM**  
ARCHITECTS & ENGINEERS  
INCORPORATED  
1000 W. 17TH ST., SUITE 100  
WICHITA, KANSAS 67202  
TEL: 316.262.1234  
WWW.RUGGLESBOHM.COM

**FOLEY EQUIPMENT**  
**SWS-3 & 4**  
Wichita, Kansas

PROJECT NUMBER: 0390 PPD  
DESIGN: KWL  
DRAWING TITLE: DRIVING FILE  
DRAWN: DRS  
42650\_Engineering\_Base

REVIEW: 3-2-2016  
DATE: 4-25-2016

RB JOB: 42650  
SHEET: 9 OF 15

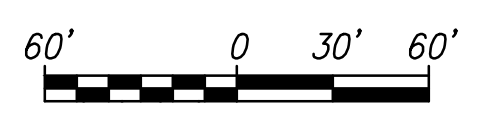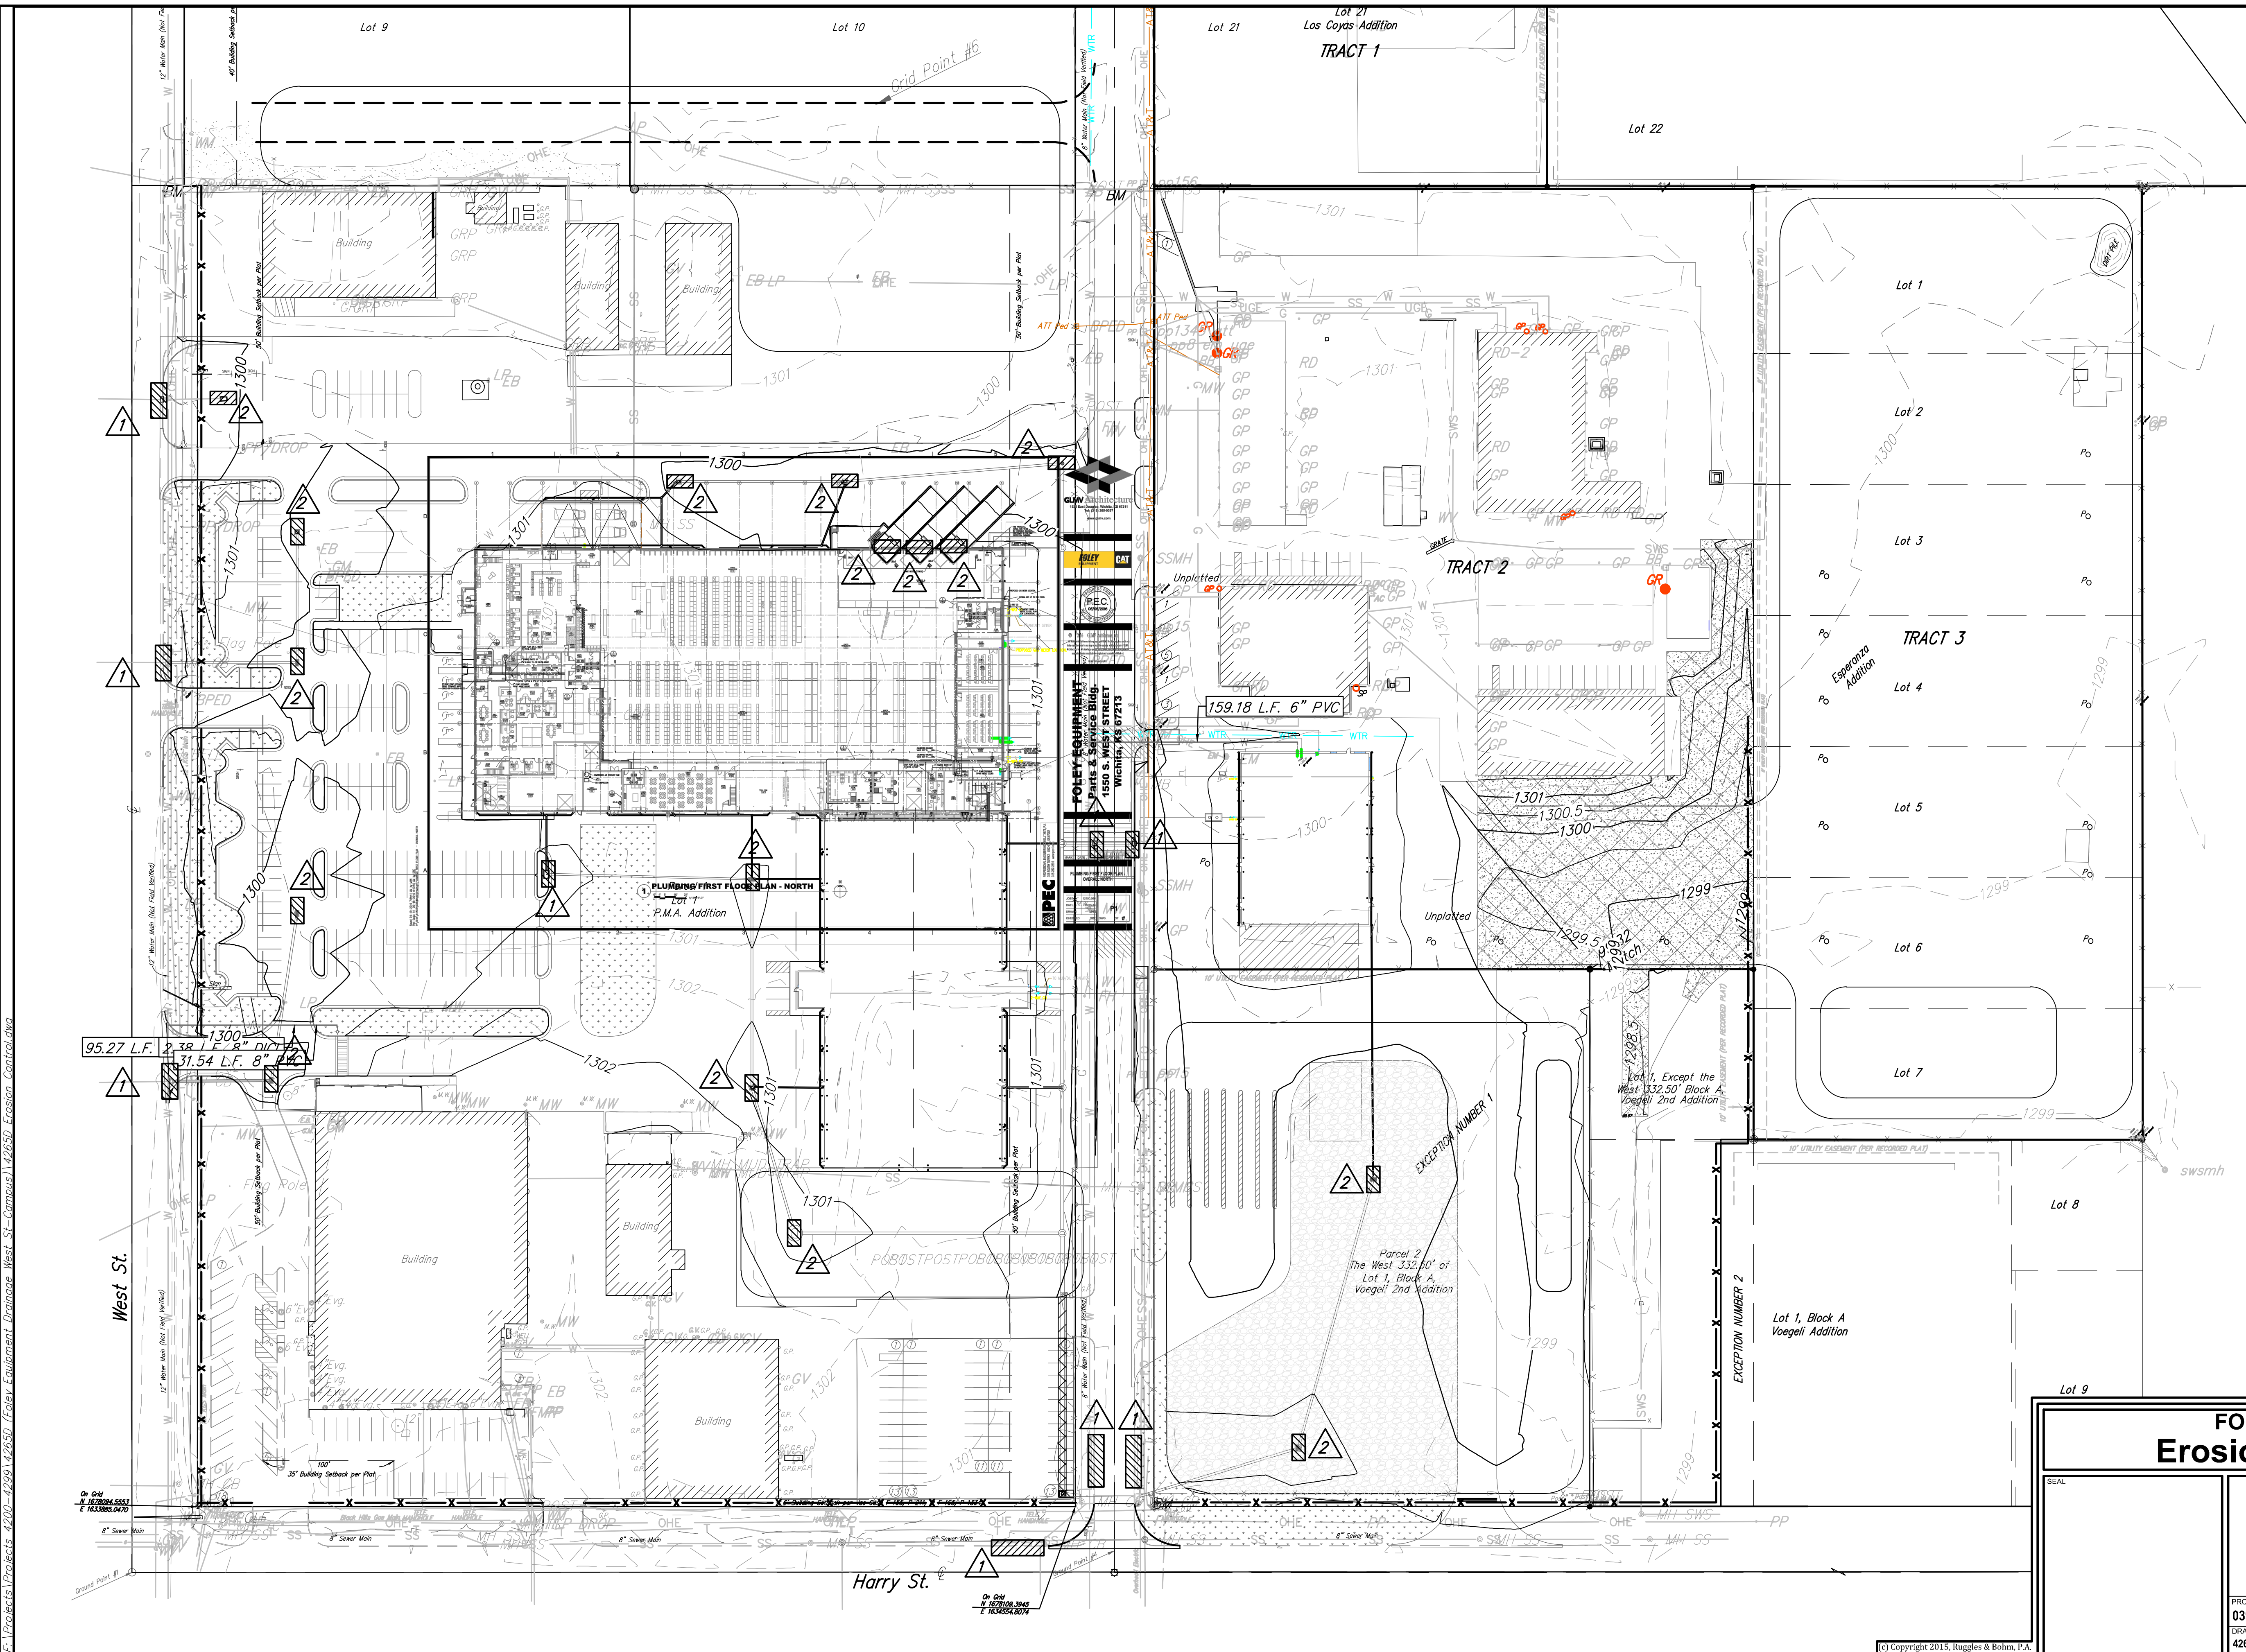

- x— INSTALL SILT FENCE (2570 L.F.)
- ▲1 INSTALL CURB INLET PROTECTION (8 Each)
- ▲2 INSTALL AREA INLET PROTECTION (18 Each)

### FOLEY EQUIPMENT Erosion Control Plan




**RUGGLES & BOHM**  
ENGINEERING | SURVEYING | LANDSCAPE ARCHITECTURE | GOVERNMENT  
924 NORTH MAIN WICHITA, KANSAS 67203 P (316) 264-8008 F (316) 264-4621  
WWW.RBKANSAS.COM


PROJECT NUMBER: 0390 PPD  
DRAWING FILE: 4265D Erosion Control [Erosion Control Plan]

DATE: 4-25-2016  
DESIGN: KWL  
DRAWN: DRS  
REVIEW: 3-2-2016  
SHEET: 10 OF 15


F:\Projects\Projects 4200-4299\4265D [Foley Equipment Drainage West St-Campus] 4265D Erosion Control.dwg

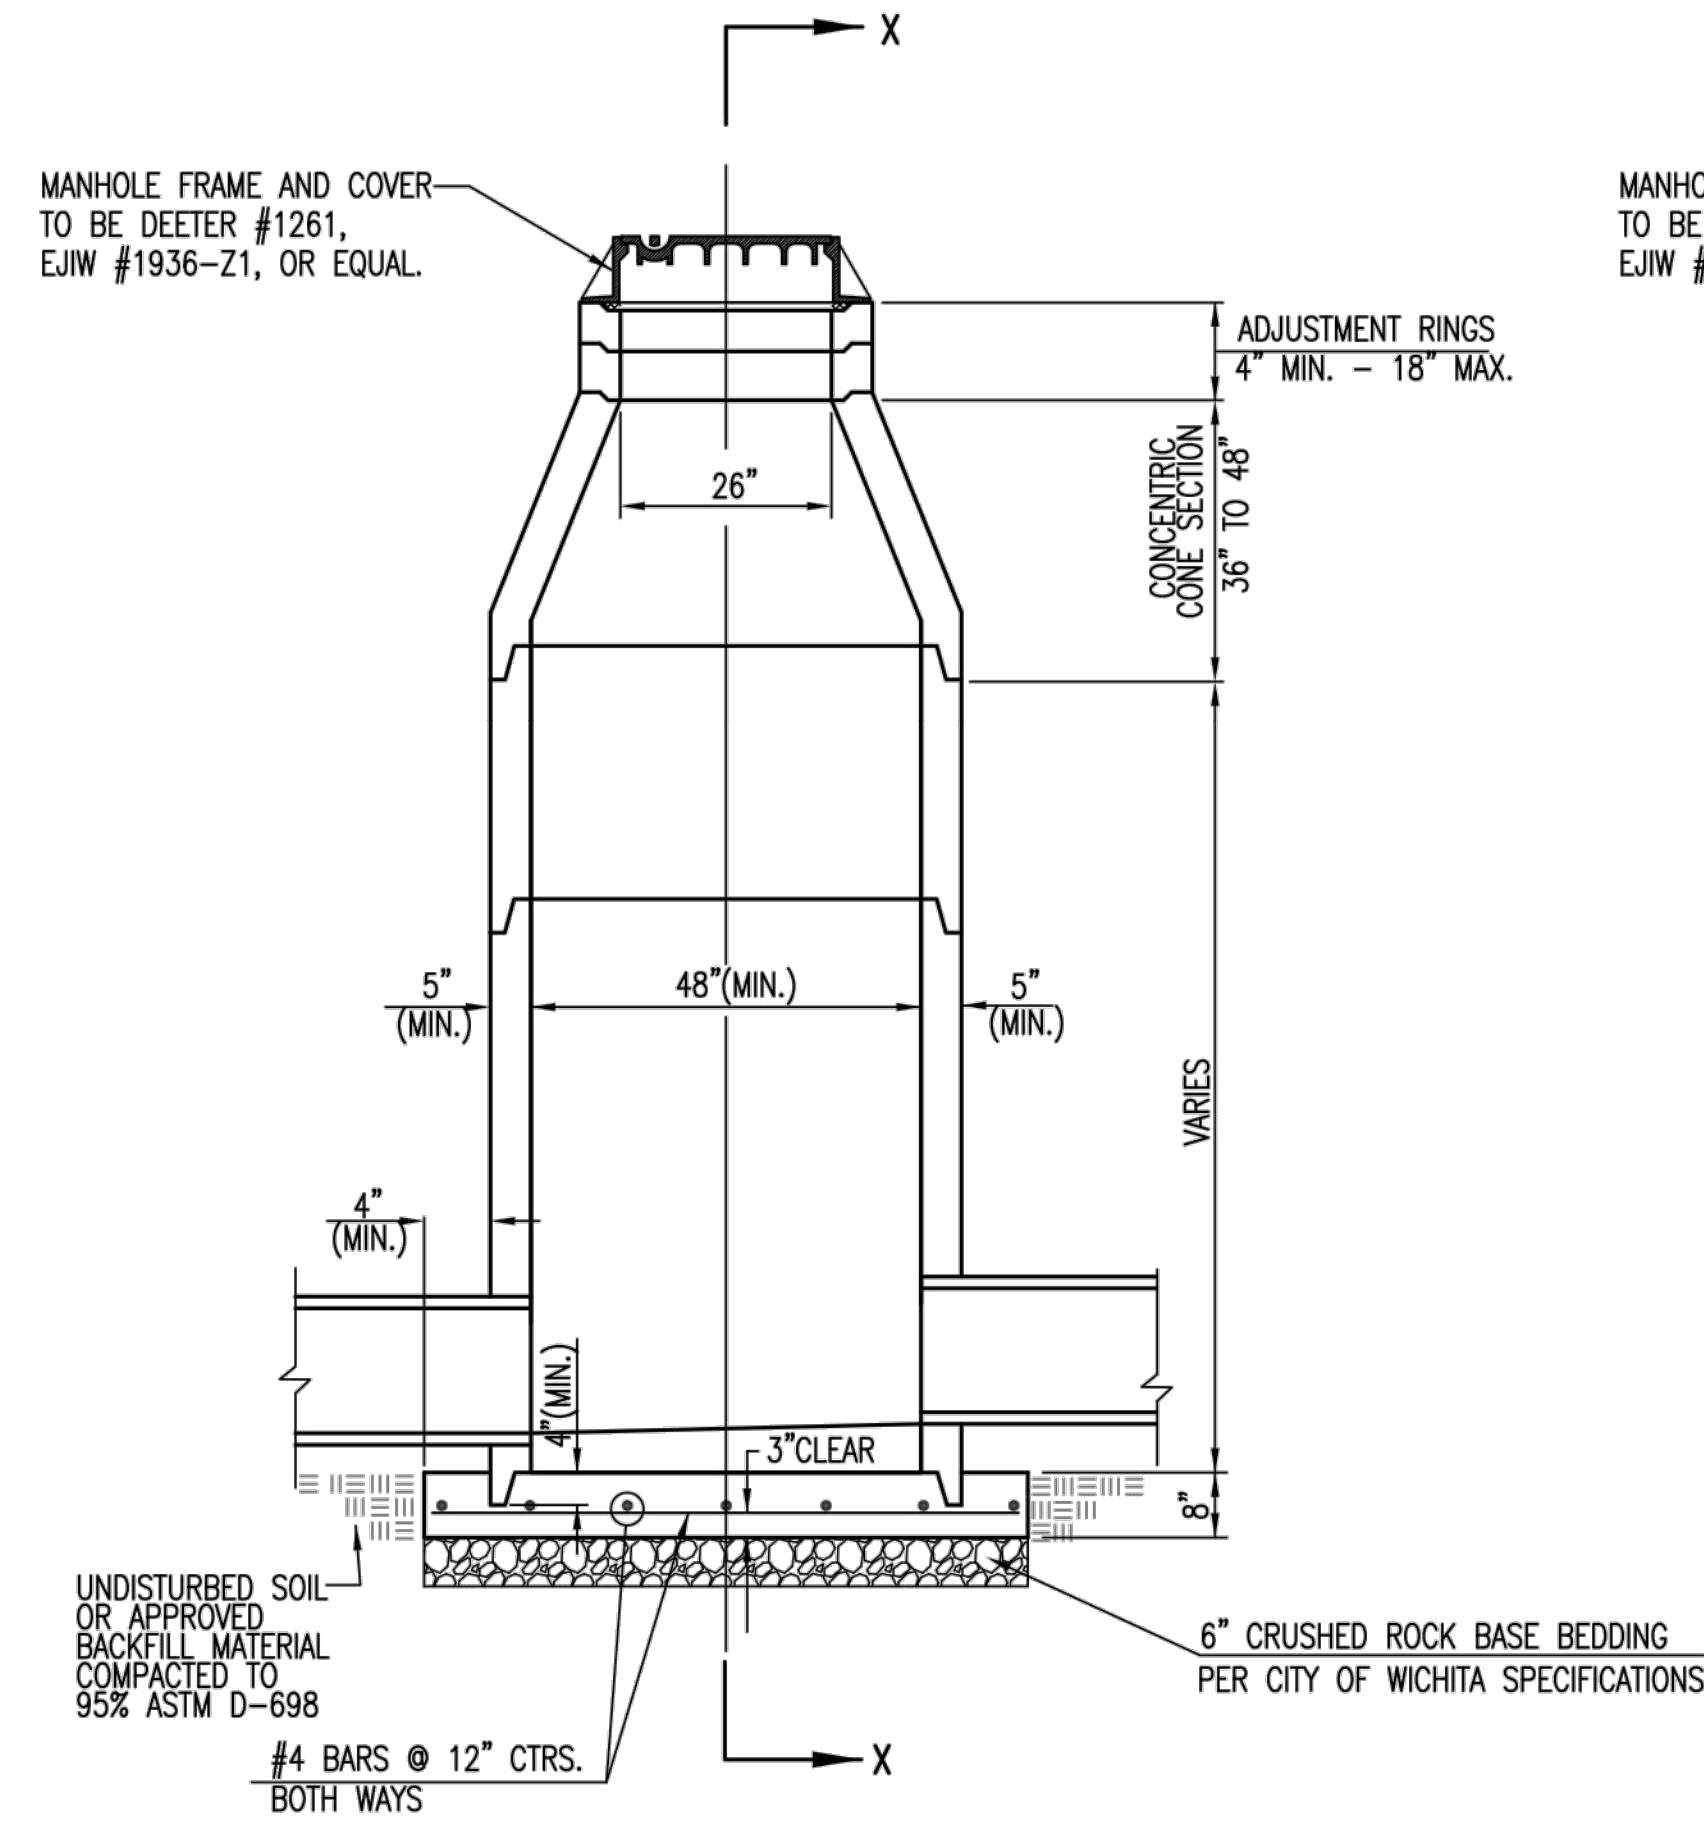


PRECAST STANDARD MANHOLE TYPE "A"

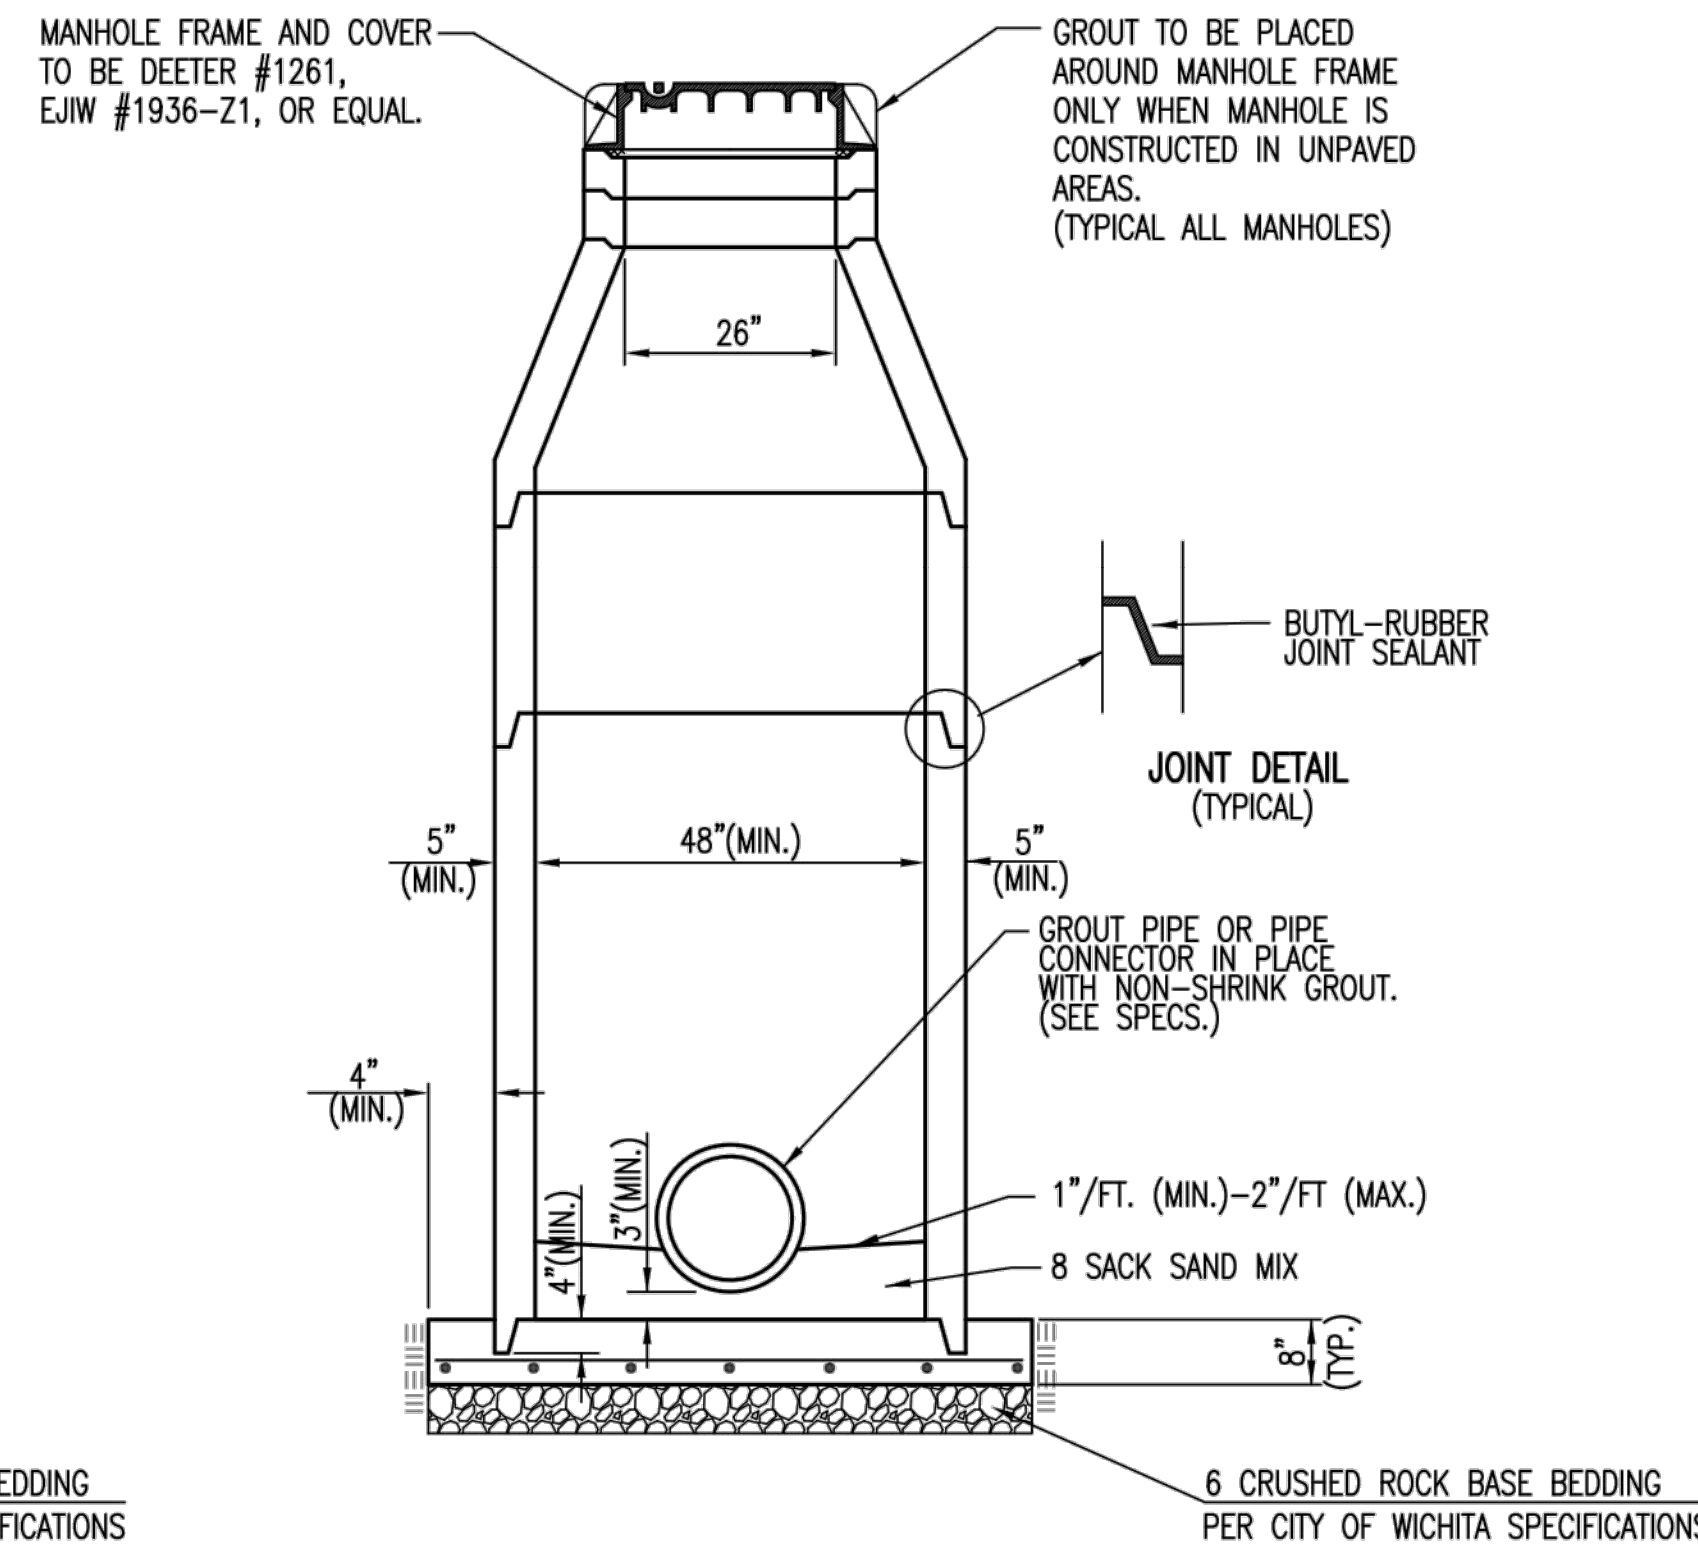

SECTION X-X (TYPICAL)

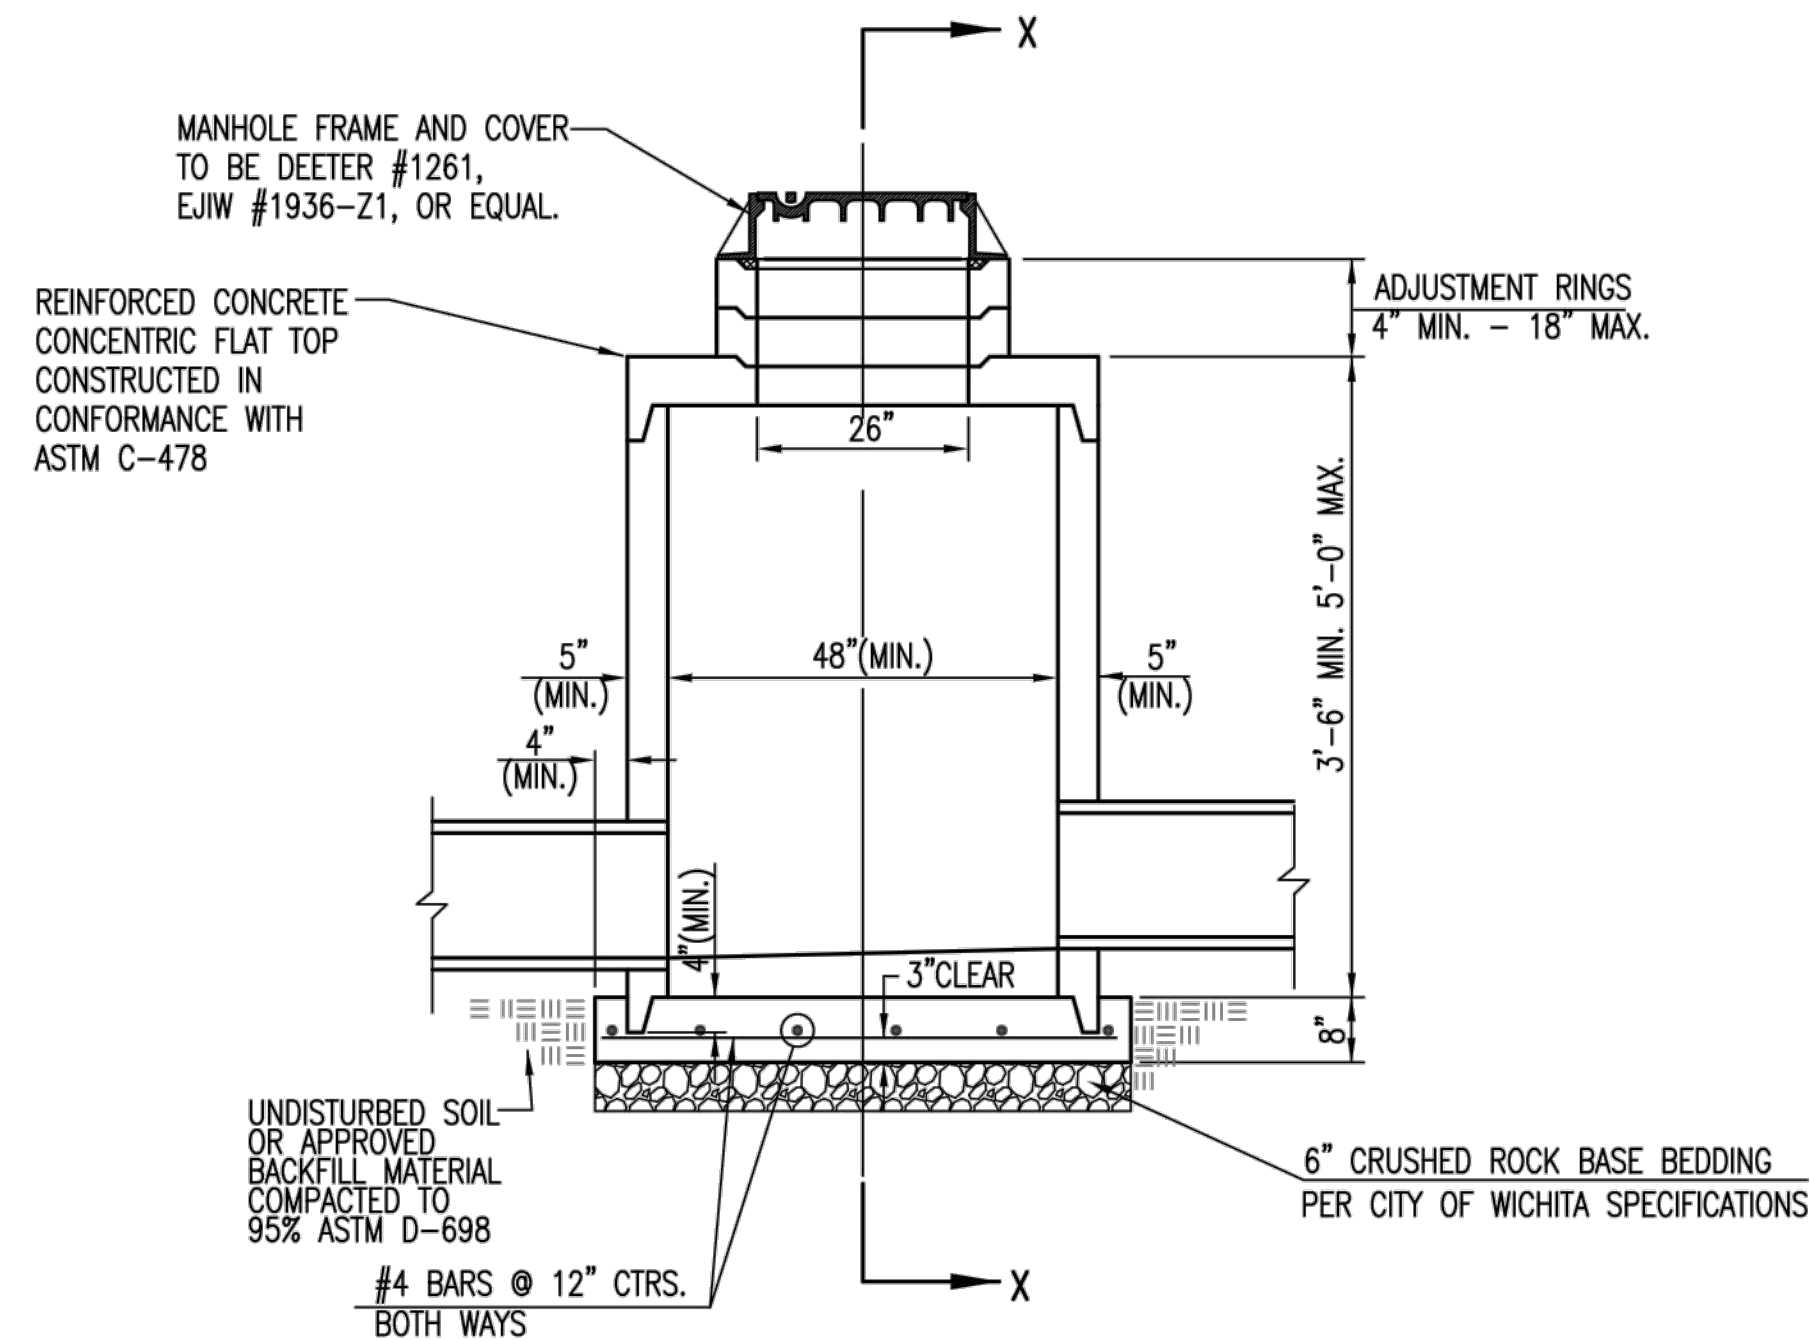

PRECAST SHALLOW MANHOLE TYPE "B"

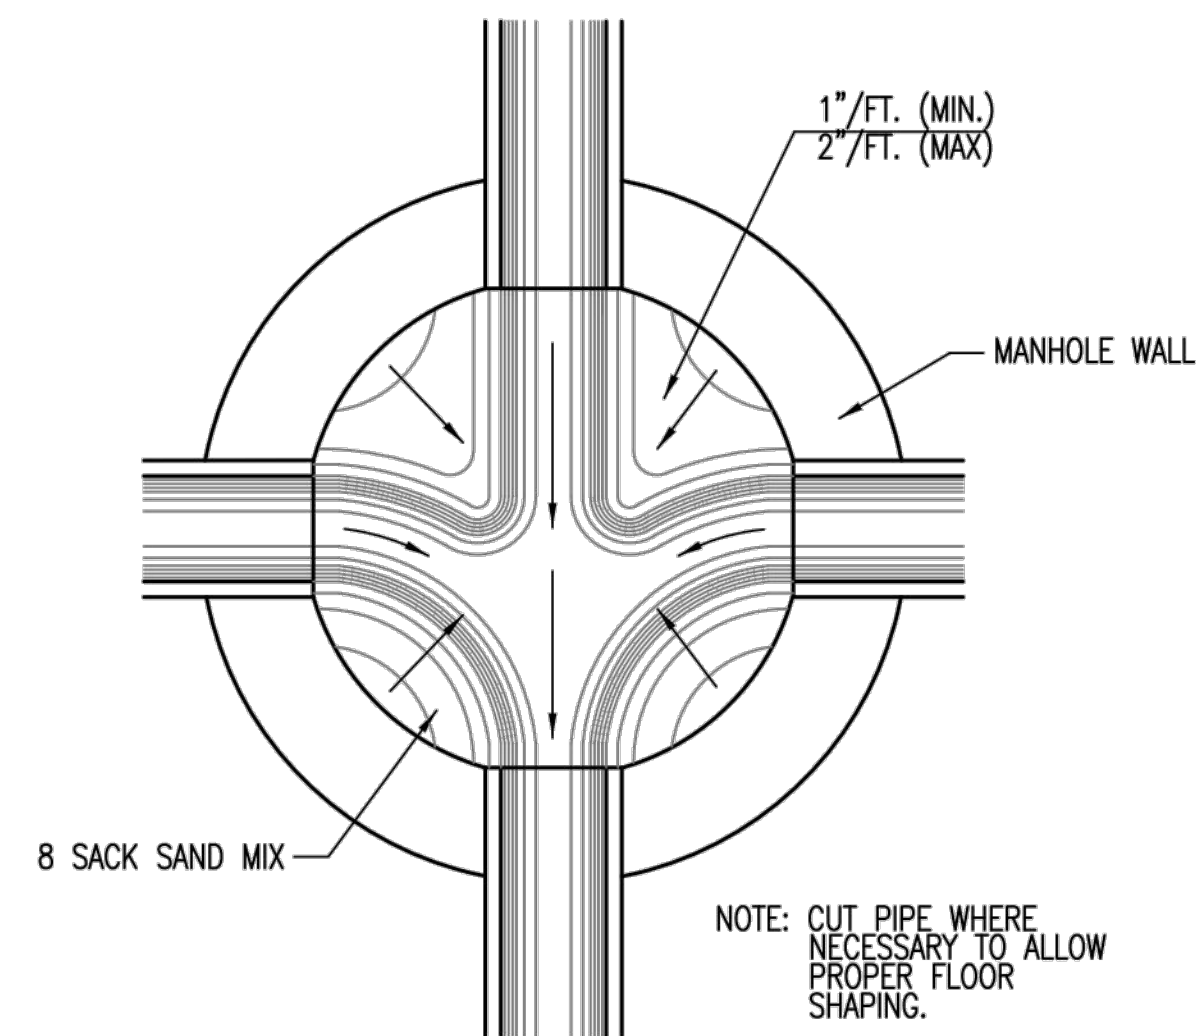



TYPICAL MANHOLE FLOOR SHAPING

GENERAL NOTES

- IF, IN THE OPINION OF THE ENGINEER, THE MANHOLE SUBGRADE APPEARS UNSTABLE, THE CONTRACTOR WILL HAVE THE OPTION TO COMPACT SUBGRADE AS SHOWN OR INCREASE THE THICKNESS OF THE MANHOLE BASE AS DIRECTED BY THE ENGINEER.
- STEEL REINFORCING WILL BE REQUIRED IN ALL MANHOLE BASES.
- ALL MANHOLE CONSTRUCTION SHALL BE WATER TIGHT.
- TOP OF MANHOLE FLOOR SLAB SHALL BE AT LEAST 3 INCHES BELOW THE FLOW LINE OF THE OUTLET PIPE TO INSURE SUFFICIENT MINIMUM THICKNESS OF SHAPED INVERT.
- ALL PRECAST CONCRETE MANHOLE SECTIONS SHALL CONFORM TO THE LATEST REVISION OF ASTM C-478 AS MODIFIED BY THE SPECIFICATIONS.
- CONCRETE USED FOR MANHOLE CONSTRUCTION SHALL CONFORM TO CITY OF WICHITA SPECIFICATIONS FOR CONCRETE PAVEMENT MIX.
- PRECAST MANHOLES SHALL BE SET AT LEAST 4 INCHES INTO MANHOLE BASE.
- MANHOLES WITH PIPE SIZES 24" AND LARGER SHALL HAVE 5 FOOT INSIDE DIAMETER (MIN.)
- MANHOLES WITH PRECAST BASES MAY BE USED AT THE CONTRACTORS OPTION. THESE MANHOLES SHALL HAVE AN 8" MINIMUM BASE THICKNESS AND SHALL BE PLACED ON AN 8" MIN. CRUSHED ROCK BASE. PIPES SHALL BE ENCASED WITH CRUSHED ROCK TO AT LEAST 3 FEET FROM THE MANHOLE WALL.
- CONTRACTOR SHALL REMOVE LIFTING HOOKS AFTER INSTALLATION. RECESSES IN MANHOLE WALL SHALL BE GROUTED FLUSH TO THE MANHOLE WALL WITH HYDRAULIC CEMENT AFTER THE MANHOLE IS IN PLACE. LIFTING HOLES THRU THE MANHOLE WALL WILL NOT BE ACCEPTED.
- THE ENDS OF ALL PIPES IN MANHOLES SHALL BE CUT OFF FLUSH WITH THE INSIDE FACE OF THE MANHOLE WALL.
- MANHOLE INVERT SHALL BE SHAPED WITH 8 SACK SAND MIX CONCRETE TO CREATE FLOW CHANNELS AND TO INCREASE HYDRAULIC EFFICIENCY SUCH THAT THE MANHOLE WILL BE SELF CLEANING BETWEEN ALL INLET AND/OR OUTLET PIPES.
- MANHOLE FRAME AND COVER TO BE DEETER #1261, EJIW #1936-Z1, OR APPROVED EQUAL, SEE SW-303.
- FOR FLAT GRATED INLET APPLICATION, GRATE TO BE DEETER #1933, EJIW #1205 MDI, OR APPROVED EQUAL.
- FOR BEEHIVE GRATE APPLICATION, GRATE TO BE DEETER #4495, EJIW #120545, OR APPROVED EQUAL.



**CITY OF WICHITA**  
PUBLIC WORKS & UTILITIES  
ENGINEERING DIVISION

<b>PRECAST CONCRETE MANHOLE (STORM SEWER)</b>		
CITY ENGINEER <b>GARY JANZEN, P.E.</b>		
PROJECT NUMBER 0390 PPD	OCA NUMBER 607861	DATE 11/2010
CITY ENGINEER'S OFFICE CITY HALL - SEVENTH FLOOR 455 NORTH MAIN STREET WICHITA, KANSAS 67202-1620 (316) 268-4501		SHEET <b>11</b> 15

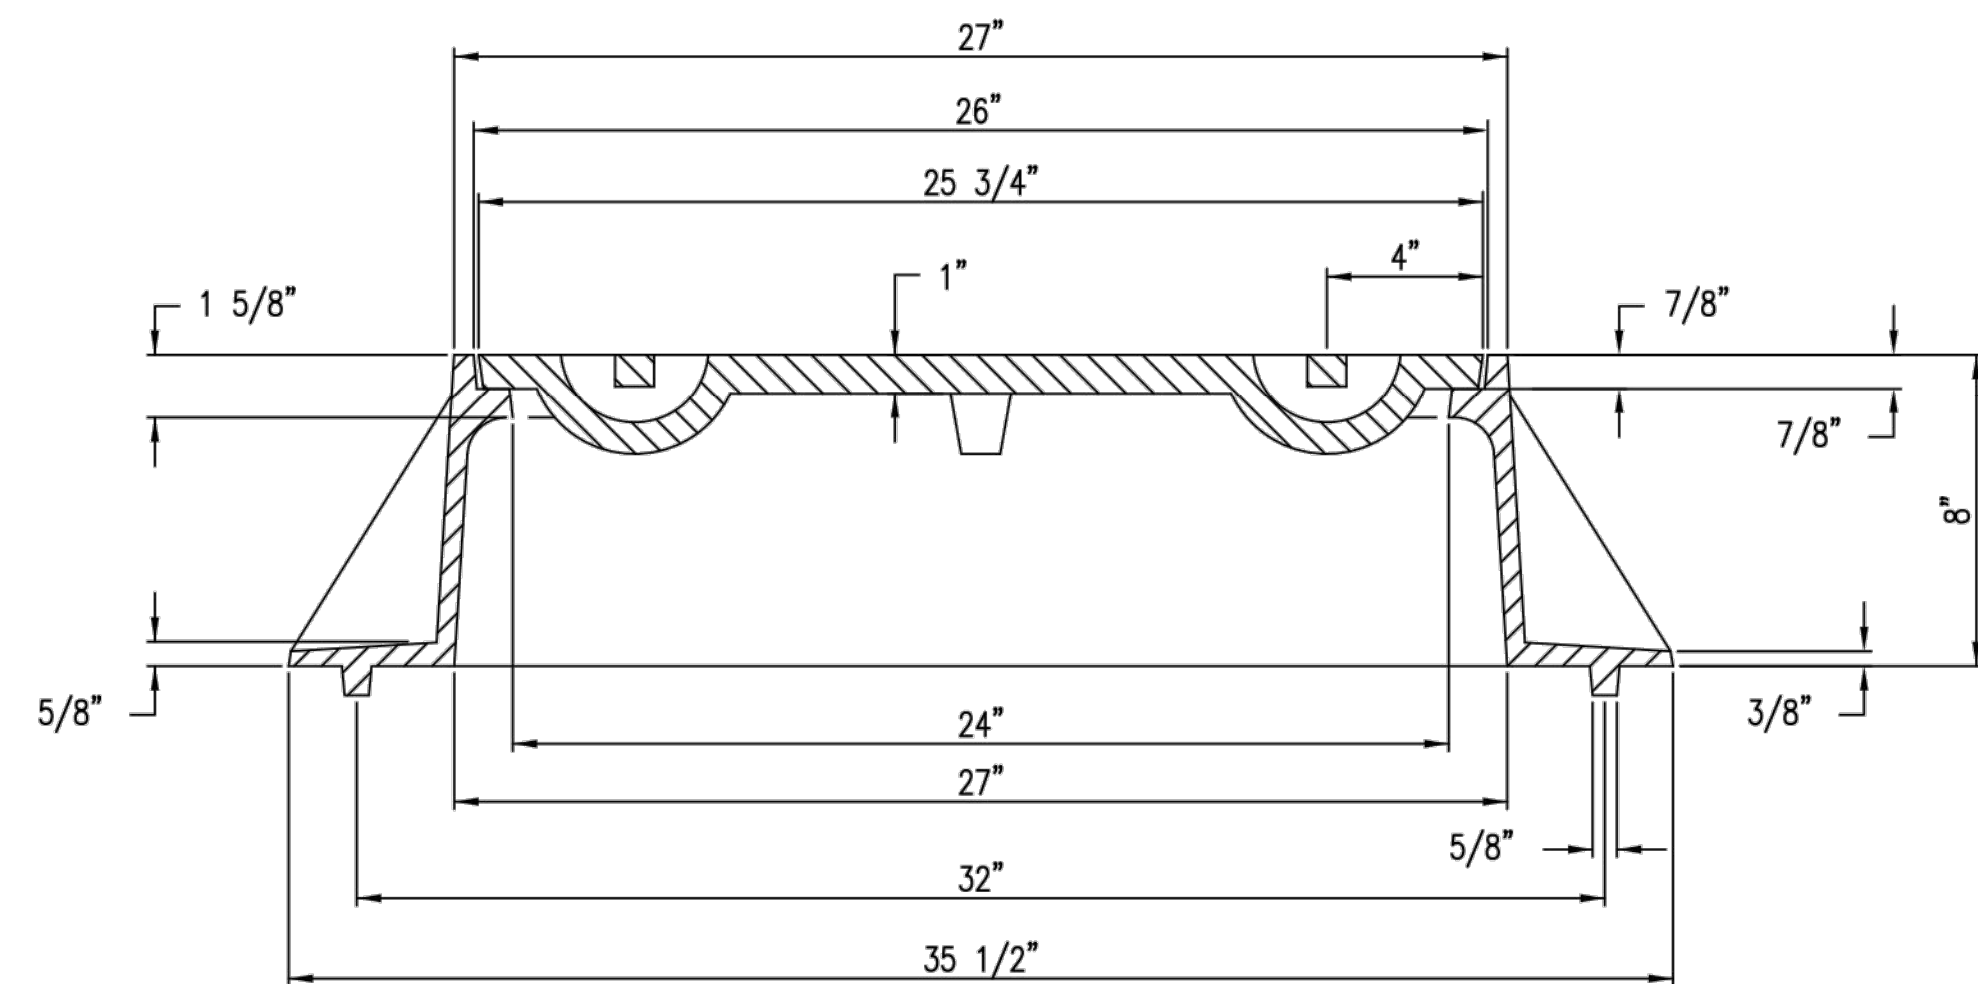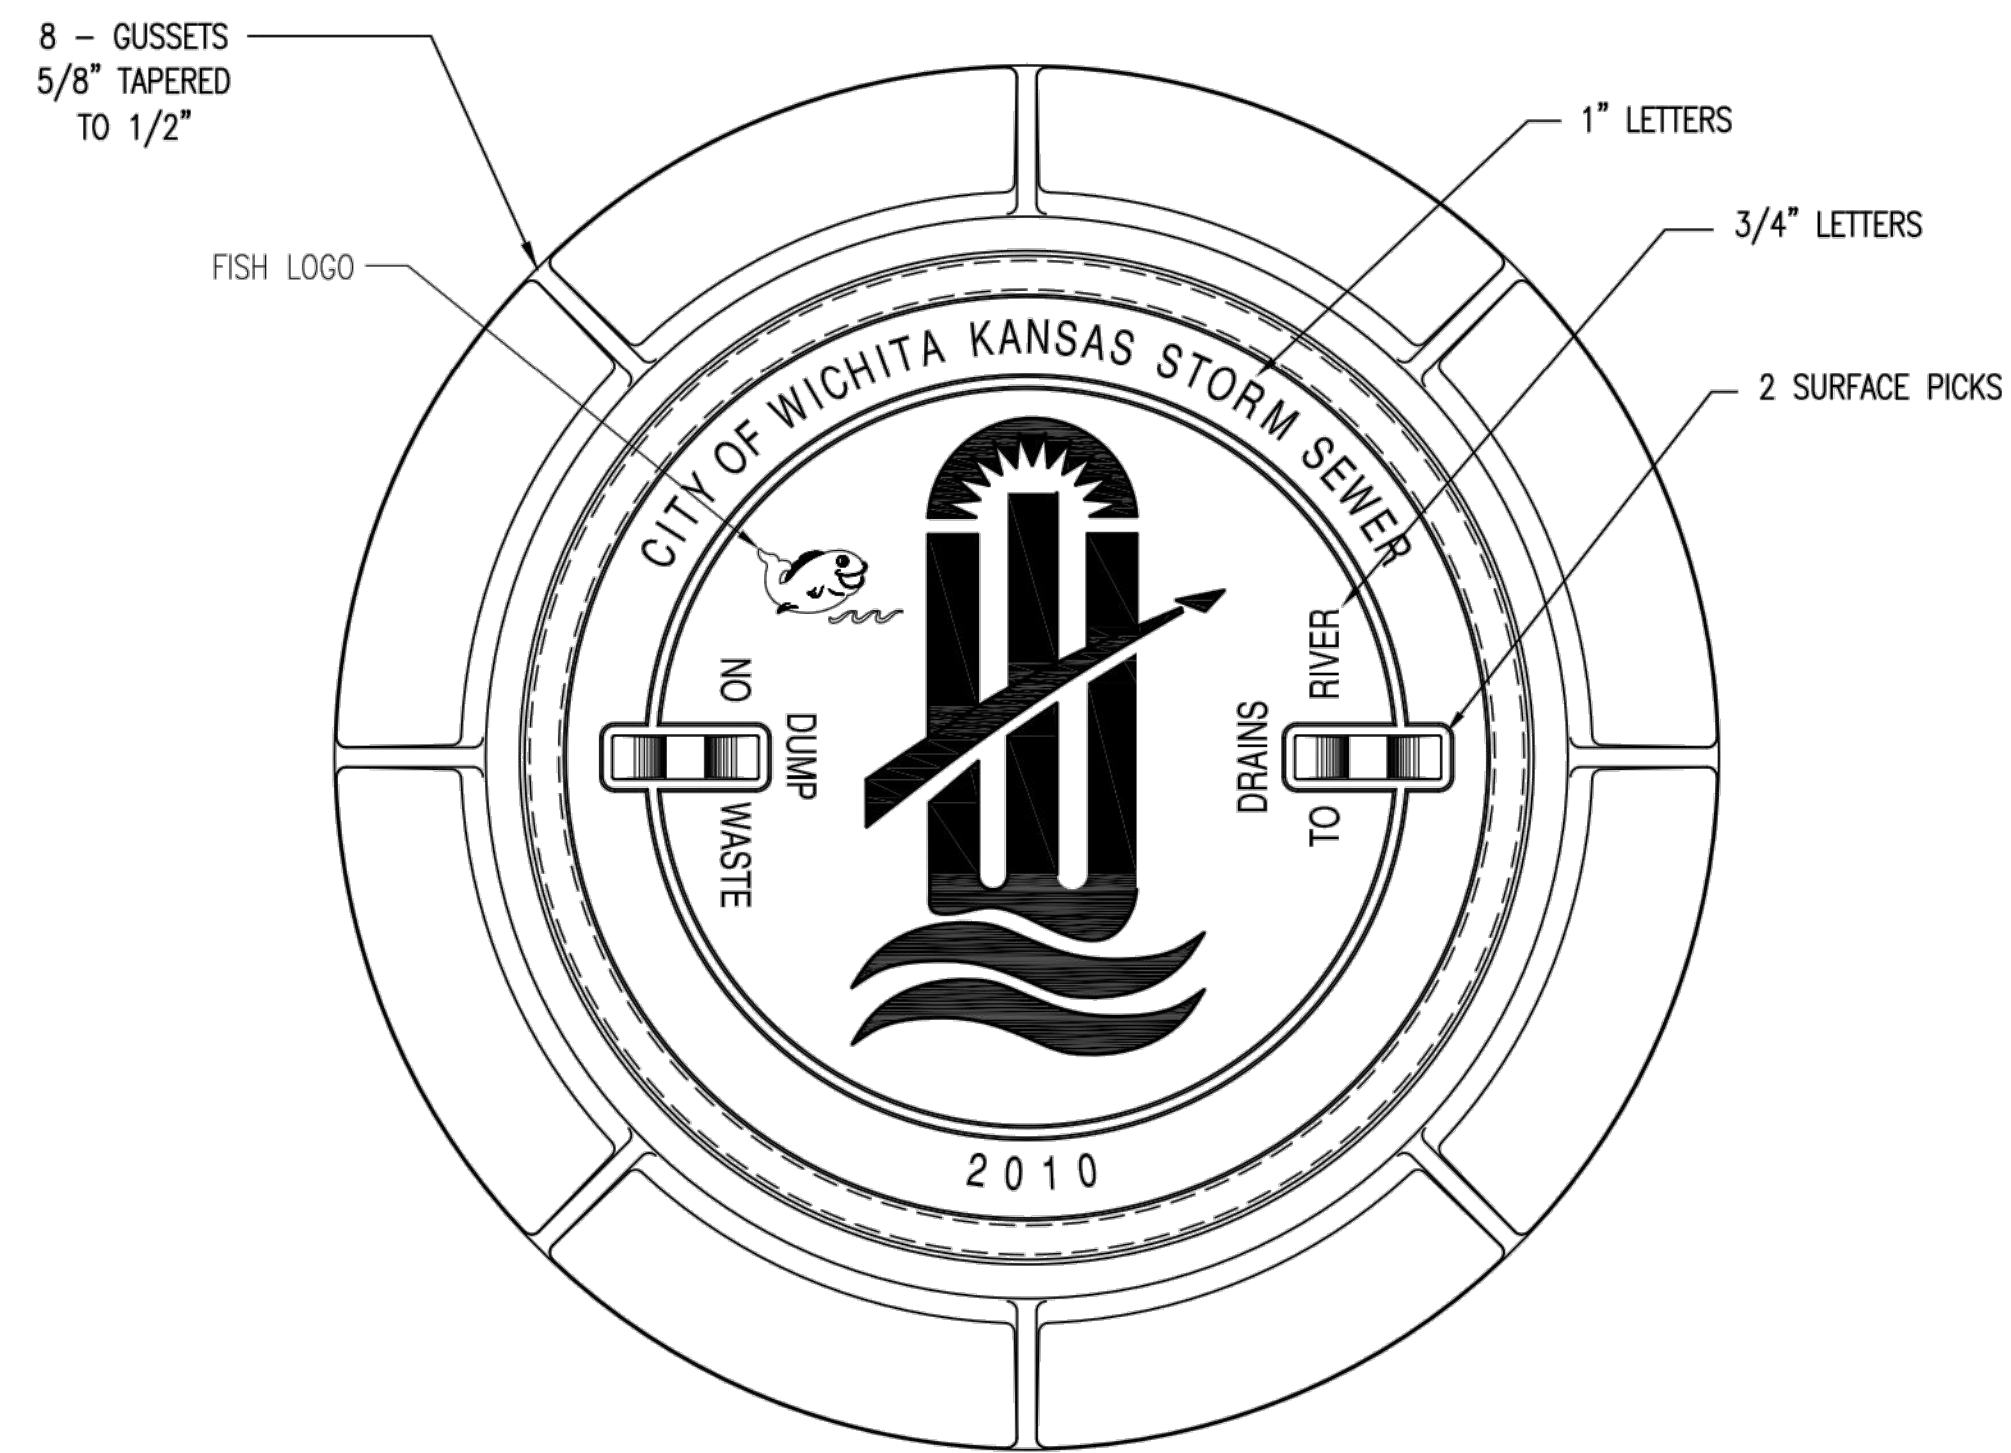

**MANHOLE FRAME**  
**DEETER #1261 OR EJIW #1936-Z1**

- NOTE:
1. FURNISHED WITH MACHINED HORIZONTAL BEARING SURFACE.
  2. COVER TO BE DEETER #1261 OR EJIW #1936A.

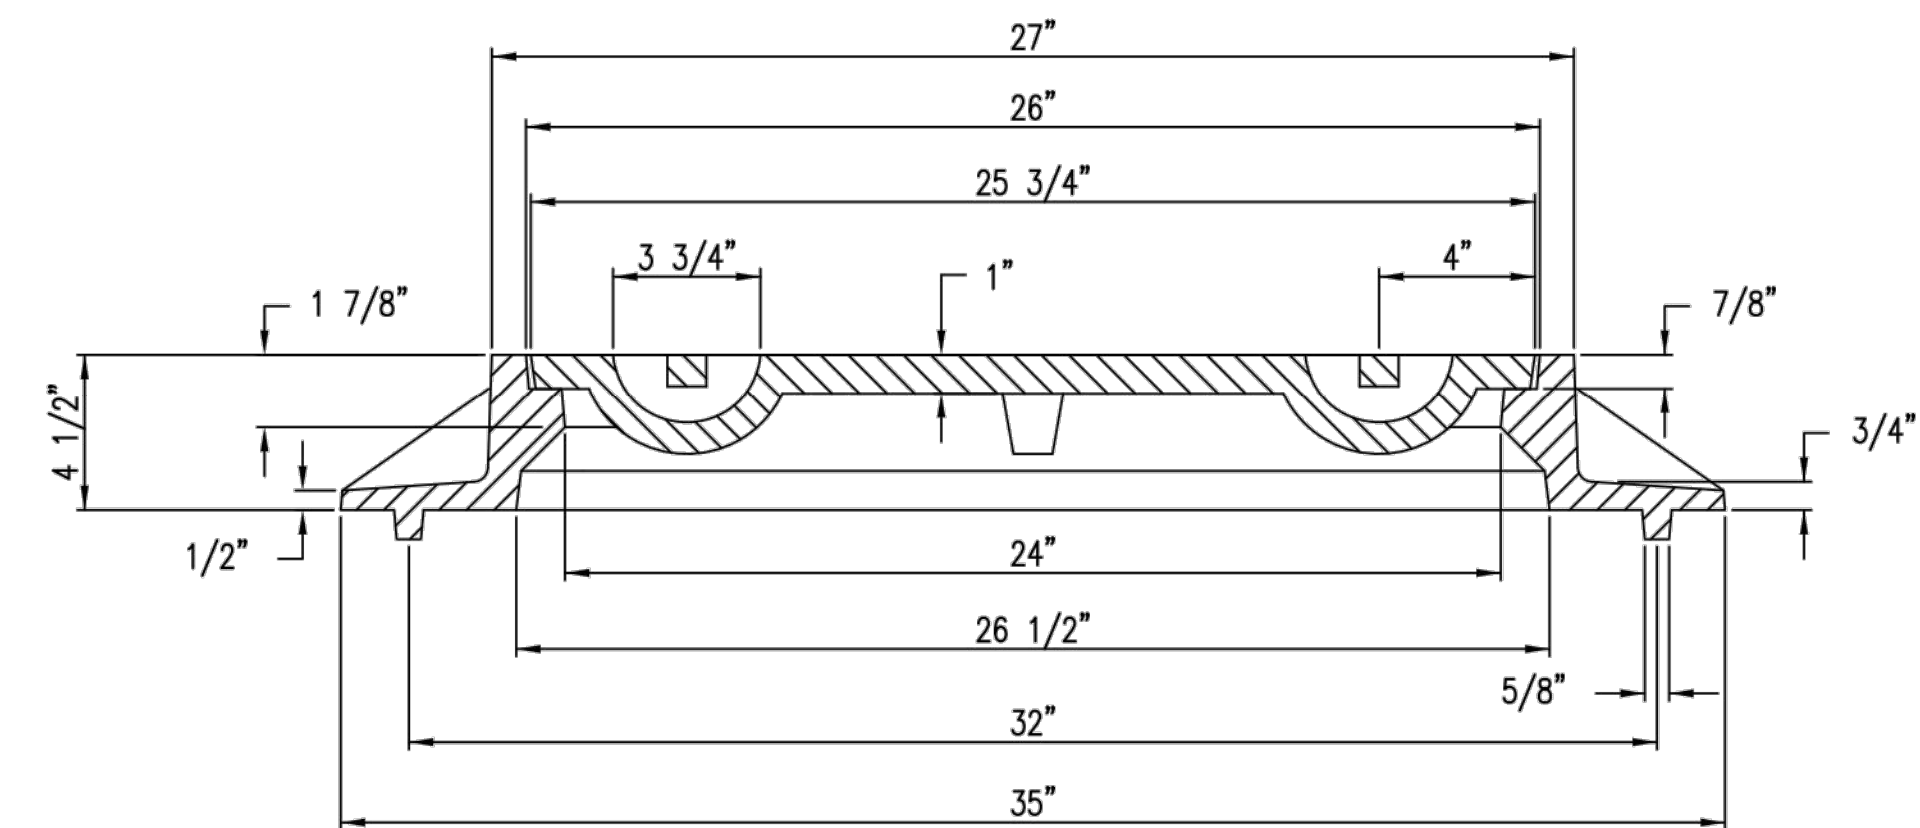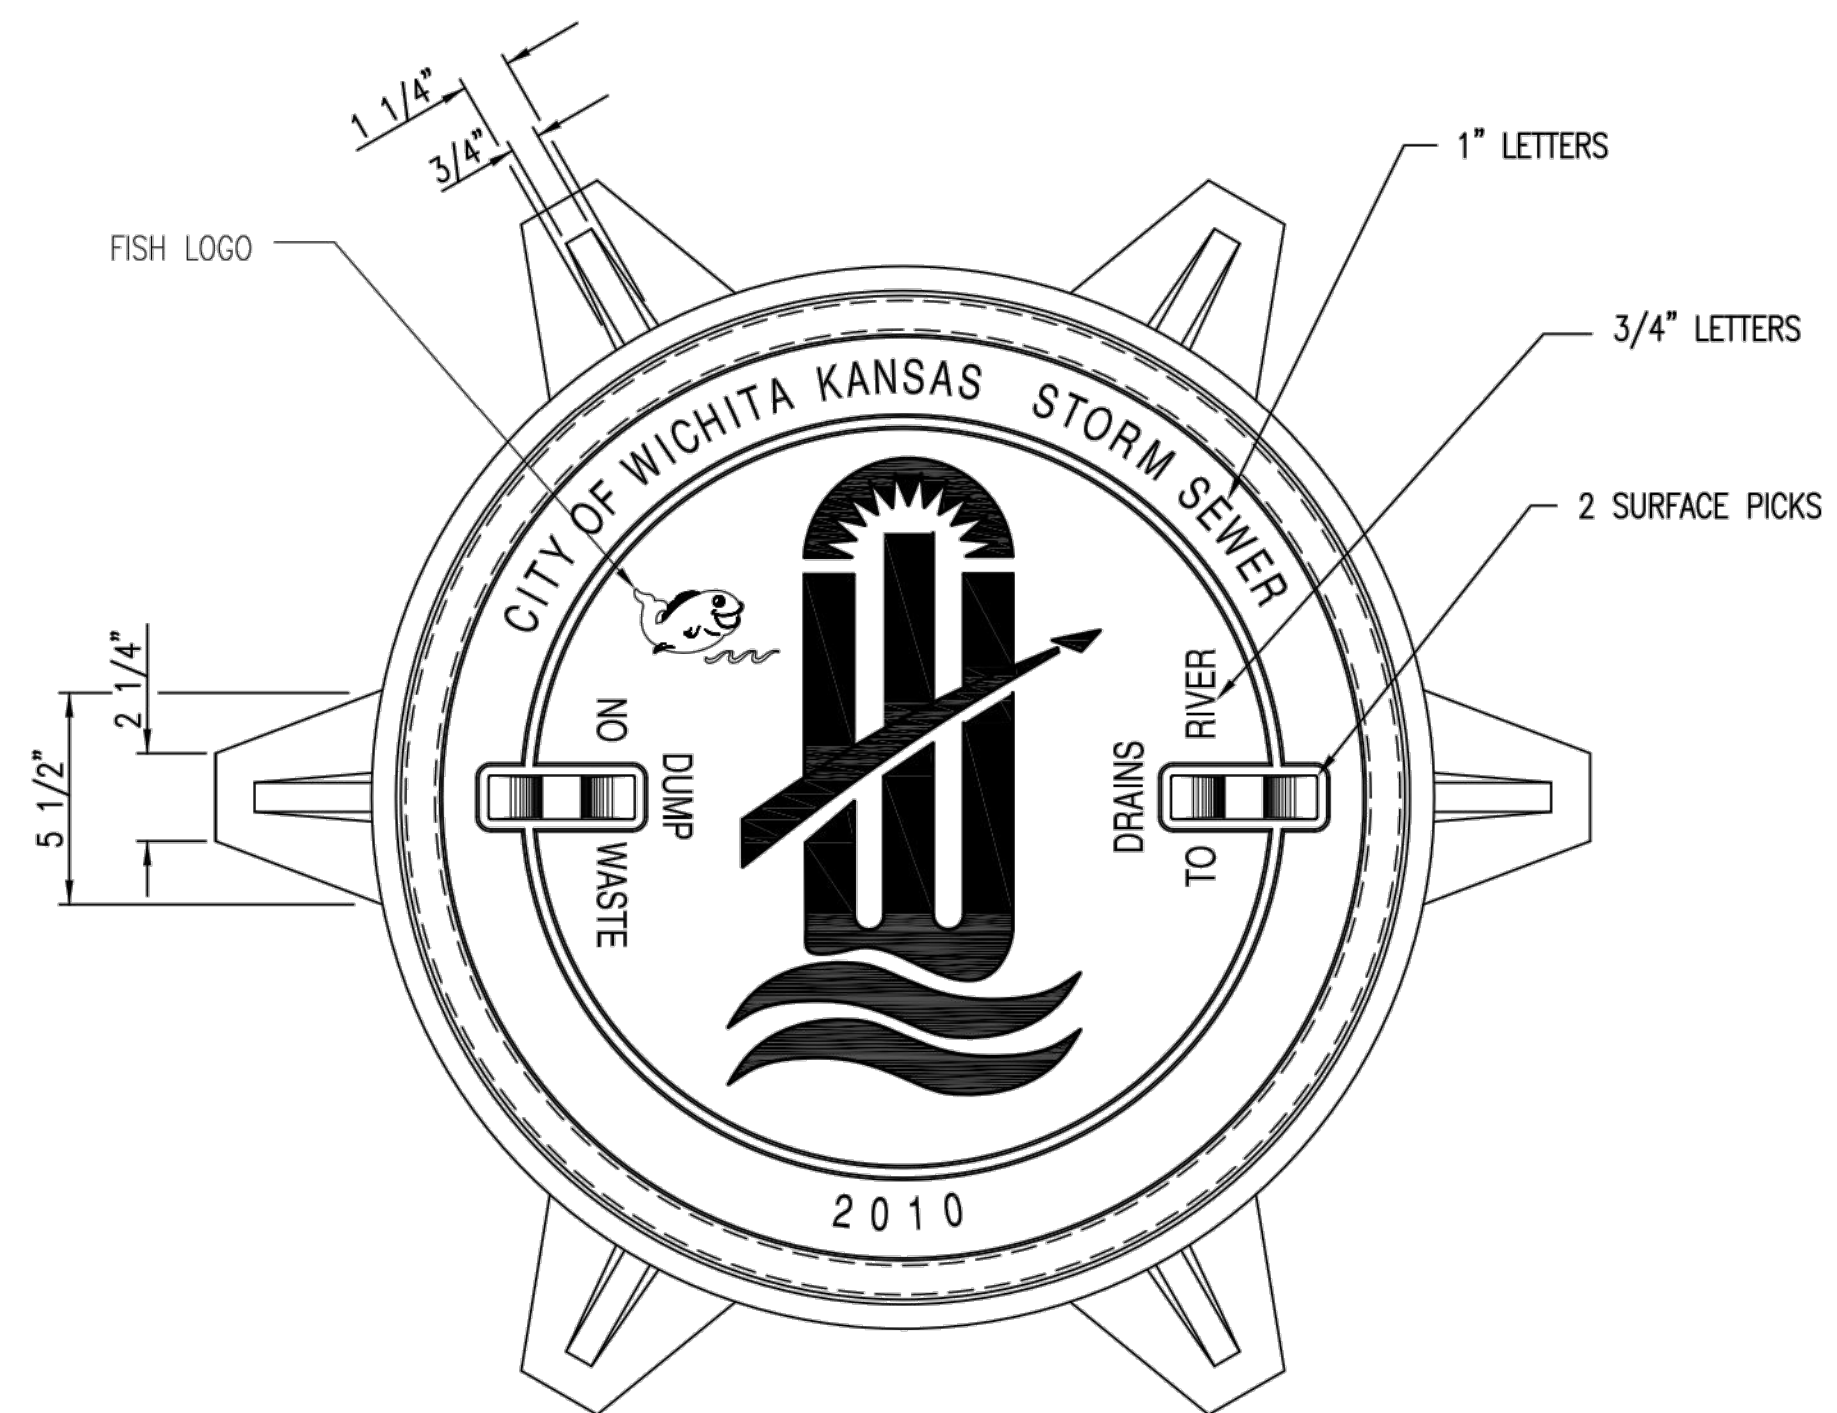


**INLET FRAME**  
**DEETER #2014 OR EJIW #1936-Z4**

- NOTE:
1. FURNISHED WITH MACHINED HORIZONTAL BEARING SURFACES.
  2. NOT TO BE USED UNDER PAVEMENT.
  3. COVER TO BE DEETER #1261 OR EJIW #1936A.




<b>MANHOLE/INLET FRAME AND COVER (STORM SEWER)</b>		
CITY ENGINEER <b>GARY JANZEN, P.E.</b>		
PROJECT NUMBER 0390 PPD	OCA NUMBER 607861	DATE 11/2010
CITY ENGINEER'S OFFICE CITY HALL - SEVENTH FLOOR 455 NORTH MAIN STREET WICHITA, KANSAS 67202-1620 (316) 268-4501		SHEET <b>12</b> 15

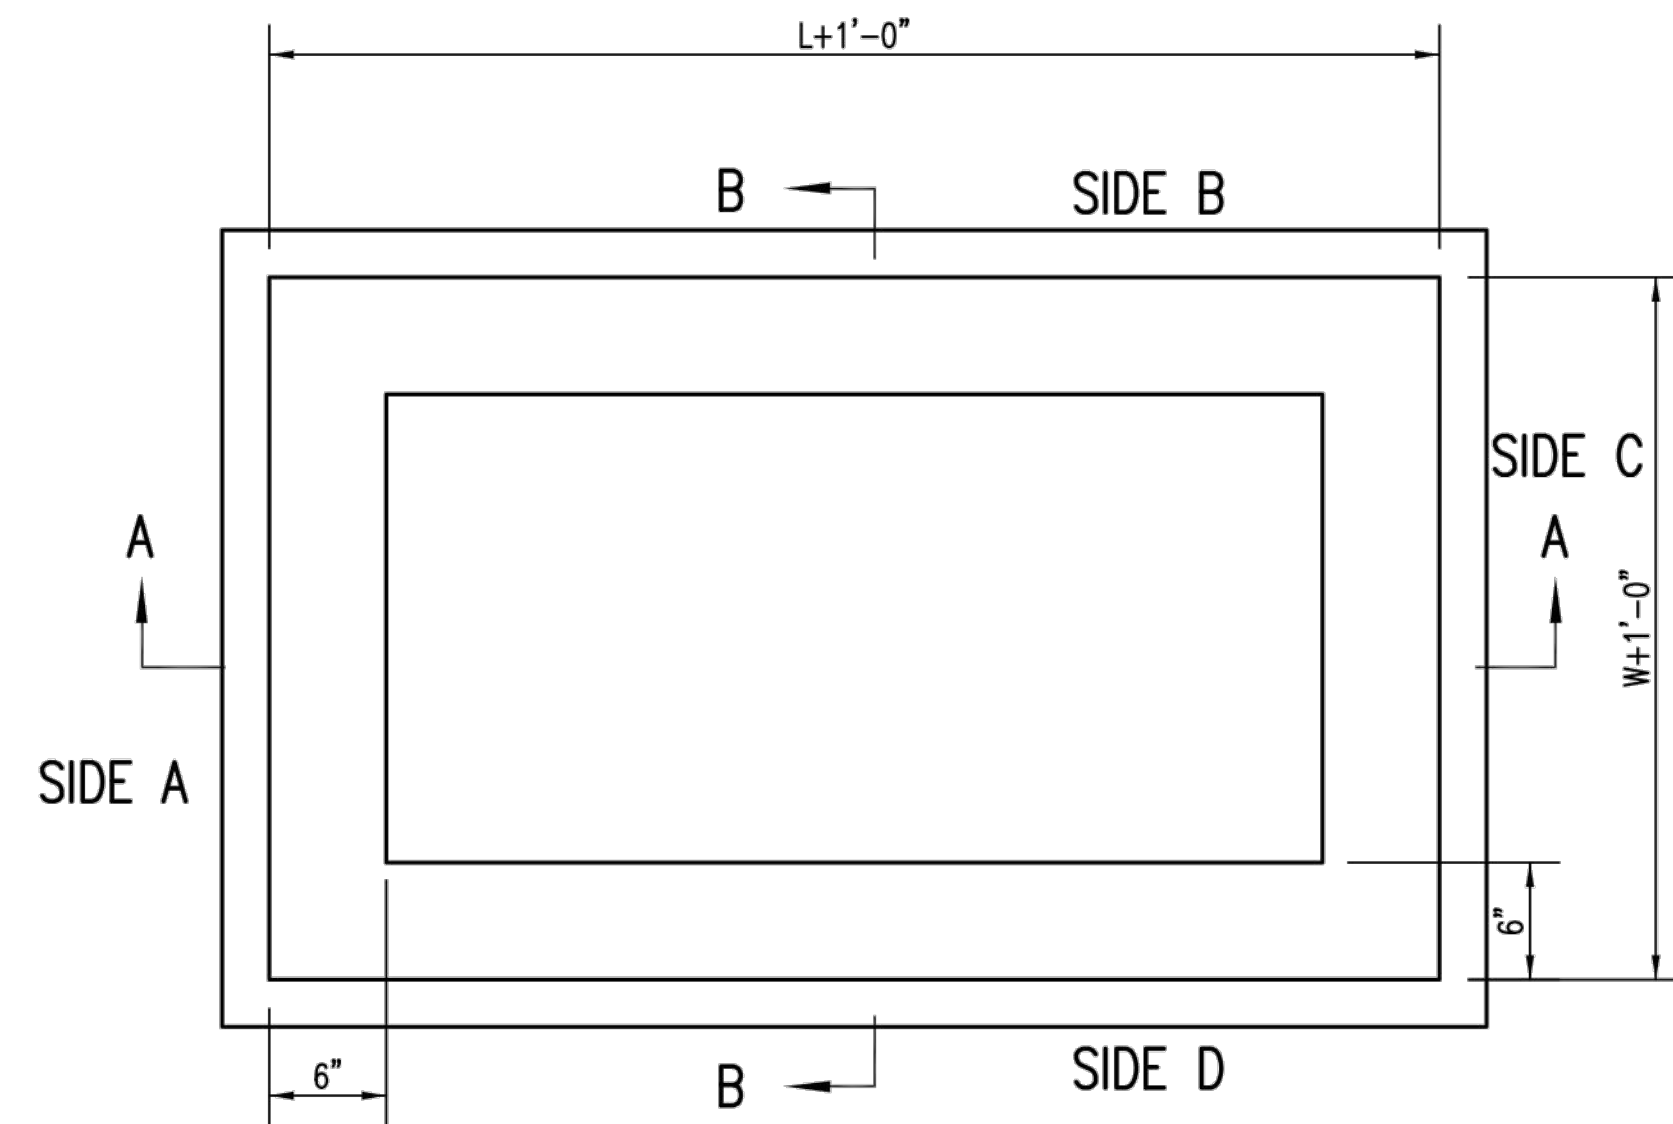


TOP VIEW

GENERAL NOTES

1. GRATE FRAME TO BE INSTALLED ON THIN MORTAR CUSHION TO INSURE FULL SUPPORT ALONG BRICK. CONCRETE USED FOR INLET CONSTRUCTION SHALL CONFORM TO CITY OF WICHITA SPECIFICATIONS FOR CONCRETE PAVEMENT MIX.
2. INLET INVERT SHALL BE SHAPED WITH 8 SACK SAND MIX CONCRETE TO CREATE FLOW CHANNELS AND TO INCREASE HYDRAULIC EFFICIENCY SUCH THAT THE INLET WILL BE SELF CLEANING BETWEEN ALL INLET AND/OR OUTLET PIPES.
3. THE ENDS OF ALL PIPES INSTALLED IN INLETS SHALL BE CUT OFF FLUSH WITH THE INSIDE FACE OF THE INLET WALL.
4. INLET FRAME AND GRATE TO BE DEETER #1261, EJV #1936-Z1 OR APPROVED EQUAL, SEE SW-303.
5. CONTRACTOR SHALL REMOVE LIFTING HOOKS AFTER INSTALLATION. RECESSES IN MANHOLE WALL SHALL BE GROUTED FLUSH TO THE MANHOLE WALL WITH HYDRAULIC CEMENT AFTER THE MANHOLE IS IN PLACE. LIFTING HOLES THRU THE MANHOLE WALL WILL NOT BE ACCEPTED.

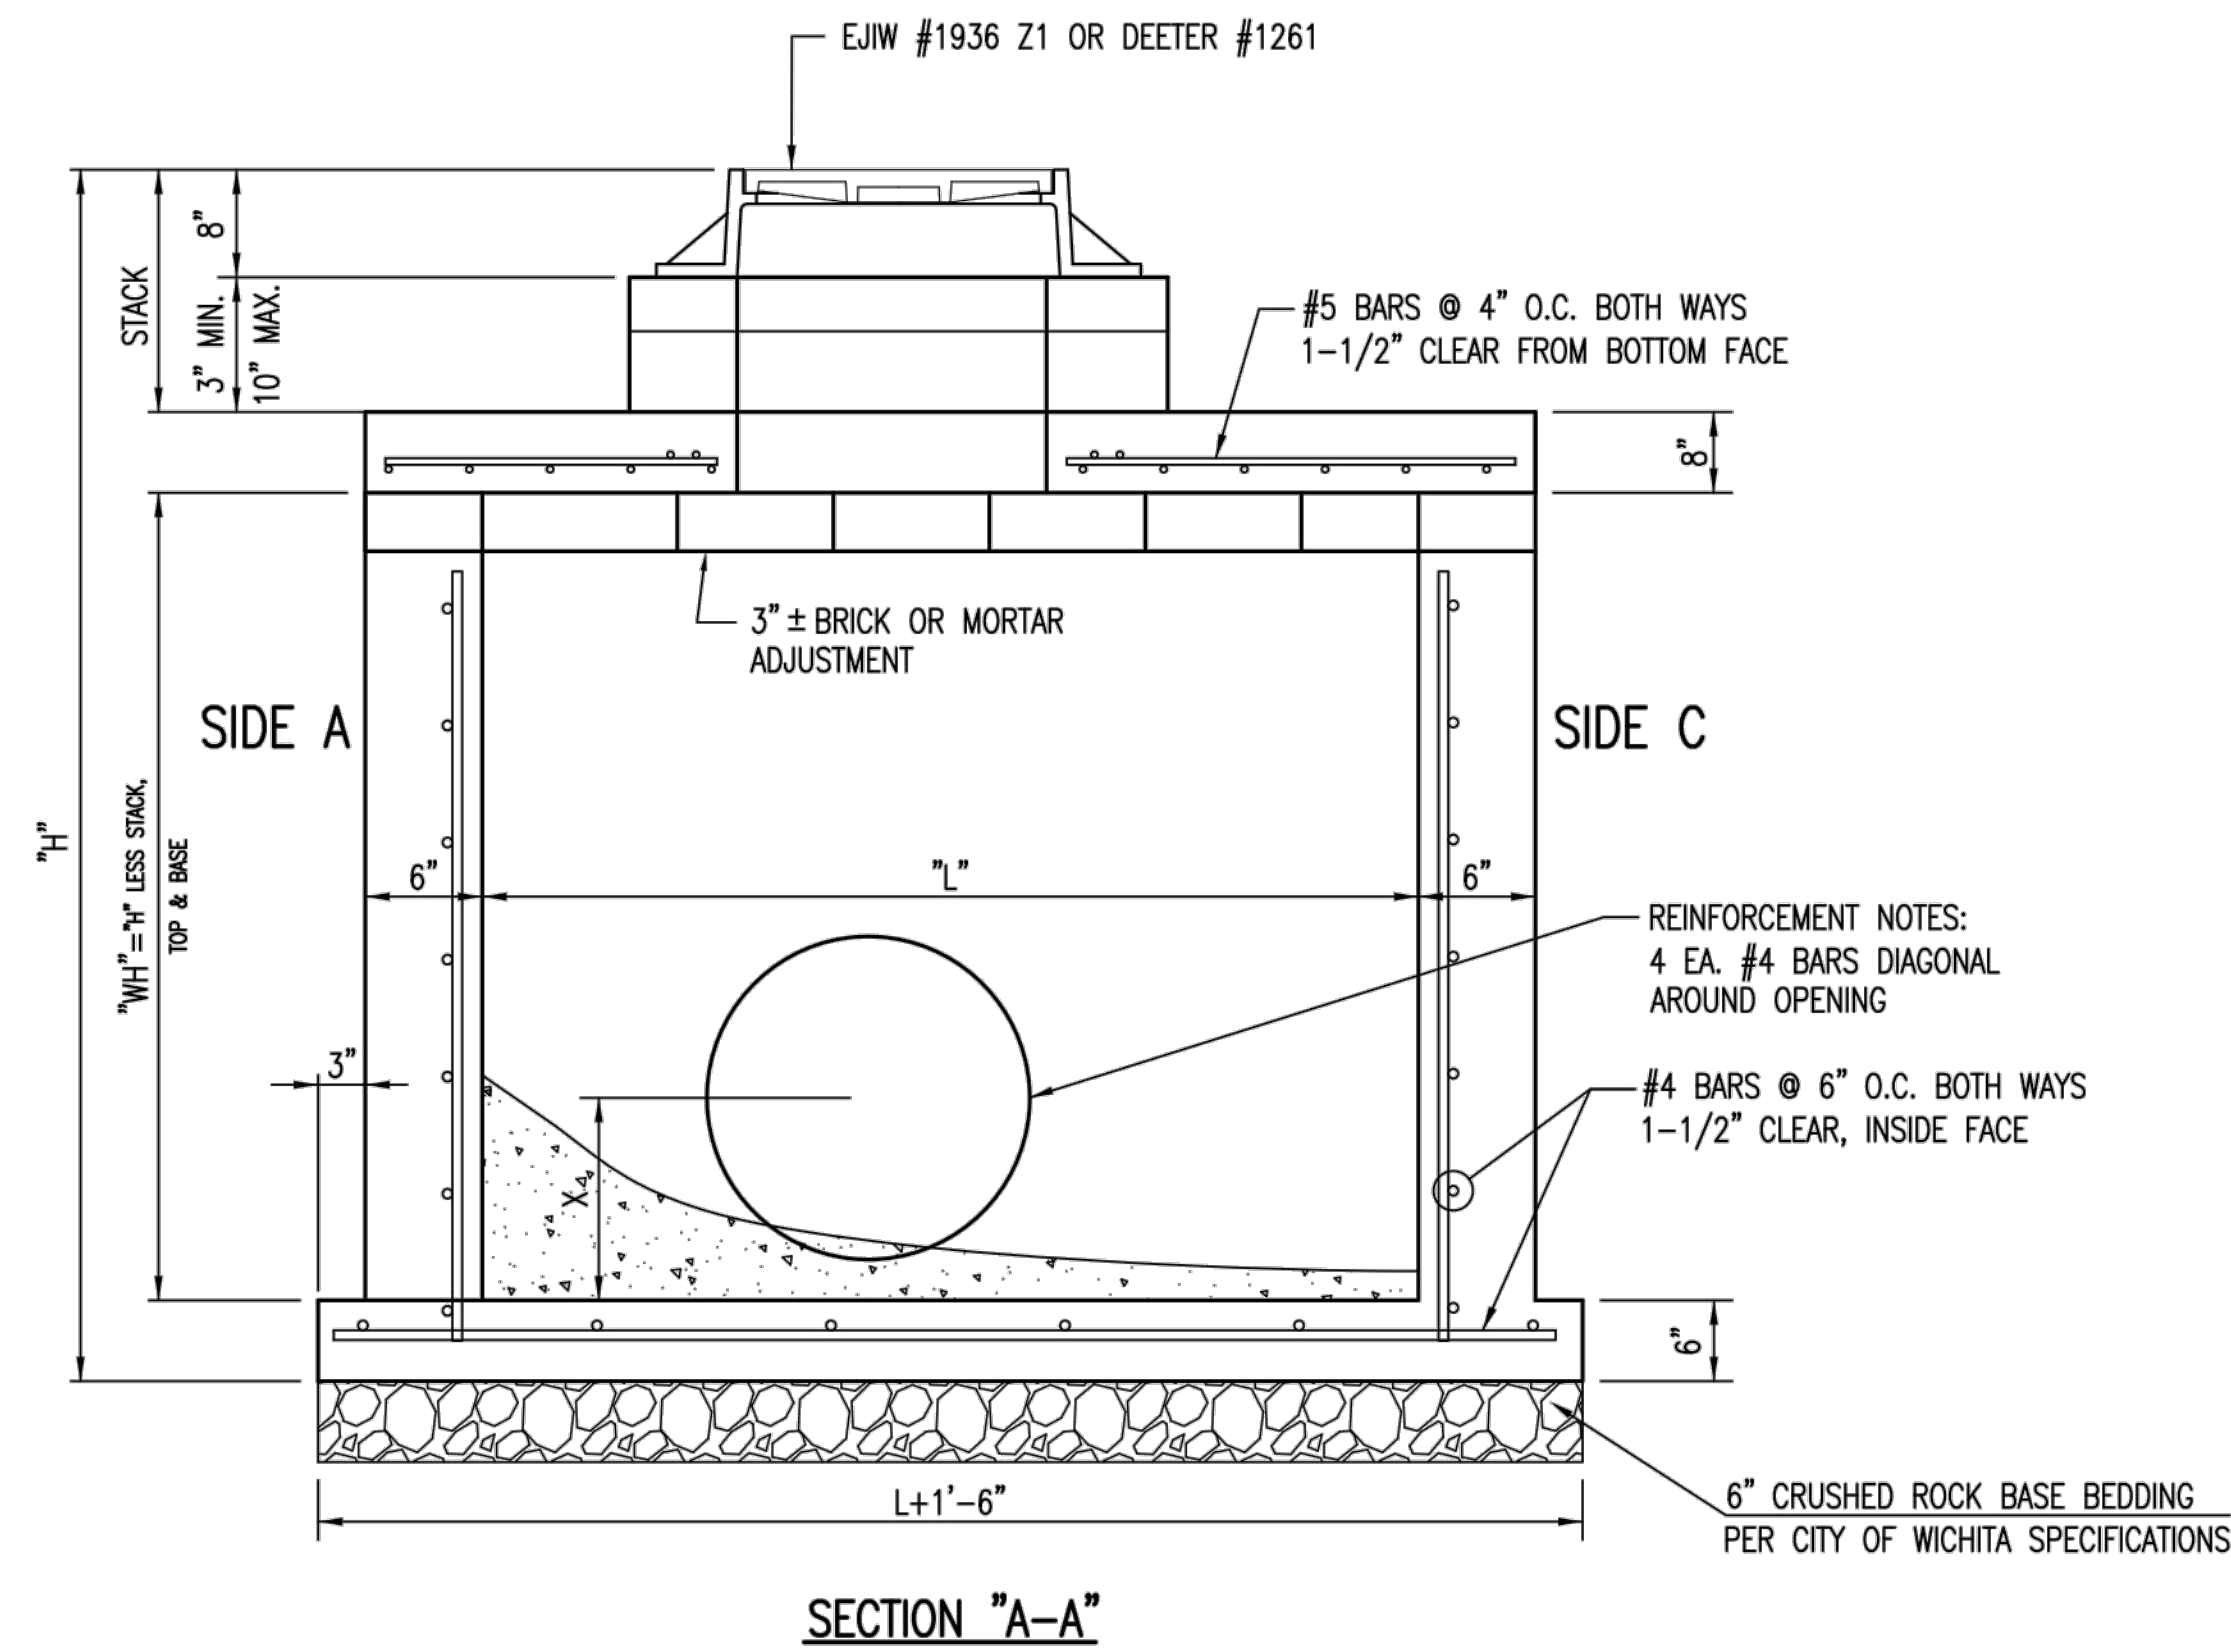

SECTION "A-A"

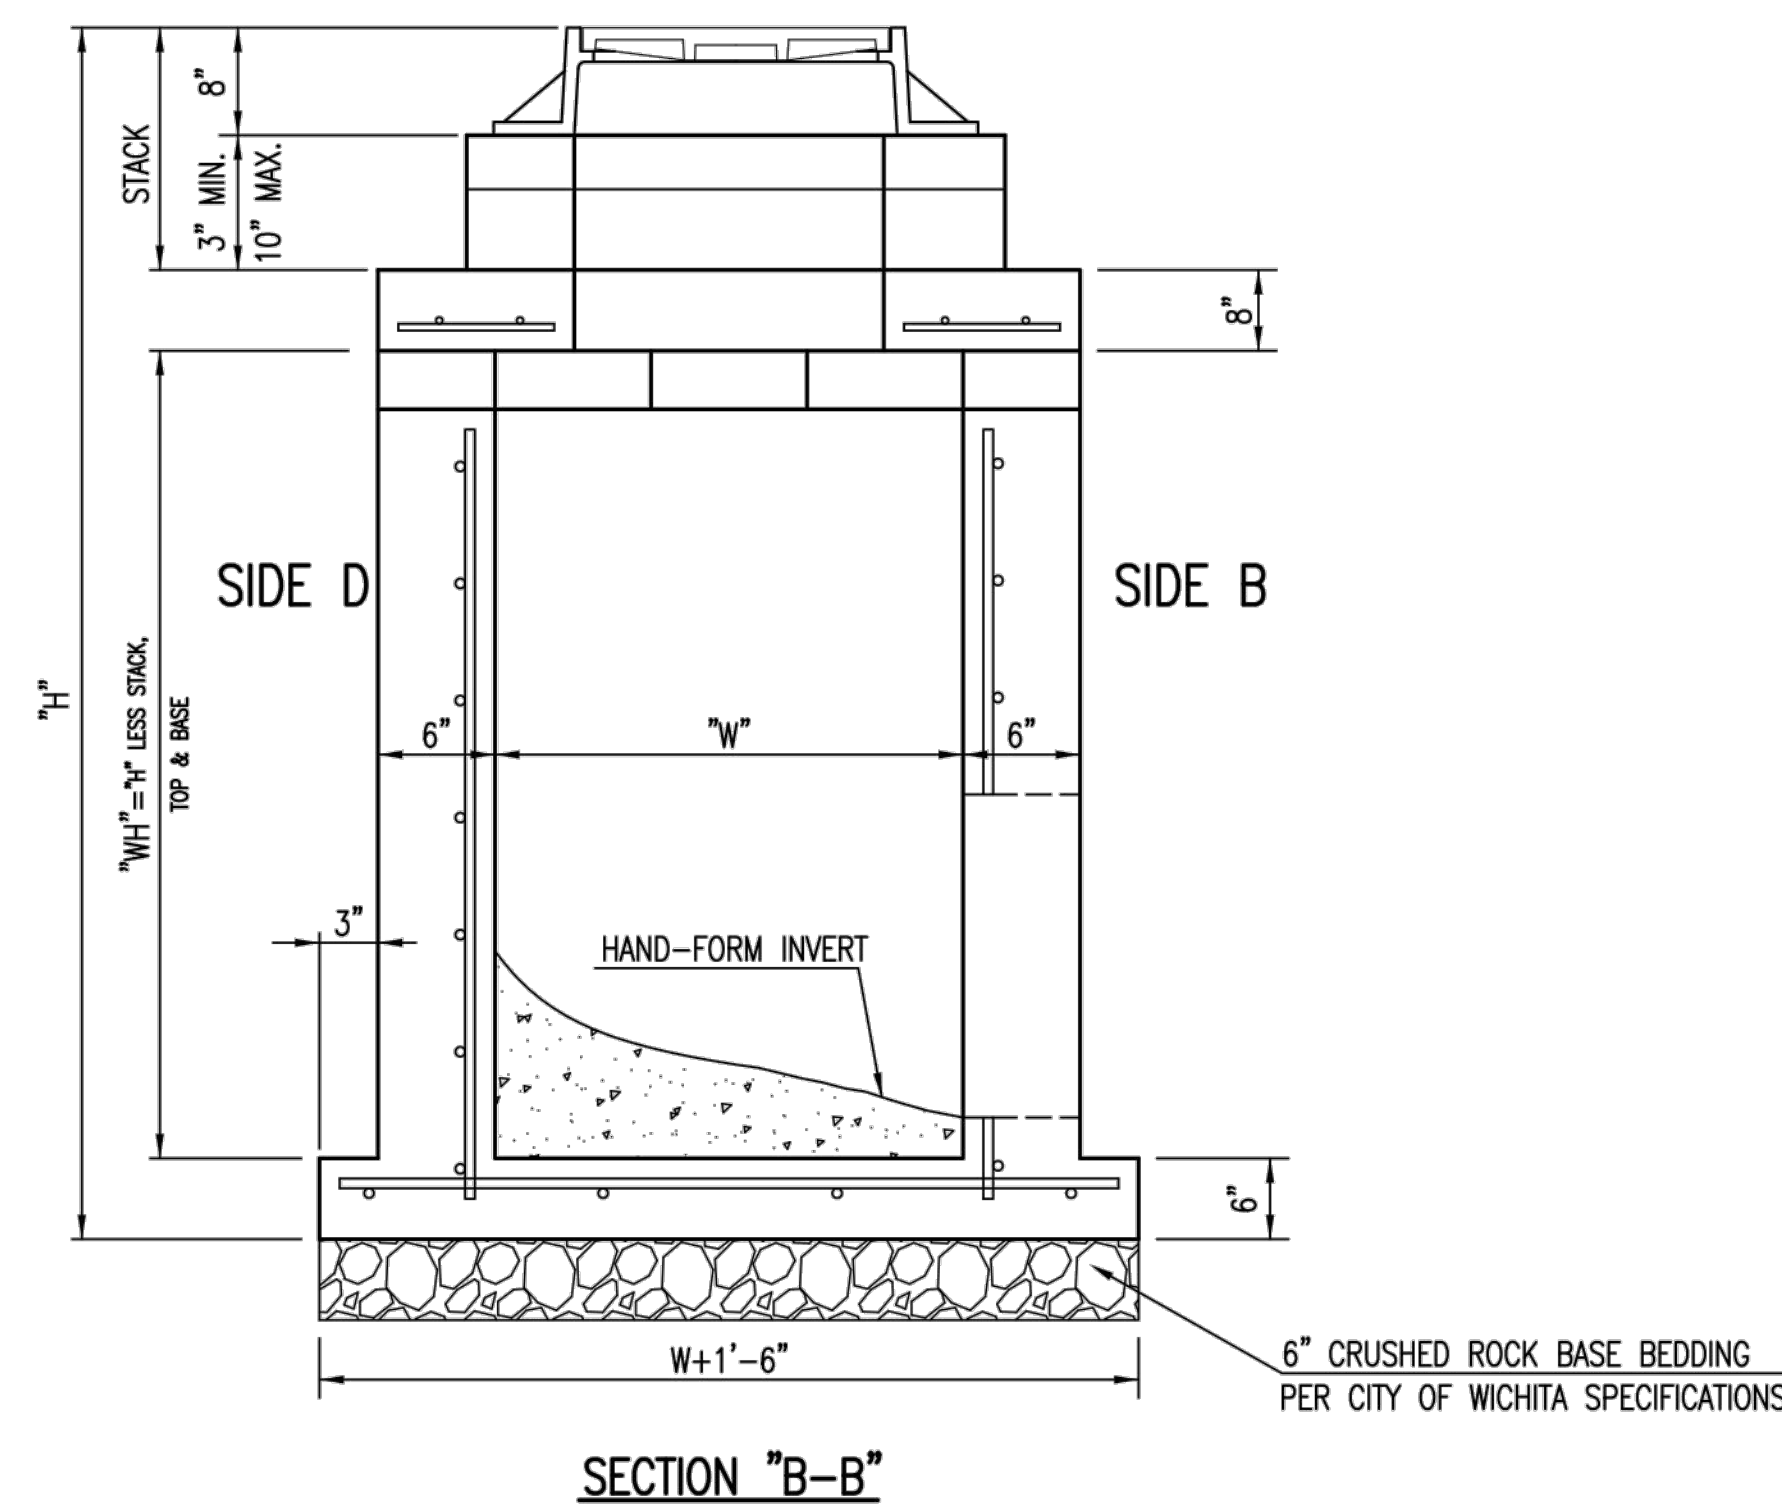

SECTION "B-B"



<b>REINFORCED CONCRETE MANHOLE (STORM SEWER)</b>		
CITY ENGINEER <b>GARY JANZEN, P.E.</b>		
PROJECT NUMBER 0390 PPD	OCA NUMBER 607861	DATE 11/2010
CITY ENGINEER'S OFFICE CITY HALL - SEVENTH FLOOR 455 NORTH MAIN STREET WICHITA, KANSAS 67202-1620 (316) 268-4501		SHEET <b>13</b> 15

Manufacturer's Maintenance Recommendations:

\* Monthly monitoring for the first year of a new installation after the site has been stabilized.

\* Measurements should be taken after each rain event of .5 inches or more, or monthly, as determined by local weather conditions.

\* Checking sediment depth and noting the surface pollutants in the structure will be helpful in planning maintenance.

\* The pollutants collected in SNOUT equipped structures will consist of floatable debris and oils on the surface of the captured water, and grit and sediment on the bottom of the structure.

\* It is best to schedule maintenance based on the solids collected in the sump.

\* Optimally, the structure should be cleaned when the sump is half full (e.g. when 2 feet of material collects in a 4 foot sump, clean it out).

\* Structures should also be cleaned if a spill or other incident causes a larger than normal accumulation of pollutants in a structure.

\* Maintenance is best done with a vacuum truck.


\* If Bio-Skirts™ are being used in the structure to enhance hydrocarbon capture and/or bacteria removals, they should be checked on a monthly basis, and serviced or replaced when more than 2/3 of the boom is submerged, indicating a nearly saturated state. Assuming a typical pollutant-loading environment exists, Bio-Skirts should be serviced\* or replaced annually.

\* In the case of an oil spill, the structure should be serviced and Bio-Skirts replaced (if any) immediately

\* All collected wastes must be handled and disposed of according to local environmental requirements.

\* To maintain the SNOUT hoods themselves, an annual inspection of the anti-siphon vent and access hatch are recommended. A simple flushing of the vent, or a gentle rodding with a flexible wire are all that's typically needed to maintain the anti-siphon properties. Opening and closing the access hatch once a year ensures a lifetime of trouble-free service.

CONFIGURATION DETAIL

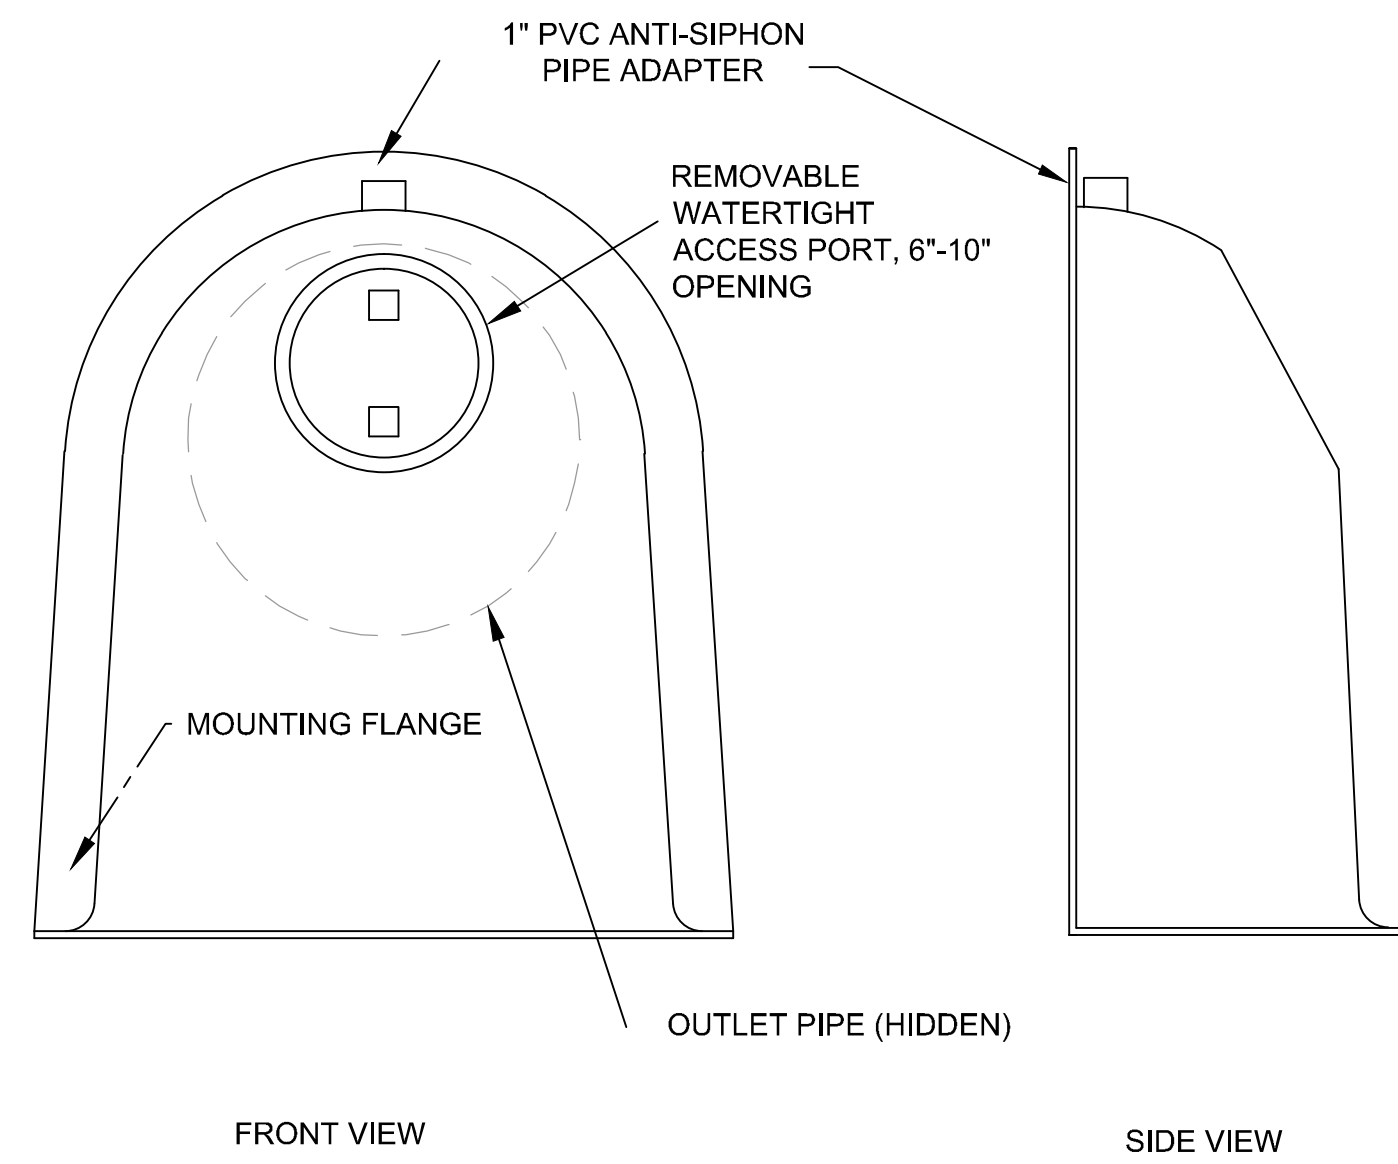


SNOUT OIL-WATER-DEBRIS SEPARATOR

NOTES:

- ALL HOODS AND TRAPS FOR CATCH BASINS AND WATER QUALITY STRUCTURES SHALL BE AS MANUFACTURED BY:  
BEST MANAGEMENT PRODUCTS, INC.  
53 MT. ARCHER RD.  
LYME, CT 06371  
(860) 434-0277, (860) 434-3195 FAX  
TOLL FREE: (800) 504-8008 OR (888) 434-0277  
WEB SITE: [www.bmpinc.com](http://www.bmpinc.com)  
OR PRE-APPROVED EQUAL
- ALL HOODS SHALL BE CONSTRUCTED OF A GLASS REINFORCED RESIN COMPOSITE WITH ISO GEL COAT EXTERIOR FINISH WITH A MINIMUM 0.125" LAMINATE THICKNESS.
- ALL HOODS SHALL BE EQUIPPED WITH A WATERTIGHT ACCESS PORT, A MOUNTING FLANGE, AND AN ANTI-SIPHON VENT PIPE AND ELBOW AS DRAWN. (SEE CONFIGURATION DETAIL)
- THE SIZE AND POSITION OF THE HOOD SHALL BE DETERMINED BY OUTLET PIPE SIZE AS PER MANUFACTURER'S RECOMMENDATION (SNOUT SIZE ALWAYS LARGER THAN PIPE SIZE).
- THE BOTTOM OF THE HOOD SHALL EXTEND DOWNWARD A MINIMUM DISTANCE EQUAL TO 1/2 THE OUTLET PIPE DIAMETER WITH A MINIMUM DISTANCE OF 6" FOR PIPES <12" I.D.
- THE ANTI-SIPHON VENT SHALL EXTEND ABOVE HOOD BY MINIMUM OF 3" AND A MAXIMUM OF 12" ACCORDING TO STRUCTURE CONFIGURATION.
- THE SURFACE OF THE STRUCTURE WHERE THE HOOD IS MOUNTED SHALL BE FINISHED SMOOTH AND FREE OF LOOSE MATERIAL AND PIPE SHALL BE FINISHED FLUSH TO WALL.
- THE HOOD SHALL BE SECURELY ATTACHED TO STRUCTURE WALL WITH 3/8" STAINLESS STEEL BOLTS AND OIL-RESISTANT GASKET AS SUPPLIED BY MANUFACTURER. (SEE INSTALLATION DETAIL)
- INSTALLATION INSTRUCTIONS SHALL BE FURNISHED WITH MANUFACTURER SUPPLIED INSTALLATION KIT.  
INSTALLATION KIT SHALL INCLUDE:  
A. INSTALLATION INSTRUCTIONS  
B. PVC ANTI-SIPHON VENT PIPE AND ADAPTER  
C. OIL-RESISTANT CRUSHED CELL FOAM GASKET WITH PSA BACKING  
D. 3/8" STAINLESS STEEL BOLTS  
E. ANCHOR SHIELDS


US Patent # 6126817

TYPICAL INSTALLATION

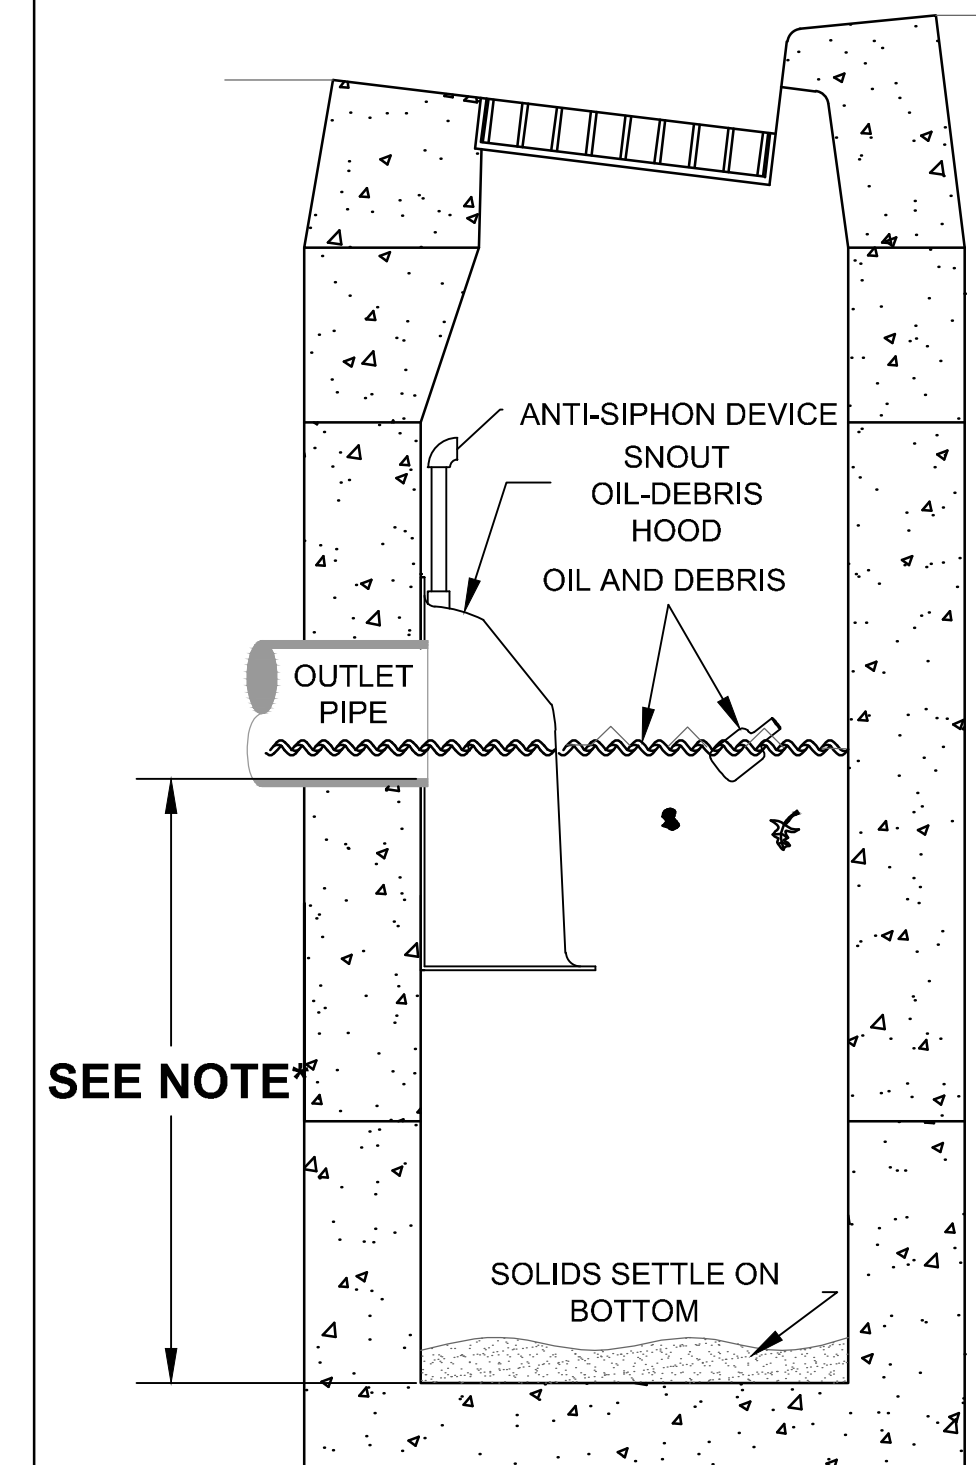

\*NOTE- SUMP DEPTH OF 36" MIN. FOR < OR= 12" DIAM. OUTLET. FOR OUTLETS >OR= 15", DEPTH = 2.5-3X DIAM.



INSTALLATION DETAIL

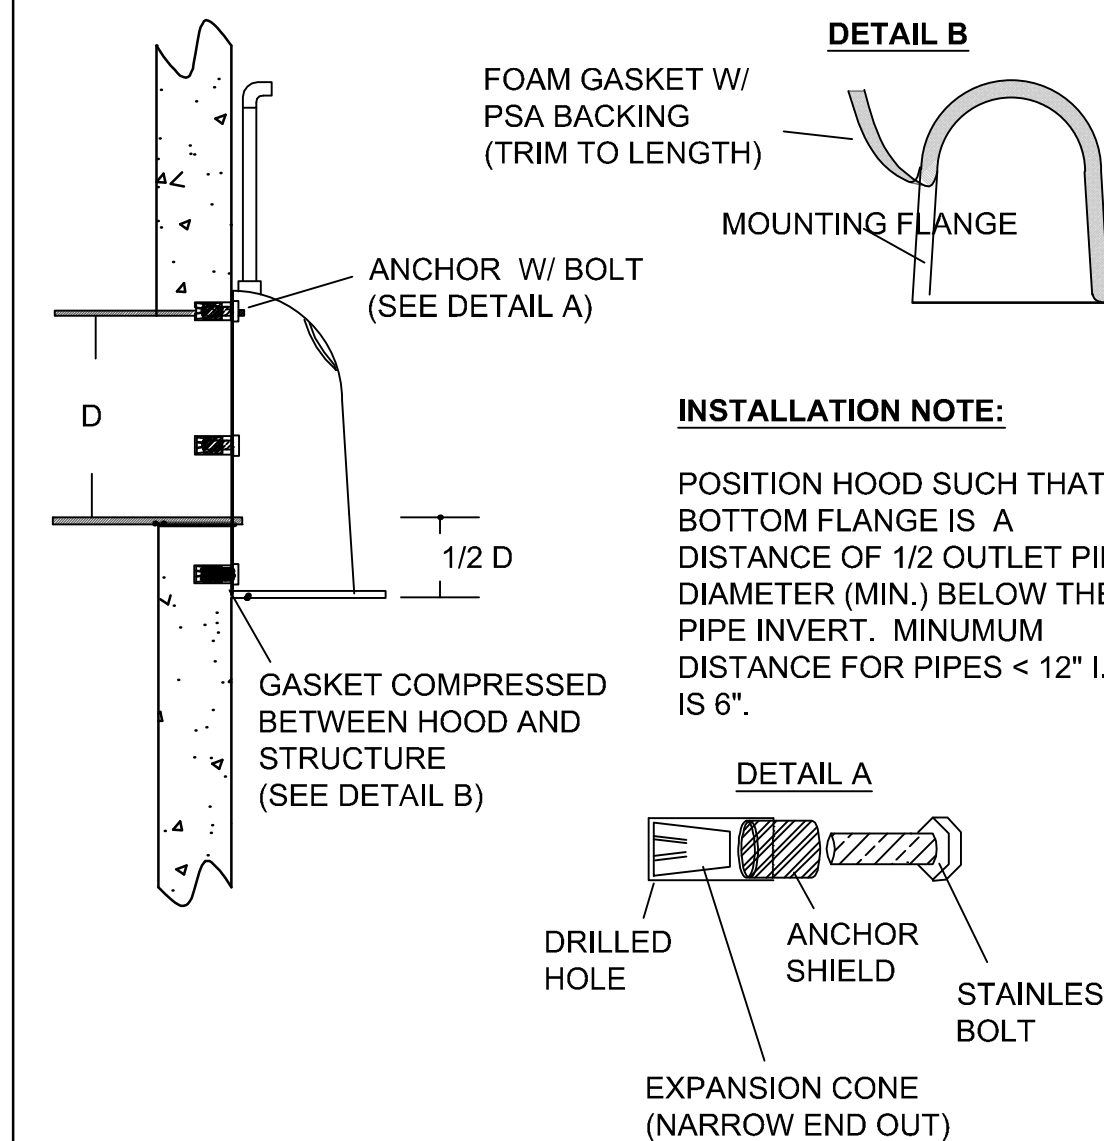

**HOOD SPECIFICATION FOR CATCH BASINS AND WATER QUALITY STRUCTURES**

DESCRIPTION	DATE	SCALE
OIL- DEBRIS HOOD SPECIFICATION AND INSTALLATION (TYPICAL)	09/08/00	NONE
DRAWING NUMBER		
SP-SN		

<b>FOLEY EQUIPMENT</b>			
<b>Snout Detail</b>			
SEAL			DATE
	<b>RUGGLES &amp; BOHM</b>		4-25-2016
	<small>ENGINEERING   SURVEYING   LANDSCAPE ARCHITECTURE   GOVERNMENT</small>		DESIGN
	<small>924 NORTH MAIN WICHITA, KANSAS 67203 P (316) 264-8008 F (316) 264-4621 WWW.RBKANSAS.COM</small>		KWL
	PROJECT NUMBER	RB JOB NO.	DRAWN
	0390 PPD	4265D	DRS
	DRAWING FILE	DWG. SCALE	REVIEW
	4265D Storm Sewer Details [Snout Detail]	...	3-2-2016
			SHEET
			14
			OF 15

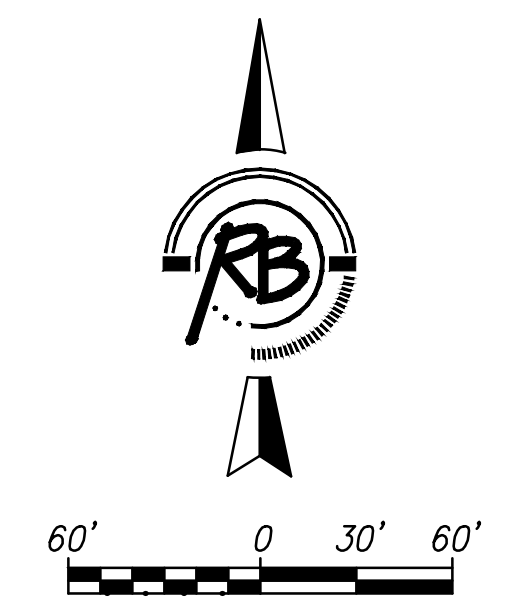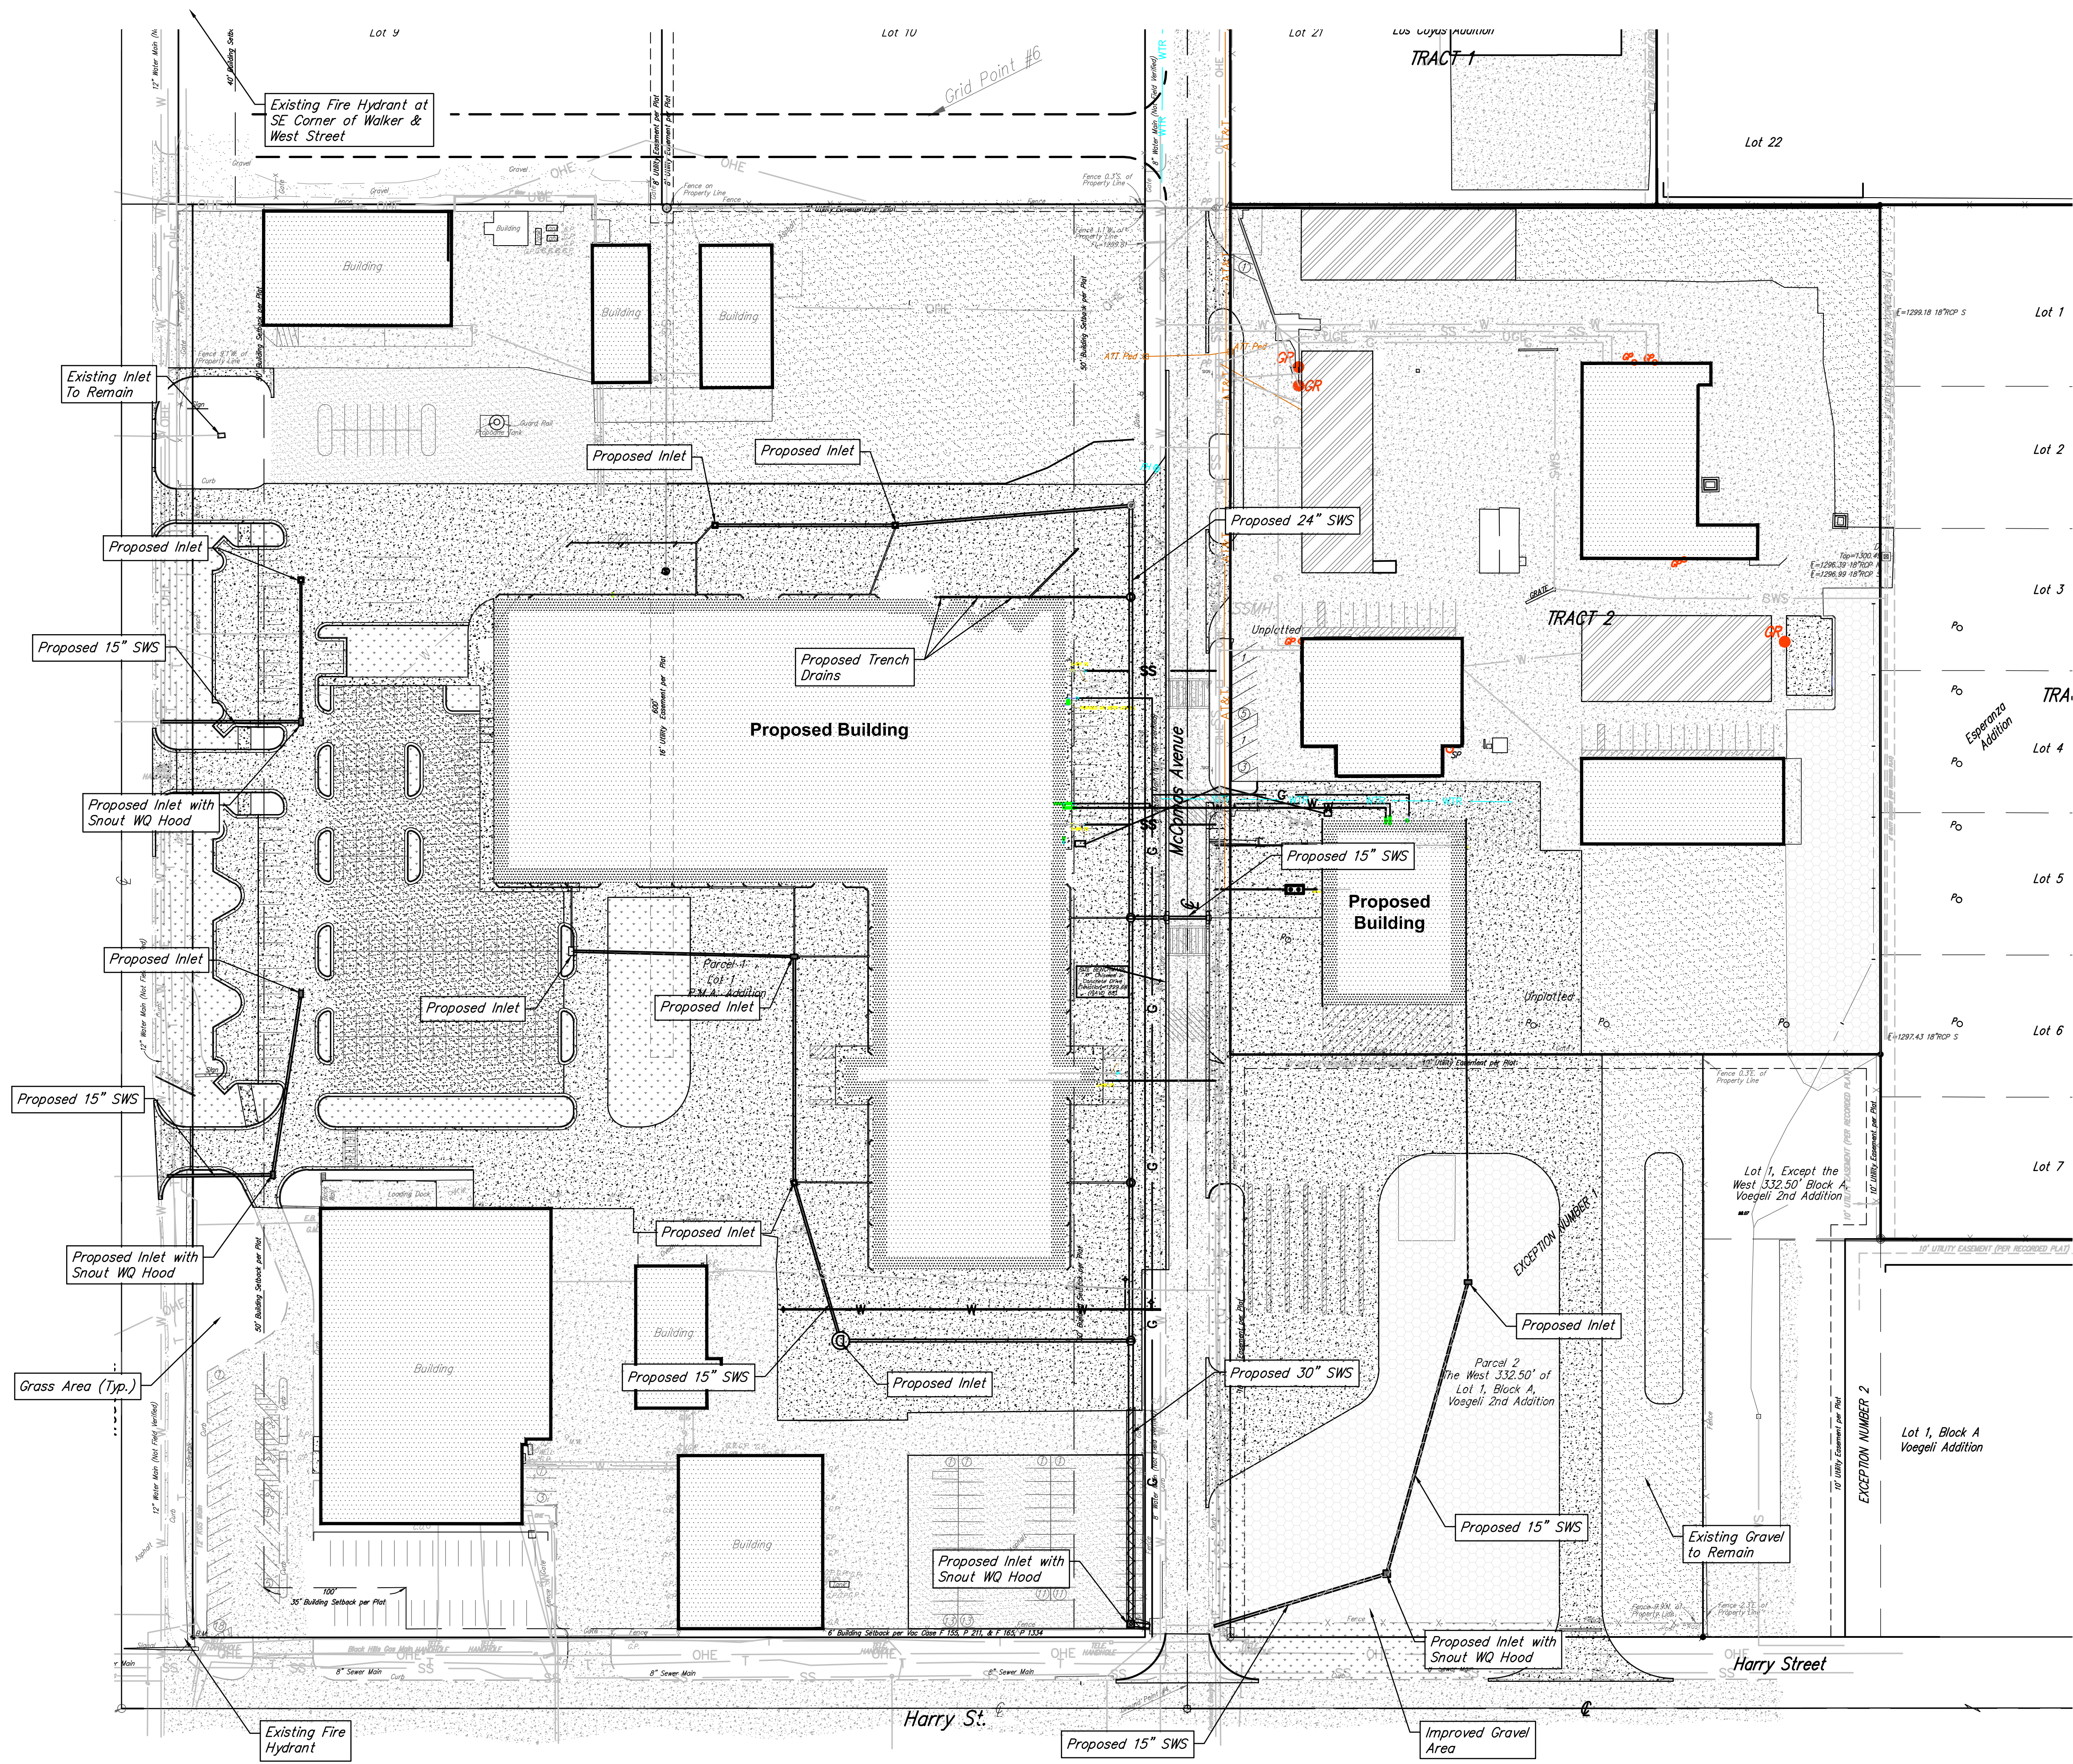

**Existing Site Information**  
 Pavement - 10.36 acres (39%)  
 Buildings - 2.82 acres (11%)  
 Compacted Gravel - 12.09 acres (46%)  
 Grass - 1.13 acres (4%)

$C100 = 0.39(0.89) + 0.11(0.93) + 0.46(0.80) + 0.04(0.51) = 0.84$

**Proposed Site Information**  
 Pavement - 14.34 acres (54%)  
 Buildings - 5.36 acres (20%)  
 Compacted Gravel - 3.70 acres (14%)  
 Select Gravel Surfacing - 1.34 acres (5%)  
 Grass - 1.66 acres (7%)

$C100 = 0.54(0.89) + 0.20(0.93) + 0.14(0.80) + 0.05(0.60) + 0.07(0.51) = 0.84$

- Notes:**
- Pervious Pavement may be incorporated in display areas along West Street to further reduce runoff coefficients.
  - Open graded gravel with limited fines to be used in the "select gravel paving" areas. AB-3 and other gravel prone to crushing will not be used.
  - Snout Water Quality Hoods will be installed on the furthest downstream structure of all proposed storm sewers that tie into City of Wichita SWS systems.
  - All new roof drains will be directed into storm sewer systems.

<b>FOLEY INDUSTRIES SITE IMPROVEMENTS</b>		<b>ERU &amp; Drainage Concept</b>	
	<b>RUGGLES &amp; BOHM</b>		
	<small>ENGINEERING   SURVEYING   LANDSCAPE ARCHITECTURE   GOVERNMENT</small> <small>924 NORTH MAIN WICHITA, KANSAS 67203 P (316) 264-8008 F (316) 264-4621</small> <small>WWW.RBKANSAS.COM</small>		
PROJECT NUMBER	RB JOB NO.	DWG. SCALE	DATE
	4265D	1" = 60'	4-25-2016
DRAWING FILE			DESIGN
4265D ERU Plan.dwg			KWL
			DRAWN
			KWL
			REVIEW
			Feb. 9, 2016
			SHEET
			15
			OF 15