

LATERAL 64, MAIN 24

OF THE

WAR INDUSTRIES SEWER

(SERVING TALLGRASS EAST COMMERCIAL 2ND)

IN


THE CITY OF WICHITA, KANSAS

CITY OF WICHITA PROJECT NO. 468-85132
 OCA NO. 744444
 GARY JANZEN, P.E. - CITY ENGINEER

McCullough Excavation - Contractor
J. Wagner - City of Wichita, Field Project Engineer
S. May - City of Wichita, Inspector
 Stub
 Completion Date: 2/5/2018
 : apr 10/23/2017

DEVELOPER CONTACT

MR. DAVID HAMBRICK
 SLAWSON COMPANIES
 727 N. WACO, SUITE 400
 WICHITA, KANSAS 67203
 (316) 263-3201

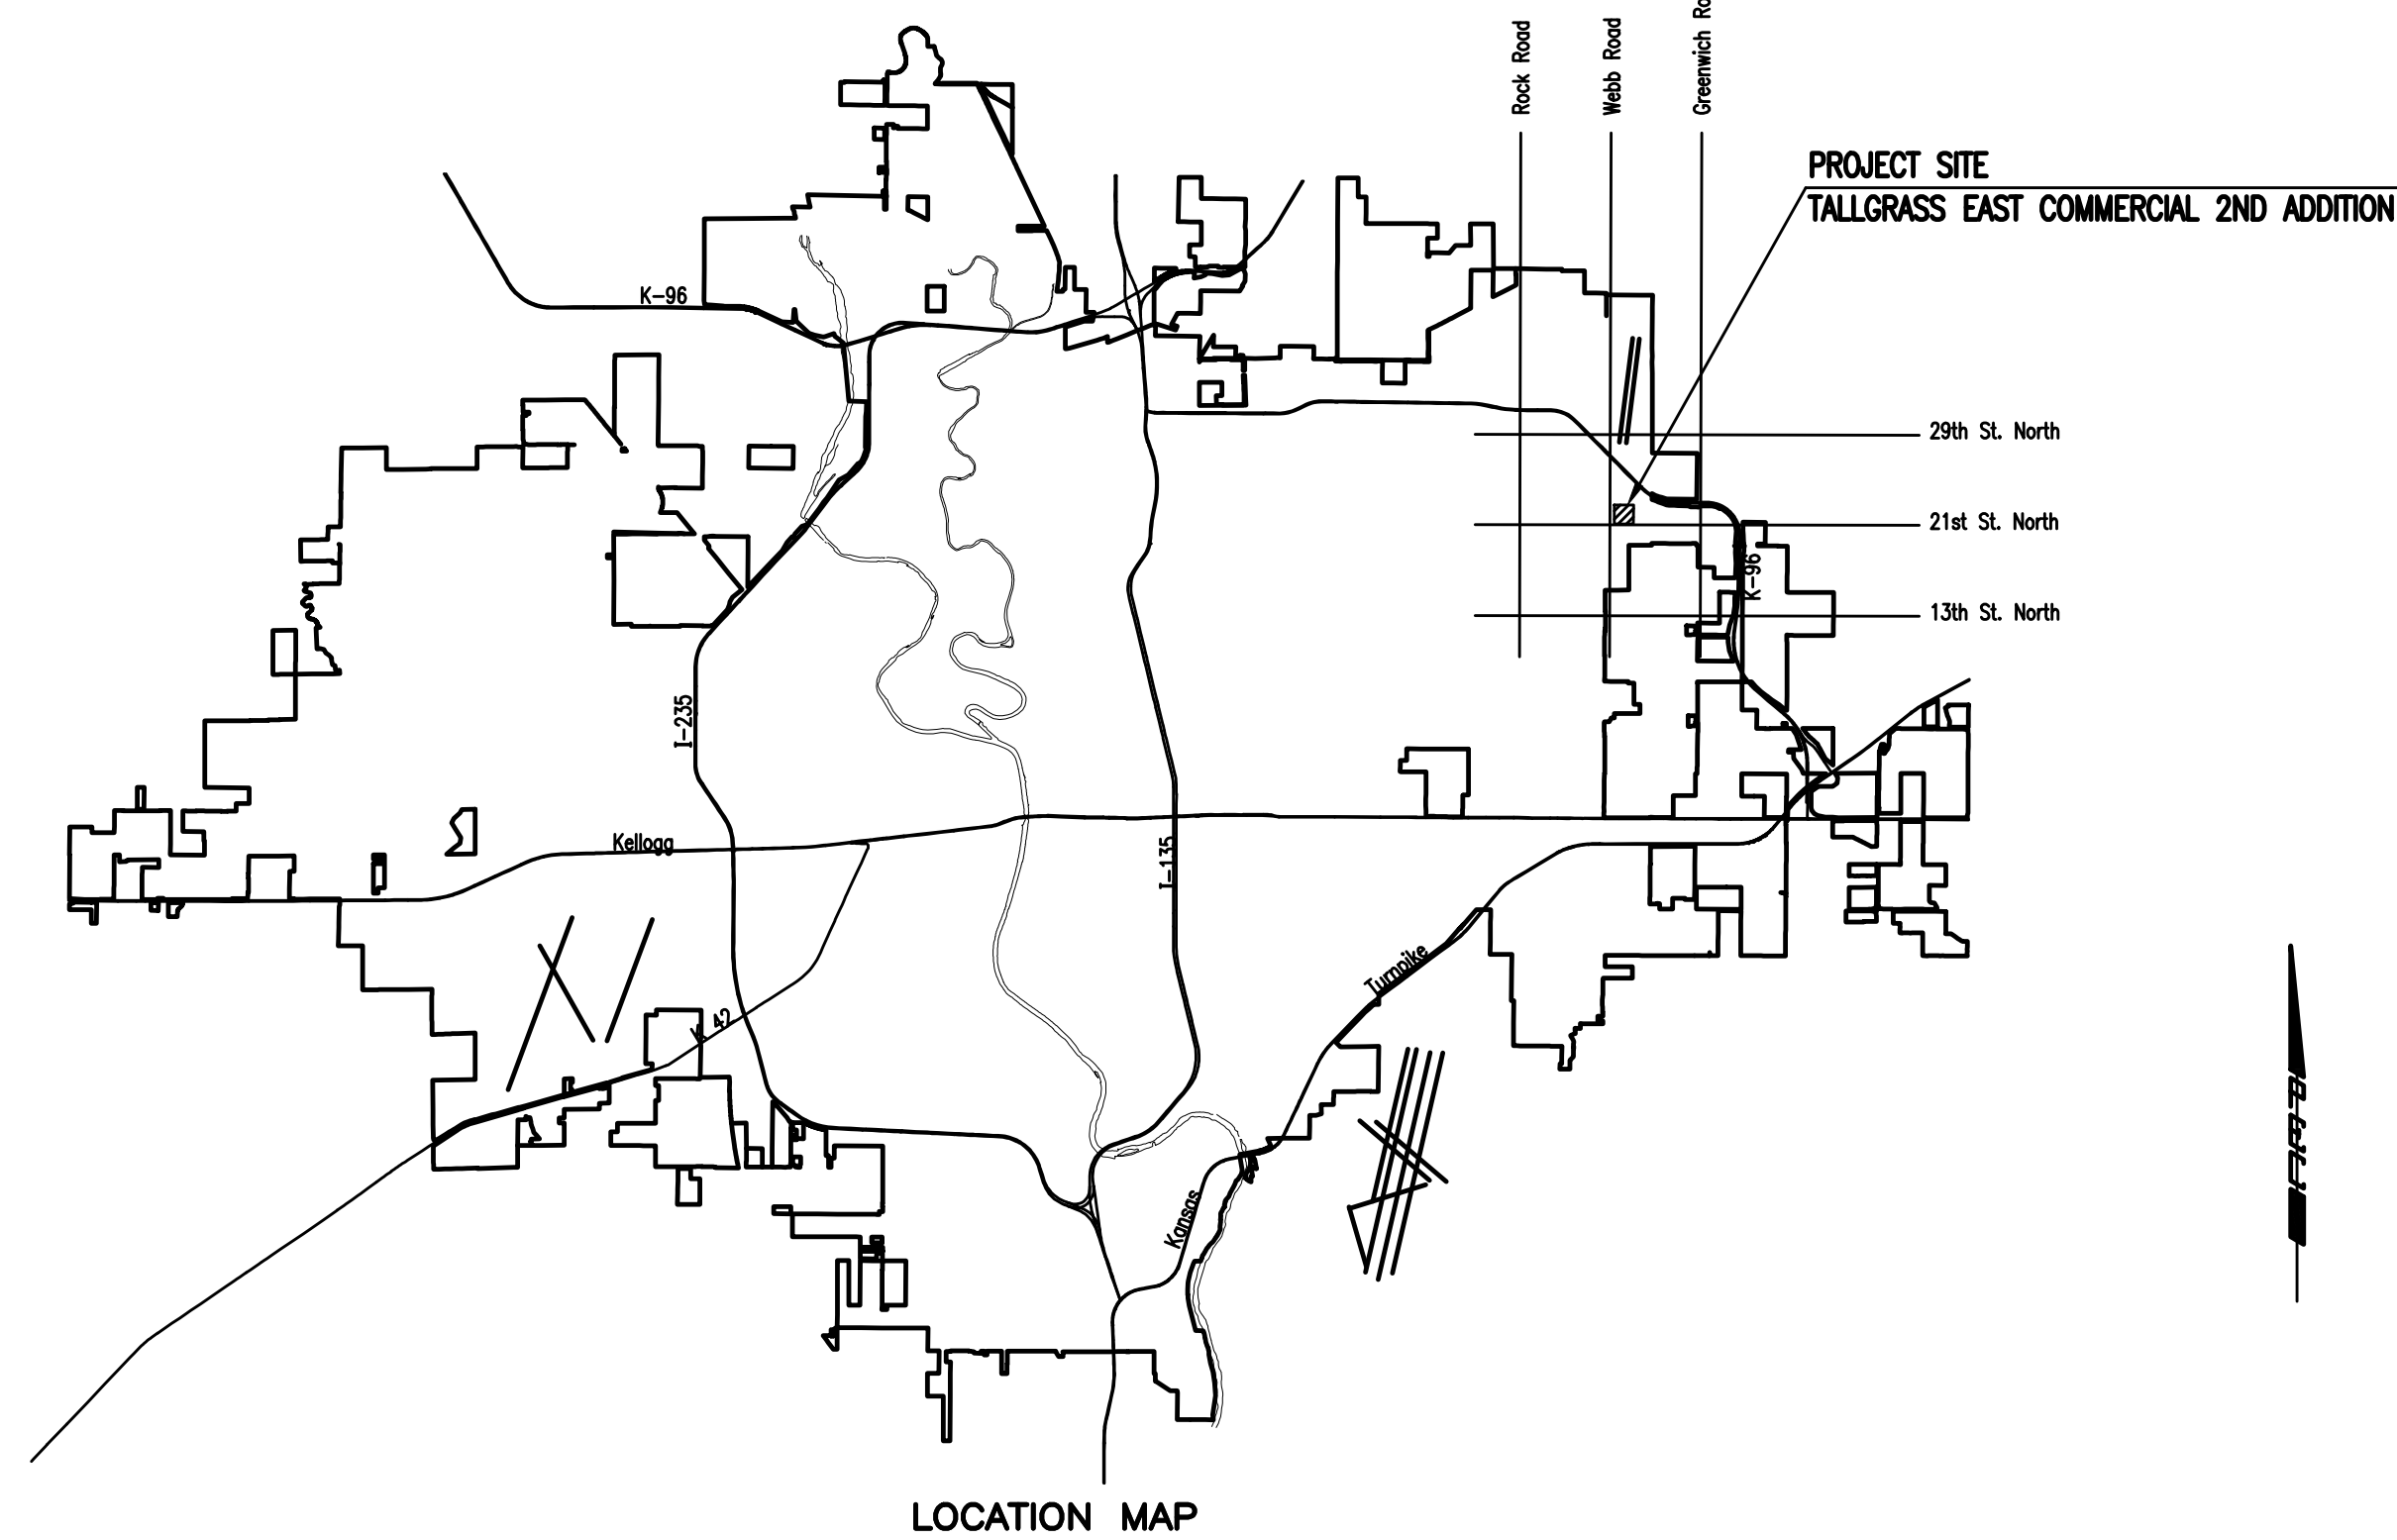

INDEX OF SHEETS

SHEET NO. 1	TITLE SHEET
SHEET NO. 2	KEY MAP, BUBBLE MAP AND GENERAL NOTES
SHEET NO. 3	SANITARY SEWER LINE NO. 1
SHEET NO. 4	PRECAST SANITARY SEWER MANHOLE
SHEET NO. 5	MANHOLE FRAME AND COVER (SANITARY SEWER)
SHEET NO. 6	VERTICAL RISER ASSEMBLY DETAIL
SHEET NO. 7	COPY OF PLAT (TALLGRASS EAST COMMERCIAL 2ND ADDITION) SOIL EROSION BMP'S (available at Wichita.gov)



JUNE 2017
 PLANS PREPARED BY
PROFESSIONAL ENGINEERING CONSULTANTS, P.A.
 ENGINEERS
 WICHITA, KANSAS