


FHWA REGION NO.	STATE	PROJECT NO.	YEAR	SHEET NO.	TOTAL SHEETS
7	KS.	87-U-1362-01	1993	6	149

Revised Plan 8/13/93

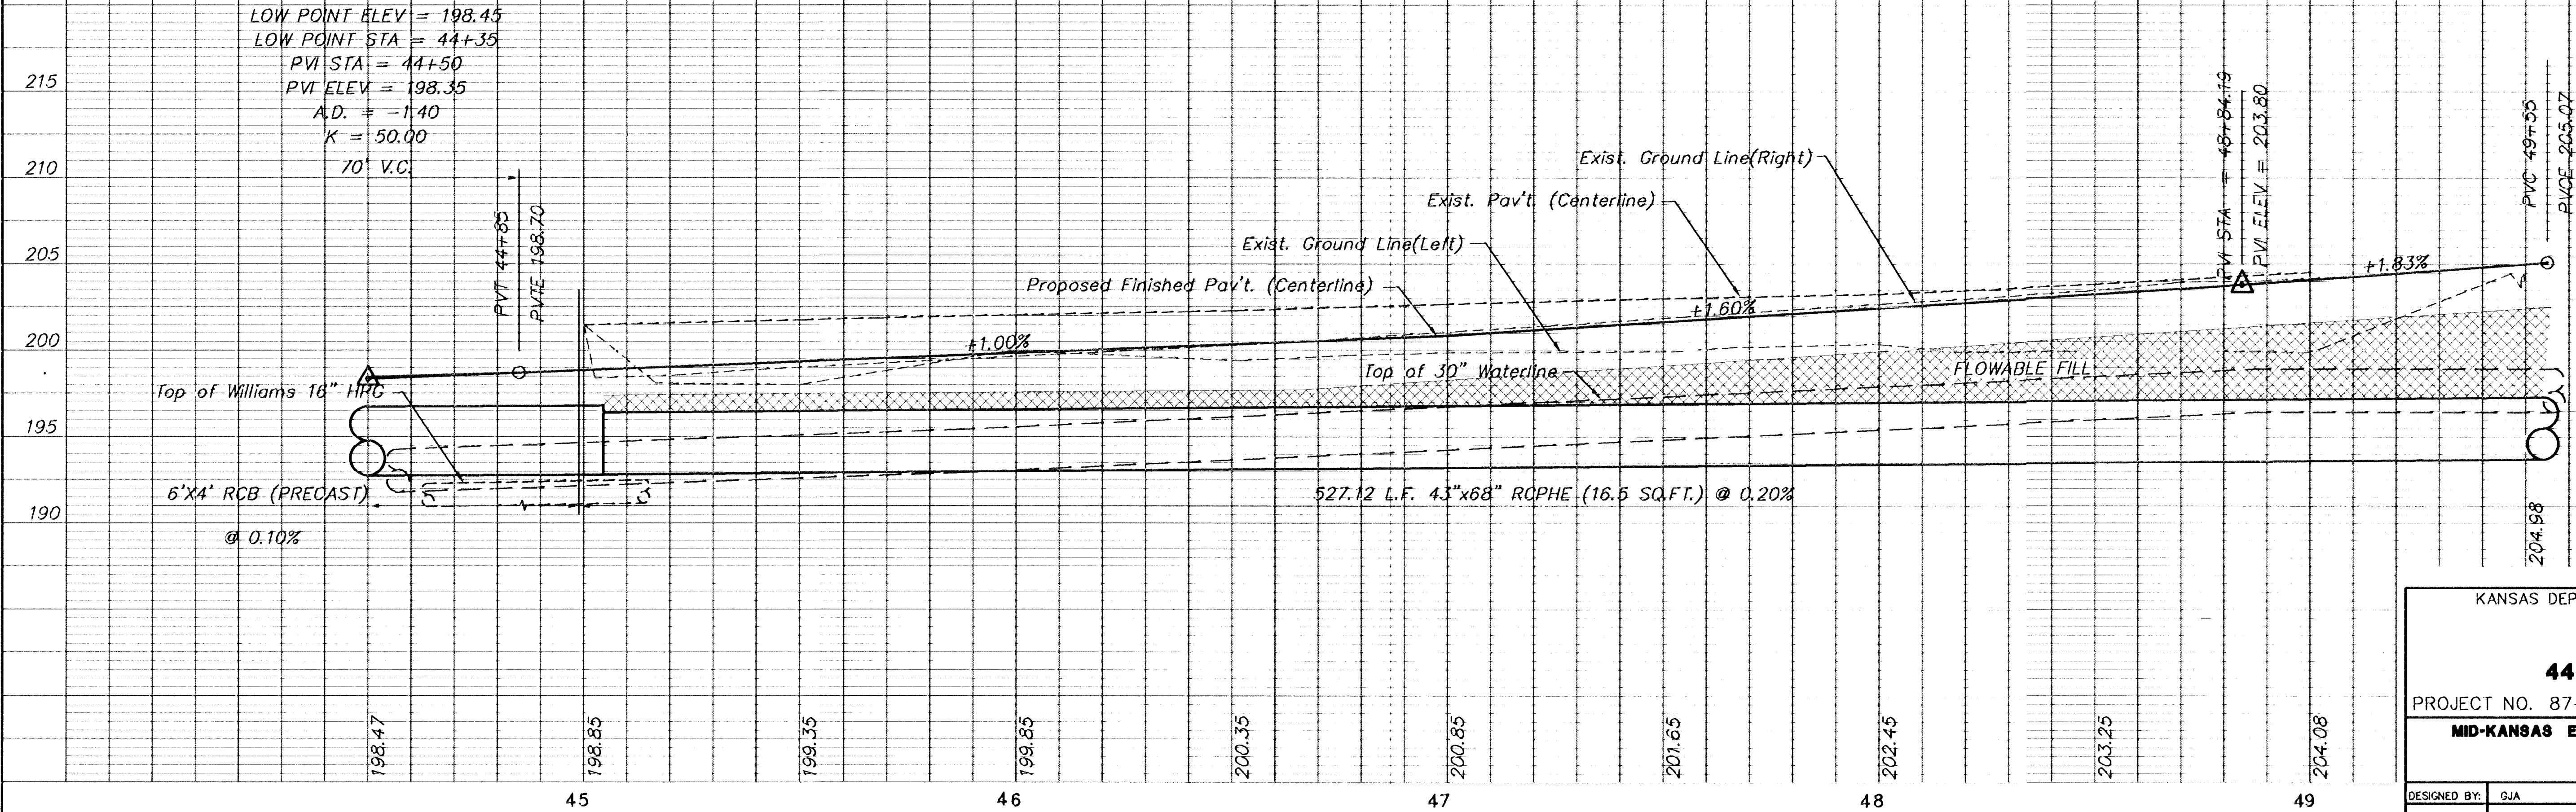

REVISED 8/13/93

KANSAS DEPARTMENT OF TRANSPORTATION

WEBB ROAD

44+50 TO 49+50

PROJECT NO. 87-U-1362-01 SEDGWICK CO.

MID-KANSAS ENGINEERING CONSULTANTS, INC.

WICHITA, KANSAS

DESIGNED BY: GJA

CHECKED BY: DLH & KJS

DRAWN BY: ALN

DATE: SHEET 6 OF 149

Revised