


BENCHMARKS:
 BM #1: COW BM at the SW corner of
 Pawnee Ave. and Maize Road.
 Elev. = 135.15 (City Datum)

BM #2: "□" in top of curb on the
 north side of Yosemite, 65' east of
 Maize Road.
 Elev. = 143.67 (City Datum)

BM #3: COW BM at Shefford on the
 south side of Pawnee Ave.
 Elev. = 145.53 (City Datum)

Sta 0+37.00, 17.25' Rt.
 Install subdivision benchmark
 (Flat Survey Marker No.
 8134-08 3" top diameter) in
 top of curb. Cost shall be
 incidental to L.F. Curb &
 Gutter.

Scale: 1" = 20'
 • = Iron

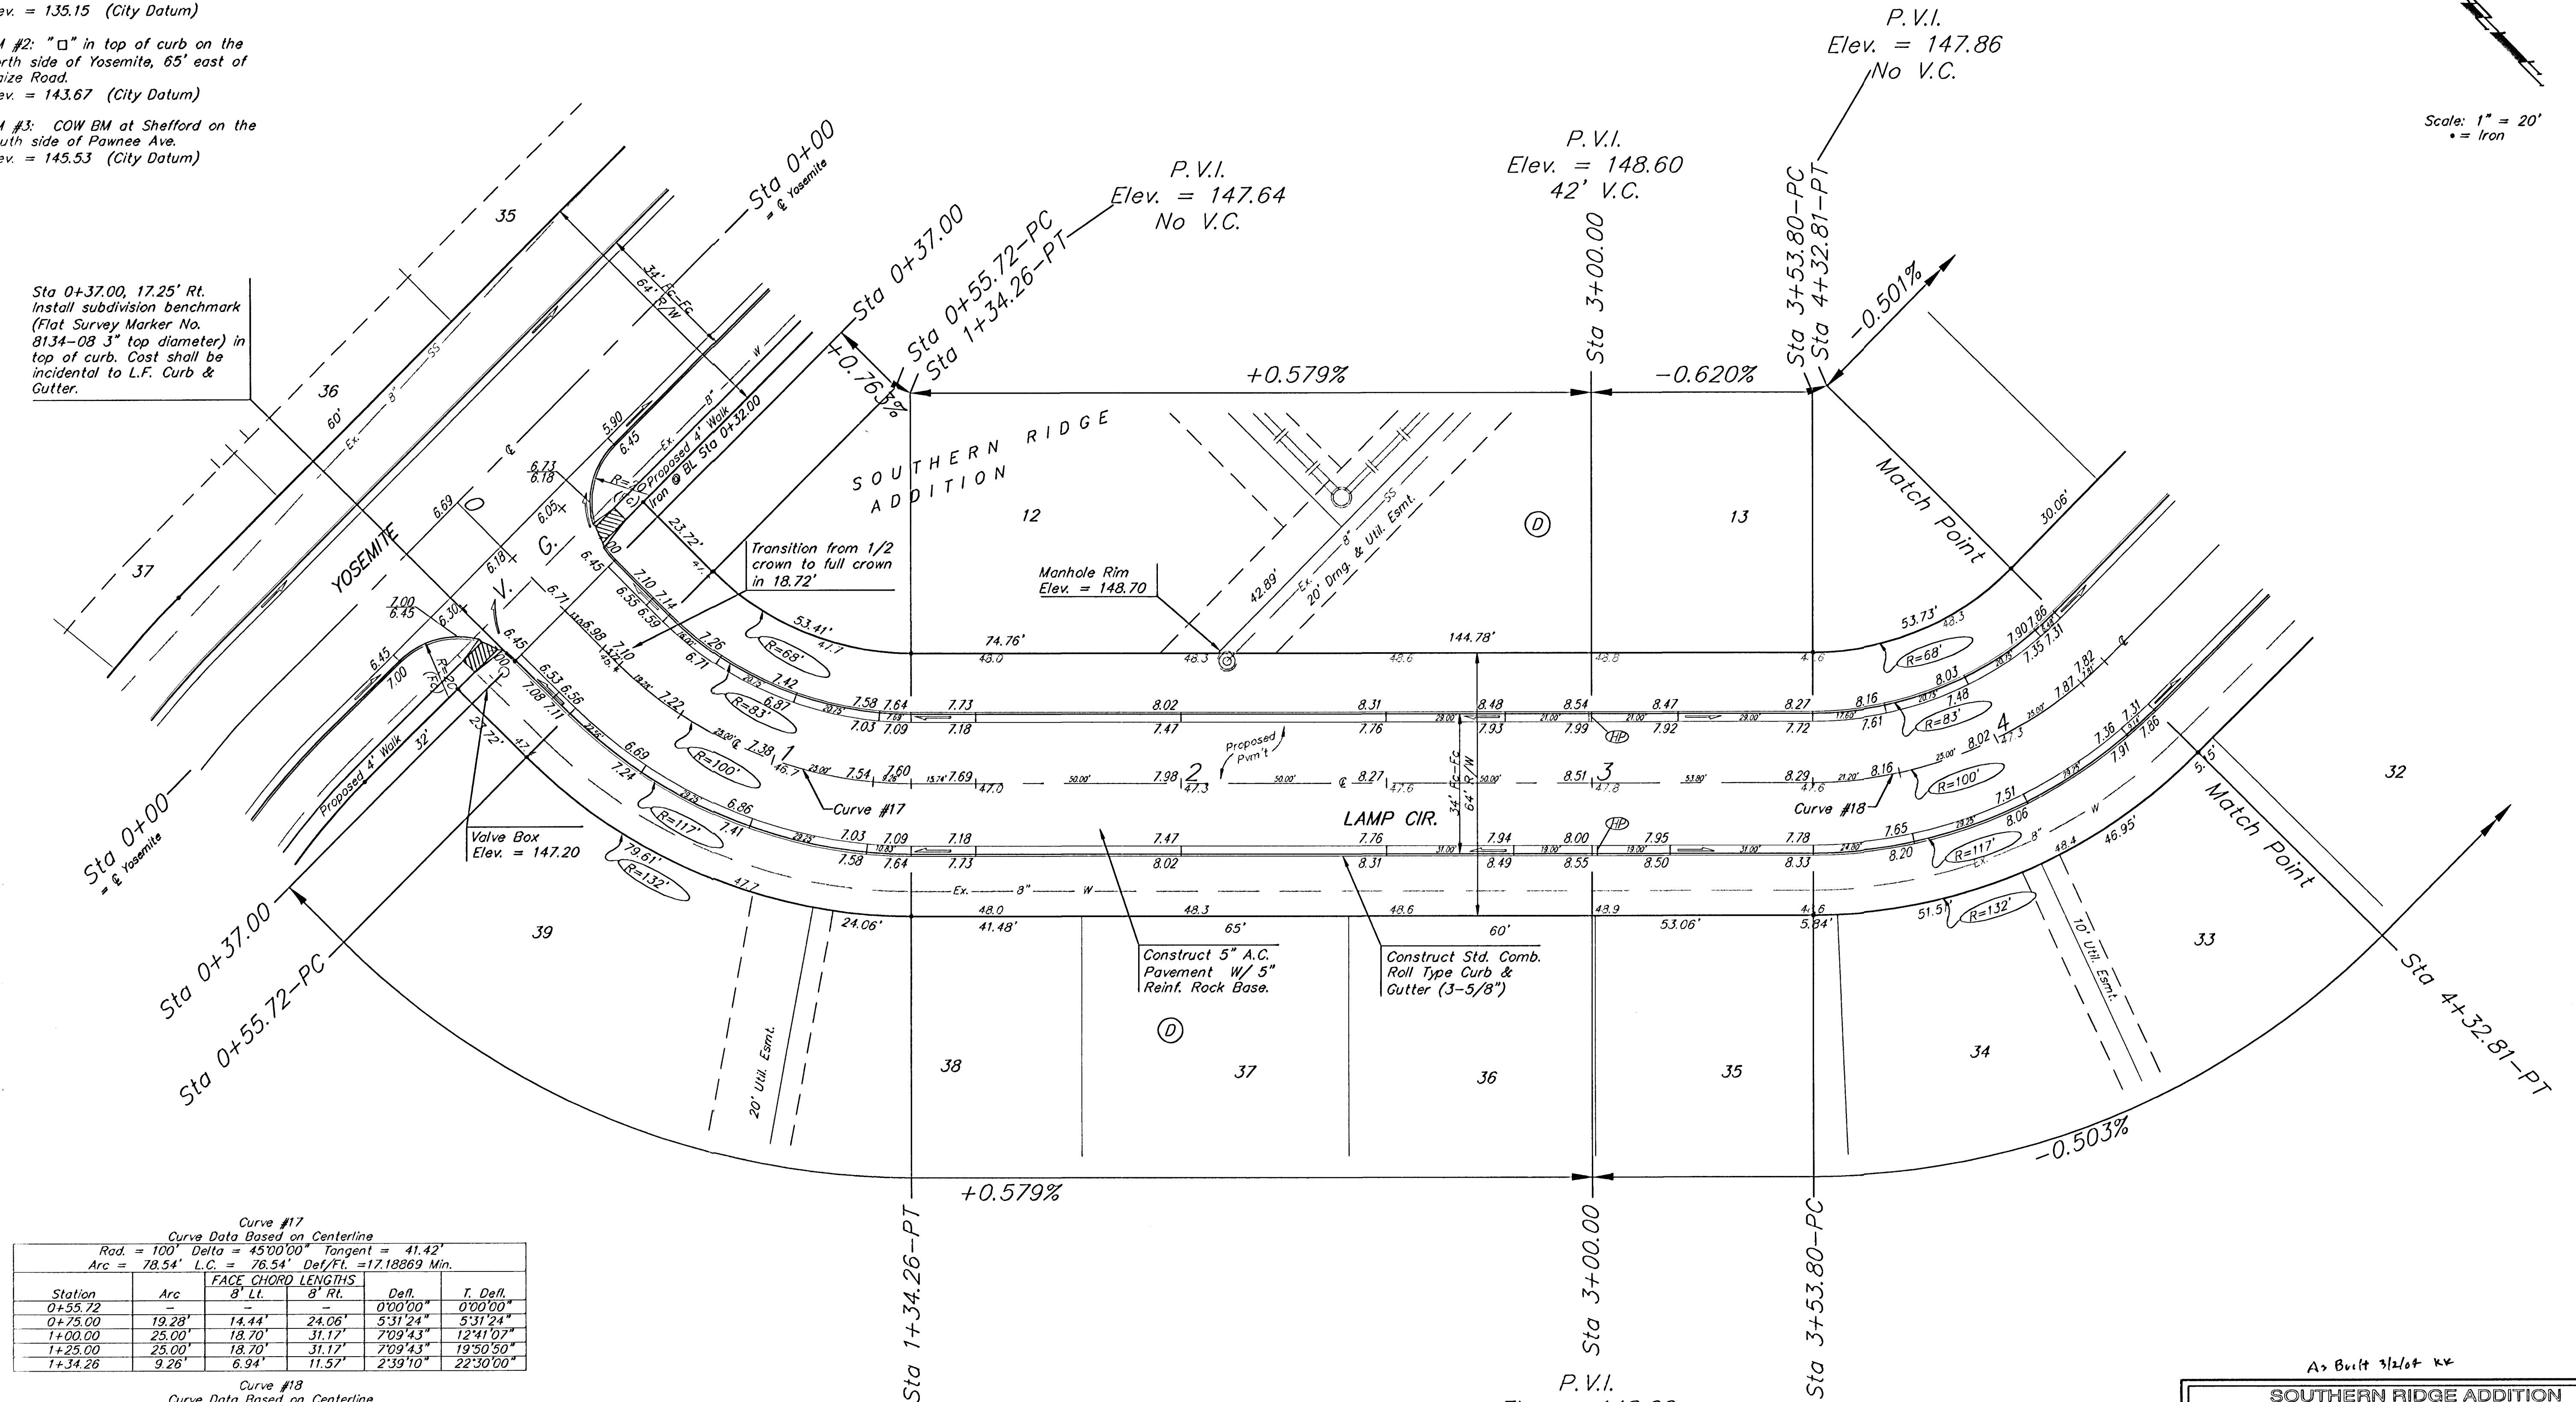

NOTE: ROLL TYPE CURB & GUTTER TO
 BE CONSTRUCTED ON THE
 PAVEMENT SHOWN ON THIS SHEET.
 TOP OF CURB ELEVATIONS ARE
 GIVEN FOR FULL HEIGHT CURB.

As Built 3/2/04 K4

SOUTHERN RIDGE ADDITION
LAMP CIR.
 STA 0+00 TO STA 4+32.81

BAUGHMAN COMPANY P.A.
 ENGINEERING, SURVEYING, & PLANNING
 316-262-7271 • 315 ELLIS • WICHITA, KANSAS 67211

PROJECT NUMBER
472-63881

DESIGN NBW	DRAWN TMS	APPROVED	DATE 05/03	SCALE Noted	SHEET 18 OF 48
---------------	--------------	----------	---------------	----------------	-------------------------