



RR Spike in N. Face of PP in
N. R/W of Maple N. of Nineiron.
Elev. = 177.01 (City Datum)

"□" Cut center of north
Headwall of RCBC in N. R/W of
Maple 570' East of centerline
of City View.
Elev. = 187.91 (City Datum)

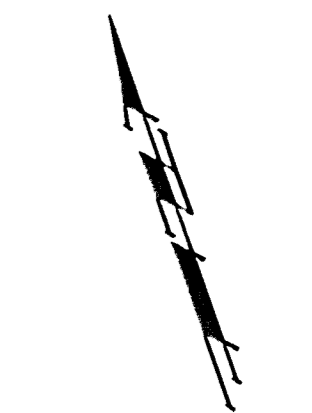

Scale: 1" = 20'
• = Iron

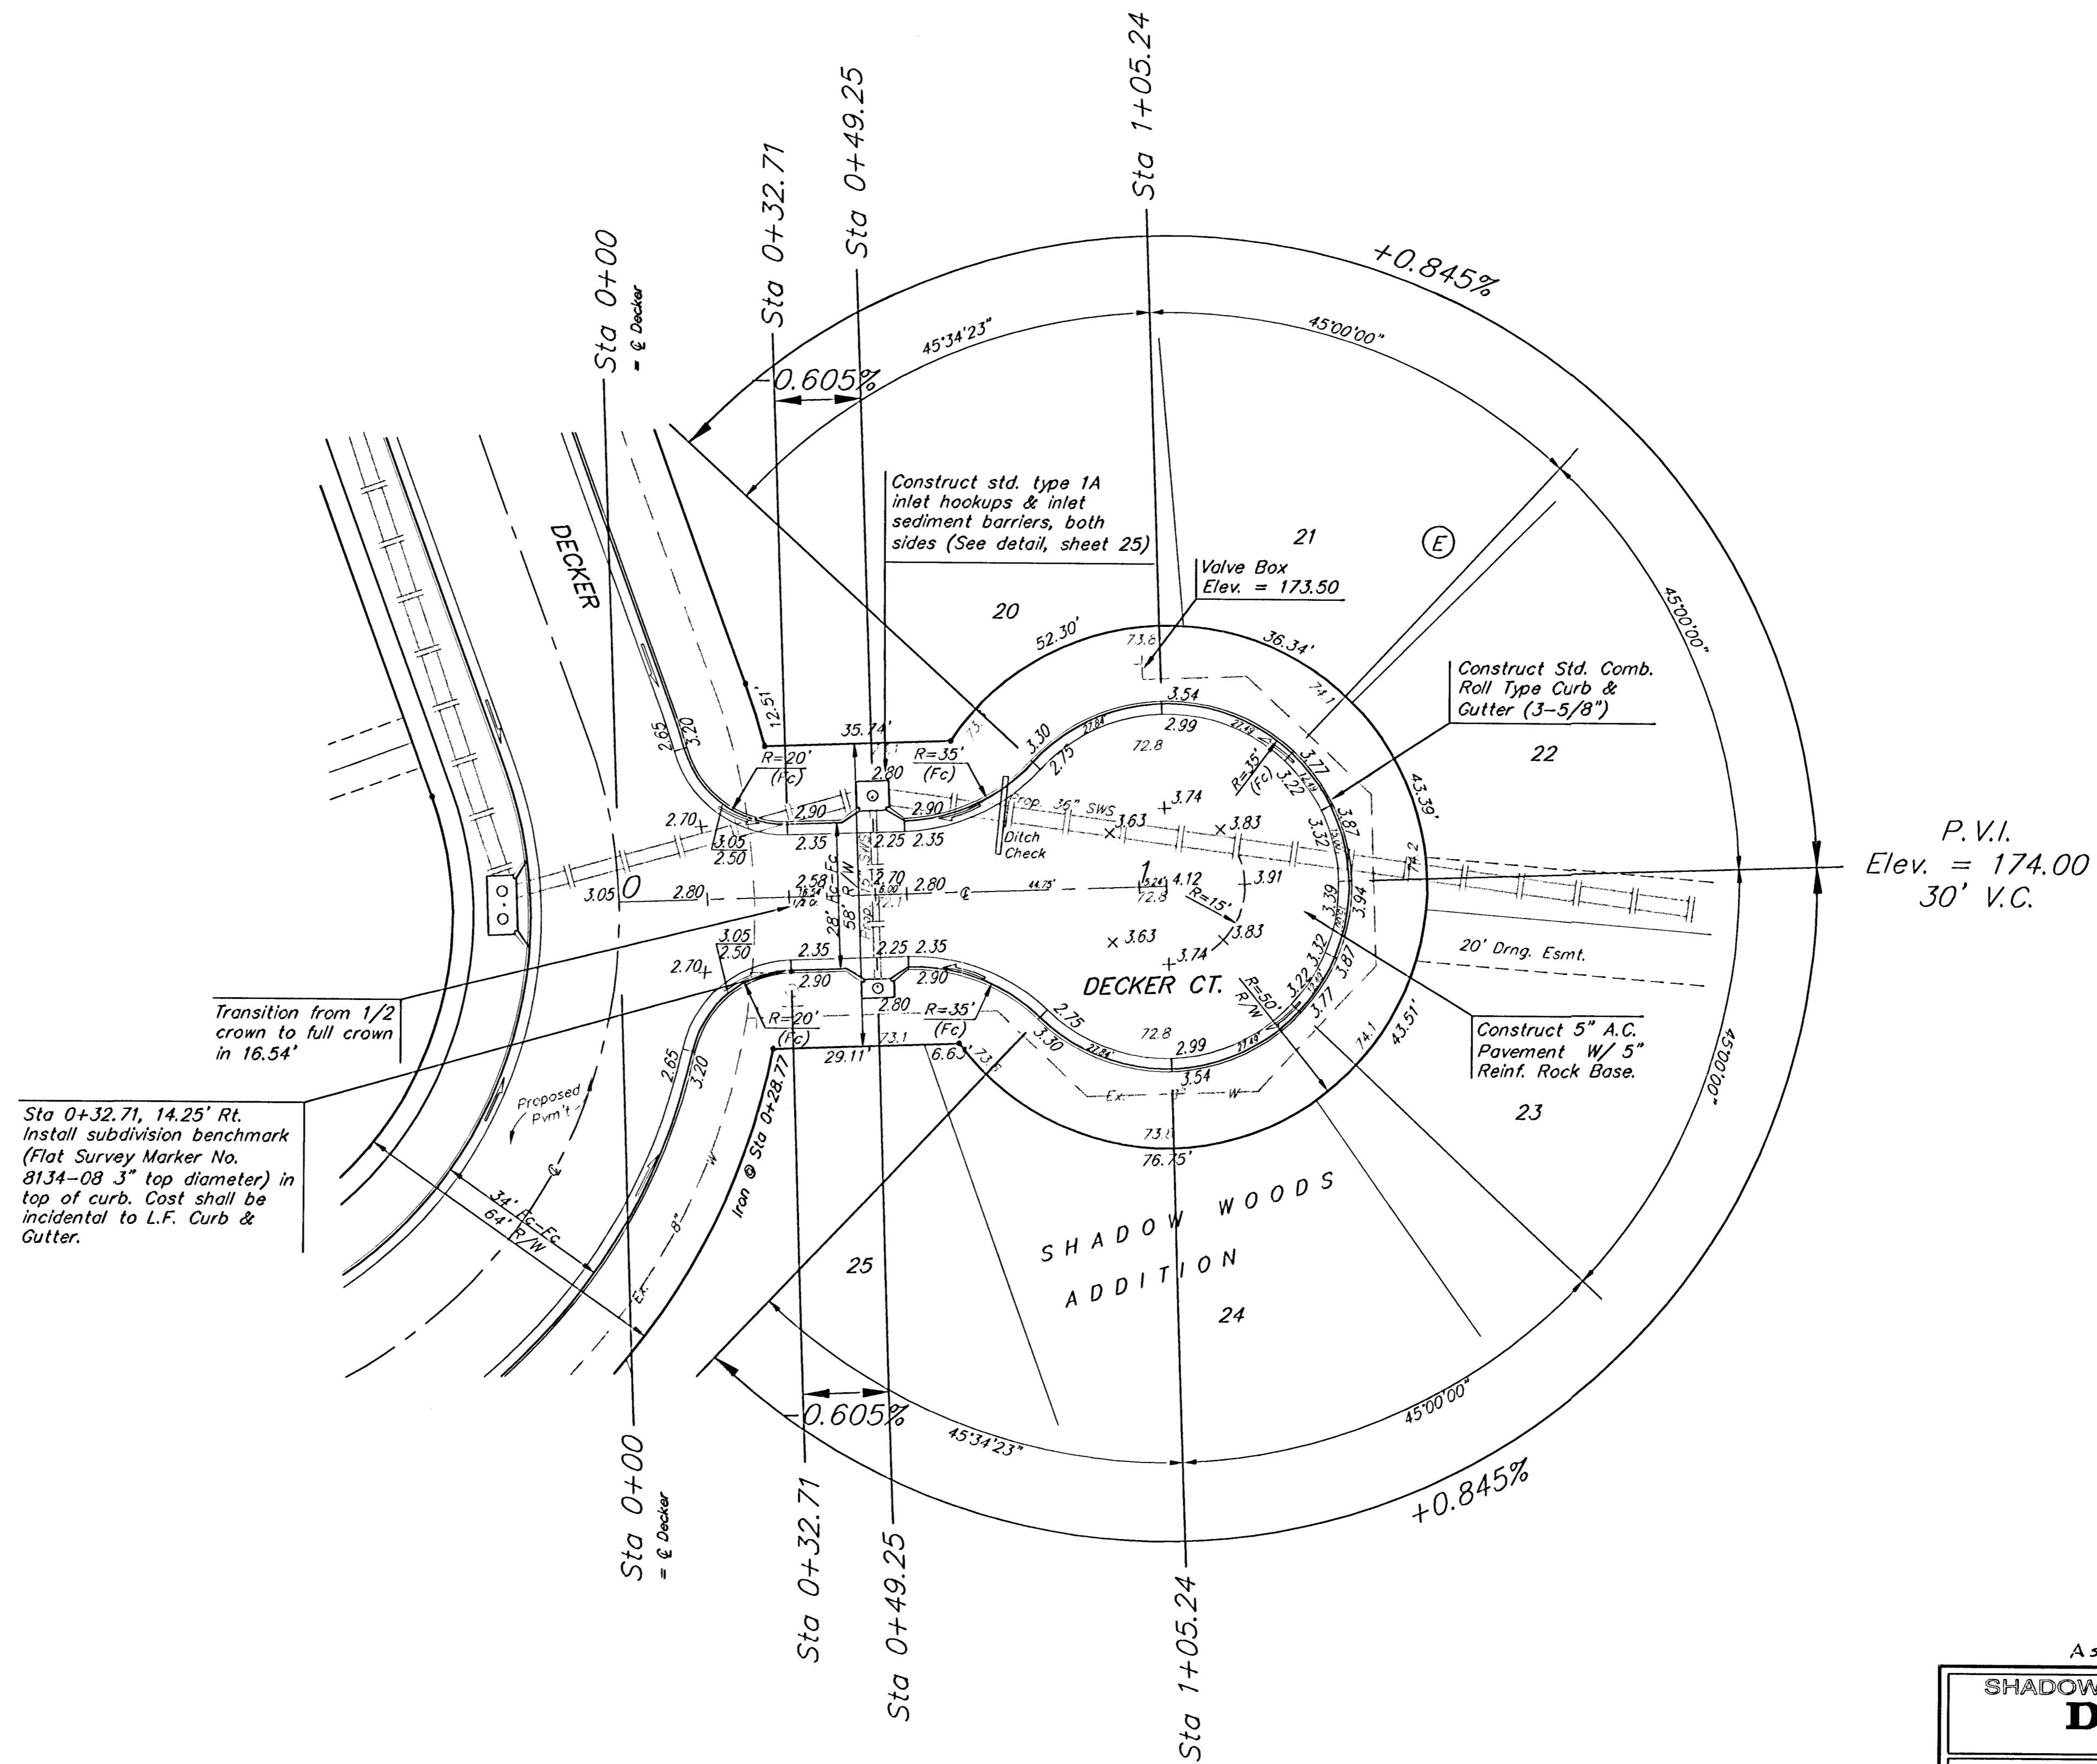

NOTE: ROLL TYPE CURB & GUTTER TO BE CONSTRUCTED ON THE PAVEMENT SHOWN ON THIS SHEET. TOP OF CURB ELEVATIONS ARE GIVEN FOR FULL HEIGHT CURB.

As Built

SHADOW WOODS ADDITION - PHASE IA
DECKER CT.
STA 0+00 TO STA 1+05.24

BAUGHMAN COMPANY P.A.
ENGINEERING, SURVEYING, & PLANNING
315-262-7271 • 315 ELLIS • WICHITA, KANSAS 67211

DESIGN NSW	DRAWN TMS	APPROVED	DATE 05-28-03	SCALE Noted	SHEET 12 OF 37
---------------	--------------	----------	------------------	----------------	-------------------------

Shadow Woods/Str 03-01-E496