



RR Spike in N. Face of PP in N. R/W of Maple N. of Nineiron. Elev. = 177.01 (City Datum)

" " Cut center of north Headwall of RCBC in N. R/W of Maple 570' East of centerline of City View. Elev. = 187.91 (City Datum)

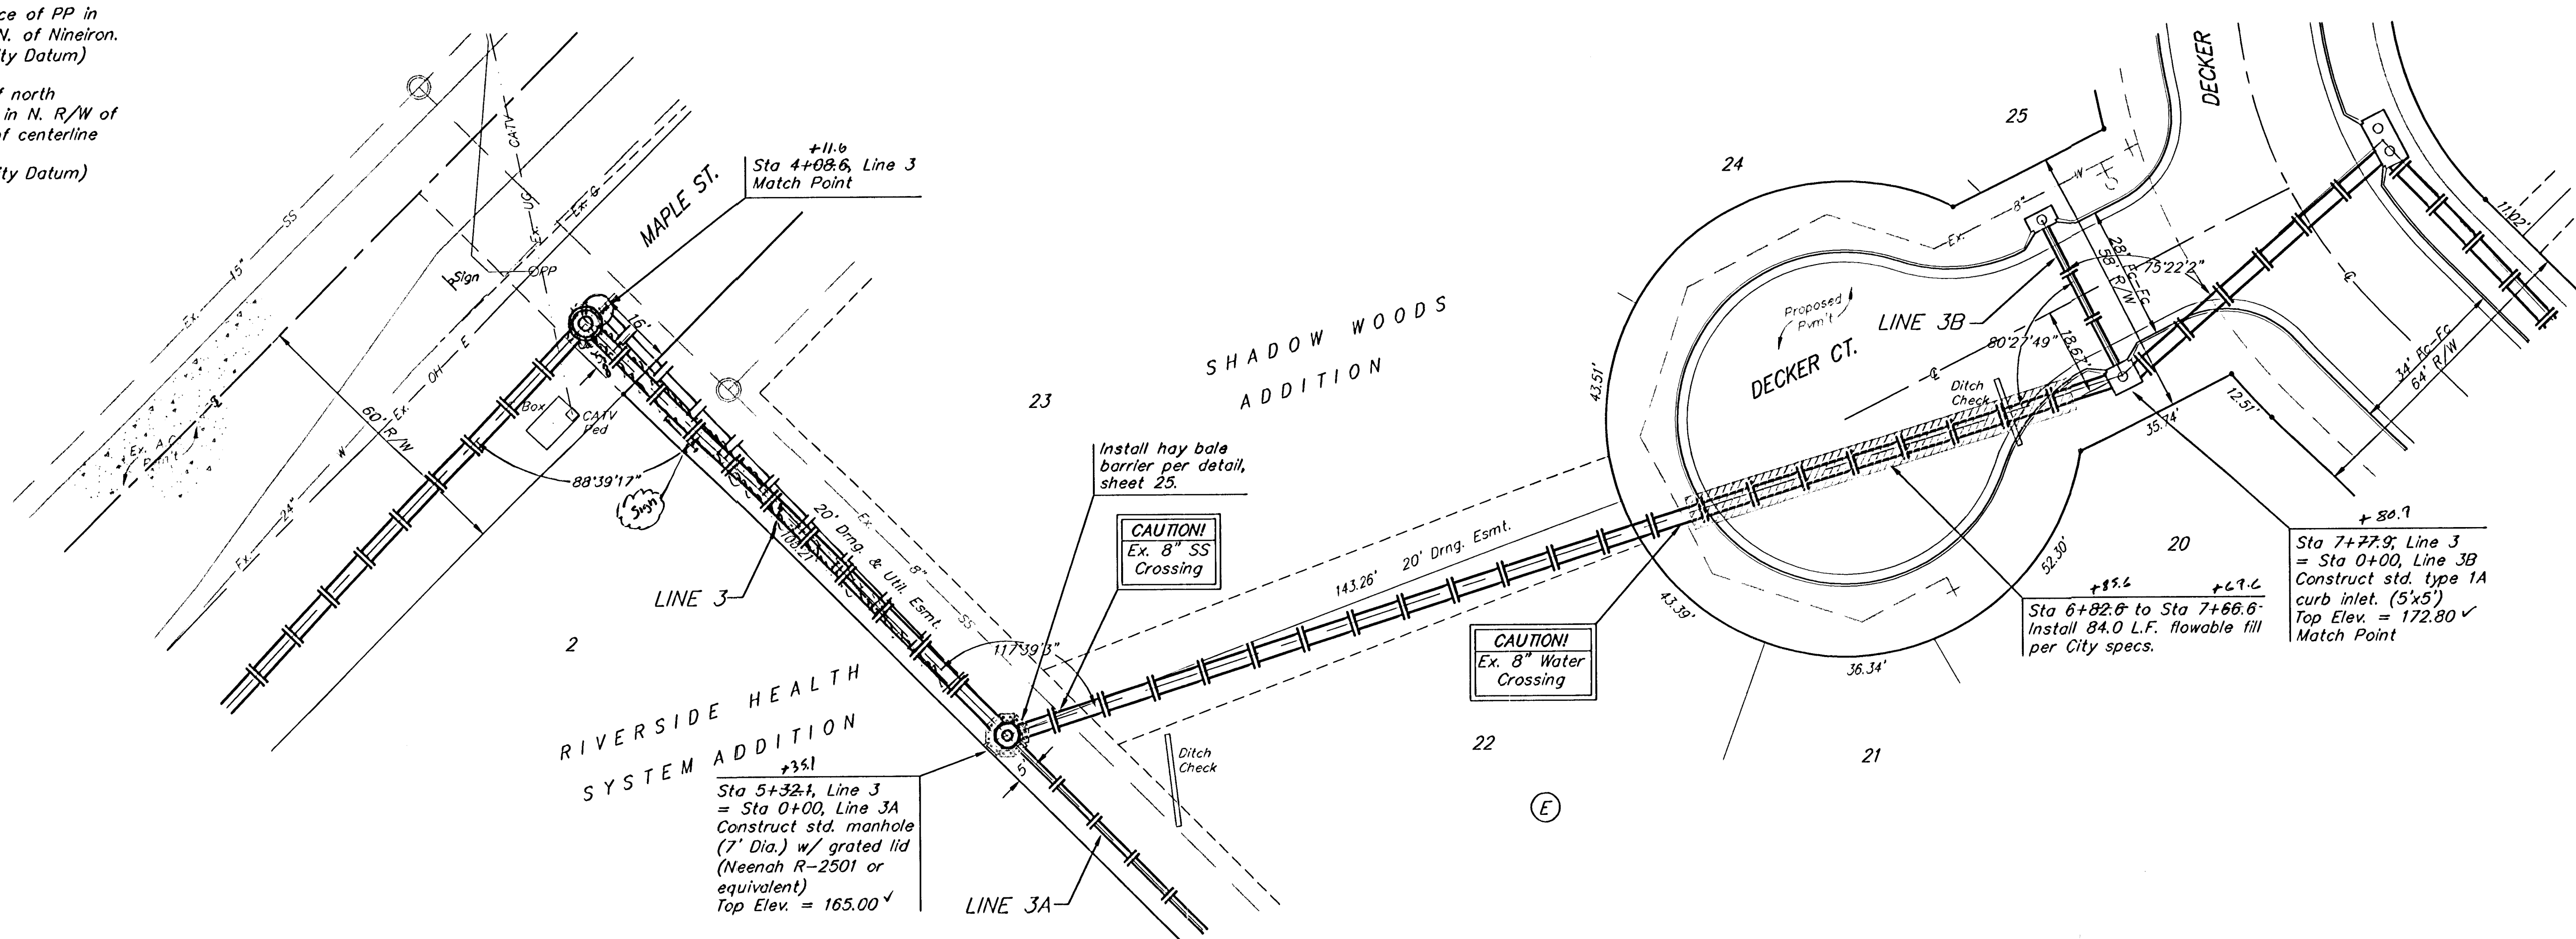

Scale: 1" = 20' Horizontal
1" = 5' Vertical
• = Iron

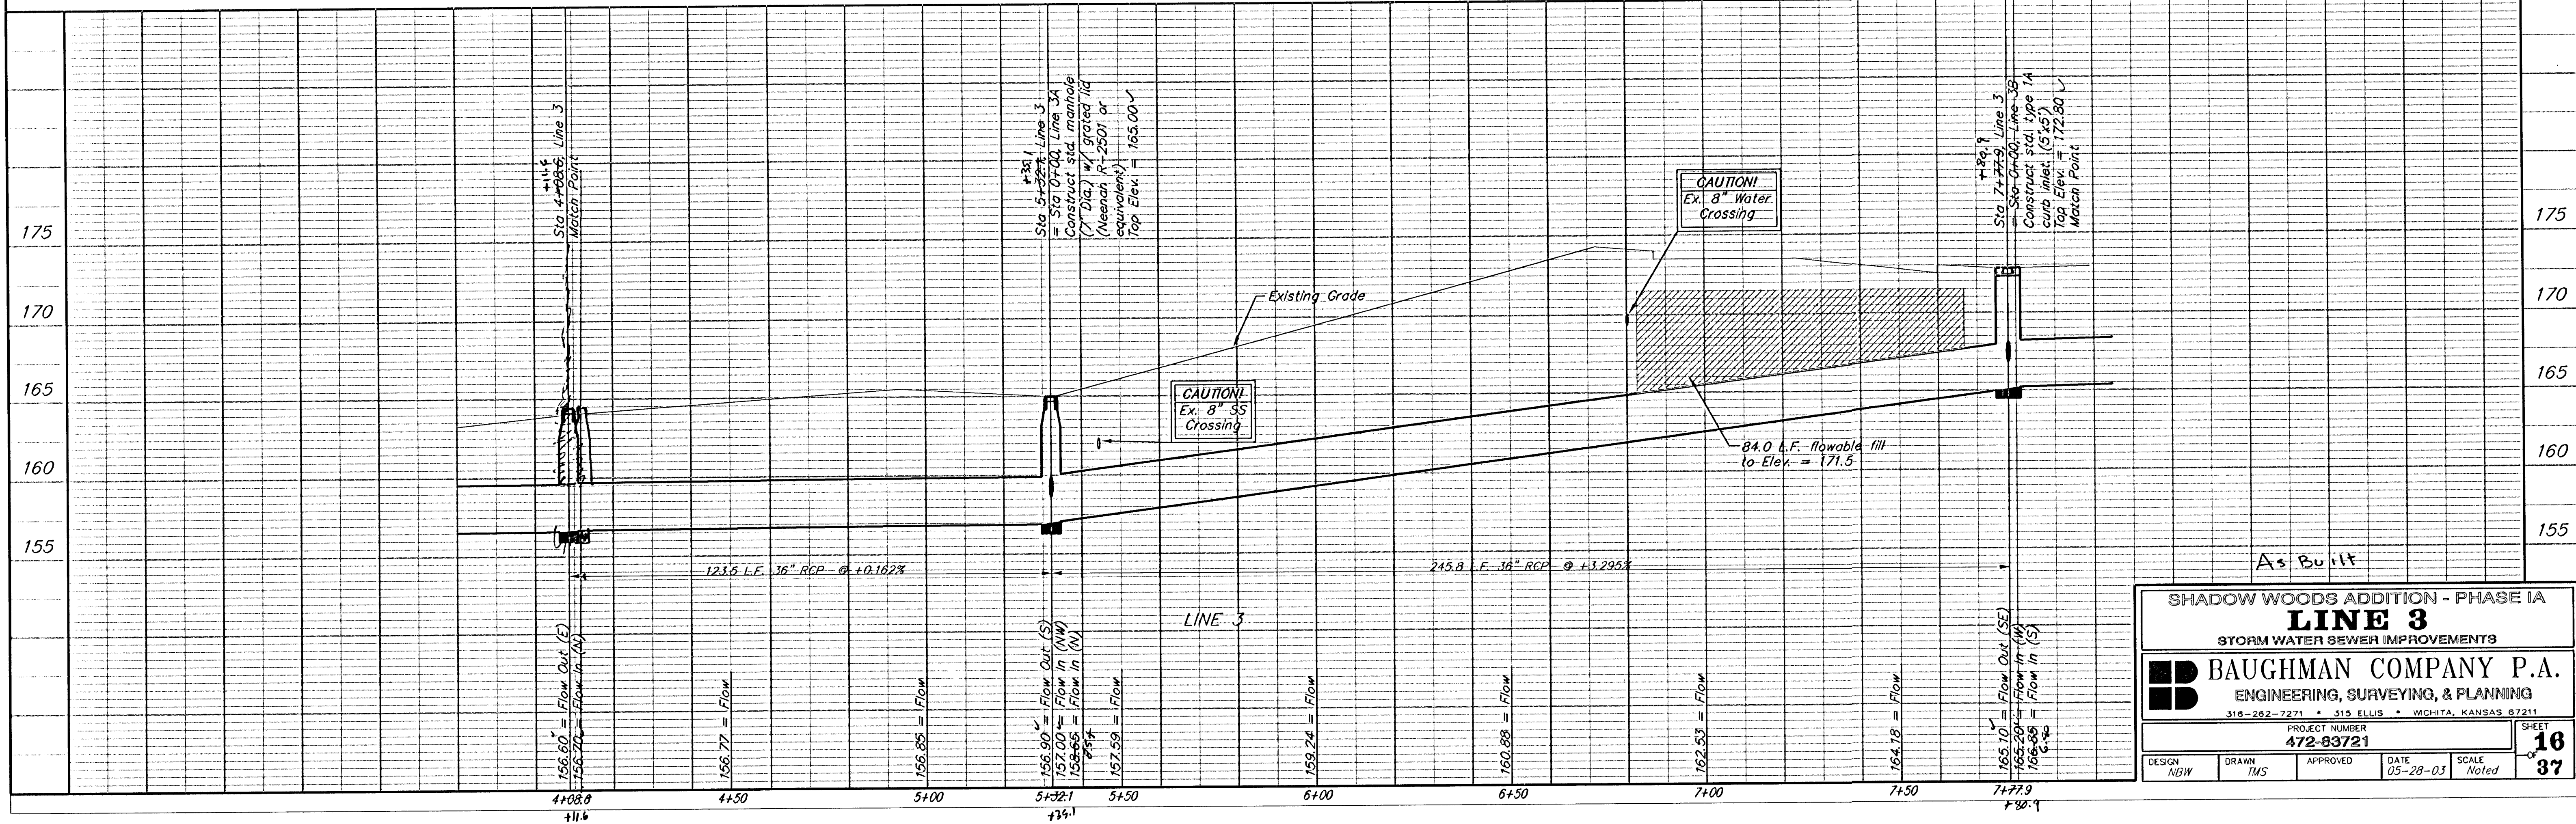

SHADOW WOODS ADDITION - PHASE IA
LINE 3
STORM WATER SEWER IMPROVEMENTS

BAUGHMAN COMPANY P.A.
ENGINEERING, SURVEYING, & PLANNING
316-262-7271 • 315 ELLIS • WICHITA, KANSAS 67211

PROJECT NUMBER
472-83721

DESIGN NBW DRAWN TMS APPROVED DATE 05-28-03 SCALE Noted

SHEET **16** OF **37**

Shadow Woods/SWS4-03-01-E301