

# UTILITY RELOCATIONS FOR I-235 BRIDGE REPLACEMENTS

BETWEEN MERIDIAN AND I-135

CITY OF WICHITA PROJECT NO. 448-90739

OCA NO. 636365


AND

CITY OF WICHITA PROJECT NO. 468-85126

OCA NO. 620850

CITY OF WICHITA, KANSAS  
GARY JANZEN, P.E. - CITY ENGINEER

Dondlinger Construction - Contractor  
G. Baalman - City of Wichita, Field Project Engineer  
As-built  
Release Date: 8/13/2018

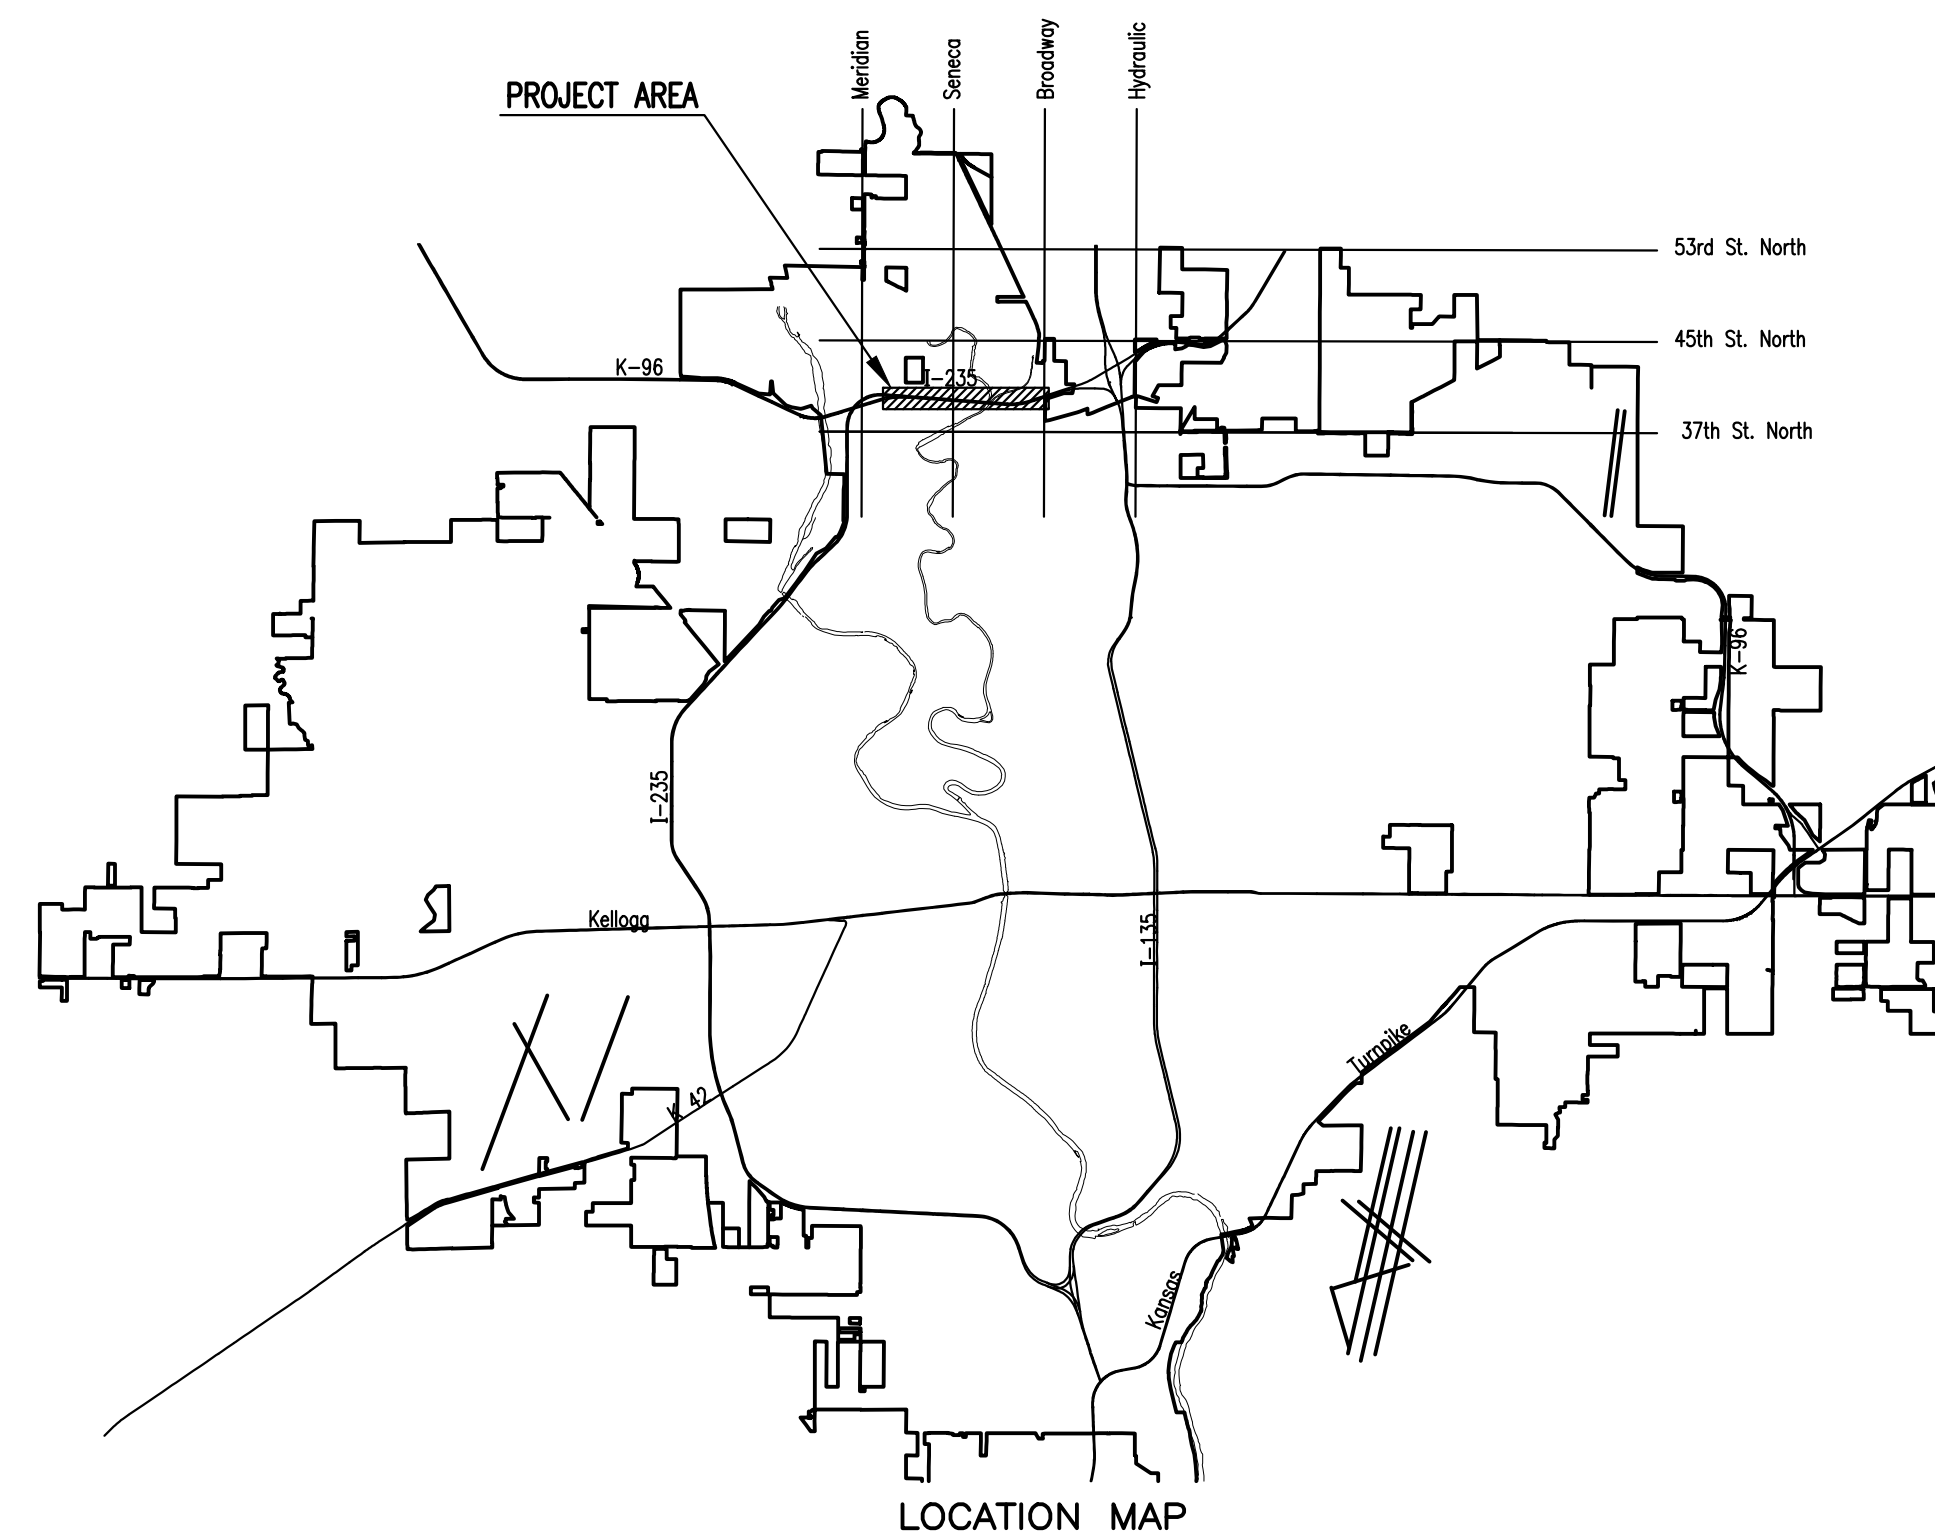

#### INDEX OF SHEETS

SHEET NO. 1	TITLE SHEET
SHEET NO. 2	KEY MAP AND GENERAL NOTES
SHEET NO. 3	BUBBLE MAP
SHEET NO. 4	DEMOLITION PLAN (WATERLINE NO. 1)
SHEET NO. 5-6	WATERLINE NO. 1
SHEET NO. 7	WATERLINE NO. 2 AND NO. 3
SHEET NO. 8	WATERLINE NO. 4
SHEET NO. 9	STANDARD WATER ASSEMBLY DETAIL
SHEET NO. 10	MISCELLANEOUS WATER DETAILS
SHEET NO. 11	STANDARD WATER SERVICE DETAIL
SHEET NO. 12	FORCE MAIN LINE NO. 1
SHEET NO. 13	FORCE MAIN LINE NO. 2
SHEET NO. 14	FORCE MAIN LINE NO. 3
SHEET NO. 15	SANITARY SEWER LINE NO. 1
SHEET NO. 16	PRECAST SANITARY SEWER MANHOLE
SHEET NO. 17	MANHOLE FRAME AND COVER
SHEET NO. 18-22	SOIL EROSION BMP'S

OCTOBER 2017

PLANS PREPARED BY  
PROFESSIONAL ENGINEERING CONSULTANTS, P.A.  
ENGINEERS  
WICHITA, KANSAS

