


SANITARY AND STORM SEWER IMPROVEMENTS TO SERVE BAXTER AND ASSOCIATES 1676 PPS (607861) CITY OF WICHITA, KANSAS Jim Armour, P.E., City Engineer

INDEX OF SHEETS



- 1 Cover Sheet
- 2 Plan and Profile SS
- 3 Plan and Profile SWS
- 4 Type P Manhole Detail
- 5 Type 1 Inlet Detail

GENERAL NOTES

1. Contractor will be required to provide notice to utility companies a minimum of twenty-four (24) hours prior to any excavation, as follows:
 Kansas One-Call 687-2470
 The Contractor must notify the following in case of an emergency:
 Cablevision 262-4270
 or Westor Energy 263-2061
 383-8650
 383-8600
 Southwestern Bell Telephone Company 1-571-2611
 City of Wichita Water Department 268-4908
 City of Wichita Sewer Department 268-4071
 Kansas Gas Service 832-3168
 or 832-3167
2. Exist. utilities and their locations, as shown on the plans, represent the best information obtainable for design. Location information has been obtained from the various utility companies and is either from company record drawings or company-provided field locations. The Contractor will be required to work around existing utilities which do not conflict with proposed construction.
3. The Contractor to verify utility locations prior to construction of this project.
4. Utility service and installation shall be coordinated with the respective utility owners. Contacts are:
 Kansas Gas Service James Stoltz 831-3122
 Westor Energy Russ Chitwood 261-6251
 Wichita Water Paul Bryant 268-4555
 Steve Palmer 268-4908
 Southwestern Bell Jim Toben 268-2759
 Multimedia Cablevision Mark Anaya 262-4270
5. All lawn/turf areas disturbed by construction of proposed improvements shall be restored with sod. All sodding work shall be in accordance with the City of Wichita standard specifications and the City of Wichita administrative regulation No. AR78 which governs cleanup and replacement following construction. All costs for this work shall be subsidiary to the lump sum price bid for "Site Restoration."
6. Traffic affected by the construction of this project shall be handled in accordance with the latest edition of the Manual on Uniform Traffic Control Devices.
7. All commercial signs to be moved by others prior to construction.
8. Properties within the project may have underground irrigation systems (lawn sprinklers) which conflict with the new construction. Contractor shall remove such components as needed during construction of the project. The irrigation system shall be reinstalled in like kind before project completion. Any irrigation system modifications required because of project improvements shall be coordinated with the property owner. Portions of underground irrigation systems not in conflict with construction shall be protected from damage and shall remain in place. All work related to underground irrigation/sprinklers shall be subsidiary to Site Restoration.
9. Cuts made to paved surfaces on public property will be repaired by the City's contractor and charged against the owner / applicant. Unit repair Prices are available from the City at 268-4418. A surcharge may be applicable: Call 268-4418 for details. Repair costs to be paid prior to release of water Service if water service is affected.

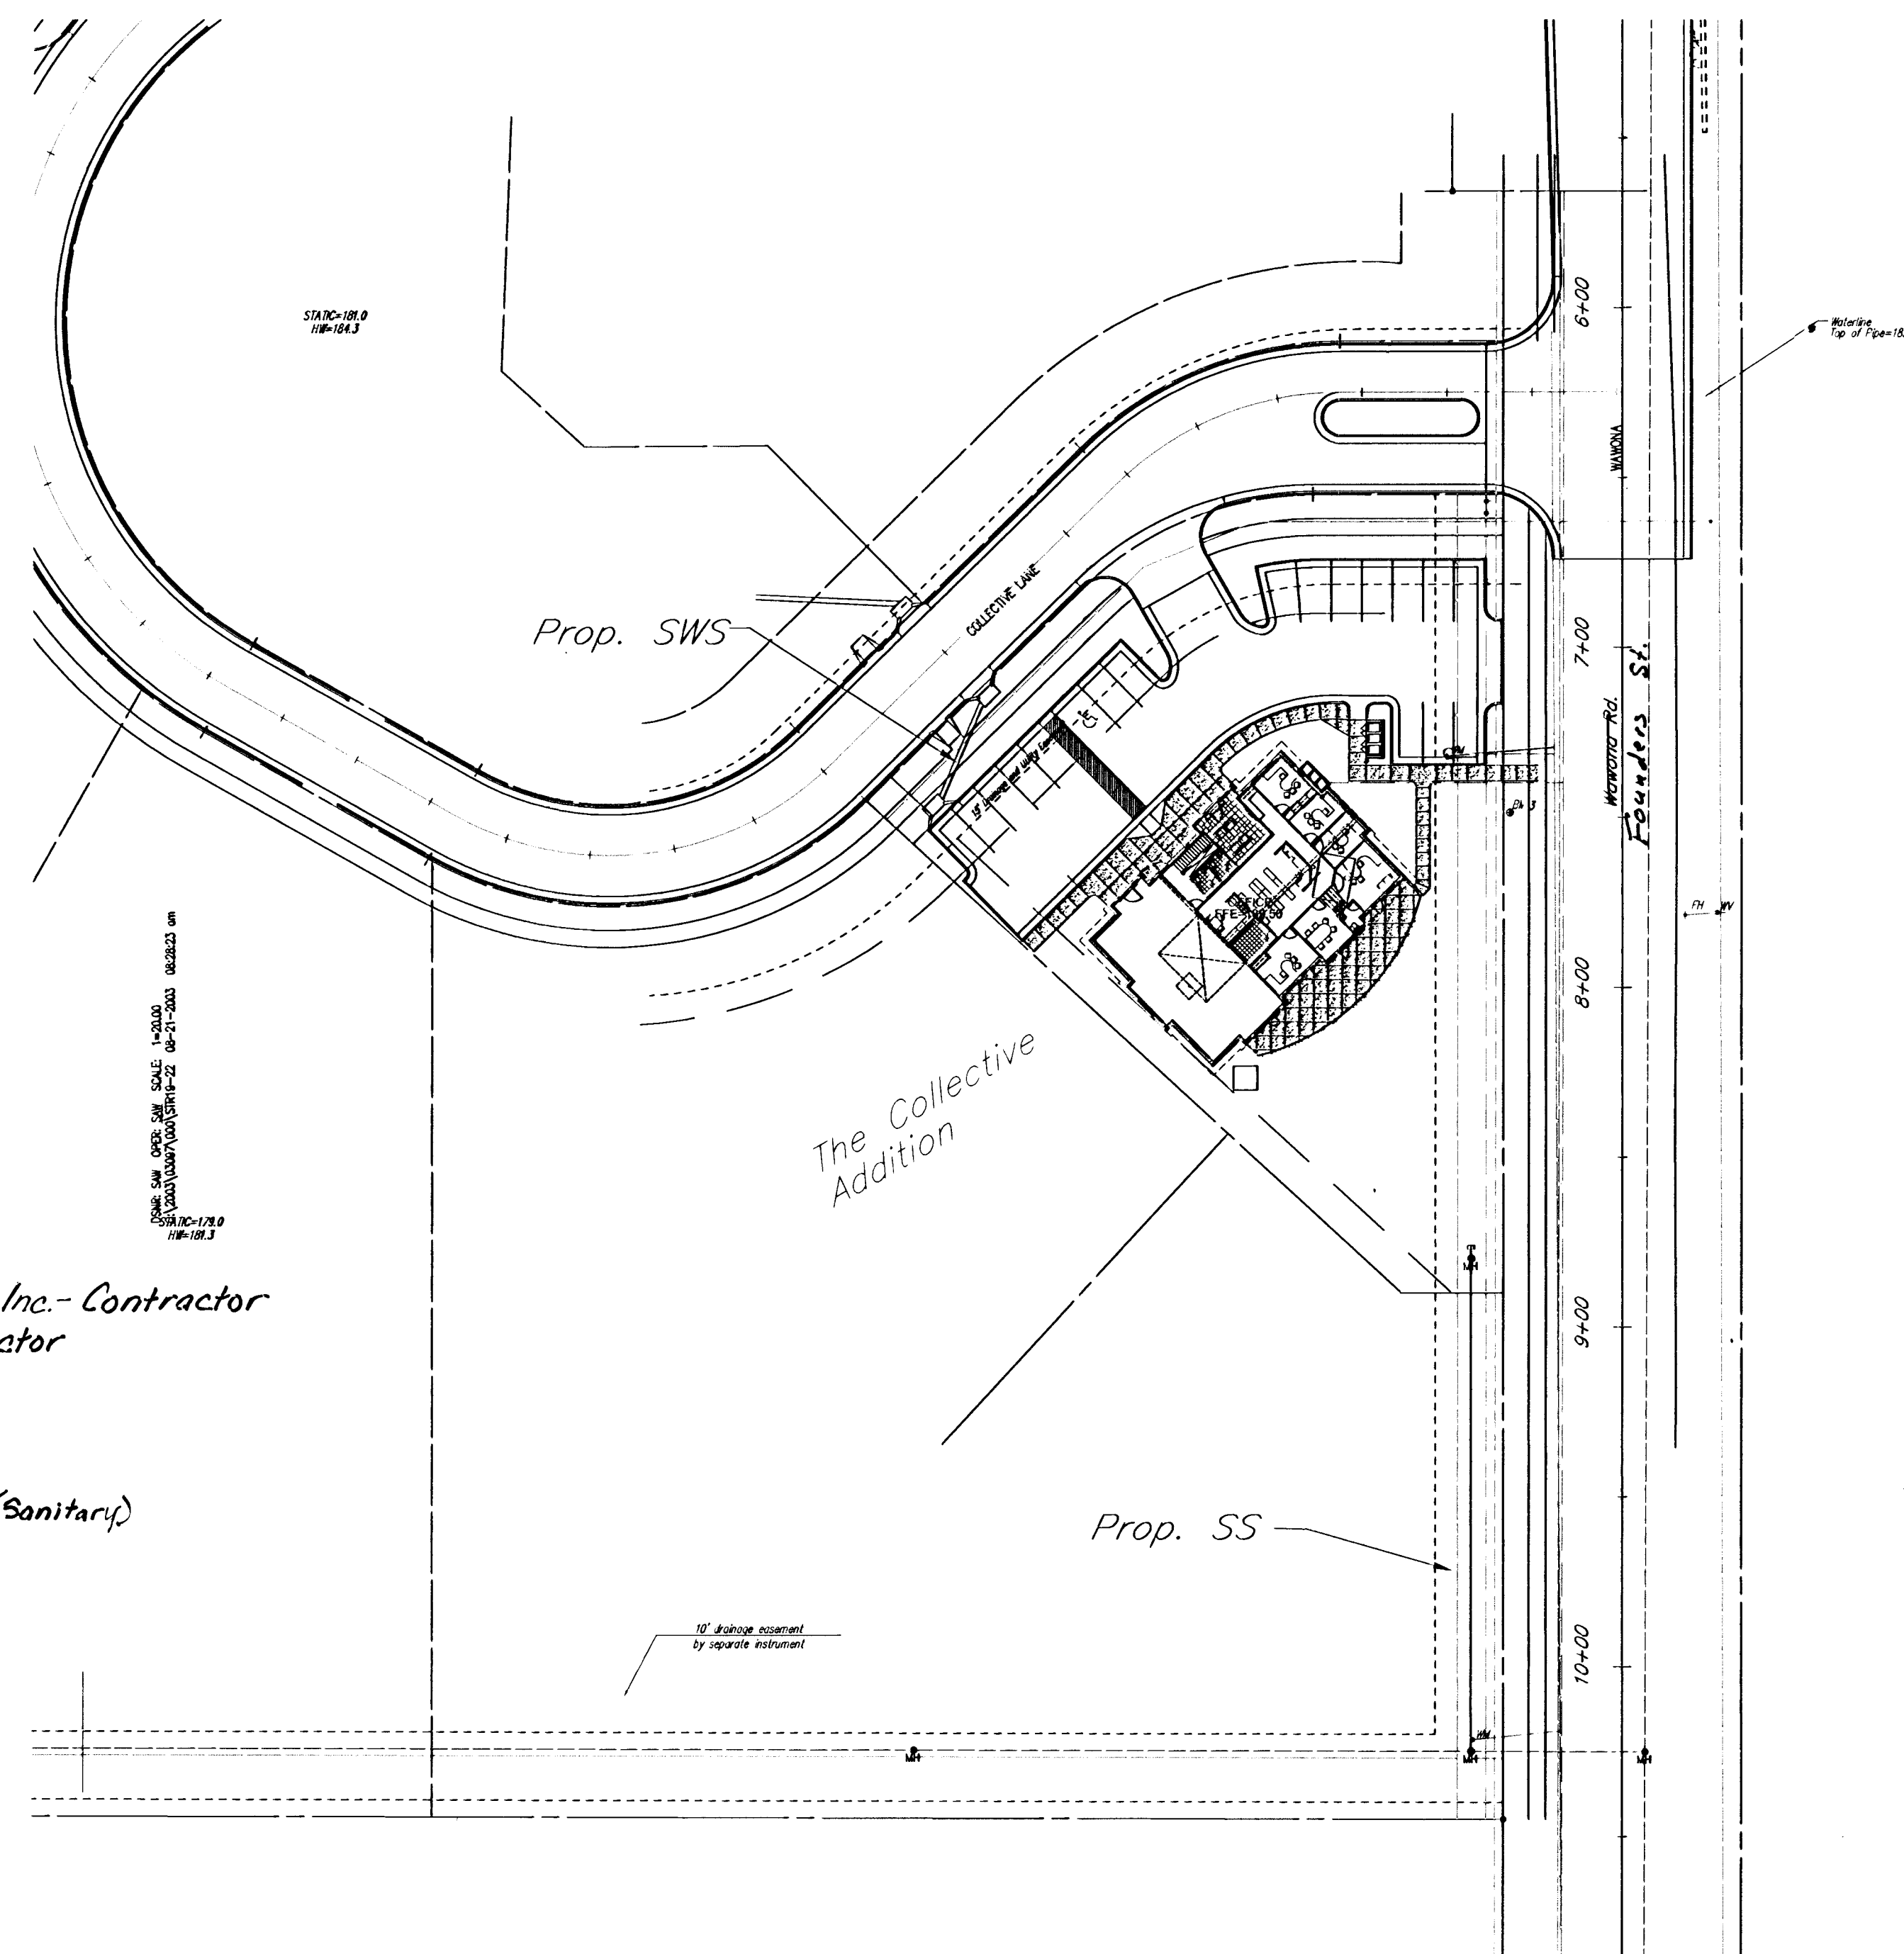

McCullough Excavation, Inc. - Contractor
 Gann, K.E. Miller - Inspector
 Released 9/1/06
 As-Built
 Stub
 .pdf by JDL 9/13/06 (Sanitary)

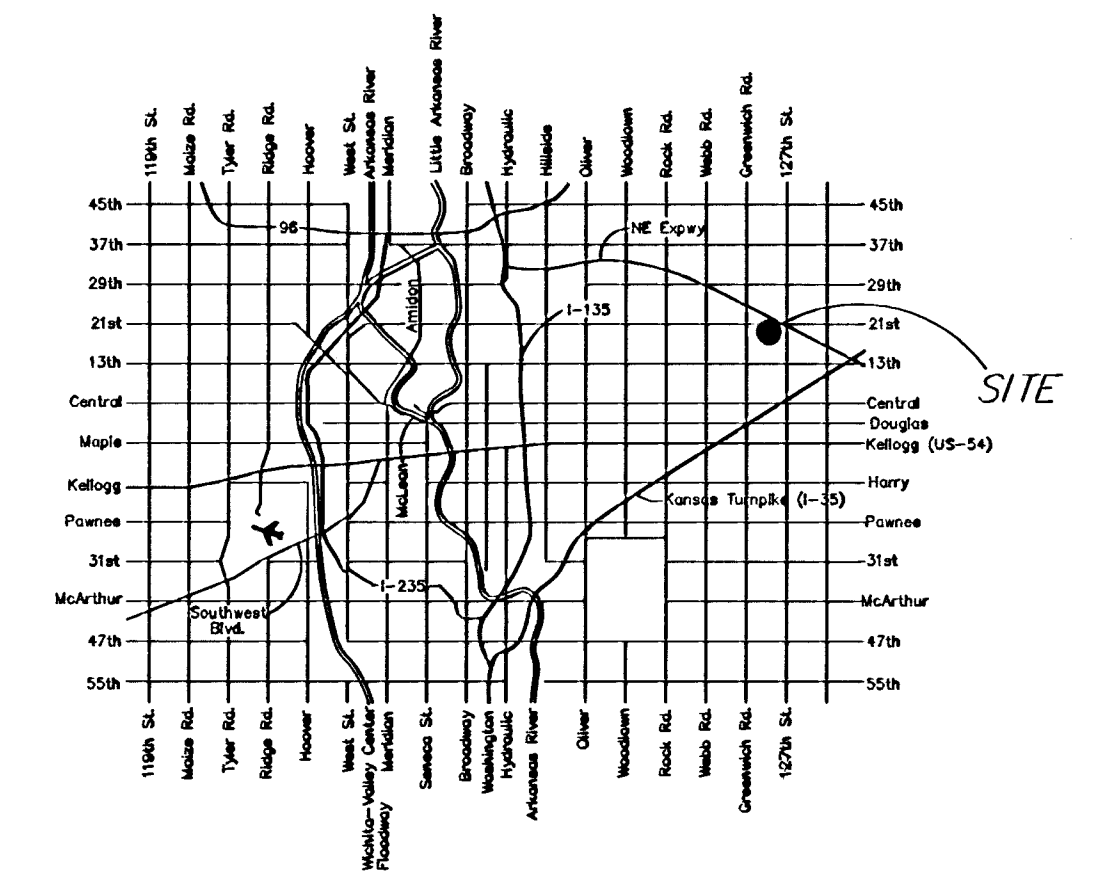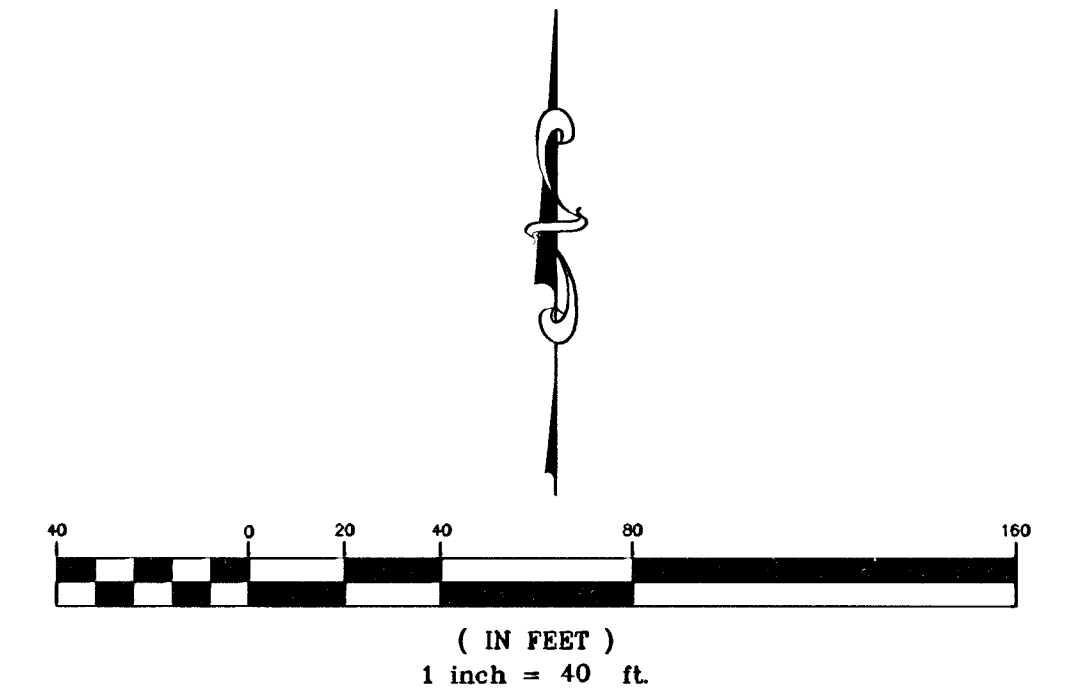

LOCATION MAP

Benchmark:
 R.R. Spike in N. Face of
 P.P. 120± of Ctr. Res.
 A on W. side of Wawona.

Baseline:
 0+00 at the intersection
 of 21st and Wawona.

APPROVED AS NOTED
 City Engineer Office: *[Signature]* 8/30/06
 NOTE TO CONTRACTORS
 Installation, inspection and testing for this project is to be provided by a Licensed Consulting Engineering Firm under contract with the Owner/Developer. Said inspection to be in accordance with the City of Wichita standard construction engineering practices and certified by a Licensed Professional Engineer. No work shall be performed in dedicated easements or public right-of-way by the Contractor without such inspection nor shall any work be commenced without written authorization by the City Engineer. All Construction and Materials shall comply with the City of Wichita Specifications and Standards (on file and available in the City Engineer's Office).

AS-BUILT
 8/31/06
 Date: K.E. Miller
 K.E. Miller
 8/31/06



516 S. Market,
 Wichita, KS 67202
 316/264-0242