
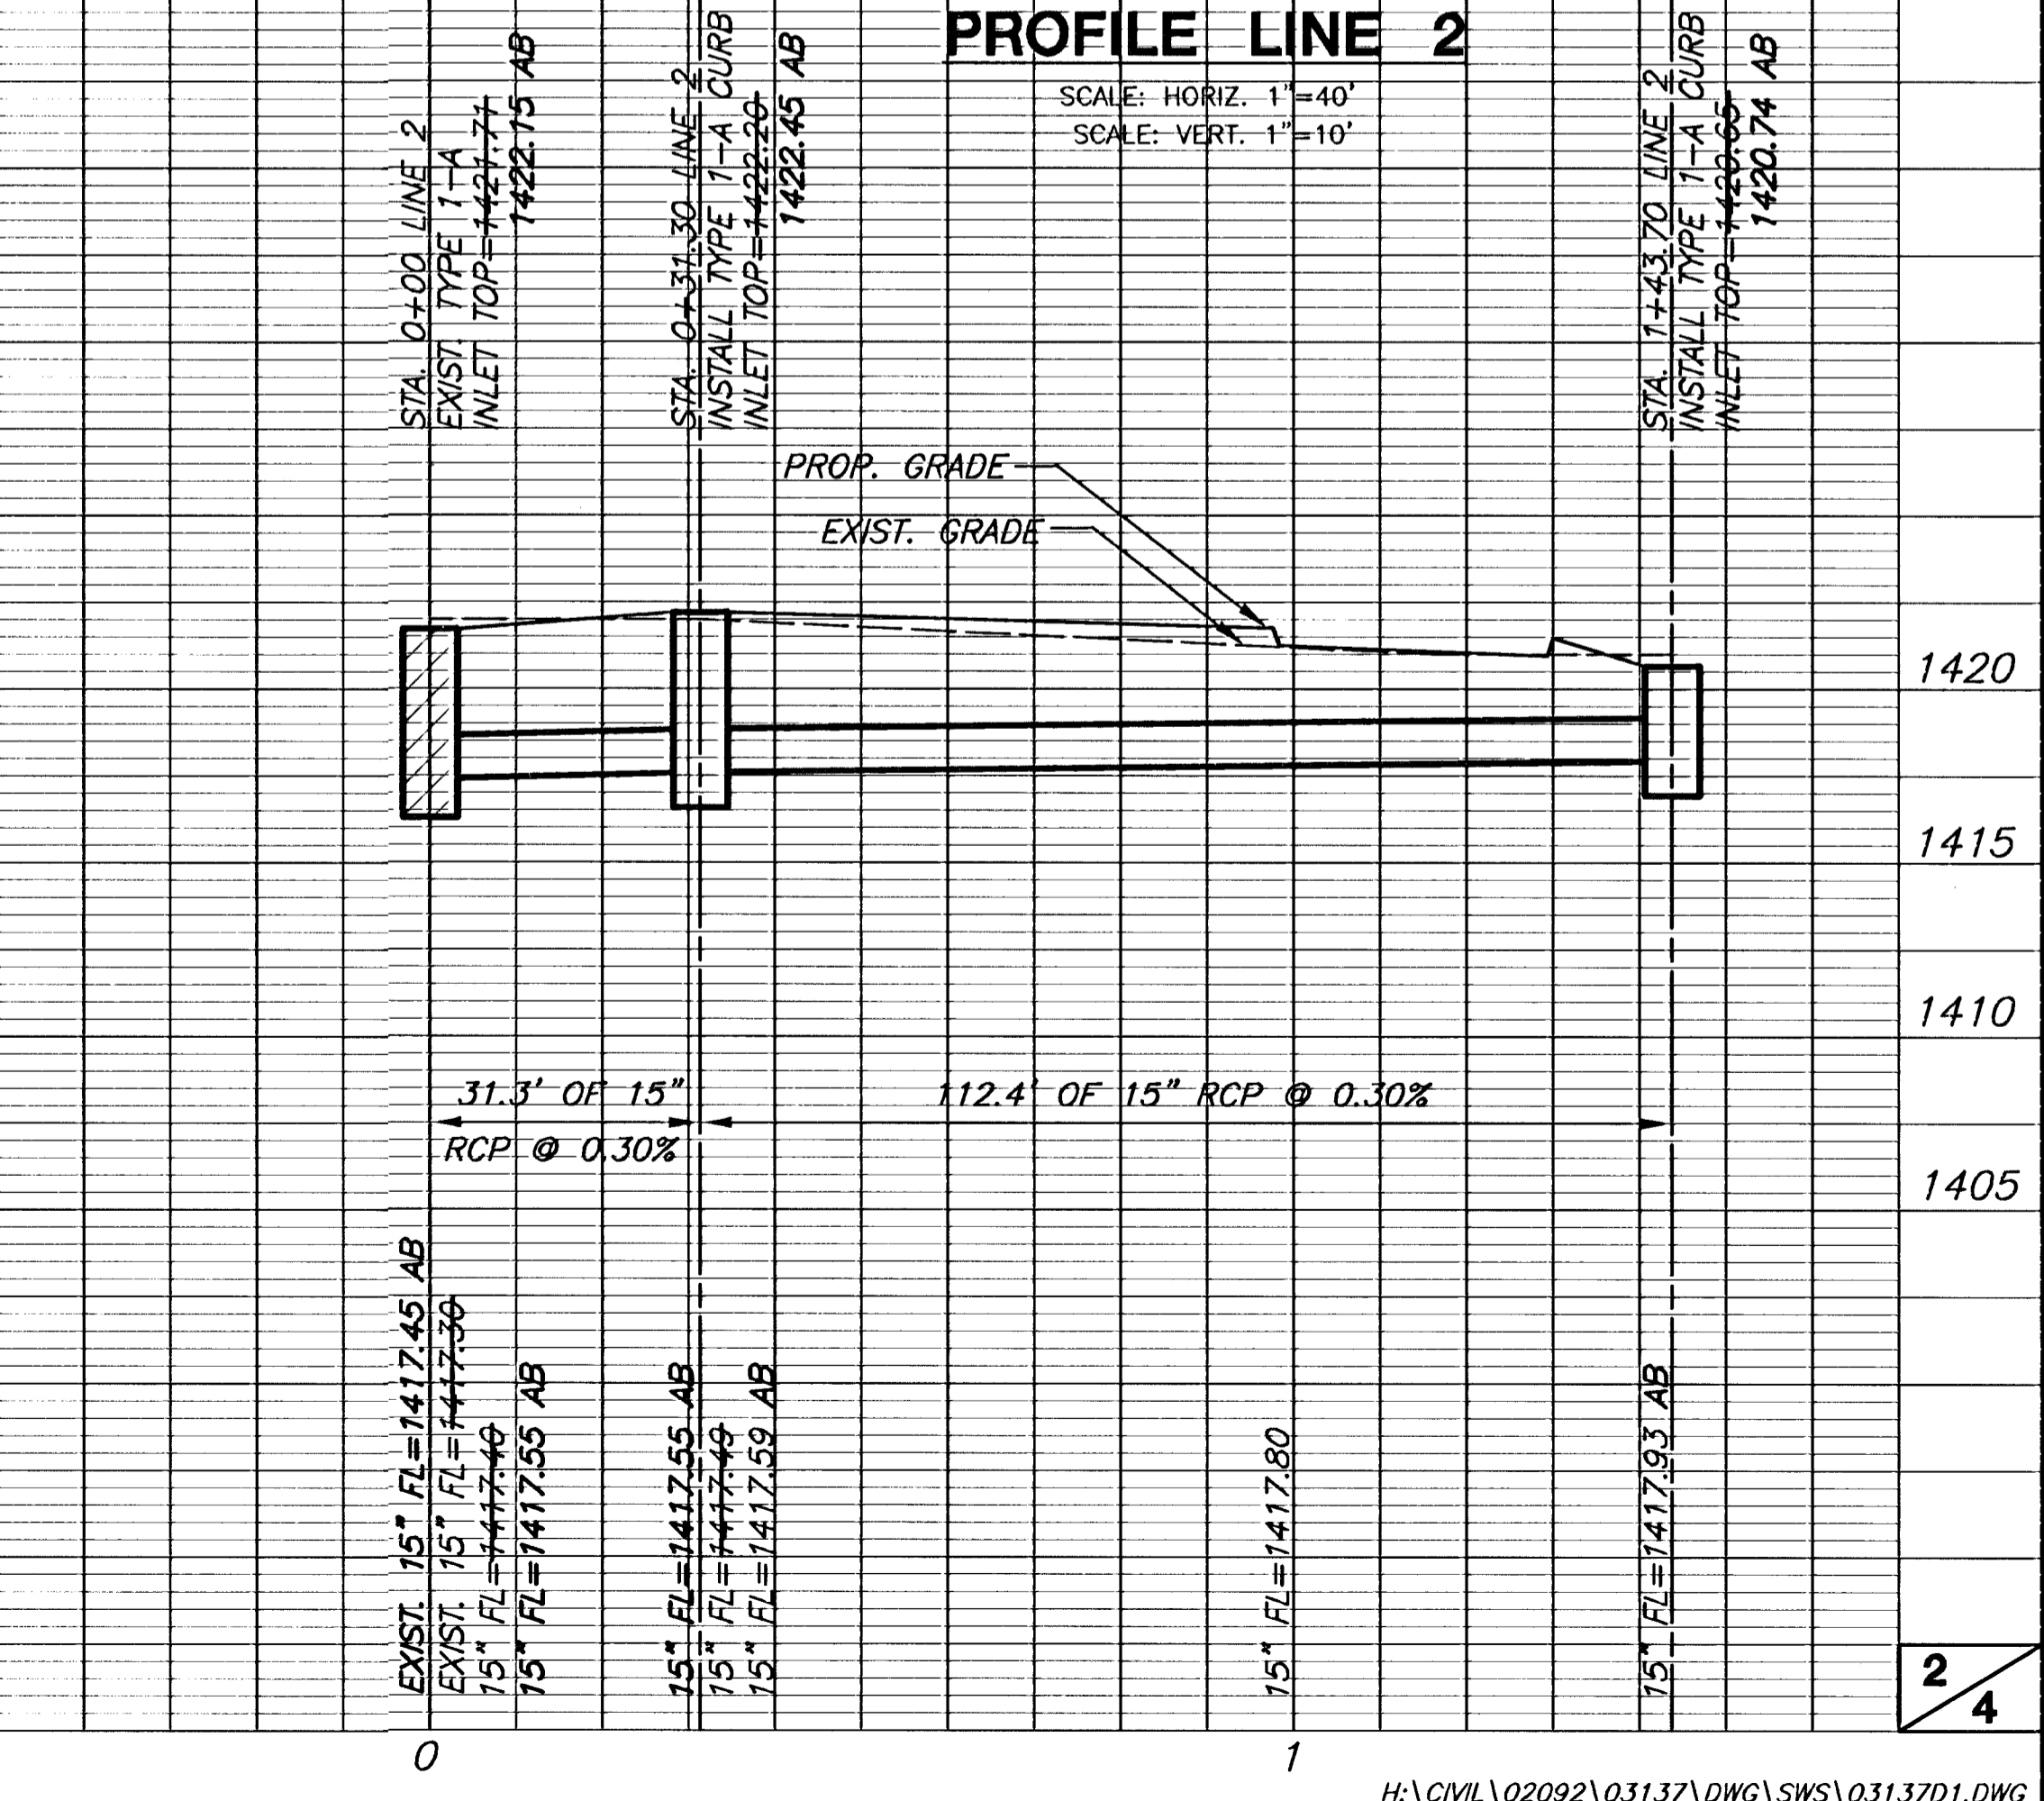
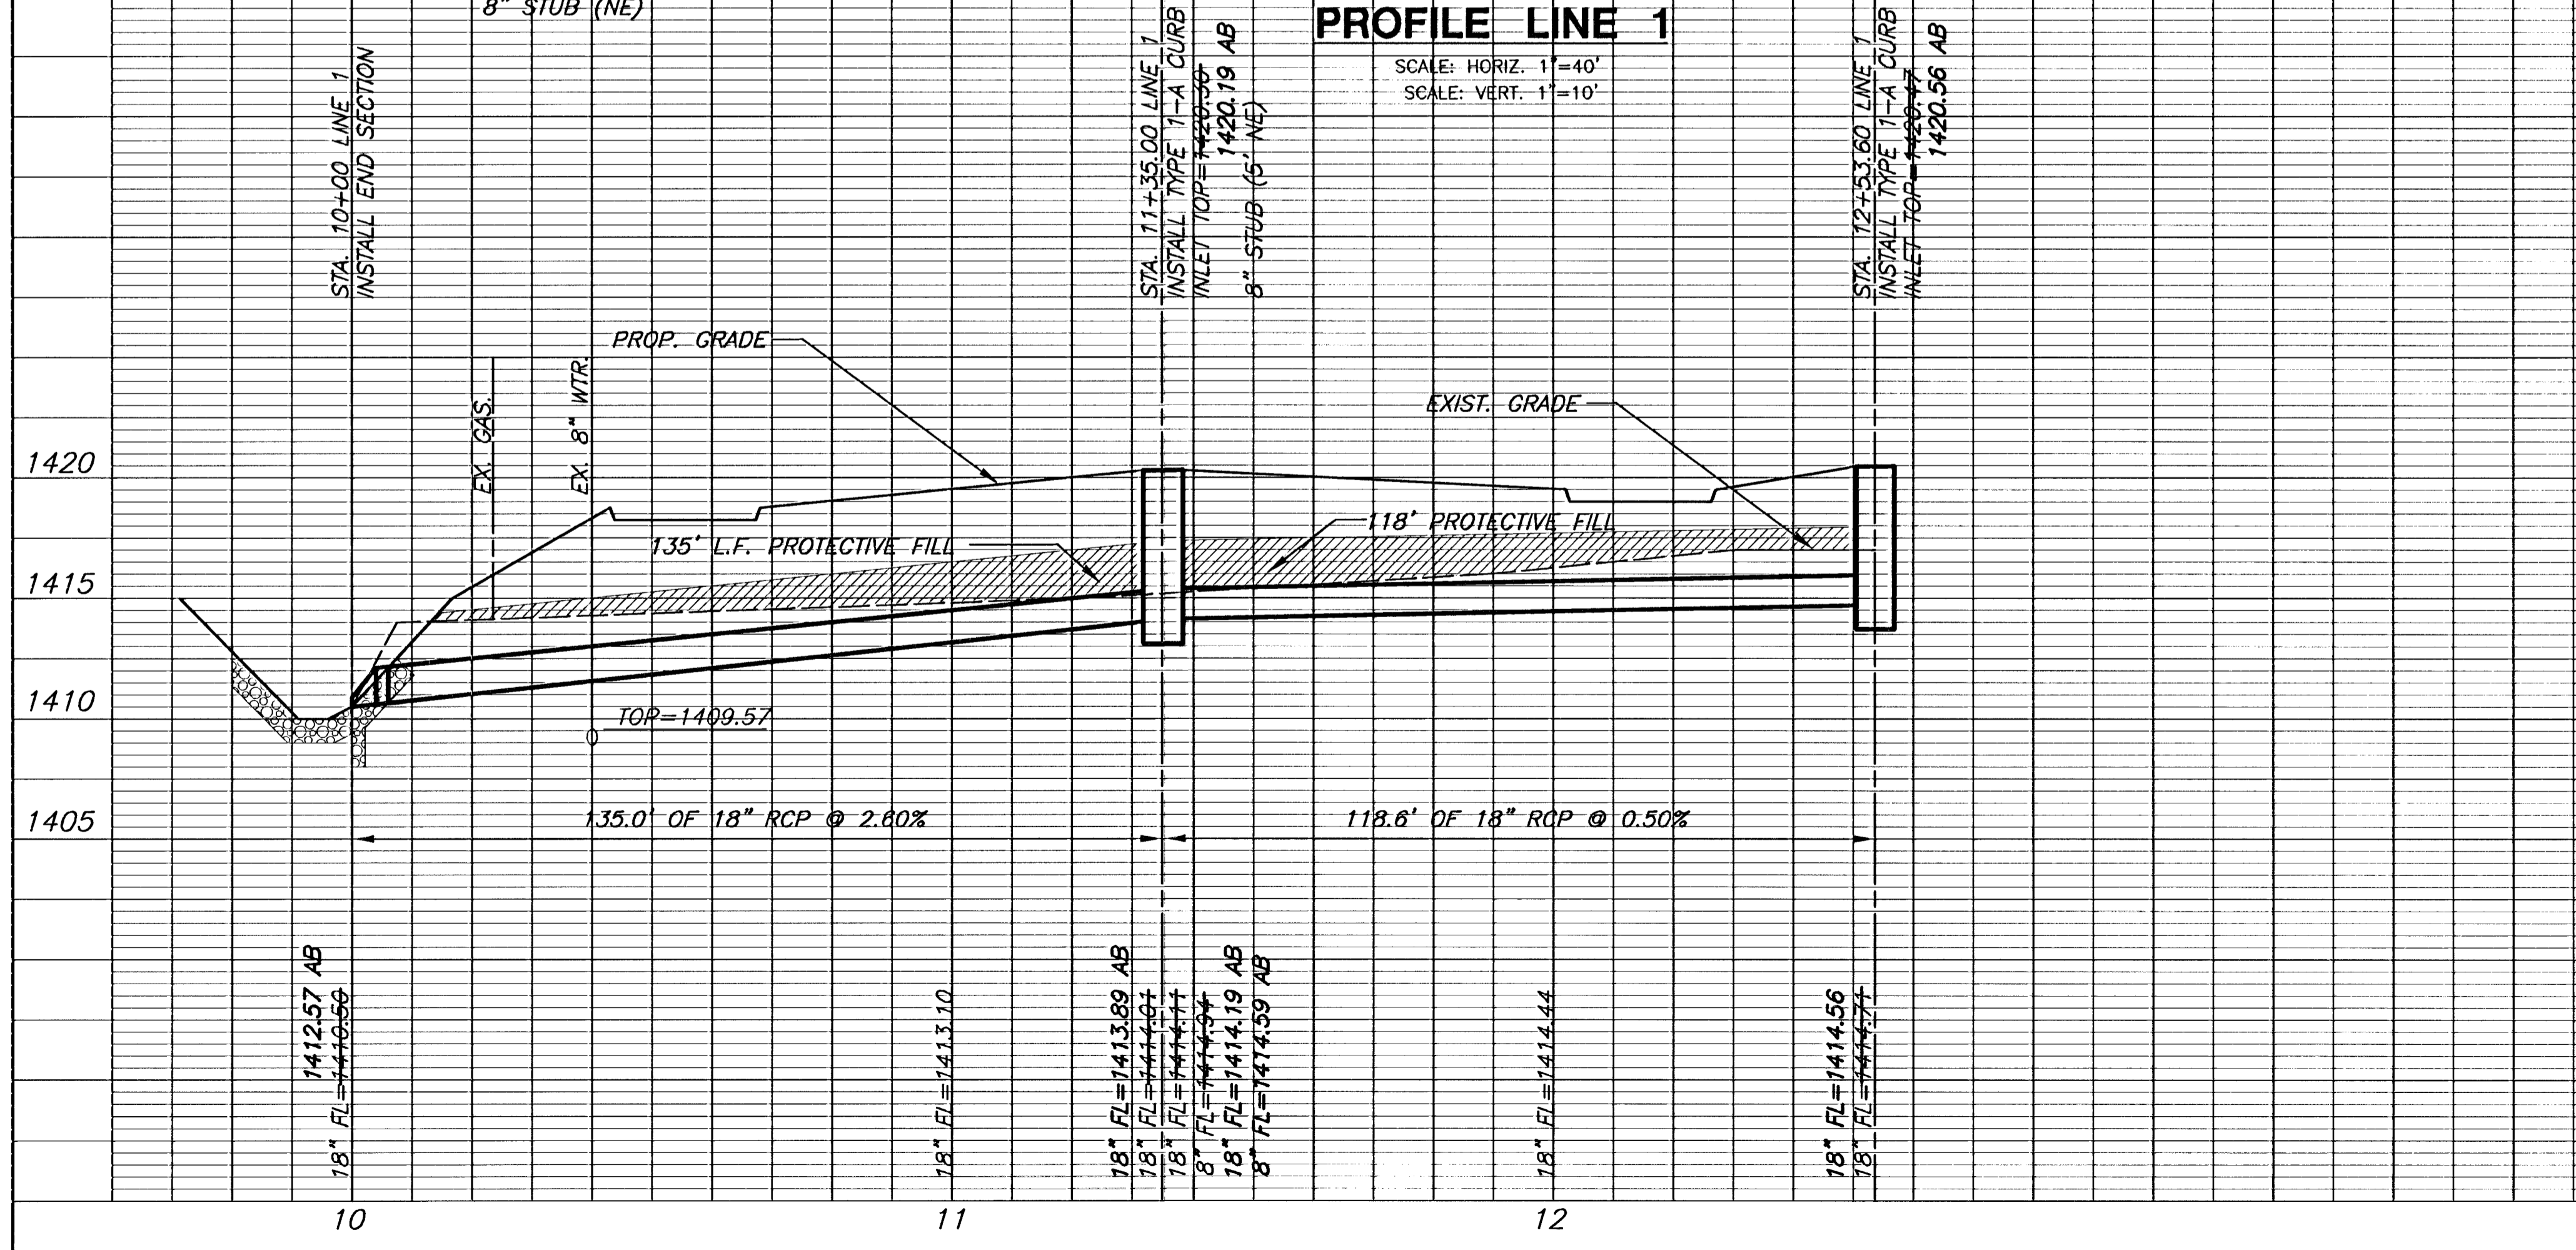
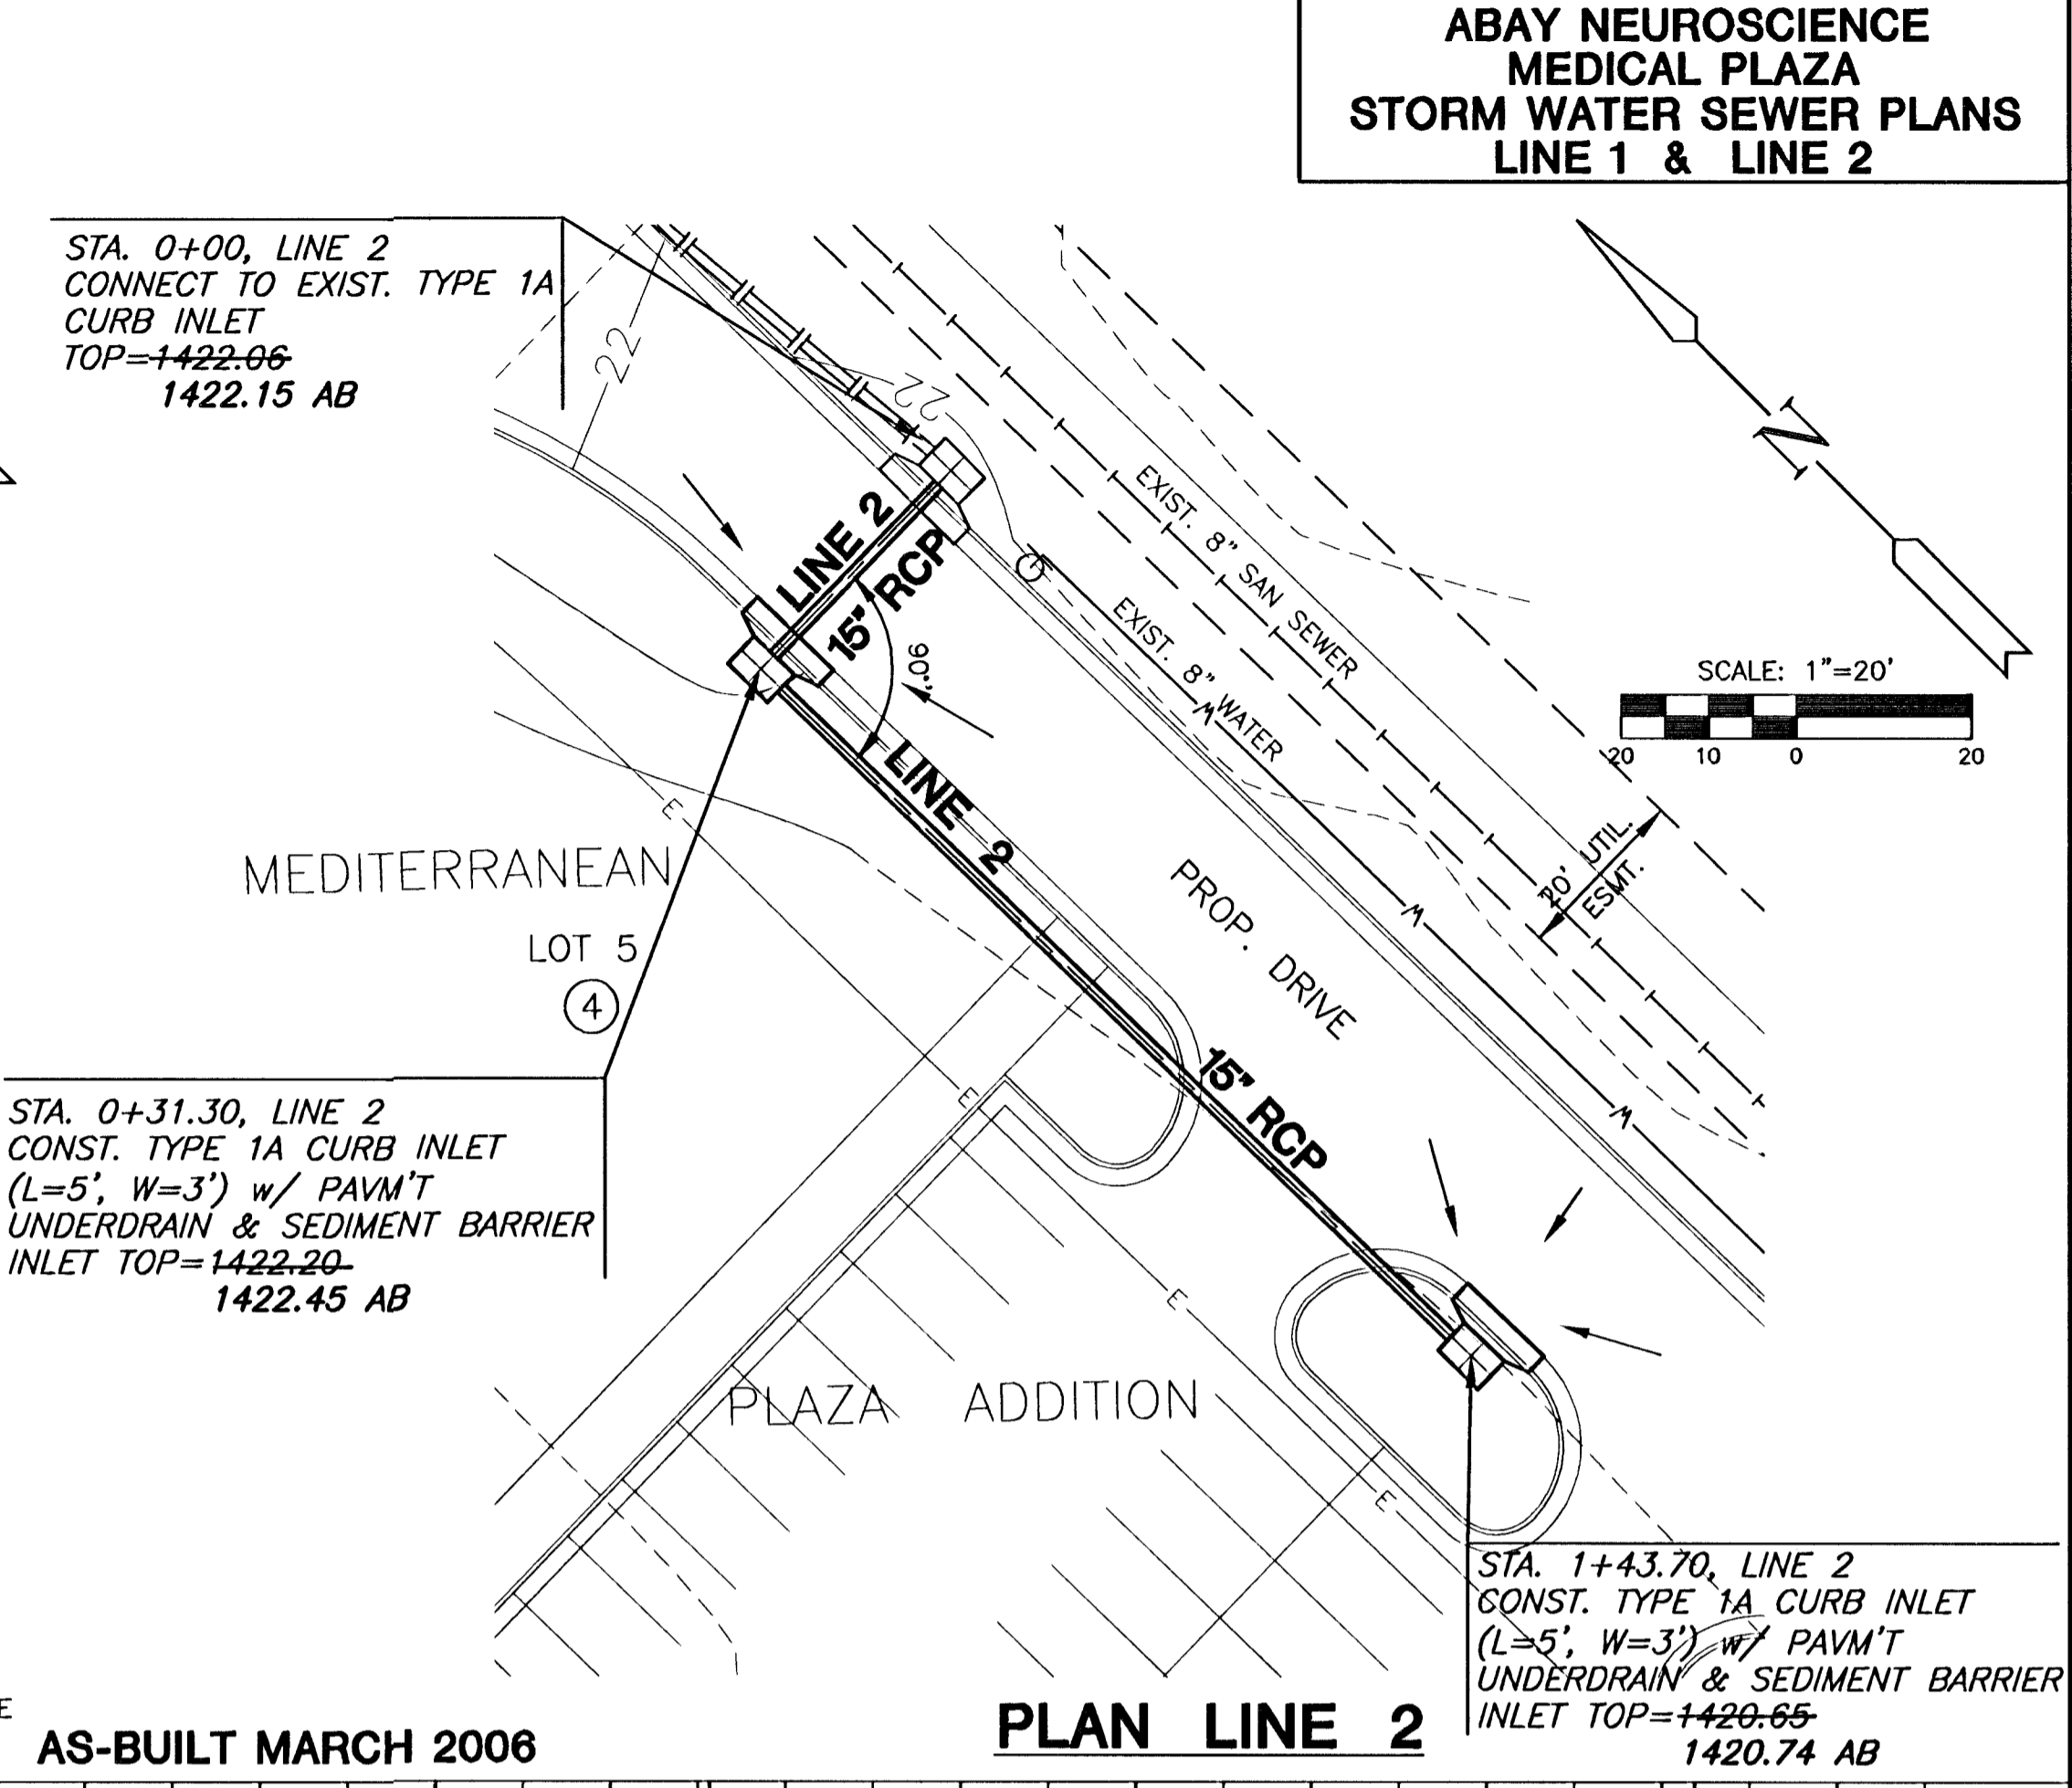


**ABAY NEUROSCIENCE
MEDICAL PLAZA
STORM WATER SEWER PLANS
LINE 1 & LINE 2**

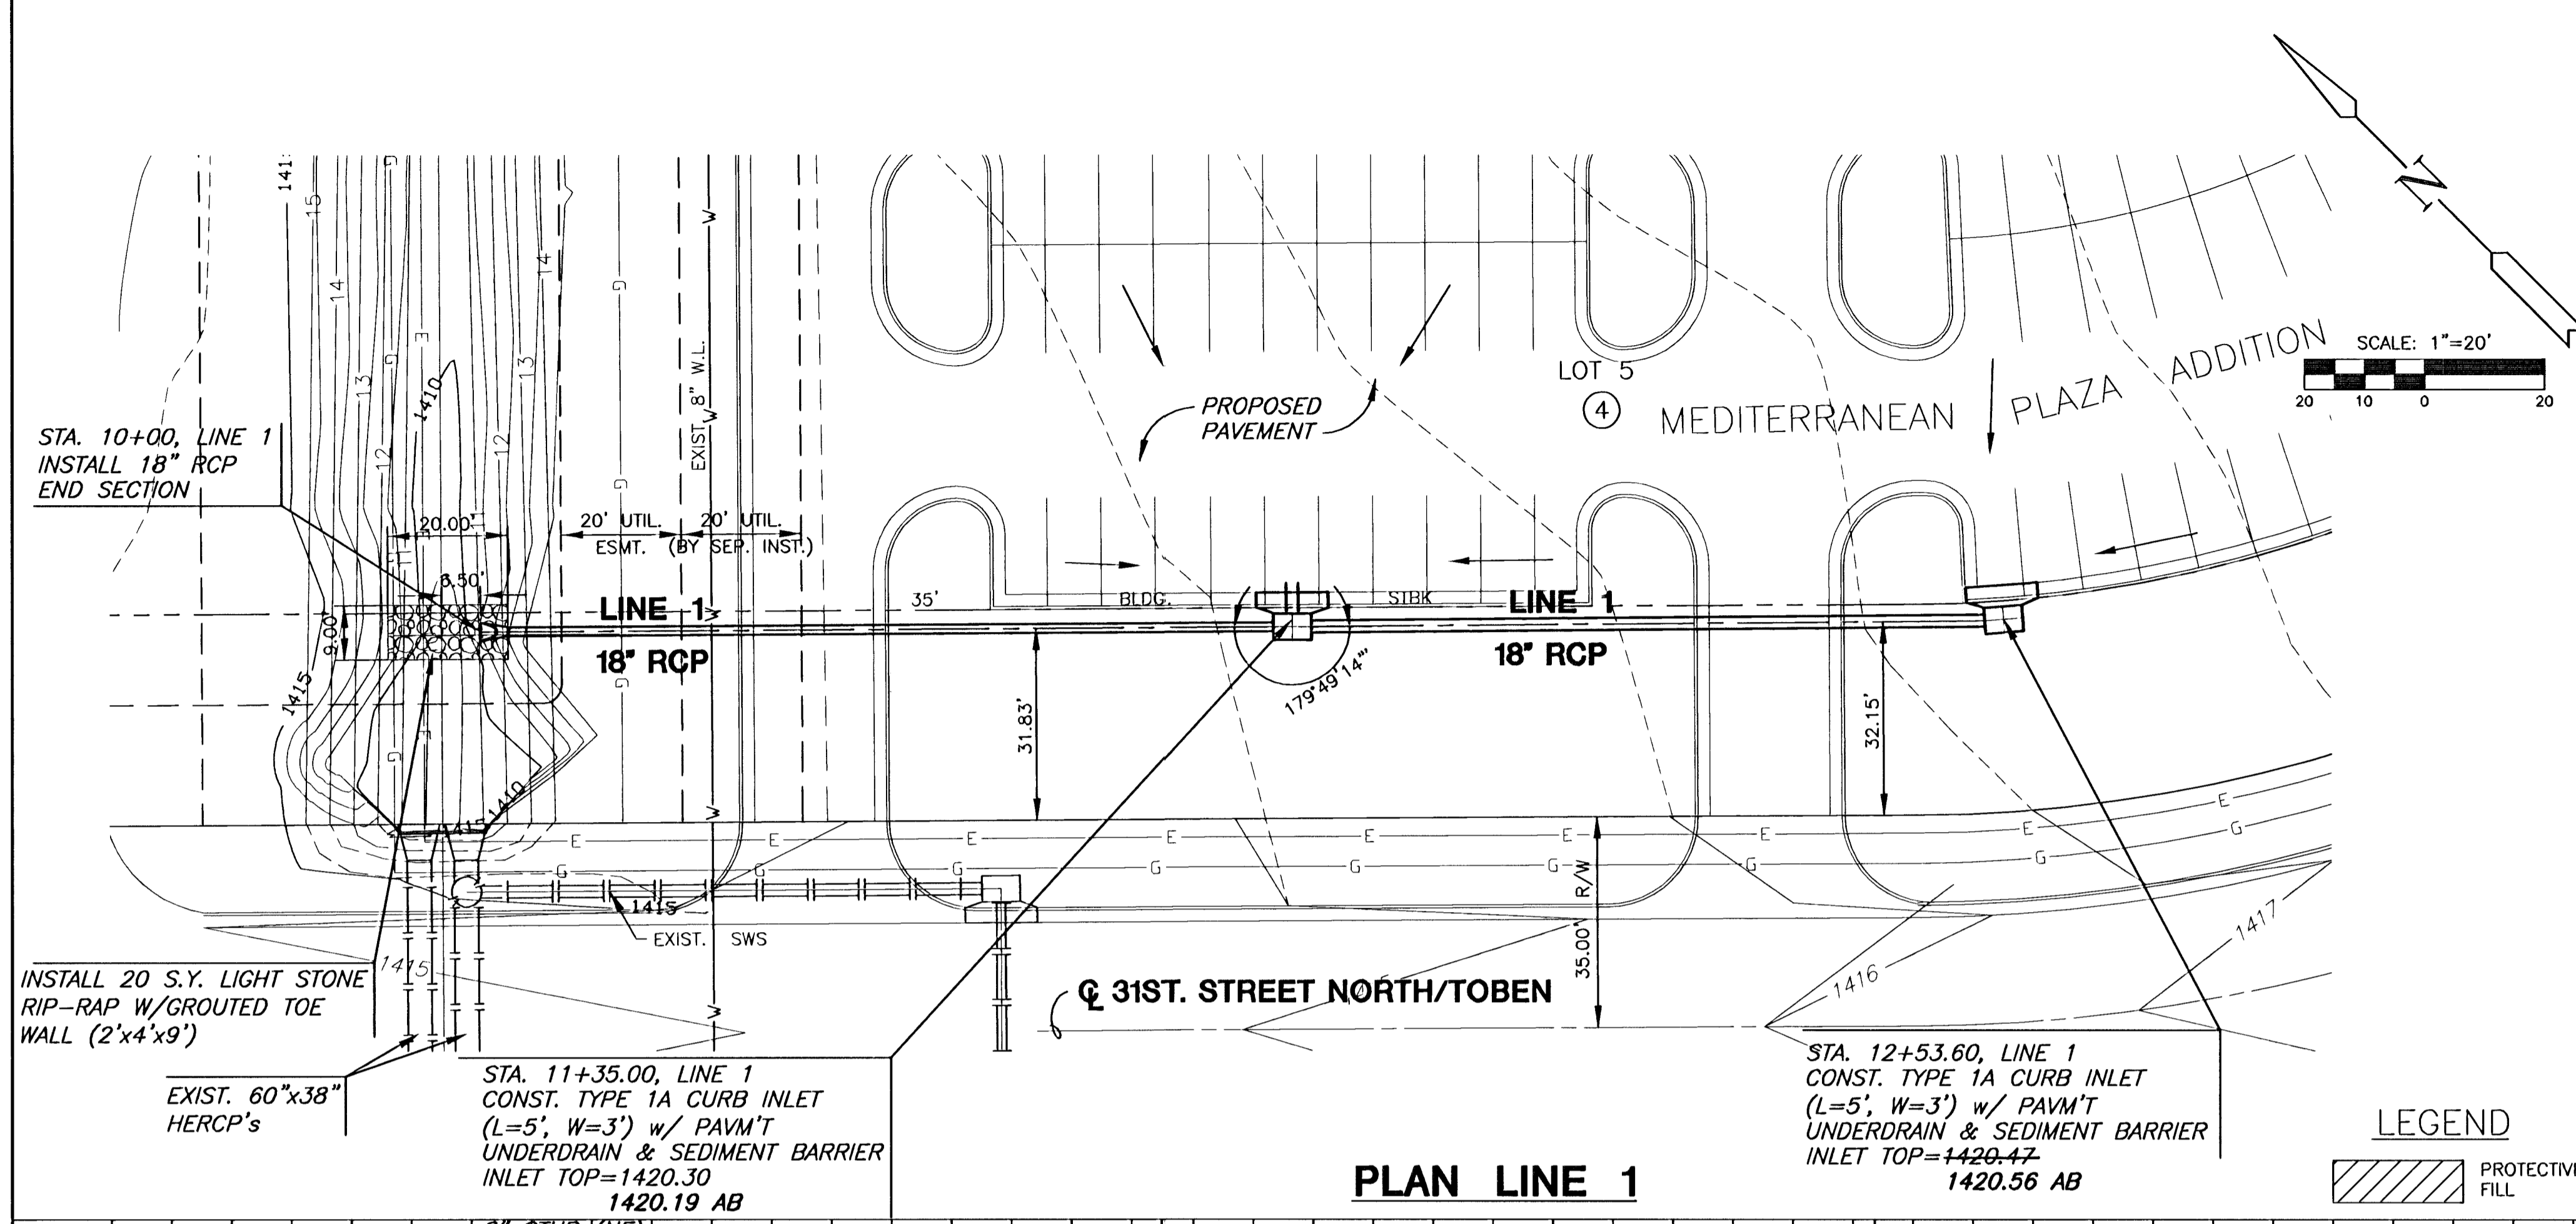

LEGEND
 PROTECTIVE FILL
AS-BUILT MARCH 2006