

Private Project Storm Water Sewer
STORM WATER SEWER IMPROVEMENTS
to serve

E.S. DEVELOPMENT MIDWEST COMMERCIAL ADDITION

CITY OF WICHITA, KANSAS

James L. Armour, P.E. City Engineer

Project Number

1702 PPS

O.C.A. Number

607861

GENERAL NOTES:

1. Contractor will be required to provide notice to utility companies a minimum of forty-eight (48) hours prior to any excavation, as follows:

Kansas One-Call 687-2470

The Contractor must notify the following in case of an emergency:

Cox Communications 262-4270
Kansas Gas Service 1-888-482-4950
Westar Energy 383-8650
Aquila Energy 1-888-482-4950
SDC 268-2243
City of Wichita Water Dept. 268-4563
City of Wichita Sewer Maint. 268-4024
City of Wichita Storm Sewer Maint. 268-4030
City of Wichita Traffic Maint. 268-4034
Conoco Pipeline Co. 1-800-231-2551

2. Underground utility service lines and overhead utility pole lines are to be adjusted as necessary by others prior to construction unless the plans specifically call for their adjustment by the Contractor or unless the plans specifically identify a utility to be adjusted by its owner during construction. Existing utilities and their location, as shown on the plans, represent the best information obtainable for design. The Contractor will be required to work around existing utilities within the right-of-way which do not conflict with proposed construction.

3. Trees and shrubs in public right-of-way which are in direct conflict with proposed new construction shall be removed by the Contractor with the Engineer's approval. Trees and shrubs which are not in direct conflict with proposed new construction shall be saved and protected from damage.


4. The Contractor shall give all property owners and/or tenants of developed property abutting the construction of this project a minimum of ten (10) days advance notice prior to start of construction.

5. The Contractor shall be responsible for preserving property irons. The Contractor will be required to re-establish any property irons which are damaged or destroyed by his construction operations. Such irons shall be re-established by a licensed land surveyor in accordance with state laws.

6. All excavation & trenching material shall be stockpiled or spread out on site as determined by the Engineer.

7. All existing and proposed erosion control measures including silt fencing, erosion control mat, straw bales, inlet barriers, and const. entrance shall be maintained throughout construction by the contractor and until project is accepted by the City of Wichita. The on-site engineer shall complete weekly reports on the status of erosion control measures. The contractor shall be required to comply with maintenance and/or replacement of erosion control measures as determined by the on-site engineer until project is accepted by City of Wichita. Maintenance and/or replacement of erosion control measures to be paid by L.S. bid item "Site Clearing & Restoration"


8. Contractor shall refer to the Storm Water Pollution Prevention Plan for required erosion control measures and coordinate with General Contractor as to installation and maintenance requirements.

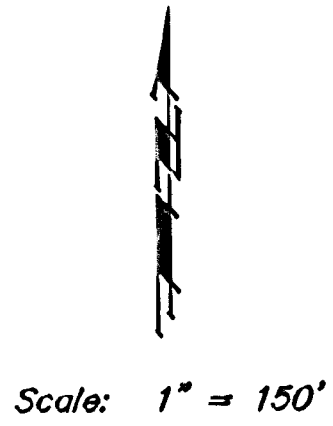


Benchmarks

CITY OF WICHITA DISC - MAIZE RD.
& STERLING, (2400 BLOCK N.), TOP
OF CURB, WEST END OF MEDIAN ON
C OF STERLING.
61' E. OF C OF MAIZE RD.
ELEV. = 1353.57 NGVD29

SMALL RAILROAD SPIKE IN E. FACE
OF POWER POLE, 34.6' S. & 8.9' W.
OF THE NW COR. OF LOT 2, BLOCK
A.
ELEV. = 1351.99 NGVD29

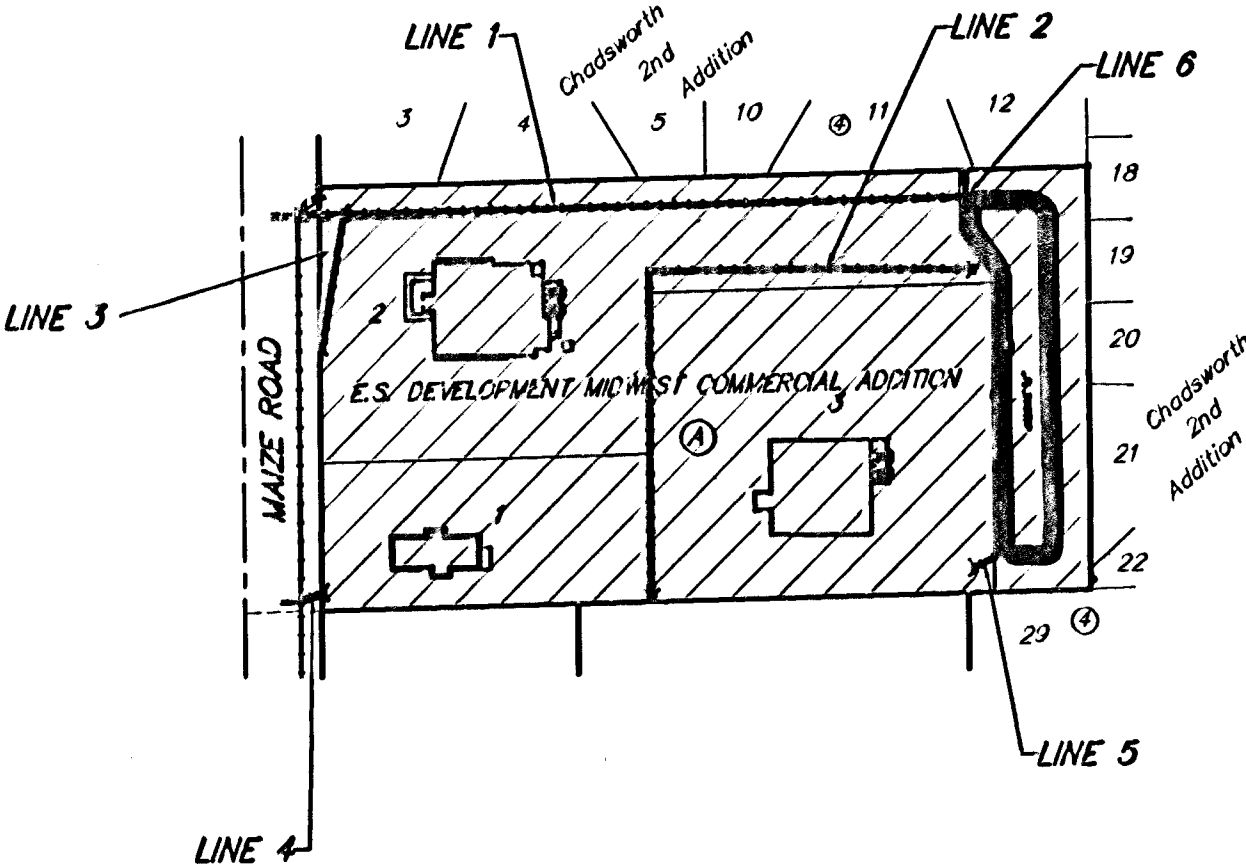

Benefit District

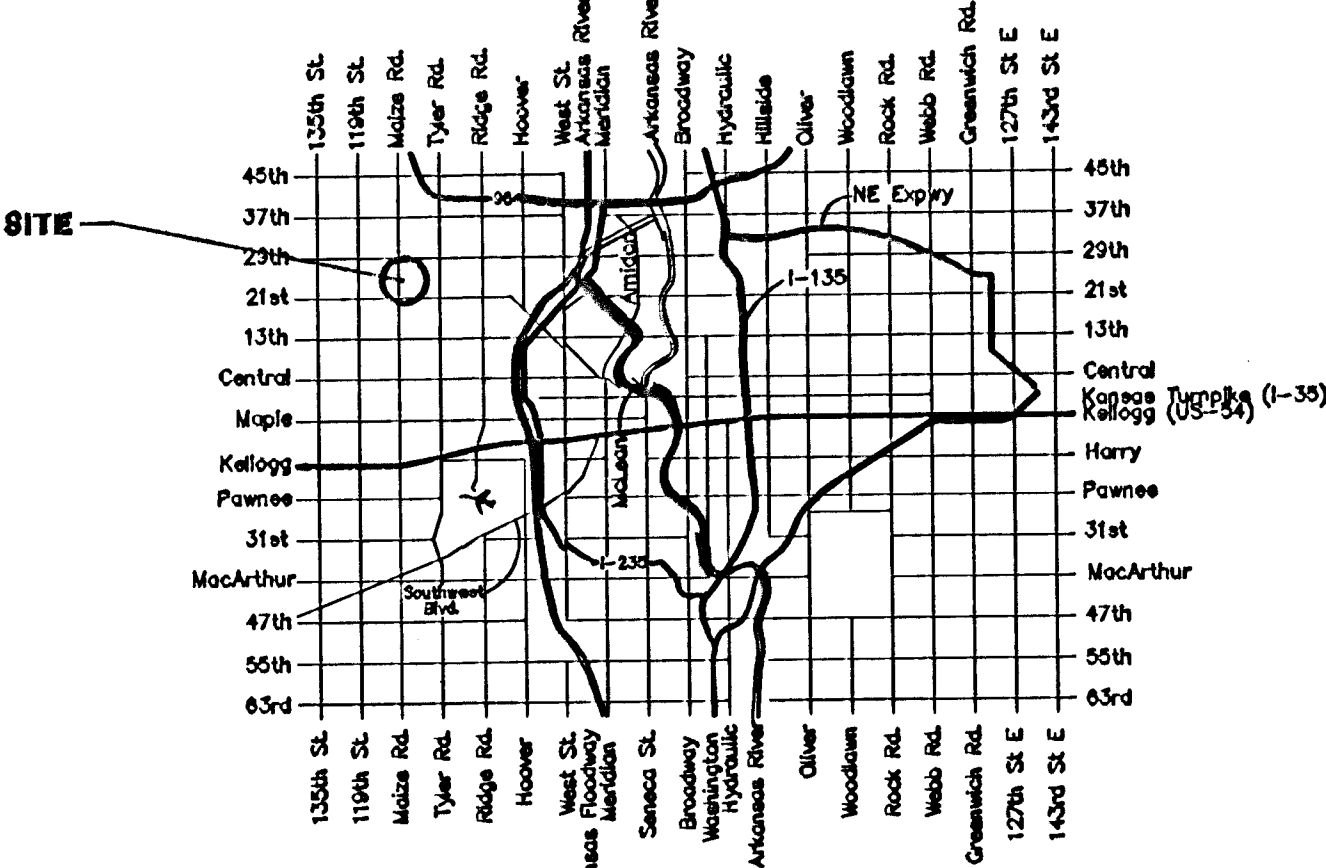

Vicinity Map


Sheet Index

Title Sheet	1
Pond Plan	2
Line 1	3
Line 2	4-5
Line 3, 4	6
Line 5, 6	7
Special Shallow Manhole Detail	8
Type 1A Curb Inlet Detail	9
Standard Drop Inlet Detail	10
Ring & Cover Detail	11
Reinforced Conc. Headwall Detail	12


APPROVED AS NOTED
BY CITY ENGINEER OF WICHITA

Sanitary Sewers _____
Storm Sewers SEE 9-20-06
Driveway Approaches _____
Water Mains _____
Paving _____

NOTE TO CONTRACTORS
Installation, inspection and testing for this project is to be provided by a Licensed Consulting Engineering firm under contract with the Owner/Developer. Said inspection is to be in accordance with the City of Wichita standard construction engineering practices and certified by a Licensed Professional Engineer. No work shall be performed in unexcused elements or public right-of-way by the Contractor without such inspection nor shall any work be commenced without written authorization by the City Engineer. All Construction and Materials shall comply with the City of Wichita Specifications and Standards (on file and available in the City Engineer's Office).

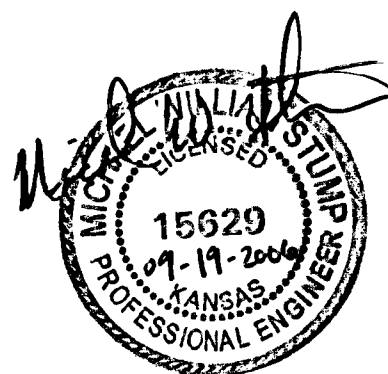

As Built Note:
All Inlets
Constructed
As Type 1 Inlets.

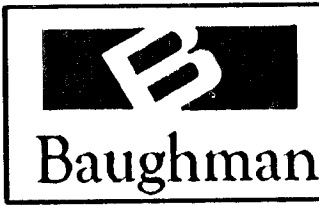

As Built 11/1/06 KH

Baughman Company, P.A. 315 Ellis St. Wichita, KS 67211 P 316 262 7271 F 316 262 0147
ENGINEERING | SURVEYING | PLANNING | LANDSCAPE ARCHITECTURE

As Built - S.W.S. for E.S. Development Midwest
Comm. Addition
1702 PPS, 9/20/06
JL