


PLAN LINE 3



PLAN LINE 4

AS-BUILT: JUNE 2004

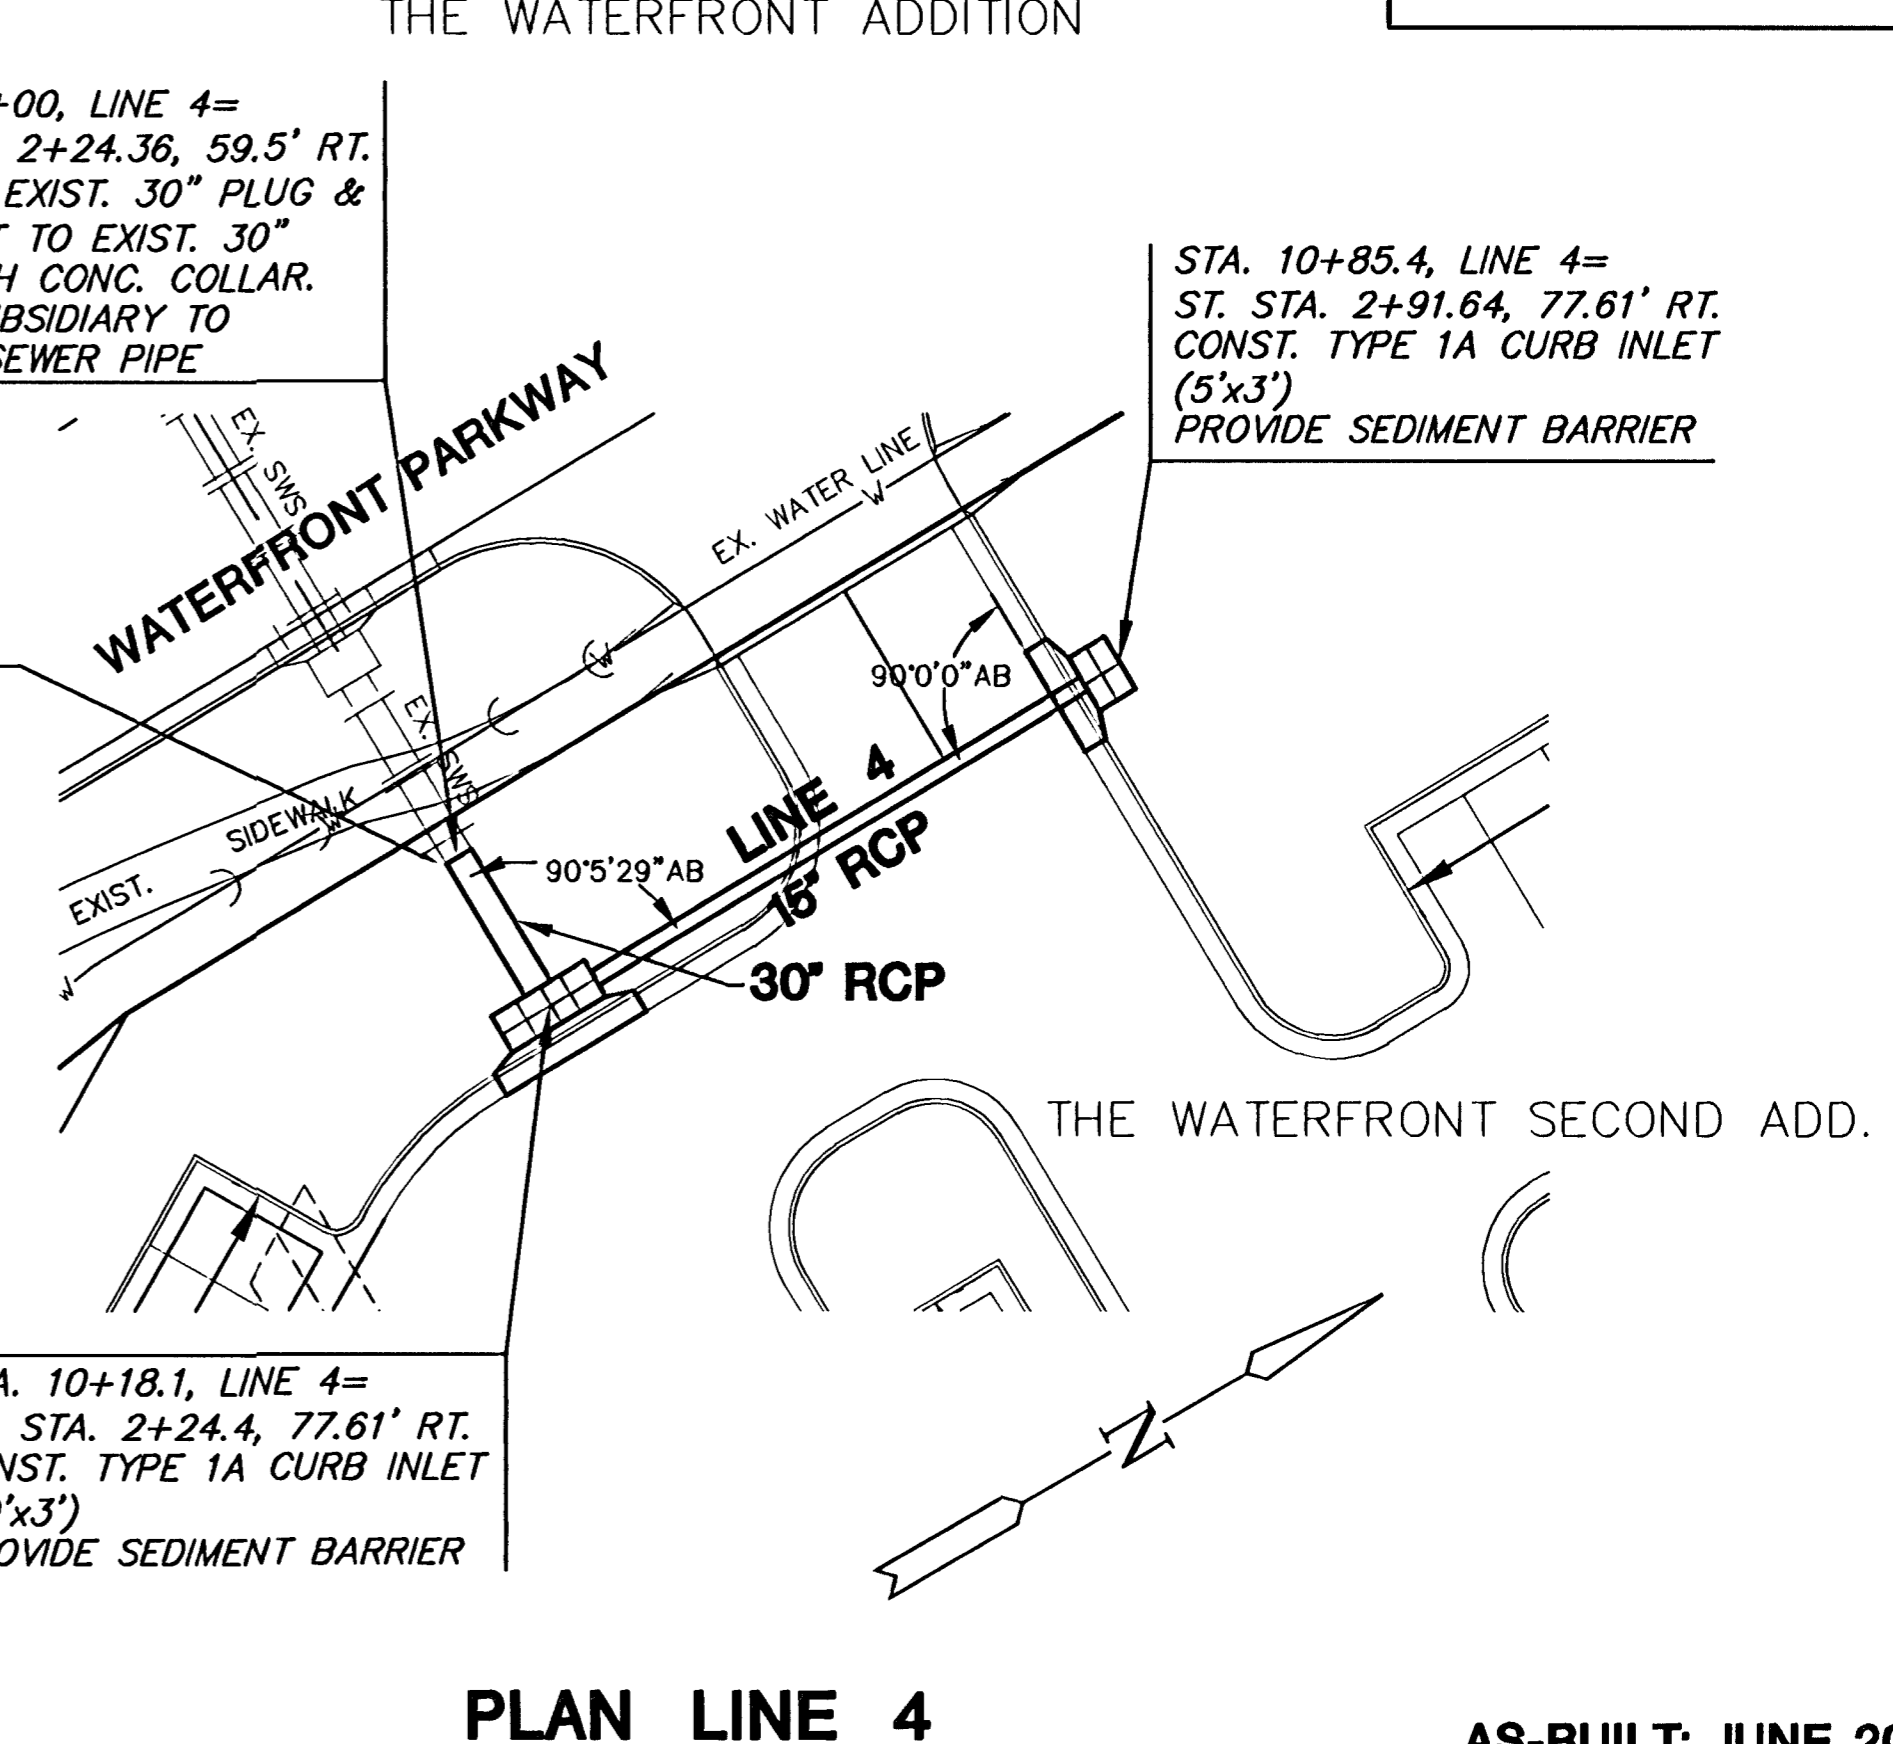