


CONTRACTOR TO VERIFY LOCATION AND ELEVATION OF EXIST. LINE PRIOR TO CONSTRUCTION.

PLAN LINE 5



AS-BUILT: JUNE 2004

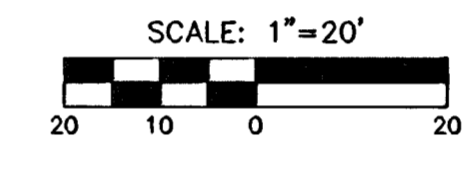