




**Bench Mark**

R.R. Spike in HLP located at the N.E. Corner Lot 30, Block 1 Bay Country. Elev. = 154.44 (City Datum)

\*□\* Cut in Top of Curb located at the N.W. Corner Lot 45, Block 1 Bay Country. Elev. = 153.87 (City Datum)

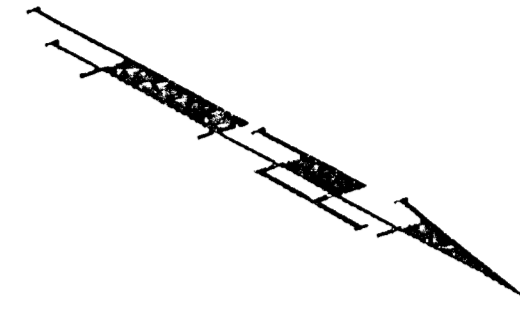

Scale: 1" = 20'-0"  
• = Iron

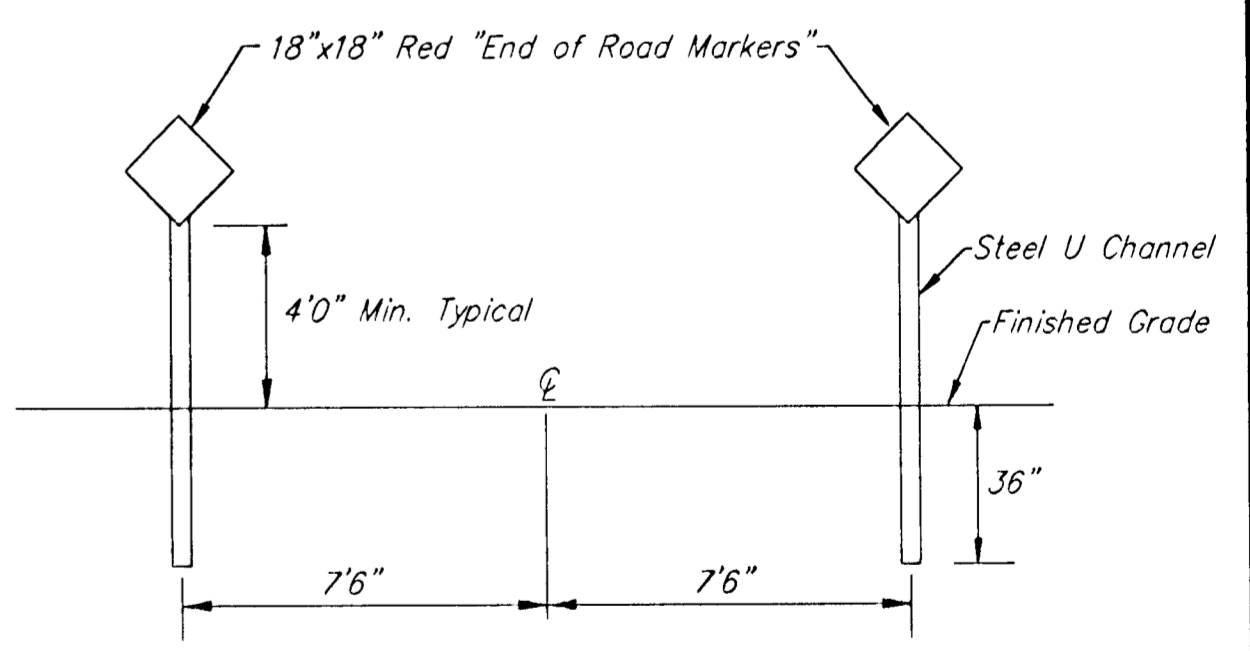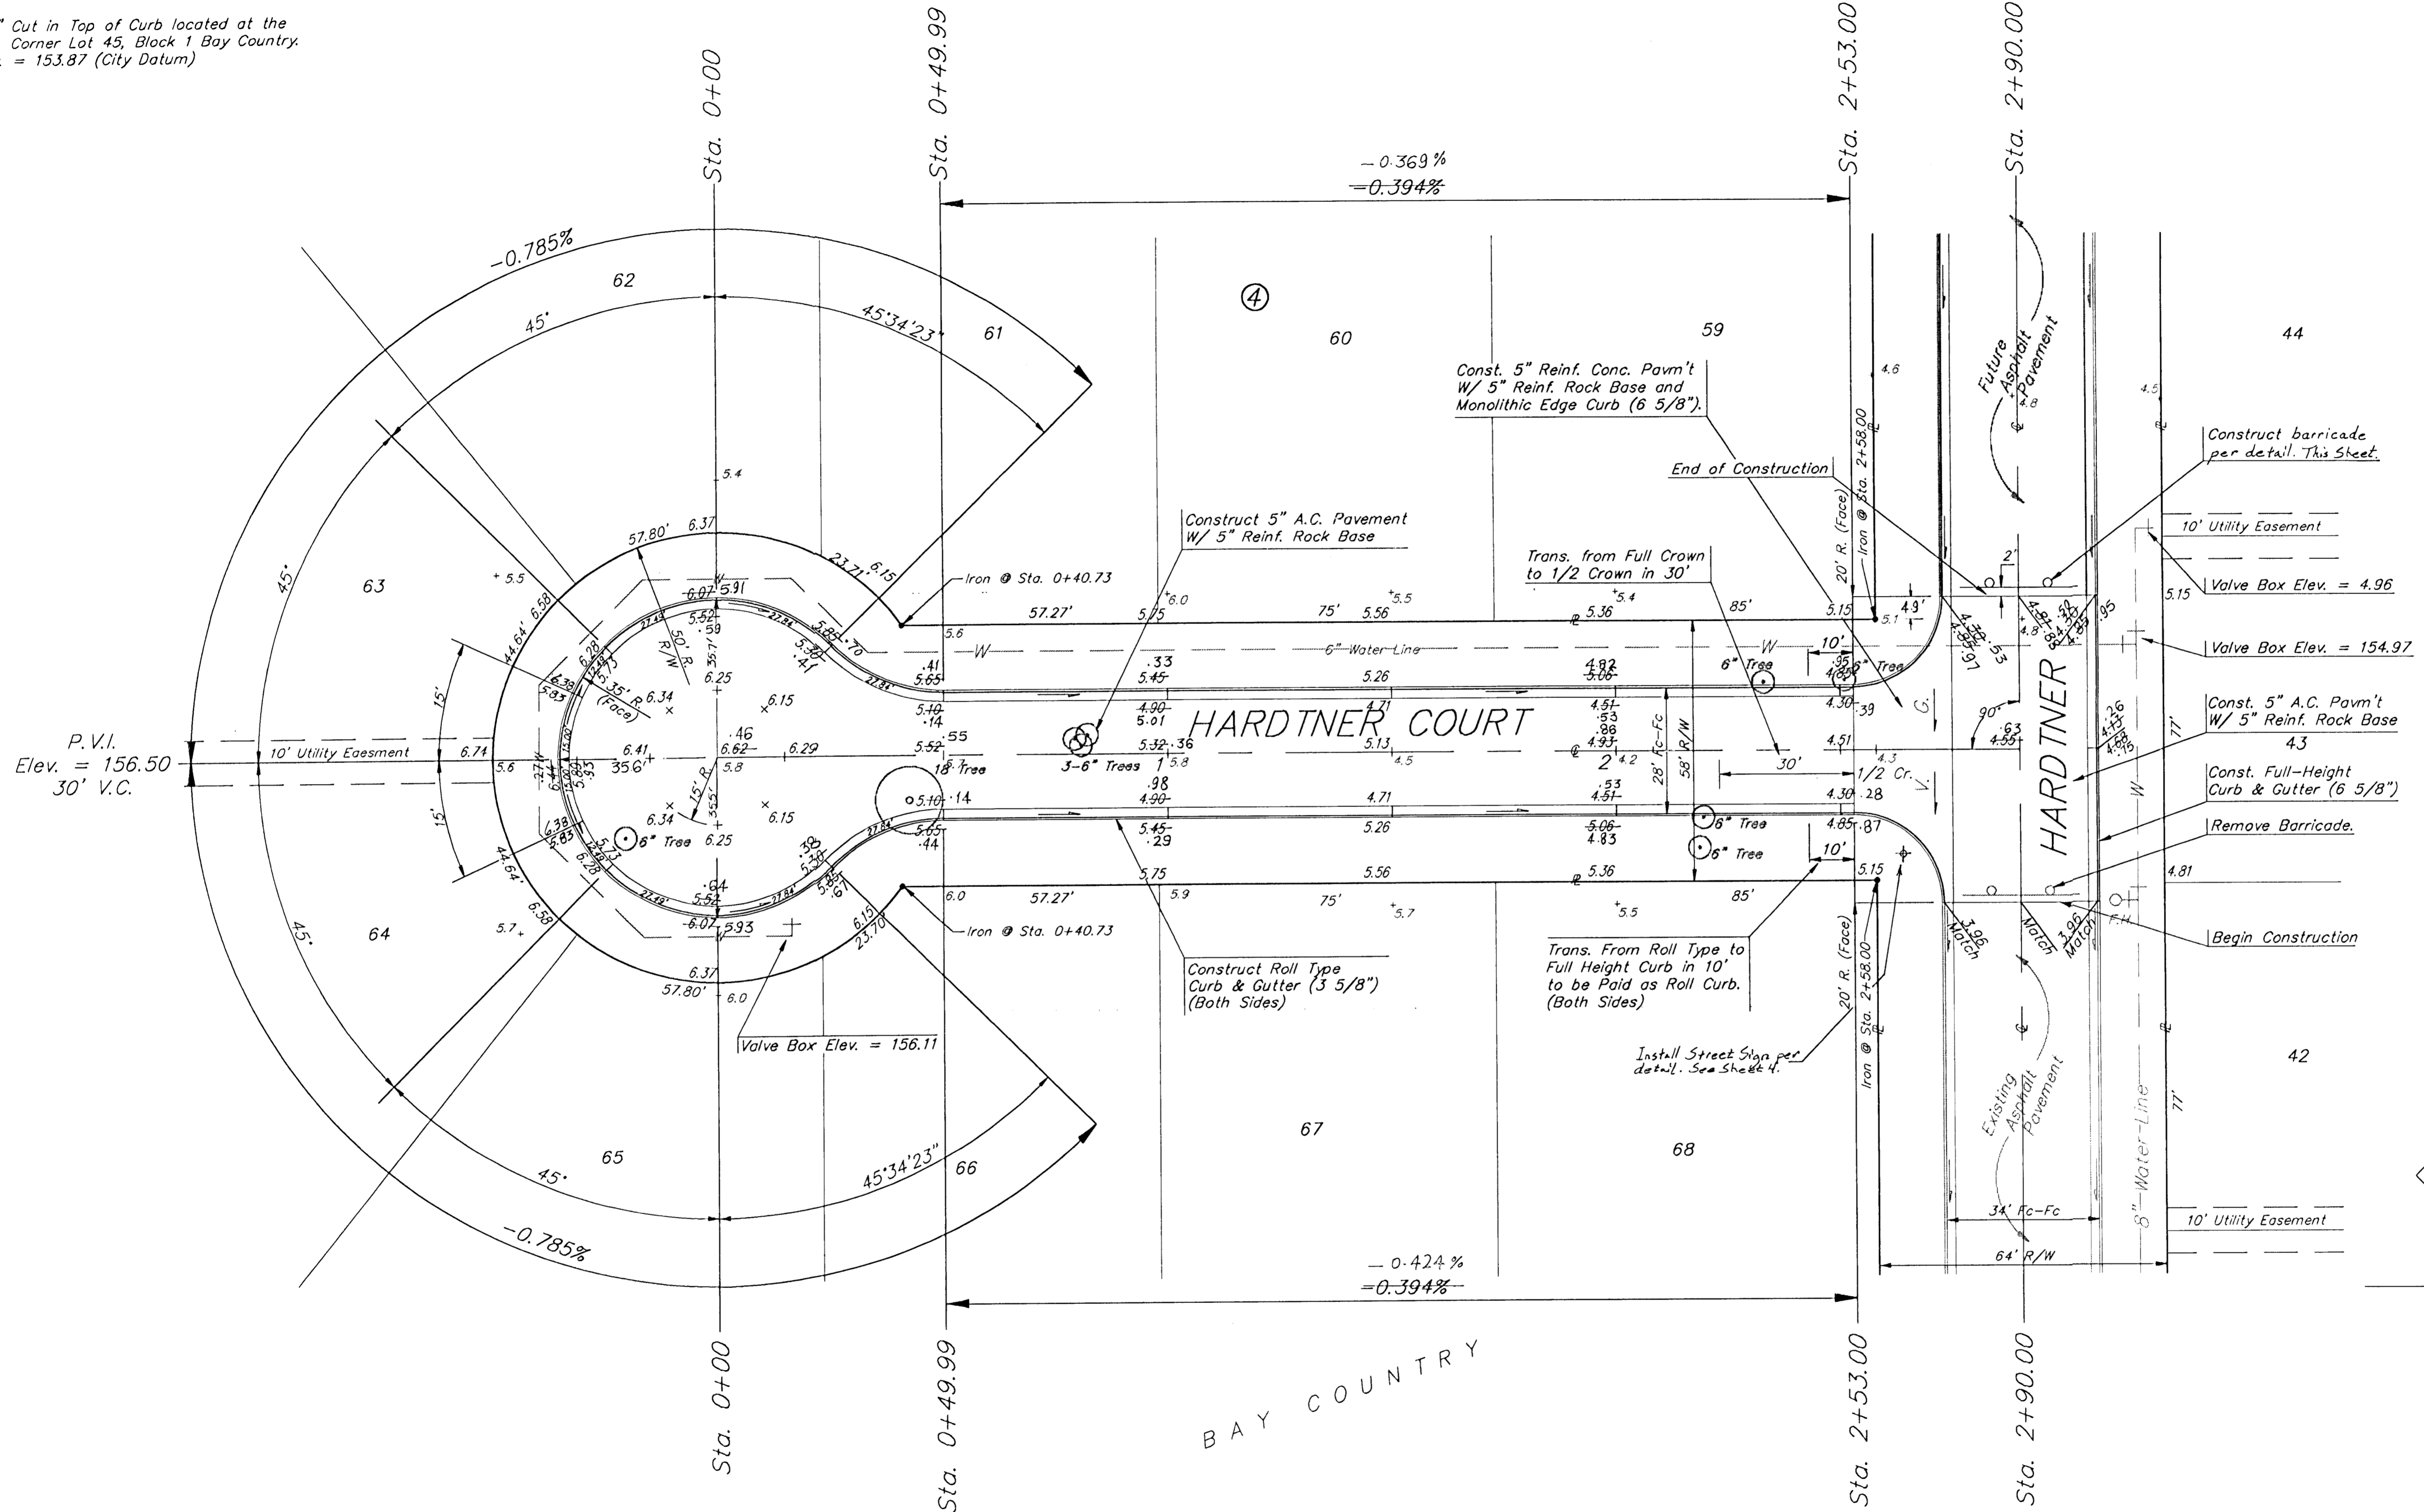

Barricade Detail  
As Built 8-20-93 A-Z.

As Built 8-20-93

<b>BAY COUNTRY - PHASE II HARDTNER COURT</b>			
<b>BAUGHMAN COMPANY P. A.</b> ENGINEERING & SURVEYING 316/262-7271 • 315 ELLIS • WICHITA, KANSAS 67211			
PROJECT NUMBER <b>077 PPP (607879)</b>			SHEET <b>3</b>
DESIGN B.P.	DRAWN M.S.P.	UTIL. CHECK'D	DATE April 1993
			SCALE 1" = 20'-0"
			OF <b>4</b>

30-02-491