
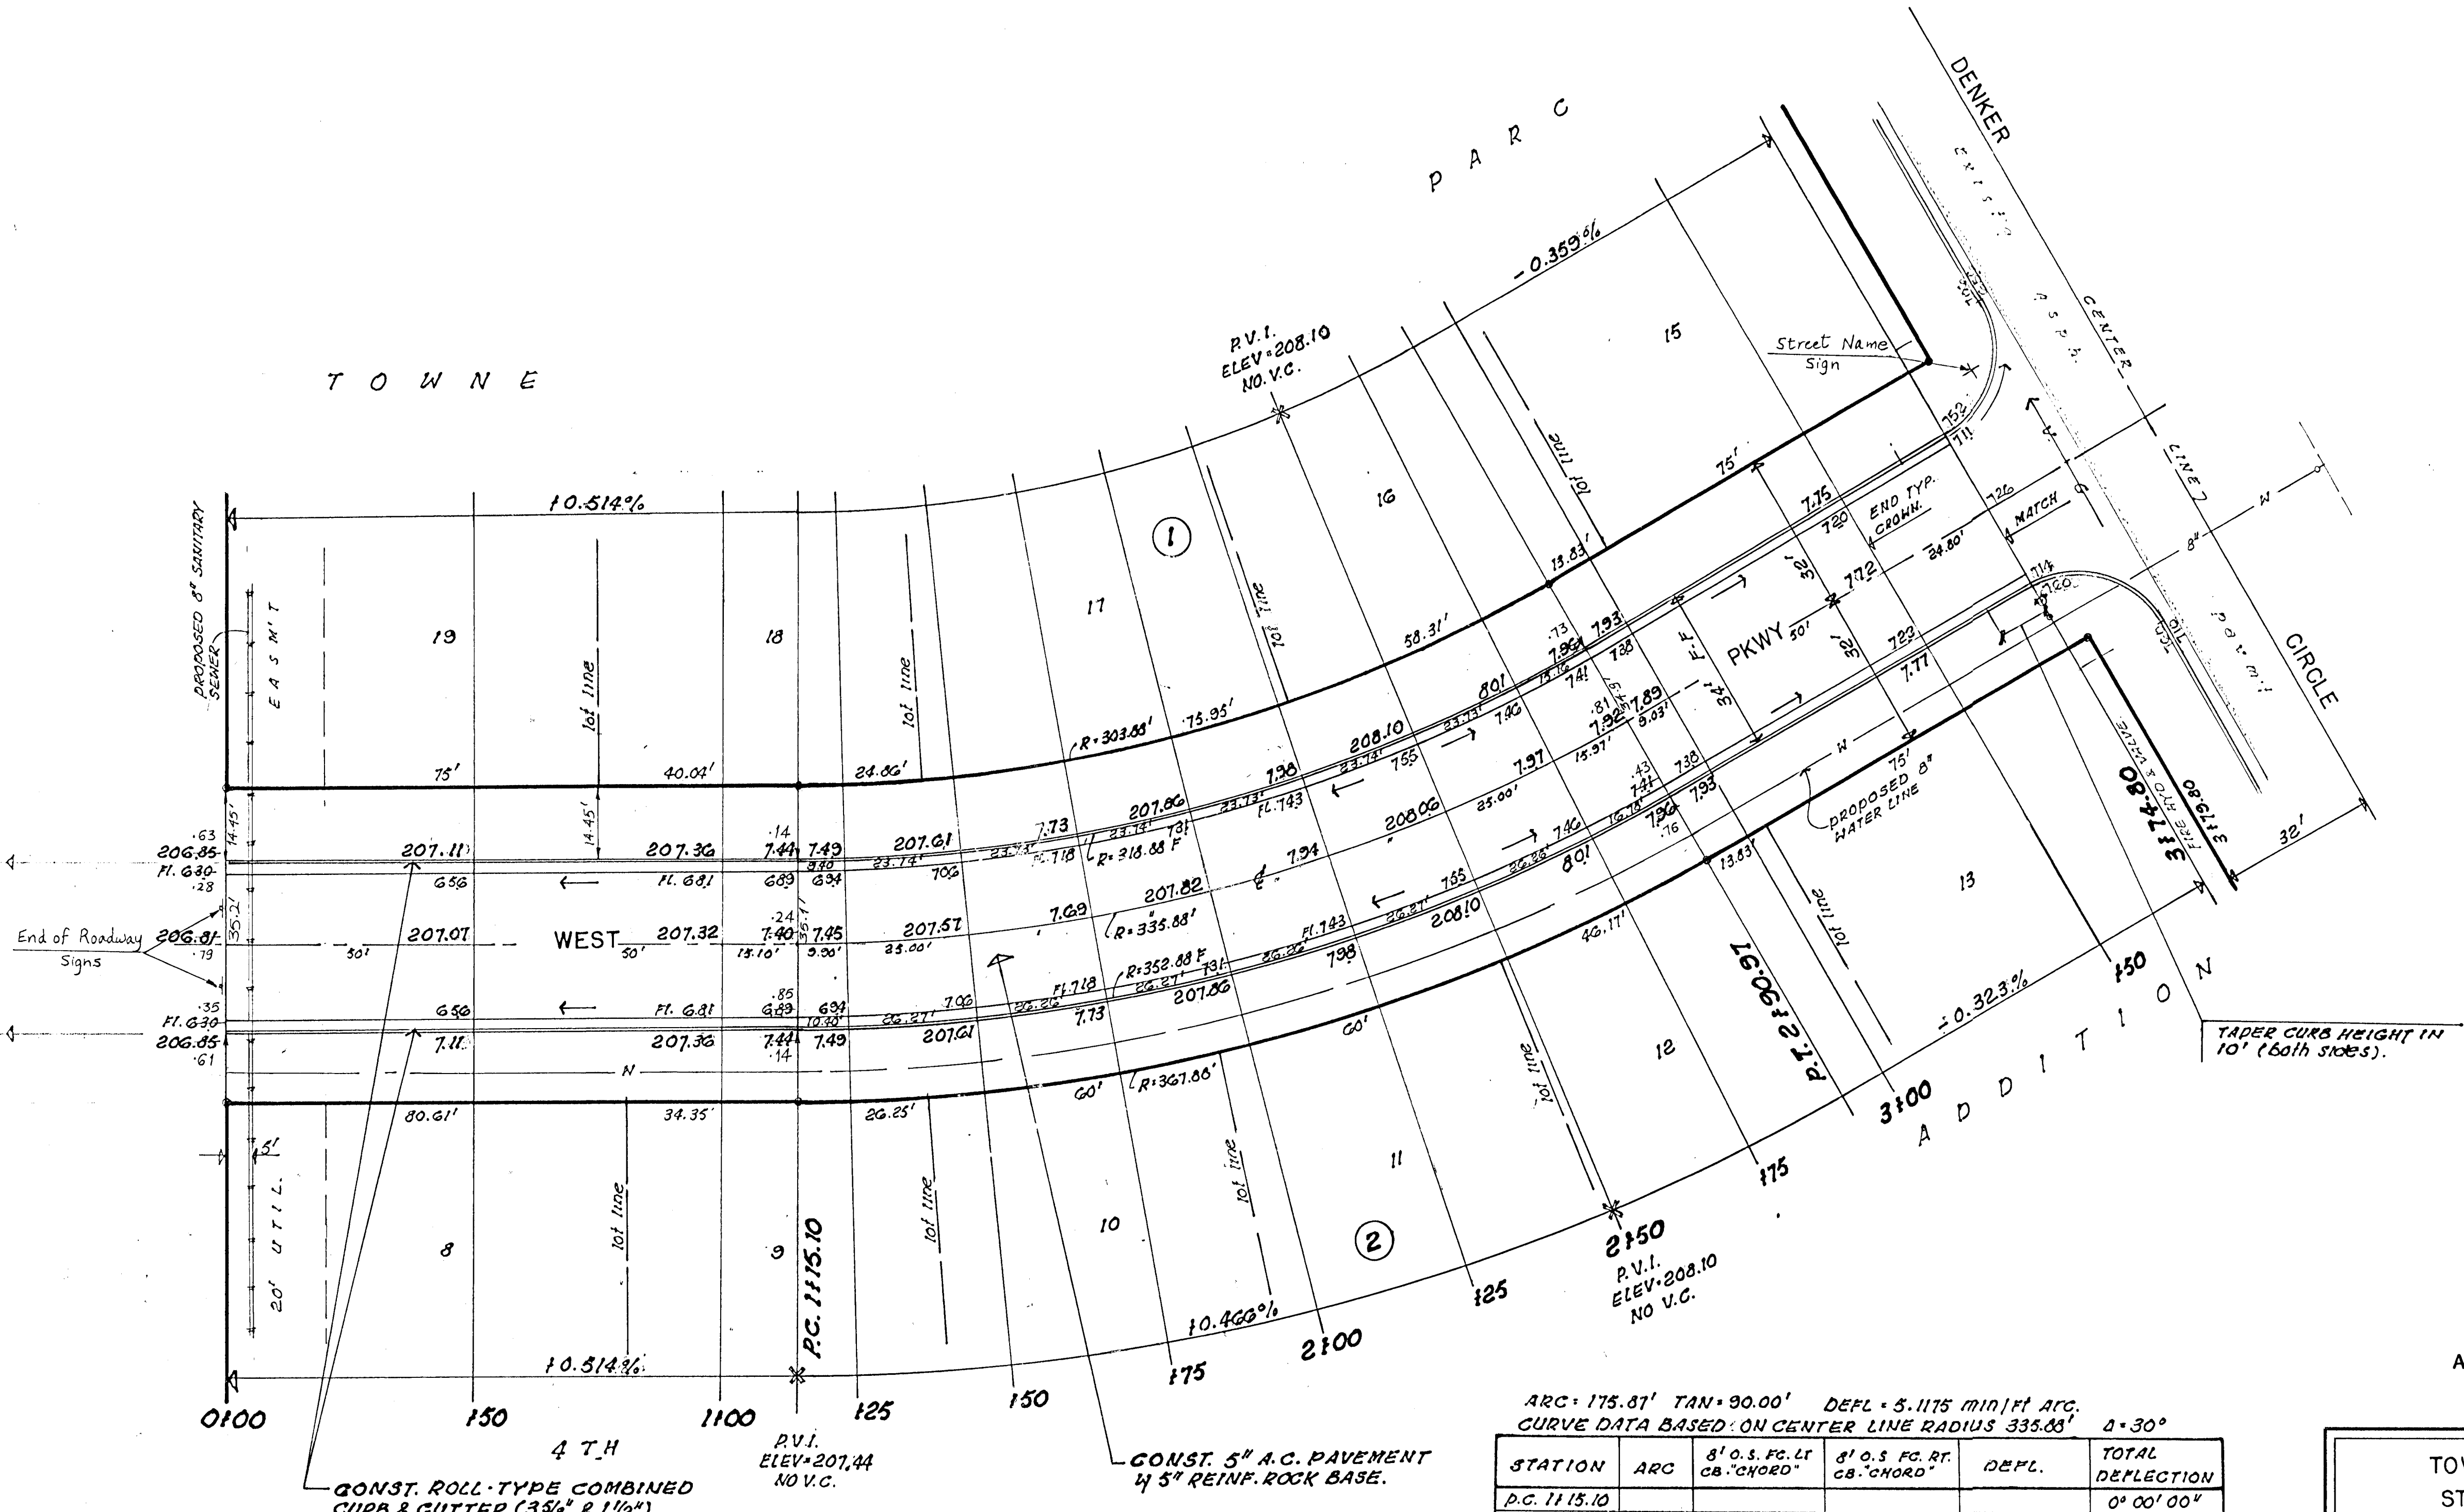


B.M. SQUARE CUT TOP OF CURB 28.1' WEST OF 1/4 SEC. LINE,
SOUTH SIDE OF HURST. ELEVATION = 211.22 CITY DATUM.

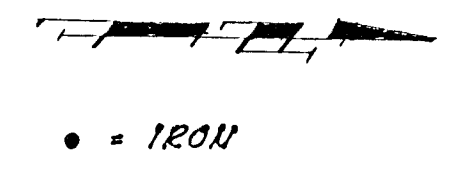

NOTE: 0.25' MUST BE SUBTRACTED FROM TOP OF CURB
ELEVATION FOR TOP OF ROLL-TYPE CURB.


EARTHWORK
EXCAVATION = 1221.6 CUBIC YDS

ARC: 175.87' TAN: 90.00' DEFL: 5.1175 MIN/100' ARC.
CURVE DATA BASED ON CENTER LINE RADIUS 335.88' Δ = 30°

STATION	ARC	8' O.S. FC. LT. CB. CHORD	8' O.S. FC. RT. CB. CHORD	DEFL.	TOTAL DEFLECTION
P.C. 1115.10					0° 00' 00"
125	9.30'	9.16'	10.63'	0° 50' 40"	0° 50' 40"
150	23.00'	23.13'	26.85'	2° 07' 56"	2° 58' 36"
175	"	"	"	"	5° 06' 32"
2100	"	"	"	"	7° 14' 28"
125	"	"	"	"	9° 22' 24"
150	"	"	"	"	11° 30' 20"
175	25.00'	23.13'	26.85'	2° 07' 56"	13° 38' 16"
P.T. 2130.97	15.97'	14.78'	17.15'	1° 21' 44"	15° 00' 00"

As Built 8-25-93
As Built 8-25-93 A.Z.

TOWNE PARC 4TH ADDITION
STREET PAVEMENT PLAN

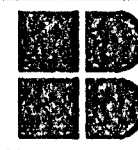 BAUGHMAN COMPANY P. A.
ENGINEERING & SURVEYING
316/262-7271 • 315 ELLIS • WICHITA, KANSAS 67211

PROJECT NUMBER
078 PPP (607879)

DESIGN
DRAWN
UTIL. CHECK'D
DATE

SCALE
1" = 20'

SHEET
3
OF
7