


WATER VALVE BOX ELEVATIONS			
STREET	STATION	OFFSET	PROPOSED ELEVATION
19TH STREET COURT	55+87	39.73' RL	210.2

PROJECT NO.	SHEET NO.	TOTAL SHEETS
472-83376	14	50

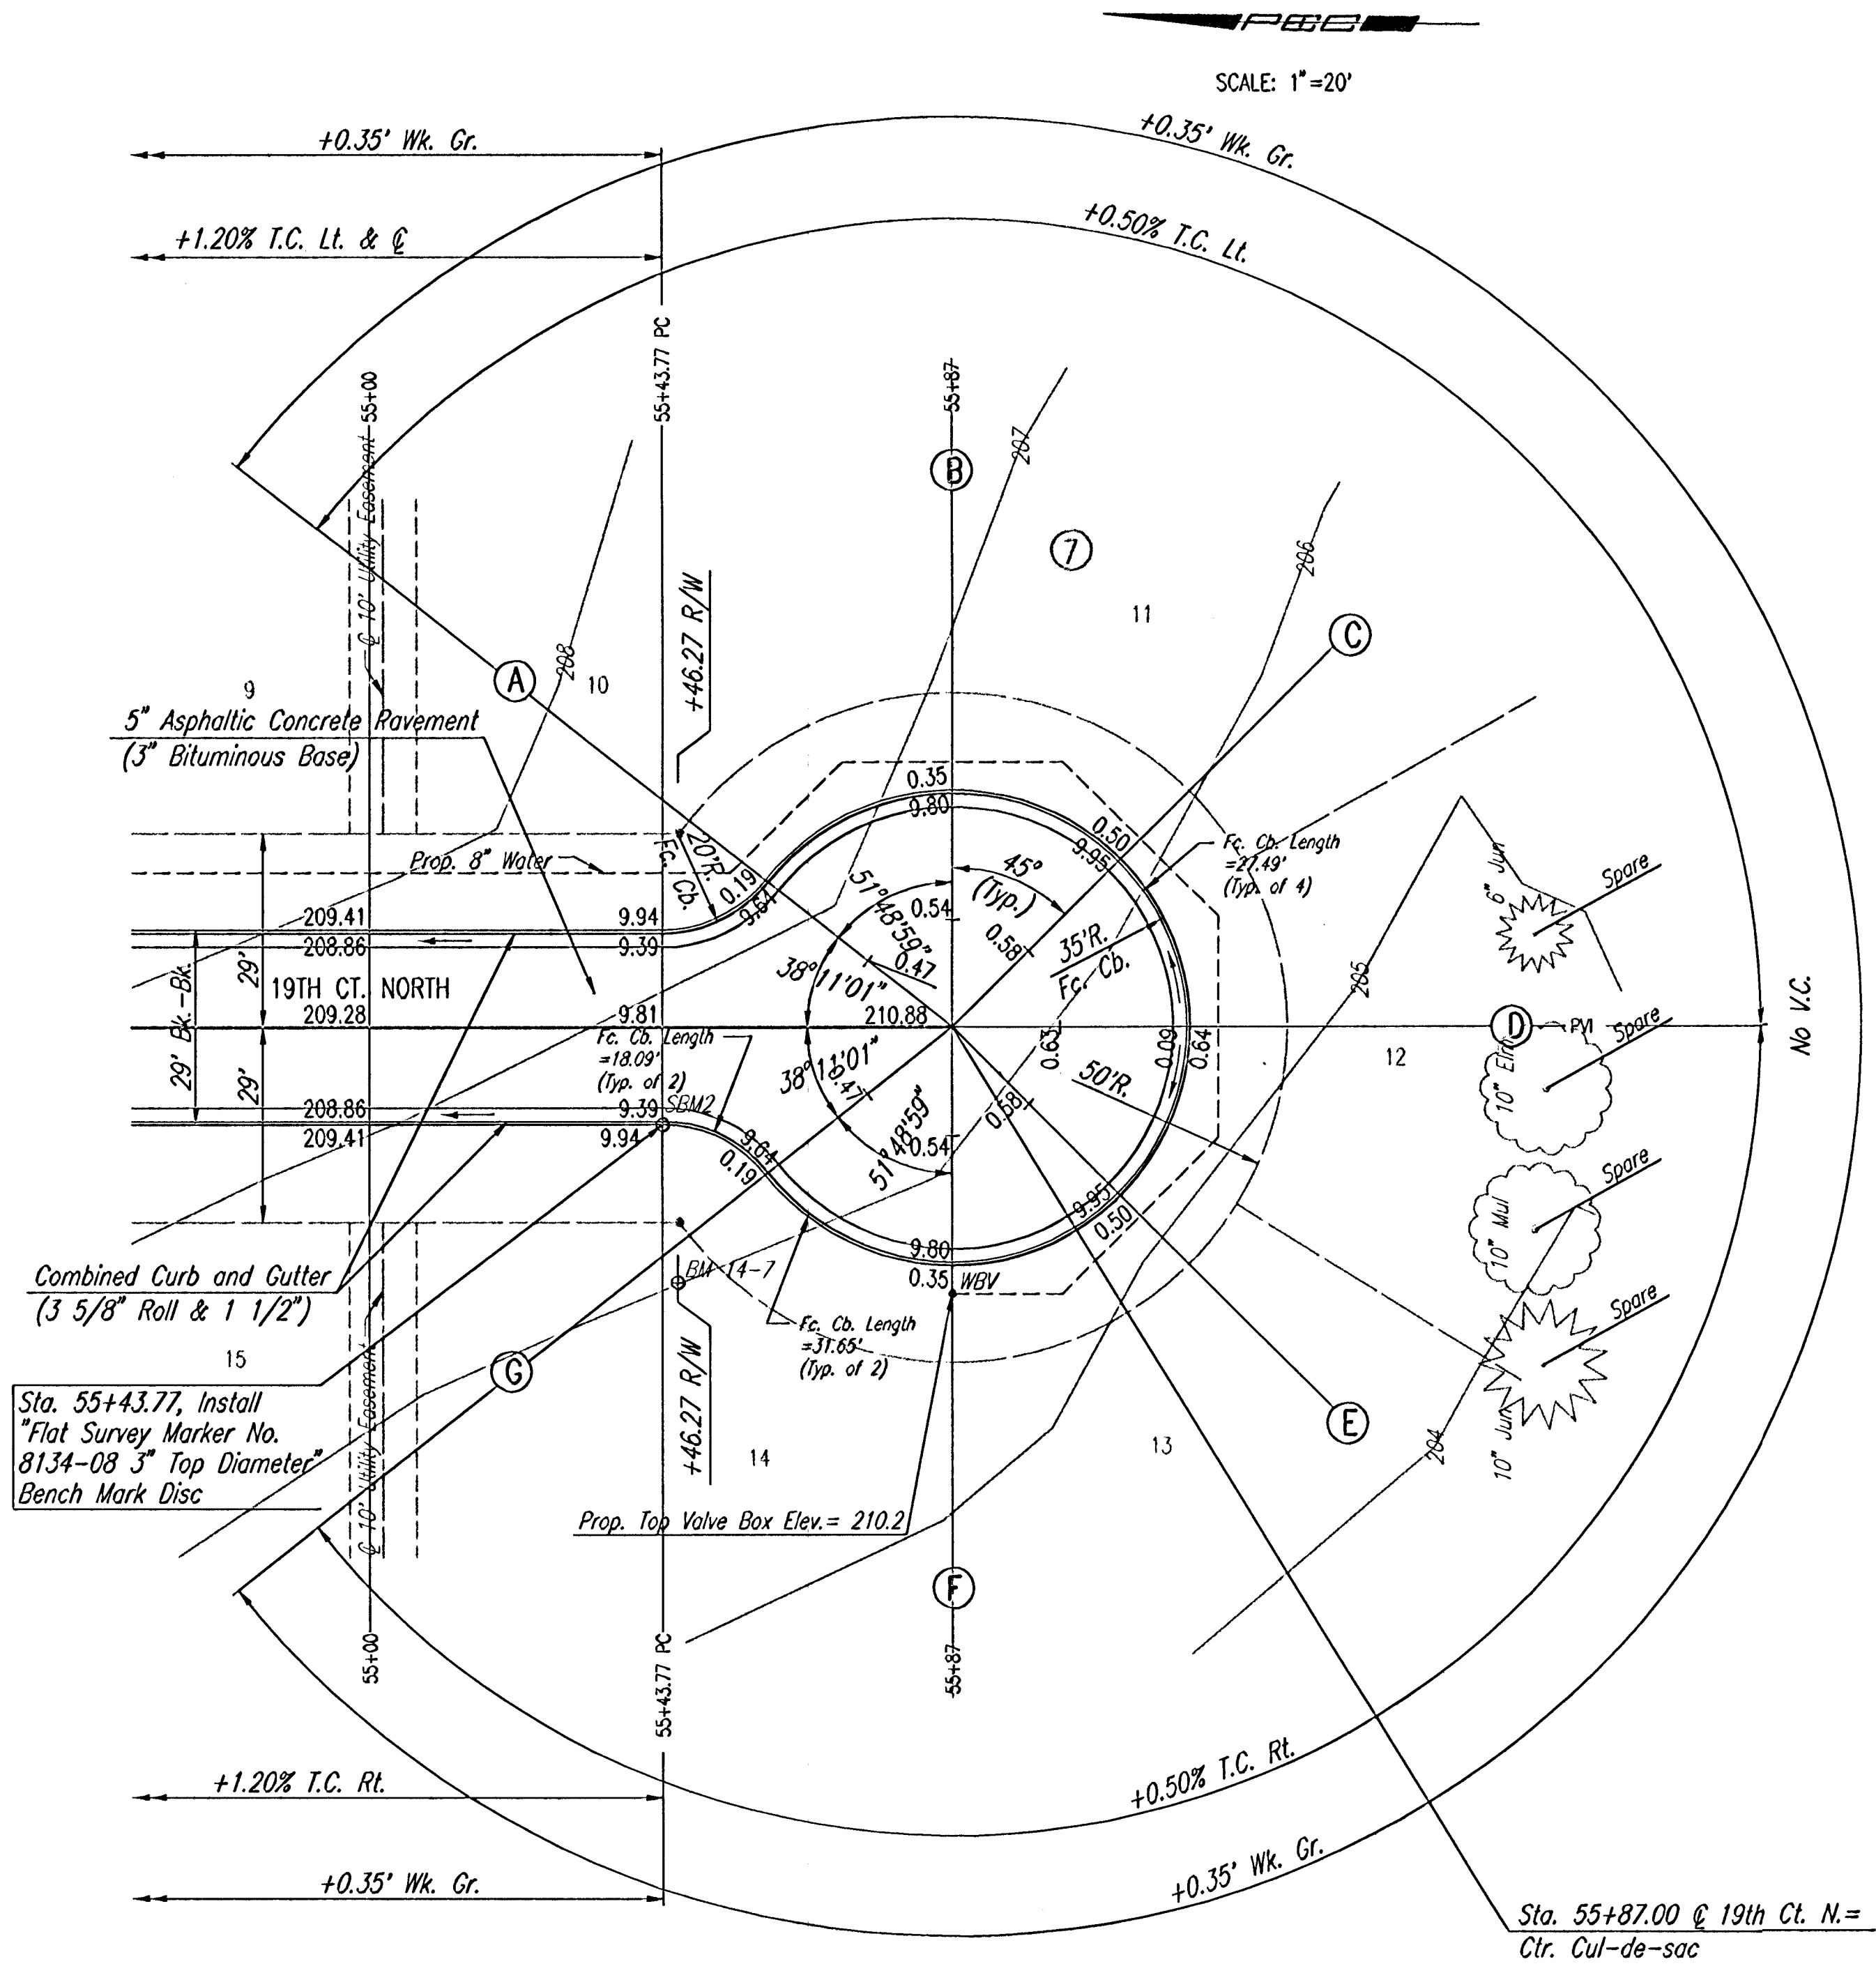

NOTE: THIS STREET TO BE CONSTRUCTED WITH ROLL-TYPE CURB. TOP OF CURB ELEVATIONS GIVEN ARE FOR FULL HEIGHT CURB.

RECORD DRAWING

24 NOV 03

REMINTON PLACE - PHASE 2

19TH COURT NORTH
STA. 55+00.00 TO STA. 55+87.00



Professional Engineering Consultants, P.A.
303 S. TOPEKA • WICHITA, KANSAS 67202
316-262-2691 • FAX 316-262-3003

Designed by	BER	Checked by	
Drawn by	DEP	Date: DEC, 2002	Job No. 02398