


PROJECT NO.	SHEET NO.	TOTAL SHEETS
472-83376	15	50

WATER VALVE BOX ELEVATIONS			
STREET	STATION	OFFSET	PROPOSED ELEVATION
CHURCHILL	45+21.72	20.0' RL	213.5
CHURCHILL	45+24.72	23.0' RL	213.5

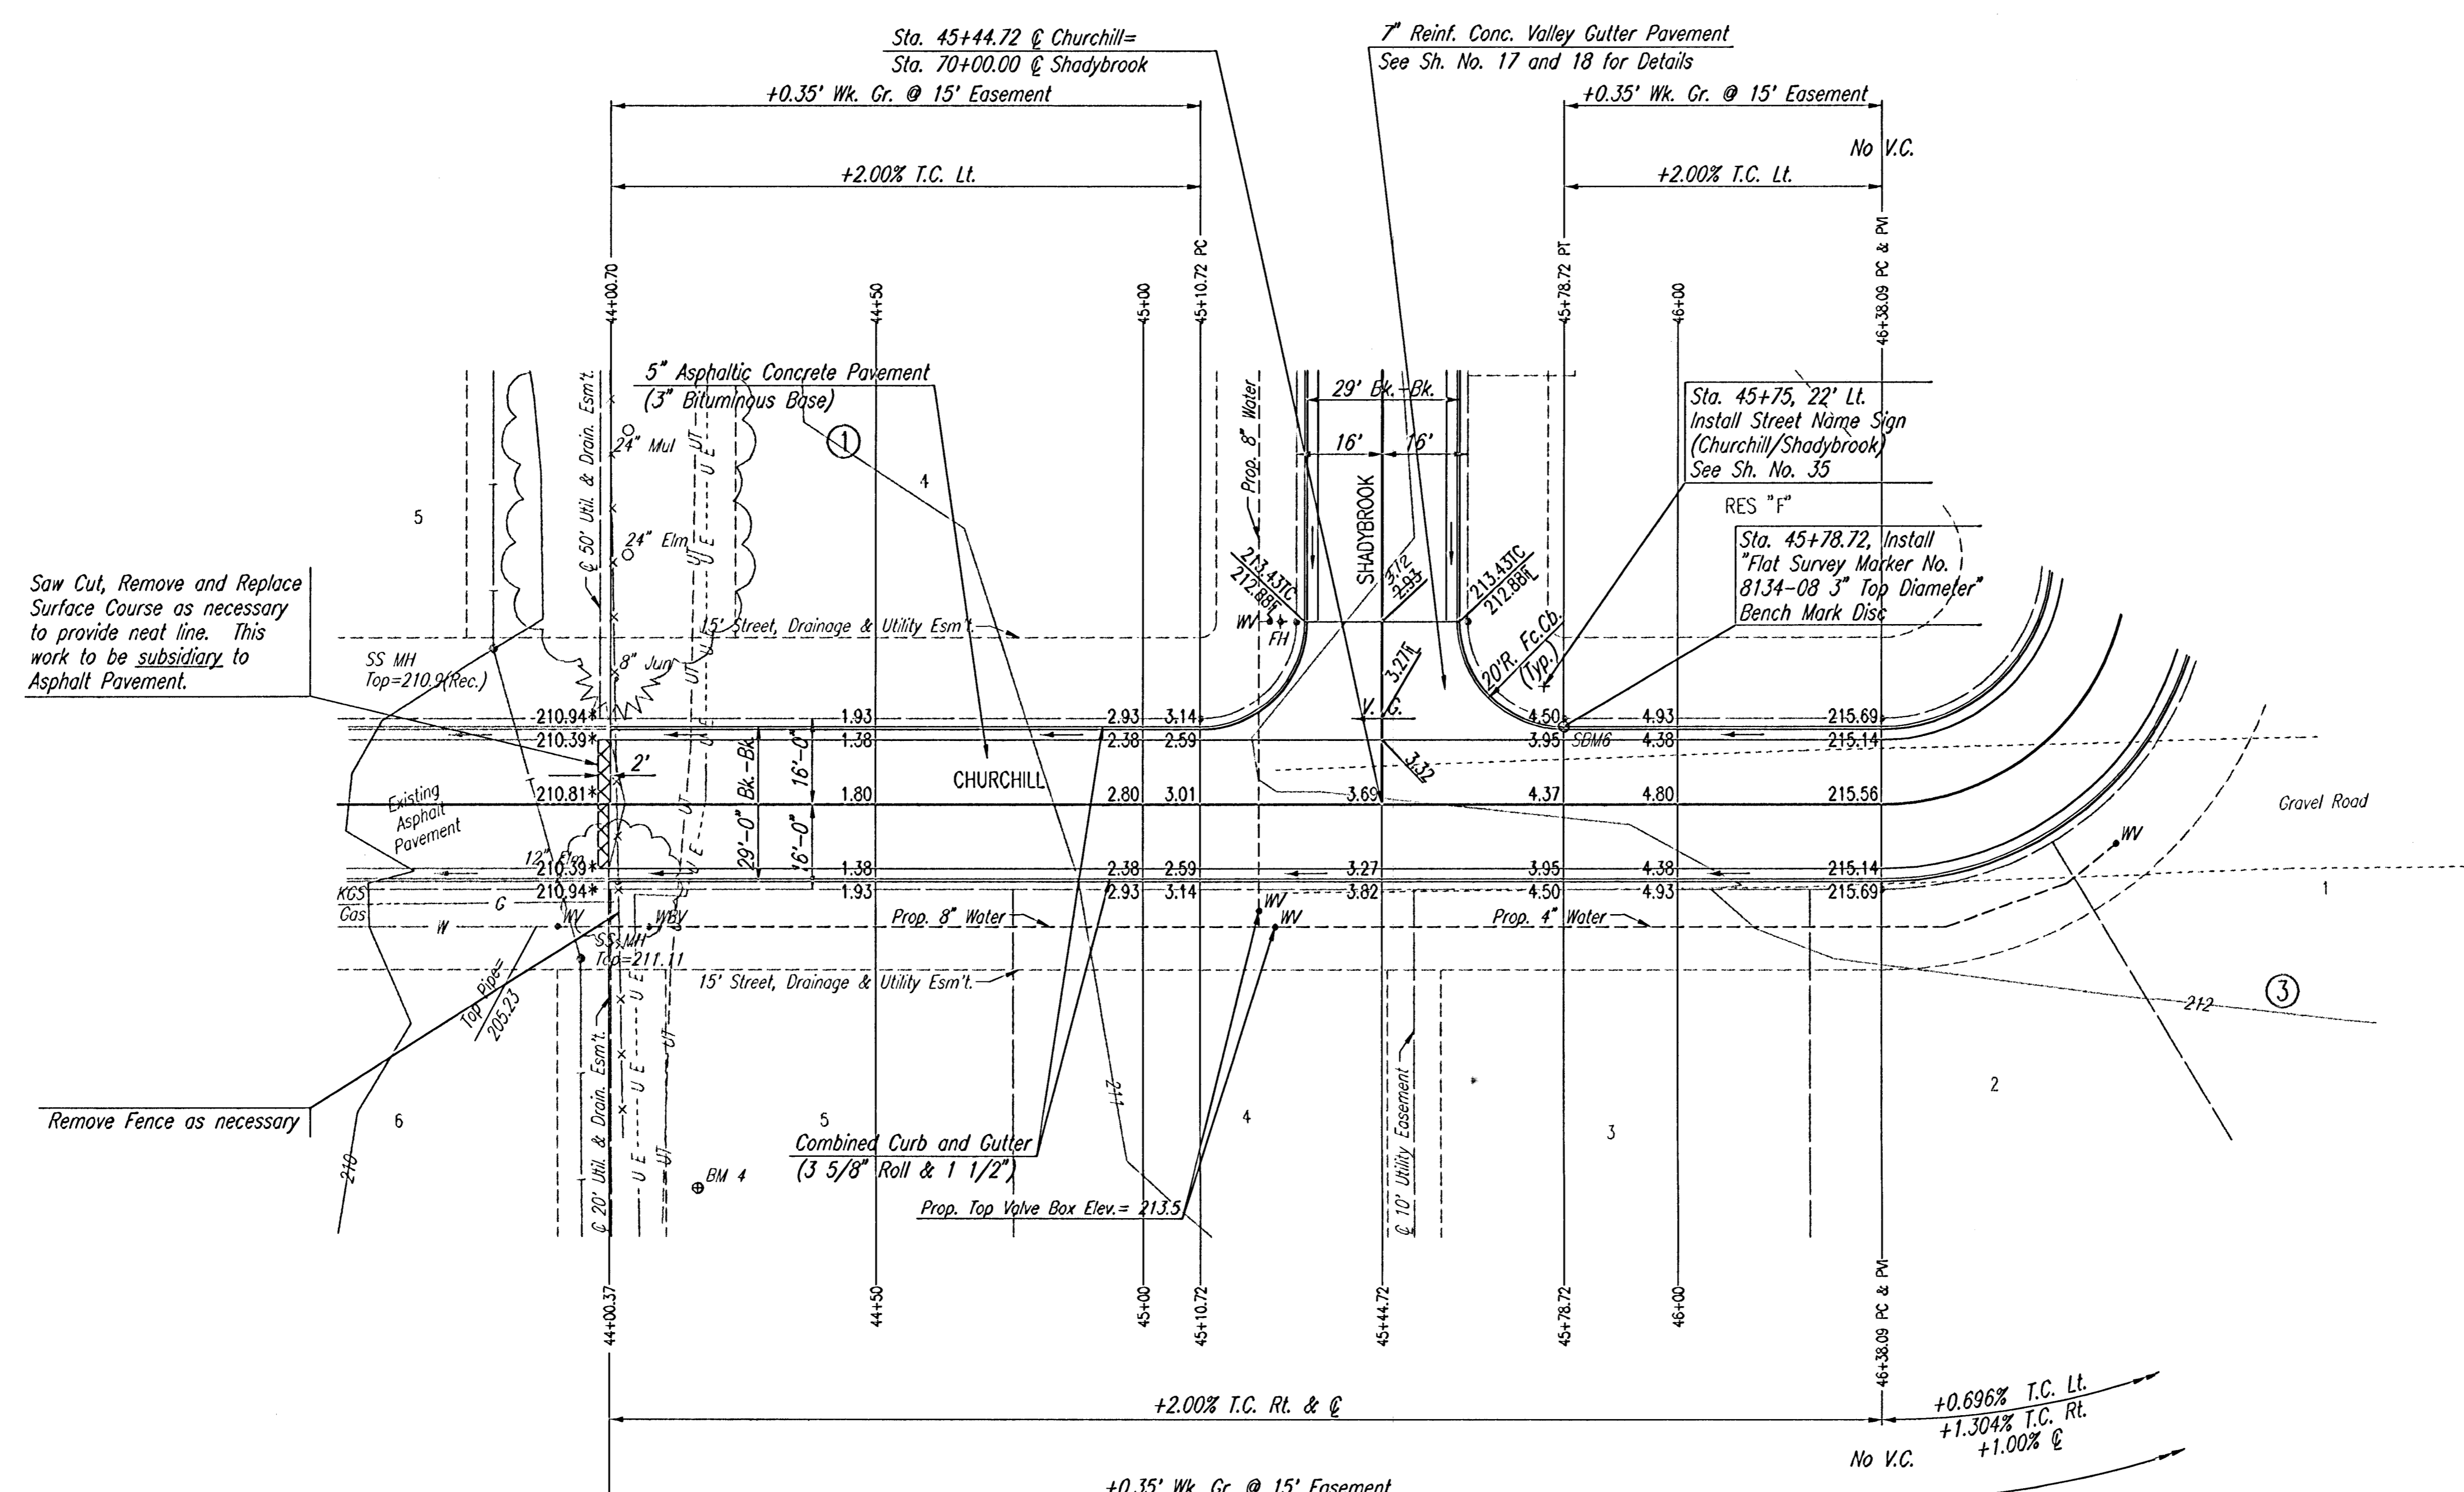

Saw Cut, Remove and Replace Surface Course as necessary to provide neat line. This work to be subsidiary to Asphalt Pavement.

Remove Fence as necessary

Sta. 45+75, 22' Lt. Install Street Name Sign (Churchill/Shadybrook) See Sh. No. 35

RES "F"
Sta. 45+78.72, Install "Flat Survey Marker No. 8134-08 3" Top Diameter" Bench Mark Disc

NOTE: THIS STREET TO BE CONSTRUCTED WITH ROLL-TYPE CURB. TOP OF CURB ELEVATIONS GIVEN ARE FOR FULL HEIGHT CURB.

* MATCH EXISTING

RECORD DRAWING
Bradley H. Edwards 24 NOV 03
 REMINGTON PLACE - PHASE 2

CHURCHILL
 STA. 43+98.72 TO STA. 46+38.09

Professional Engineering Consultants, P.A.
 303 S. TOPEKA • WICHITA, KANSAS 67202
 316-262-2691 • FAX 316-262-3003

Designed by	BER	Checked by	
Drawn by	DEP	Date	DEC, 2002
		Job No.	02398

DSNR: DEP OPER: DEP SCALE: 1"=20.00
 0:\2002\02398\000\CHURCHILL1 12-03-2002 03:13:34 pm