

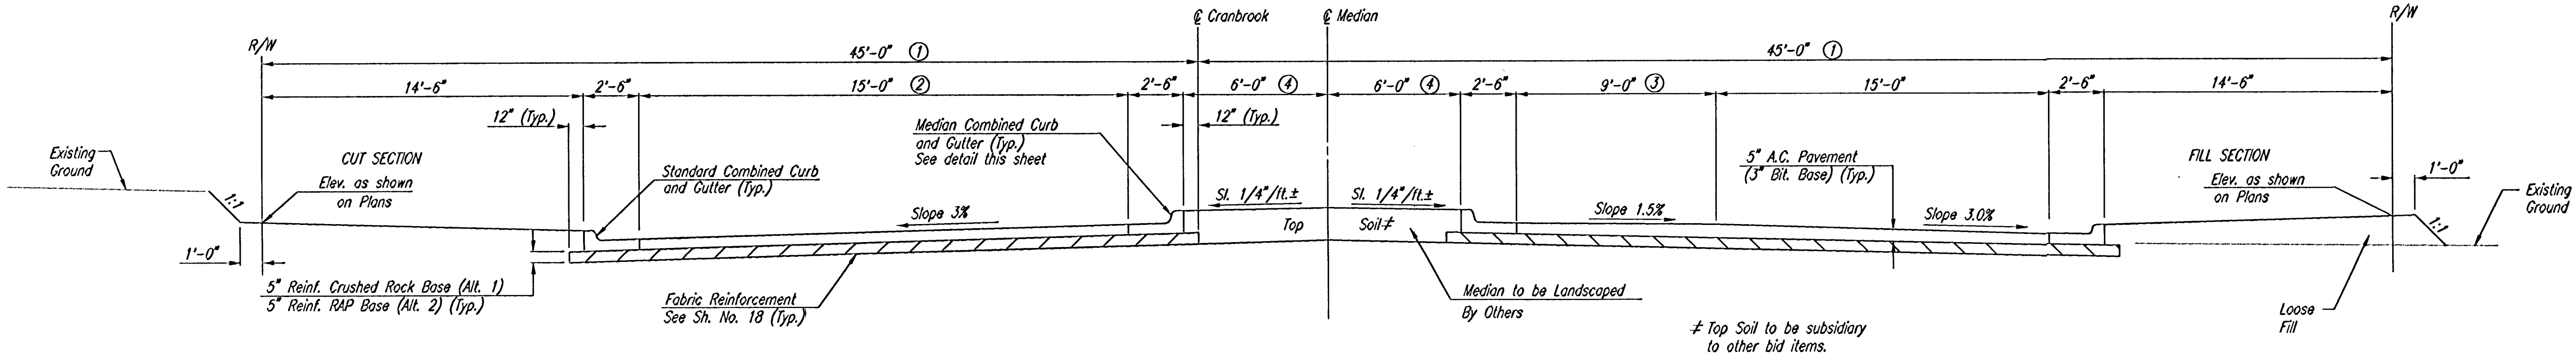


PROJECT NO.	SHEET NO.	TOTAL SHEETS
472-83376	21	50

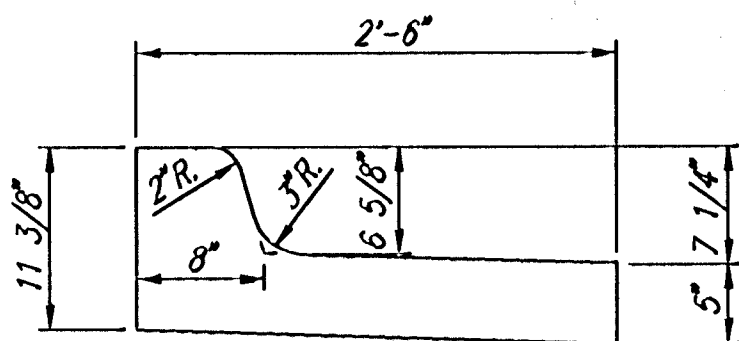

- ① Varies from 32'-0" at Sta. 56+90.37 to 45'-0" at Sta. 57+73.60
See Plan
- ② Varies from 15'-0" at Sta. 57+04.84 to 28'-0" at Sta. 58+06.64
See Plan
- ③ Varies from 0'-0" at Sta. 57+04.84 to 13'-0" at Sta. 58+06.64
See Plan
- ④ No Median Sta. 57+04.84 to Sta. 58+06.64
See Plan

♦ LEFT FACE OF CURB STATION

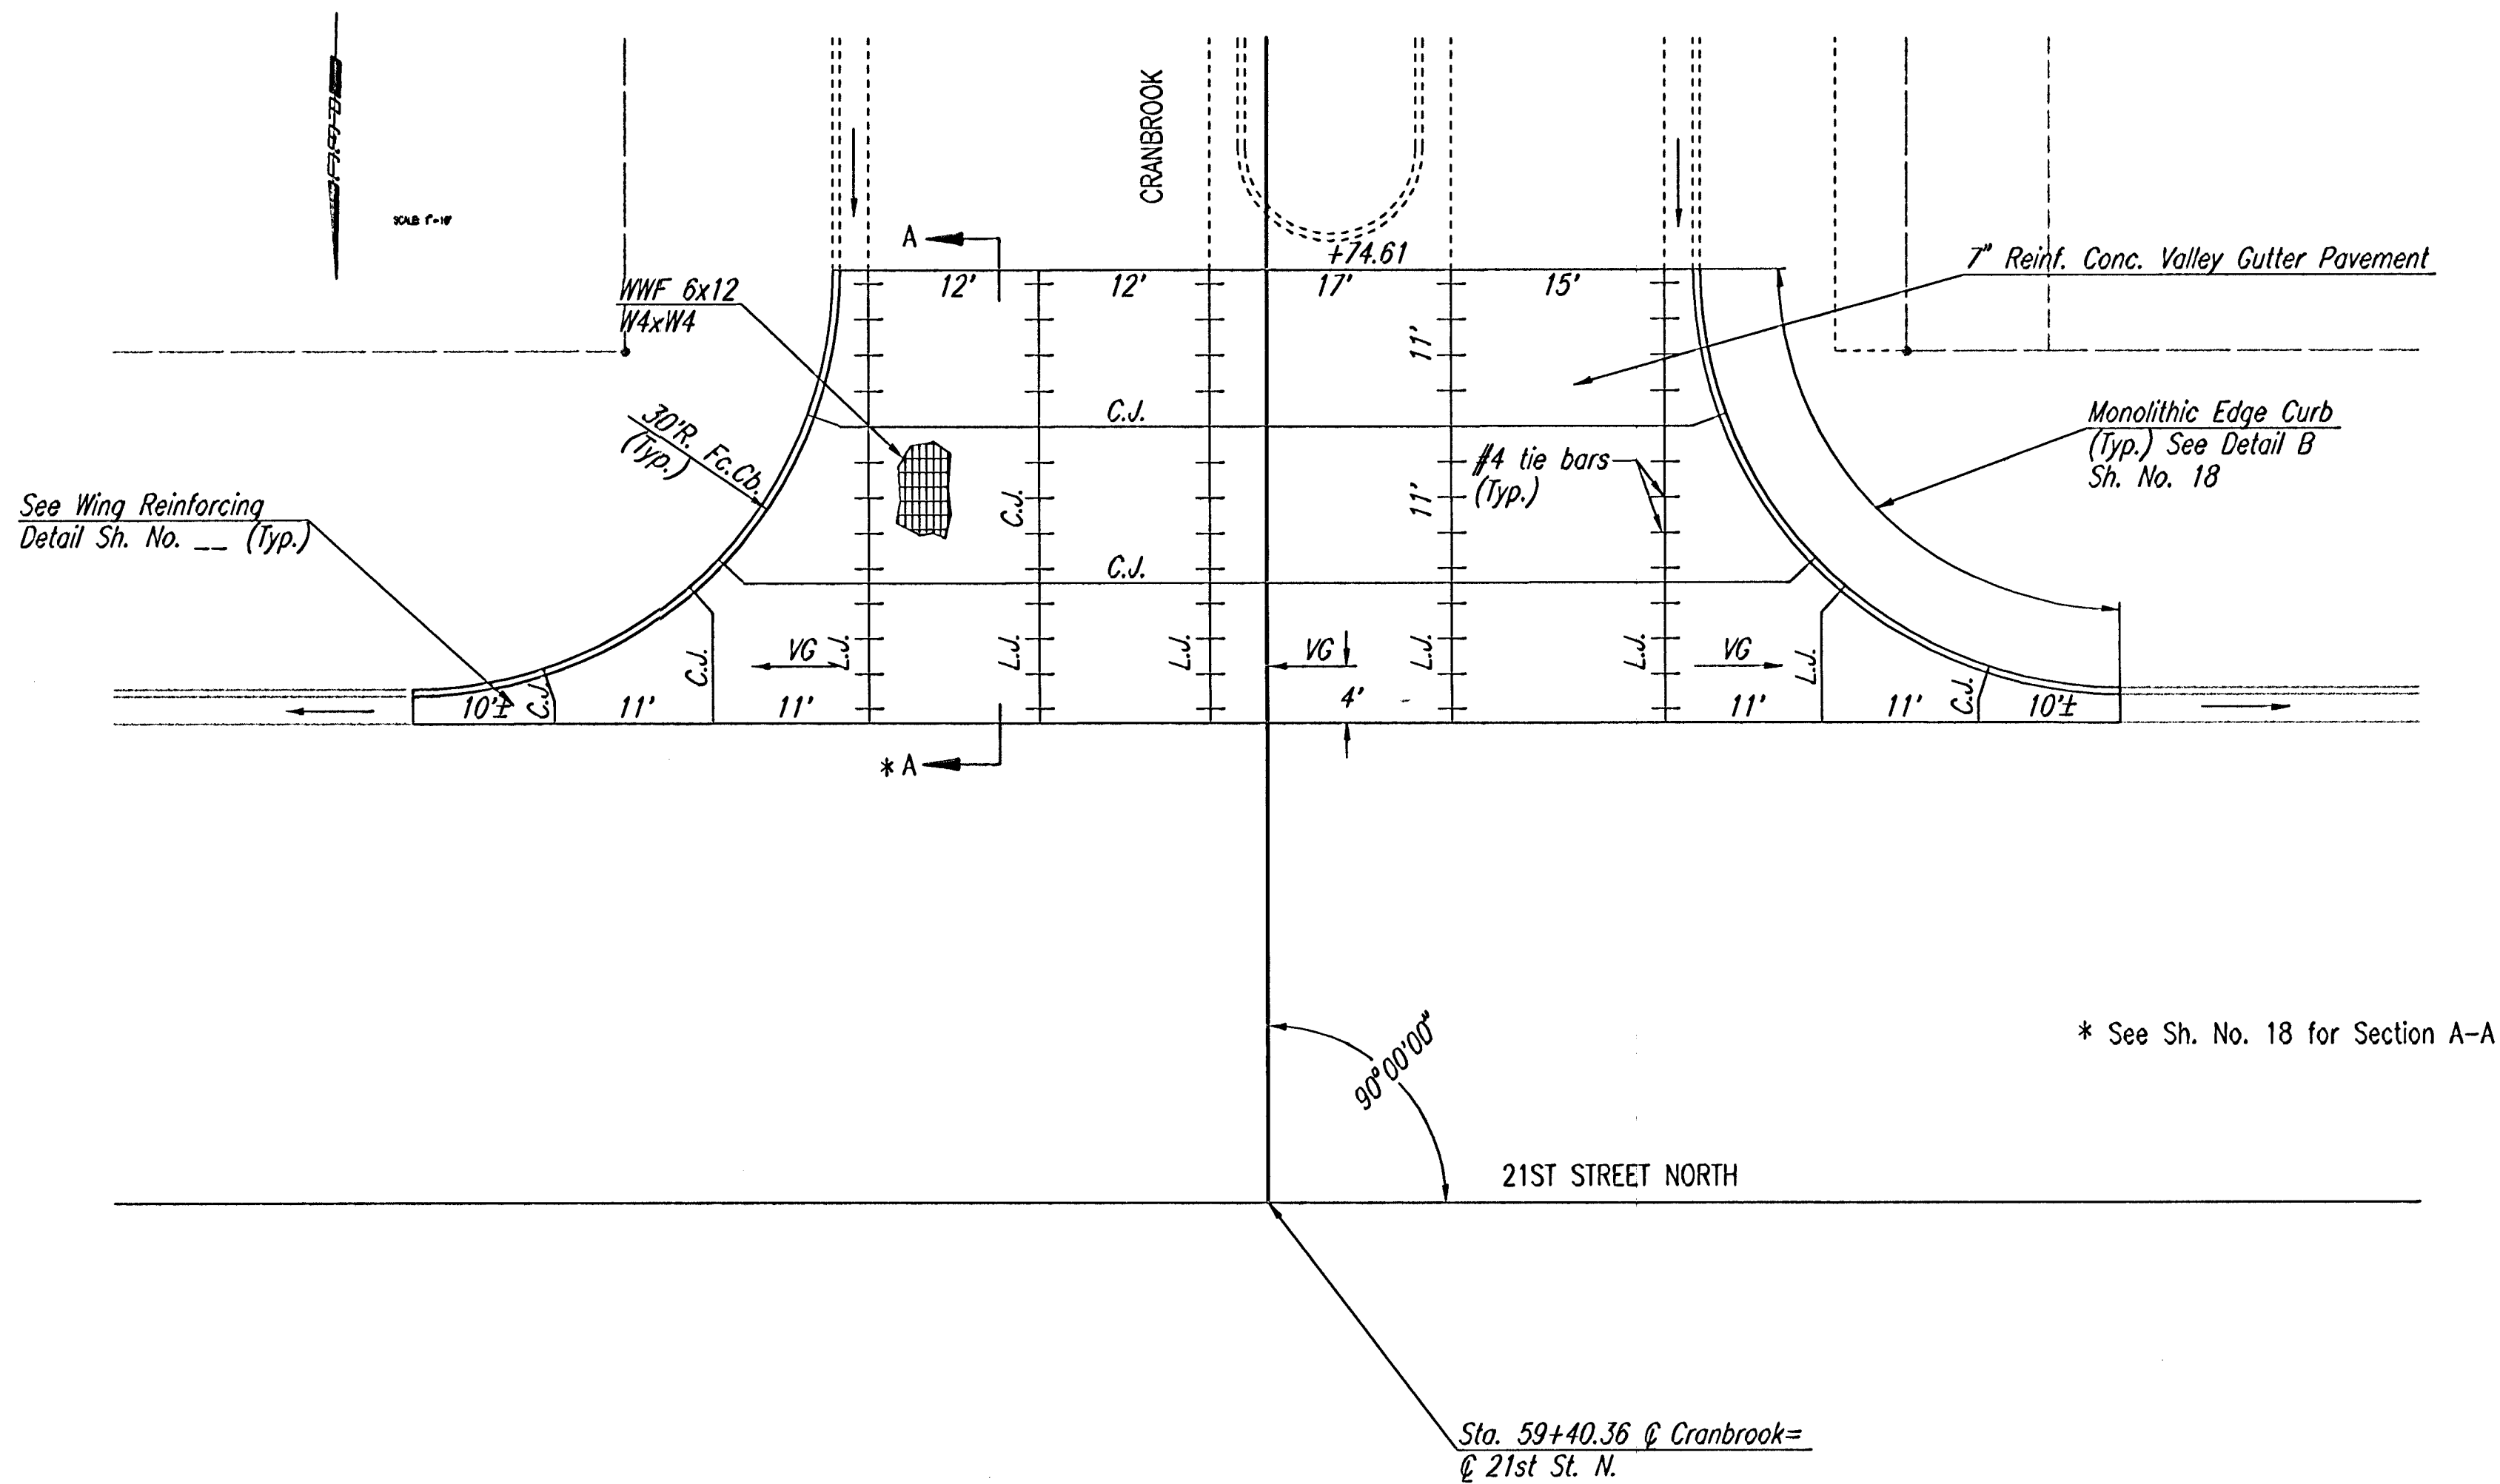

MEDIAN COMBINED CURB & GUTTER
(6 5/8")

RECORD DRAWING

CRANBROOK ENTRANCE
TYPICAL SECTION AND
VALLEY GUTTER PLAN



Professional Engineering Consultants, P.A.
303 S. TOPEKA • WICHITA, KANSAS 67202
316-262-2691 • FAX 316-262-3003

Designed by	BER	Checked by	
Drawn by	DEP	Date	DEC., 2002
		Job No.	02398